

On page 1, insert description from plat: "A resubdivision of lots 1, 2 and 3, Porteous Subdivision No. 6, in the Northwest Quarter, etc.

KH: Legal description has been updated.

Please add a new cover sheet with new Data table add what exist and what's been added

KH: A new cover sheet with date table has been added.

\\kimley-horn.com\mt_den\DEN_Civil\196008000_Porteos Industrial\CADD\Plansheets\Contextual Site Plan\196008000CV.dwg Officeass, Cody 9/19/2022 9:21 AM

LEGAL DESCRIPTION: PARCELS OF LAND LOCATED IN THE NORTHWEST QUARTER OF SECTION 9 AND THE NORTHEAST QUARTER OF SECTION 8, TOWNSHIP 3 SOUTH, RANGE 65 WEST OF THE 6TH P.M., ADAMS COUNTY, STATE OF COLORADO

THIS SITE PLAN AND ANY AMENDMENTS HERETO, UPON APPROVAL BY THE CITY OF AURORA AND RECORDING, SHALL BE BINDING UPON THE APPLICANTS THEREFORE, THEIR SUCCESSORS AND ASSIGNS. THIS PLAN SHALL LIMIT AND CONTROL THE ISSUANCE AND VALIDITY OF ALL BUILDING PERMITS, AND SHALL RESTRICT AND LIMIT THE CONSTRUCTION, LOCATION, USE, OCCUPANCY AND OPERATION OF ALL LAND AND STRUCTURES WITHIN THIS PLAN TO ALL CONDITIONS, REQUIREMENTS, LOCATIONS AND LIMITATIONS SET FORTH HEREIN. ABANDONMENT, WITHDRAWAL OR AMENDMENT OF THIS PLAN MAY BE PERMITTED ONLY UPON APPROVAL OF THE CITY OF AURORA.

LOT 1: IN WITNESS THEREOF, AOZI – AURORA BUILDING I, LLC AN INDIANA LIMITED LIABILITY COMPANY, BY: AMBROSE PROPERTY GROUP, LLC AN INDIANA LIMITED LIABILITY COMPANY, ITS MANAGER, AS ITS INTEREST MAY APPEAR OF RECORD HAS CAUSED THESE PRESENTS TO BE EXECUTED

THIS 19th DAY OF September AD. 2022

BY: [Signature]
TITLE: AUTHORIZED REPRESENTATIVE

STATE OF INDIANA
COUNTY OF Marion

THE FOREGOING INSTRUMENT WAS ACKNOWLEDGED BEFORE ME, A NOTARY PUBLIC IN AND FOR THE STATE OF INDIANA, ON Sept. 19th, 2022, BY Grant Goldman IN HIS CAPACITY AS AUTHORIZED REPRESENTATIVE OF AMBROSE PROPERTY GROUP, LLC, AS MANAGER OF AOZI – AURORA BUILDING I, LLC AN INDIANA LIMITED LIABILITY COMPANY, WITNESS MY HAND AND OFFICIAL SEAL

[Signature] NOTARY SEAL
(NOTARY PUBLIC)

MY COMMISSION EXPIRES July 15, 2030

NOTARY BUSINESS ADDRESS: 888 Keystone Crossing, Indianapolis 46240

LOT 2: IN WITNESS THEREOF, AOZI – AURORA BUILDING II, LLC AN INDIANA LIMITED LIABILITY COMPANY, BY: AMBROSE PROPERTY GROUP, LLC AN INDIANA LIMITED LIABILITY COMPANY, ITS MANAGER, AS ITS INTEREST MAY APPEAR OF RECORD HAS CAUSED THESE PRESENTS TO BE EXECUTED

THIS 19th DAY OF September AD. 2022

BY: [Signature]
TITLE: AUTHORIZED REPRESENTATIVE

STATE OF INDIANA
COUNTY OF Marion

THE FOREGOING INSTRUMENT WAS ACKNOWLEDGED BEFORE ME, A NOTARY PUBLIC IN AND FOR THE STATE OF INDIANA, ON Sept. 19th, 2022, BY Grant Goldman IN HIS CAPACITY AS AUTHORIZED REPRESENTATIVE OF AMBROSE PROPERTY GROUP, LLC, AS MANAGER OF AOZI – AURORA BUILDING II, LLC AN INDIANA LIMITED LIABILITY COMPANY, WITNESS MY HAND AND OFFICIAL SEAL

[Signature] NOTARY SEAL
(NOTARY PUBLIC)

MY COMMISSION EXPIRES July 15, 2030

NOTARY BUSINESS ADDRESS: 888 Keystone Crossing, Indianapolis 46240

LOT 3: IN WITNESS THEREOF, ACP DIA 1287 INVESTORS, LLC, A COLORADO LIMITED LIABILITY COMPANY, BY: PORTEOS HOLDINGS, LLC, AN ARIZONA LIMITED LIABILITY COMPANY, ITS SOLE MEMBER, BY: DIA 1287 HOLDINGS, LLC, AN ARIZONA LIMITED LIABILITY COMPANY, ITS SOLE MEMBER, BY: A&C PROPERTIES, INC., AN ARIZONA CORPORATION, ITS MANAGER AS ITS INTEREST MAY APPEAR OF RECORD HAS CAUSED THESE PRESENTS TO BE EXECUTED

THIS 26th DAY OF September AD. 2022

BY: William P. Wichterman
TITLE: VICE PRESIDENT

STATE OF Colorado
COUNTY OF Denver

THE FOREGOING INSTRUMENT WAS ACKNOWLEDGED BEFORE ME, A NOTARY PUBLIC IN AND FOR THE STATE OF Colorado, ON 9/20, 2022, BY William P. Wichterman IN HIS CAPACITY AS V.P. OF A&C PROPERTIES, INC., THE MANAGER OF DIA 1287, LLC, THE SOLE MEMBER OF PORTEOS HOLDINGS, LLC, THE SOLE MEMBER OF ACP DIA 1287 INVESTORS, LLC, A COLORADO LIMITED LIABILITY COMPANY, WITNESS MY HAND AND OFFICIAL SEAL

Sarah Seipp NOTARY SEAL
(NOTARY PUBLIC)

MY COMMISSION EXPIRES 3/16/2025

NOTARY BUSINESS ADDRESS: 4582 S Ulster St. #1500 Denver, CO 80237

All the added sheet from the approved set like sheet 31 needs to be bubbled the entire page including the title block

KH: The entire page for new layout sheets has been clouded.

PROJECT DATA

LAND AREA WITHIN PROPERTY LINES	130.46 ACRES
NUMBER OF BUILDINGS	2
NUMBER OF STORIES	1
MAXIMUM HEIGHT OF BUILDINGS	50'-0"
TOTAL GROSS FLOOR AREA	1,648,602 SF
OFFICE GFA/WAREHOUSE GFA;	BUILDING 1: 62,410 SF; 187,230 SF; 374,460 SF
DISTRIBUTION GFA	BUILDING 2: 30,735 SF; 860,581 SF; 133,185 SF
TOTAL BUILDING COVERAGE	1,648,602 SF; 29%
HARD SURFACE AREA	2,797,423 SF; 49%
LANDSCAPE AREA	1,250,224 SF; 22%
TOTAL NUMBER OF PARKING SPACES	1,671
PRESENT ZONING CLASSIFICATION	AD AIRPORT DISTRICT SUBAREA C
PROPOSED USE	STORAGE, DISTRIBUTION, AND WAREHOUSING
NUMBER OF SIGNS PERMITTED	5 PERMANENT SIGNS ALLOWED
PROPOSED NUMBER OF SIGNS	5
MAXIMUM ALLOWED SIGN AREA	200 SQ. FT.
MAXIMUM MONUMENT SIGN CRITERIA	UP TO 4 SIGN AT 50 SF EACH (4 SIGNS PROVIDED)
2015 IBC OCCUPANCY CLASS	B/S-1
2015 IBC CONSTRUCTION TYPE	TYPE IIB – AUTOMATIC SPRINKLER SYSTEM
SUMMARY OF WAREHOUSE, DISTRIBUTION, AND OFFICE PARKING CALCULATIONS ABOVE:	
TOTAL AUTO SPACES:	REQUIRED 1,178 PROVIDED 1,671
TRAILER SPACES:	N/A 985
ACCESSIBLE SPACES:	22 (ICC A117-2009 GUIDELINES) 30
VAN ACCESSIBLE SP:	5 5
BICYCLE SPACES:	84 (5% REQUIRED) 84
*SEE SHEET 2 FOR DETAILED PARKING BREAKDOWN	

OWNER/DEVELOPER (LOT 1)

AOZI – AURORA BUILDING I, LLC
888 KEYSTONE CROSSING
SUITE 1150
INDIANAPOLIS, IN 46240-4609

OWNER/DEVELOPER (LOT 3)

ACP DIA 1287 INVESTORS, LLC
4530 EAST SHEA BOULEVARD,
SUITE 100
PHOENIX, AZ 85028

ARCHITECT

POWERS BROWN ARCHITECTURE
1580 LINCOLN ST., SUITE 480
DENVER, CO 80203
(303) 225-3345

LANDSCAPE ARCHITECT

KIMLEY-HORN
CHRIS HEPLER, RLA
4582 SOUTH ULSTER STREET, SUITE 1500
DENVER, CO 80237
(303) 228-2319

OWNER/DEVELOPER (LOT 2)

AOZI – AURORA BUILDING II, LLC
888 KEYSTONE CROSSING
SUITE 1150
INDIANAPOLIS, IN 46240-4609

ENGINEER

KIMLEY-HORN
BRAD COONEY, P.E.
4582 SOUTH ULSTER STREET, SUITE 1500
DENVER, CO 80237
(303) 974-3625


SURVEYOR

COLLIERS ENGINEERING & DESIGN.
BRANDON A. MOSER, P.L.S.
7110 W. JEFFERSON AVE, SUITE 100
LAKEWOOD, CO 80235
(303) 731-6216

ISSUED	
SHEET NO.	SHEET INDEX
1	COVER SHEET
2-3	GENERAL NOTES
4	OVERALL SITE PLAN
5-25	DETAILED SITE PLANS
26	OVERALL GRADING PLAN
27-47	DETAILED GRADING PLANS
48	OVERALL UTILITY PLAN
49-68	DETAILED UTILITY PLANS
69	OVERALL LANDSCAPE PLAN
70-91	DETAILED LANDSCAPE PLAN
92-93	BUILDING PLAN AND ELEVATIONS
94	OVERALL PHOTOMETRIC PLAN
95-1P	DETAILED PHOTOMETRIC PLANS

PORTEOS INDUSTRIAL AT PORTEOS
SITE PLAN WITH ADJUSTMENTS

LOCATED IN THE NW $\frac{1}{4}$ OF SECTION 9,
TOWNSHIP 3 SOUTH, RANGE 65 WEST OF THE 6TH P.M.,
CITY OF AURORA, ADAMS COUNTY, STATE OF COLORADO

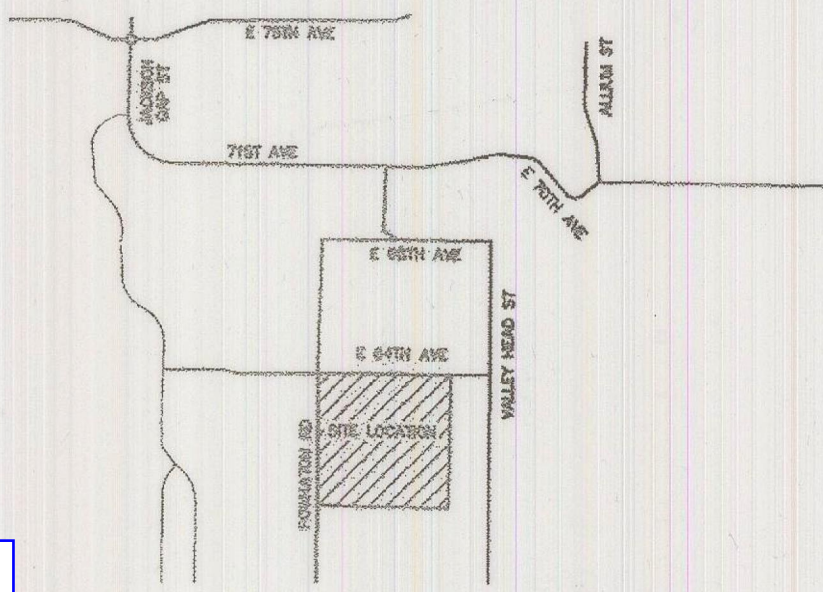

VICINITY MAP

LEGAL DESCRIPTION:

PORTEOS SUBDIVISION FILING NO. 6 CONSISTS OF PARCELS OF LAND LOCATED IN THE NORTHWEST QUARTER OF SECTION 9, TOWNSHIP 3 SOUTH, RANGE 65 WEST OF THE 6TH P.M., CITY OF AURORA, ADAMS COUNTY, STATE OF COLORADO

BENCHMARK

CITY OF AURORA BENCHMARK NUMBER 11V3S65 BEING A 3.25" ALUMINUM CAP 0.6' BELOW SURFACE IN PLOWED FIELD "CITY OF AURORA 2008 PLS 23527"
NAVD 88 ELEVATION: 5434.00'

CITY OF AURORA SITE PLAN NOTES:

- THE DEVELOPER, HIS SUCCESSORS AND ASSIGNS, INCLUDING THE HOMEOWNERS OR MERCHANTS ASSOCIATION, SHALL BE RESPONSIBLE FOR INSTALLATION, MAINTENANCE AND REPLACEMENT OF ALL FIRE LANE SIGNS AS REQUIRED BY THE CITY OF AURORA.
- ALL SIGNS MUST CONFORM TO THE CITY OF AURORA SIGN CODE AND AURORA FDP. THE DEVELOPER IS REQUIRED TO PLACE TRAFFIC CONTROL, STREET NAME, AND GUIDE SIGNS ON ALL PUBLIC STREETS AND PRIVATE STREETS APPROACHING AN INTERSECTION WITH A PUBLIC STREET.
- RIGHT OF WAY FOR INGRESS AND EGRESS FOR SERVICE AND EMERGENCY VEHICLES IS GRANTED OVER, ACROSS, ON AND THROUGH ANY AND ALL PRIVATE ROADS AND WAYS NOW OR HEREAFTER ESTABLISHED ON THE DESCRIBED PROPERTY, AND THE SAME ARE HEREBY DESIGNATED AS "SERVICE/EMERGENCY AND UTILITY EASEMENTS" AND SHALL BE POSTED "NO PARKING – FIRE LANE."
- "ACCESSIBLE EXTERIOR ROUTES" SHALL BE PROVIDED FROM PUBLIC TRANSPORTATION STOPS, ACCESSIBLE PARKING AND ACCESSIBLE PASSENGER LOADING ZONES AND PUBLIC SIDEWALKS TO 60% OF THE ACCESSIBLE BUILDING ENTRANCES THEY SERVE. THE ACCESSIBLE ROUTE BETWEEN ACCESSIBLE PARKING AND ACCESSIBLE BUILDING ENTRANCES SHALL BE THE MOST PRACTICAL DIRECT ROUTE. THE ACCESSIBLE ROUTE MUST BE LOCATED WITHIN A SIDEWALK, NO SLOPE ALONG THIS ROUTE MAY EXCEED 1:20 WITHOUT PROVIDING A RAMP WITH A MAXIMUM SLOPE OF 1:12 AND HANDRAILS. CROSSWALKS ALONG THIS ROUTE SHALL BE WIDE ENOUGH TO WHOLLY CONTAIN THE CURB RAMP WITH A MINIMUM WIDTH OF 36" AND SHALL BE PAINTED WITH WHITE STRIPES. THE CITY OF AURORA ENFORCES HANDICAPPED ACCESSIBILITY REQUIREMENTS BASED ON THE 2015 INTERNATIONAL BUILDING CODE, CHAPTER 11, AND THE INTERNATIONAL CODE COUNCIL (ICC) A117.1-2009.
- THE APPLICANT HAS THE OBLIGATION TO COMPLY WITH ALL APPLICABLE REQUIREMENTS OF THE AMERICANS WITH DISABILITIES ACT.
- THE DEVELOPER, HIS SUCCESSORS AND ASSIGNS, SHALL BE RESPONSIBLE FOR INSTALLATION, MAINTENANCE AND REPLACEMENT OF ALL LANDSCAPING MATERIALS SHOWN OR INDICATED ON THE APPROVED SITE PLAN OR LANDSCAPE PLAN ON FILE IN THE PLANNING & DEVELOPMENT SERVICES DEPARTMENT. ALL LANDSCAPING WILL BE INSTALLED PRIOR TO ISSUANCE OF CERTIFICATE OF OCCUPANCY.

SEE SHEET 3 FOR CONTINUED SITE PLAN NOTES.

AMENDMENTS

1 SITE LAYOUT CHANGES 3/25/24

Every sheet that has a layout change need to be bubbled and add delta to the amendments box

KH: Sheets with layout changes have been clouded.

CLERK AND RECORDER'S CERTIFICATE

ACCEPTED FOR FILING IN THE OFFICE OF THE COUNTY CLERK AND RECORDER OF ADAMS COUNTY, COLORADO ON THIS _____ DAY OF _____, 20____ A.D. AT _____ O'CLOCK _____ M.

COUNTY CLERK AND RECORDER _____ DEPUTY

FILE: _____

PAGE NO.: _____

RECEPTION NO.: _____

CITY OF AURORA APPROVALS

CITY ATTORNEY: [Signature]

PLANNING DIRECTOR: [Signature]

PLANNING COMMISSION: N/A

CITY COUNCIL: N/A

ATTEST: N/A

DATABASE APPROVAL: 11/17/20

DATE: 10/25/22

DATE: 11/25/22

DATE: N/A

DATE: N/A

DATE: N/A

DATE: 11/17/20

Kimley»Horn

PORTEOS INDUSTRIAL AT PORTEOS
CITY OF AURORA, COUNTY OF ADAMS
SITE PLAN WITH ADJUSTMENTS
COVER SHEET

DATE: 5/20/2020
DESIGNED BY:
DRAWN BY:
CHECKED BY: RJP


FILE NO.
196008000CV
PROJECT NO.
196008000

SHEET NO.
1

1 SITE
LAY
UT
CHAN
GES
SO
3/25/24
4 BJC


REVISION
BY
NO.

KIMLEY-HORN AND ASSOCIATES, INC.
196008000CV
Denver, Colorado 80237 (303) 228-2300

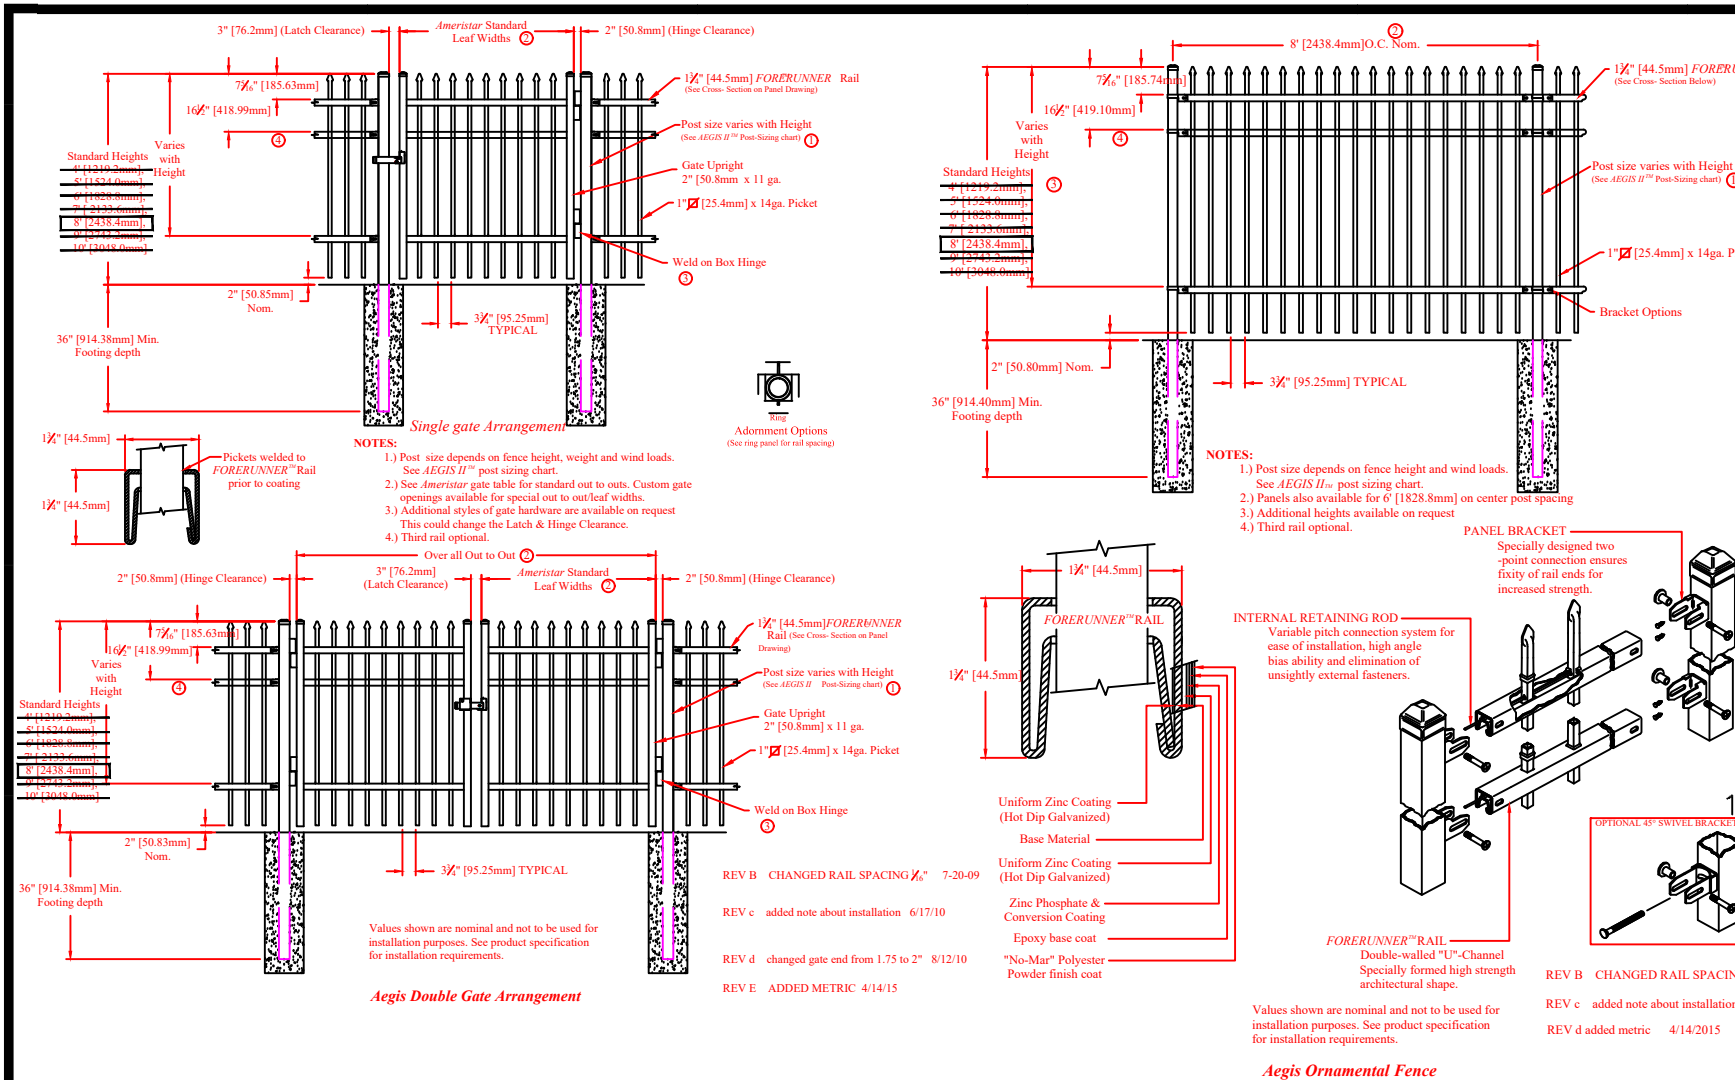


<u>PARKING BREAKDOWN*</u>		
	LOT 1, BUILDING 1	LOT 2, BUILDING 2
TOTAL SF	624,101	1,024,501
SPACES AVAILABLE	1032	233 INITIAL BUILD 639 FULL BUILD
OFFICE SPACES	188	92
DISTRIBUTION SPACES	375	547
WAREHOUSE SPACES	0	0
TOTAL REQUIRED SPACES	563	227

*THE REQUIRED PARKING COMES FROM AURORA UNIFIED DEVELOPMENT ORDINANCE (UDO) STANDARDS. BUILDING 1 WAS CALCULATED USING 10% OFFICE SPACE (3 SPOTS PER EVERY 1000 GSF), 60% DISTRIBUTION SPACE (1 SPOT PER EVERY 1000 GSF), AND 30% WAREHOUSE SPACE (NO PARKING REQUIREMENTS). BUILDING 2 WAS CALCULATED USING 3% OFFICE SPACE, 13% DISTRIBUTION, AND 84% WAREHOUSE.

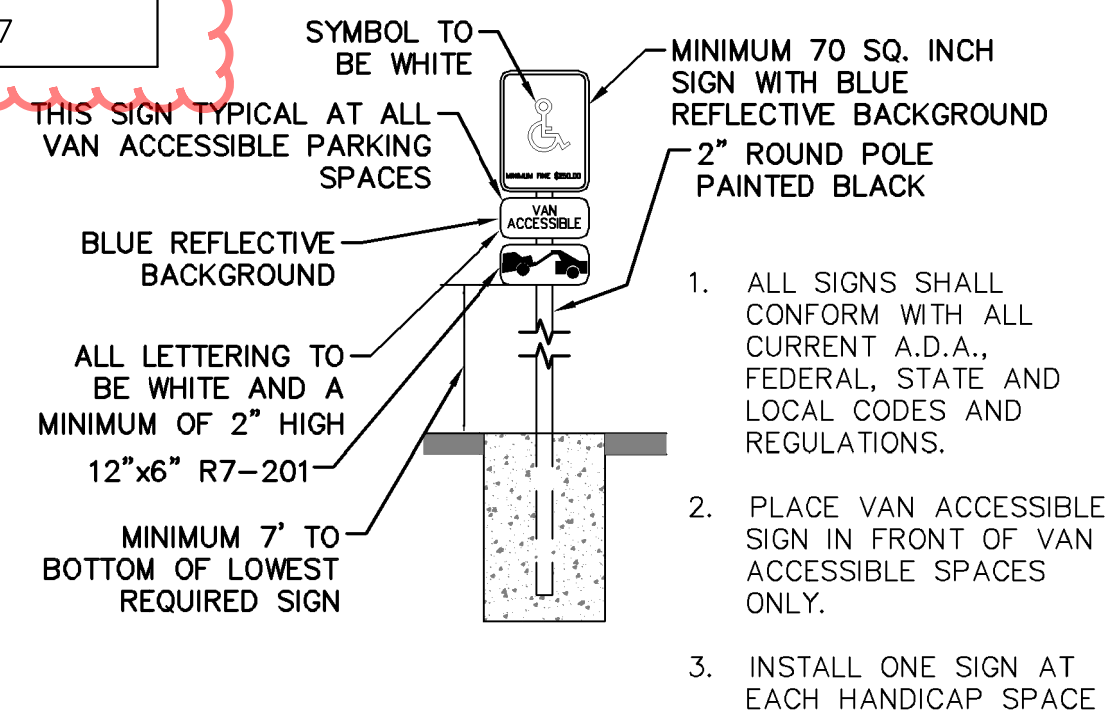


DIAGONAL STRIPING DETAIL

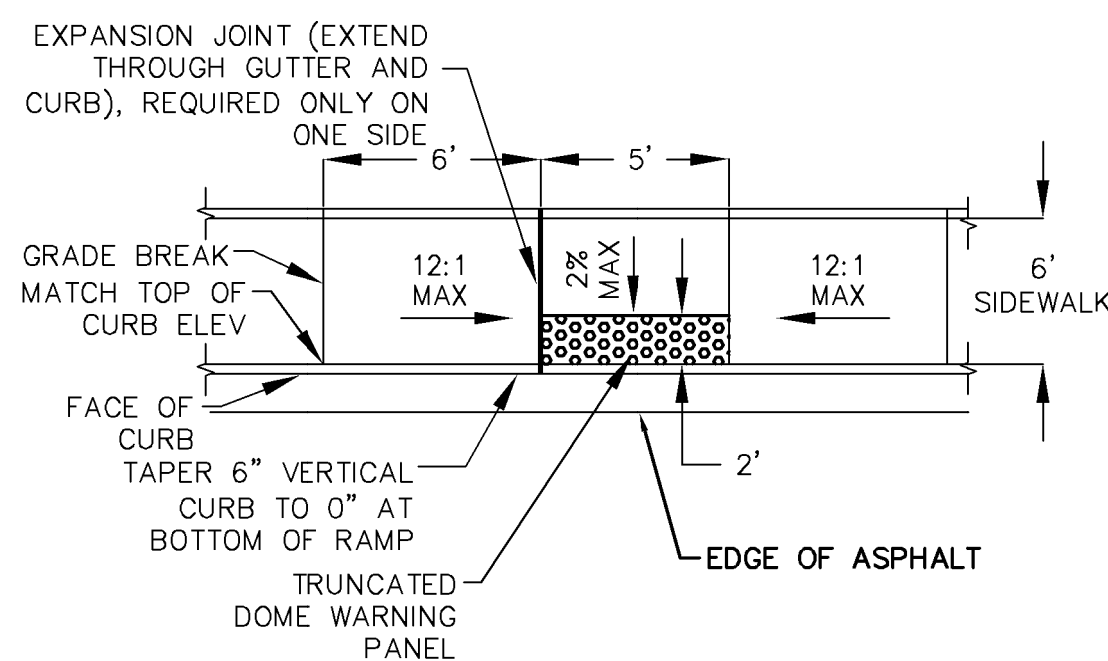

PARALLEL CURB RAMP DETAIL

N.T.S.

NOTE: CATCH GUTTER SLOPE SHALL BE MODIFIED AT CURB RAMP LOCATIONS
TO BE MAX 2% CROSS SLOPE AND MAX 5% IN DIRECTION OF TRAVEL

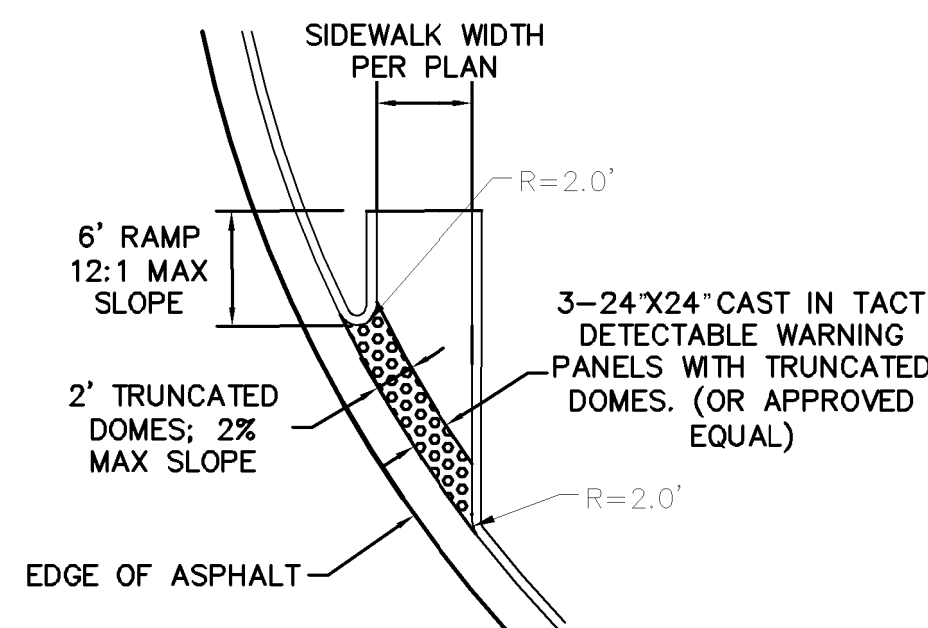


PRIVATE CURB/STRUCTURE DETAIL

NTS


FIRE LANE SIGN

N.T.S.

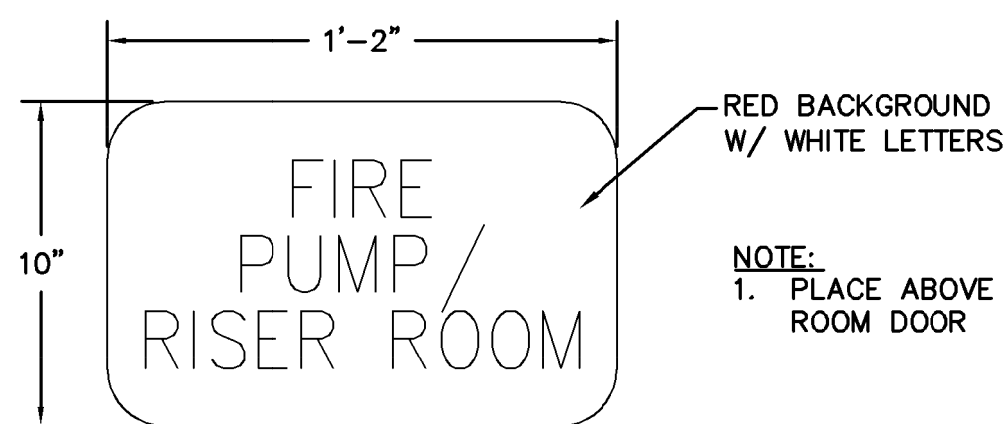


FIRE PUMP/RISER ROOM SIGN

N.T.S.

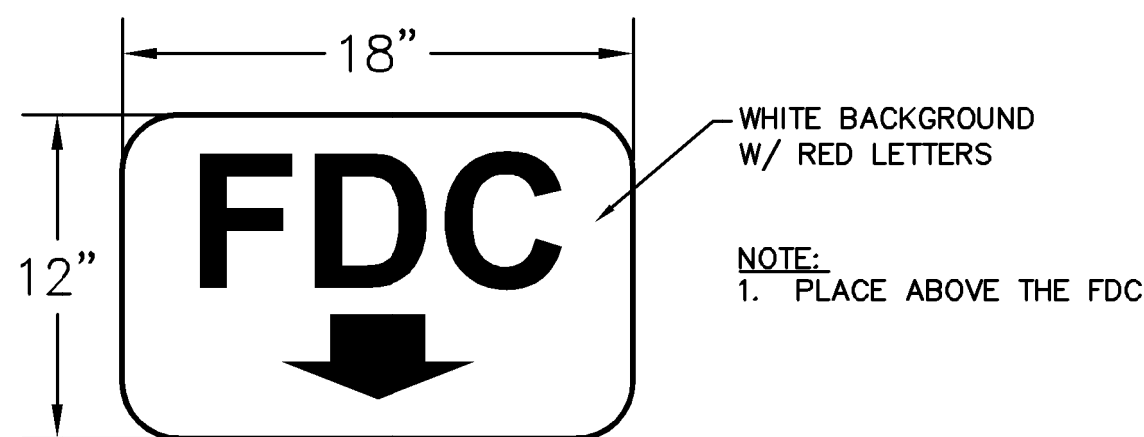

FDC SIGN

N.T.S.

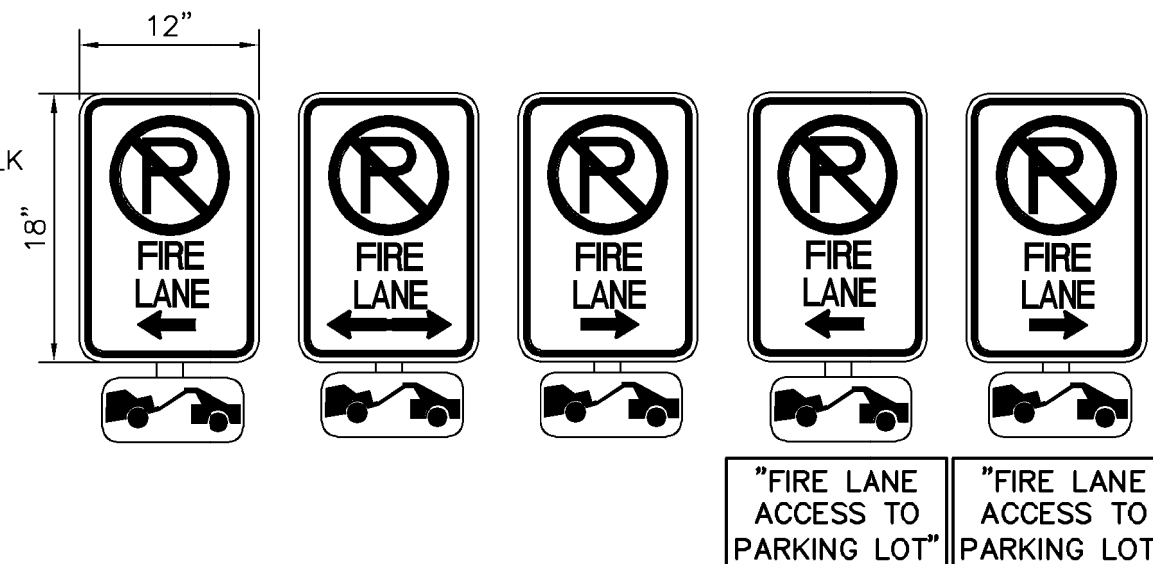

FIRE LANE NOTES:

1. SIGNS SHALL BE LOCATED AT THE RIGHT SIDE OF THE FIRE LANE ENTRANCE AND AT THE END OF THE FIRE LANE. THE INTERMEDIATE SIGNS SHALL HAVE DOUBLE HEADED ARROWS POINTING IN BOTH DIRECTIONS.

2. TYPICALLY, THE MAXIMUM SPACING OF THE FIRE LANE SIGNS IS 100' ON CENTER WITH SIGNS BEING PLACED ON BOTH SIDES OF THE FIRE LANE EASEMENT. WHERE EXCESSIVE CURVATURE OF THE FIRE LANE EXISTS, THE SPACING OF THE FIRE LANE SIGNAGE WILL BE INCREASED AS NEEDED.

3. THE SIGNS SHALL BE SET AT ANGLE OF NOT LESS THAN 30 DEGREES AND NOT MORE THAN 45 DEGREES WITH THE CURB OR LINE OF TRAFFIC FLOW.

4. FIRE LANE SIGNS SHOULD BE INSTALLED 2' BEHIND CURB OR SIDEWALK.


5. THE CLEARANCE TO THE BOTTOM OF THE SIGN SHALL BE 7 FEET. THERE SHALL BE NO OTHER SIGNS ATTACHED TO THE SIGN OR POST.

6. PLACEMENT OF THESE SIGNS CANNOT ENCOACH INTO THE 29' INSIDE TURNING RADIUS OF THE FIRE LANE EASEMENT, OBSTRUCT ANY FIRE HYDRANT OR FIRE DEPARTMENT CONNECTION OR ENCOACH INTO THE ACCESSIBLE ROUTE OF THE SIDEWALK AREA.

K:\DEN_Civil\196008000_Porteos Industrial\CADD\Plansheets\Contextual Site Plan\196008000GN.dwg Offchiss, Cody 10/12/2022 11:01 AM


MaxiForce™ Collapsible Bollard

Standard Body, Padlock Operated, Standard Style 1 Head, Simple Base

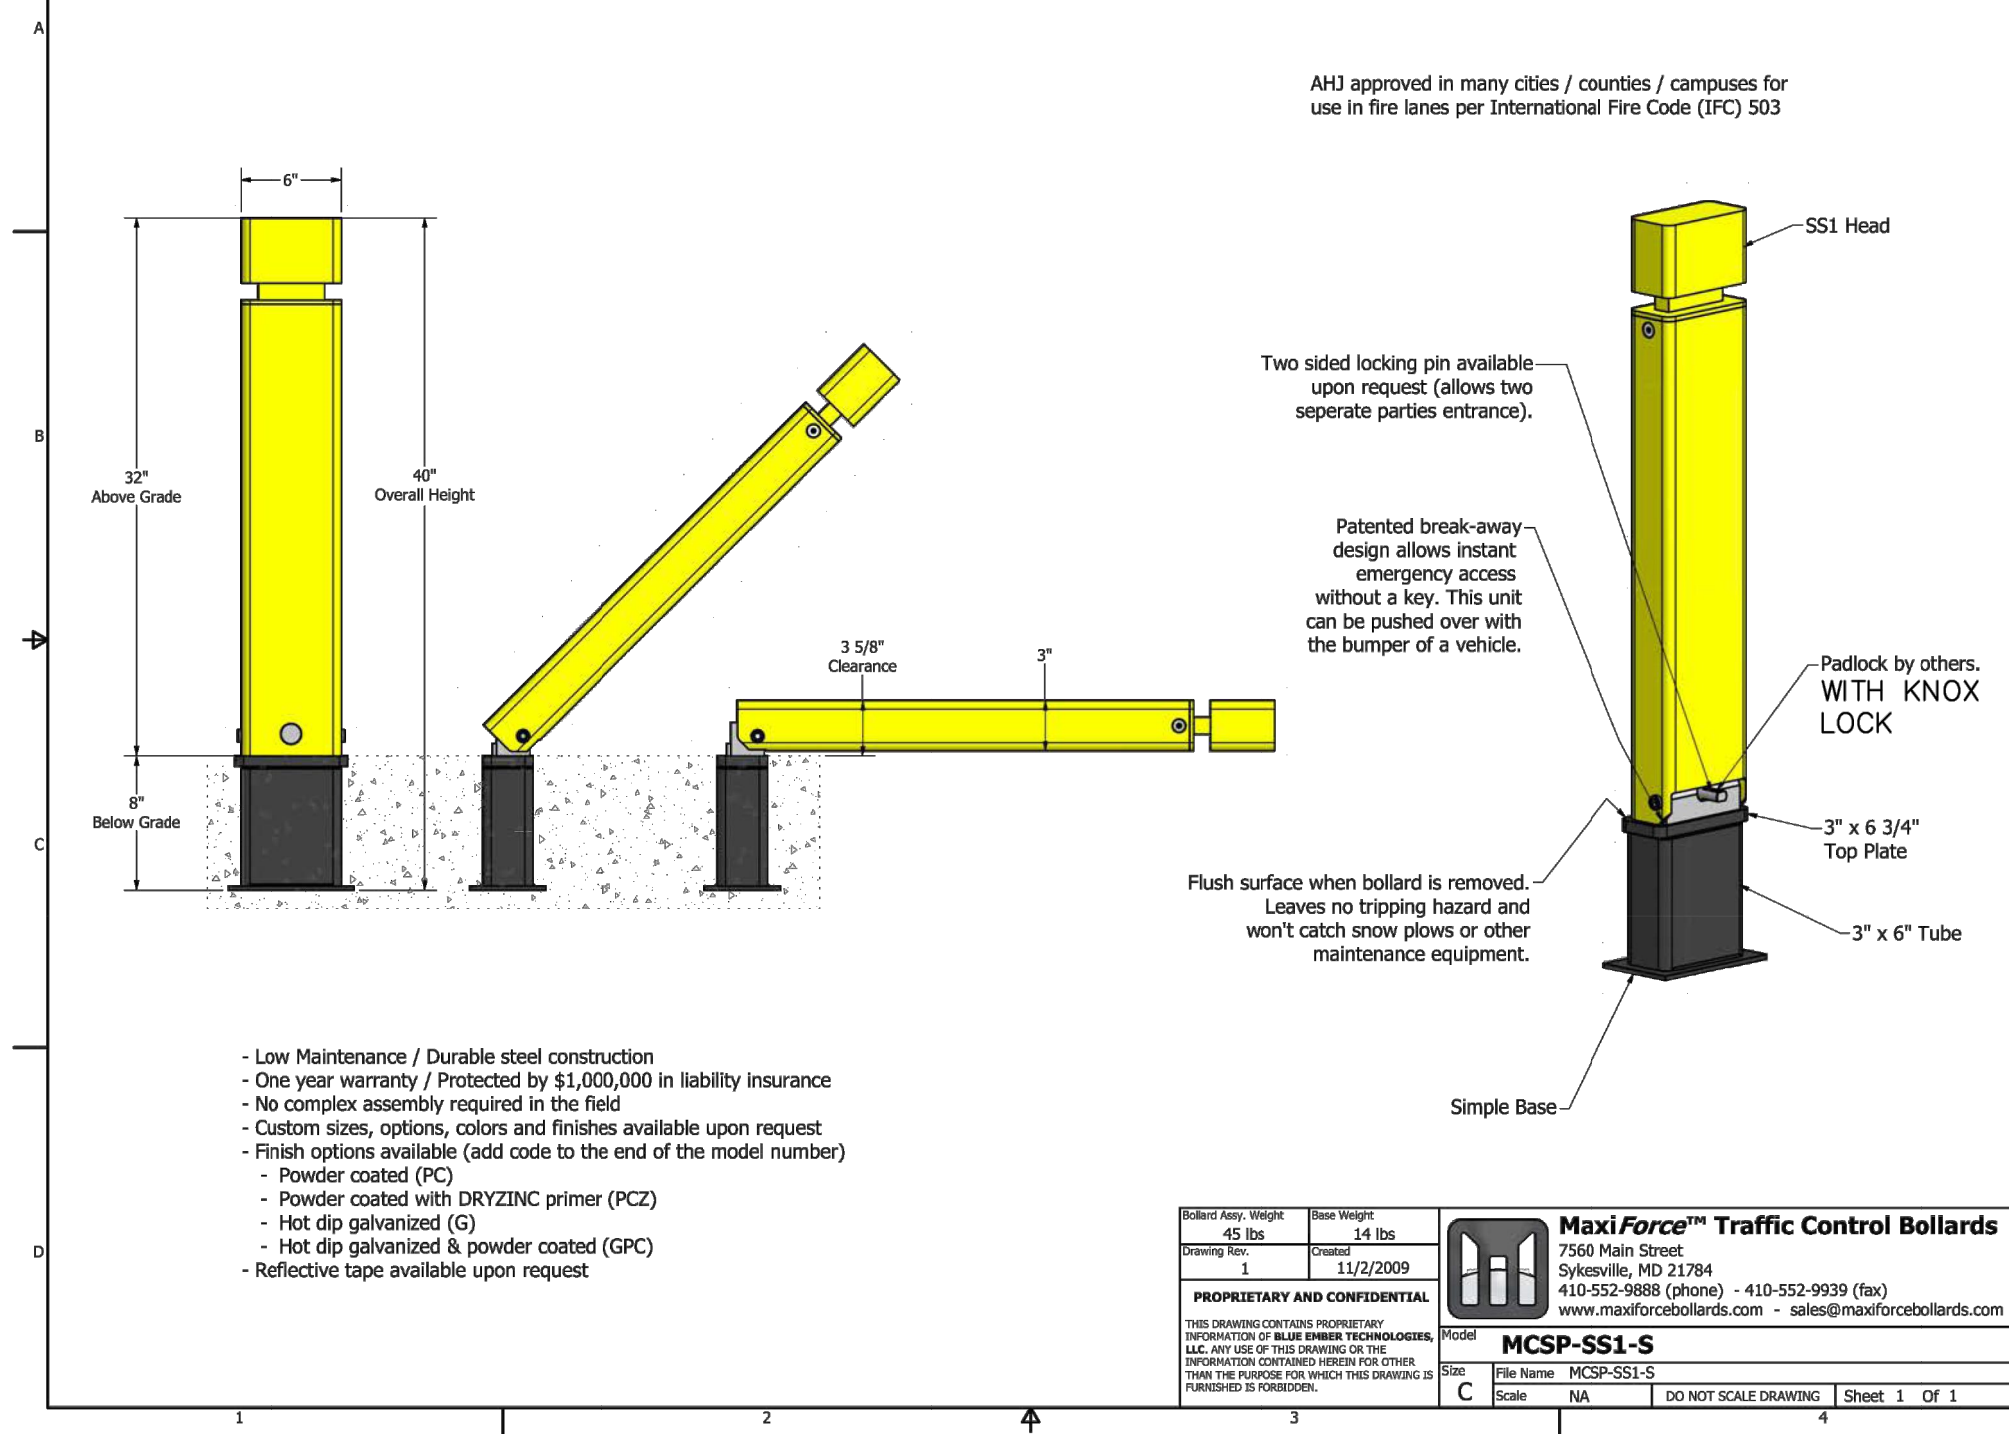

7 MAXIFORCE COLLAPSIBLE BOLLARDS WITH KNOX LOCKS

N.T.S.

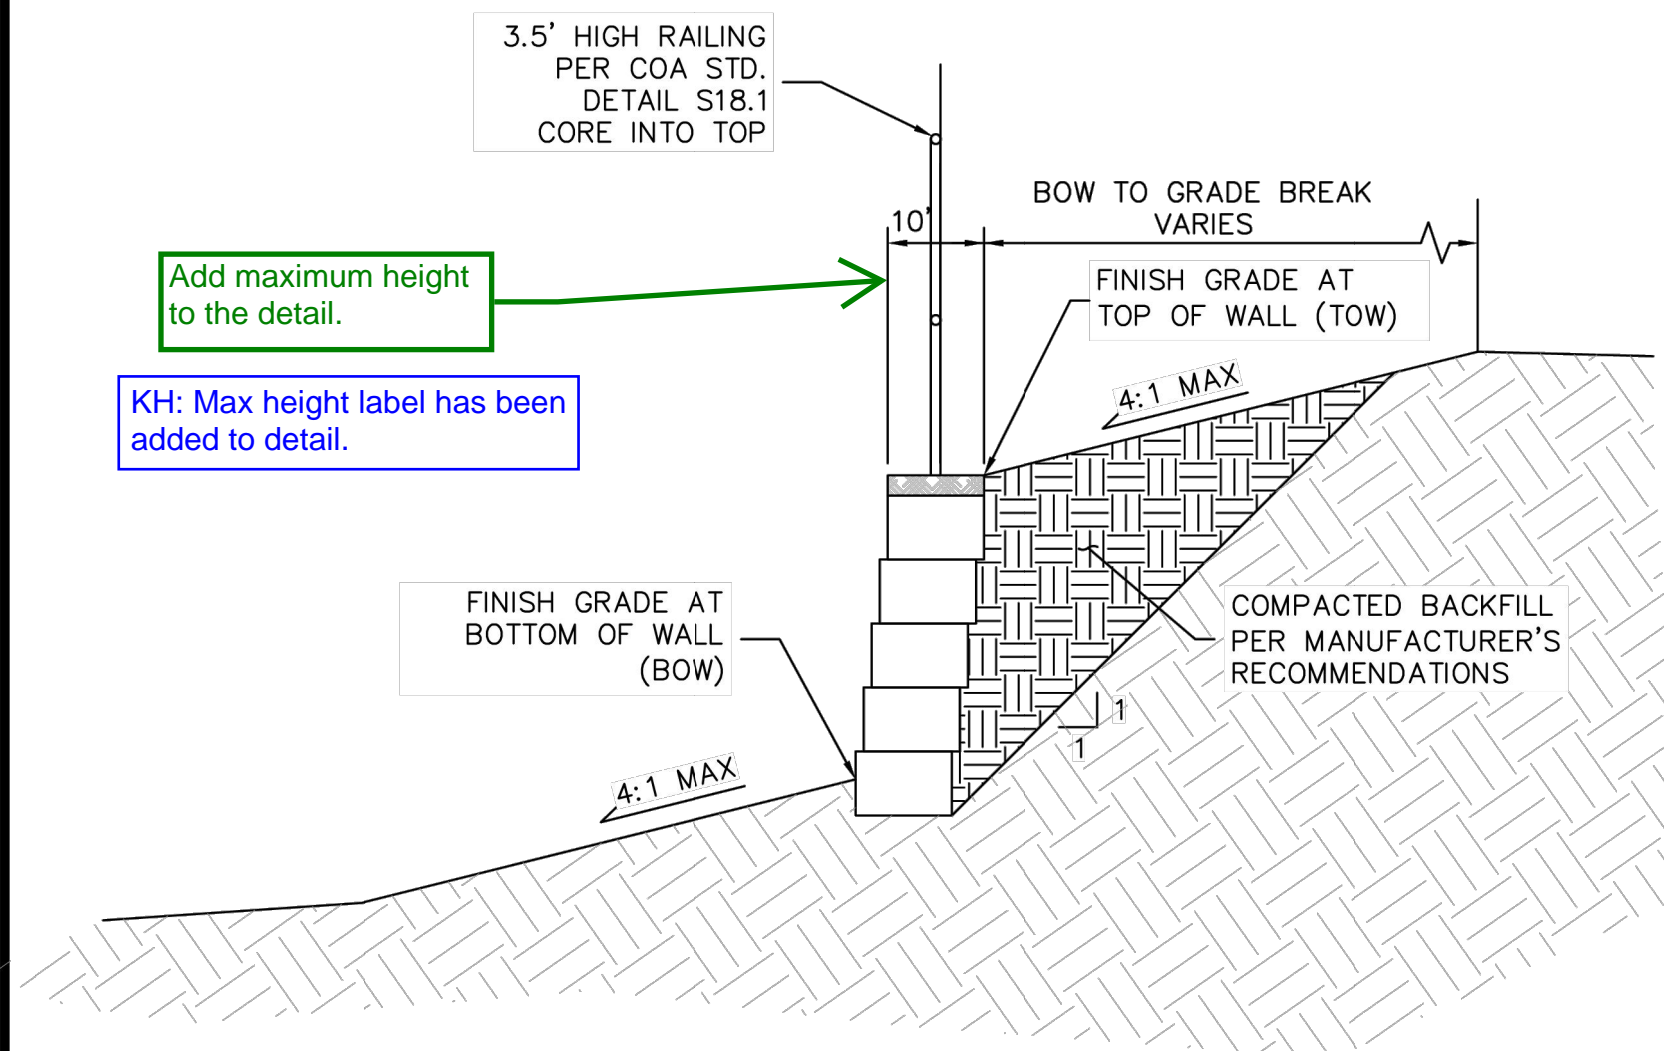

8 MSE RETAINING WALL WITH RAILING DETAIL

N.T.S.

CITY OF AURORA SITE PLAN NOTES (CONTINUED):

- ALL CROSSINGS OR ENCROACHMENTS INTO EASEMENTS AND RIGHTS-OF-WAY OWNED BY THE CITY OF AURORA ("CITY") IDENTIFIED AS BEING PRIVATELY-OWNED AND MAINTAINED HEREIN ARE ACKNOWLEDGED BY THE UNDERSIGNED AS BEING SUBJECT TO CITY'S USE AND OCCUPANCY OF SAID EASEMENTS OR RIGHTS-OF-WAY. THE UNDERSIGNED, ITS SUCCESSORS AND ASSIGNS, FURTHER AGREES TO REMOVE, REPAIR, REPLACE, RELOCATE, MODIFY, OR OTHERWISE ADJUST SAID CROSSINGS OR ENCROACHMENTS UPON REQUEST FROM THE CITY AND AT NO EXPENSE TO THE CITY. THE CITY RESERVES THE RIGHT TO MAKE FULL USE OF THE EASEMENTS AND RIGHTS-OF-WAY AS MAY BE NECESSARY OR CONVENIENT AND THE CITY RETAINS ALL RIGHTS TO OPERATE, MAINTAIN, INSTALL, REPAIR, REMOVE OR RELOCATE ANY CITY FACILITIES LOCATED WITHIN SAID EASEMENTS AND RIGHTS-OF-WAY AT ANY TIME AND IN SUCH A MANNER AS IT DEEMS NECESSARY OR CONVENIENT.
- THE APPROVAL OF THIS DOCUMENT DOES NOT CONSTITUTE FINAL APPROVAL OF GRADING, DRAINAGE, UTILITY, PUBLIC IMPROVEMENTS AND BUILDING PLANS. CONSTRUCTION PLANS MUST BE REVIEWED AND APPROVED BY THE APPROPRIATE AGENCY PRIOR TO THE ISSUANCE OF BUILDING PERMITS.
- ALL BUILDING ADDRESS NUMBERS SHALL COMPLY WITH THE AURORA CITY CODE, SECTION 126, ARTICLE VII - NUMBERING OF BUILDINGS.
- ALL ROOFTOP MECHANICAL EQUIPMENT AND VENTS GREATER THAN EIGHT (8) INCHES IN DIAMETER MUST BE SCREENED. SCREENING MAY BE DONE EITHER WITH AN EXTENDED PARAPET WALL OR A FREESTANDING SCREEN WALL. SCREENS SHALL BE AT LEAST AS HIGH AS THE EQUIPMENT THEY HIDE. IF EQUIPMENT IS VISIBLE BECAUSE SCREENS DON'T MEET THIS MINIMUM HEIGHT REQUIREMENT, THE DIRECTOR OF PLANNING MAY REQUIRE CONSTRUCTION MODIFICATIONS PRIOR TO THE ISSUANCE OF A PERMANENT CERTIFICATE OF OCCUPANCY.
- NOTWITHSTANDING ANY SURFACE IMPROVEMENTS, LANDSCAPING, PLANTING OR CHANGES SHOWN IN THESE SITE OR CONSTRUCTION PLANS, OR ACTUALLY CONSTRUCTED OR PUT IN PLACE, ALL UTILITY EASEMENTS MUST REMAIN UNOBSTRUCTED AND FULLY ACCESSIBLE ALONG THEIR ENTIRE LENGTH TO ALLOW FOR ADEQUATE MAINTENANCE EQUIPMENT. ADDITIONALLY, NO INSTALLATION, PLANTING, CHANGE IN THE SURFACE, ETC., SHALL INTERFERE WITH THE OPERATION OF THE UTILITY LINES PLACED WITHIN THE EASEMENT. BY SUBMITTING THESE SITE OR CONSTRUCTION PLANS FOR APPROVAL, THE LANDOWNER RECOGNIZES AND ACCEPTS THE TERMS, CONDITIONS AND REQUIREMENTS OF THIS NOTE.
- FINAL GRADE SHALL BE AT LEAST SIX (6) INCHES BELOW ANY EXTERIOR WOOD SIDING ON THE PREMISES.
- ALL INTERESTED PARTIES ARE HEREBY ALERTED THAT THIS SITE PLAN IS SUBJECT TO ADMINISTRATIVE CHANGES AND AS SHOWN ON THE ORIGINAL SITE PLAN ON FILE IN THE AURORA CITY PLANNING OFFICE AT THE MUNICIPAL BUILDING. A COPY OF THE OFFICIAL CURRENT PLAN MAY BE PURCHASED THERE. LIKEWISE, SITE PLANS ARE REQUIRED TO AGREE WITH THE APPROVED SUBDIVISION PLAT OF RECORD AT THE TIME OF A BUILDING PERMIT; AND IF NOT, MUST BE AMENDED TO AGREE WITH THE PLAT AS NEEDED, OR VICE VERSA.
- ERRORS IN APPROVED SITE PLANS RESULTING FROM COMPUTATIONS OR INCONSISTENCIES IN THE DRAWINGS MADE BY THE APPLICANT ARE THE RESPONSIBILITY OF THE PROPERTY OWNER OF RECORD. WHERE FOUND, THE CURRENT MINIMUM CODE REQUIREMENTS WILL APPLY AT THE TIME OF BUILDING PERMIT. PLEASE BE SURE THAT ALL PLAN COMPUTATIONS ARE CORRECT.
- ALL REPRESENTATIONS AND COMMITMENTS MADE BY APPLICANTS AND PROPERTY OWNERS AT PUBLIC HEARINGS REGARDING THIS PLAN ARE BINDING UPON THE APPLICANT, PROPERTY OWNER, AND ITS HEIRS, SUCCESSORS, AND ASSIGNS.
- ARCHITECTURAL FEATURES, SUCH AS BAY WINDOWS, FIREPLACES, ROOF OVERHANGS, GUTTERS, EAVES, FOUNDATIONS, FOOTINGS, CANTILEVERED WALLS, ETC. ARE NOT ALLOWED TO ENCROACH INTO ANY EASEMENT OR FIRE LANE.
- THE 2015 INTERNATIONAL FIRE CODE (IFC), REQUIRES ALL BUILDINGS TO BE ASSESSED FOR ADEQUATE EMERGENCY RESPONDER RADIO COVERAGE (ERRC). AT THE TIME THE STRUCTURE IS AT FINAL FRAME AND FINAL ELECTRICAL INSPECTIONS, THE GENERAL CONTRACTOR (GC) WILL BE REQUIRED TO HIRE A QUALIFIED INDEPENDENT 3RD PARTY TO ASSESS THE RADIO FREQUENCY LEVELS WITHIN THE STRUCTURE. ONCE COMPLETED, THE 3RD PARTY WILL PROVIDE THE RESULTS OF THE TEST TO BOTH THE GC AND THE AURORA BUILDING DIVISION AS TO WHETHER THE STRUCTURE PASSED OR FAILED THE PRELIMINARY RADIO SURVEILLANCE. A STRUCTURE THAT HAS PASSED THIS SURVEILLANCE REQUIRES NO FURTHER ACTION BY THE GC. A FAILED RADIO SURVEILLANCE WILL REQUIRE A LICENSED CONTRACTOR TO SUBMIT PLANS TO THE AURORA BUILDING DIVISION TO OBTAIN A BUILDING PERMIT FOR THE INSTALLATION OF AN ERRC SYSTEM PRIOR TO INSTALLATION. THIS ASSESSMENT AND INSTALLATION IS AT THE OWNER OR DEVELOPERS EXPENSE. FUTURE INTERIOR OR EXTERIOR MODIFICATIONS TO THE STRUCTURE AFTER THE ORIGINAL CERTIFICATE OF OCCUPANCY IS ISSUED WILL REQUIRE A REASSESSMENT FOR ADEQUATE RADIO FREQUENCY COVERAGE.
- IN LOCATIONS WHERE UTILITY EASEMENTS OVERLAP DRAINAGE EASEMENTS, ONLY SUBSURFACE UTILITIES SHALL BE PERMITTED WITHIN THE PORTION OF THE UTILITY EASEMENT THAT OVERLAPS THE DRAINAGE EASEMENT. INSTALLATION OF ABOVE GROUND UTILITIES WITHIN A DRAINAGE EASEMENT REQUIRES PRIOR WRITTEN APPROVAL BY CITY ENGINEER.
- THE DEVELOPER, HIS OR HER SUCCESSORS, AND ASSIGNS SHALL BE RESPONSIBLE FOR INSTALLATION, MAINTENANCE, AND REPLACEMENT OF THE ACCESS CONTROL GATE OR BARRIER SYSTEM TO ENSURE EMERGENCY VEHICLE ACCESS TO WITHIN THE SITE. IF THE ABOVE CONDITIONS ARE NOT MET, THE OWNERS, HIS OR HER SUCCESSORS, AND ASSIGNS, SHALL BE REQUIRED BY FIRE DEPARTMENT ORDER NOTICE THAT ALL AFFECTED GATES WILL BE CHAINED AND LOCKED IN THE OPEN POSITION UNTIL REPAIRED OR REPLACED, AND RETESTED. IF THE GATING SYSTEM IS NOT MAINTAINED TO THE SATISFACTION OF THE FIRE DEPARTMENT, THE LICENSE AGREEMENT FOR THE EMERGENCY VEHICLE GATE OPENING SYSTEM WILL BE REVOKED AND THE GATING SYSTEM MUST BE REMOVED. THE GATING SYSTEM WILL INCLUDE AN EMERGENCY VEHICLE GATE OPENING SYSTEM UTILIZING A REDUNDANCY BACK-UP SYSTEM THAT CONSISTS OF; A) SIREN OPERATED SYSTEM; B) AUTOMATIC KNOX KEY SWITCH; AND C) MANUAL OVERRIDE (IN THE EVENT OF SYSTEM FAILURE). GATING SYSTEMS WILL BE INSTALLED IN ACCORDANCE WITH THE "GATING SYSTEMS CROSSING FIRE APPARATUS ACCESS ROADS CHECKLIST". A SEPARATE BUILDING PERMIT THROUGH THE BUILDING DIVISION IS REQUIRED TO BE OBTAINED BY THE CONTRACTOR PRIOR TO THE INSTALLATION OF ANY GATING/BARRIER SYSTEM THAT CROSSES A DEDICATED FIRE LANE EASEMENT
- AOZI - AURORA BUILDING I, LLC. SHALL BE RESPONSIBLE FOR PAYMENT OF 25% OF THE TRAFFIC SIGNALIZATION COSTS FOR THE INTERSECTION OF 64TH AVE AND POWHATON RD, IF AND WHEN TRAFFIC SIGNAL WARRANTS ARE SATISFIED. TRAFFIC SIGNAL WARRANTS TO CONSIDER SHALL BE AS DESCRIBED IN THE MOST RECENTLY ADOPTED VERSION OF MANUAL ON UNIFORM TRAFFIC CONTROL DEVICES, AS OF THE DATE OR DATES OF ANY SUCH WARRANT STUDIES. FOR WARRANT PURPOSES, THE MINOR STREET APPROACH TRAFFIC SHALL TYPICALLY BE COMPRISED OF ALL THROUGH AND LEFT-TURN MOVEMENT AND 50% OF RIGHT TURN MOVEMENTS UNLESS OTHERWISE DETERMINED BY THE TRAFFIC ENGINEER. PURSUANT TO 124-37.5 OF CITY CODE, THE PERCENTAGE OF THE TRAFFIC SIGNALIZATION COSTS IDENTIFIED ABOVE SHALL BE PAID TO THE CITY BY THE APPLICANT/ OWNER, TO BE HELD IN ESCROW FOR SUCH PURPOSE, PRIOR TO THE ISSUANCE OF A BUILDING PERMIT FOR THE RELATED DEVELOPMENT OR AS OTHERWISE REQUIRED BY CITY CODE. THE PERCENTAGE ABOVE WILL BE APPLIED TO THE ENTIRE TRAFFIC SIGNALIZATION COST AS ESTIMATED AT THE TIME OF THE ESCROW DEPOSIT TO CALCULATE SPECIFIC DOLLAR FUNDING REQUIREMENT.

ADJUSTMENTS:

MAJOR ADJUSTMENT

- PER UDO SECTION 4.6.5 - PARKING DESIGN AND LOCATION, REQUIREMENT FOR 60% MAX OF LOT FRONTAGE TO BE SURFACE PARKING WILL BE WAIVED.

FDP ADJUSTMENT

- PER UDO SECTION 3.3.5, REQUIREMENT FOR LOADING AREAS NOT TO FACE PUBLIC ROW WILL BE WAIVED.

Kimley»Horn

KIMLEY-HORN AND ASSOCIATES, INC.
4835 South Ute Avenue, Suite 1500
Denver, Colorado 80237 (303) 228-2300

PORTEOS INDUSTRIAL AT PORTEOS
CITY OF AURORA, COUNTY OF ADAMS
SITE PLAN WITH ADJUSTMENTS
GENERAL NOTES

DATE: 5/20/2020
DESIGNED BY:
DRAWN BY:
CHECKED BY: RUP

FILE NO.
196008000GN
PROJECT NO.
196008000

SHEET NO.

3

CHANG
ES
SO
3/25/24
B30

APPR




BY

REVISION


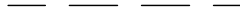






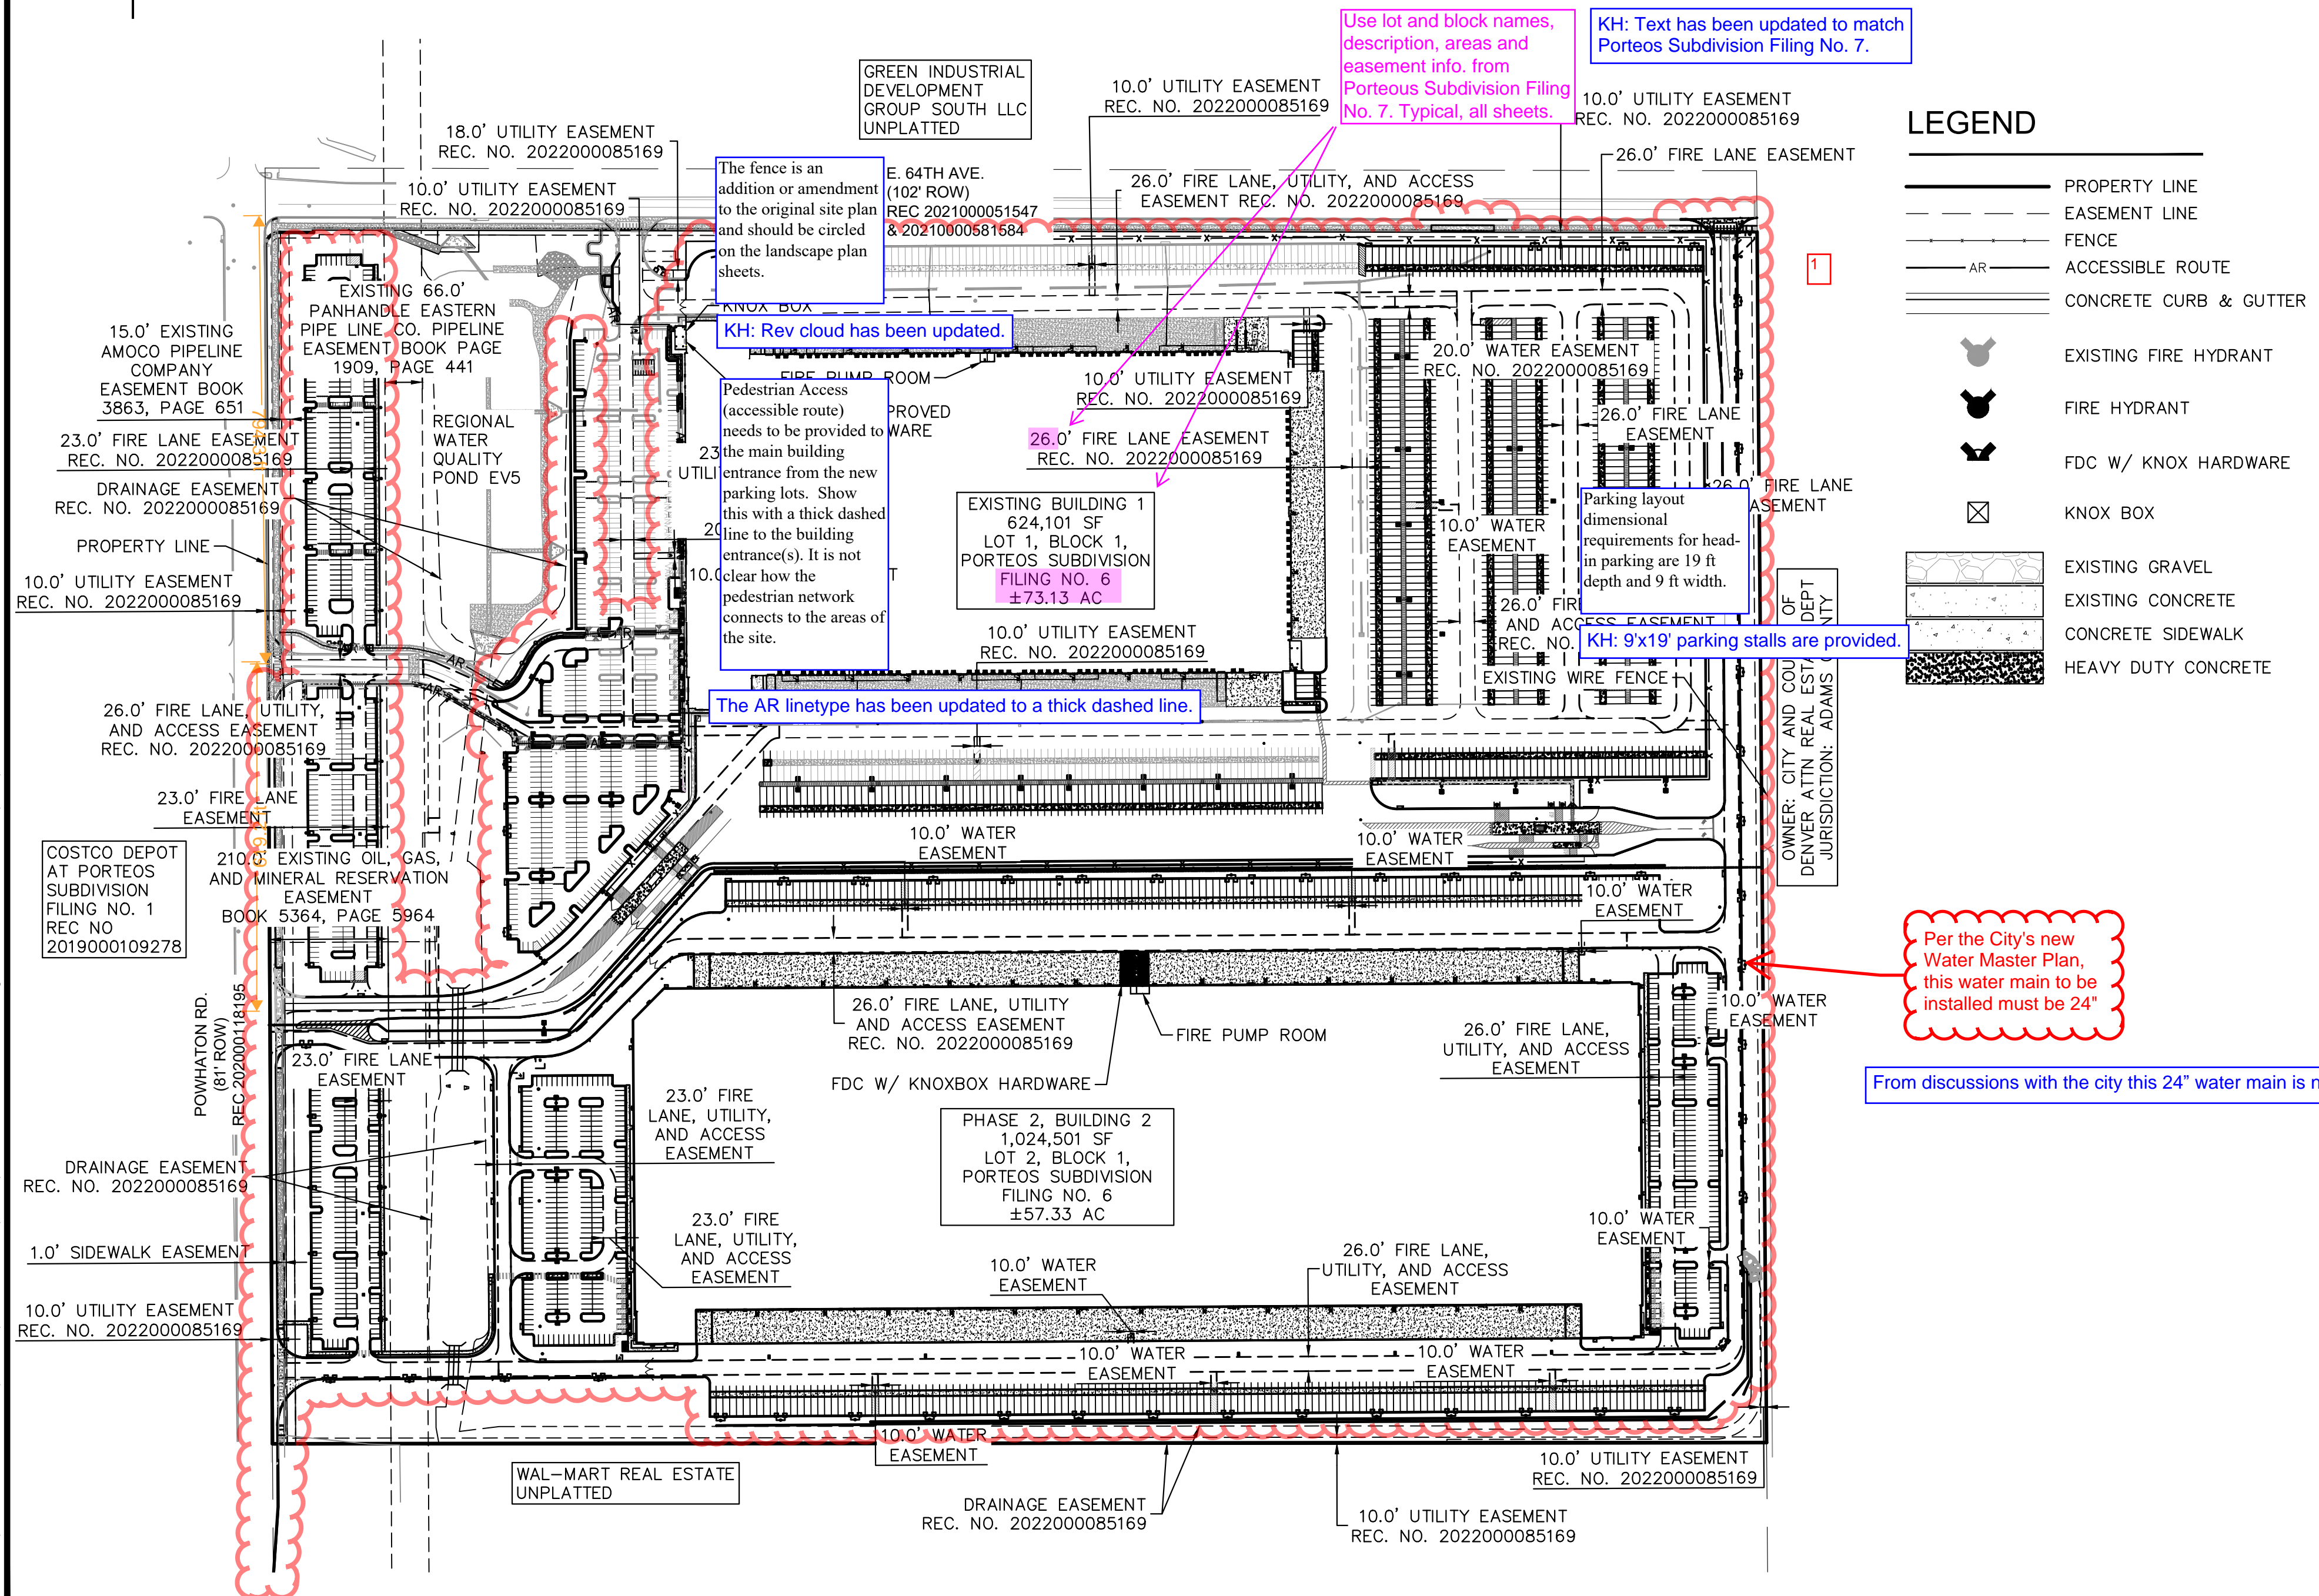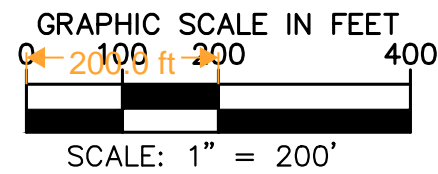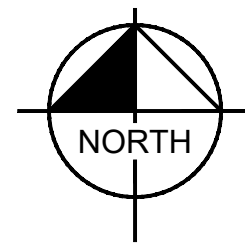




NO.

PORTEOS INDUSTRIAL AT PORTEOS SITE PLAN AMENDMENT

LOCATED IN THE NW $\frac{1}{4}$ OF SECTION 9,
TOWNSHIP 3 SOUTH, RANGE 65 WEST OF THE 6TH P.M.,
CITY OF AURORA, ADAMS COUNTY, STATE OF COLORADO



LEGEND

- | | |
|---|------------------------|
|  | PROPERTY LINE |
|  | EASEMENT LINE |
|  | FENCE |
|  | ACCESSIBLE ROUTE |
|  | CONCRETE CURB & GUTTER |
|  | EXISTING FIRE HYDRANT |
|  | FIRE HYDRANT |
|  | FDC W/ KNOX HARDWARE |
|  | KNOX BOX |
|  | EXISTING GRAVEL |
|  | EXISTING CONCRETE |
|  | CONCRETE SIDEWALK |
|  | HEAVY DUTY CONCRETE |

Per the City's new Water Master Plan, this water main to be installed must be 24"

From discussions with the city this 24" water main is no longer required.

Kimley»Horn
KIMLEY-HORN AND ASSOCIATES, INC.

LOS INDUSTRIAL AT PORTEOS

CITY OF AURORA, COUNTY OF ADAMS

SITE PLAN AMENDMENT

POR

DATE:	03/22/2024
DESIGNED BY:	CAO
DRAWN BY:	AGM
CHECKED BY:	BJC

FILE NO.
196617002 SP OV


PROJECT NO.
196617002

SHEET NO.	
-----------	--

4

<: \DEN_Civil\196617002 DIA1\CADD\PlanSheets\CSP\196617002_SP OV.dwg OKeefe, Sam 3/27/2024 8:02 AM

K:\DEN_Civil\196617002 DIA1\CADD\PlanSheets\CSP\196617002_SP DTL-DIA I.dwg OKeefe, Sam 3/27/2024 8:03 AM

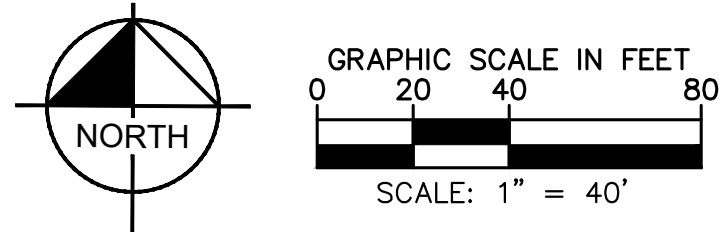


PORTEOS INDUSTRIAL AT PORTEOS SITE PLAN AMENDMENT

LOCATED IN THE NW $\frac{1}{4}$ OF SECTION 9,
TOWNSHIP 3 SOUTH, RANGE 65 WEST OF THE 6TH P.M.,
CITY OF AURORA, ADAMS COUNTY, STATE OF COLORADO

Use lot and block names,
description, areas and
easement info. from Porteous
Subdivision Filing No. 7.
Typical, all sheets.

KH: Text has been updated to match
Porteous Subdivision Filing No. 7.

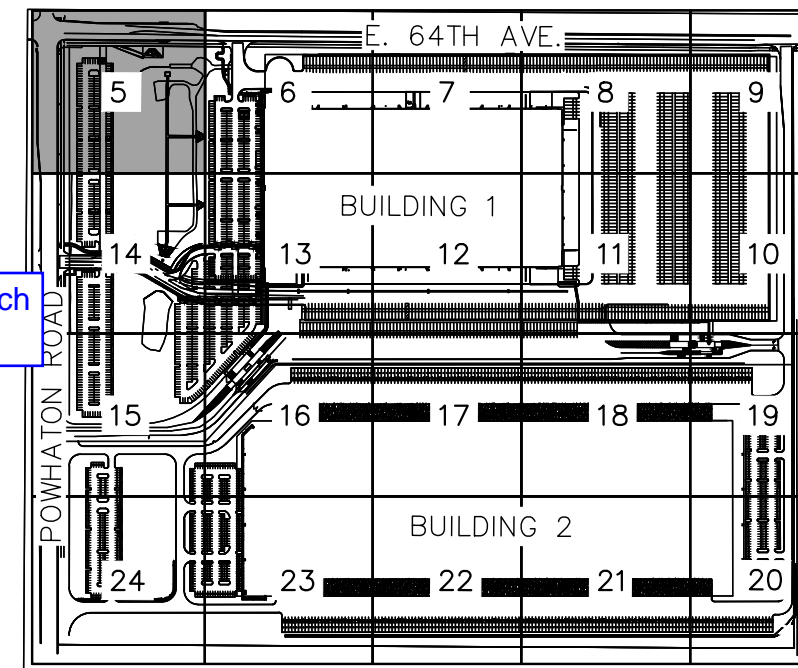

LEGEND


	PROPERTY LINE
	EASEMENT LINE
	STEEL SECURITY FENCE
	ACCESSIBLE ROUTE
	CONCRETE CURB & GUTTER
	PARKING COUNT
	PAINT STRIPING
	EXISTING GRAVEL
	EXISTING CONCRETE
	CONCRETE SIDEWALK
	HEAVY DUTY CONCRETE
	LIGHT DUTY ASPHALT
	HEAVY DUTY ASPHALT

SITE PLAN KEYNOTES

- 1 ACCESSIBLE PARKING SPACES W/ ACCESSIBLE PARKING SIGN
- 2 VAN ACCESSIBLE PARKING SPACES W/ VAN ACCESSIBLE PARKING SIGN
- 3 ACCESSIBLE CURB RAMP W/ DETECTIBLE WARNING
- 4 STOP SIGN
- 5 PEDESTRIAN CROSSWALK
- 6 SIGHT LIGHTING
- 7 STAIRS & BUILDING EGRESS DOOR
- 8 "NO PARKING FIRE LANE" SIGN
- 9 BOLLARD
- 10 BUILDING INGRESS/ENGRESS DOOR
- 11 BUILDING EGRESS DOOR
- 12 STORM INLET
- 13 STORM MANHOLE
- 14 FIRE HYDRANT, ASSEMBLY PER COA STD. DETAIL 208
- 15 FIRE HYDRANT W/ BOLLARDS, ASSEMBLY PER COA STD. DETAIL 208
- 16 SPEED BUMP
- 17 FIRE LANE SIGN

SITE PLAN NOTES

1. ALL RADII AREA 3' AND MEASURED FROM FACE OF CURB UNLESS STATED OTHERWISE.

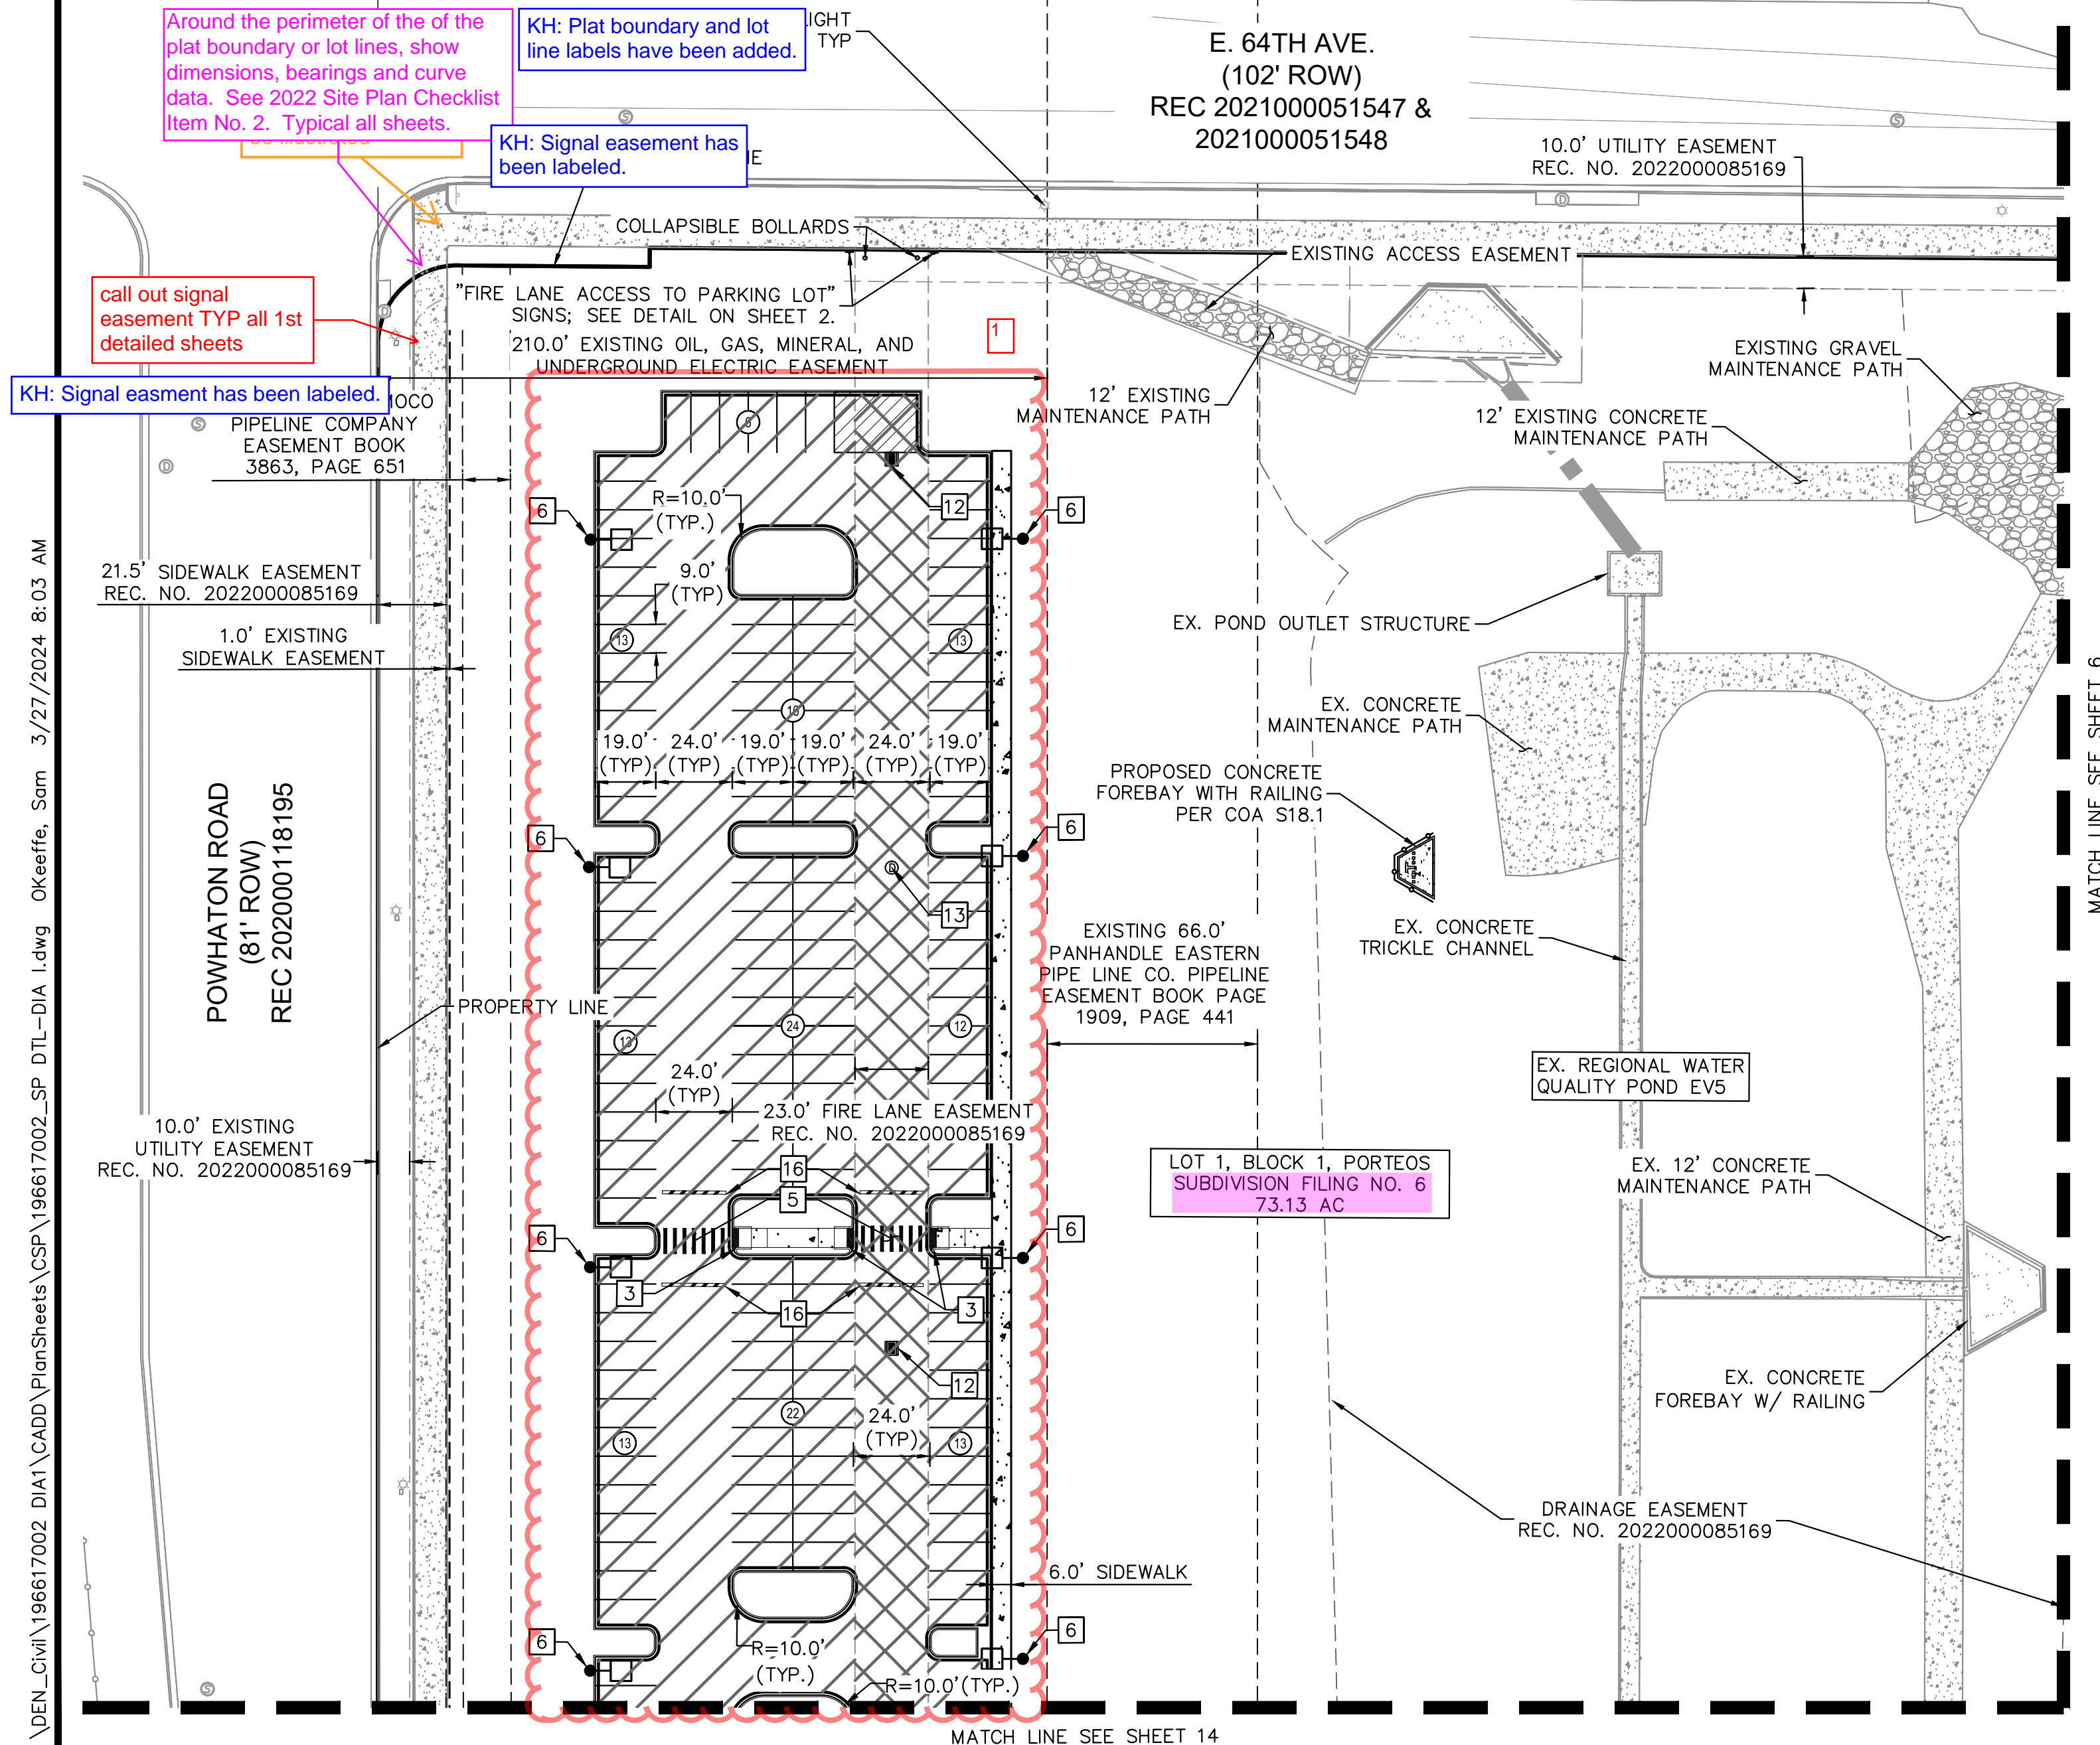

Kimley»Horn
KIMLEY-HORN AND ASSOCIATES, INC.
6205 S. WILLOW
Greenwood Village, CO 80111 (303) 228-2300


PORTEOS INDUSTRIAL AT PORTEOS
CITY OF AURORA, COUNTY OF ADAMS
SITE PLAN AMENDMENT
DETAILED SITE PLAN

DATE: 03/22/2024
DESIGNED BY: CAO
DRAWN BY: AGM
CHECKED BY: BUC

FILE NO.
196617002_SP DTL-DIA I
PROJECT NO.
196617002

SHEET NO.

K:\DEN_Civil\196617002 DIA1\CADD\PlanSheets\CSP\196617002_SP DTL-DIA I.dwg Mavis, August 3/27/2024 12:03 PM

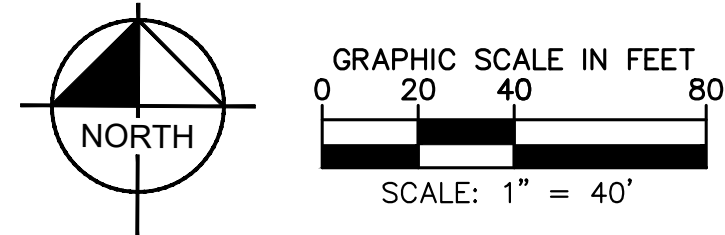


PORTEOS INDUSTRIAL AT PORTEOS

SITE PLAN AMENDMENT

LOCATED IN THE NW ¼ OF SECTION 9,
TOWNSHIP 3 SOUTH, RANGE 65 WEST OF THE 6TH P.M.,
CITY OF AURORA, ADAMS COUNTY, STATE OF COLORADO

Use lot and block names,
description, areas and
easement info. from
Porteos Subdivision Filing
No. 7. Typical, all sheets.

KH: Text has been updated to match
Porteos Subdivision Filing No. 7.

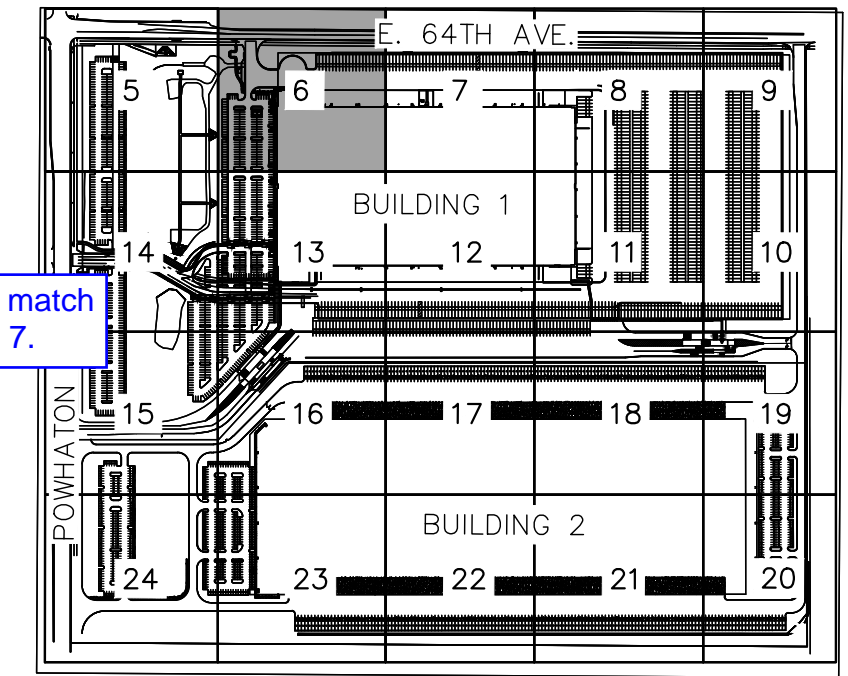

KEYMAP
NTS

LEGEND


- PROPERTY LINE
- EASEMENT LINE
- STEEL SECURITY FENCE
- ACCESSIBLE ROUTE
- CONCRETE CURB & GUTTER
- PAVEMENT SAWCUT LINE
- PARKING COUNT
- PAINT STRIPING
- EXISTING GRAVEL
- EXISTING CONCRETE
- CONCRETE SIDEWALK
- HEAVY DUTY CONCRETE
- LIGHT DUTY ASPHALT
- HEAVY DUTY ASPHALT

SITE PLAN KEYNOTES

- ACCESSIBLE PARKING SPACES W/ ACCESSIBLE PARKING SIGN
- VAN ACCESSIBLE PARKING SPACES W/ VAN ACCESSIBLE PARKING SIGN
- ACCESSIBLE CURB RAMP W/ DETECTIBLE WARNING
- STOP SIGN
- PEDESTRIAN CROSSWALK
- SIGHT LIGHTING
- STAIRS & BUILDING EGRESS DOOR
- "NO PARKING FIRE LANE" SIGN
- BOLLARD
- BUILDING INGRESS/ENGRESS DOOR
- BUILDING EGRESS DOOR
- STORM INLET
- STORM MANHOLE
- FIRE HYDRANT, ASSEMBLY PER COA STD. DETAIL 208
- FIRE HYDRANT W/ BOLLARDS, ASSEMBLY PER COA STD. DETAIL 208
- SPEED BUMP
- FIRE LANE SIGN

SITE PLAN NOTES

- ALL RADII AREA 3' AND MEASURED FROM FACE OF CURB UNLESS STATED OTHERWISE.

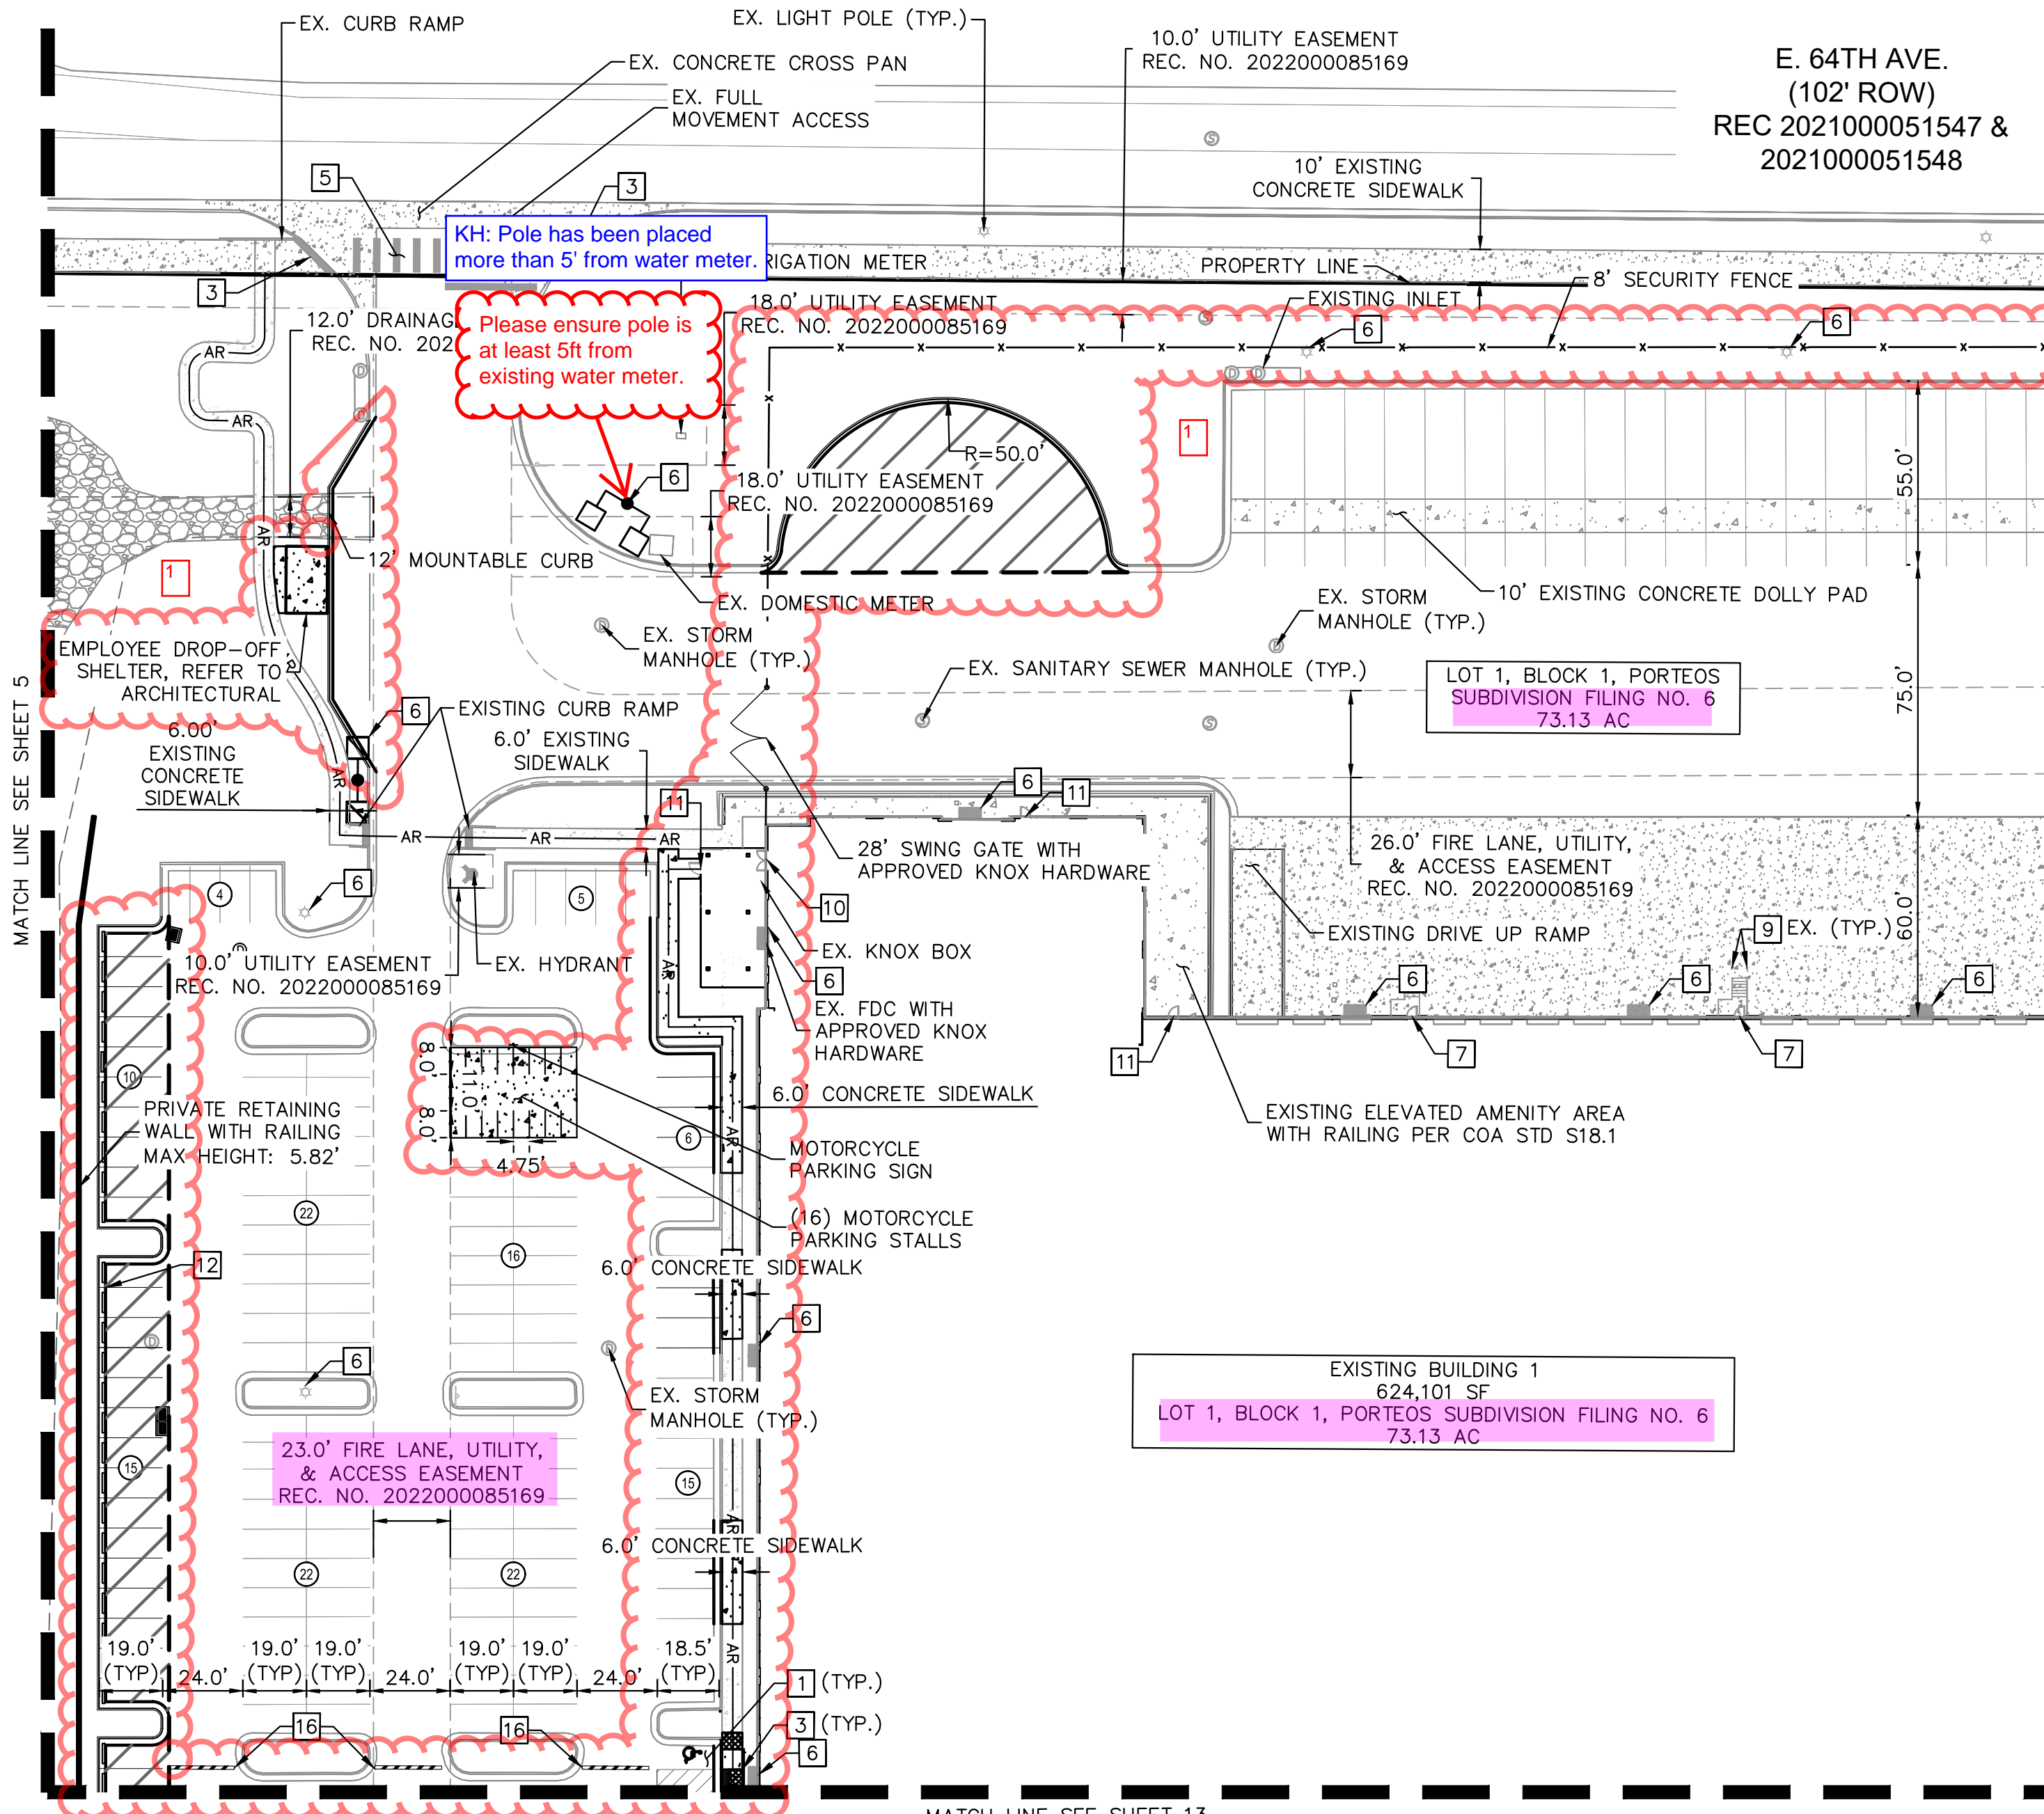

Kimley»Horn


PORTEOS INDUSTRIAL AT PORTEOS
CITY OF AURORA, COUNTY OF ADAMS
SITE PLAN AMENDMENT
DETAILED SITE PLAN

DATE: 03/22/2024
DESIGNED BY: CAO
DRAWN BY: AGM
CHECKED BY: BUC

FILE NO.
196617002_SP DTL-DIA I
PROJECT NO.
196617002

SHEET NO.

K:\DEN_Civil\196617002 DIA1\CADD\PlanSheets\CSP\196617002_SP DTL-DIA I.dwg Mavis, August 3/27/2024 12:03 PM

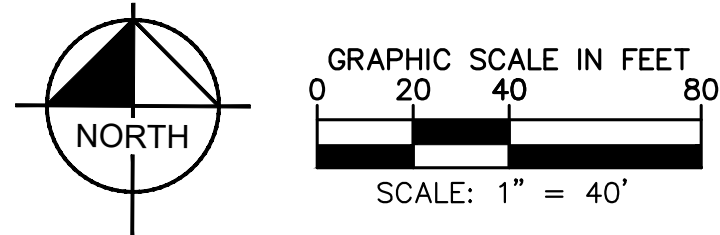


PORTEOS INDUSTRIAL AT PORTEOS SITE PLAN AMENDMENT

LOCATED IN THE NW $\frac{1}{4}$ OF SECTION 9,
TOWNSHIP 3 SOUTH, RANGE 65 WEST OF THE 6TH P.M.,
CITY OF AURORA, ADAMS COUNTY, STATE OF COLORADO

Use lot and block names,
description, areas and easement
info. from Porteos Subdivision
Filing No. 7. Typical, all sheets,
though not noted after this sheet.

KH: Text has been updated to match
Porteos Subdivision Filing No. 7.

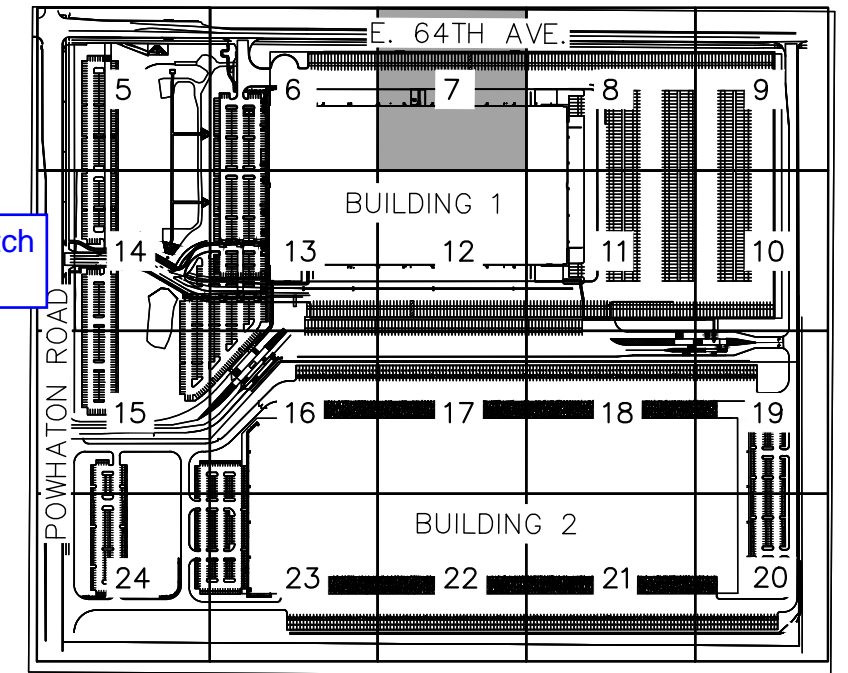

KEYMAP
NTS

LEGEND

	PROPERTY LINE
	EASEMENT LINE
	STEEL SECURITY FENCE
	ACCESSIBLE ROUTE
	CONCRETE CURB & GUTTER
	PAVEMENT SAWCUT LINE
	PARKING COUNT
	PAINT STRIPING
	EXISTING GRAVEL
	EXISTING CONCRETE
	CONCRETE SIDEWALK
	HEAVY DUTY CONCRETE
	LIGHT DUTY ASPHALT
	HEAVY DUTY ASPHALT

SITE PLAN KEYNOTES

- 1 ACCESSIBLE PARKING SPACES W/ ACCESSIBLE PARKING SIGN
- 2 VAN ACCESSIBLE PARKING SPACES W/ VAN ACCESSIBLE PARKING SIGN
- 3 ACCESSIBLE CURB RAMP W/ DETECTIBLE WARNING
- 4 STOP SIGN
- 5 PEDESTRIAN CROSSWALK
- 6 SIGHT LIGHTING
- 7 STAIRS & BUILDING EGRESS DOOR
- 8 "NO PARKING FIRE LANE" SIGN
- 9 BOLLARD
- 10 BUILDING INGRESS/ENGRESS DOOR
- 11 BUILDING EGRESS DOOR
- 12 STORM INLET
- 13 STORM MANHOLE
- 14 FIRE HYDRANT, ASSEMBLY PER COA STD. DETAIL 208
- 15 FIRE HYDRANT W/ BOLLARDS, ASSEMBLY PER COA STD. DETAIL 208
- 16 SPEED BUMP
- 17 FIRE LANE SIGN

SITE PLAN NOTES

1. ALL RADII AREA 3' AND MEASURED FROM FACE OF CURB UNLESS STATED OTHERWISE.

Kimley»Horn
KIMLEY-HORN AND ASSOCIATES, INC.
6205 S. HARRISON AVE.
GREENWOOD VILLAGE, CO 80111 (303) 228-2300

PORTEOS INDUSTRIAL AT PORTEOS
CITY OF AURORA, COUNTY OF ADAMS
SITE PLAN AMENDMENT
DETAILED SITE PLAN


DATE: 03/22/2024
DESIGNED BY: CAO
DRAWN BY: AGM
CHECKED BY: BJC

FILE NO.
196617002_SP DTL-DIA I
PROJECT NO.
196617002

SHEET NO.

7

k:\DEN_Civil\196617002 DIA1\CADD\PlanSheets\CSP\196617002_SP DTL-DIA I.dwg OKeefe, Sam 3/27/2024 8:05 AM

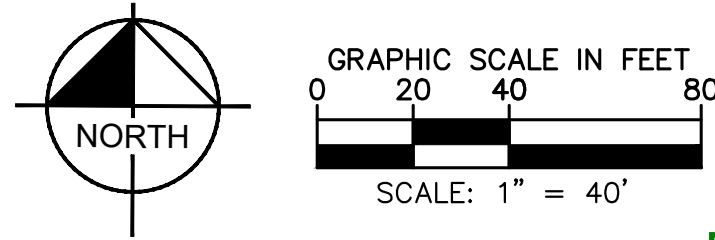


This sheet is an added sheet from the approved set. Please bubbled the entire page including the title block.

KH: Rev cloud has been updated to the entire page.


PORTEOS INDUSTRIAL AT PORTEOS SITE PLAN AMENDMENT

LOCATED IN THE NW $\frac{1}{4}$ OF SECTION 9,
TOWNSHIP 3 SOUTH, RANGE 65 WEST OF THE 6TH P.M.,
CITY OF AURORA, ADAMS COUNTY, STATE OF COLORADO

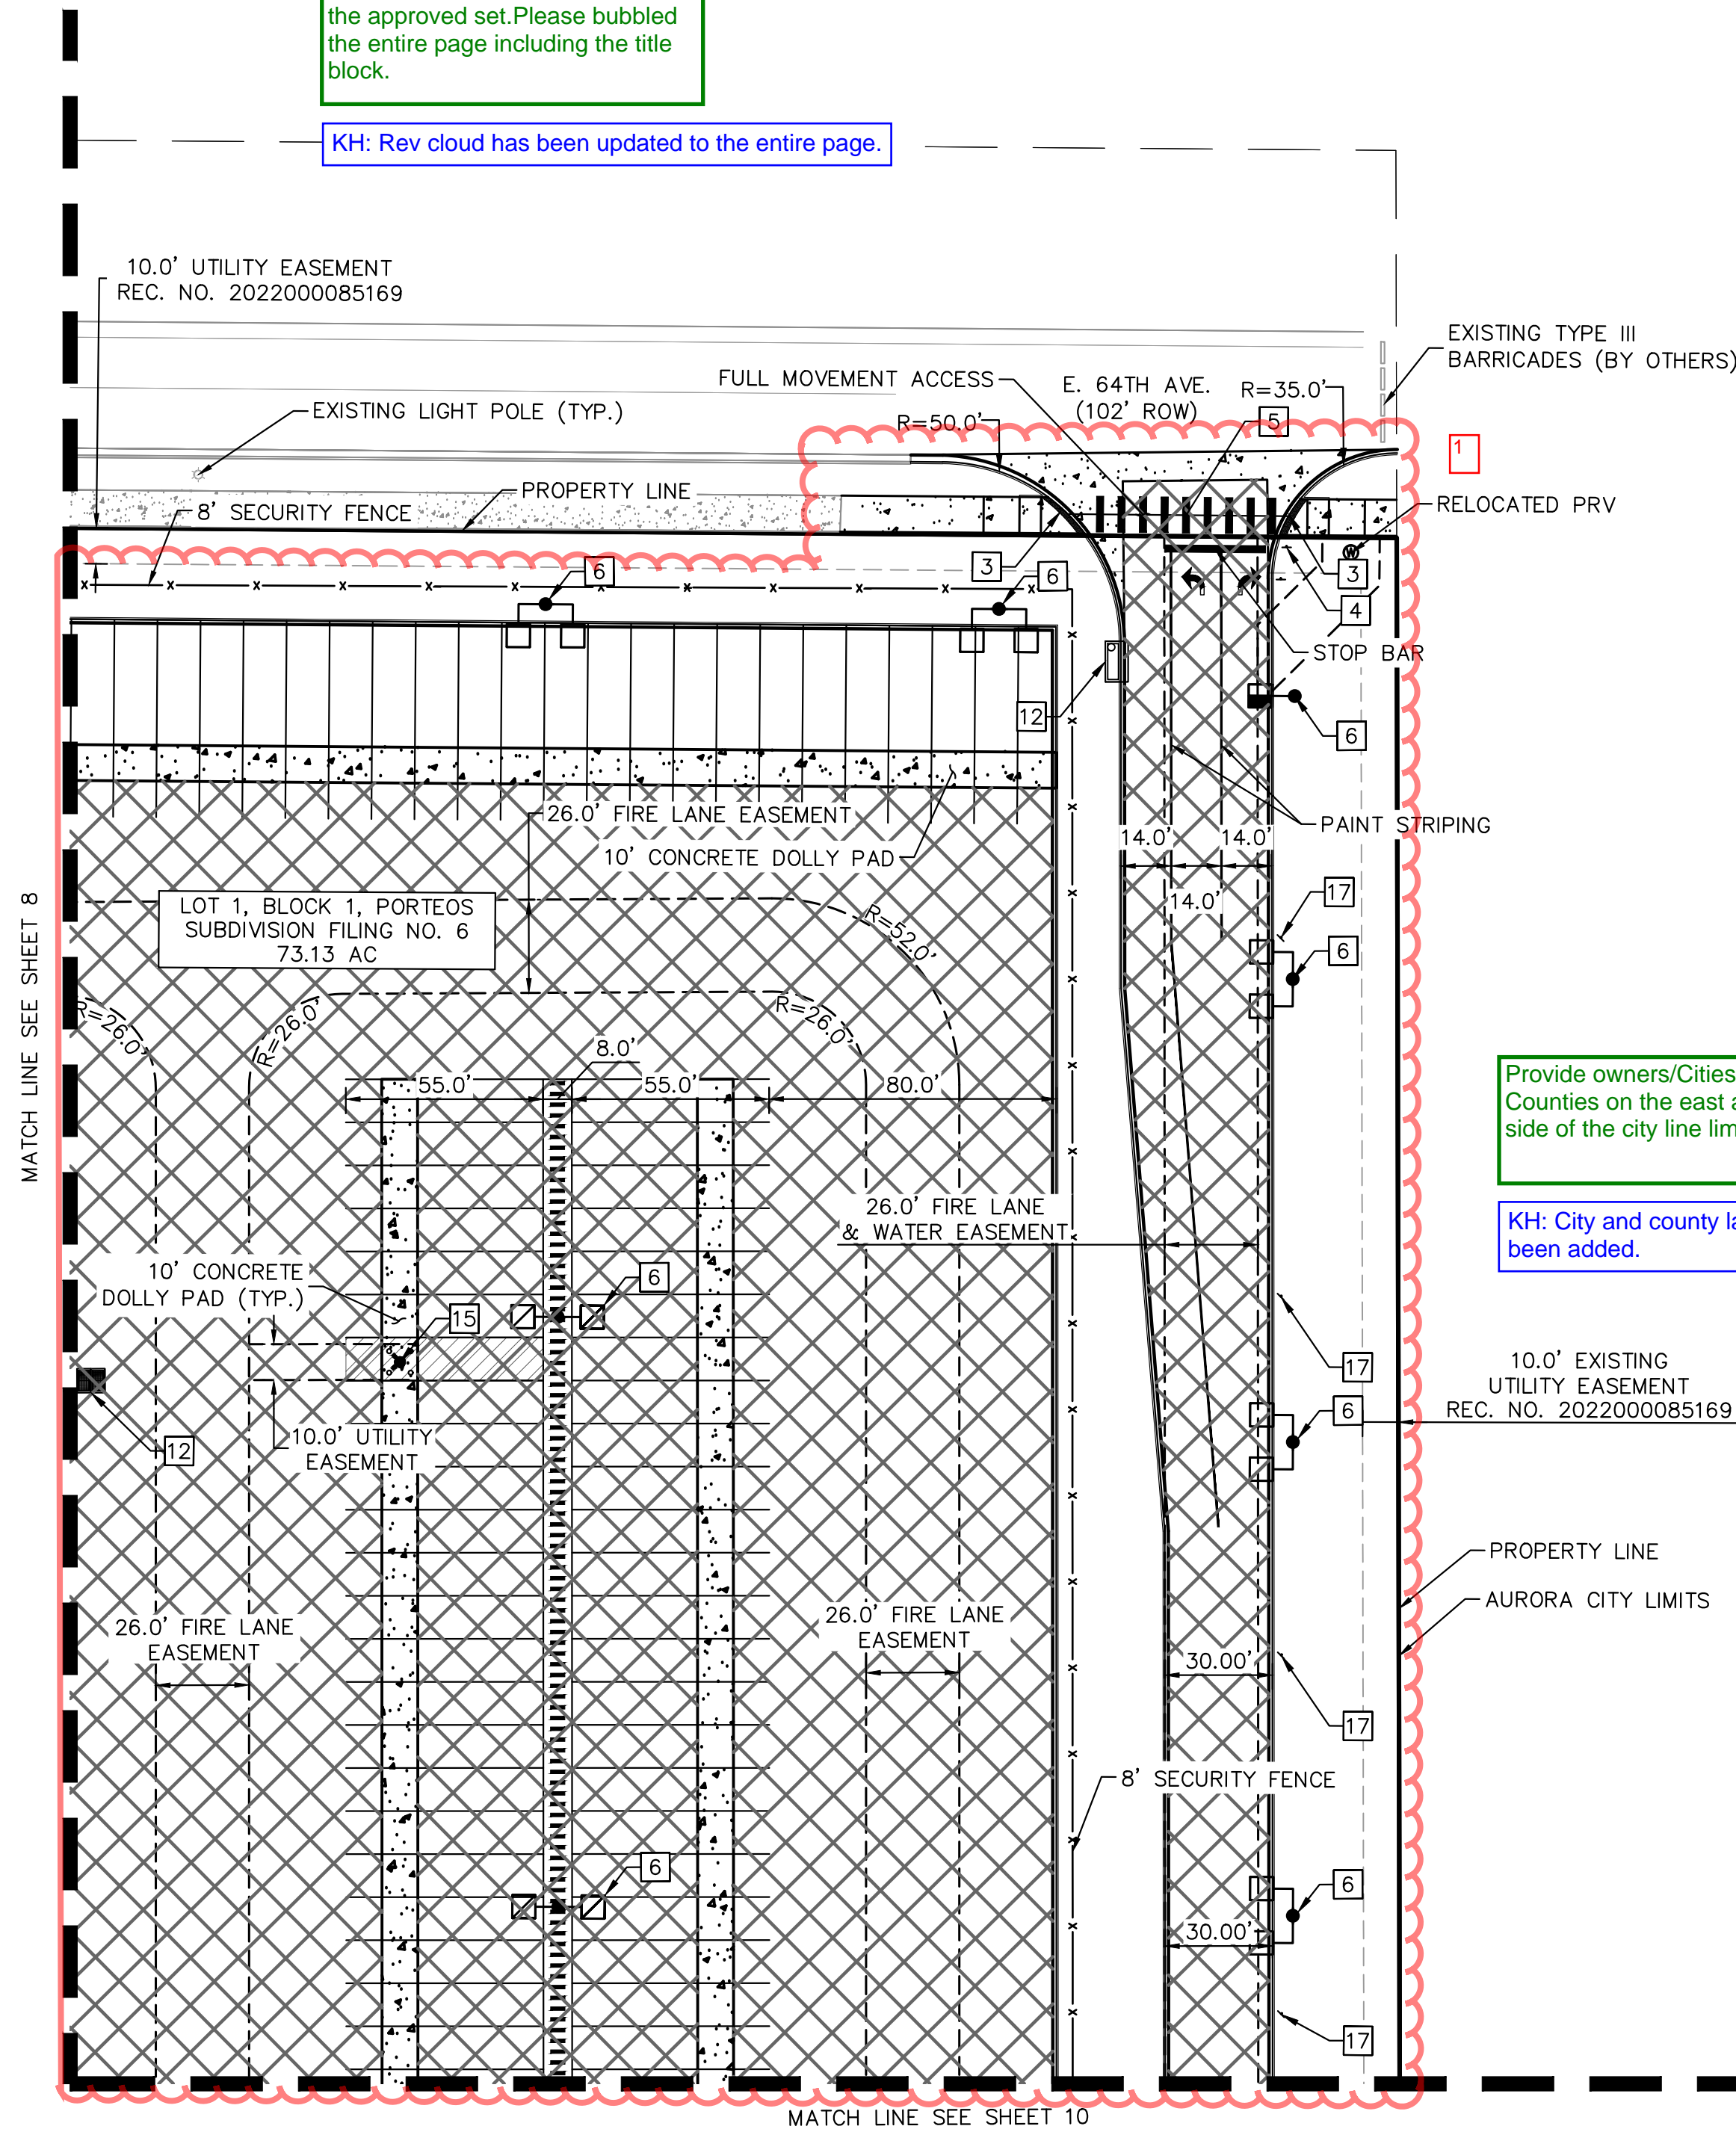

Provide owners/Cities and Counties on the east and west side of the city line limits.

KH: City and county labels have been added.

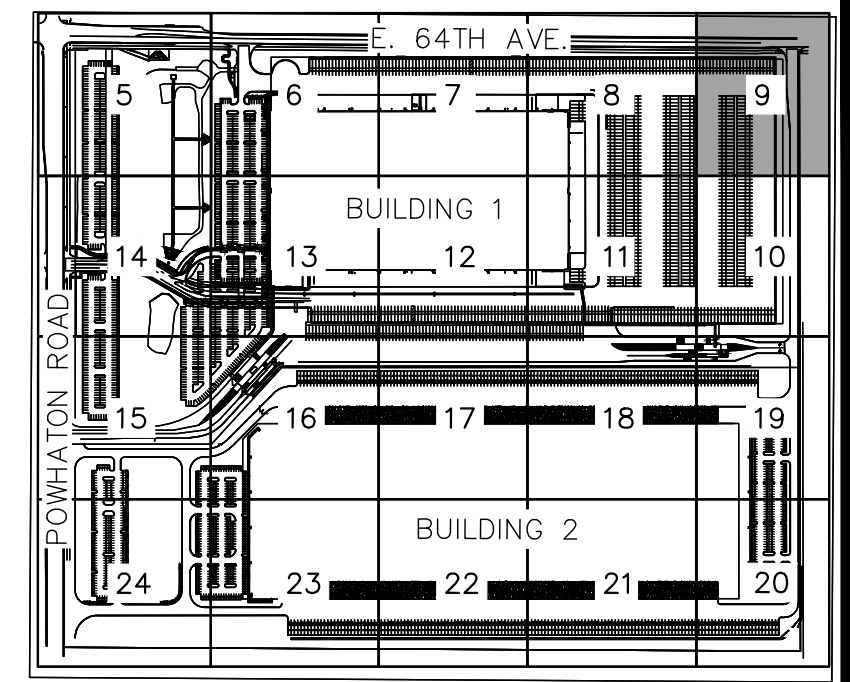

KEYMAP
NTS

LEGEND

- PROPERTY LINE
- EASEMENT LINE
- STEEL SECURITY FENCE
- ACCESSIBLE ROUTE
- CONCRETE CURB & GUTTER
- PARKING COUNT
- PAINT STRIPING
- EXISTING GRAVEL
- EXISTING CONCRETE
- CONCRETE SIDEWALK
- HEAVY DUTY CONCRETE
- LIGHT DUTY ASPHALT
- HEAVY DUTY ASPHALT

SITE PLAN KEYNOTES


- ACCESSIBLE PARKING SPACES W/ ACCESSIBLE PARKING SIGN
- VAN ACCESSIBLE PARKING SPACES W/ VAN ACCESSIBLE PARKING SIGN
- ACCESSIBLE CURB RAMP W/ DETECTIBLE WARNING
- STOP SIGN
- PEDESTRIAN CROSSWALK
- SIGHT LIGHTING
- STAIRS & BUILDING EGRESS DOOR
- "NO PARKING FIRE LANE" SIGN
- BOLLARD
- BUILDING INGRESS/ENGRESS DOOR
- BUILDING EGRESS DOOR
- STORM INLET
- STORM MANHOLE
- FIRE HYDRANT, ASSEMBLY PER COA STD. DETAIL 208
- FIRE HYDRANT W/ BOLLARDS, ASSEMBLY PER COA STD. DETAIL 208
- SPEED BUMP
- FIRE LANE SIGN

SITE PLAN NOTES

- ALL RADII AREA 3' AND MEASURED FROM FACE OF CURB UNLESS STATED OTHERWISE.



CHANG F6 SO 3/25/24 B30	
FILE NO. 196617002_SP DTL-DIA I	DATE: 03/22/2024
PROJECT NO. 196617002	DESIGNED BY: CAO
SHEET NO. 9	DRAWN BY: AGM
	CHECKED BY: BJC
PORTEOS INDUSTRIAL AT PORTEOS CITY OF AURORA, COUNTY OF ADAMS SITE PLAN AMENDMENT DETAILED SITE PLAN	
KIMLEY-HORN AND ASSOCIATES, INC. 6205 S. W. 11th Ave., Suite 200 Greenwood Village, CO 80111 (303) 228-2300	
NO.	REVISION
BY	DATE
APPR	

K:\DEN_Civil\196617002 DIA1\CADD\PlanSheets\CSP\196617002_SP DTL-DIA 1.dwg OKeefe, Sam 3/27/2024 8:06 AM

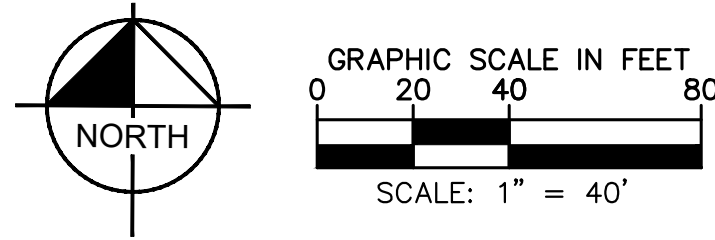

PORTEOS INDUSTRIAL AT PORTEOS SITE PLAN AMENDMENT

LOCATED IN THE NW $\frac{1}{4}$ OF SECTION 9,
TOWNSHIP 3 SOUTH, RANGE 65 WEST OF THE 6TH P.M.,
CITY OF AURORA, ADAMS COUNTY, STATE OF COLORADO

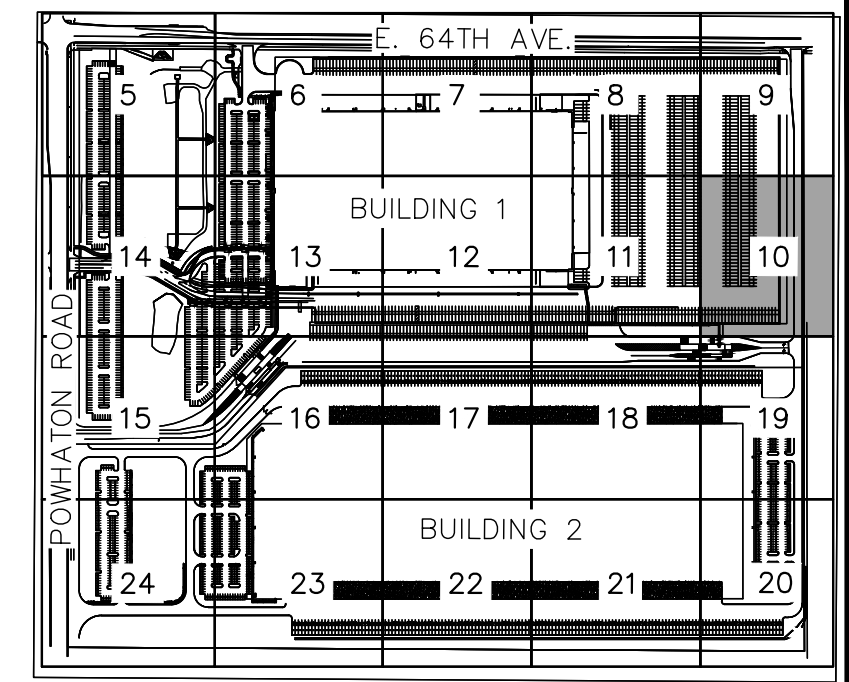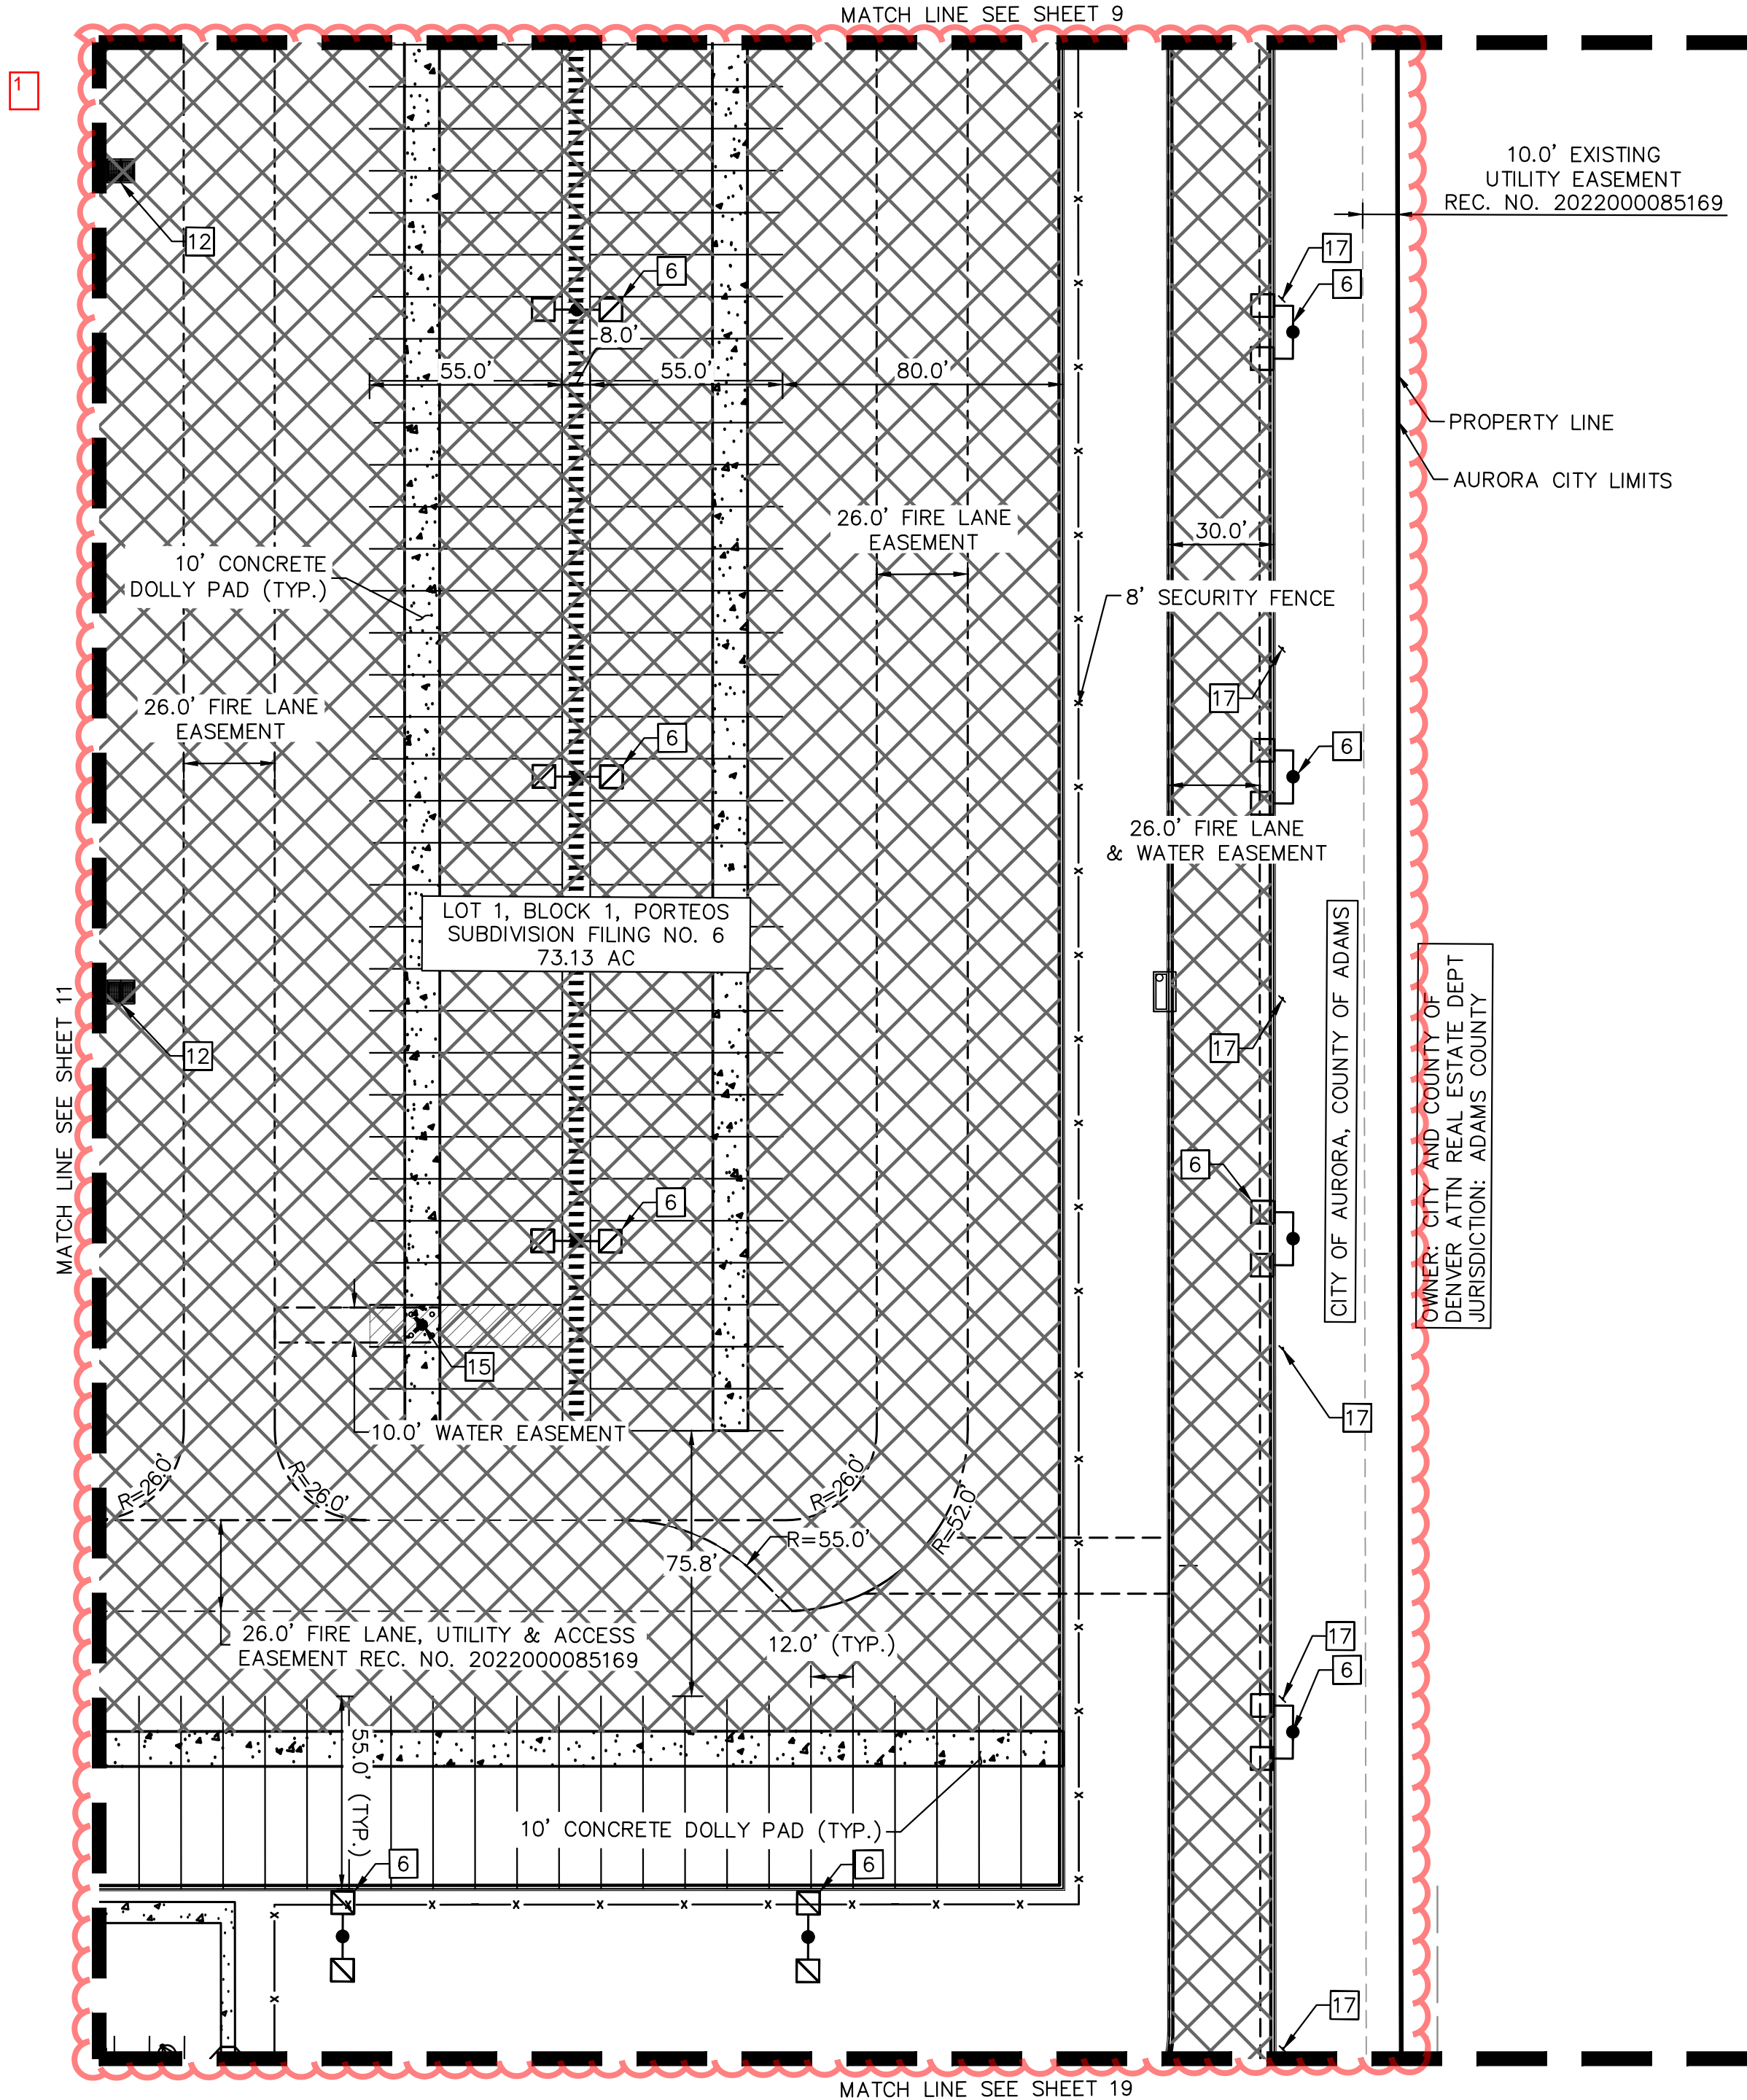

KEYMAP
NTS

LEGEND

	PROPERTY LINE
	EASEMENT LINE
	STEEL SECURITY FENCE
	ACCESSIBLE ROUTE
	CONCRETE CURB & GUTTER
	PARKING COUNT
	PAINT STRIPING
	EXISTING GRAVEL
	EXISTING CONCRETE
	CONCRETE SIDEWALK
	HEAVY DUTY CONCRETE
	LIGHT DUTY ASPHALT
	HEAVY DUTY ASPHALT

SITE PLAN KEYNOTES

- 1 ACCESSIBLE PARKING SPACES W/ ACCESSIBLE PARKING SIGN
- 2 VAN ACCESSIBLE PARKING SPACES W/ VAN ACCESSIBLE PARKING SIGN
- 3 ACCESSIBLE CURB RAMP W/ DETECTIBLE WARNING
- 4 STOP SIGN
- 5 PEDESTRIAN CROSSWALK
- 6 SIGHT LIGHTING
- 7 STAIRS & BUILDING EGRESS DOOR
- 8 "NO PARKING FIRE LANE" SIGN
- 9 BOLLARD
- 10 BUILDING INGRESS/ENGRESS DOOR
- 11 BUILDING EGRESS DOOR
- 12 STORM INLET
- 13 STORM MANHOLE
- 14 FIRE HYDRANT, ASSEMBLY PER COA STD. DETAIL 208
- 15 FIRE HYDRANT W/ BOLLARDS, ASSEMBLY PER COA STD. DETAIL 208
- 16 SPEED BUMP
- 17 FIRE LANE SIGN

SITE PLAN NOTES

1. ALL RADII AREA 3' AND MEASURED FROM FACE OF CURB UNLESS STATED OTHERWISE.

Kimley»Horn
KIMLEY-HORN AND ASSOCIATES, INC.
6205 S. W. 11th Ave., Suite 200
Greenwood Village, CO 80111 (303) 228-2300


PORTEOS INDUSTRIAL AT PORTEOS
CITY OF AURORA, COUNTY OF ADAMS
SITE PLAN AMENDMENT
DETAILED SITE PLAN

DATE: 03/22/2024
DESIGNED BY: CAO
DRAWN BY: AGM
CHECKED BY: BJC

FILE NO.
196617002_SP DTL-DIA 1
PROJECT NO.
196617002

SHEET NO.


K:\DEN_Civil\196617002 DIA1\CADD\PlanSheets\CSP\196617002_SP DTL-DIA I.dwg Mavis, August 3/27/2024 11:16 AM

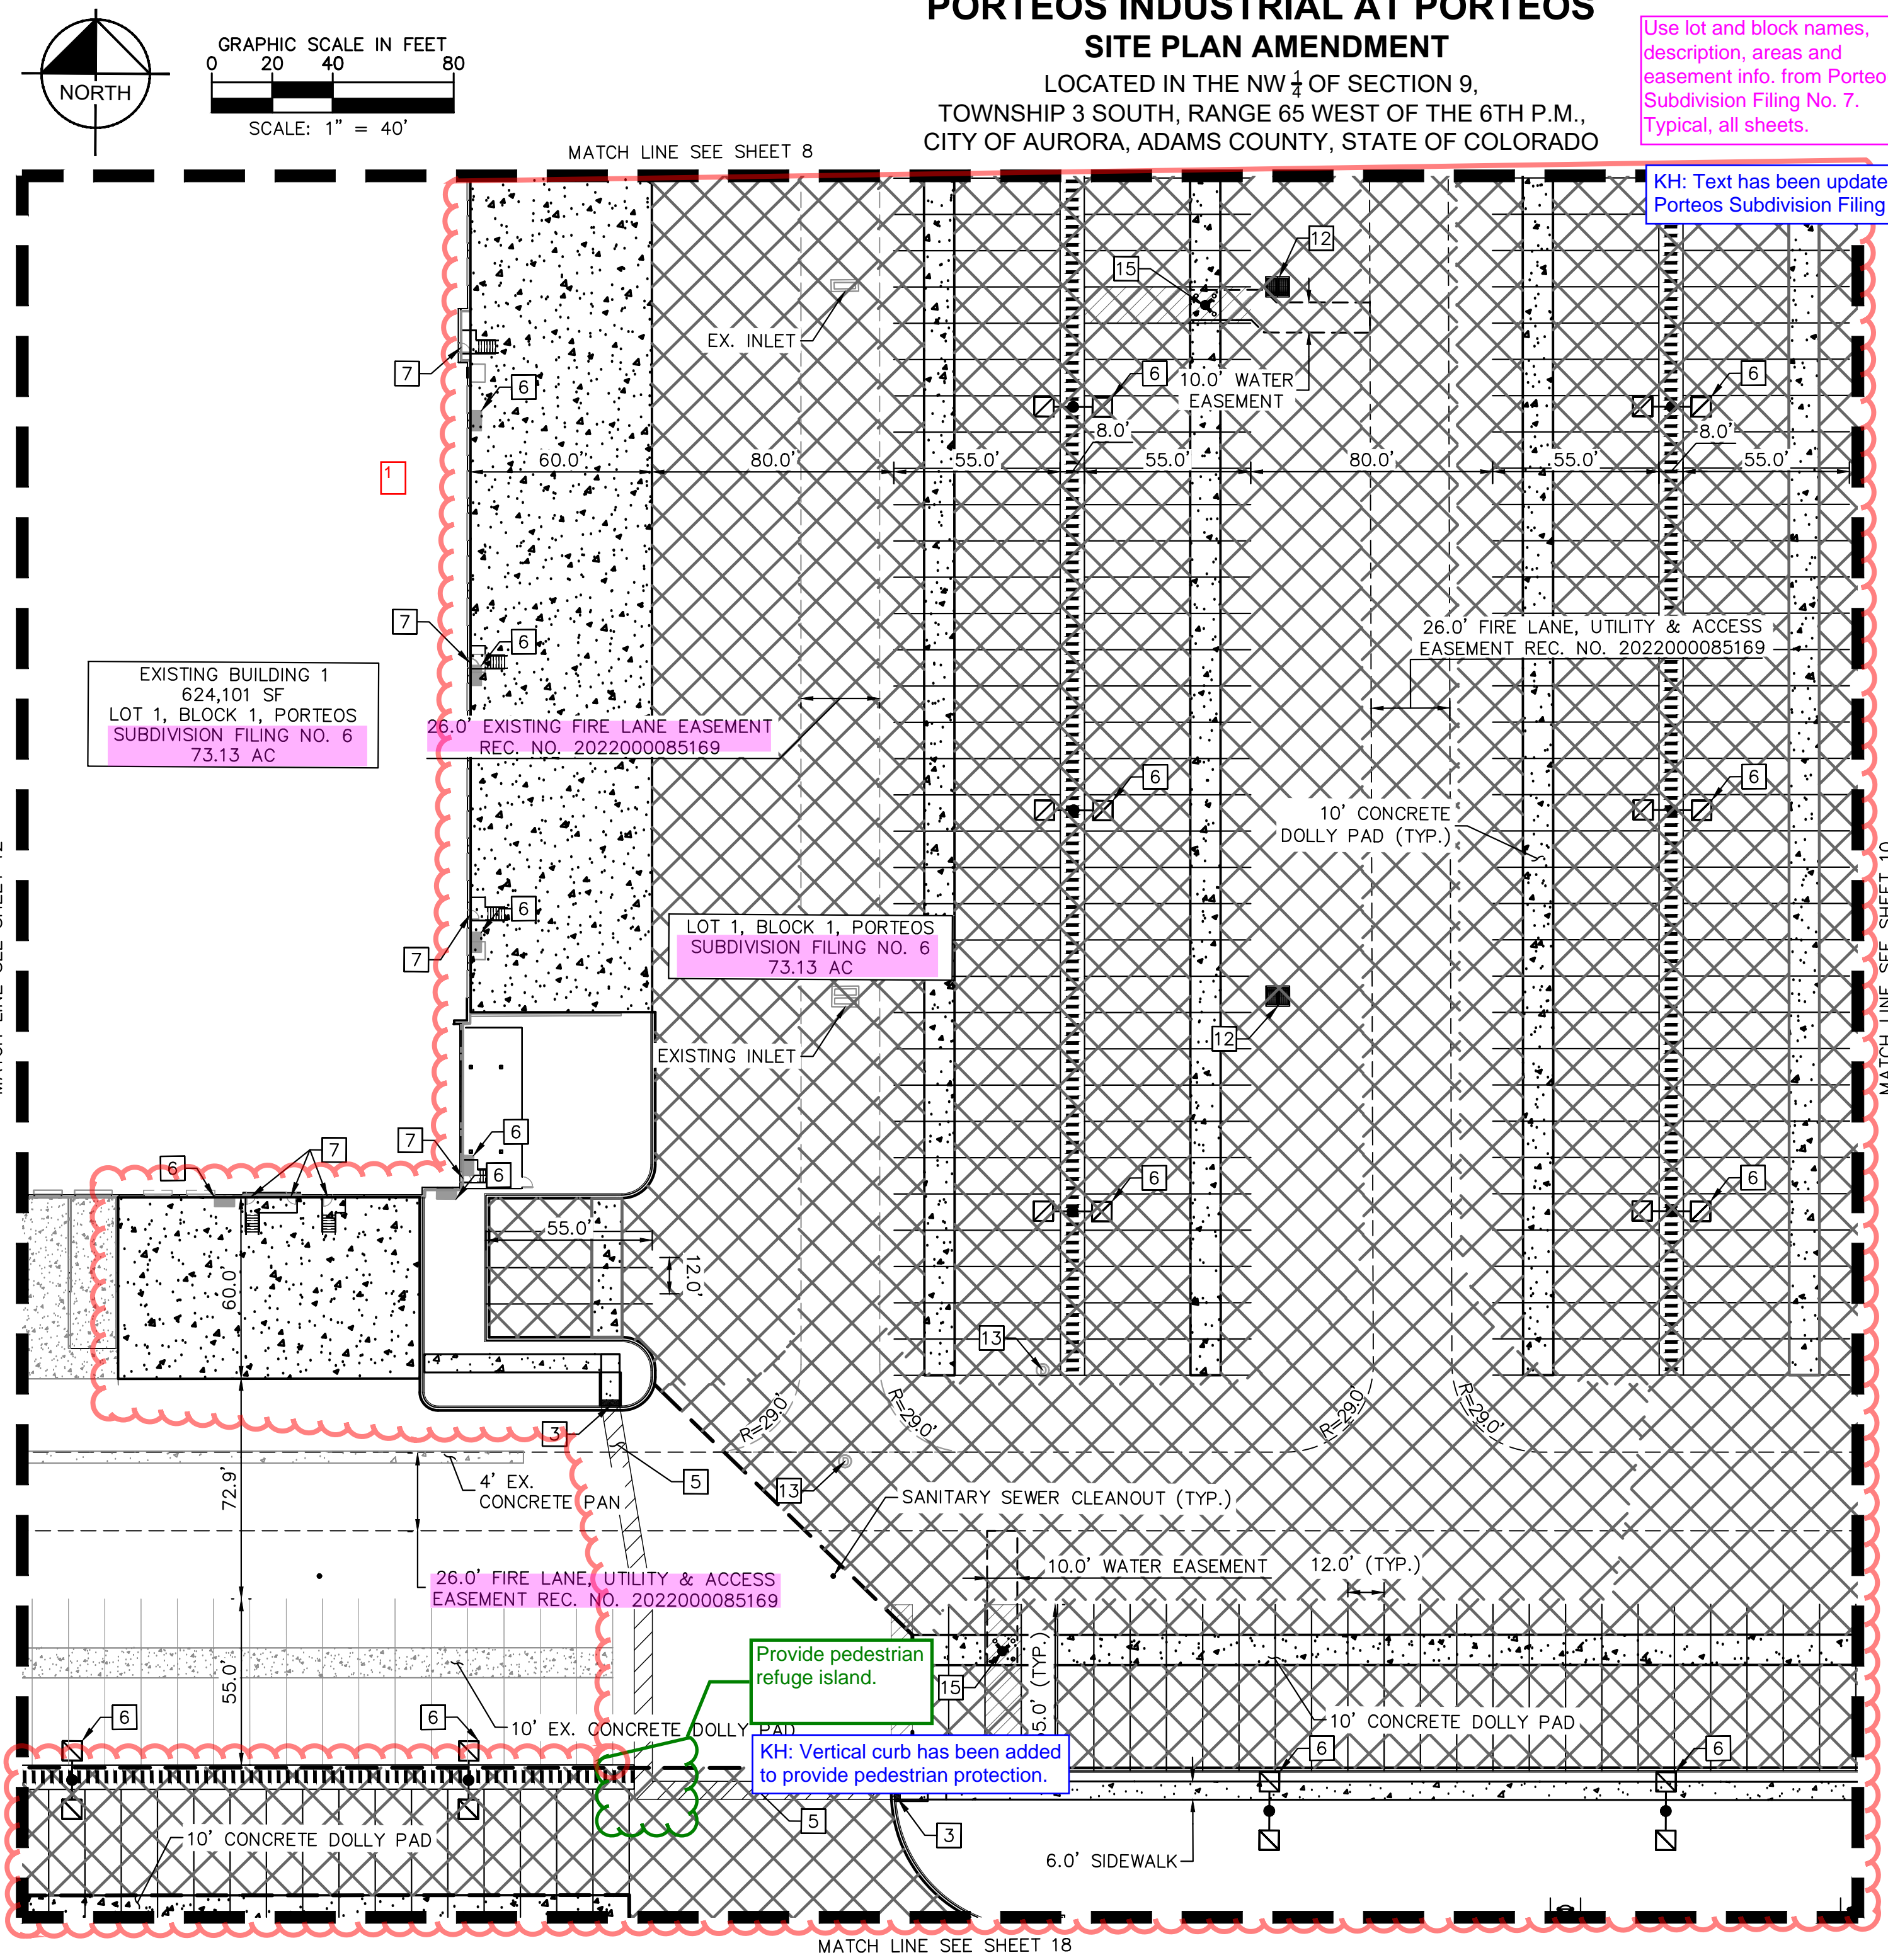

PORTEOS INDUSTRIAL AT PORTEOS
SITE PLAN AMENDMENT
LOCATED IN THE NW ¼ OF SECTION 9,
TOWNSHIP 3 SOUTH, RANGE 65 WEST OF THE 6TH P.M.,
CITY OF AURORA, ADAMS COUNTY, STATE OF COLORADO

Use lot and block names,
description, areas and
easement info. from Porteous
Subdivision Filing No. 7.
Typical, all sheets.

KH: Text has been updated to match
Porteous Subdivision Filing No. 7.

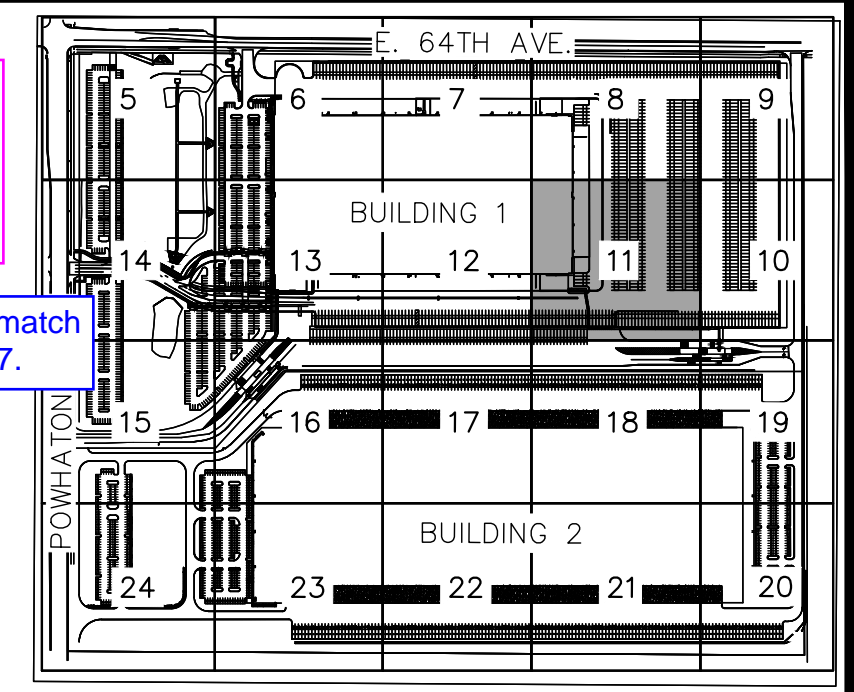

LEGEND

- PROPERTY LINE
- EASEMENT LINE
- STEEL SECURITY FENCE
- ACCESSIBLE ROUTE
- CONCRETE CURB & GUTTER
- PAVEMENT SAWCUT LINE
- PARKING COUNT
- PAINT STRIPING
- EXISTING GRAVEL
- EXISTING CONCRETE
- CONCRETE SIDEWALK
- HEAVY DUTY CONCRETE
- LIGHT DUTY ASPHALT
- HEAVY DUTY ASPHALT

SITE PLAN KEYNOTES

- ACCESSIBLE PARKING SPACES W/ ACCESSIBLE PARKING SIGN
- VAN ACCESSIBLE PARKING SPACES W/ VAN ACCESSIBLE PARKING SIGN
- ACCESSIBLE CURB RAMP W/ DETECTIBLE WARNING
- STOP SIGN
- PEDESTRIAN CROSSWALK
- SIGHT LIGHTING
- STAIRS & BUILDING EGRESS DOOR
- "NO PARKING FIRE LANE" SIGN
- BOLLARD
- BUILDING INGRESS/ENGRESS DOOR
- BUILDING EGRESS DOOR
- STORM INLET
- STORM MANHOLE
- FIRE HYDRANT, ASSEMBLY PER COA STD. DETAIL 208
- FIRE HYDRANT W/ BOLLARDS, ASSEMBLY PER COA STD. DETAIL 208
- SPEED BUMP
- FIRE LANE SIGN

SITE PLAN NOTES

- ALL RADII AREA 3' AND MEASURED FROM FACE OF CURB UNLESS STATED OTHERWISE.

Kimley»Horn
KIMLEY-HORN AND ASSOCIATES, INC.
6205 S. WILLOW
GREENWOOD VILLAGE, CO 80111 (303) 228-2300


PORTEOS INDUSTRIAL AT PORTEOS
CITY OF AURORA, COUNTY OF ADAMS
SITE PLAN AMENDMENT
DETAILED SITE PLAN

DATE: 03/22/2024
DESIGNED BY: CAO
DRAWN BY: AGM
CHECKED BY: BUC

FILE NO.
196617002_SP DTL-DIA I
PROJECT NO.
196617002

SHEET NO.

K:\DEN_Civil\196617002 DIA1\CADD\PlanSheets\CSP\196617002_SP DTL-DIA I.dwg Mavis, August 3/27/2024 11:17 AM

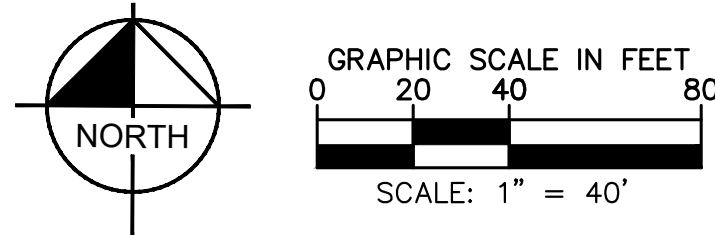


PORTEOS INDUSTRIAL AT PORTEOS SITE PLAN AMENDMENT

LOCATED IN THE NW $\frac{1}{4}$ OF SECTION 9,
TOWNSHIP 3 SOUTH, RANGE 65 WEST OF THE 6TH P.M.,
CITY OF AURORA, ADAMS COUNTY, STATE OF COLORADO

Use lot and block names,
description, areas and
easement info. from Porteous
Subdivision Filing No. 7.
Typical, all sheets.

KH: Text has been updated to match
Porteous Subdivision Filing No. 7.

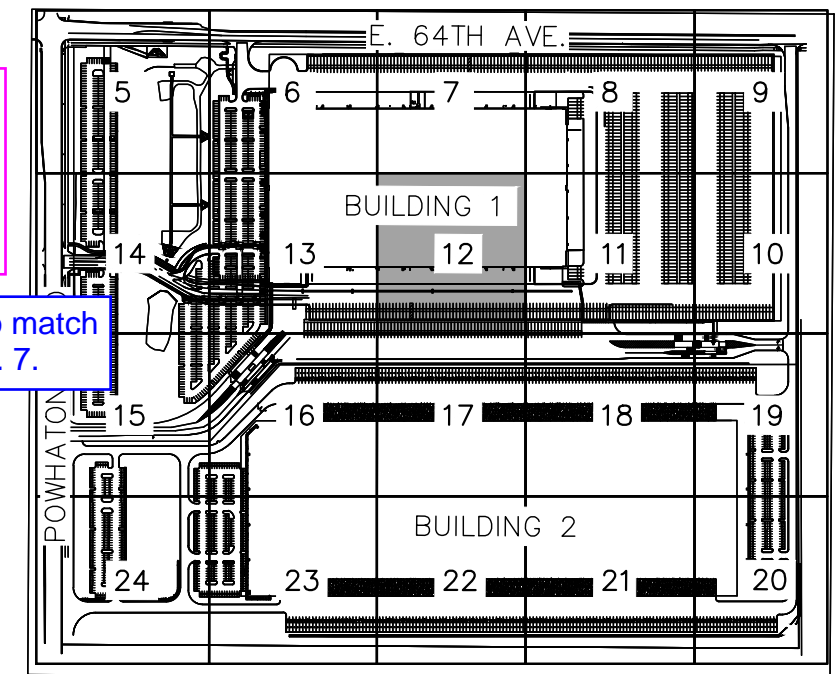

LEGEND

- PROPERTY LINE
- EASEMENT LINE
- STEEL SECURITY FENCE
- ACCESSIBLE ROUTE
- CONCRETE CURB & GUTTER
- PAVEMENT SAWCUT LINE
- PARKING COUNT
- PAINT STRIPING
- EXISTING GRAVEL
- EXISTING CONCRETE
- CONCRETE SIDEWALK
- HEAVY DUTY CONCRETE
- LIGHT DUTY ASPHALT
- HEAVY DUTY ASPHALT

SITE PLAN KEYNOTES

- ACCESSIBLE PARKING SPACES W/ ACCESSIBLE PARKING SIGN
- VAN ACCESSIBLE PARKING SPACES W/ VAN ACCESSIBLE PARKING SIGN
- ACCESSIBLE CURB RAMP W/ DETECTIBLE WARNING
- STOP SIGN
- PEDESTRIAN CROSSWALK
- SIGHT LIGHTING
- STAIRS & BUILDING EGRESS DOOR
- "NO PARKING FIRE LANE" SIGN
- BOLLARD
- BUILDING INGRESS/ENGRESS DOOR
- BUILDING EGRESS DOOR
- STORM INLET
- STORM MANHOLE
- FIRE HYDRANT, ASSEMBLY PER COA STD. DETAIL 208
- FIRE HYDRANT W/ BOLLARDS, ASSEMBLY PER COA STD. DETAIL 208
- SPEED BUMP
- FIRE LANE SIGN

SITE PLAN NOTES

- ALL RADII AREA 3' AND MEASURED FROM FACE OF CURB UNLESS STATED OTHERWISE.

Kimley»Horn
KIMLEY-HORN AND ASSOCIATES, INC.
6205 S. W. 11TH AVE.
GREENWOOD VILLAGE, CO 80111 (303) 228-2300


PORTEOS INDUSTRIAL AT PORTEOS
CITY OF AURORA, COUNTY OF ADAMS
SITE PLAN AMENDMENT

DATE: 03/22/2024
DESIGNED BY: CAO
DRAWN BY: AGM
CHECKED BY: BJC

FILE NO.
196617002_SP DTL-DIA I
PROJECT NO.
196617002

SHEET NO.

K:\DEN_Civil\196617002 DIA1\CADD\PlanSheets\CSP\196617002_SP DTL-DIA I.dwg OKeefe, Sam 3/27/2024 8:08 AM

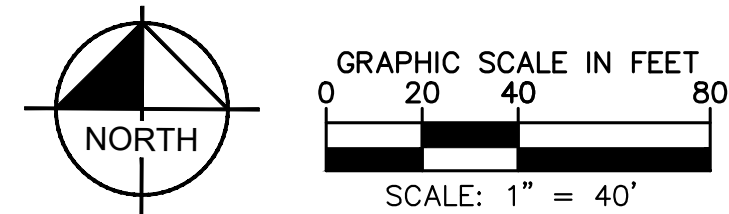


PORTEOS INDUSTRIAL AT PORTEOS SITE PLAN AMENDMENT

LOCATED IN THE NW $\frac{1}{4}$ OF SECTION 9,
TOWNSHIP 3 SOUTH, RANGE 65 WEST OF THE 6TH P.M.,
CITY OF AURORA, ADAMS COUNTY, STATE OF COLORADO

Use lot and block names,
description, areas and
easement info. from Porteos
Subdivision Filing No. 7.
Typical, all sheets.

KH: Text has been updated to match
Porteos Subdivision Filing No. 7.

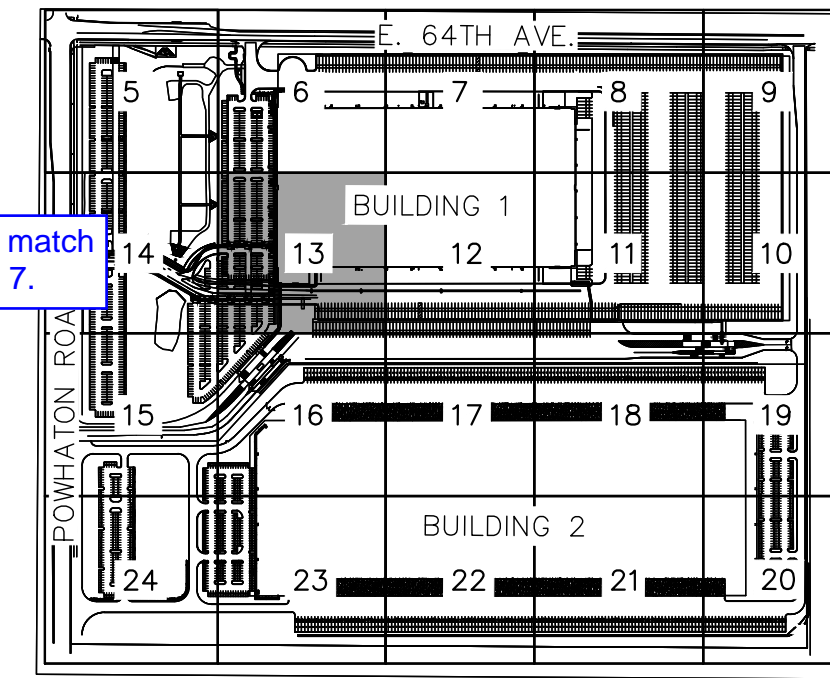


LEGEND

- PROPERTY LINE
- EASEMENT LINE
- STEEL SECURITY FENCE
- ACCESSIBLE ROUTE
- CONCRETE CURB & GUTTER
- PARKING COUNT
- PAINT STRIPING
- EXISTING GRAVEL
- EXISTING CONCRETE
- CONCRETE SIDEWALK
- HEAVY DUTY CONCRETE
- LIGHT DUTY ASPHALT
- HEAVY DUTY ASPHALT

SITE PLAN KEYNOTES

- ACCESSIBLE PARKING SPACES W/ ACCESSIBLE PARKING SIGN
- VAN ACCESSIBLE PARKING SPACES W/ VAN ACCESSIBLE PARKING SIGN
- ACCESSIBLE CURB RAMP W/ DETECTIBLE WARNING
- STOP SIGN
- PEDESTRIAN CROSSWALK
- SIGHT LIGHTING
- STAIRS & BUILDING EGRESS DOOR
- "NO PARKING FIRE LANE" SIGN
- BOLLARD
- BUILDING INGRESS/ENGRESS DOOR
- BUILDING EGRESS DOOR
- STORM INLET
- STORM MANHOLE
- FIRE HYDRANT, ASSEMBLY PER COA STD. DETAIL 208
- FIRE HYDRANT W/ BOLLARDS, ASSEMBLY PER COA STD. DETAIL 208
- SPEED BUMP
- FIRE LANE SIGN

SITE PLAN NOTES

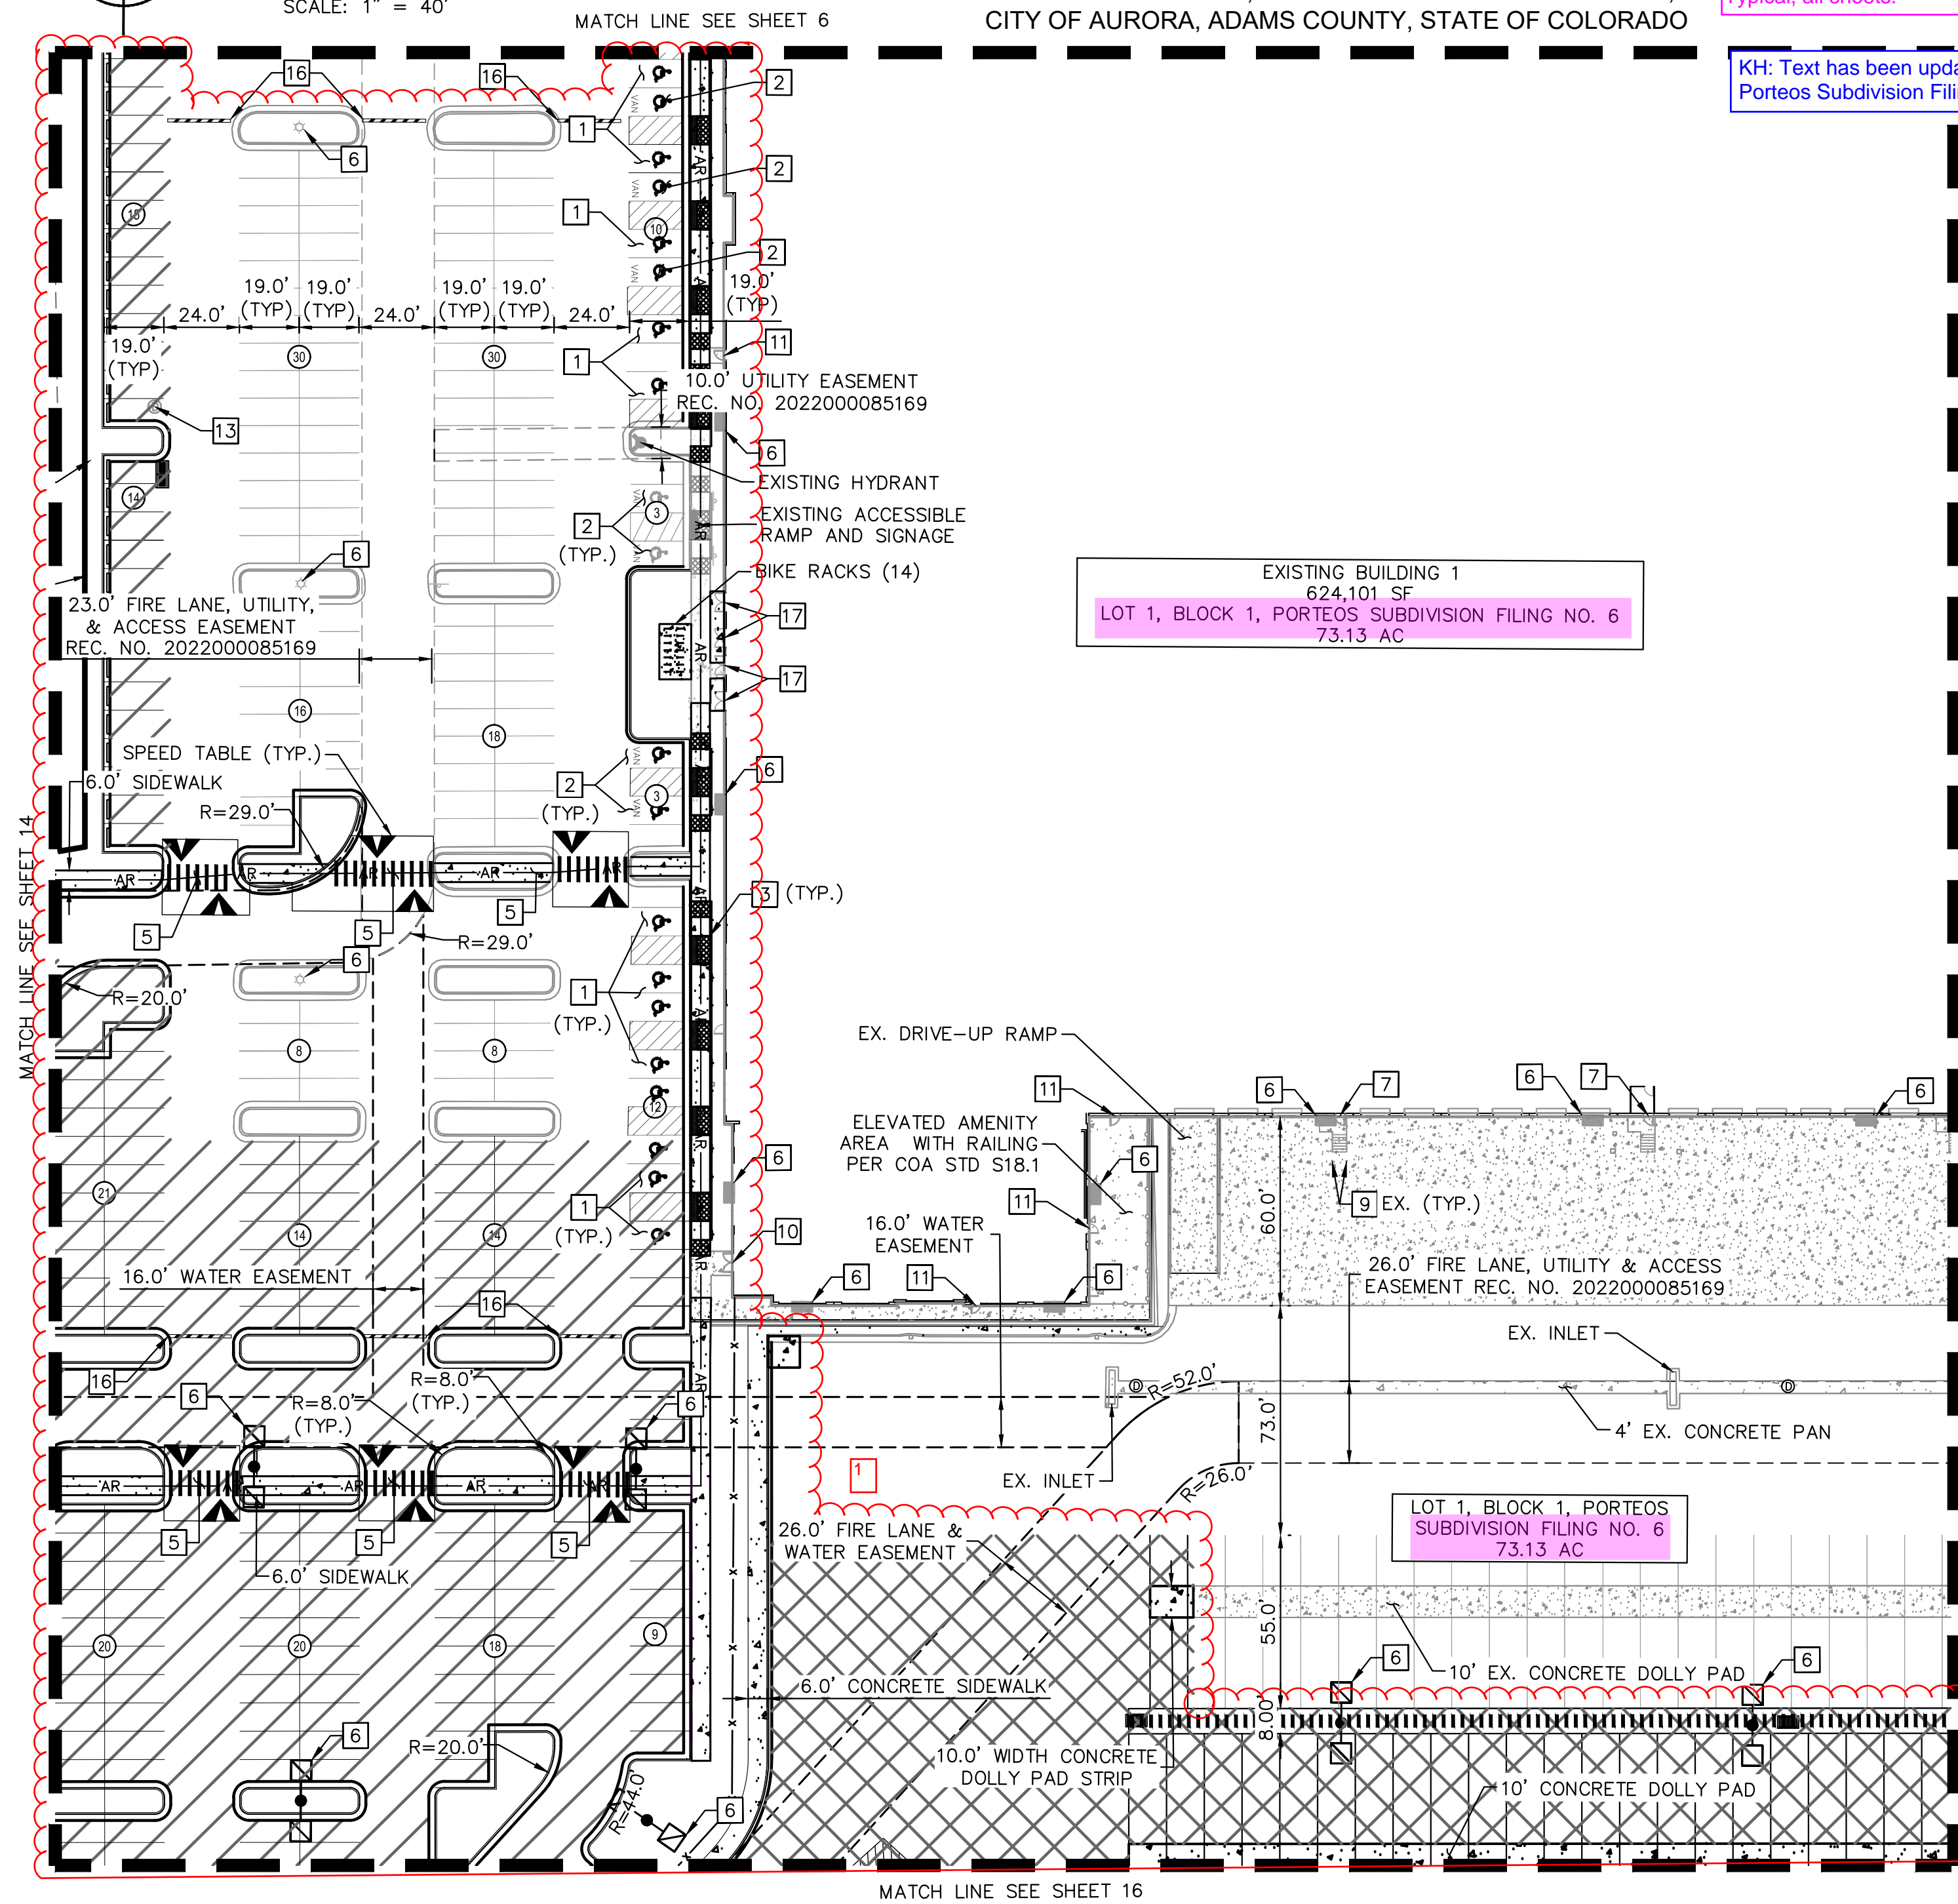

EXISTING BUILDING 1
624,101 SF
LOT 1, BLOCK 1, PORTEOS SUBDIVISION FILING NO. 6
73.13 AC

LOT 1, BLOCK 1, PORTEOS
SUBDIVISION FILING NO. 6
73.13 AC


Kimley»Horn
KIMLEY-HORN AND ASSOCIATES, INC.
6205 S. W. 11th Ave.
Greenwood Village, CO 80111 (303) 228-2300

PORTEOS INDUSTRIAL AT PORTEOS
CITY OF AURORA, COUNTY OF ADAMS
SITE PLAN AMENDMENT
DETAILED SITE PLAN

DATE: 03/22/2024
DESIGNED BY: CAO
DRAWN BY: AGM
CHECKED BY: BUC


FILE NO.
196617002_SP DTL-DIA I
PROJECT NO.
196617002

SHEET NO.

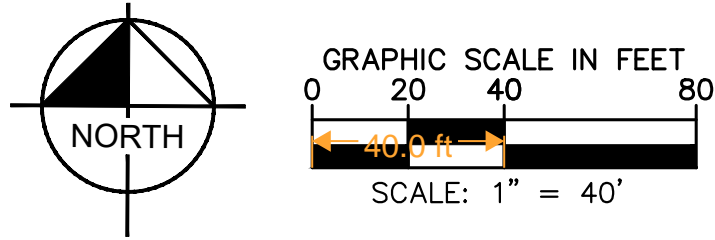

PORTEOS INDUSTRIAL AT PORTEOS SITE PLAN AMENDMENT

LOCATED IN THE NW ¼ OF SECTION 9,
TOWNSHIP 3 SOUTH, RANGE 65 WEST OF THE 6TH P.M.,
CITY OF AURORA, ADAMS COUNTY, STATE OF COLORADO

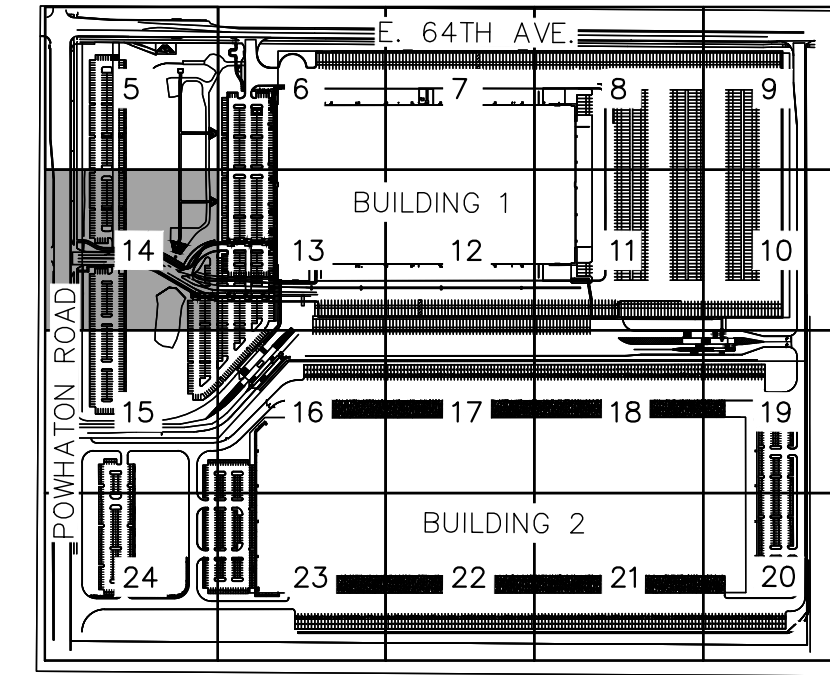


LEGEND

- PROPERTY LINE
- EASEMENT LINE
- STEEL SECURITY FENCE
- ACCESSIBLE ROUTE
- CONCRETE CURB & GUTTER
- PARKING COUNT
- PAINT STRIPING
- EXISTING GRAVEL
- EXISTING CONCRETE
- CONCRETE SIDEWALK
- HEAVY DUTY CONCRETE
- LIGHT DUTY ASPHALT
- HEAVY DUTY ASPHALT



SITE PLAN KEYNOTES

- 1 ACCESSIBLE PARKING SPACES W/ ACCESSIBLE PARKING SIGN
- 2 VAN ACCESSIBLE PARKING SPACES W/ VAN ACCESSIBLE PARKING SIGN
- 3 ACCESSIBLE CURB RAMP W/ DETECTIBLE WARNING
- 4 STOP SIGN
- 5 PEDESTRIAN CROSSWALK
- 6 SIGHT LIGHTING
- 7 STAIRS & BUILDING EGRESS DOOR
- 8 "NO PARKING FIRE LANE" SIGN
- 9 BOLLARD
- 10 BUILDING INGRESS/ENGRESS DOOR
- 11 BUILDING EGRESS DOOR
- 12 STORM INLET
- 13 STORM MANHOLE
- 14 FIRE HYDRANT, ASSEMBLY PER COA STD. DETAIL 208
- 15 FIRE HYDRANT W/ BOLLARDS, ASSEMBLY PER COA STD. DETAIL 208
- 16 SPEED BUMP
- 17 FIRE LANE SIGN

SITE PLAN NOTES

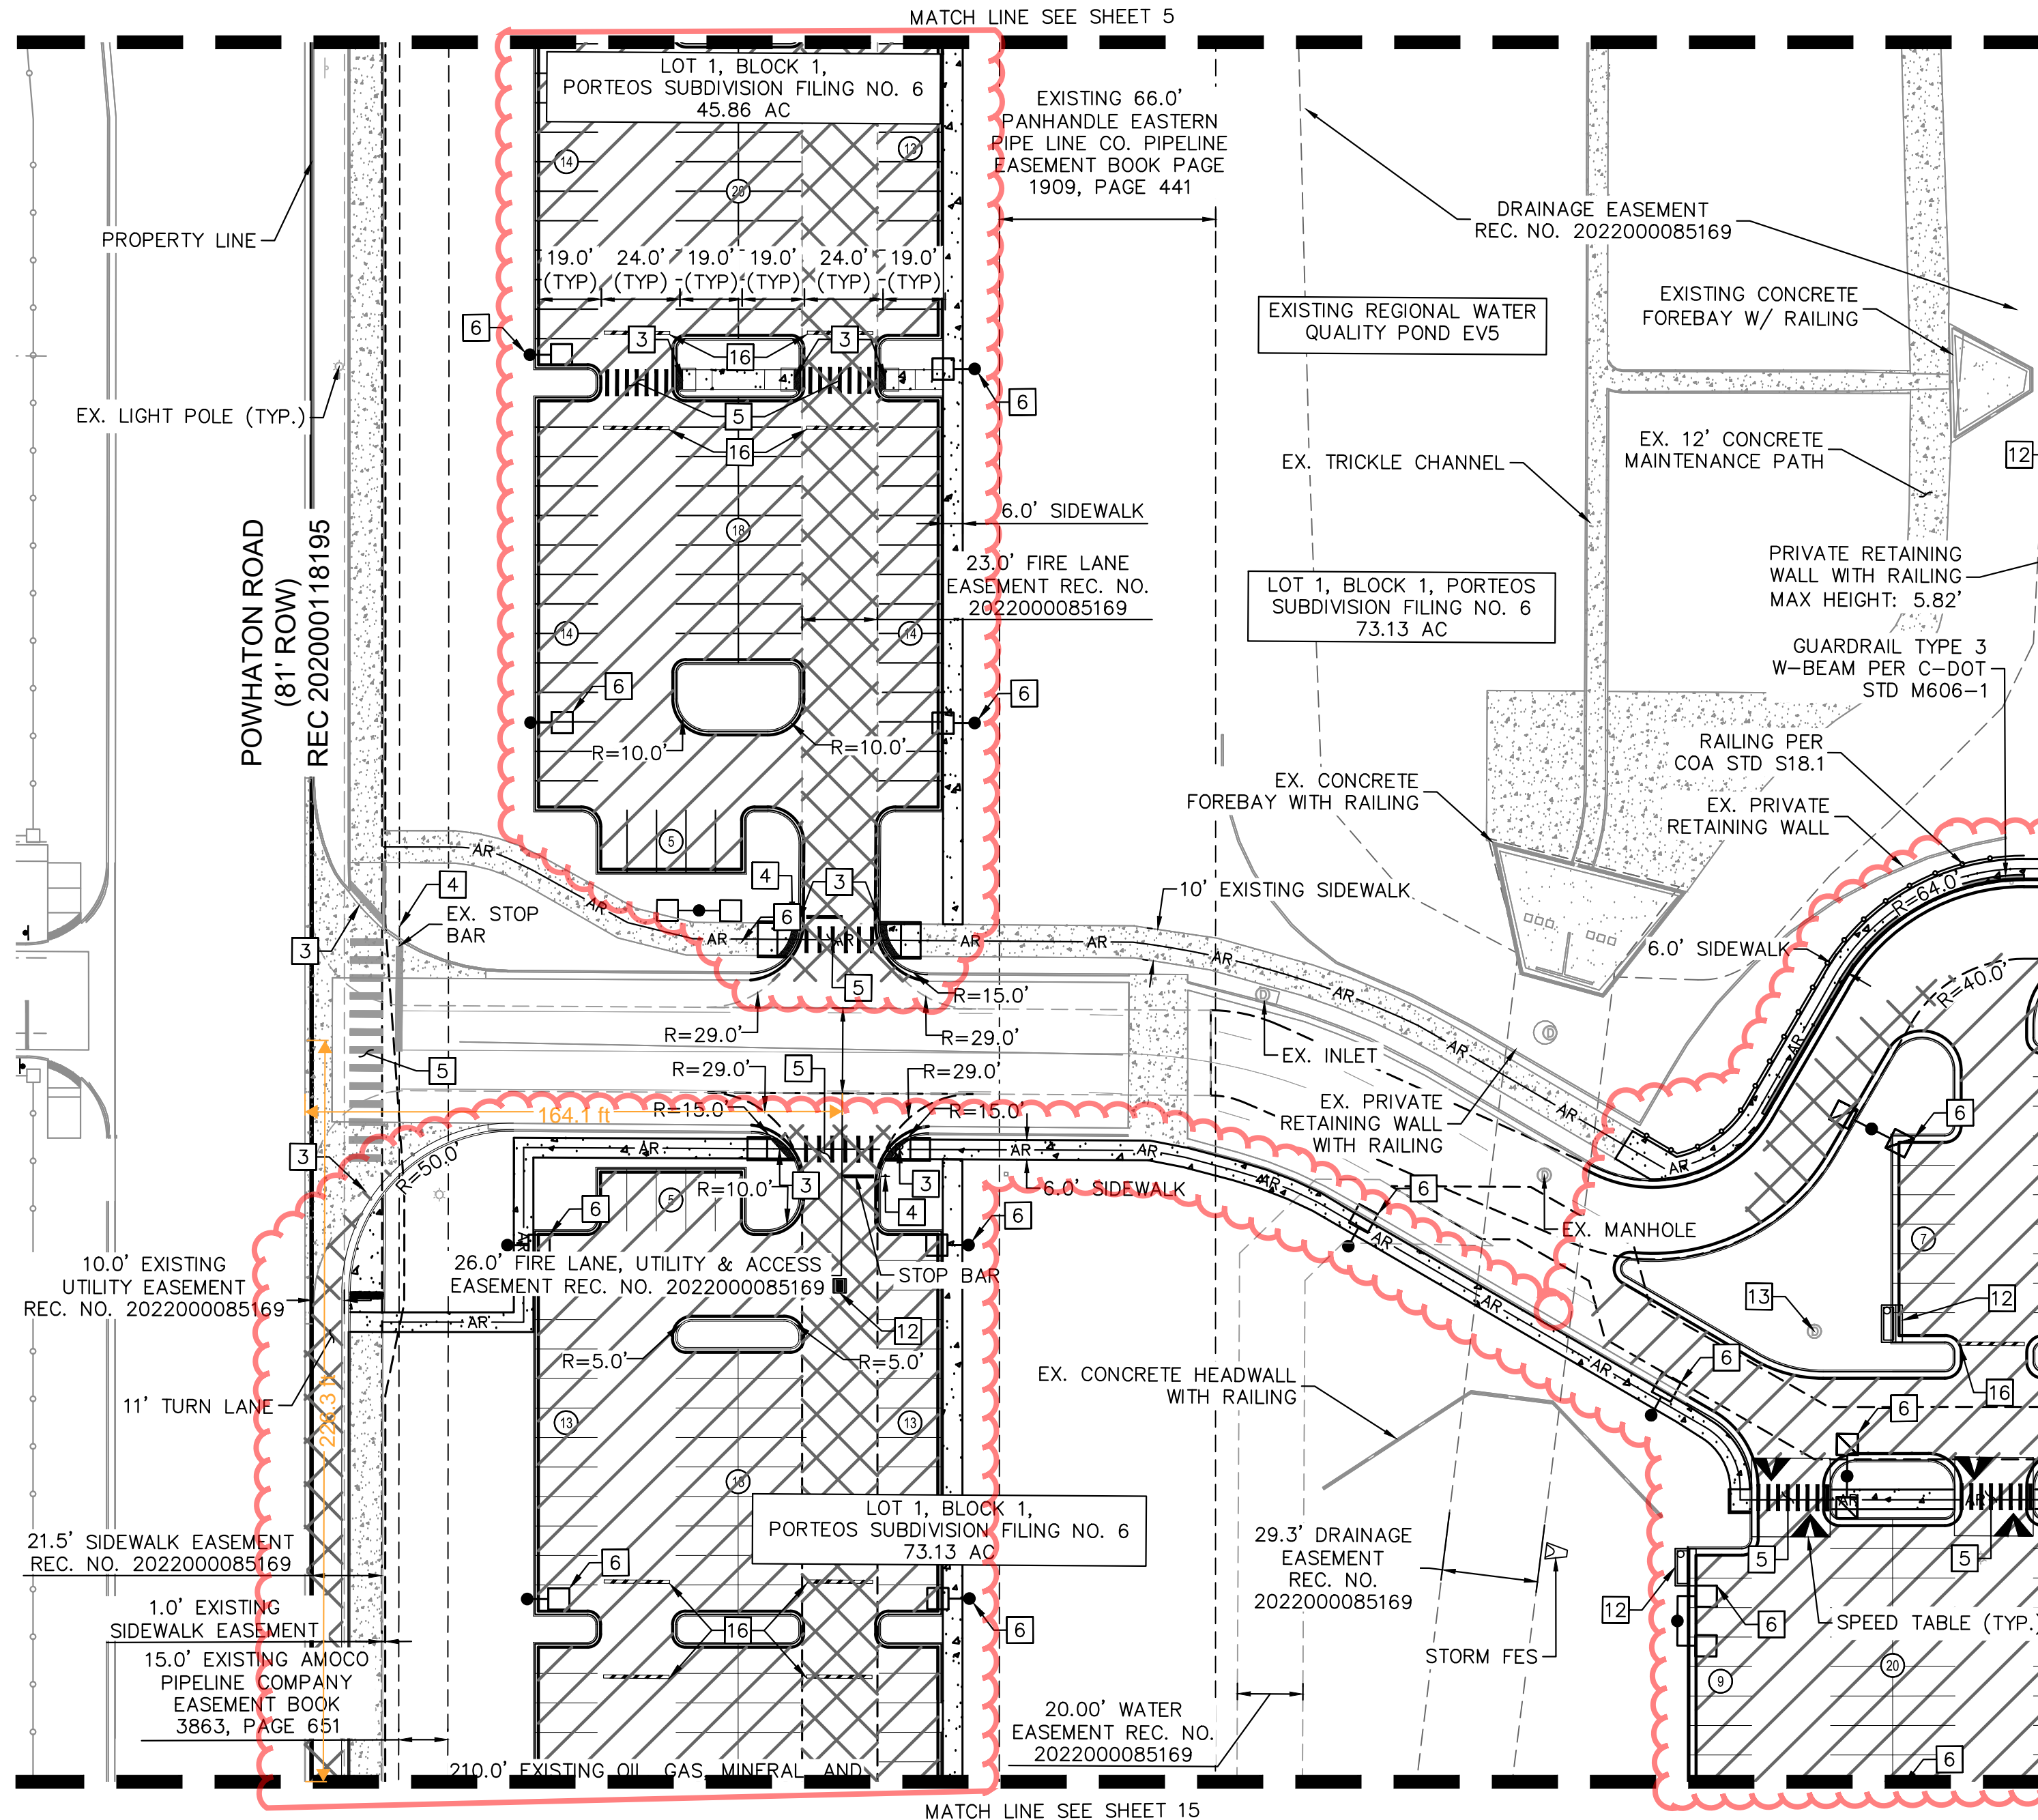

K:\DEN_Civil\196617002 DIA\ CADD\PlanSheets\CSP\196617002_SP DTL-DIA II.dwg OKeeffe, Sam 3/27/2024 12:36 PM

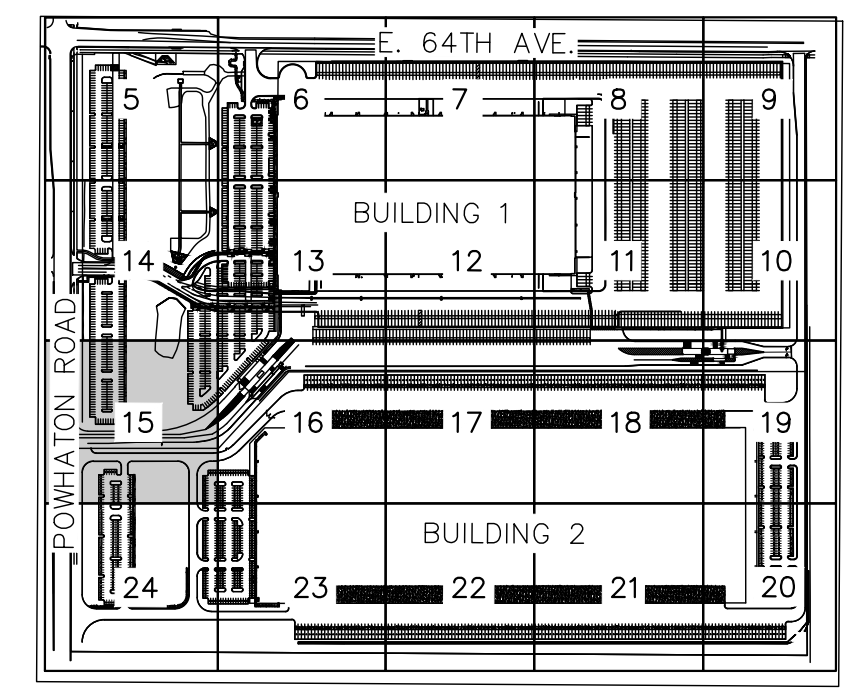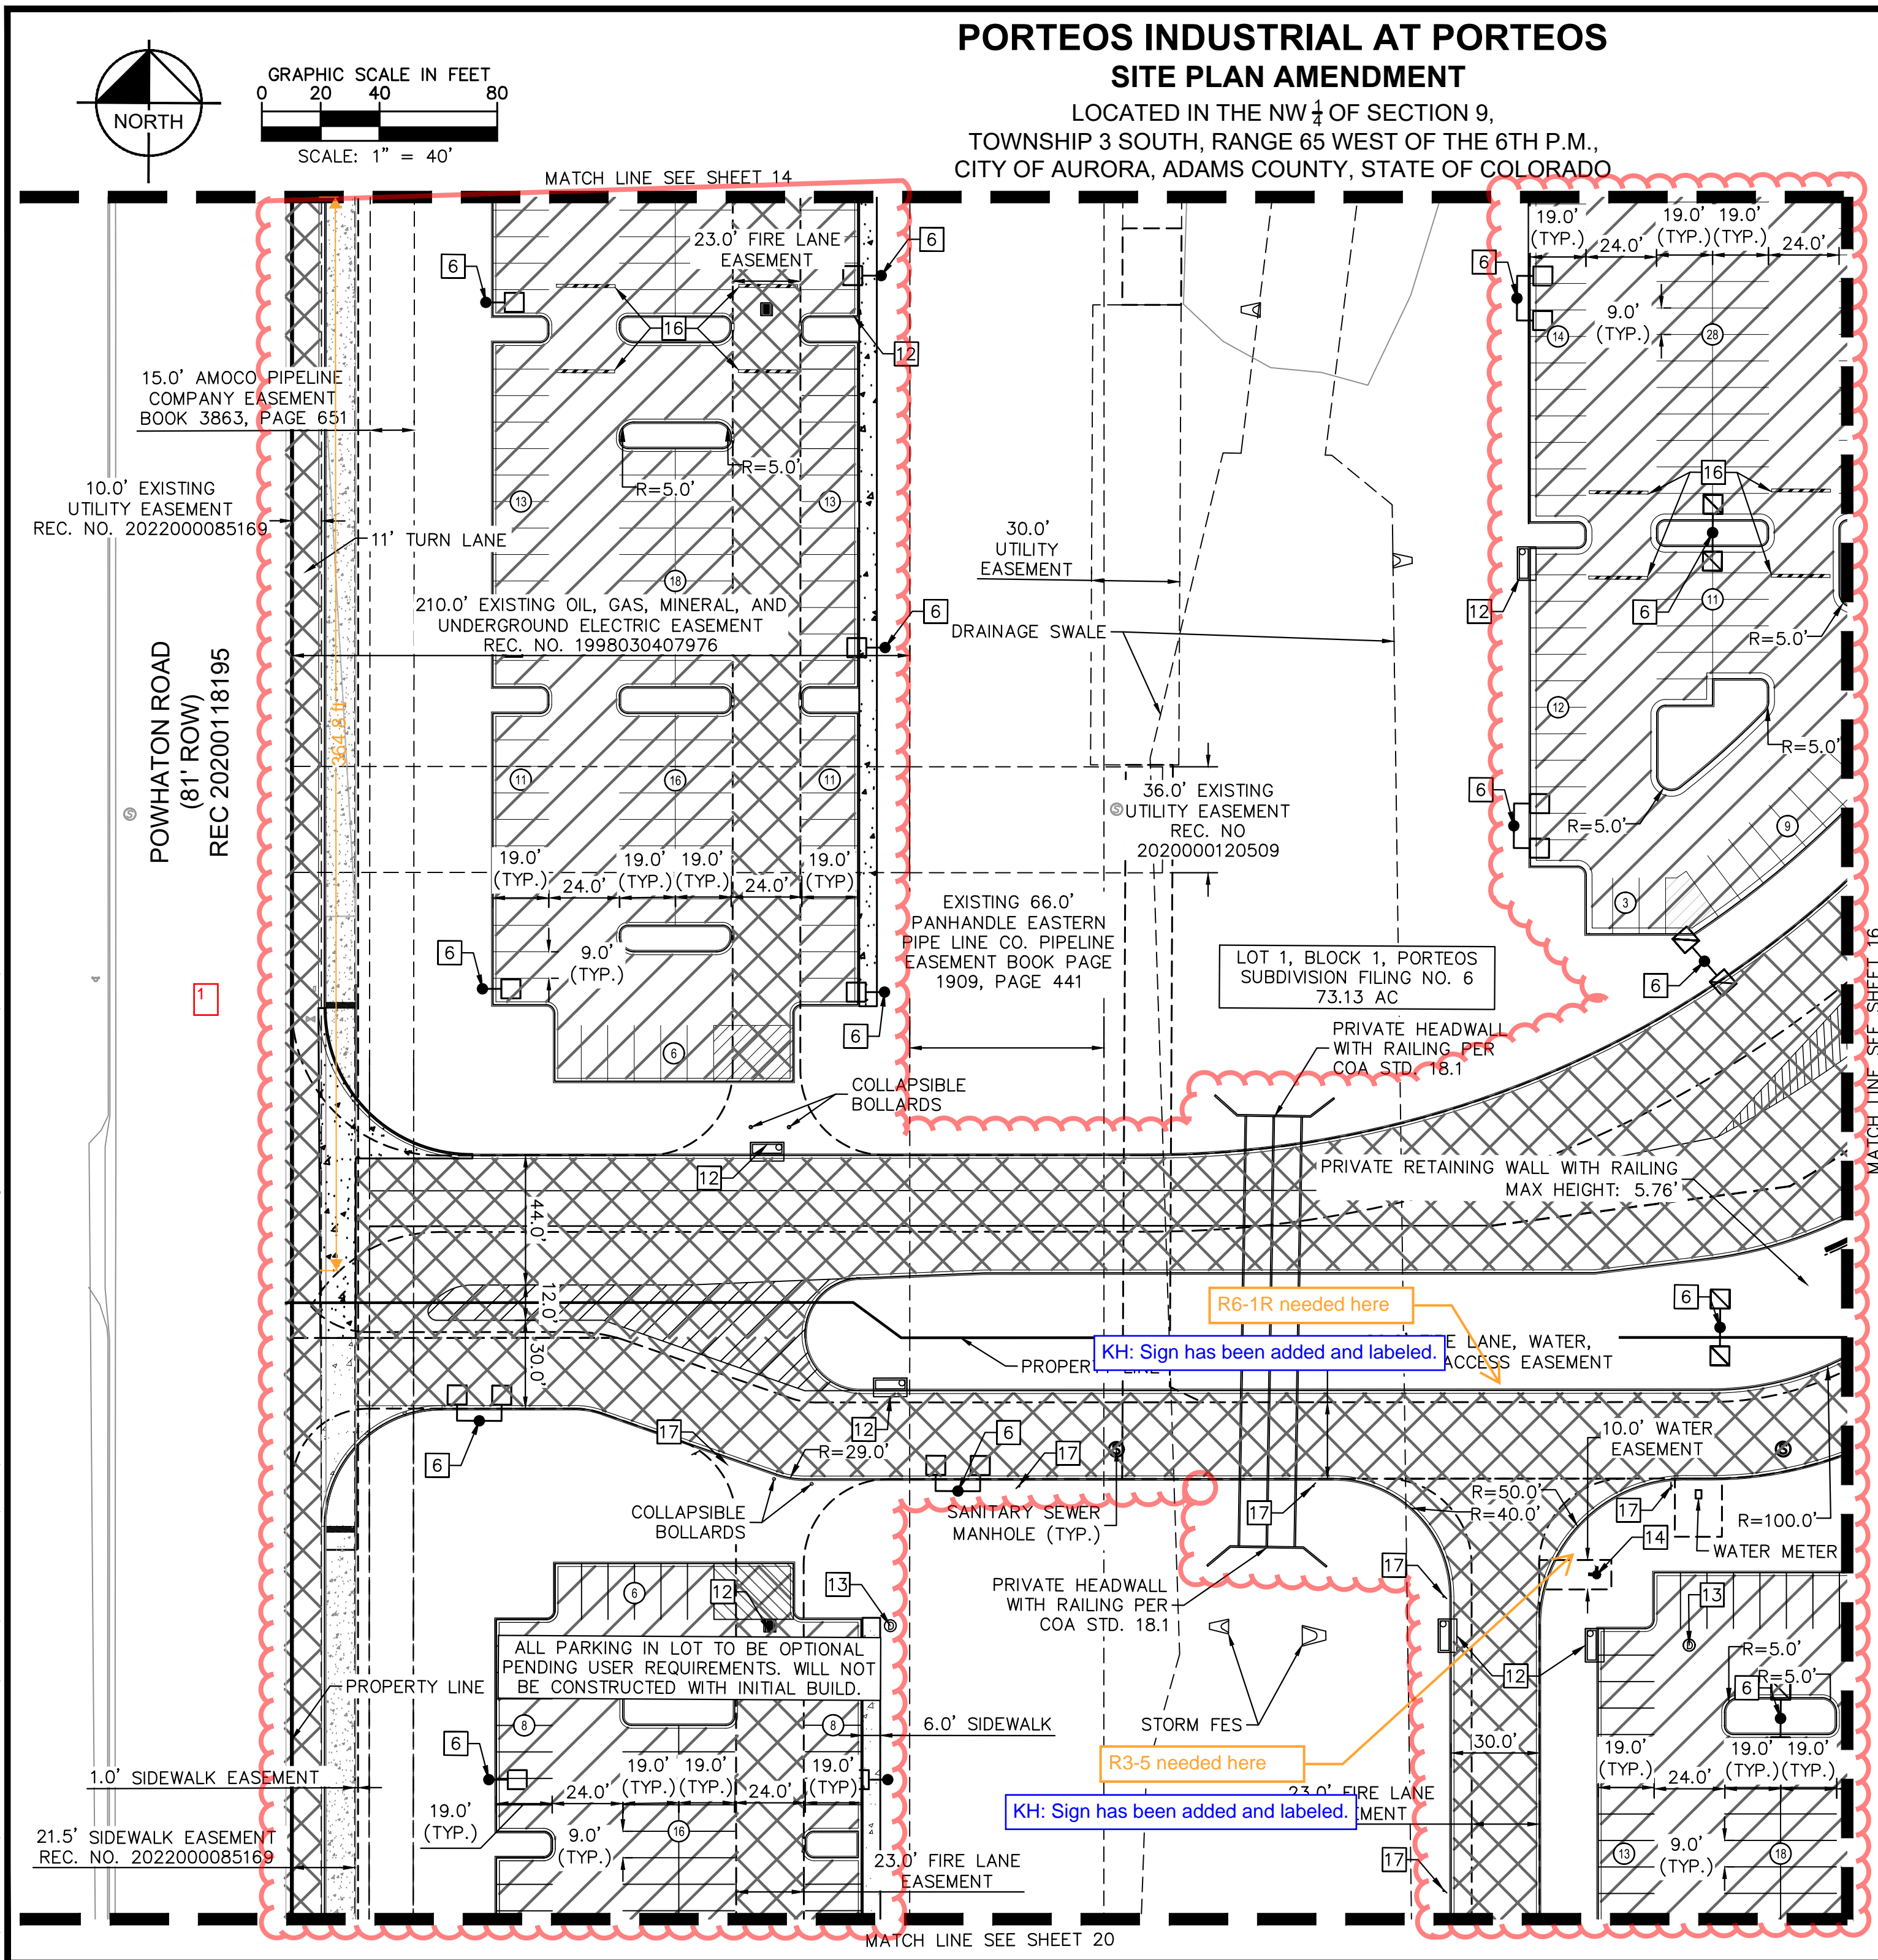

KEYMAP
NTS

LEGEND

- PROPERTY LINE
- EASEMENT LINE
- STEEL SECURITY FENCE
- ACCESSIBLE ROUTE
- CONCRETE CURB & GUTTER
- PAVEMENT SAWCUT LINE
- PARKING COUNT
- PAINT STRIPING
- EXISTING GRAVEL
- EXISTING CONCRETE
- CONCRETE SIDEWALK
- HEAVY DUTY CONCRETE
- LIGHT DUTY ASPHALT
- HEAVY DUTY ASPHALT

SITE PLAN KEYNOTES

- ACCESSIBLE PARKING SPACES W/ ACCESSIBLE PARKING SIGN
- VAN ACCESSIBLE PARKING SPACES W/ VAN ACCESSIBLE PARKING SIGN
- ACCESSIBLE CURB RAMP W/ DETECTIBLE WARNING
- STOP SIGN
- PEDESTRIAN CROSSWALK
- SIGHT LIGHTING
- STAIRS & BUILDING EGRESS DOOR
- "NO PARKING FIRE LANE" SIGN
- BOLLARD
- BUILDING INGRESS/ENGRESS DOOR
- BUILDING EGRESS DOOR
- STORM INLET
- STORM MANHOLE
- FIRE HYDRANT, ASSEMBLY PER COA STD. DETAIL 208
- FIRE HYDRANT W/ BOLLARDS, ASSEMBLY PER COA STD. DETAIL 208
- SPEED BUMP
- FIRE LANE SIGN

SITE PLAN NOTES

- ALL RADII AREA 3' AND MEASURED FROM FACE OF CURB UNLESS STATED OTHERWISE.

PORTEOS INDUSTRIAL AT PORTEOS
CITY OF AURORA, COUNTY OF ADAMS
SITE PLAN AMENDMENT
DETAILED SITE PLAN

DATE: 03/22/2024
DESIGNED BY: CAO
DRAWN BY: AGM
CHECKED BY: BUC

FILE NO. 196617002_SP DTL-DIA II
PROJECT NO. 196617002
SHEET NO. 15



Kimley»Horn
KIMLEY-HORN AND ASSOCIATES, INC.
6205 S. HAWKINS AVE.
GREENWOOD VILLAGE, CO 80111 (303) 228-2300

PORTEOS INDUSTRIAL AT PORTEOS
CITY OF AURORA, COUNTY OF ADAMS
SITE PLAN AMENDMENT
DETAILED SITE PLAN

DATE: 03/22/2024
DESIGNED BY: CAO
DRAWN BY: AGM
CHECKED BY: BUC

FILE NO. 196617002_SP DTL-DIA II
PROJECT NO. 196617002
SHEET NO. 15

K:\DEN_Civil\196617002 DIA\CADD\PlanSheets\CSP\196617002_SP DTL-DIA II.dwg OKeefe, Sam 3/27/2024 12:37 PM

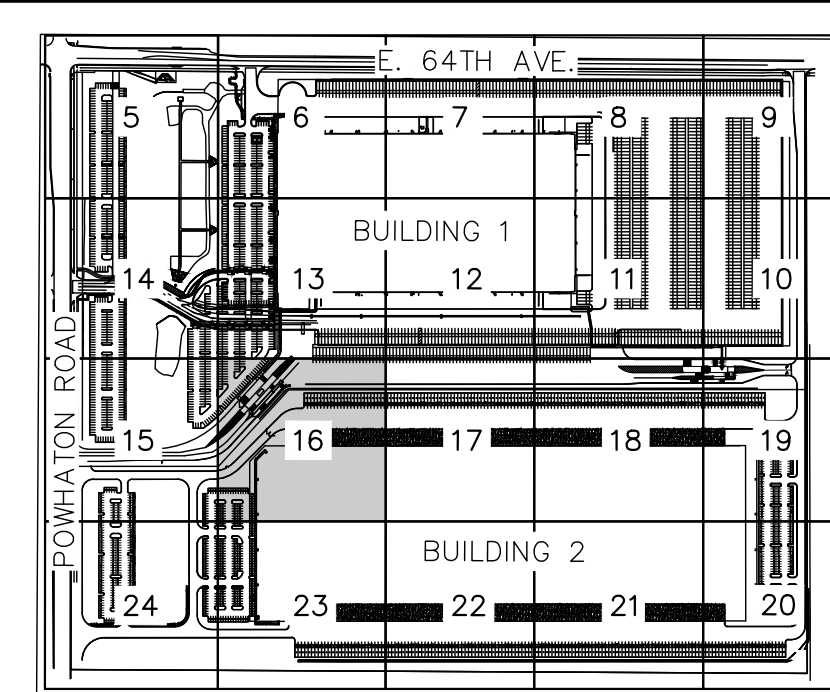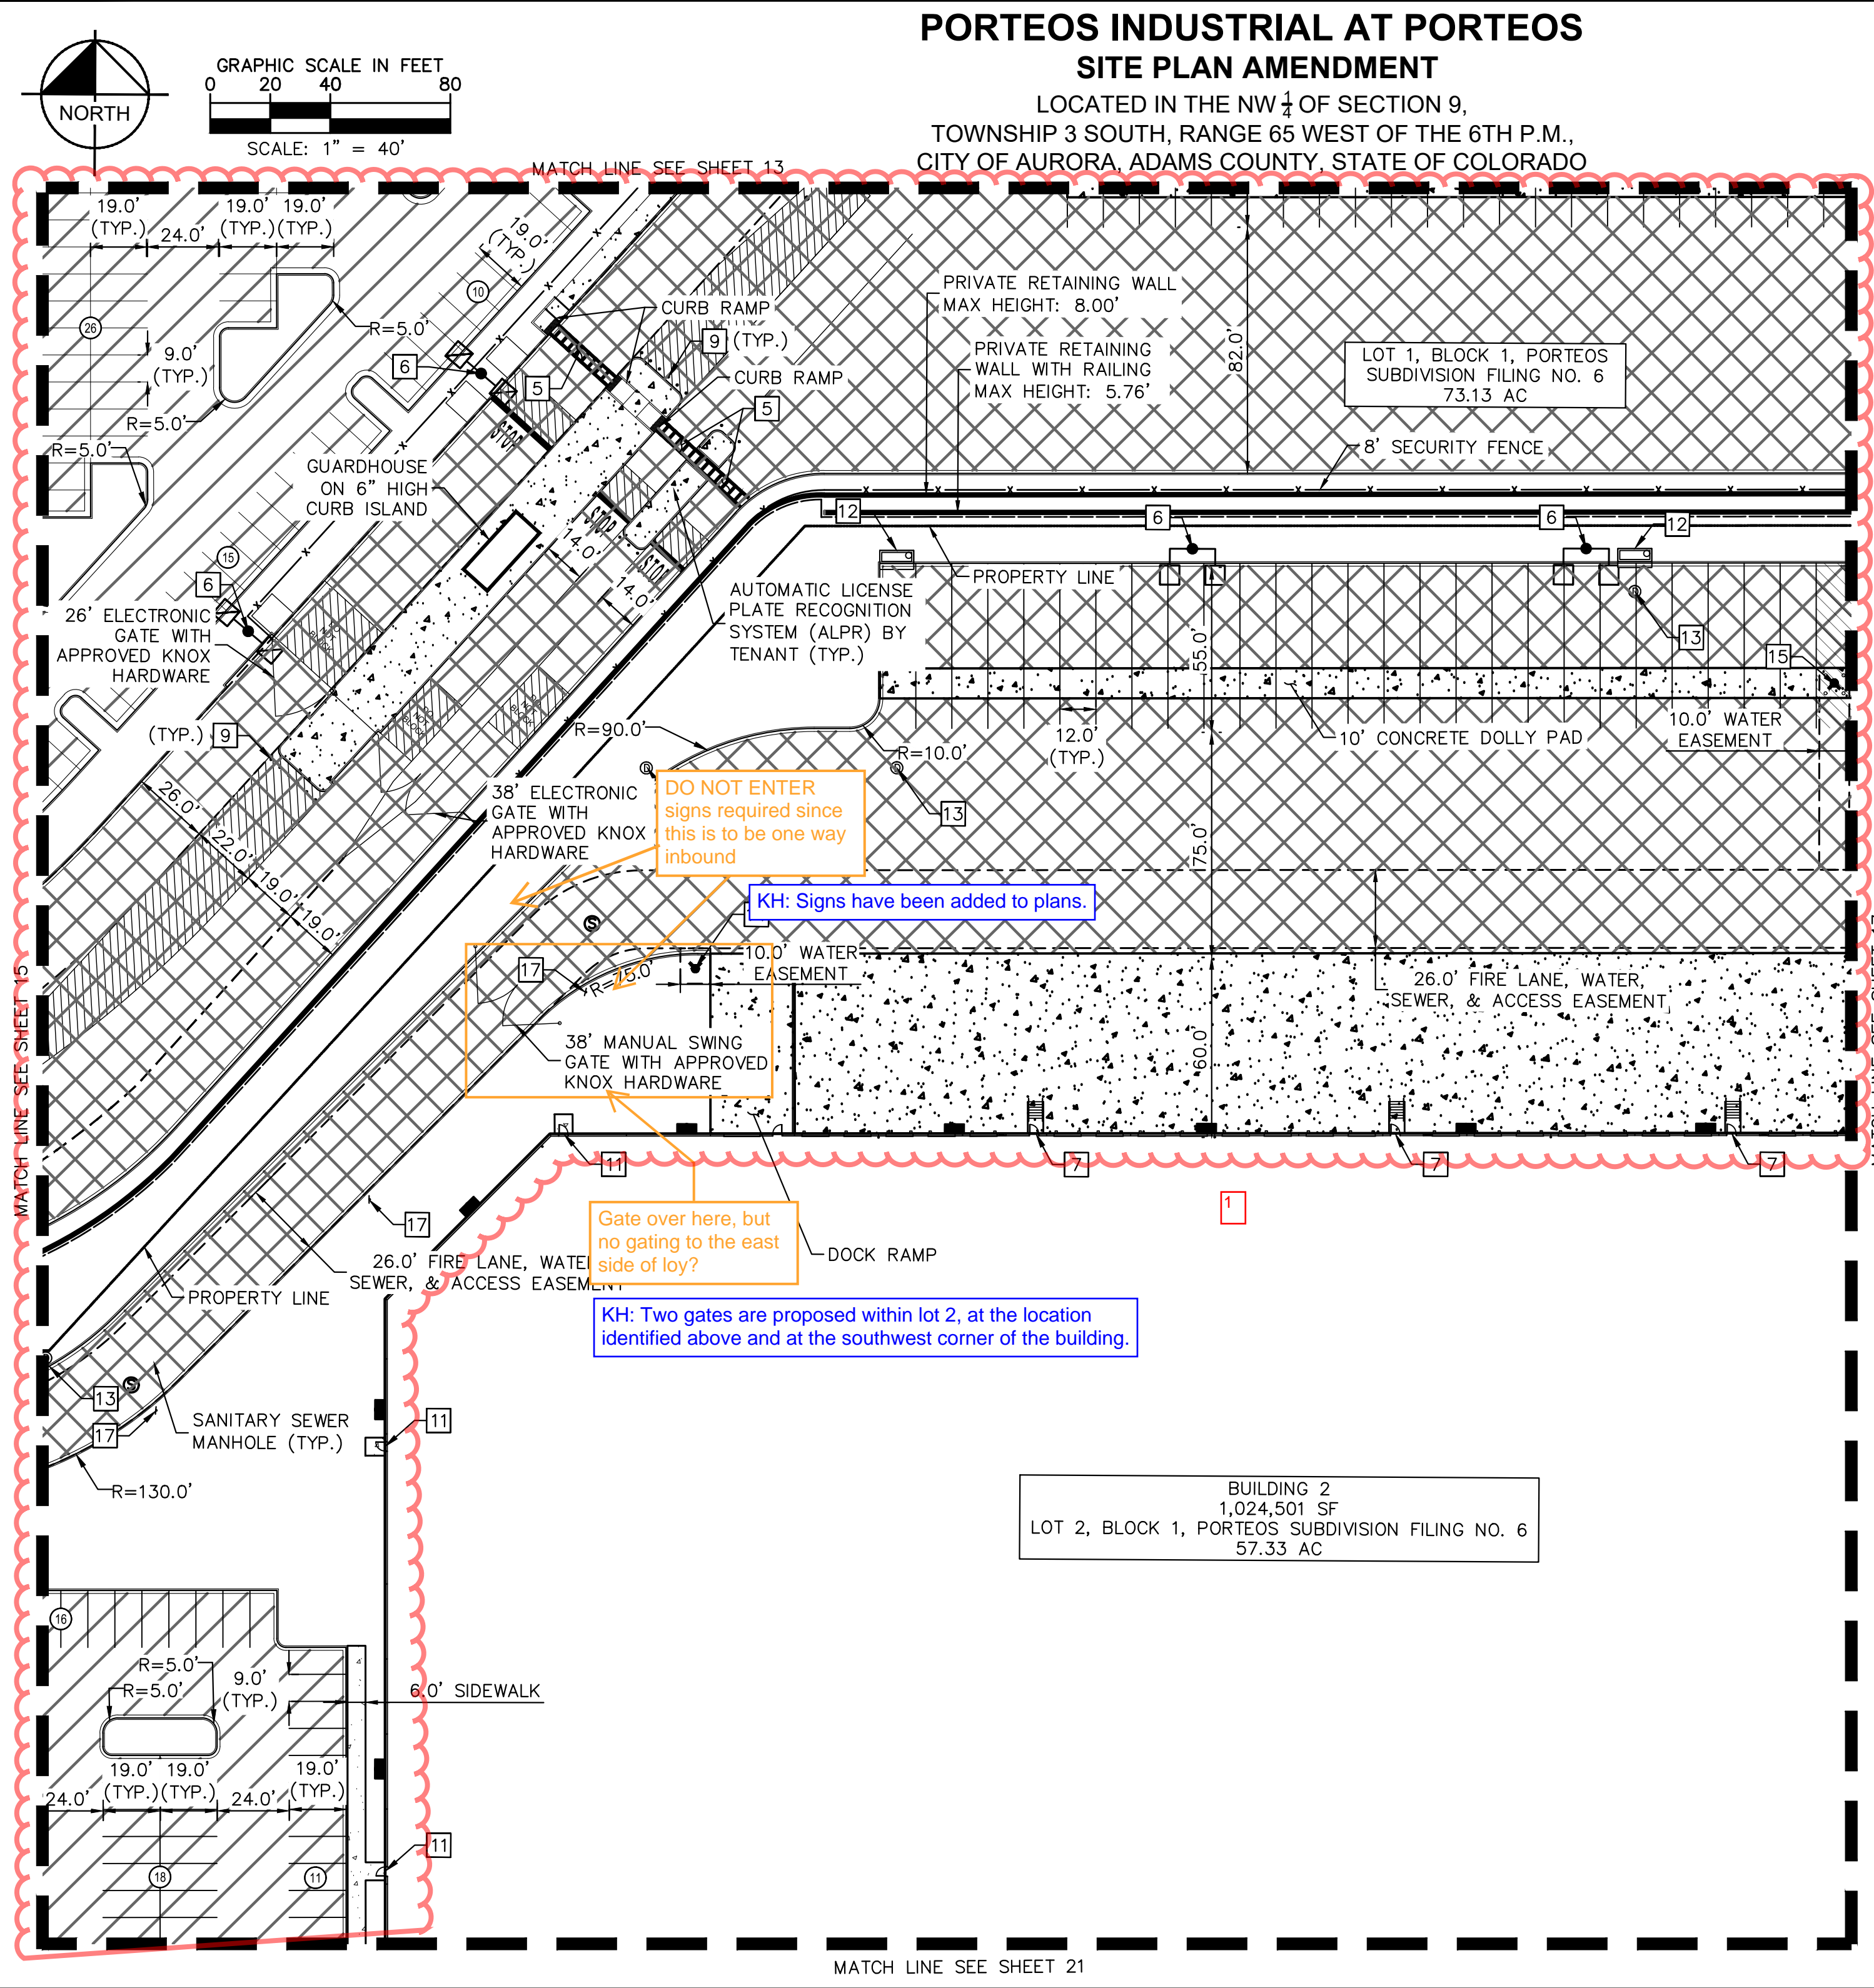

- KEYMAP**
NTS
- LEGEND**
- PROPERTY LINE
 - EASEMENT LINE
 - STEEL SECURITY FENCE
 - ACCESSIBLE ROUTE
 - CONCRETE CURB & GUTTER
 - PAVEMENT SAWCUT LINE
 - PARKING COUNT
 - PAINT STRIPING
 - EXISTING GRAVEL
 - EXISTING CONCRETE
 - CONCRETE SIDEWALK
 - HEAVY DUTY CONCRETE
 - LIGHT DUTY ASPHALT
 - HEAVY DUTY ASPHALT


- SITE PLAN KEYNOTES**
- ACCESSIBLE PARKING SPACES W/ ACCESSIBLE PARKING SIGN
 - VAN ACCESSIBLE PARKING SPACES W/ VAN ACCESSIBLE PARKING SIGN
 - ACCESSIBLE CURB RAMP W/ DETECTIBLE WARNING
 - STOP SIGN
 - PEDESTRIAN CROSSWALK
 - SIGHT LIGHTING
 - STAIRS & BUILDING EGRESS DOOR
 - "NO PARKING FIRE LANE" SIGN
 - BOLLARD
 - BUILDING INGRESS/ENGRESS DOOR
 - BUILDING EGRESS DOOR
 - STORM INLET
 - STORM MANHOLE
 - FIRE HYDRANT, ASSEMBLY PER COA STD. DETAIL 208
 - FIRE HYDRANT W/ BOLLARDS, ASSEMBLY PER COA STD. DETAIL 208
 - SPEED BUMP
 - FIRE LANE SIGN

SITE PLAN NOTES

- ALL RADII AREA 3' AND MEASURED FROM FACE OF CURB UNLESS STATED OTHERWISE.



PORTEOS INDUSTRIAL AT PORTEOS CITY OF AURORA, COUNTY OF ADAMS SITE PLAN AMENDMENT DETAILED SITE PLAN				NO.	REVISION	BY	DATE	APPR
FILE NO. 196617002_SP DTL-DIA II	PROJECT NO. 196617002	DATE: 03/22/2024	DESIGNED BY: CAO	DRAWN BY: AGM CHECKED BY: BJC				
SHEET NO.				16				

k:\DEN_Civil\196617002 DIA1\CADD\PlanSheets\CSP\196617002_SP DTL-DIA II.dwg OKeeffe, Sam 3/27/2024 12:37 PM

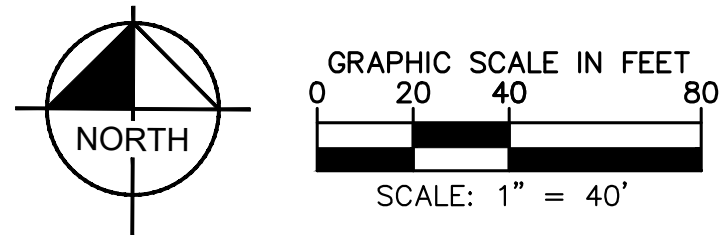

PORTEOS INDUSTRIAL AT PORTEOS SITE PLAN AMENDMENT

LOCATED IN THE NW $\frac{1}{4}$ OF SECTION 9,
TOWNSHIP 3 SOUTH, RANGE 65 WEST OF THE 6TH P.M.,
CITY OF AURORA, ADAMS COUNTY, STATE OF COLORADO

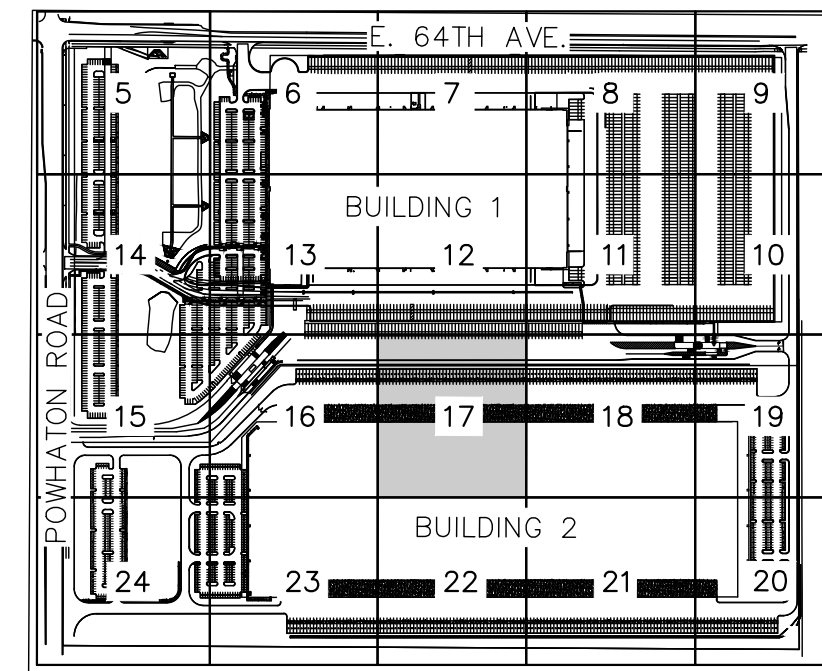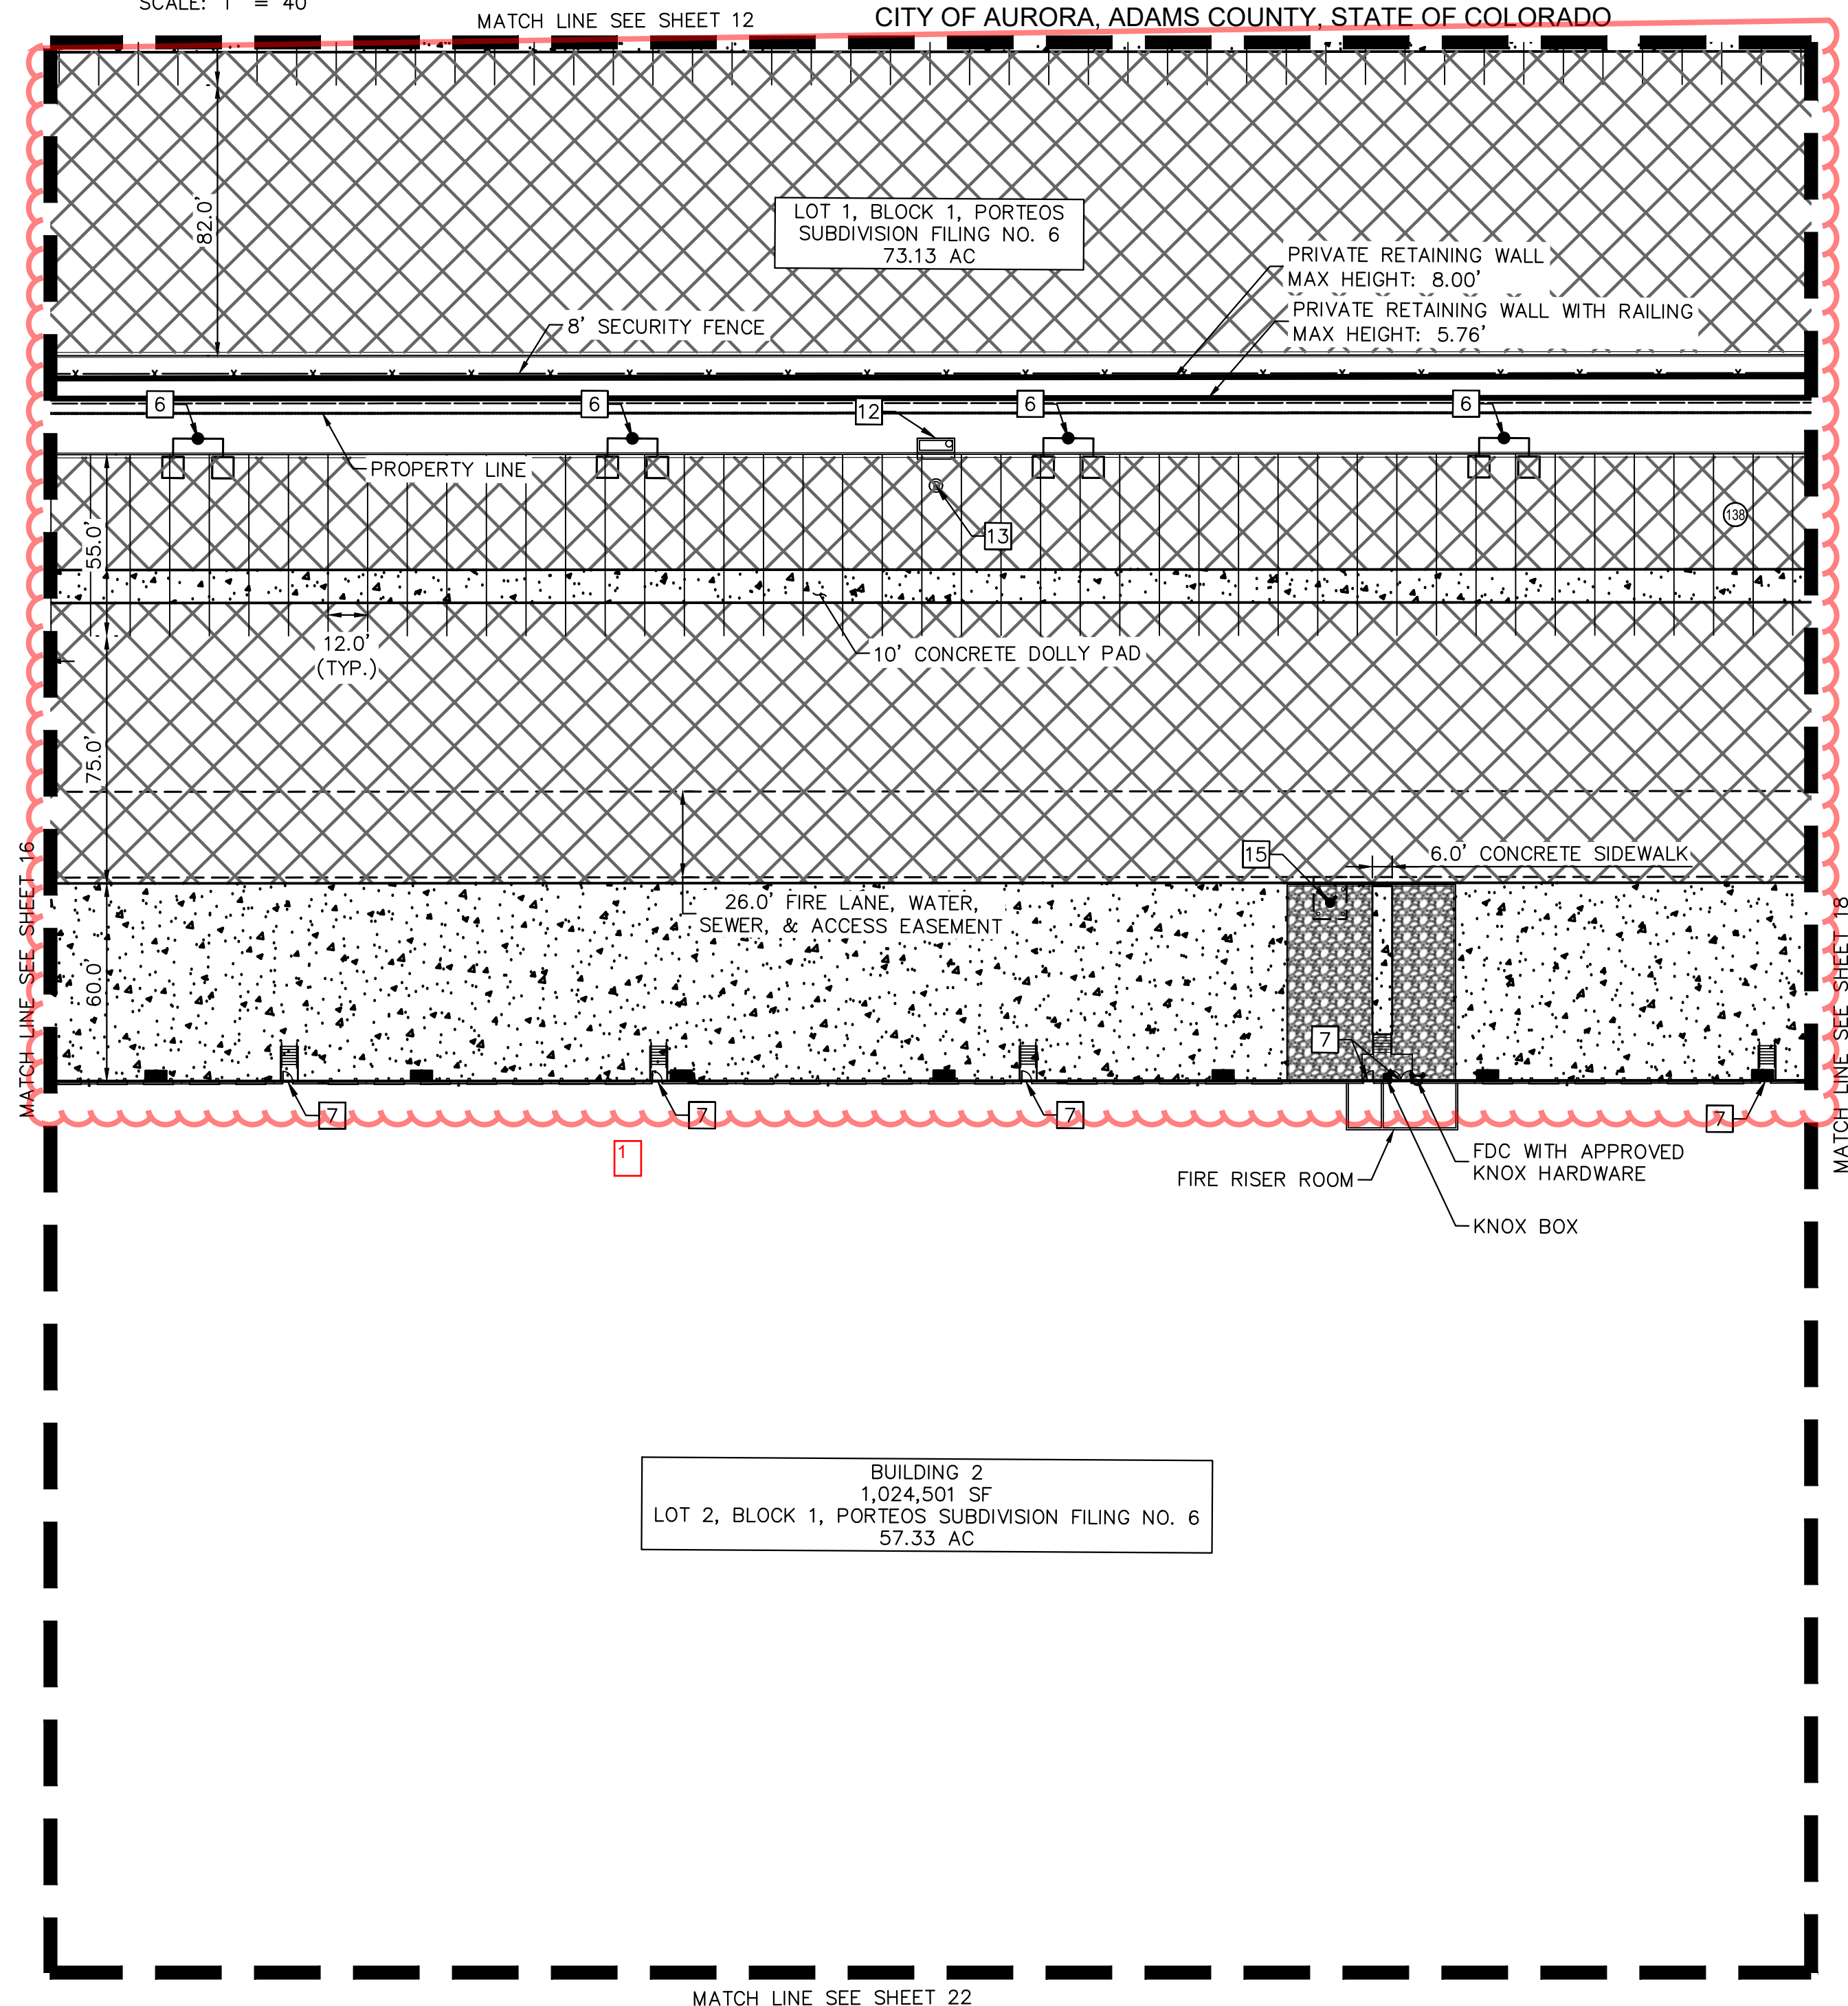

KEYMAP
NTS

LEGEND

- PROPERTY LINE
- EASEMENT LINE
- STEEL SECURITY FENCE
- ACCESSIBLE ROUTE
- CONCRETE CURB & GUTTER
- PAVEMENT SAWCUT LINE
- PARKING COUNT
- PAINT STRIPING
- EXISTING GRAVEL
- EXISTING CONCRETE
- CONCRETE SIDEWALK
- HEAVY DUTY CONCRETE
- LIGHT DUTY ASPHALT
- HEAVY DUTY ASPHALT

SITE PLAN KEYNOTES

- ACCESSIBLE PARKING SPACES W/ ACCESSIBLE PARKING SIGN
- VAN ACCESSIBLE PARKING SPACES W/ VAN ACCESSIBLE PARKING SIGN
- ACCESSIBLE CURB RAMP W/ DETECTIBLE WARNING
- STOP SIGN
- PEDESTRIAN CROSSWALK
- SIGHT LIGHTING
- STAIRS & BUILDING EGRESS DOOR
- "NO PARKING FIRE LANE" SIGN
- BOLLARD
- BUILDING INGRESS/ENGRESS DOOR
- BUILDING EGRESS DOOR
- STORM INLET
- STORM MANHOLE
- FIRE HYDRANT, ASSEMBLY PER COA STD. DETAIL 208
- FIRE HYDRANT W/ BOLLARDS, ASSEMBLY PER COA STD. DETAIL 208
- SPEED BUMP
- FIRE LANE SIGN

SITE PLAN NOTES

- ALL RADII AREA 3' AND MEASURED FROM FACE OF CURB UNLESS STATED OTHERWISE.

Kimley»Horn

KIMLEY-HORN AND ASSOCIATES, INC.
6205 S. HARRISON
GREENWOOD VILLAGE, CO 80111 (303) 228-2300



PORTEOS INDUSTRIAL AT PORTEOS
CITY OF AURORA, COUNTY OF ADAMS
SITE PLAN AMENDMENT
DETAILED SITE PLAN

DATE: 03/22/2024
DESIGNED BY: CAO
DRAWN BY: AGM
CHECKED BY: BJC

FILE NO.
196617002_SP DTL-DIA II
PROJECT NO.
196617002

SHEET NO.

K:\DEN_Civil\196617002 DIA\CADD\PlanSheets\CSP\196617002_SP DTL-DIA II.dwg OKeeffe, Sam 3/27/2024 12:37 PM

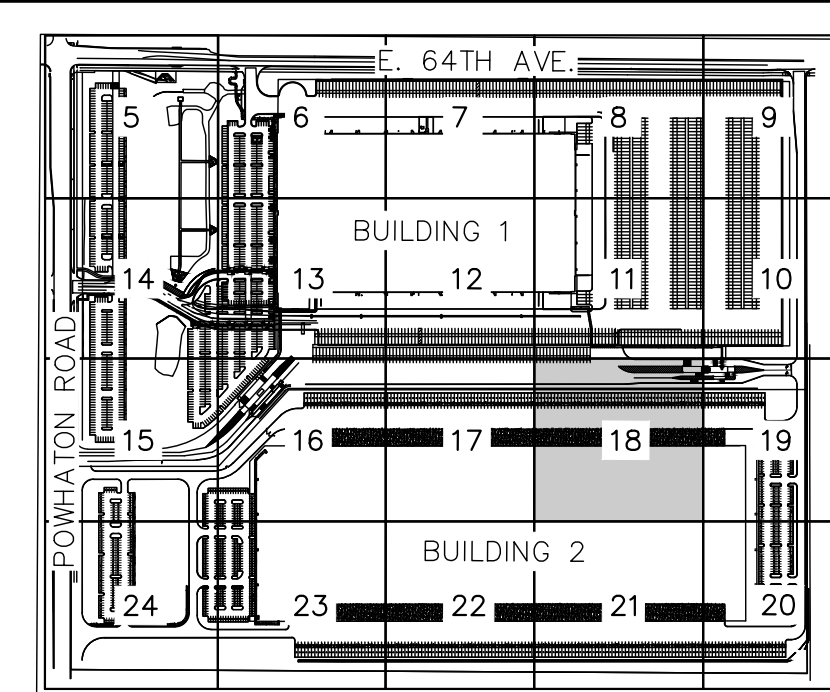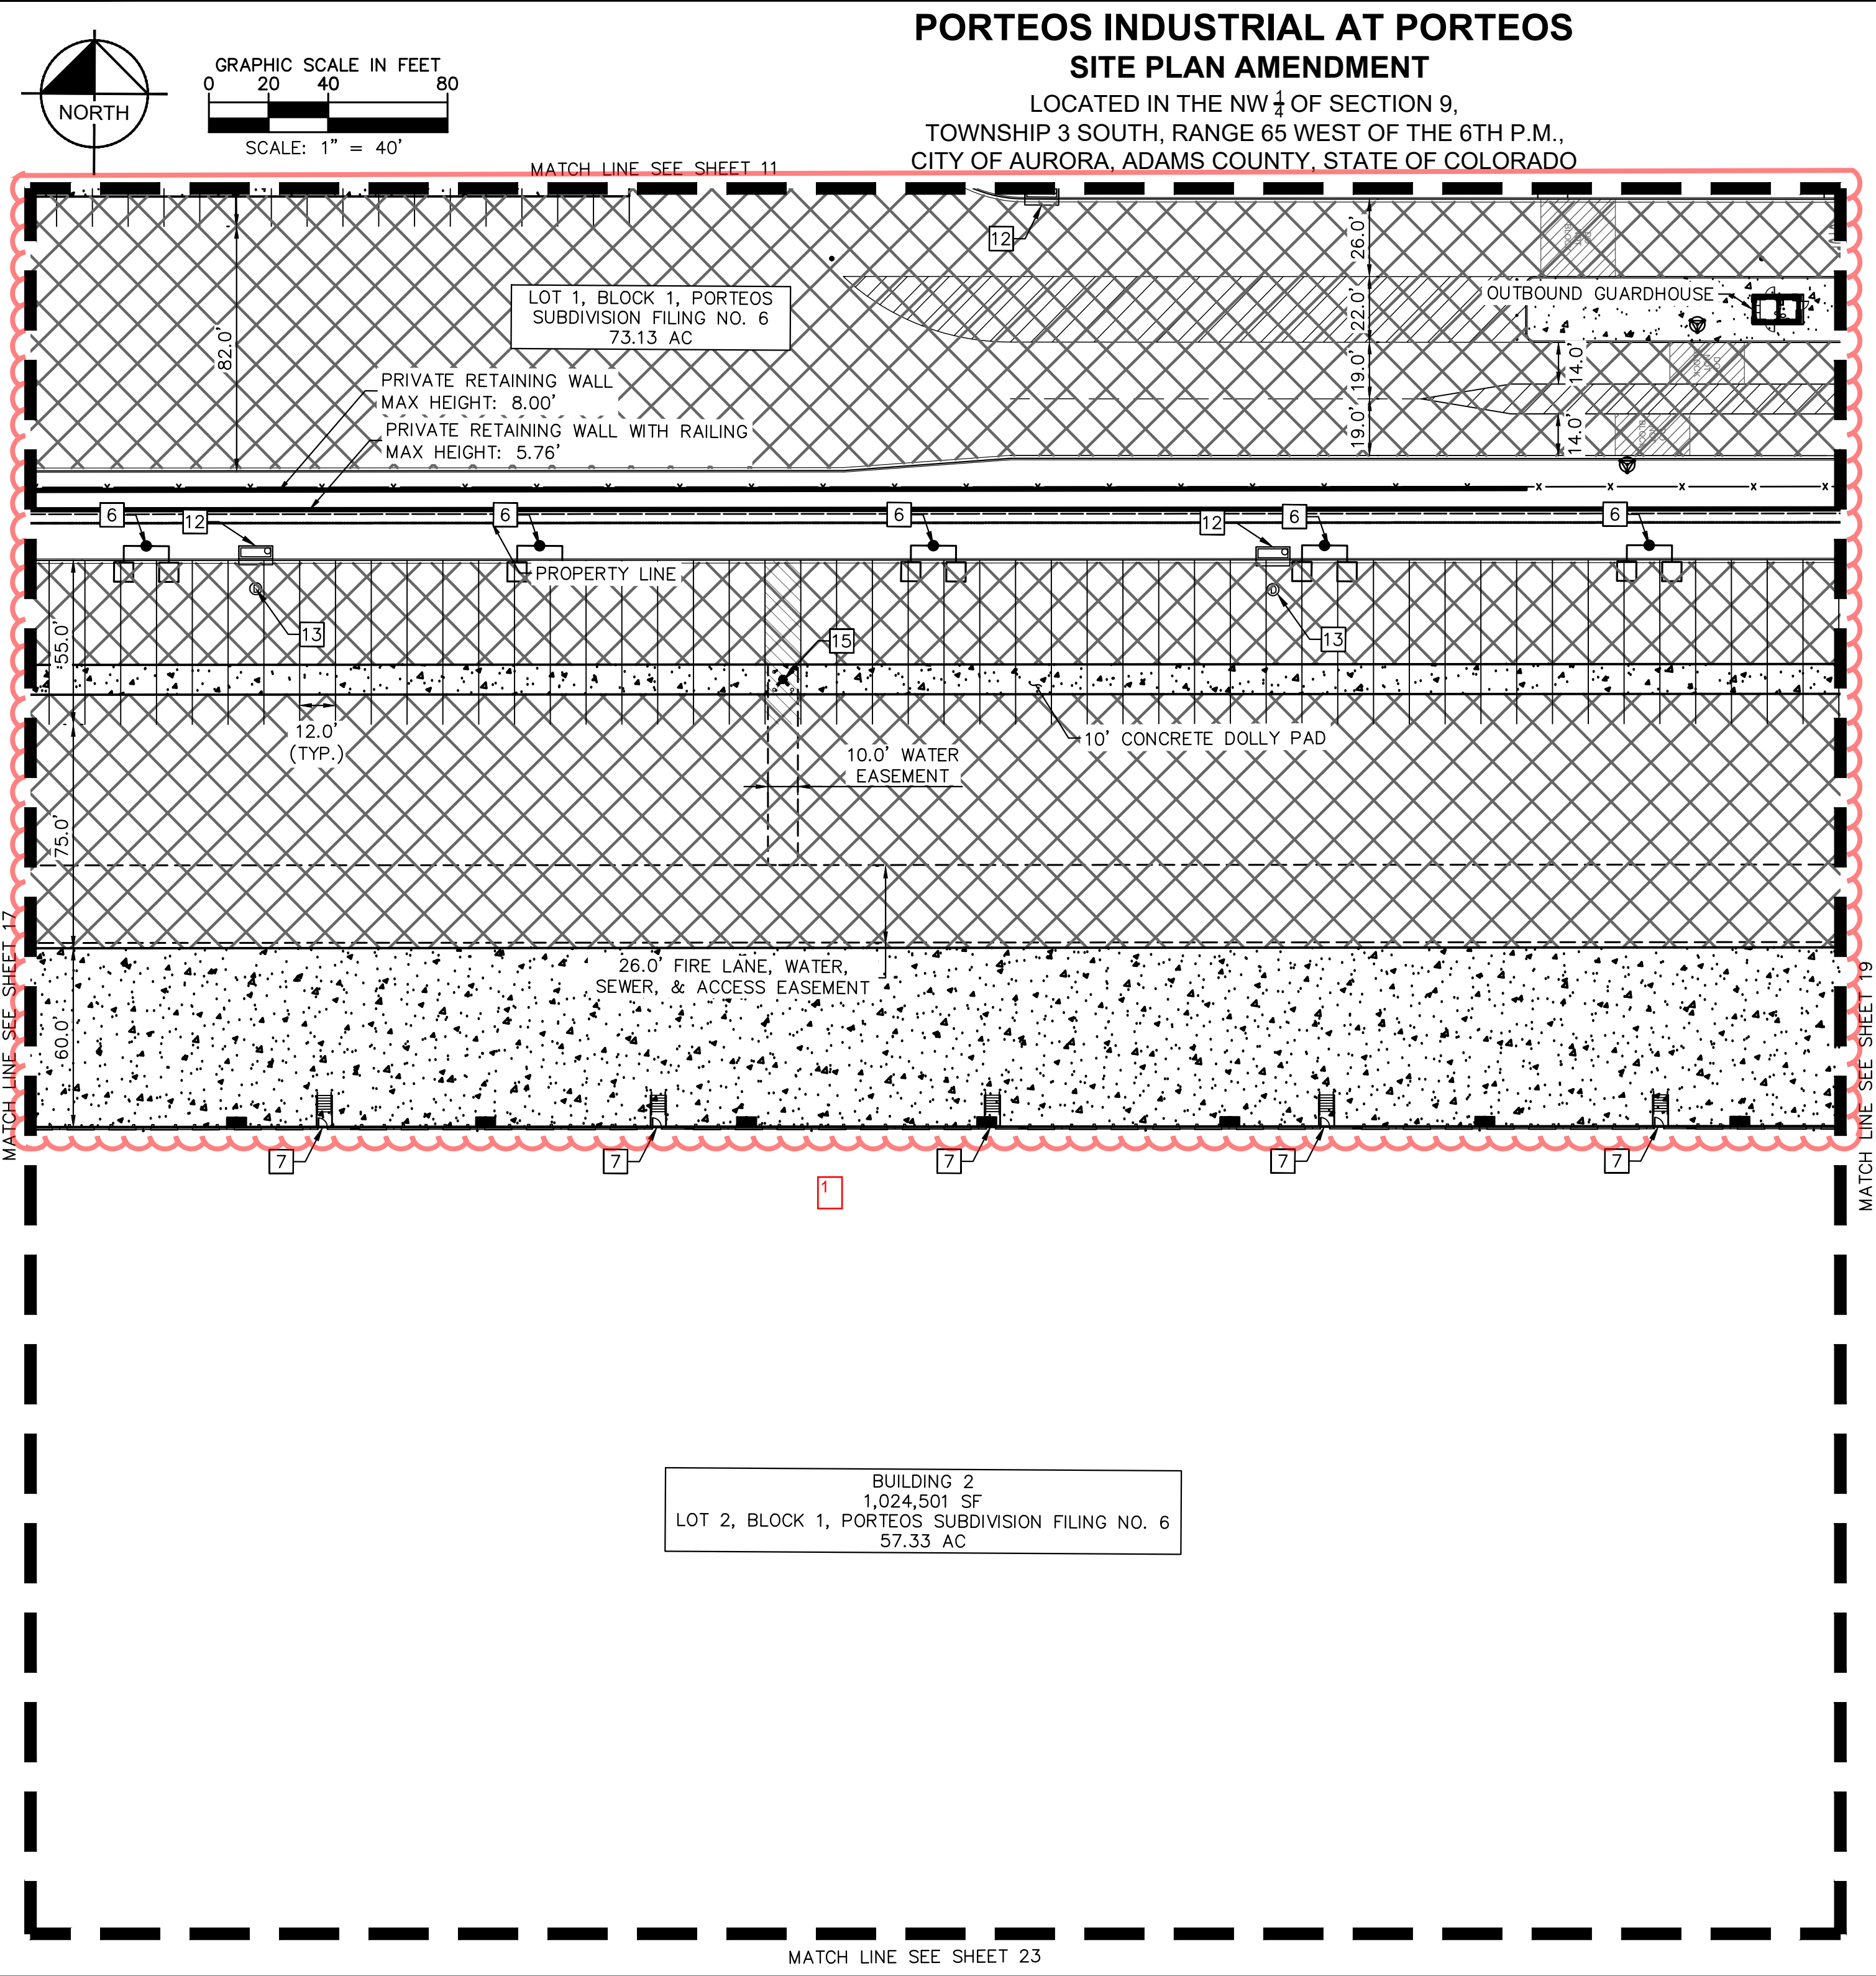

- LEGEND**
- PROPERTY LINE
 - EASEMENT LINE
 - STEEL SECURITY FENCE
 - ACCESSIBLE ROUTE
 - CONCRETE CURB & GUTTER
 - PAVEMENT SAWCUT LINE
 - PARKING COUNT
 - PAINT STRIPING
 - EXISTING GRAVEL
 - EXISTING CONCRETE
 - CONCRETE SIDEWALK
 - HEAVY DUTY CONCRETE
 - LIGHT DUTY ASPHALT
 - HEAVY DUTY ASPHALT



- SITE PLAN KEYNOTES**
- ACCESSIBLE PARKING SPACES W/ ACCESSIBLE PARKING SIGN
 - VAN ACCESSIBLE PARKING SPACES W/ VAN ACCESSIBLE PARKING SIGN
 - ACCESSIBLE CURB RAMP W/ DETECTIBLE WARNING
 - STOP SIGN
 - PEDESTRIAN CROSSWALK
 - SIGHT LIGHTING
 - STAIRS & BUILDING EGRESS DOOR
 - "NO PARKING FIRE LANE" SIGN
 - BOLLARD
 - BUILDING INGRESS/ENGRESS DOOR
 - BUILDING EGRESS DOOR
 - STORM INLET
 - STORM MANHOLE
 - FIRE HYDRANT, ASSEMBLY PER COA STD. DETAIL 208
 - FIRE HYDRANT W/ BOLLARDS, ASSEMBLY PER COA STD. DETAIL 208
 - SPEED BUMP
 - FIRE LANE SIGN

SITE PLAN NOTES

- ALL RADII AREA 3' AND MEASURED FROM FACE OF CURB UNLESS STATED OTHERWISE.

PORTEOS INDUSTRIAL AT PORTEOS CITY OF AURORA, COUNTY OF ADAMS SITE PLAN AMENDMENT DETAILED SITE PLAN				NO.	REVISION	BY	DATE	APPR
FILE NO. 196617002_SP DTL-DIA II	PROJECT NO. 196617002	DATE: 03/22/2024	DESIGNED BY: CAO	DRAWN BY: AGM				
SHEET NO.				CHECKED BY: BJC				
18								

K:\DEN_Civil\196617002 DIA\1\CADD\PlanSheets\CSP\196617002_SP DTL-DIA II.dwg OKeeffe, Sam 3/27/2024 12:38 PM

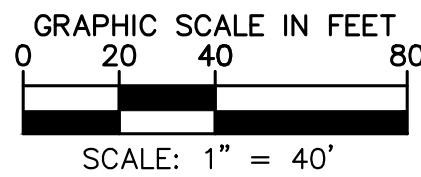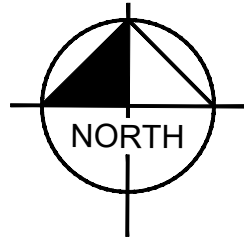


PORTEOS INDUSTRIAL AT PORTEOS SITE PLAN AMENDMENT

LOCATED IN THE NW 1/4 OF SECTION 9,
TOWNSHIP 3 SOUTH, RANGE 65 WEST OF THE 6TH P.M.,
CITY OF AURORA, ADAMS COUNTY, STATE OF COLORADO

Use lot and block names,
description, areas and
easement info. from
Porteos Subdivision Filing
No. 7. Typical, all sheets.

KH: Text has been updated to match
Porteos Subdivision Filing No. 7.

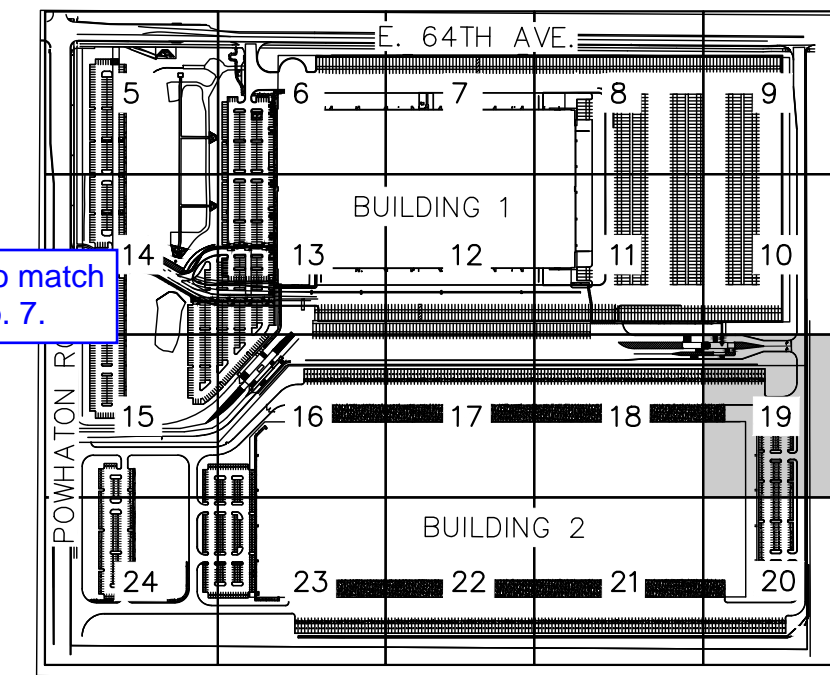

LEGEND


- PROPERTY LINE
- EASEMENT LINE
- STEEL SECURITY FENCE
- ACCESSIBLE ROUTE
- CONCRETE CURB & GUTTER
- PAVEMENT SAWCUT LINE
- PARKING COUNT
- PAINT STRIPING
- EXISTING GRAVEL
- EXISTING CONCRETE
- CONCRETE SIDEWALK
- HEAVY DUTY CONCRETE
- LIGHT DUTY ASPHALT
- HEAVY DUTY ASPHALT

SITE PLAN KEYNOTES

- ACCESSIBLE PARKING SPACES W/ ACCESSIBLE PARKING SIGN
- PARKING SPACES W/ VAN ACCESSIBLE PARKING SIGN
- ACCESSIBLE CURB RAMP W/ DETECTIBLE WARNING
- STOP SIGN
- PEDESTRIAN CROSSWALK
- SIGHT LIGHTING
- STAIRS & BUILDING EGRESS DOOR
- "NO PARKING FIRE LANE" SIGN
- BOLLARD
- BUILDING INGRESS/ENGRESS DOOR
- BUILDING EGRESS DOOR
- STORM INLET
- STORM MANHOLE
- FIRE HYDRANT, ASSEMBLY PER COA STD. DETAIL 208
- FIRE HYDRANT W/ BOLLARDS, ASSEMBLY PER COA STD. DETAIL 208
- SPEED BUMP
- FIRE LANE SIGN

SITE PLAN NOTES

- ALL RADII AREA 3' AND MEASURED FROM FACE OF CURB UNLESS STATED OTHERWISE.

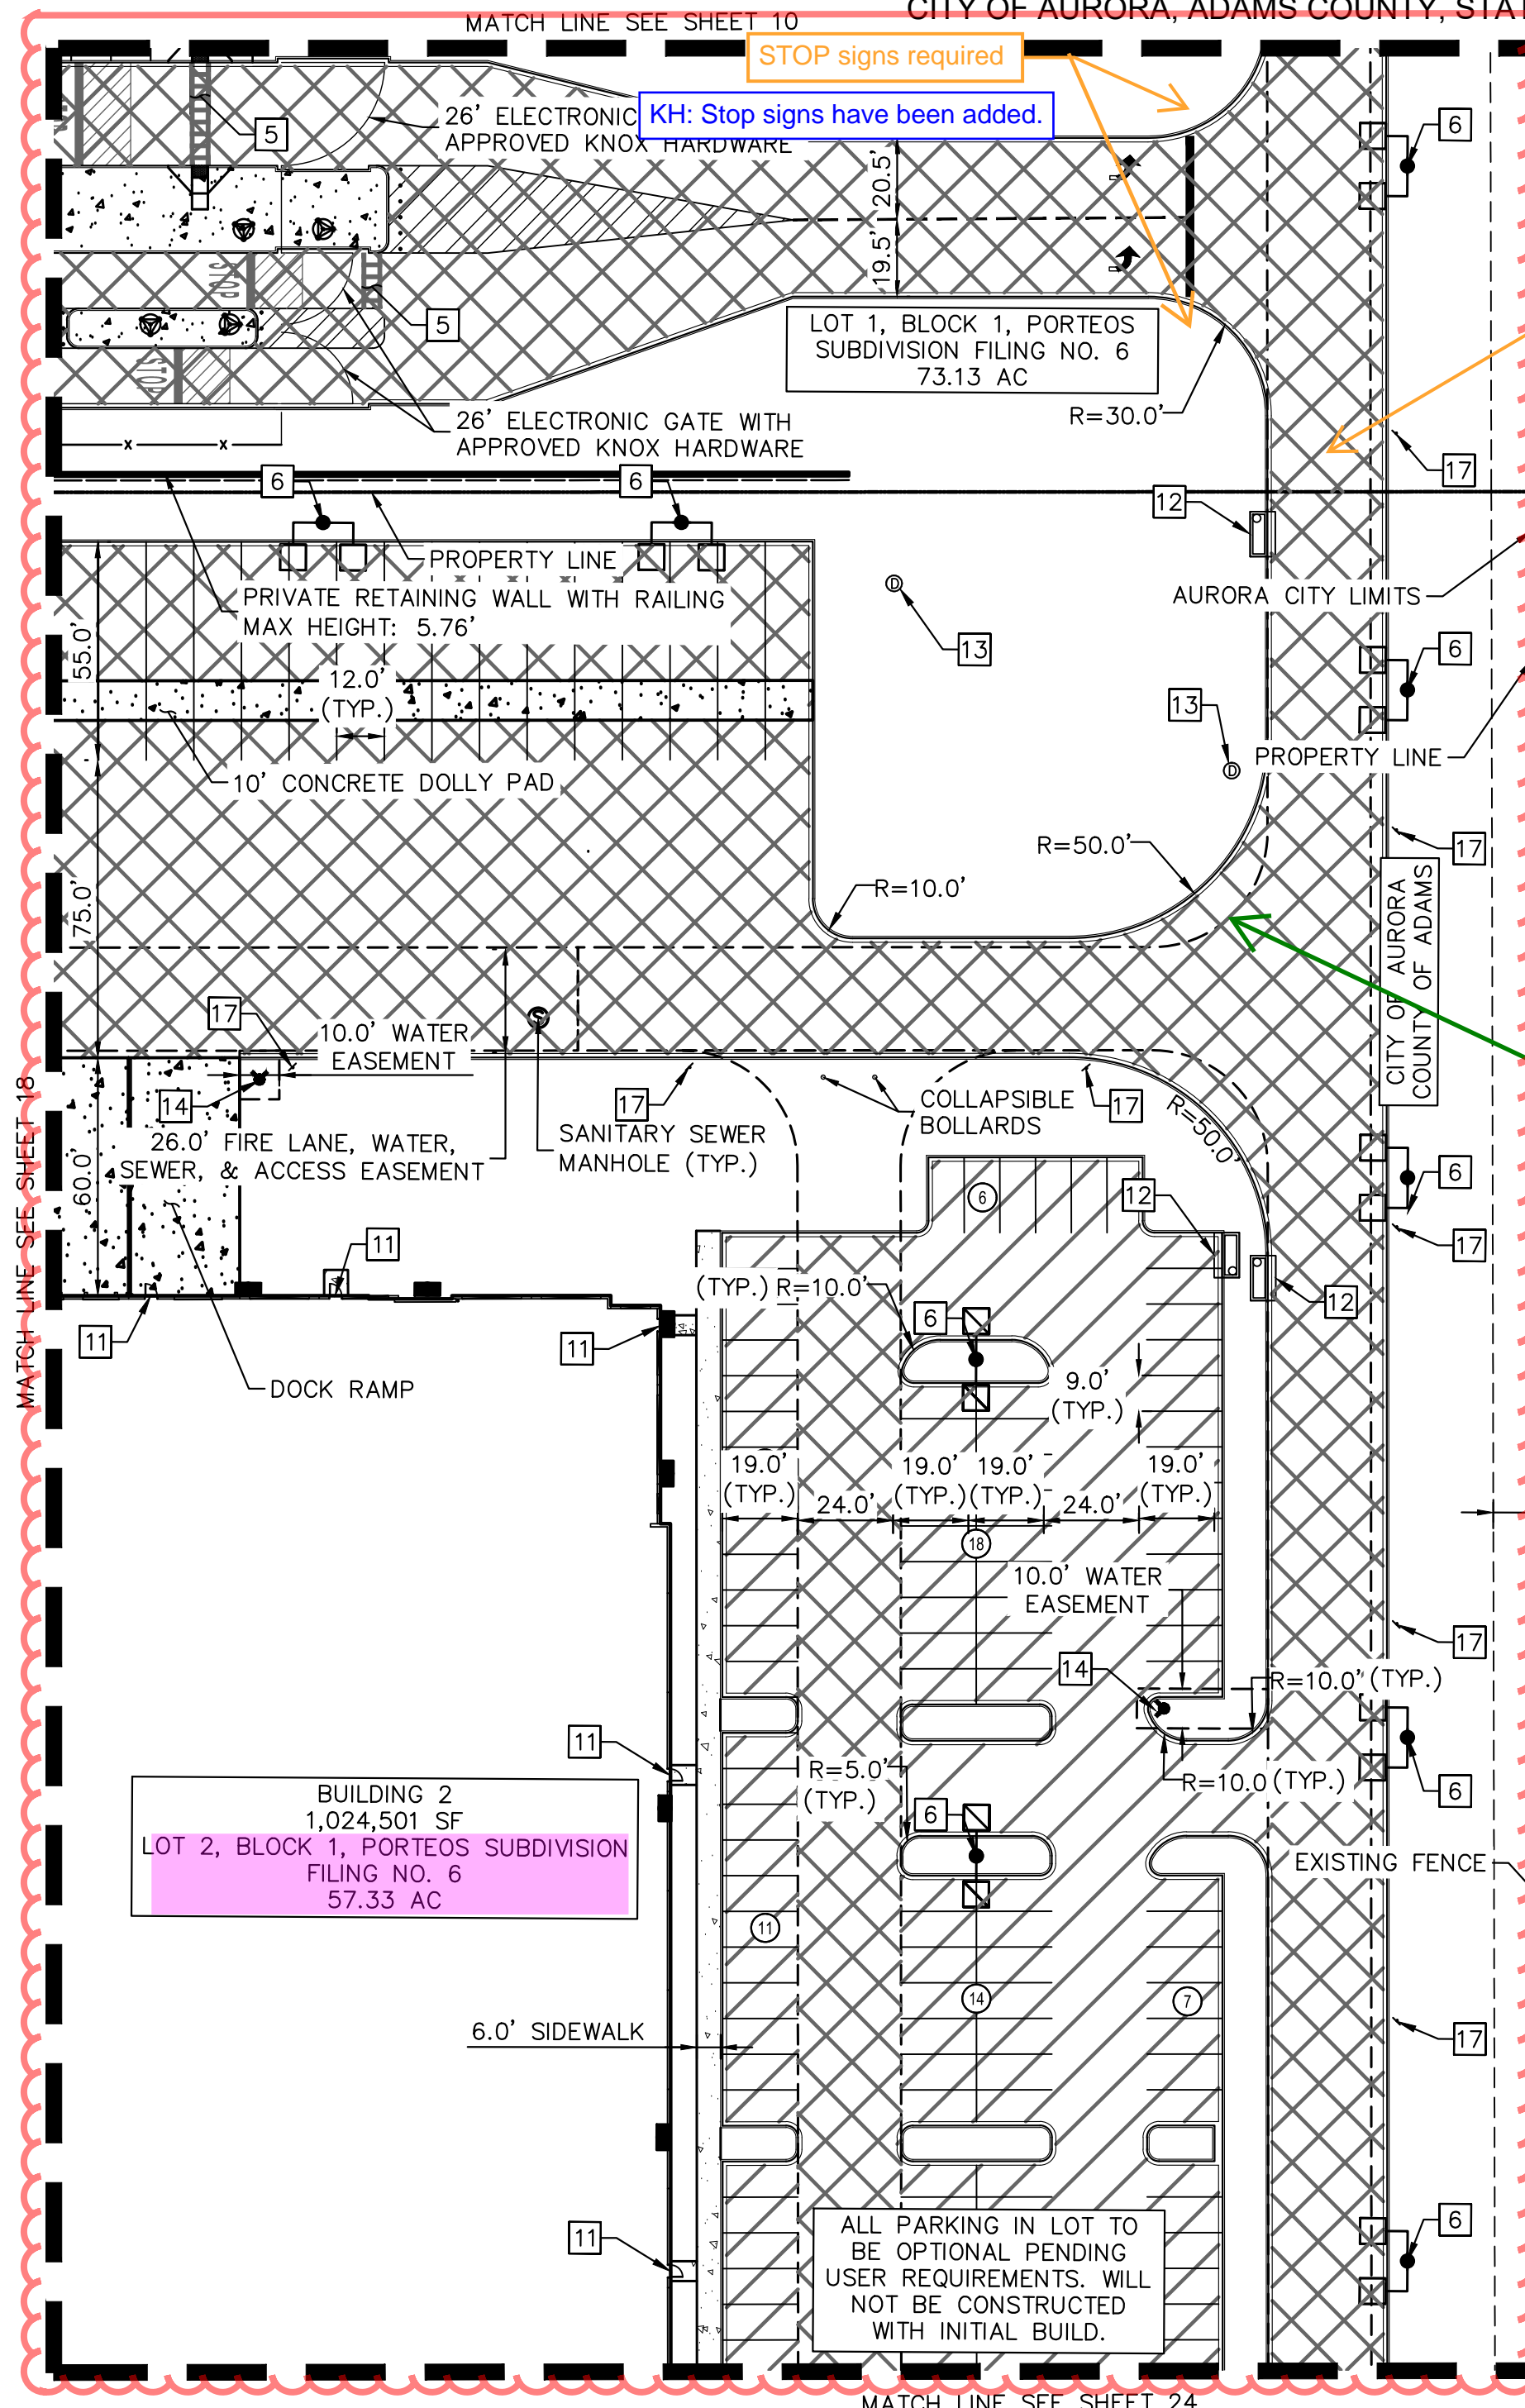

OWNER: CITY AND COUNTY OF
DENVER ATTN: REAL ESTATE DEPT
JURISDICTION: ADAMS COUNTY

MATCH LINE SEE SHEET 24

Kimley»Horn



PORTEOS INDUSTRIAL AT PORTEOS
CITY OF AURORA, COUNTY OF ADAMS
SITE PLAN AMENDMENT
DETAILED SITE PLAN

DATE: 03/22/2024
DESIGNED BY: CAO
DRAWN BY: AGM
CHECKED BY: BUC

FILE NO.
196617002_SP DTL-DIA II
PROJECT NO.
196617002



SHEET NO.

K:\DEN_Civil\196617002 DIA1\CADD\PlanSheets\CSP\196617002_SP DTL-DIA II.dwg OKeeffe, Sam 3/27/2024 8:11 AM

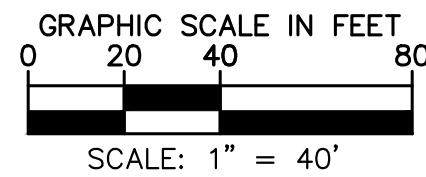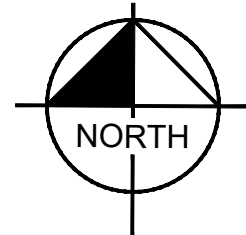

PORTEOS INDUSTRIAL AT PORTEOS SITE PLAN AMENDMENT

LOCATED IN THE NW $\frac{1}{4}$ OF SECTION 9,
TOWNSHIP 3 SOUTH, RANGE 65 WEST OF THE 6TH P.M.,
CITY OF AURORA, ADAMS COUNTY, STATE OF COLORADO

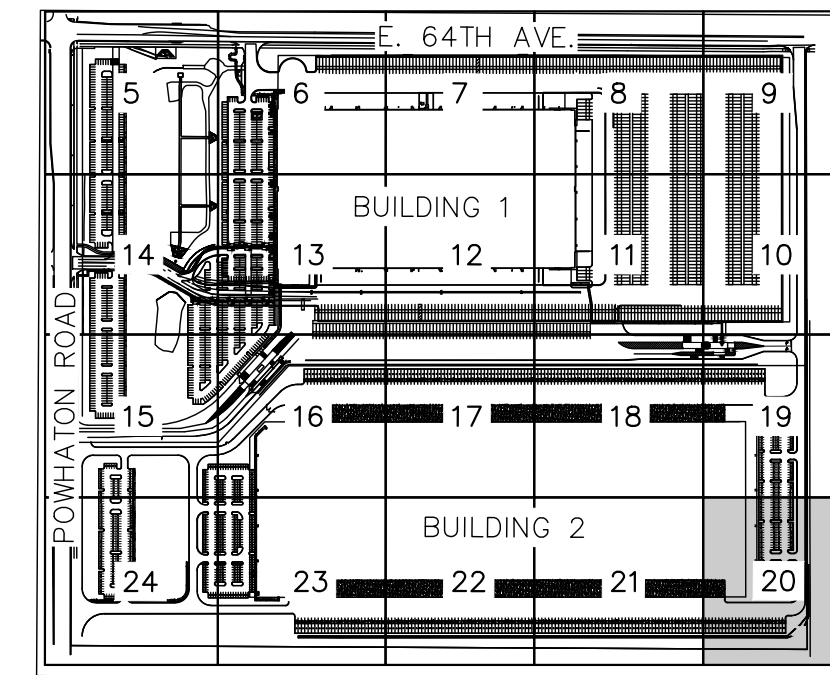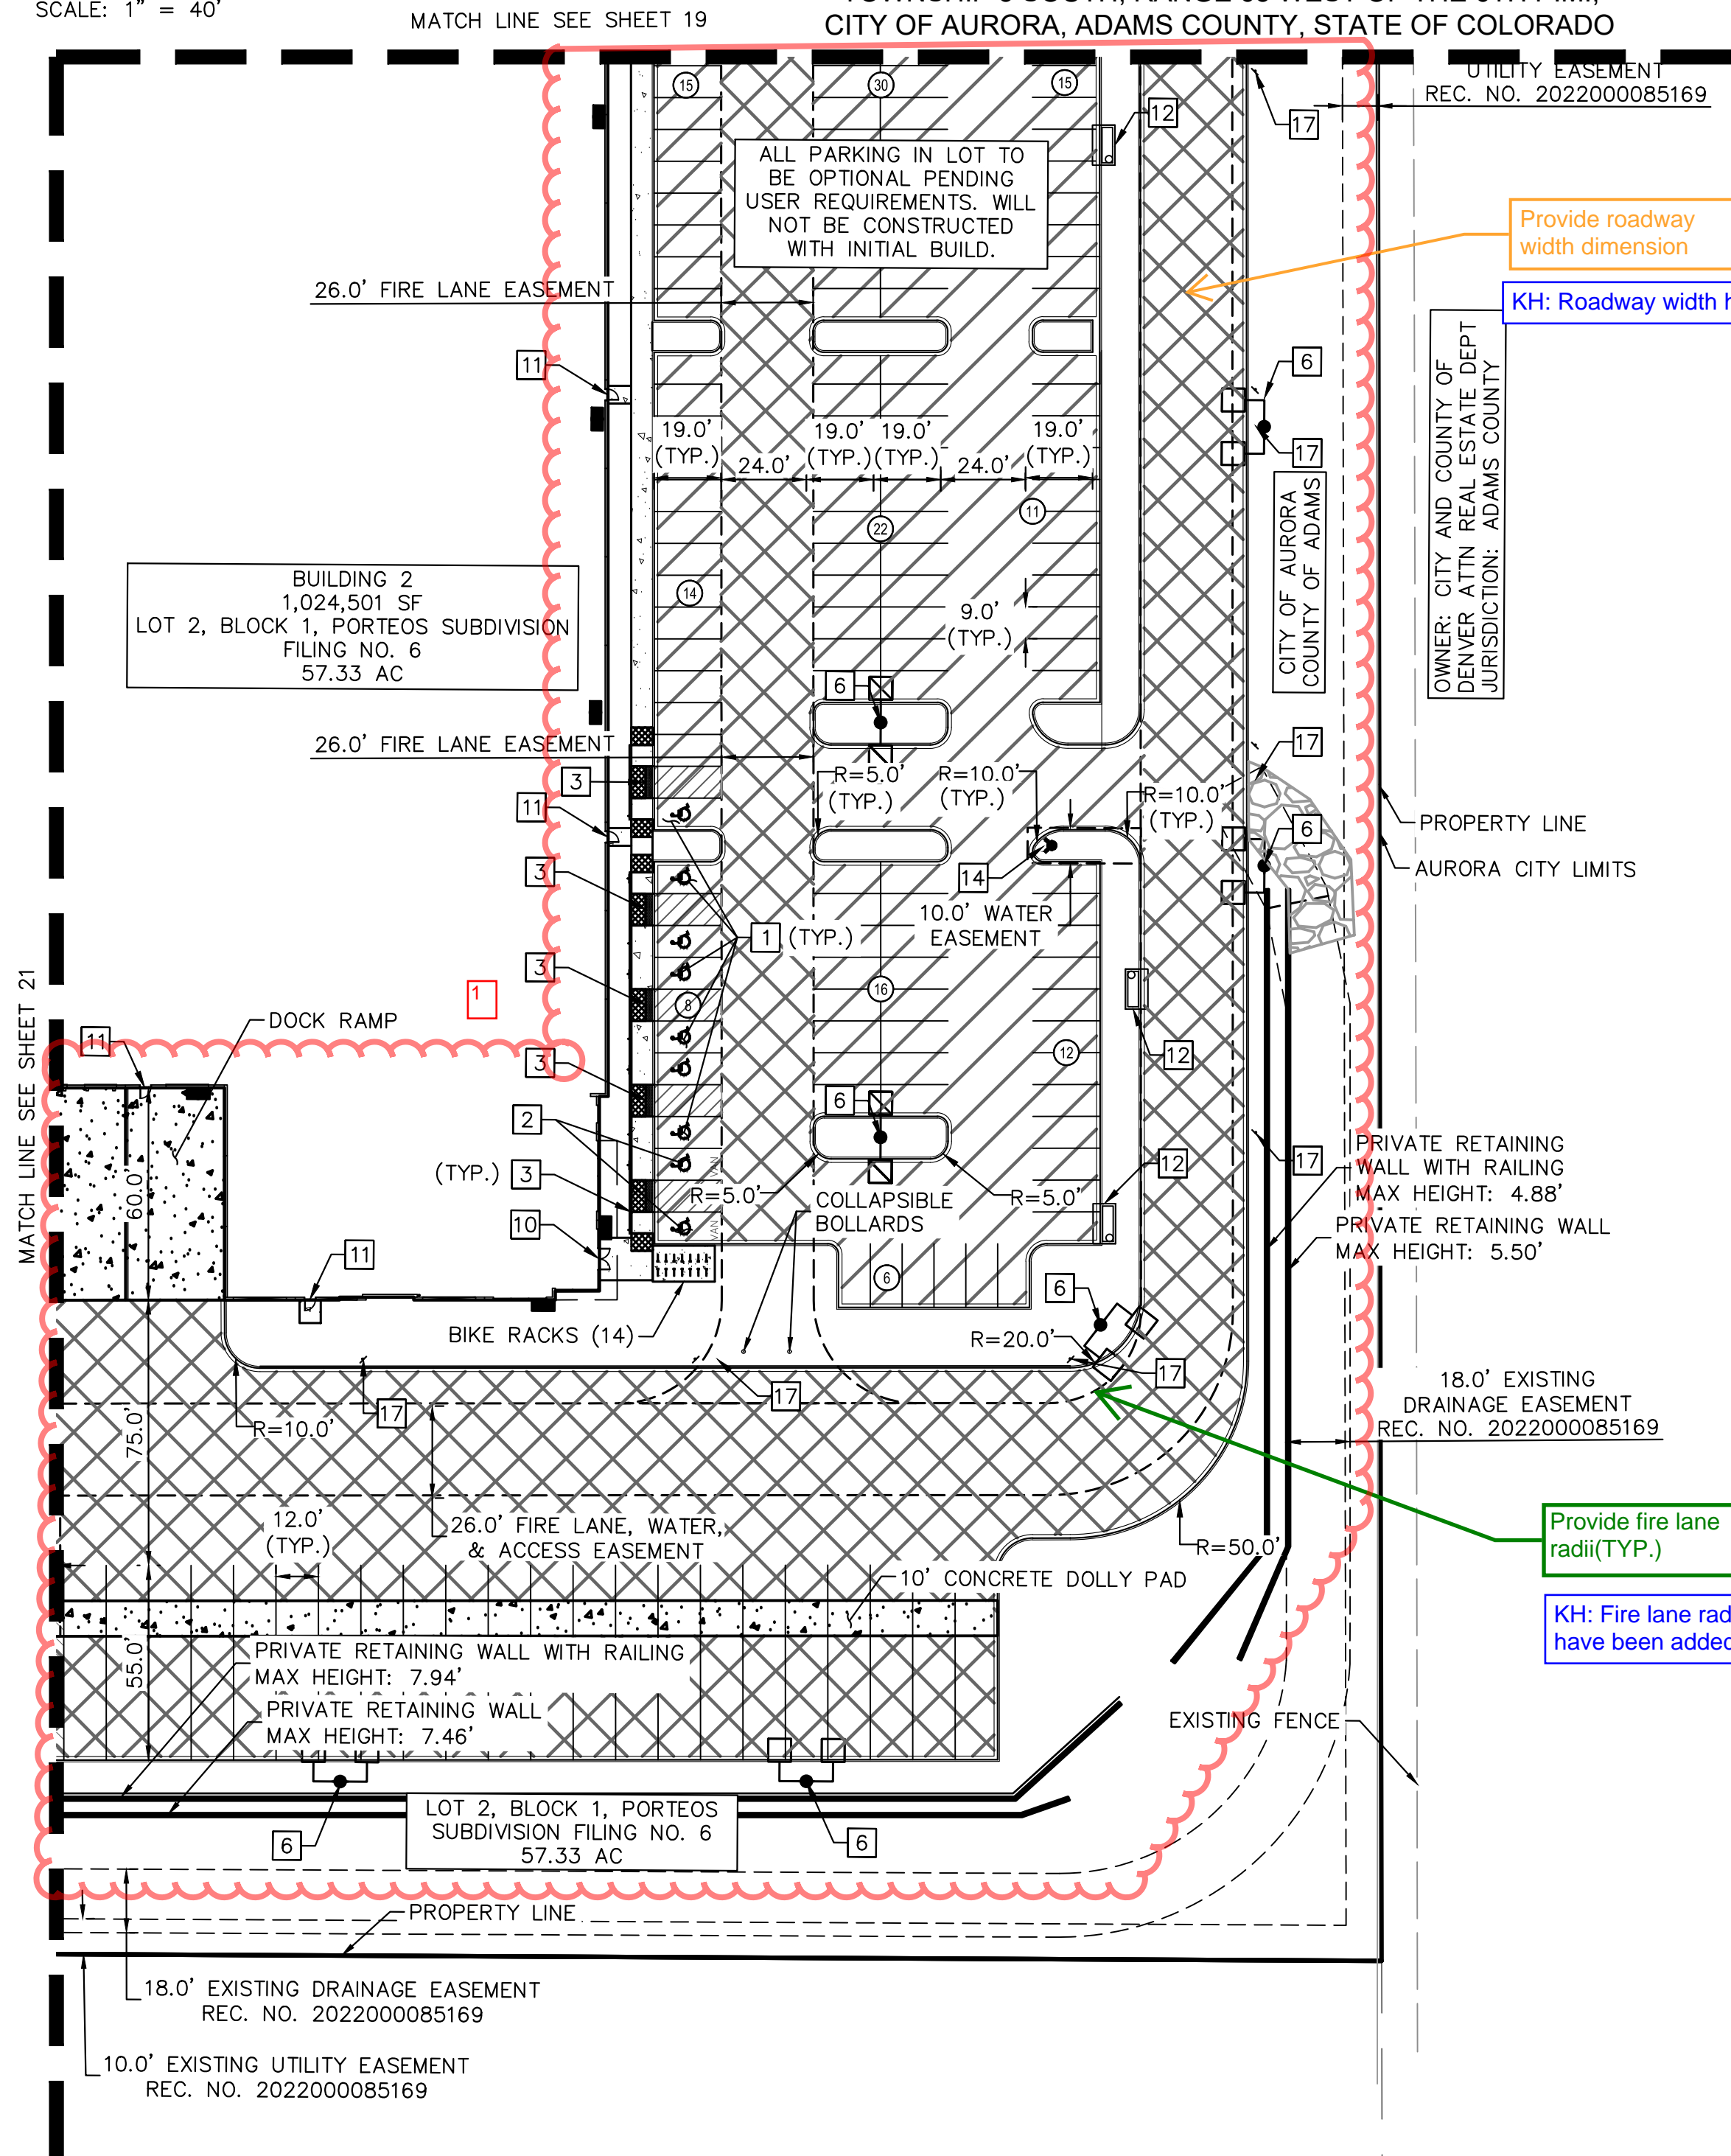

LEGEND

	PROPERTY LINE
	EASEMENT LINE
	STEEL SECURITY FENCE
	ACCESSIBLE ROUTE
	CONCRETE CURB & GUTTER
	PARKING COUNT
	PAINT STRIPING
	EXISTING GRAVEL
	EXISTING CONCRETE
	CONCRETE SIDEWALK
	HEAVY DUTY CONCRETE
	LIGHT DUTY ASPHALT
	HEAVY DUTY ASPHALT

SITE PLAN KEYNOTES

- 1 ACCESSIBLE PARKING SPACES W/ ACCESSIBLE PARKING SIGN
- 2 VAN ACCESSIBLE PARKING SPACES W/ VAN ACCESSIBLE PARKING SIGN
- 3 ACCESSIBLE CURB RAMP W/ DETECTIBLE WARNING
- 4 STOP SIGN
- 5 PEDESTRIAN CROSSWALK
- 6 SIGHT LIGHTING
- 7 STAIRS & BUILDING EGRESS DOOR
- 8 "NO PARKING FIRE LANE" SIGN
- 9 BOLLARD
- 10 BUILDING INGRESS/ENGRESS DOOR
- 11 BUILDING EGRESS DOOR
- 12 STORM INLET
- 13 STORM MANHOLE
- 14 FIRE HYDRANT, ASSEMBLY PER COA STD. DETAIL 208
- 15 FIRE HYDRANT W/ BOLLARDS, ASSEMBLY PER COA STD. DETAIL 208
- 16 SPEED BUMP
- 17 FIRE LANE SIGN

SITE PLAN NOTES

1. ALL RADII AREA 3' AND MEASURED FROM FACE OF CURB UNLESS STATED OTHERWISE.

Kimley»Horn

KIMLEY-HORN AND ASSOCIATES, INC.
6205 S. W. 11th Ave.
Greenwood Village, CO 80111 (303) 228-2300



PORTEOS INDUSTRIAL AT PORTEOS
CITY OF AURORA, COUNTY OF ADAMS
SITE PLAN AMENDMENT
DETAILED SITE PLAN

DATE: 03/22/2024
DESIGNED BY: CAO
DRAWN BY: AGM
CHECKED BY: BJC

FILE NO.
196617002_SP DTL-DIA II
PROJECT NO.
196617002

SHEET NO.

K:\DEN_Civil\196617002 DIA1\CADD\PlanSheets\CSP\196617002_SP DTL-DA II.dwg OKeeffe, Sam 3/27/2024 8:11 AM

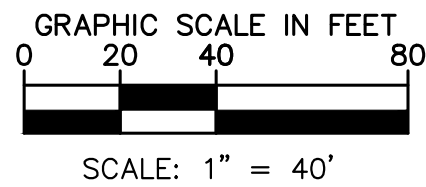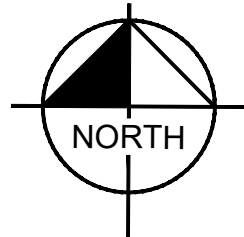


MATCH LINE SEE SHEET 18

PORTEOS INDUSTRIAL AT PORTEOS

SITE PLAN AMENDMENT

LOCATED IN THE NW $\frac{1}{4}$ OF SECTION 9,
TOWNSHIP 3 SOUTH, RANGE 65 WEST OF THE 6TH P.M.,
CITY OF AURORA, ADAMS COUNTY, STATE OF COLORADO

BUILDING 2
1,024,501 SF
LOT 2, BLOCK 1, PORTEOS SUBDIVISION FILING NO. 6
57.33 AC

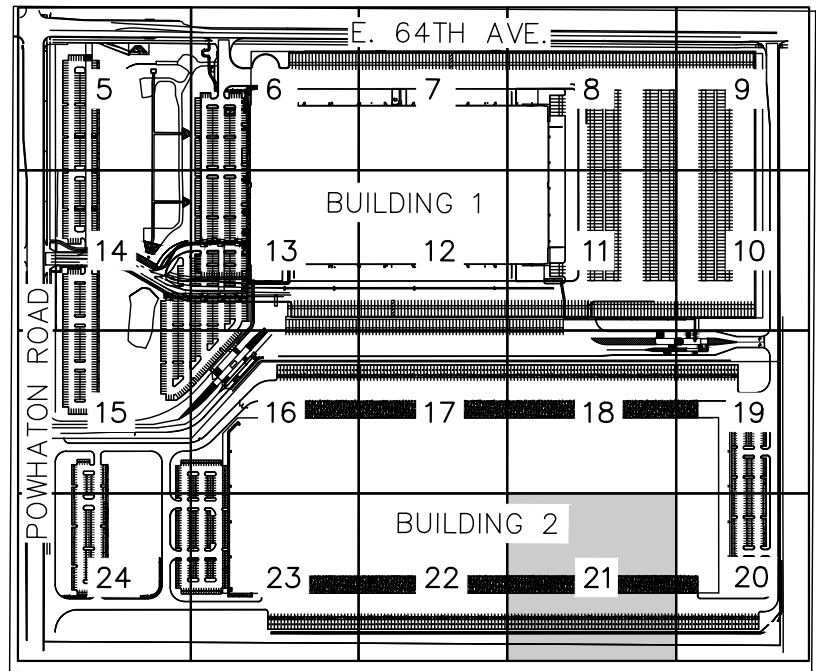

KEYMAP
NTS



LEGEND

- PROPERTY LINE
- EASEMENT LINE
- STEEL SECURITY FENCE
- ACCESSIBLE ROUTE
- CONCRETE CURB & GUTTER
- PARKING COUNT
- PAINT STRIPING
- EXISTING GRAVEL
- EXISTING CONCRETE
- CONCRETE SIDEWALK
- HEAVY DUTY CONCRETE
- LIGHT DUTY ASPHALT
- HEAVY DUTY ASPHALT

SITE PLAN KEYNOTES

- ACCESSIBLE PARKING SPACES W/ ACCESSIBLE PARKING SIGN
- VAN ACCESSIBLE PARKING SPACES W/ VAN ACCESSIBLE PARKING SIGN
- ACCESSIBLE CURB RAMP W/ DETECTIBLE WARNING
- STOP SIGN
- PEDESTRIAN CROSSWALK
- SIGHT LIGHTING
- STAIRS & BUILDING EGRESS DOOR
- "NO PARKING FIRE LANE" SIGN
- BOLLARD
- BUILDING INGRESS/ENGRESS DOOR
- BUILDING EGRESS DOOR
- STORM INLET
- STORM MANHOLE
- FIRE HYDRANT, ASSEMBLY PER COA STD. DETAIL 208
- FIRE HYDRANT W/ BOLLARDS, ASSEMBLY PER COA STD. DETAIL 208
- SPEED BUMP
- FIRE LANE SIGN

SITE PLAN NOTES

- ALL RADII AREA 3' AND MEASURED FROM FACE OF CURB UNLESS STATED OTHERWISE.

Kimley»Horn

KIMLEY-HORN AND ASSOCIATES, INC.
6205 S. W. 11th Ave.
Greenwood Village, CO 80111 (303) 228-2300



PORTEOS INDUSTRIAL AT PORTEOS
CITY OF AURORA, COUNTY OF ADAMS
SITE PLAN AMENDMENT
DETAILED SITE PLAN

DATE: 03/22/2024
DESIGNED BY: CAO
DRAWN BY: AGM
CHECKED BY: BJC

FILE NO.
196617002_SP DTL-DA II
PROJECT NO.
196617002

SHEET NO.

K:\DEN_Civil\196617002 DIA1\CADD\PlanSheets\CSP\196617002_SP DTL-DIA II.dwg OKeeffe, Sam 3/27/2024 8:12 AM

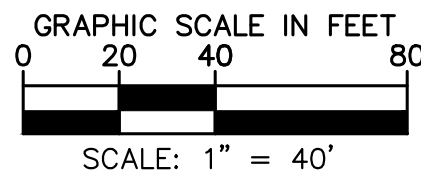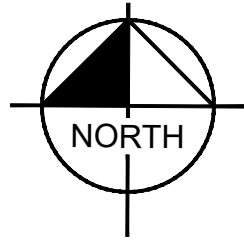

MATCH LINE SEE SHEET 17


PORTEOS INDUSTRIAL AT PORTEOS

SITE PLAN AMENDMENT


LOCATED IN THE NW $\frac{1}{4}$ OF SECTION 9,
TOWNSHIP 3 SOUTH, RANGE 65 WEST OF THE 6TH P.M.,
CITY OF AURORA, ADAMS COUNTY, STATE OF COLORADO

BUILDING 2
1,024,501 SF
LOT 2, BLOCK 1, PORTEOS SUBDIVISION FILING NO. 6
57.33 AC

MATCH LINE SEE SHEET 23

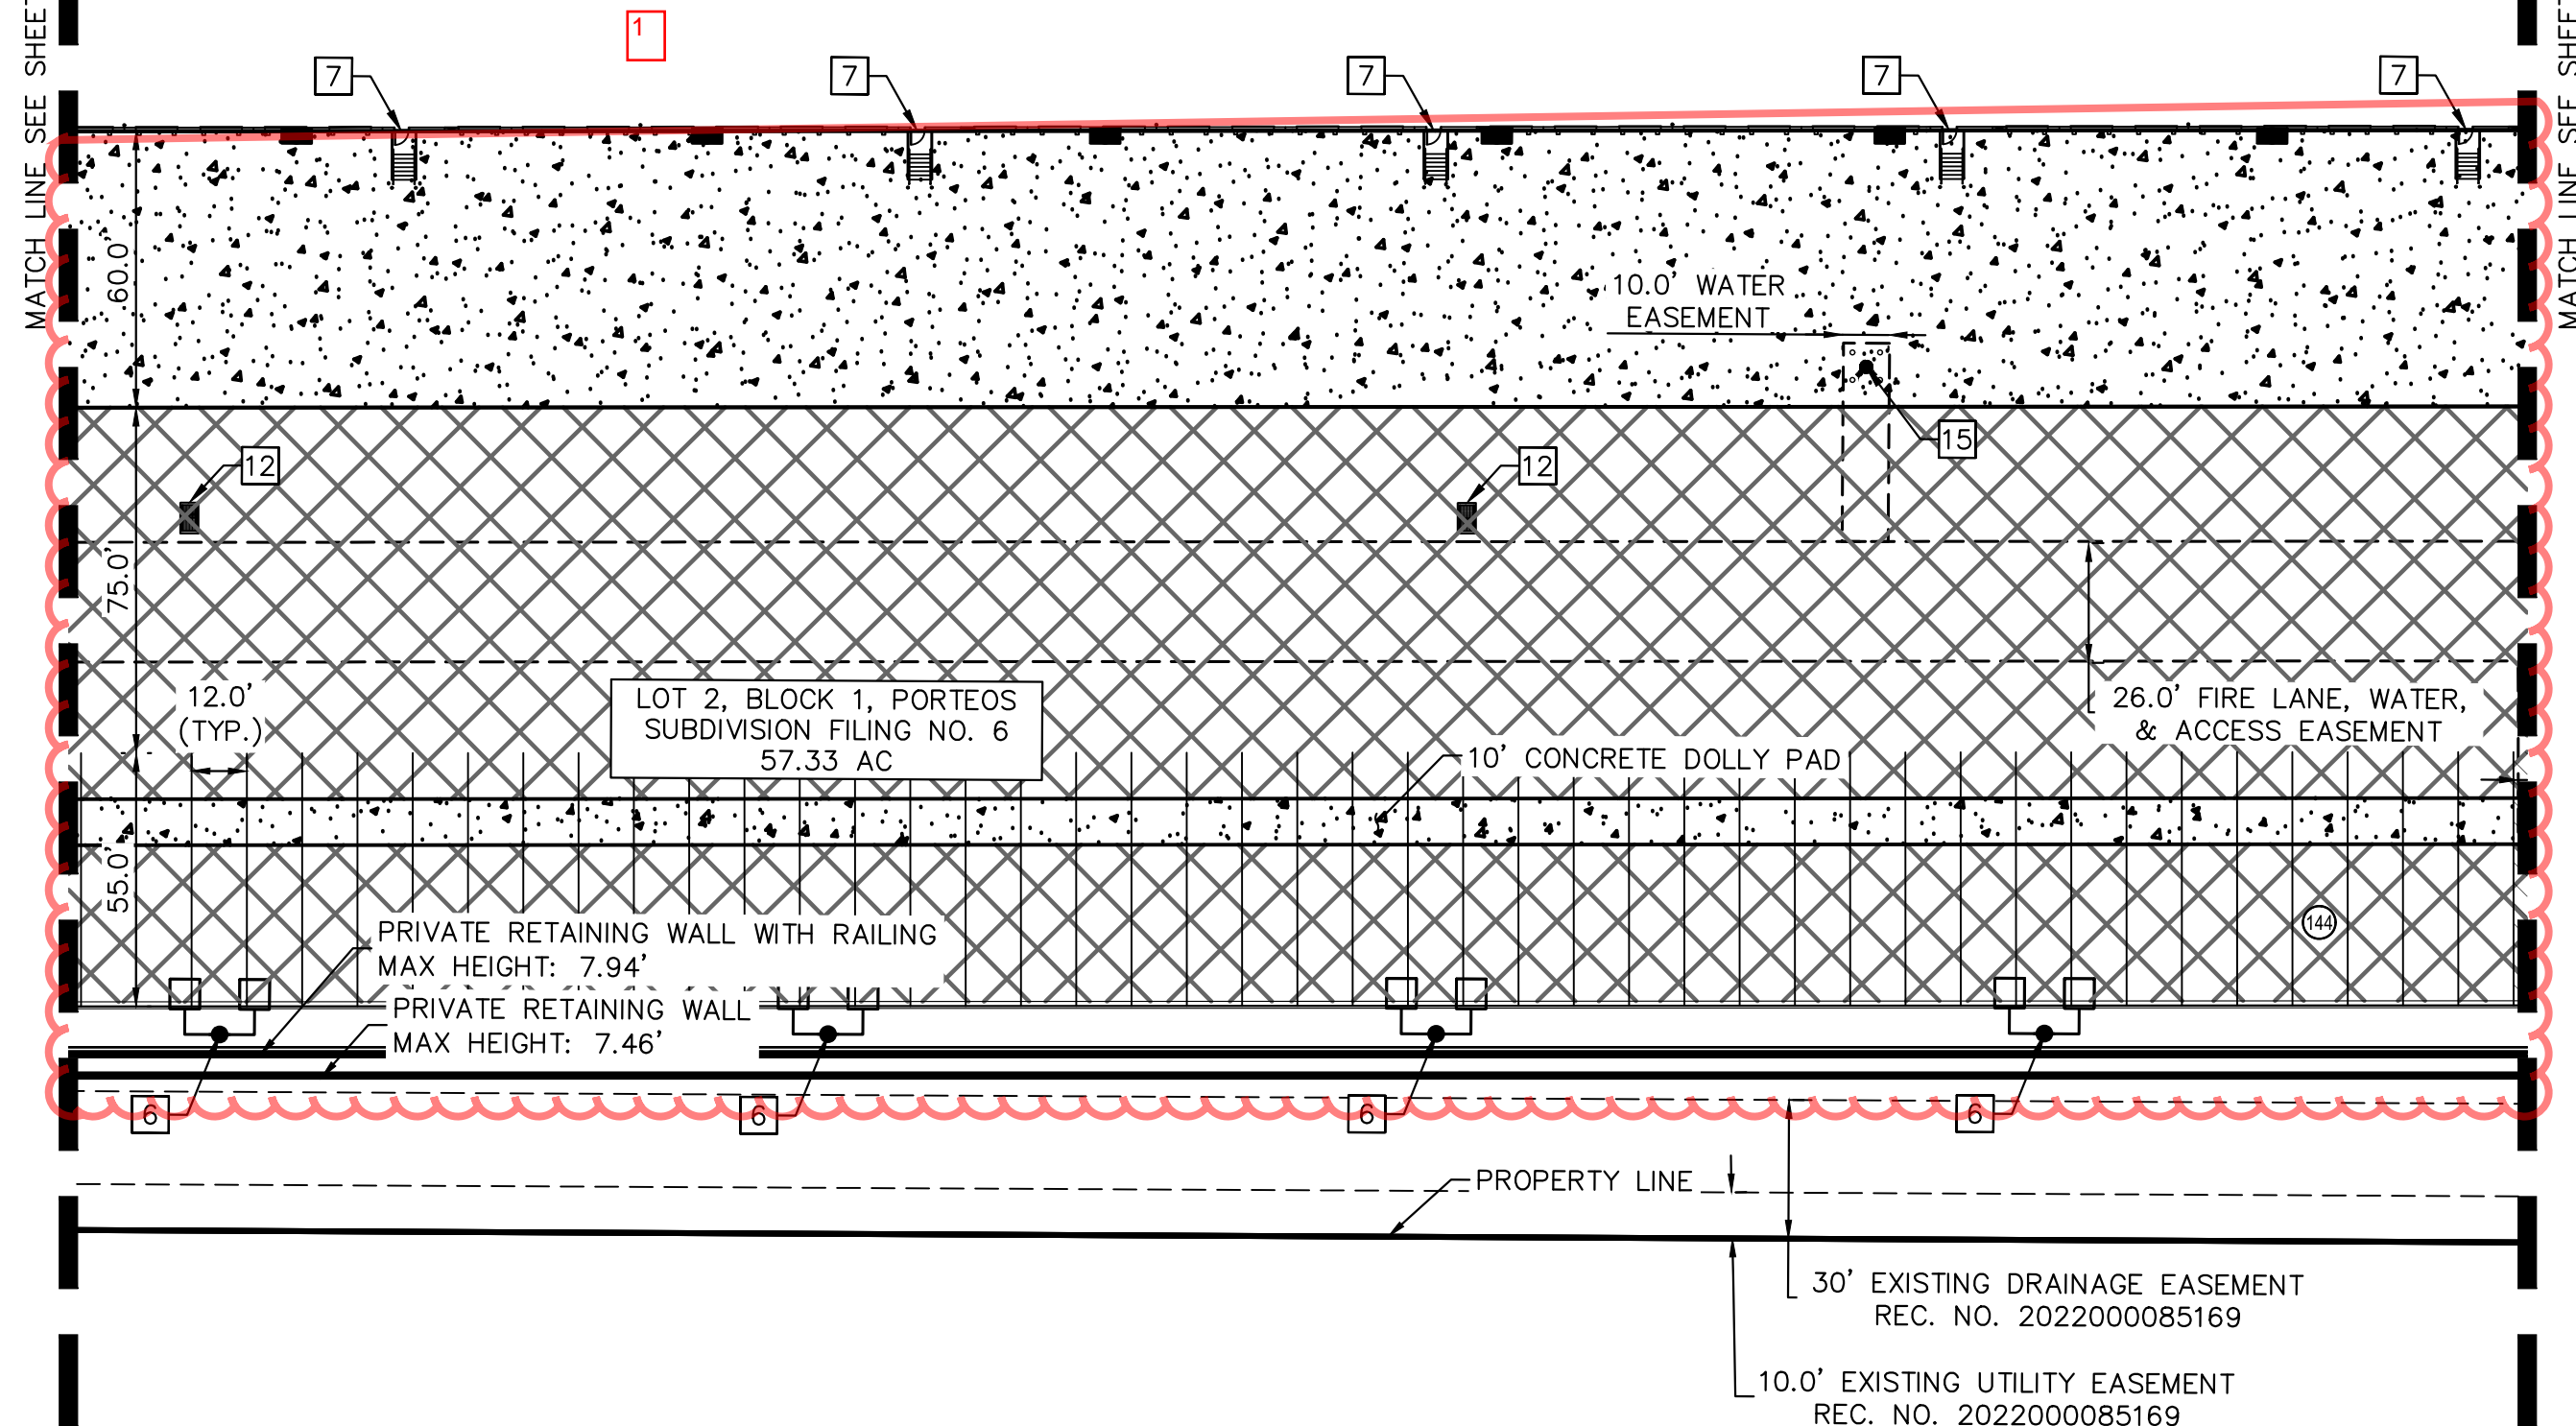

MATCH LINE SEE SHEET 21

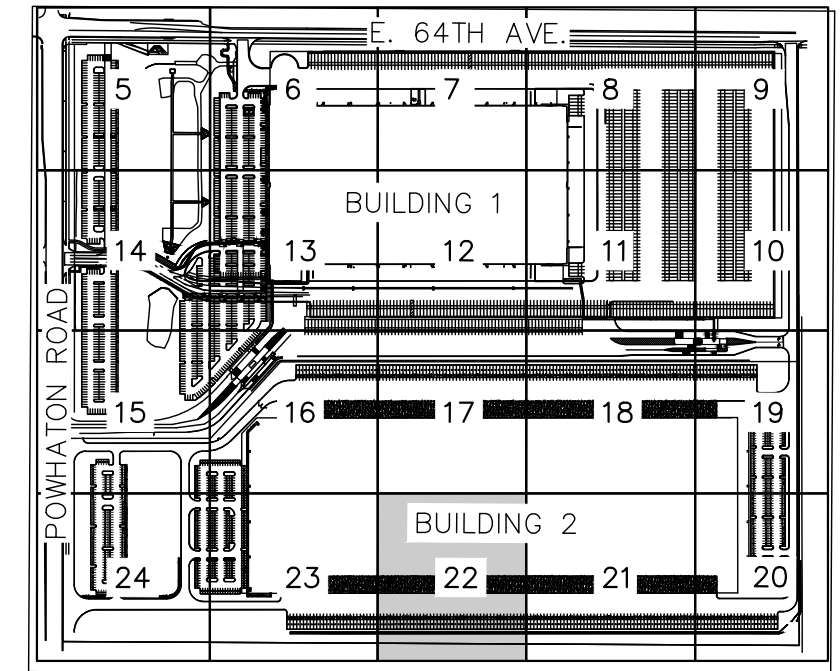

KEYMAP
NTS



LEGEND

	PROPERTY LINE
	EASEMENT LINE
	STEEL SECURITY FENCE
	ACCESSIBLE ROUTE
	CONCRETE CURB & GUTTER
	PARKING COUNT
	PAINT STRIPING
	EXISTING GRAVEL
	EXISTING CONCRETE
	CONCRETE SIDEWALK
	HEAVY DUTY CONCRETE
	LIGHT DUTY ASPHALT
	HEAVY DUTY ASPHALT

SITE PLAN KEYNOTES

- 1 ACCESSIBLE PARKING SPACES W/ ACCESSIBLE PARKING SIGN
- 2 VAN ACCESSIBLE PARKING SPACES W/ VAN ACCESSIBLE PARKING SIGN
- 3 ACCESSIBLE CURB RAMP W/ DETECTIBLE WARNING
- 4 STOP SIGN
- 5 PEDESTRIAN CROSSWALK
- 6 SIGHT LIGHTING
- 7 STAIRS & BUILDING EGRESS DOOR
- 8 "NO PARKING FIRE LANE" SIGN
- 9 BOLLARD
- 10 BUILDING INGRESS/ENGRESS DOOR
- 11 BUILDING EGRESS DOOR
- 12 STORM INLET
- 13 STORM MANHOLE
- 14 FIRE HYDRANT, ASSEMBLY PER COA STD. DETAIL 208
- 15 FIRE HYDRANT W/ BOLLARDS, ASSEMBLY PER COA STD. DETAIL 208
- 16 SPEED BUMP
- 17 FIRE LANE SIGN

SITE PLAN NOTES

1. ALL RADII AREA 3' AND MEASURED FROM FACE OF CURB UNLESS STATED OTHERWISE.

Kimley»Horn
KIMLEY-HORN AND ASSOCIATES, INC.
6205 S. W. 11th Ave.
Greenwood Village, CO 80111 (303) 228-2300

PORTEOS INDUSTRIAL AT PORTEOS
CITY OF AURORA, COUNTY OF ADAMS
SITE PLAN AMENDMENT
DETAILED SITE PLAN

DATE: 03/22/2024
DESIGNED BY: CAO
DRAWN BY: AGM
CHECKED BY: BJC

FILE NO.
196617002_SP DTL-DA II
PROJECT NO.
196617002


SHEET NO.

K:\DEN_Civil\196617002 DIA1\CADD\PlanSheets\CSP\196617002_SP DTL-DIA II.dwg OKeeffe, Sam 3/27/2024 8:12 AM

PORTEOS INDUSTRIAL AT PORTEOS

SITE PLAN AMENDMENT

LOCATED IN THE NW $\frac{1}{4}$ OF SECTION 9,
TOWNSHIP 3 SOUTH, RANGE 65 WEST OF THE 6TH P.M.,
CITY OF AURORA, ADAMS COUNTY, STATE OF COLORADO

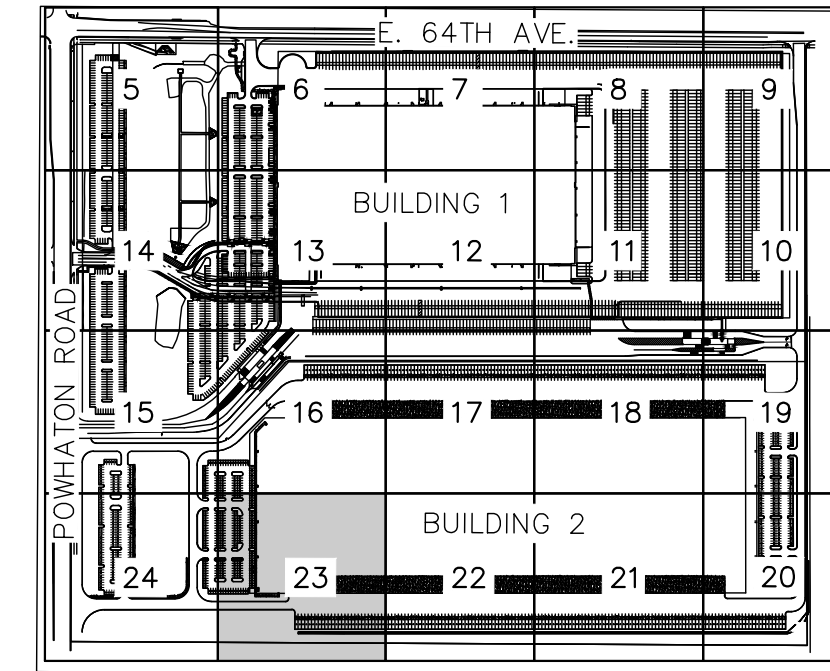

KEYMAP

NTS



LEGEND

- PROPERTY LINE
- EASEMENT LINE
- STEEL SECURITY FENCE
- ACCESSIBLE ROUTE
- CONCRETE CURB & GUTTER
- PARKING COUNT
- PAINT STRIPING
- EXISTING GRAVEL
- EXISTING CONCRETE
- CONCRETE SIDEWALK
- HEAVY DUTY CONCRETE
- LIGHT DUTY ASPHALT
- HEAVY DUTY ASPHALT

SITE PLAN KEYNOTES

- ACCESSIBLE PARKING SPACES W/ ACCESSIBLE PARKING SIGN
- VAN ACCESSIBLE PARKING SPACES W/ VAN ACCESSIBLE PARKING SIGN
- ACCESSIBLE CURB RAMP W/ DETECTIBLE WARNING
- STOP SIGN
- PEDESTRIAN CROSSWALK
- SIGHT LIGHTING
- STAIRS & BUILDING EGRESS DOOR
- "NO PARKING FIRE LANE" SIGN
- BOLLARD
- BUILDING INGRESS/ENGRESS DOOR
- BUILDING EGRESS DOOR
- STORM INLET
- STORM MANHOLE
- FIRE HYDRANT, ASSEMBLY PER COA STD. DETAIL 208
- FIRE HYDRANT W/ BOLLARDS, ASSEMBLY PER COA STD. DETAIL 208
- SPEED BUMP
- FIRE LANE SIGN

SITE PLAN NOTES

- ALL RADII AREA 3' AND MEASURED FROM FACE OF CURB UNLESS STATED OTHERWISE.

Kimley»Horn
KIMLEY-HORN AND ASSOCIATES, INC.
6205 S. HANCOCK
GREENWOOD VILLAGE, CO 80111 (303) 228-2300



PORTEOS INDUSTRIAL AT PORTEOS
CITY OF AURORA, COUNTY OF ADAMS
SITE PLAN AMENDMENT
DETAILED SITE PLAN

DATE: 03/22/2024
DESIGNED BY: CAO
DRAWN BY: AGM
CHECKED BY: BUC

FILE NO.
196617002_SP DTL-DIA II
PROJECT NO.
196617002

SHEET NO.



K:\DEN_Civil\196617002 DIA1\CADD\PlanSheets\CSP\196617002_SP DTL-DIA II.dwg OKeeffe, Sam 3/27/2024 8:13 AM

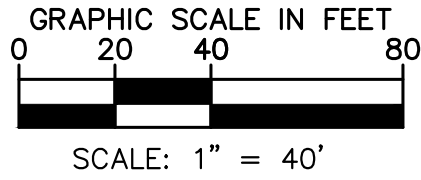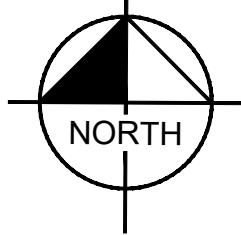

PORTEOS INDUSTRIAL AT PORTEOS

SITE PLAN AMENDMENT

LOCATED IN THE NW $\frac{1}{4}$ OF SECTION 9,
TOWNSHIP 3 SOUTH, RANGE 65 WEST OF THE 6TH P.M.,
CITY OF AURORA, ADAMS COUNTY, STATE OF COLORADO

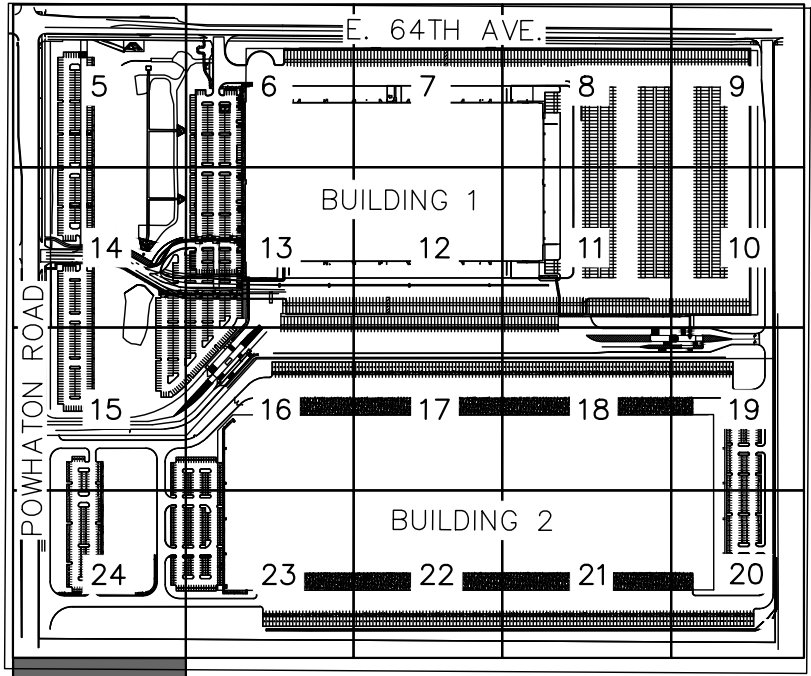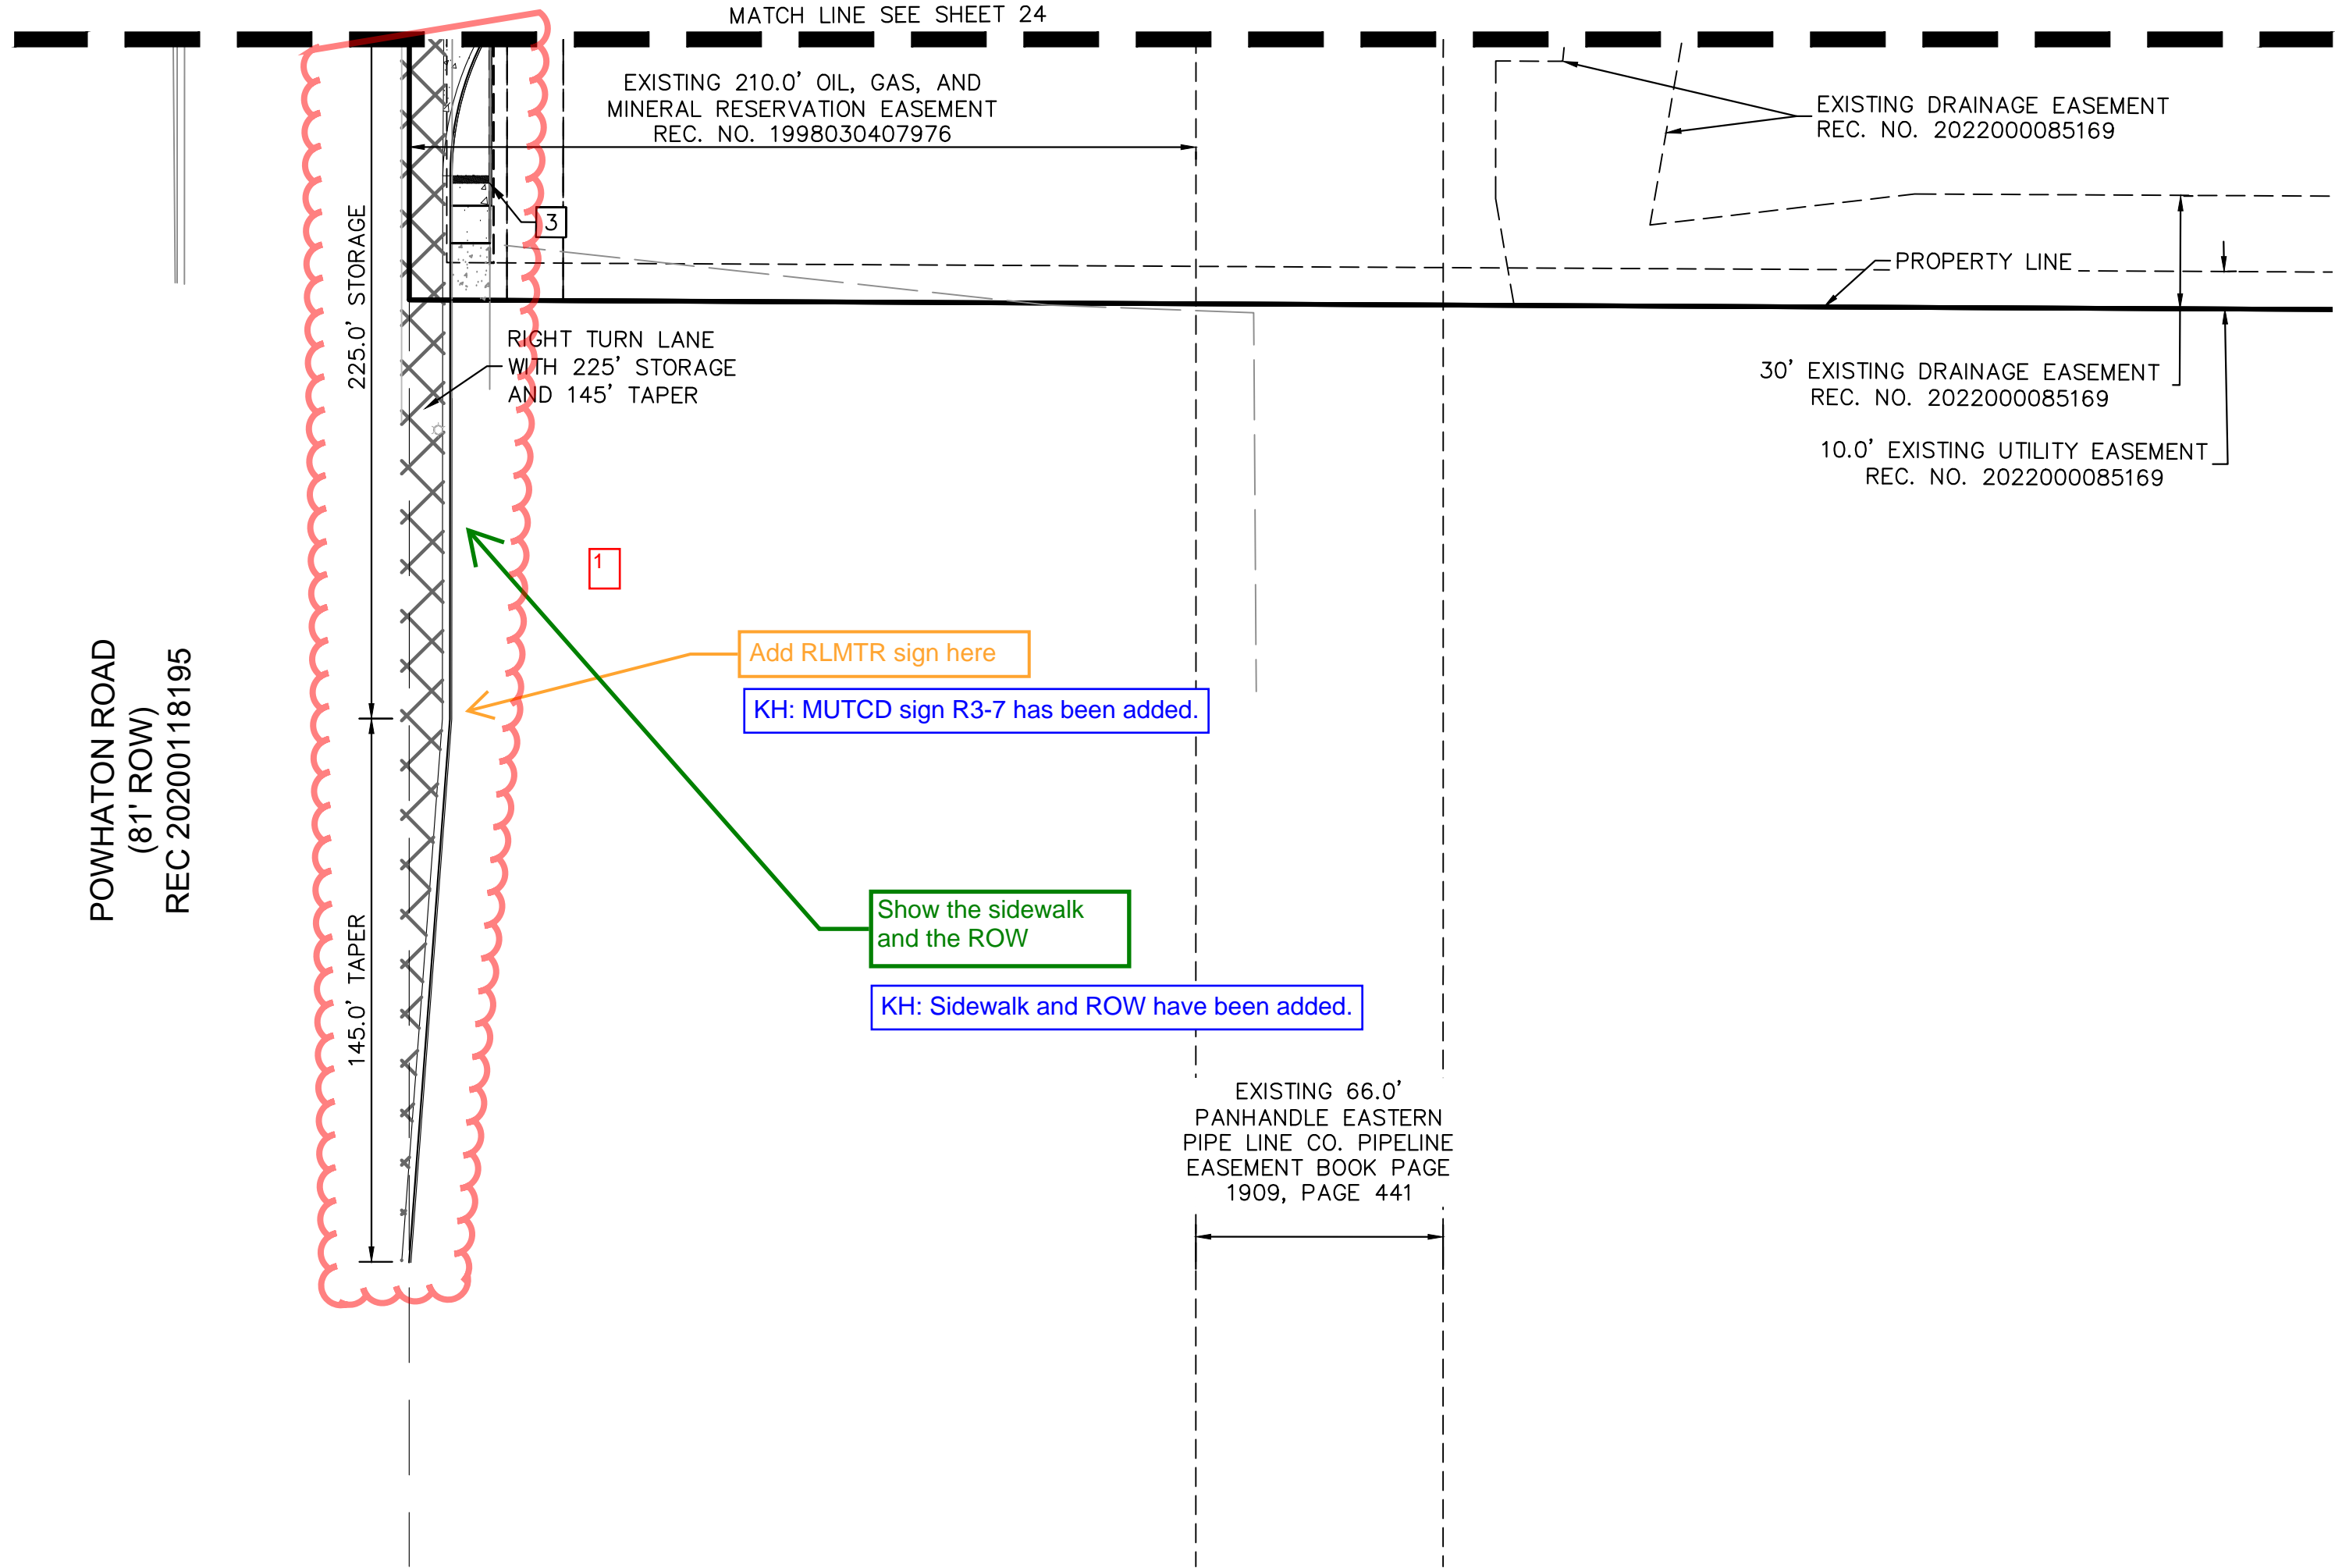

LEGEND

	PROPERTY LINE
	EASEMENT LINE
	STEEL SECURITY FENCE
	ACCESSIBLE ROUTE
	CONCRETE CURB & GUTTER
	PARKING COUNT
	PAINT STRIPING
	EXISTING GRAVEL
	EXISTING CONCRETE
	CONCRETE SIDEWALK
	HEAVY DUTY CONCRETE
	LIGHT DUTY ASPHALT
	HEAVY DUTY ASPHALT

SITE PLAN KEYNOTES

- 1 ACCESSIBLE PARKING SPACES W/ ACCESSIBLE PARKING SIGN
- 2 VAN ACCESSIBLE PARKING SPACES W/ VAN ACCESSIBLE PARKING SIGN
- 3 ACCESSIBLE CURB RAMP W/ DETECTIBLE WARNING
- 4 STOP SIGN
- 5 PEDESTRIAN CROSSWALK
- 6 SIGHT LIGHTING
- 7 STAIRS & BUILDING EGRESS DOOR
- 8 "NO PARKING FIRE LANE" SIGN
- 9 BOLLARD
- 10 BUILDING INGRESS/ENGRESS DOOR
- 11 BUILDING EGRESS DOOR
- 12 STORM INLET
- 13 STORM MANHOLE
- 14 FIRE HYDRANT, ASSEMBLY PER COA STD. DETAIL 208
- 15 FIRE HYDRANT W/ BOLLARDS, ASSEMBLY PER COA STD. DETAIL 208
- 16 SPEED BUMP
- 17 FIRE LANE SIGN

SITE PLAN NOTES

1. ALL RADII AREA 3' AND MEASURED FROM FACE OF CURB UNLESS STATED OTHERWISE.

Kimley»Horn

KIMLEY-HORN AND ASSOCIATES, INC.
6205 S. W. 11th Ave.
Greenwood Village, CO 80111 (303) 228-2300

PORTEOS INDUSTRIAL AT PORTEOS
CITY OF AURORA, COUNTY OF ADAMS
SITE PLAN AMENDMENT
DETAILED SITE PLAN

DATE: 03/22/2024
DESIGNED BY: CAO
DRAWN BY: AGM
CHECKED BY: BJC

FILE NO.
196617002_SP DTL-DIA II
PROJECT NO.
196617002

SHEET NO.



25

CHANG
ES
SO
3/25/24
P33

NO. BY DATE APPR


PORTEOS INDUSTRIAL AT PORTEOS SITE PLAN AMENDMENT

LOCATED IN THE NW ¼ OF SECTION 9,
TOWNSHIP 3 SOUTH, RANGE 65 WEST OF THE 6TH P.M.,
CITY OF AURORA, ADAMS COUNTY, STATE OF COLORADO

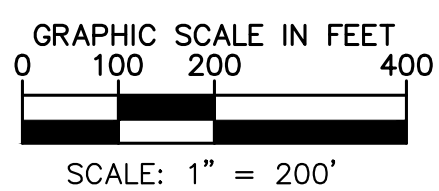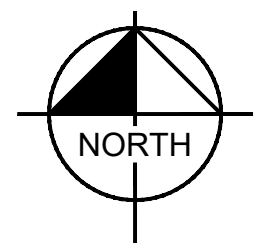

Advisory: Please review section 4.02.7.03.3.1 regarding when structural calcs are required. Structural calcs, if applicable, will be required with the first submittal of the civil plans.

KH: Acknowledged, structural calcs have been provided with the first submittal of the civil plans.

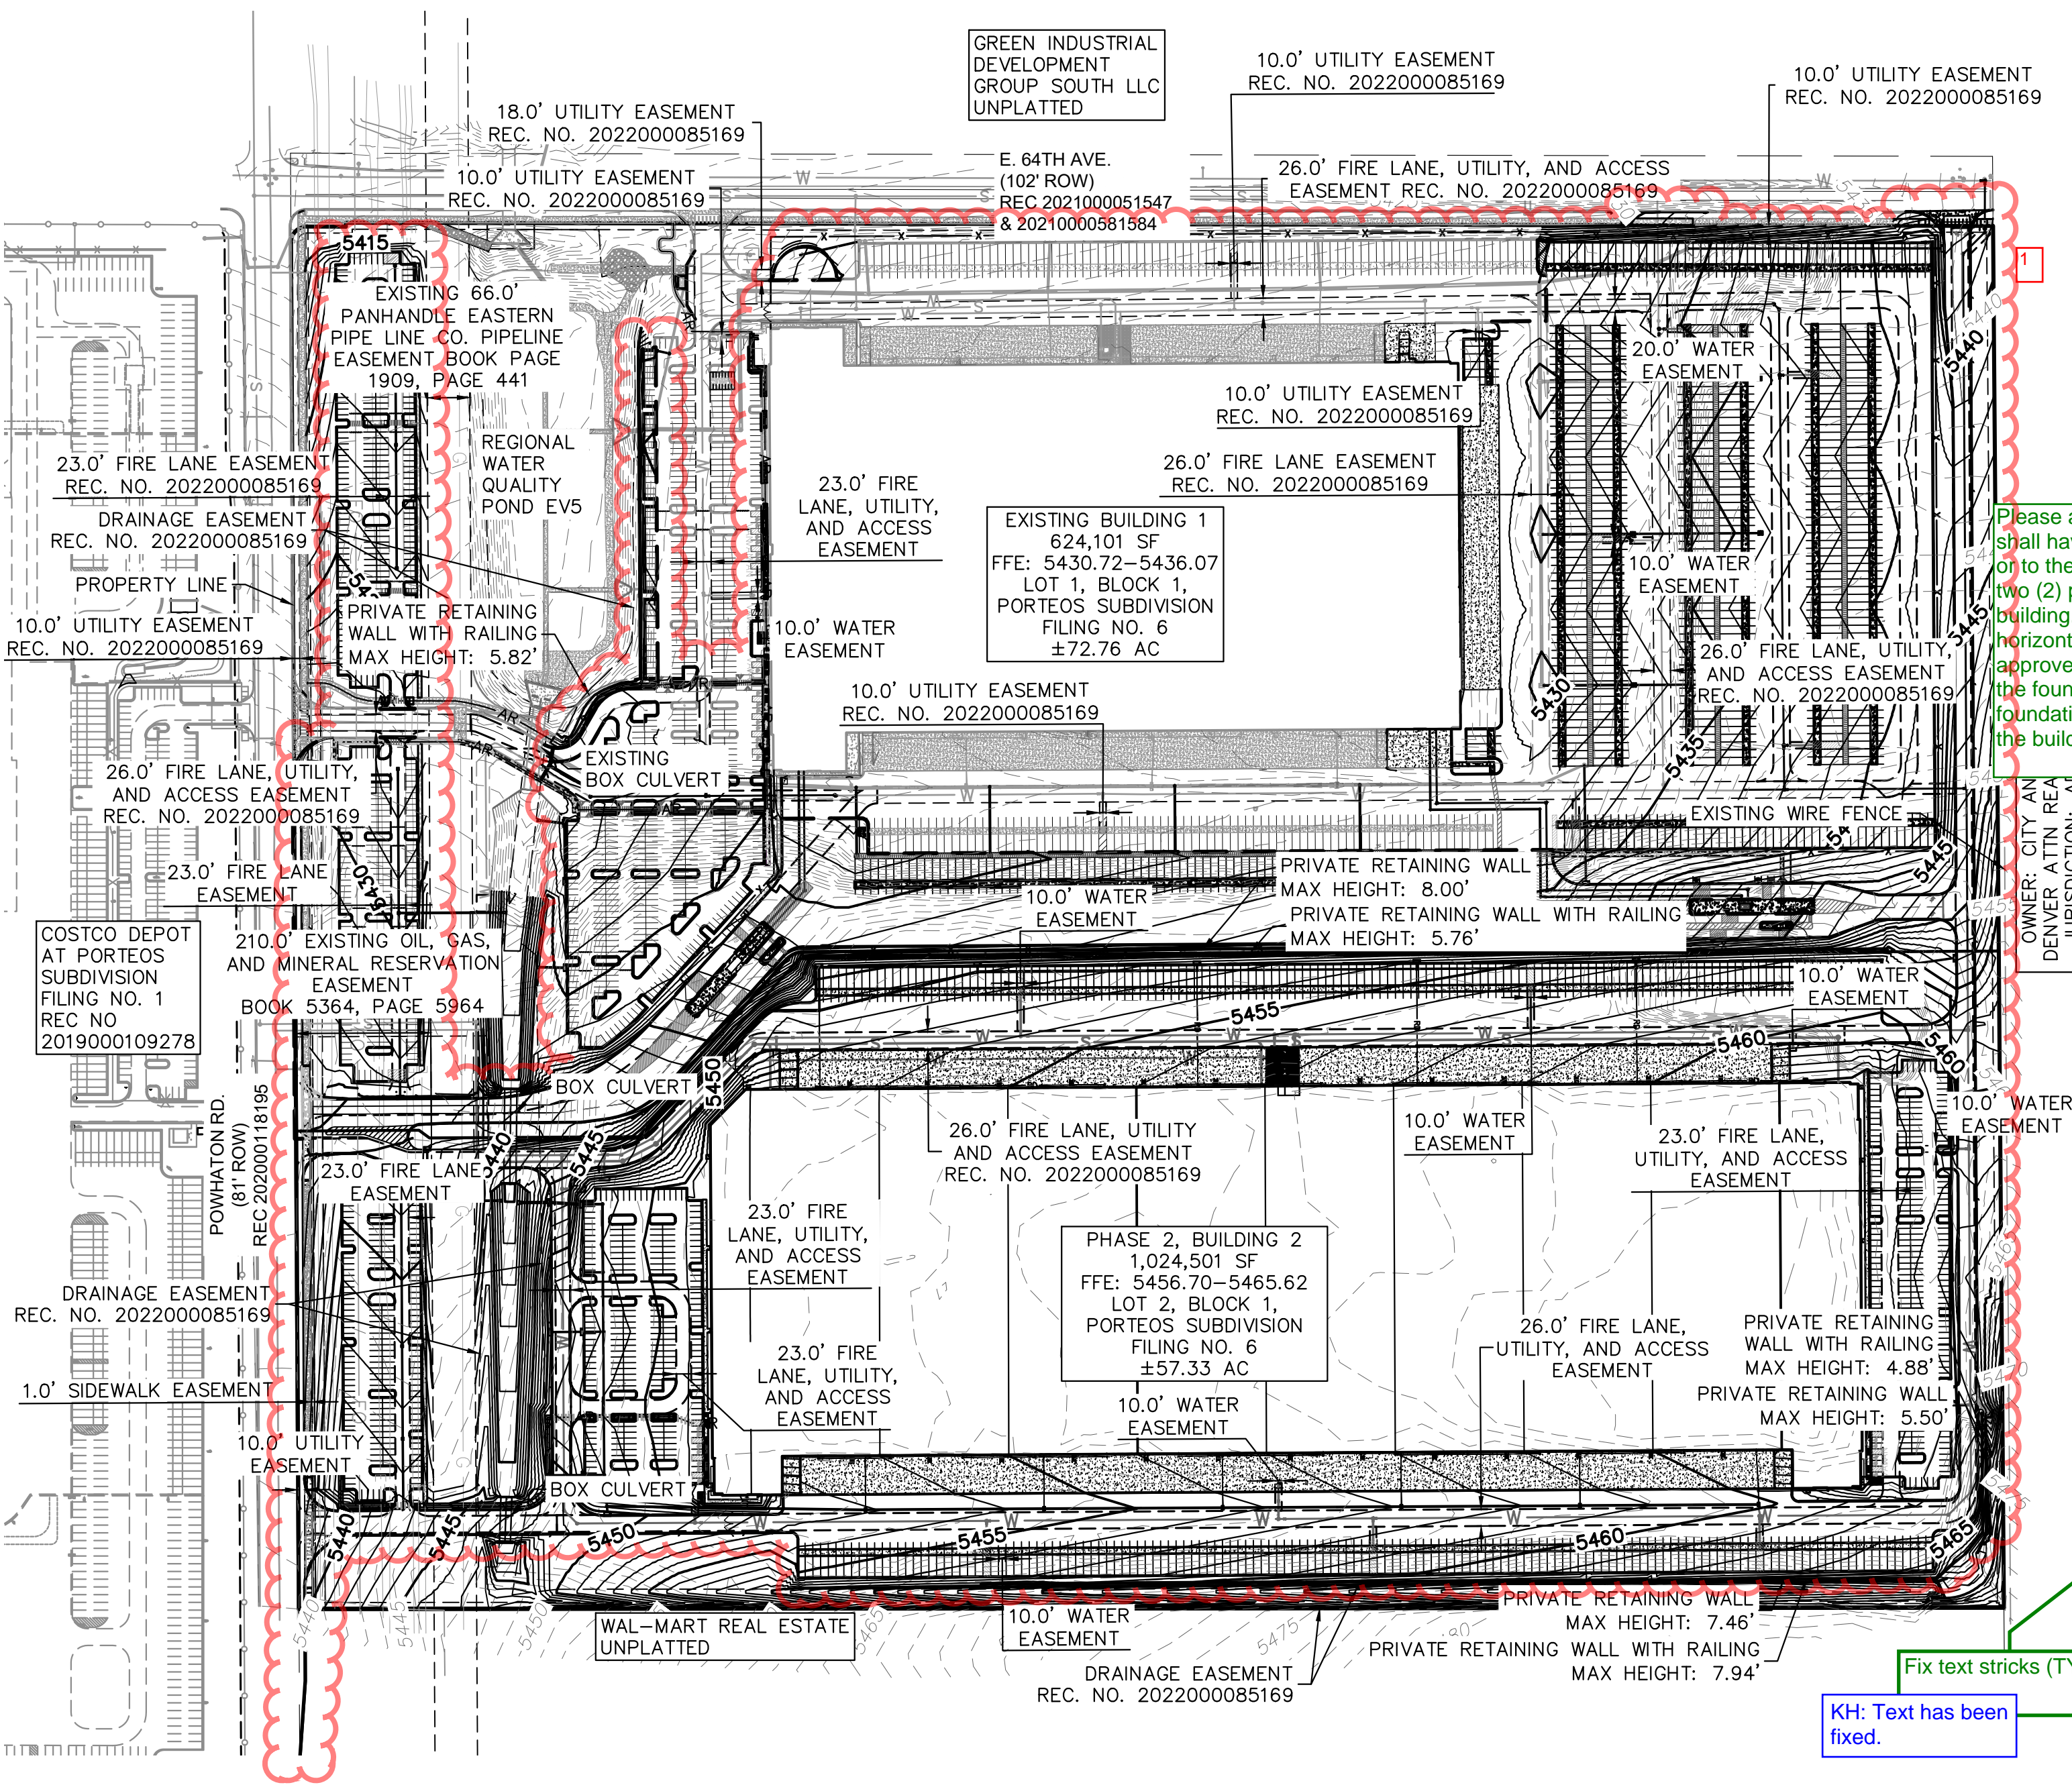

LEGEND

- PROPERTY LINE
- EASEMENT LINE
- XXXX EXISTING CONTOUR
- XXXX PROPOSED CONTOUR
- CONCRETE CURB & GUTTER
- AR ACCESSIBLE ROUTE
- X.XX% SLOPE ARROW

Please add the following note: "The maximum slope within ROW is 4:1, the maximum slope for property outside of the ROW is 3:1."

KH: Note has been added.

Please add the following note: "The slope away from the building shall have a minimum grade of five (5) percent for the first ten feet or to the property line, whichever occurs first, then a minimum of two (2) percent until the slope reaches the swale around the building. If physical obstructions or lot lines prohibit the ten feet of horizontal distance, a five (5) percent slope shall be provided to an approved alternative method of diverting storm runoff away from the foundation. Impervious surfaces within ten feet of the building foundation shall be sloped a minimum of two (2) percent away from the building." TYP.

KH: Note has been added.

Please add the following note: "The maximum cross slope in an accessible path shall not exceed two percent. The maximum longitudinal slope in an accessible path shall not exceed five percent." TYP.

KH: Note has been added.

GRADING PLAN NOTES

- GRADES ADJACENT TO THE BUILDING SHALL BE A MINIMUM OF 1% FOR THE FIRST 10 FEET FOR IMPERVIOUS AREA AND A MINIMUM OF 5% FOR PERVIOUS AREA PER COA CRITERIA. UNLESS OTHERWISE NOTED.
- STORMWATER INFRASTRUCTURE OWNERS SHALL BE DESIGNATED BY THE CONSTRUCTION DOCUMENTS.
- MAXIMUM 2% SLOPE IN ANY DIRECTION HANDICAP PARKING SPACES.
- THE MAXIMUM LONGITUDINAL SLOPE WITHIN A FIRE LANE EASEMENT SHALL NOT EXCEED 10%. THE TRANSVERSE SLOPE SHALL GENERALLY HAVE A 2% BUT NOT EXCEED 4%. THE RESULTANT SLOPE SHALL NOT EXCEED 10%.

Please add the following notes: "Minimum pavement slopes: 1% for asphalt, 0.5% for concrete." TYP.

KH: Note has been added.

Please add the following note: "Detailed layout and design for proposed curb ramps within right of way or along an accessible route will be completed with the civil plans." TYP.

KH: Note has been added.

Kimley-Horn
KIMLEY-HORN AND ASSOCIATES
6205 S. WILLOW
GREENWOOD VILLAGES, CO 80111 (303) 228-2300



PORTEOS INDUSTRIAL
CITY OF AURORA, COUNTY OF ADAMS
SITE PLAN AMENDMENT
OVERALL GRADING PLAN

DATE: 03/22/2024
DESIGNED BY: CAO
DRAWN BY: AGM
CHECKED BY: BJC

FILE NO: 196617002.GD 01
PROJECT NO: 196617002
SHEET NO.

K:\DEN_Civil\196617002 DIA1\CADD\PlanSheets\CSP\196617002_GD_OV.dwg Mavis, August 3/27/2024 10:12 AM

K:\DEN_Civil\196617002 DIA1\CADD\PlanSheets\CSP\196617002_GD DTL-DIA I.dwg Mavis, August 3/27/2024 10:13 AM

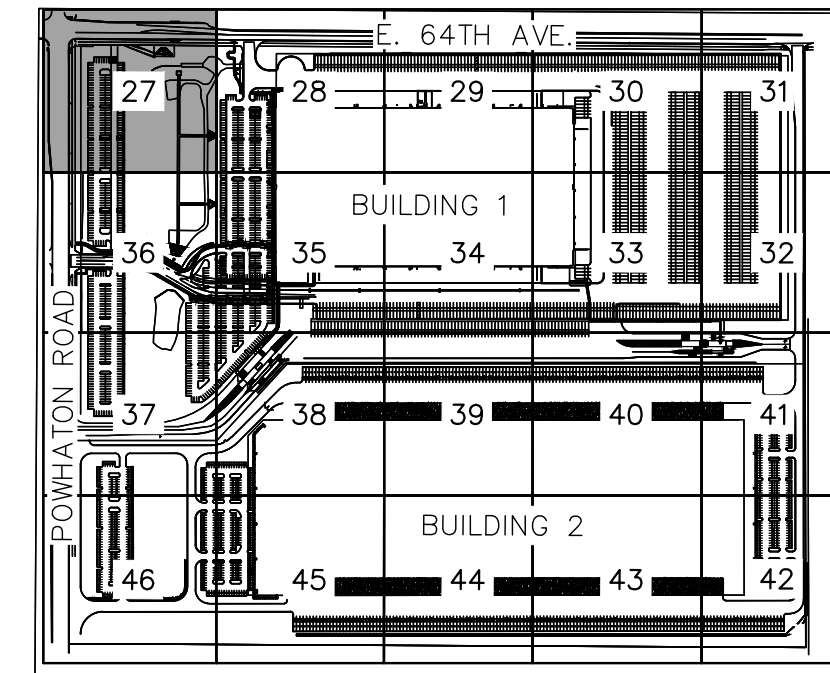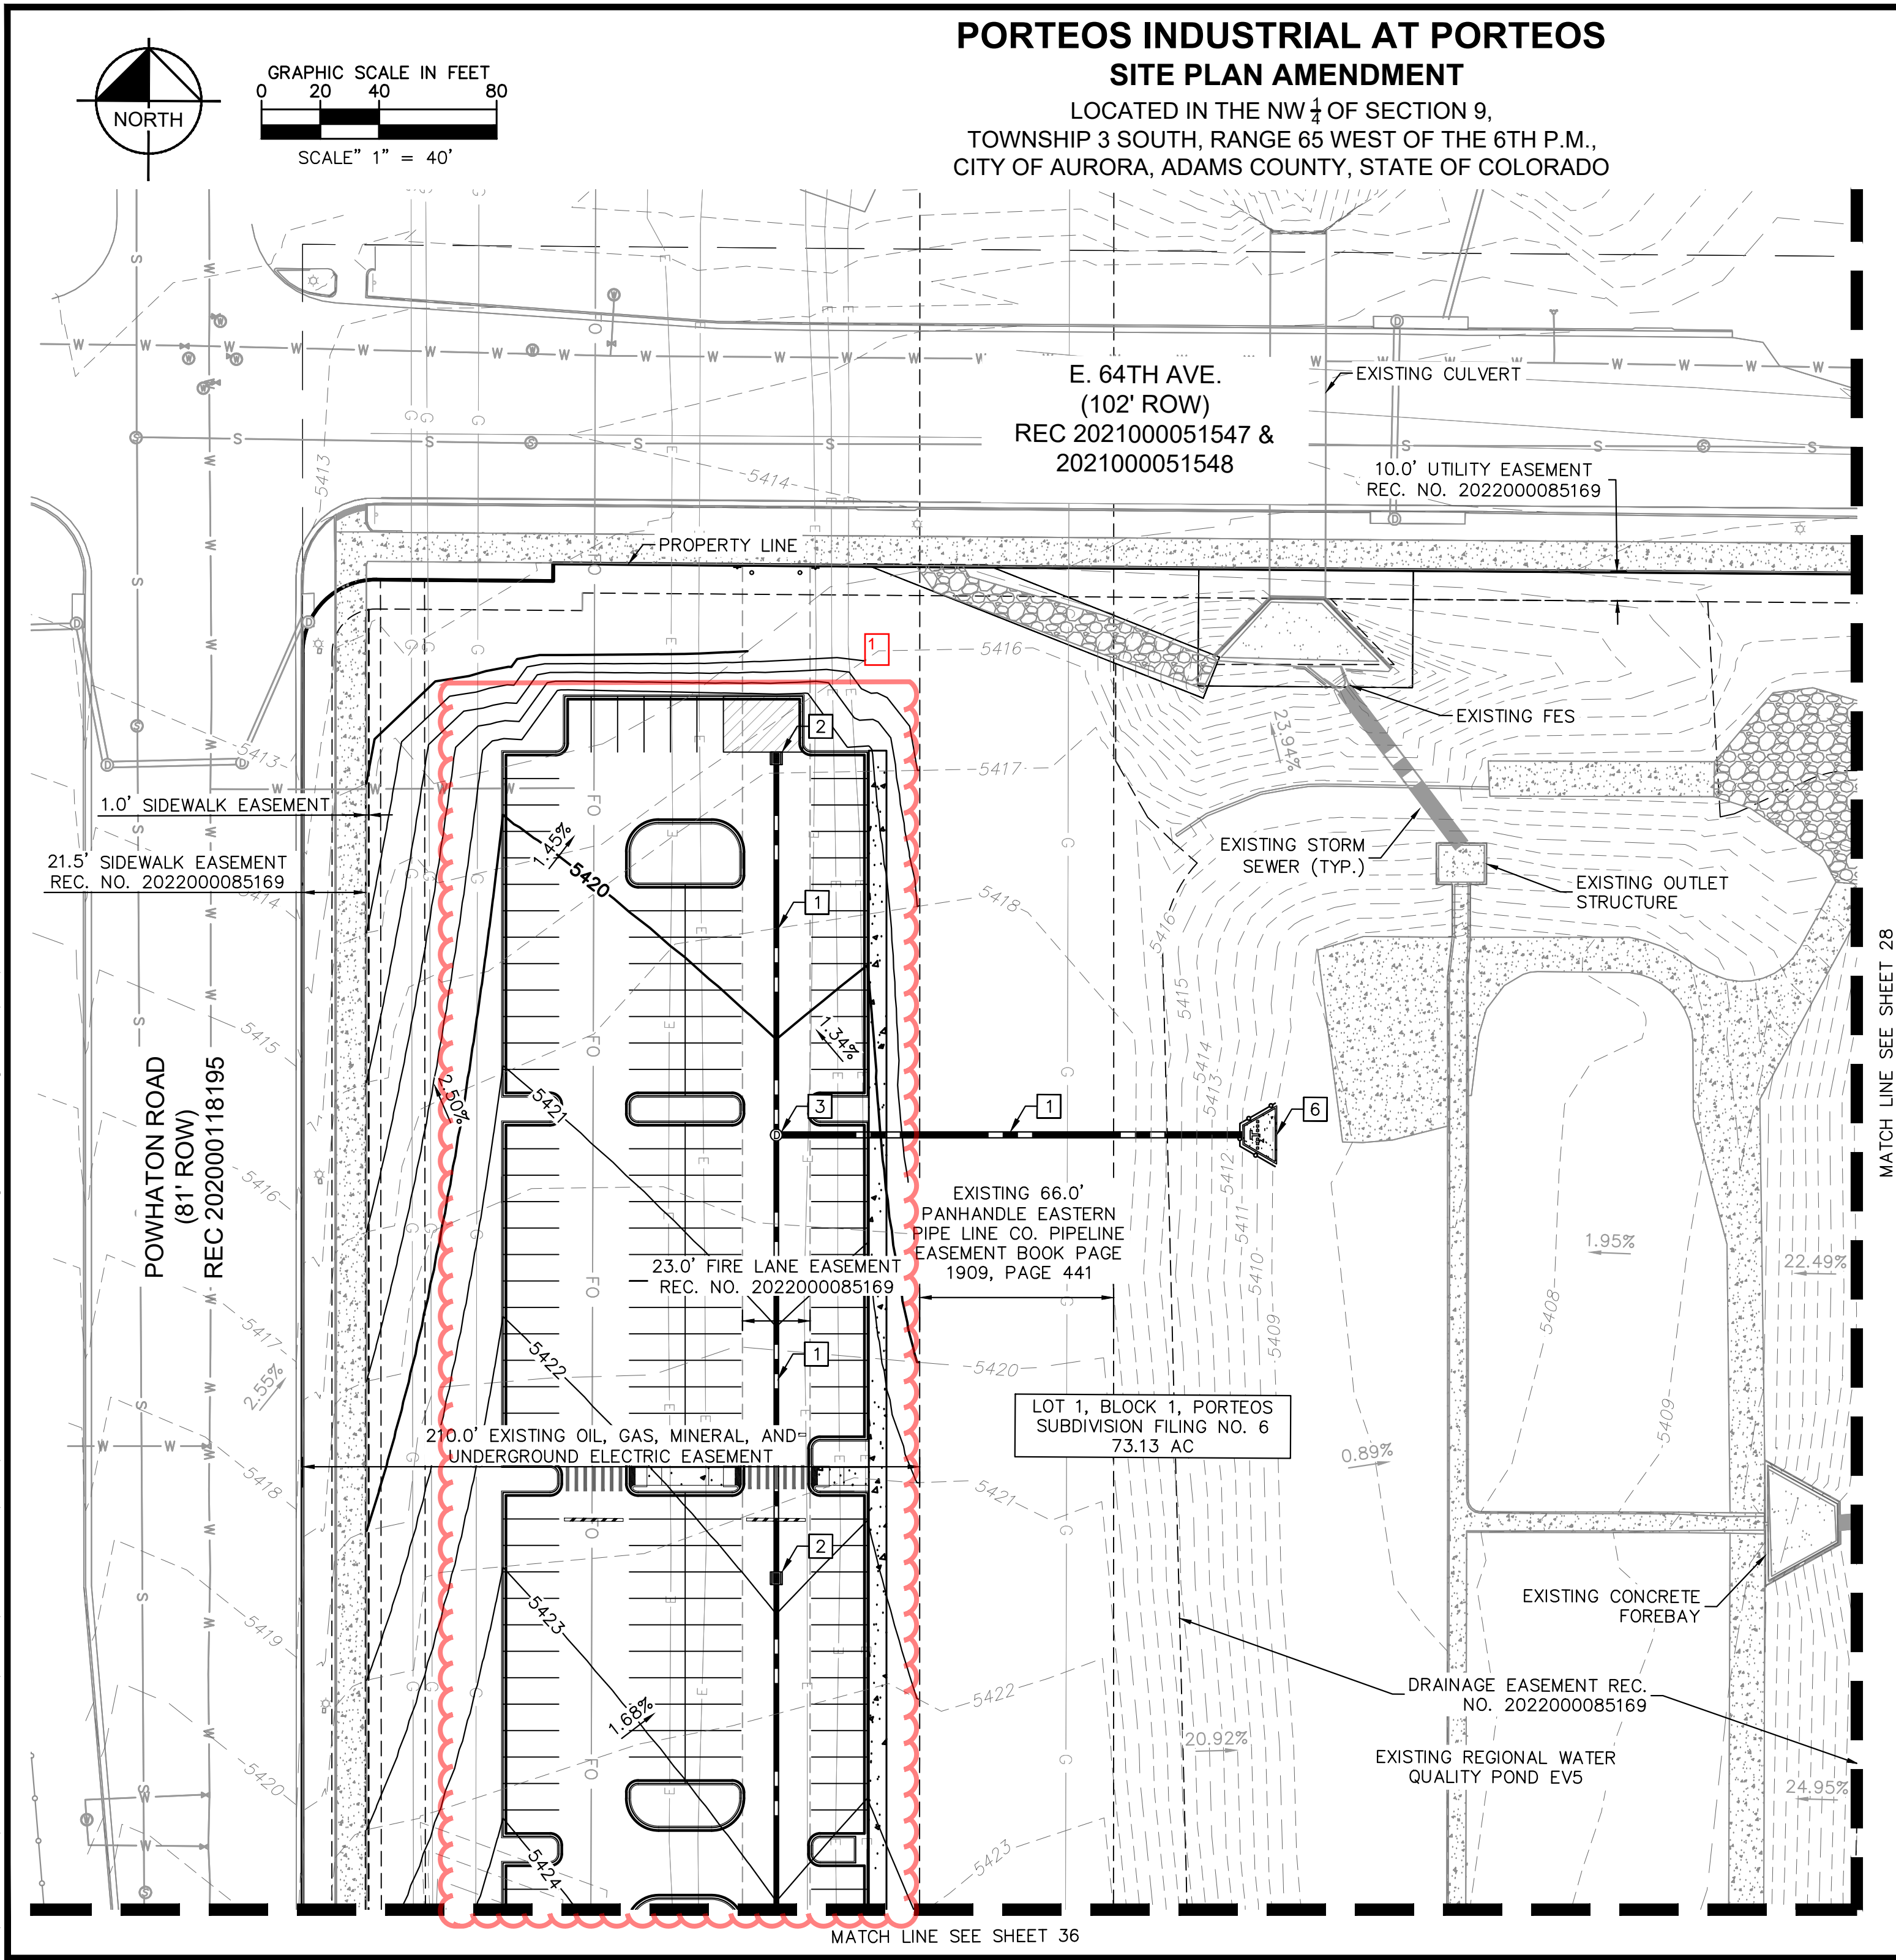

LEGEND

- PROPERTY LINE
- EASEMENT LINE
- XXXX EXISTING CONTOUR
- XXXX PROPOSED CONTOUR
- CONCRETE CURB & GUTTER
- AR ACCESSIBLE ROUTE
- PAVEMENT SAWCUT LINE
- X.XX% SLOPE ARROW

GRADING PLAN KEYNOTES

- 1 STORM SEWER
- 2 STORM INLET
- 3 STORM MANHOLE
- 4 ROOF DRAIN
- 5 FLARED END SECTION
- 6 FOREBAY

GRADING PLAN NOTES

- GRADES ADJACENT TO THE BUILDING SHALL BE A MINIMUM OF 1% FOR THE FIRST 10 FEET FOR IMPERVIOUS AREA AND A MINIMUM OF 5% FOR PERVIOUS AREA PER COA CRITERIA. UNLESS OTHERWISE NOTED.
- STORMWATER INFRASTRUCTURE OWNERSHIP SHALL BE DESIGNATED BY THE CONSTRUCTION DOCUMENTS.
- MAXIMUM 2% SLOPE IN ANY DIRECTION AT HANDICAP PARKING SPACES.
- THE MAXIMUM LONGITUDINAL SLOPE WITHIN A FIRE LANE EASEMENT SHALL NOT EXCEED 10%. THE TRANSVERSE SLOPE SHALL GENERALLY HAVE A 2% BUT NOT EXCEEDING 4%. THE RESULTANT SLOPE SHALL NOT EXCEED 10%.

Kimley»Horn
KIMLEY-HORN AND ASSOCIATES, INC.
6205 S. WILLOW
GREENWOOD VILLAGE, CO 80111 (303) 228-2300


PORTEOS INDUSTRIAL AT PORTEOS
CITY OF AURORA, COUNTY OF ADAMS
SITE PLAN AMENDMENT
DETAILED GRADING PLAN

DATE: 03/22/2024
DESIGNED BY: CAO
DRAWN BY: AGM
CHECKED BY: BUC

FILE NO.
196617002_GD DTL-DIA I
PROJECT NO.
196617002

SHEET NO.


K:\DEN_Civil\196617002 DIA1\CADD\PlanSheets\CSP\196617002_GD DTL-DIA I.dwg Mavis, August 3/27/2024 10:13 AM

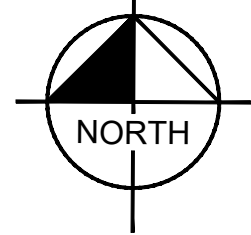

GRAPHIC SCALE IN FEET
0 20 40 80
SCALE" 1" = 40'

PORTEOS INDUSTRIAL AT PORTEOS SITE PLAN AMENDMENT

LOCATED IN THE NW $\frac{1}{4}$ OF SECTION 9,
TOWNSHIP 3 SOUTH, RANGE 65 WEST OF THE 6TH P.M.,
CITY OF AURORA, ADAMS COUNTY, STATE OF COLORADO

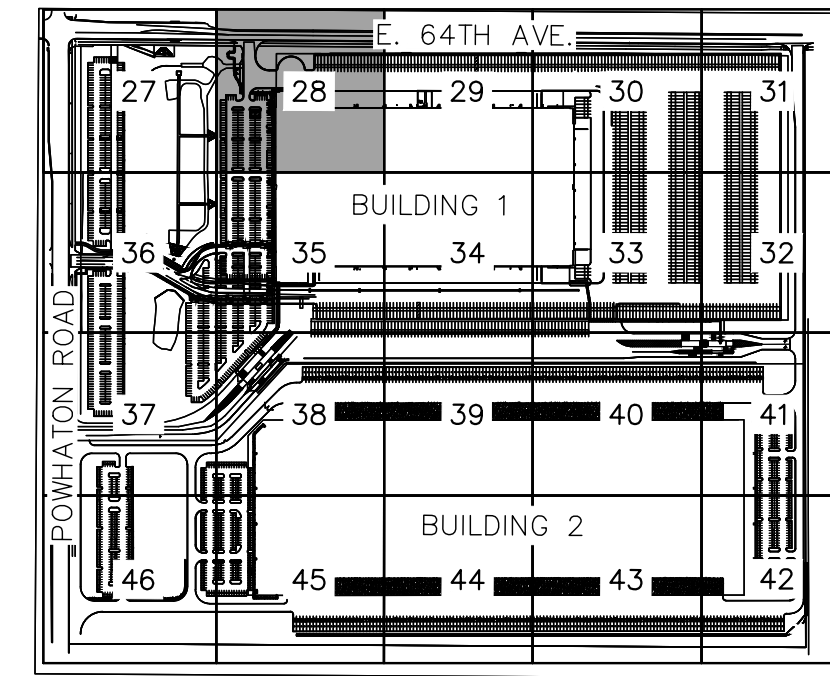

KEYMAP
NTS

LEGEND


- PROPERTY LINE
- EASEMENT LINE
- XXXX EXISTING CONTOUR
- XXXX PROPOSED CONTOUR
- CONCRETE CURB & GUTTER
- AR ACCESSIBLE ROUTE
- PAVEMENT SAWCUT LINE
- X.XX% SLOPE ARROW

GRADING PLAN KEYNOTES

- 1 STORM SEWER
- 2 STORM INLET
- 3 STORM MANHOLE
- 4 ROOF DRAIN
- 5 FLARED END SECTION
- 6 FOREBAY

GRADING PLAN NOTES

- GRADES ADJACENT TO THE BUILDING SHALL BE A MINIMUM OF 1% FOR THE FIRST 10 FEET FOR IMPERVIOUS AREA AND A MINIMUM OF 5% FOR PERVIOUS AREA PER COA CRITERIA. UNLESS OTHERWISE NOTED.
- STORMWATER INFRASTRUCTURE OWNERSHIP SHALL BE DESIGNATED BY THE CONSTRUCTION DOCUMENTS.
- MAXIMUM 2% SLOPE IN ANY DIRECTION AT HANDICAP PARKING SPACES.
- THE MAXIMUM LONGITUDINAL SLOPE WITHIN A FIRE LANE EASEMENT SHALL NOT EXCEED 10%. THE TRANSVERSE SLOPE SHALL GENERALLY HAVE A 2% BUT NOT EXCEEDING 4%. THE RESULTANT SLOPE SHALL NOT EXCEED 10%.

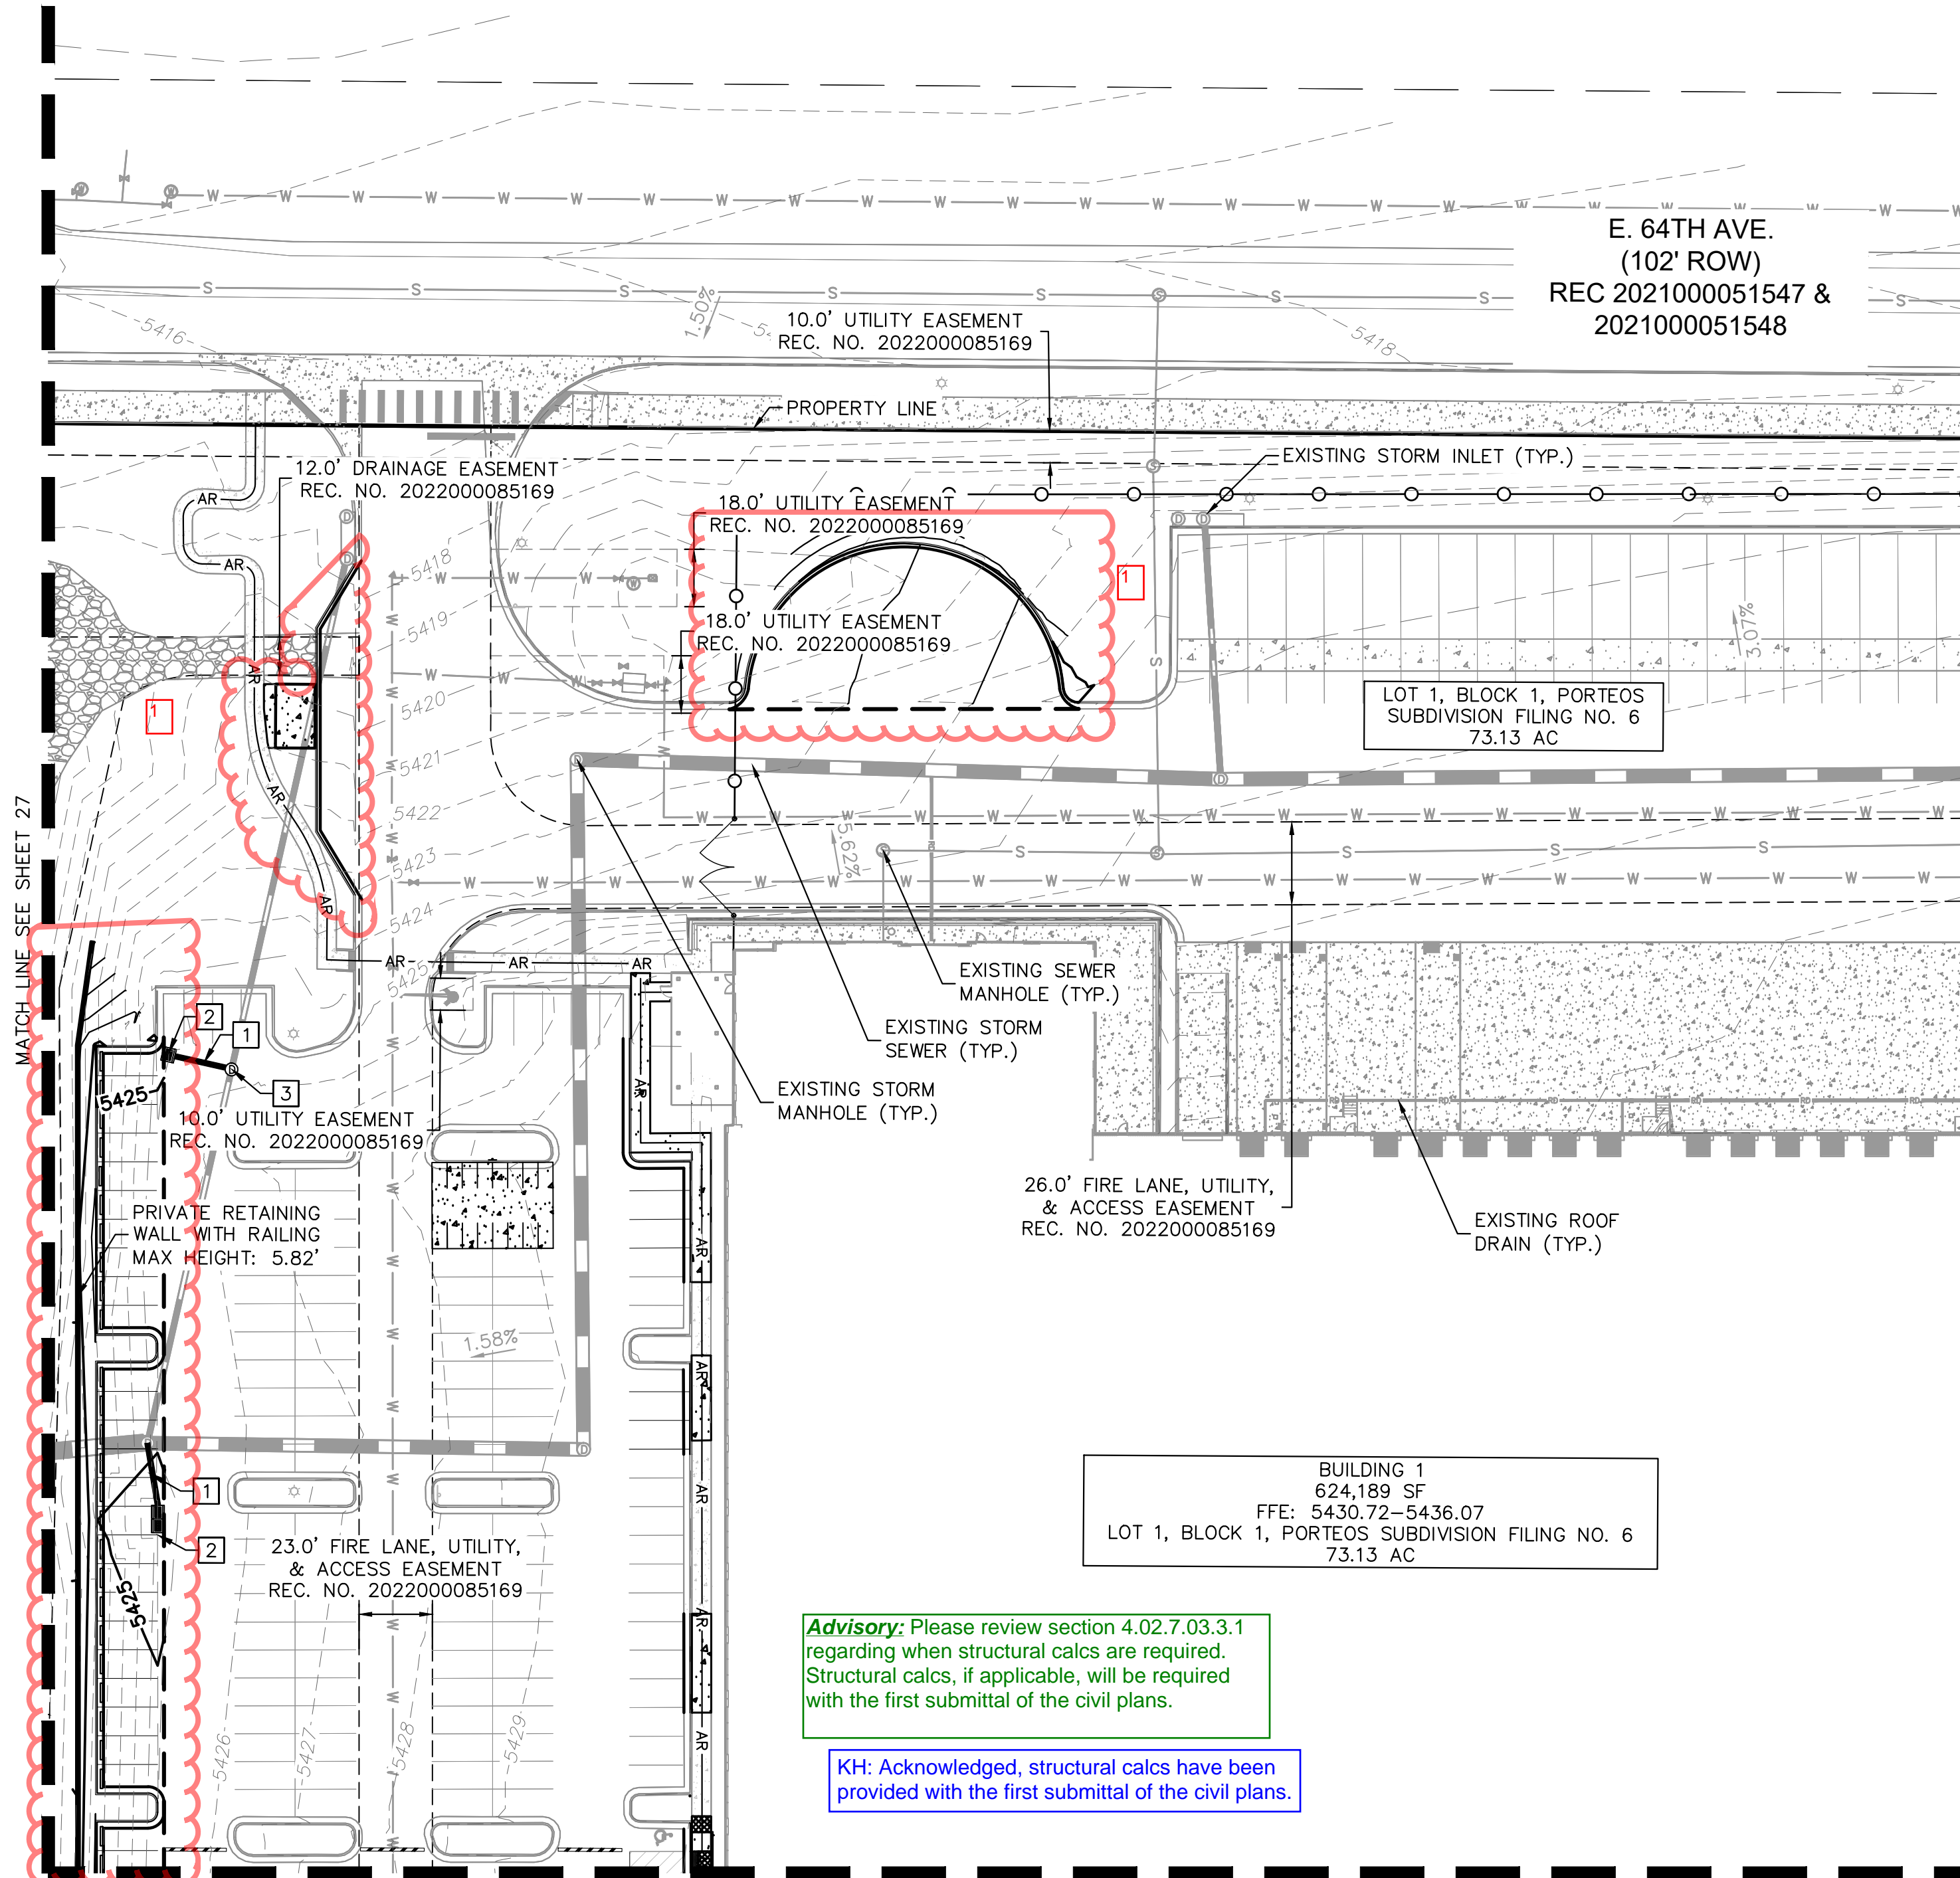

Kimley»Horn

KIMLEY-HORN AND ASSOCIATES, INC.
6205 S. WILLOW
GREENWOOD VILLAGE, CO 80111 (303) 228-2300


PORTEOS INDUSTRIAL AT PORTEOS
CITY OF AURORA, COUNTY OF ADAMS
SITE PLAN AMENDMENT
DETAILED GRADING PLAN

DATE: 03/22/2024
DESIGNED BY: CAO
DRAWN BY: AGM
CHECKED BY: BUC



FILE NO.
196617002_GD DTL-DIA I
PROJECT NO.
196617002

SHEET NO.

K:\DEN_Civil\196617002 DIA1\CADD\PlanSheets\CSP\196617002_GD DTL-DIA 1.dwg Mavis, August 3/27/2024 10:14 AM

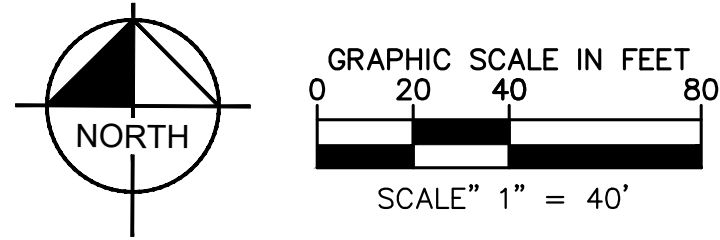

PORTEOS INDUSTRIAL AT PORTEOS
SITE PLAN AMENDMENT
LOCATED IN THE NW ¼ OF SECTION 9,
TOWNSHIP 3 SOUTH, RANGE 65 WEST OF THE 6TH P.M.,
CITY OF AURORA, ADAMS COUNTY, STATE OF COLORADO

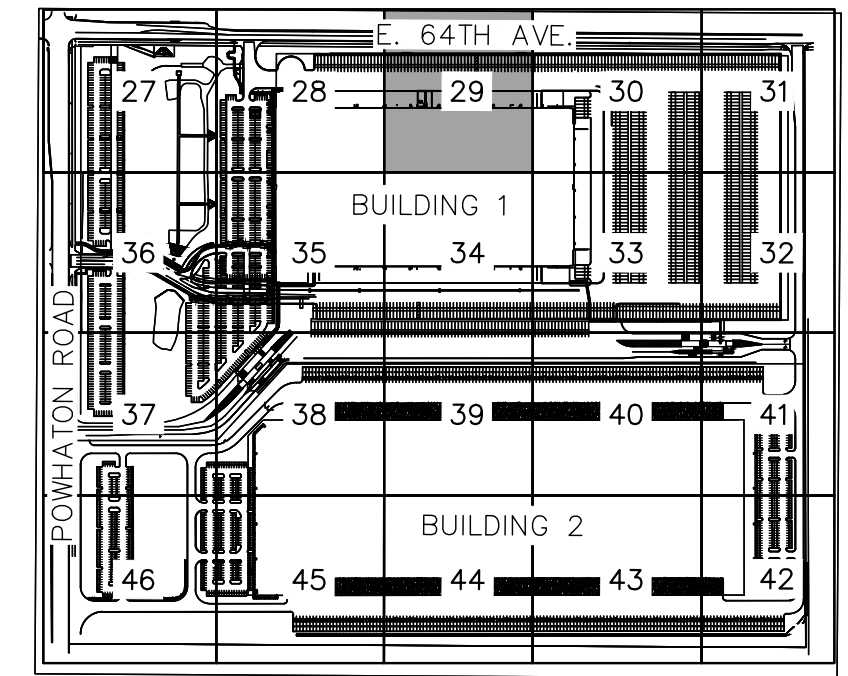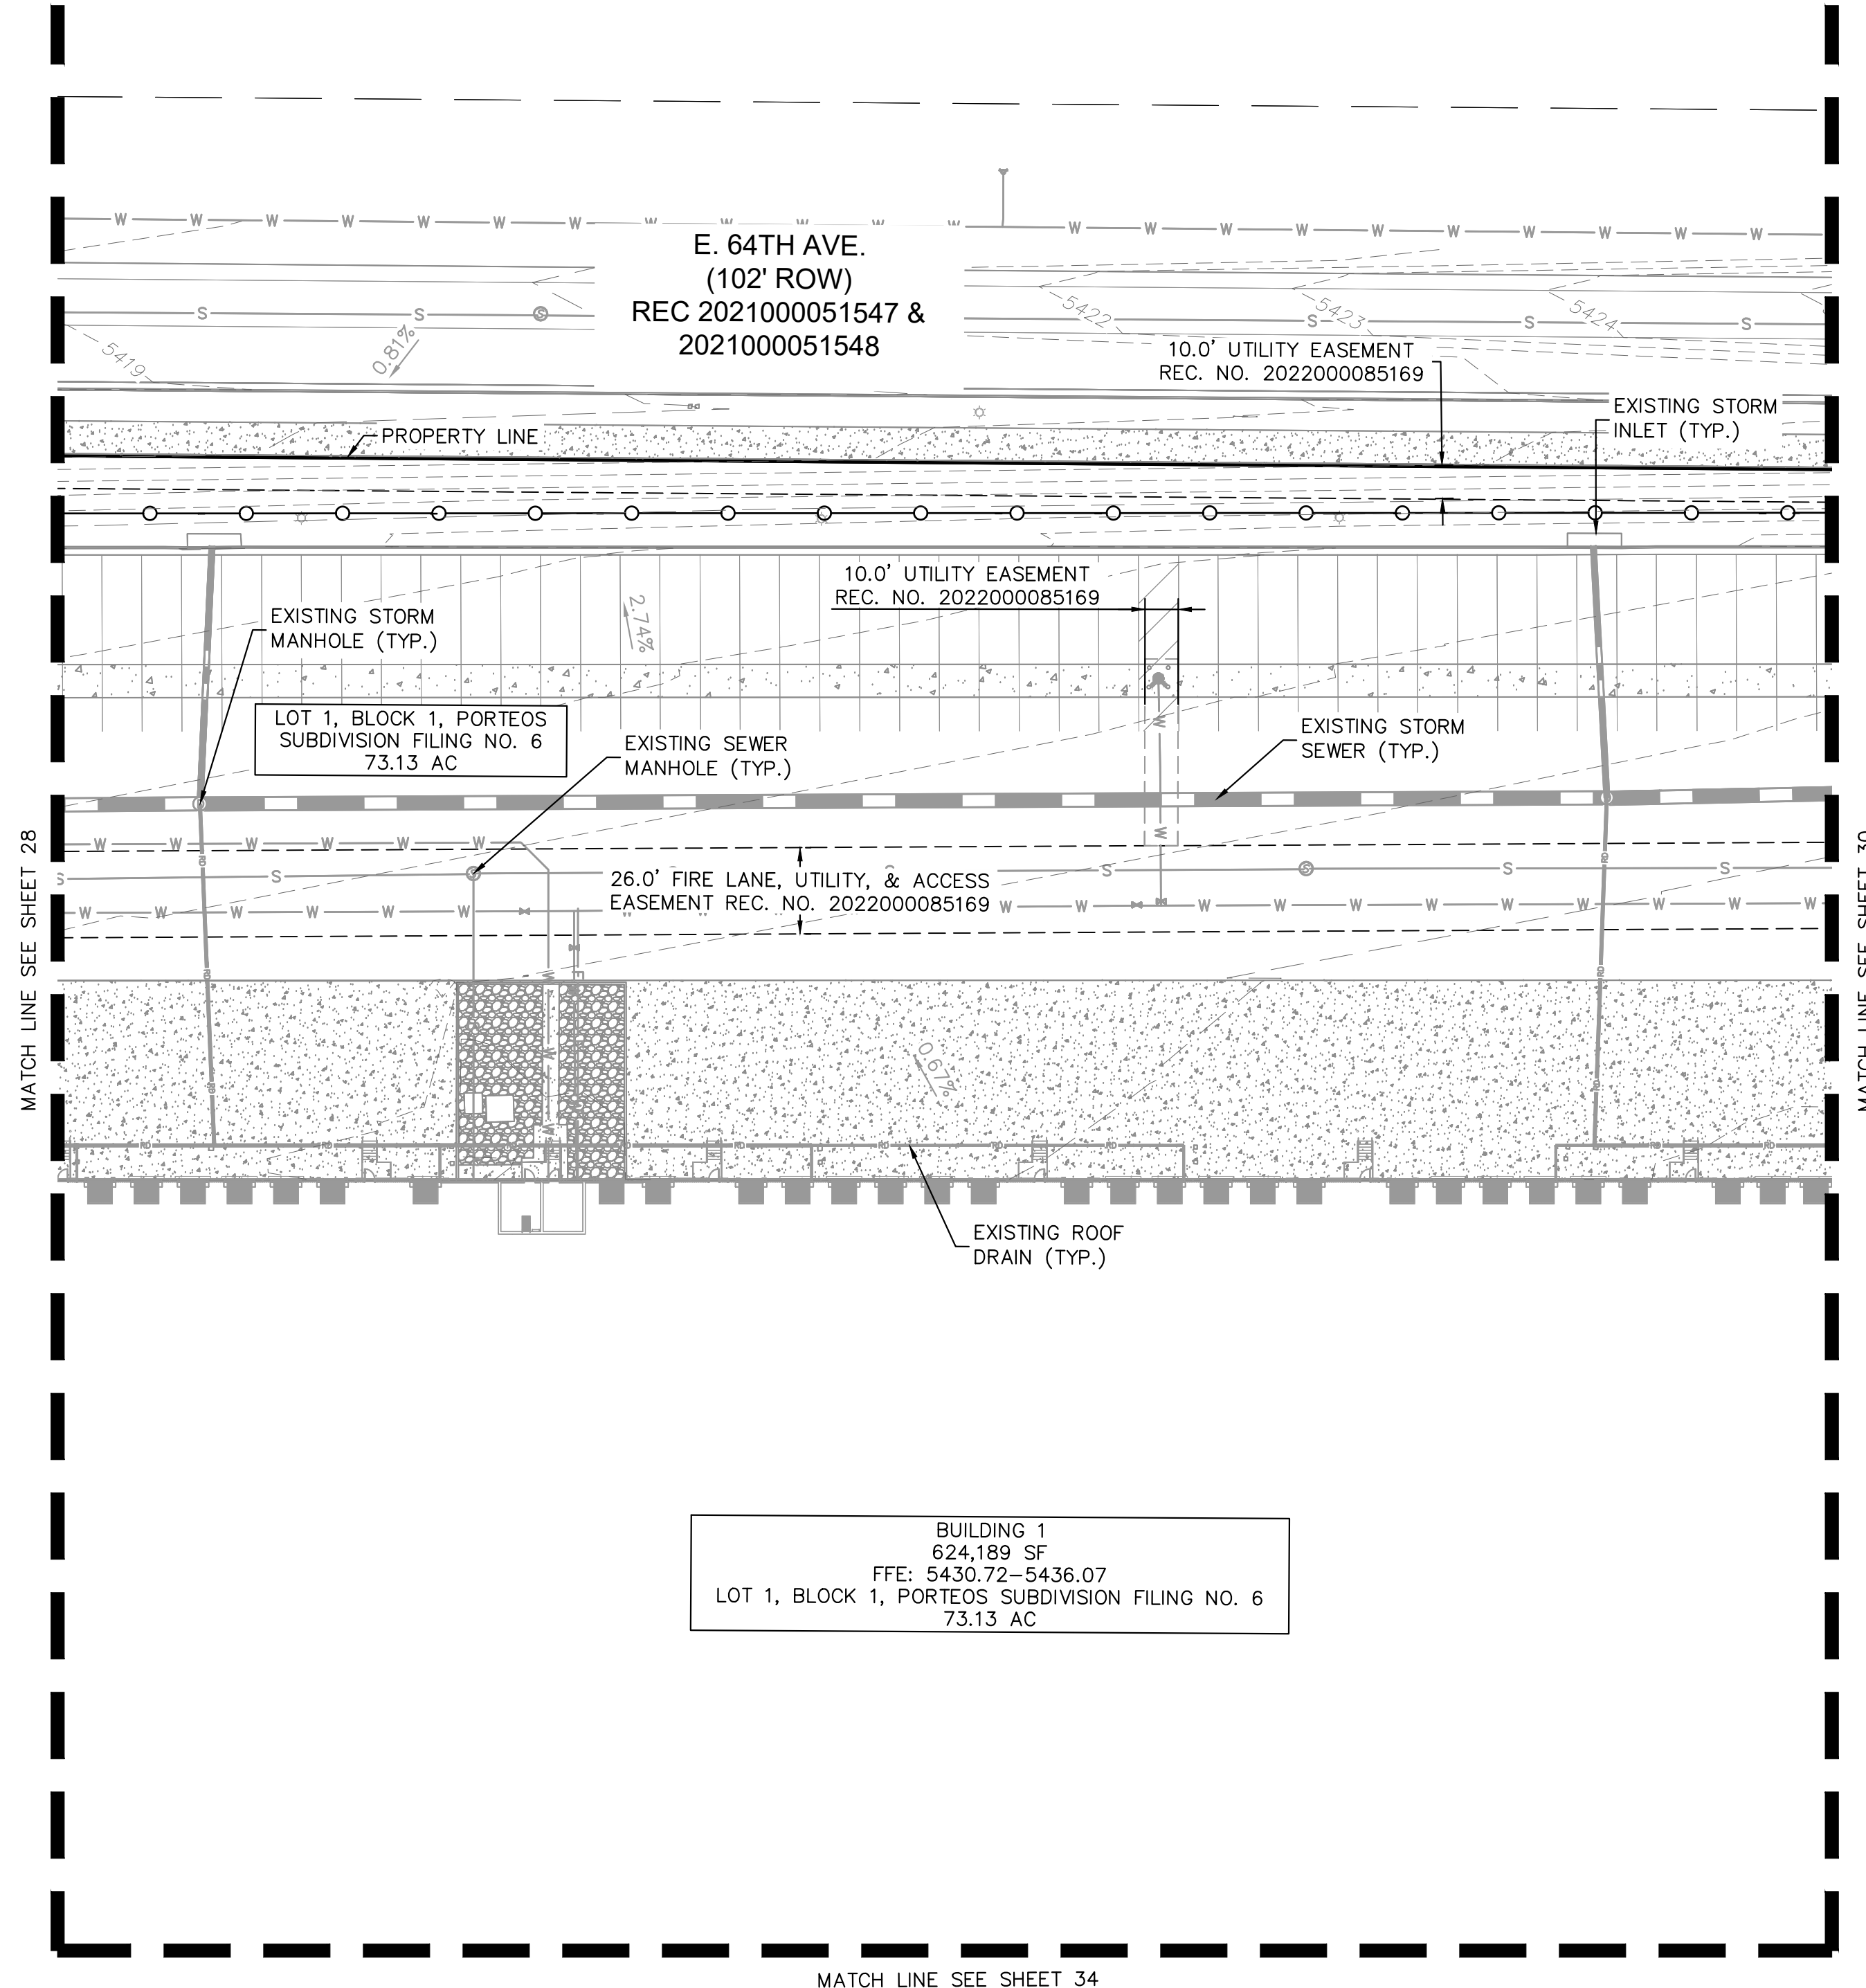

KEYMAP
NTS

LEGEND

- PROPERTY LINE
- EASEMENT LINE
- XXXX - - - - - EXISTING CONTOUR
- XXXX - - - - - PROPOSED CONTOUR
- CONCRETE CURB & GUTTER
- AR - - - - - ACCESSIBLE ROUTE
- PAVEMENT SAWCUT LINE
- X.XX% SLOPE ARROW

GRADING PLAN KEYNOTES

- 1 STORM SEWER
- 2 STORM INLET
- 3 STORM MANHOLE
- 4 ROOF DRAIN
- 5 FLARED END SECTION
- 6 FOREBAY

GRADING PLAN NOTES

1. GRADES ADJACENT TO THE BUILDING SHALL BE A MINIMUM OF 1% FOR THE FIRST 10 FEET FOR IMPERVIOUS AREA AND A MINIMUM OF 5% FOR PERVIOUS AREA PER COA CRITERIA. UNLESS OTHERWISE NOTED.
2. STORMWATER INFRASTRUCTURE OWNERSHIP SHALL BE DESIGNATED BY THE CONSTRUCTION DOCUMENTS.
3. MAXIMUM 2% SLOPE IN ANY DIRECTION AT HANDICAP PARKING SPACES.
4. THE MAXIMUM LONGITUDINAL SLOPE WITHIN A FIRE LANE EASEMENT SHALL NOT EXCEED 10%. THE TRANSVERSE SLOPE SHALL GENERALLY HAVE A 2% BUT NOT EXCEEDING 4%. THE RESULTANT SLOPE SHALL NOT EXCEED 10%.

Kimley»Horn
KIMLEY-HORN AND ASSOCIATES, INC.
6205 S. HANCOCK
GREENWOOD VILLAGE, CO 80111 (303) 228-2300


PORTEOS INDUSTRIAL AT PORTEOS
CITY OF AURORA, COUNTY OF ADAMS
SITE PLAN AMENDMENT
DETAILED GRADING PLAN

DATE: 03/22/2024
DESIGNED BY: CAO
DRAWN BY: AGM
CHECKED BY: BJC

FILE NO.
196617002_GD DTL-DIA 1
PROJECT NO.
196617002


SHEET NO.

K:\DEN_Civil\196617002 DIA1\CADD\PlanSheets\CSP\196617002_GD DTL-DIA I.dwg Mavis, August 3/27/2024 10:14 AM

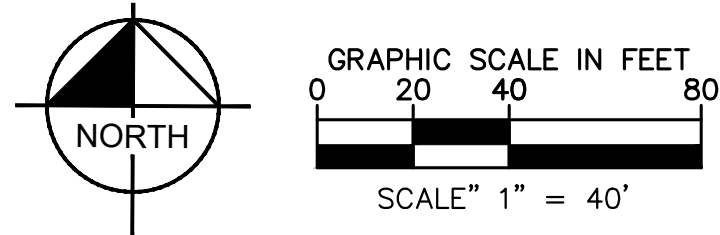

PORTEOS INDUSTRIAL AT PORTEOS SITE PLAN AMENDMENT

LOCATED IN THE NW $\frac{1}{4}$ OF SECTION 9,
TOWNSHIP 3 SOUTH, RANGE 65 WEST OF THE 6TH P.M.,
CITY OF AURORA, ADAMS COUNTY, STATE OF COLORADO

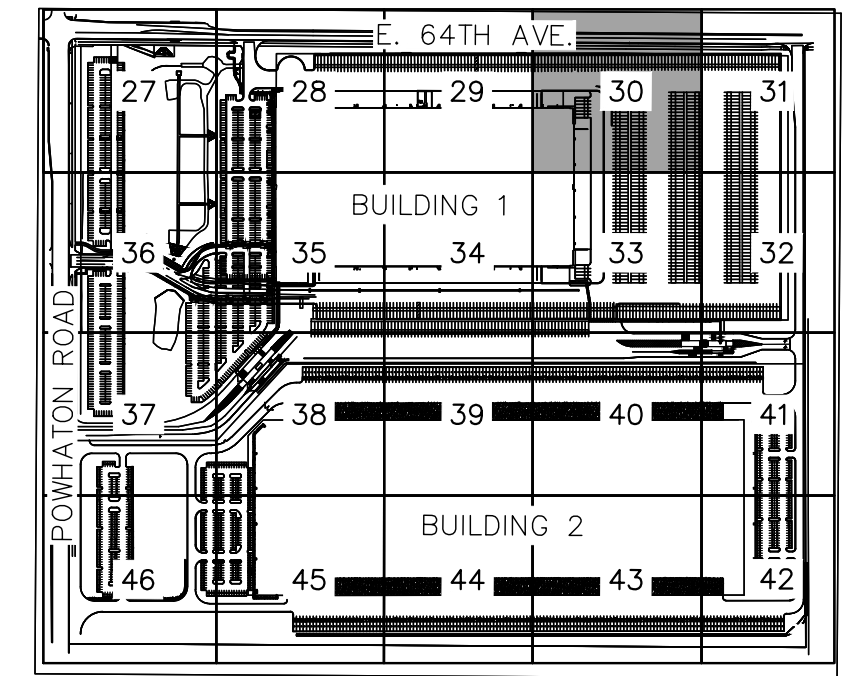

KEYMAP
NTS

LEGEND


- PROPERTY LINE
- EASEMENT LINE
- XXXX EXISTING CONTOUR
- XXXX PROPOSED CONTOUR
- CONCRETE CURB & GUTTER
- AR ACCESSIBLE ROUTE
- PAVEMENT SAWCUT LINE
- X.XX% SLOPE ARROW

GRADING PLAN KEYNOTES

- 1 STORM SEWER
- 2 STORM INLET
- 3 STORM MANHOLE
- 4 ROOF DRAIN
- 5 FLARED END SECTION
- 6 FOREBAY

GRADING PLAN NOTES

1. GRADES ADJACENT TO THE BUILDING SHALL BE A MINIMUM OF 1% FOR THE FIRST 10 FEET FOR IMPERVIOUS AREA AND A MINIMUM OF 5% FOR PERVIOUS AREA PER COA CRITERIA. UNLESS OTHERWISE NOTED.
2. STORMWATER INFRASTRUCTURE OWNERSHIP SHALL BE DESIGNATED BY THE CONSTRUCTION DOCUMENTS.
3. MAXIMUM 2% SLOPE IN ANY DIRECTION AT HANDICAP PARKING SPACES.
4. THE MAXIMUM LONGITUDINAL SLOPE WITHIN A FIRE LANE EASEMENT SHALL NOT EXCEED 10%. THE TRANSVERSE SLOPE SHALL GENERALLY HAVE A 2% BUT NOT EXCEEDING 4%. THE RESULTANT SLOPE SHALL NOT EXCEED 10%.

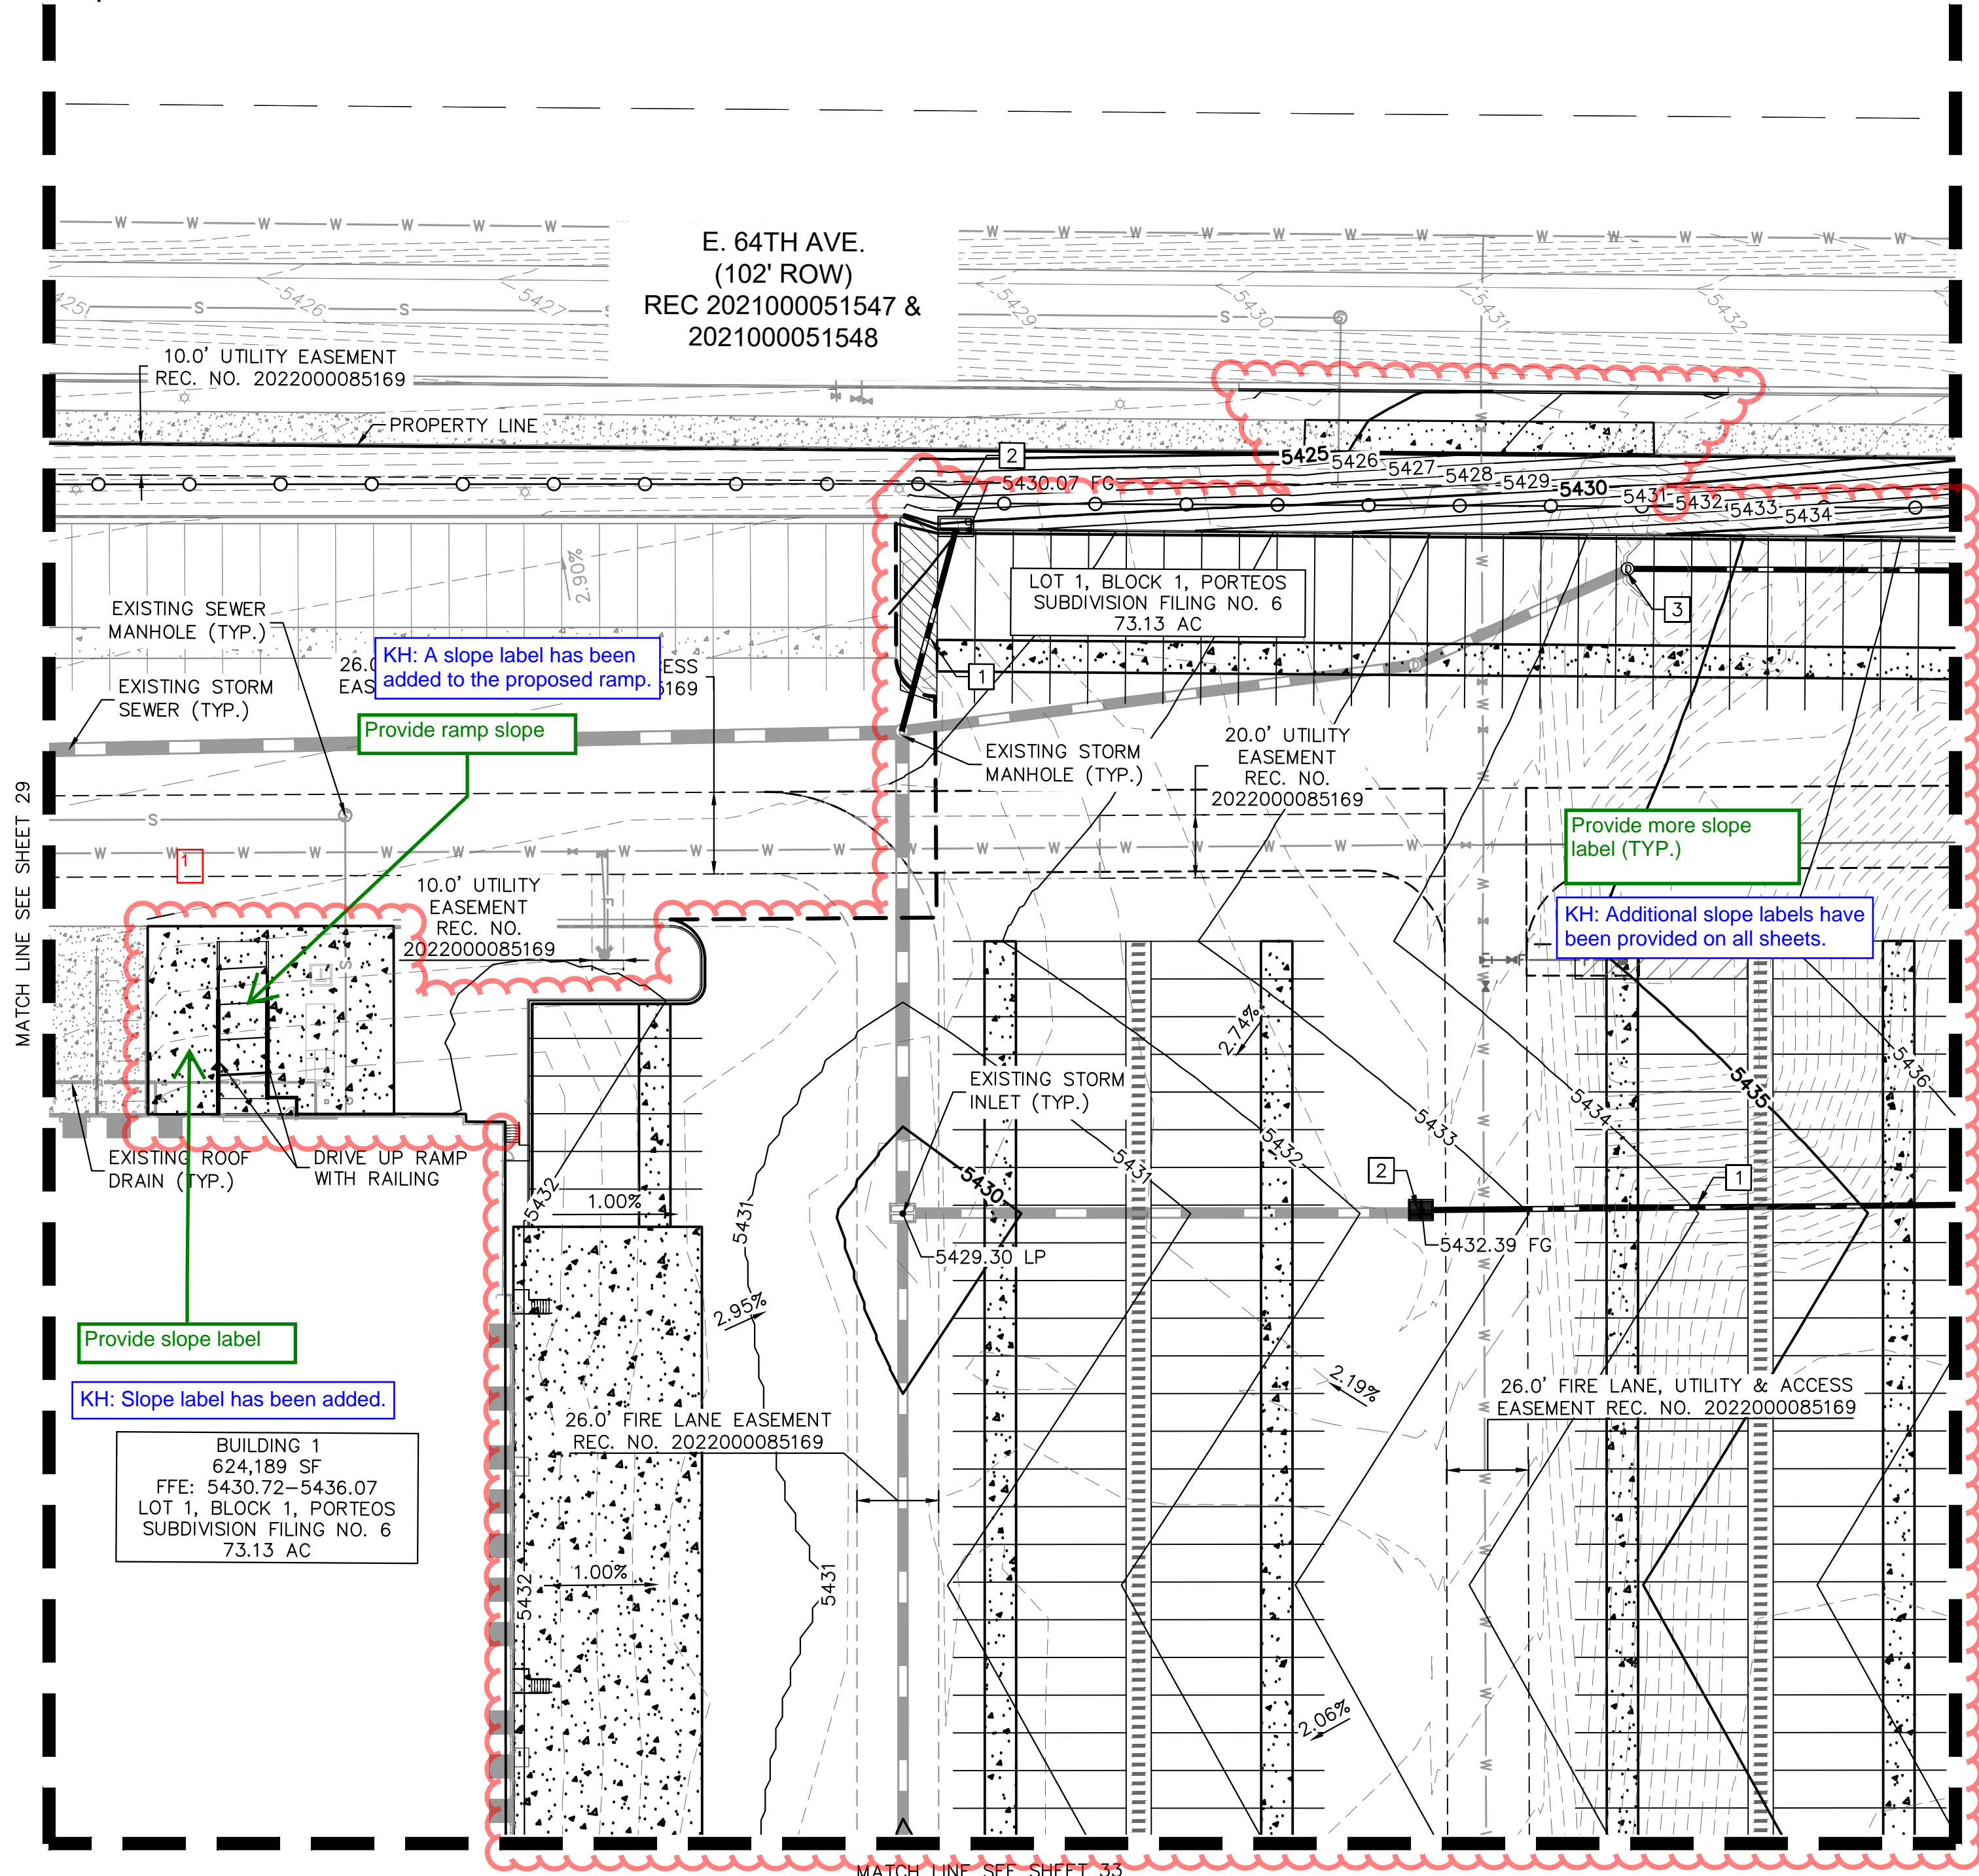



Kimley»Horn
KIMLEY-HORN AND ASSOCIATES, INC.
6205 S. WILLOW
Greenwood Village, CO 80111 (303) 228-2300

PORTEOS INDUSTRIAL AT PORTEOS
CITY OF AURORA, COUNTY OF ADAMS
SITE PLAN AMENDMENT
DETAILED GRADING PLAN

DATE: 03/22/2024
DESIGNED BY: CAO
DRAWN BY: AGM
CHECKED BY: BUC

FILE NO.
196617002_GD DTL-DIA I
PROJECT NO.
196617002

SHEET NO.

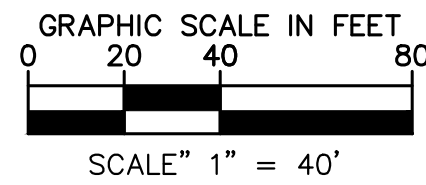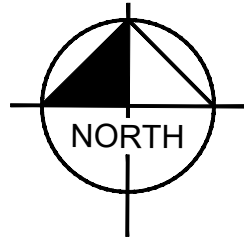


PORTEOS INDUSTRIAL AT PORTEOS

SITE PLAN AMENDMENT

LOCATED IN THE NW $\frac{1}{4}$ OF SECTION 9,
TOWNSHIP 3 SOUTH, RANGE 65 WEST OF THE 6TH P.M.,
CITY OF AURORA, ADAMS COUNTY, STATE OF COLORADO

This sheet is an added sheet from the approved set. Please bubble the entire page including the title block.

KH: Rev cloud has been updated to the entire page.

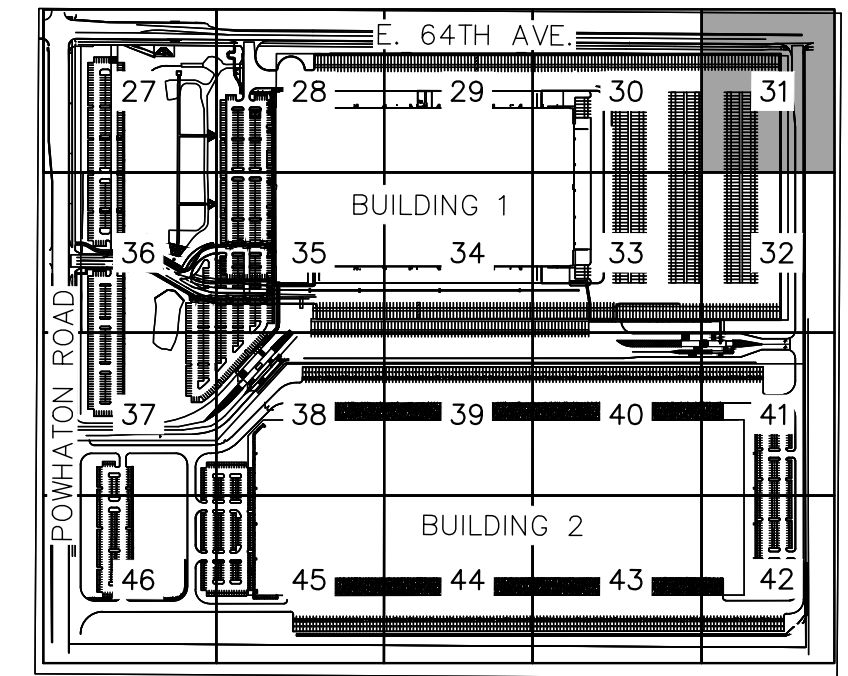

LEGEND


- PROPERTY LINE
- EASEMENT LINE
- XXXX - - - - EXISTING CONTOUR
- XXXX - - - - PROPOSED CONTOUR
- CONCRETE CURB & GUTTER
- AR - - - - ACCESSIBLE ROUTE
- PAVEMENT SAWCUT LINE
- X.XX% SLOPE ARROW

GRADING PLAN KEYNOTES

- 1 STORM SEWER
- 2 STORM INLET
- 3 STORM MANHOLE
- 4 ROOF DRAIN
- 5 FLARED END SECTION
- 6 FOREBAY

GRADING PLAN NOTES

- GRADES ADJACENT TO THE BUILDING SHALL BE A MINIMUM OF 1% FOR THE FIRST 10 FEET FOR IMPERVIOUS AREA AND A MINIMUM OF 5% FOR PERVIOUS AREA PER COA CRITERIA. UNLESS OTHERWISE NOTED.
- STORMWATER INFRASTRUCTURE OWNERSHIP SHALL BE DESIGNATED BY THE CONSTRUCTION DOCUMENTS.
- MAXIMUM 2% SLOPE IN ANY DIRECTION AT HANDICAP PARKING SPACES.
- THE MAXIMUM LONGITUDINAL SLOPE WITHIN A FIRE LANE EASEMENT SHALL NOT EXCEED 10%. THE TRANSVERSE SLOPE SHALL GENERALLY HAVE A 2% BUT NOT EXCEEDING 4%. THE RESULTANT SLOPE SHALL NOT EXCEED 10%.

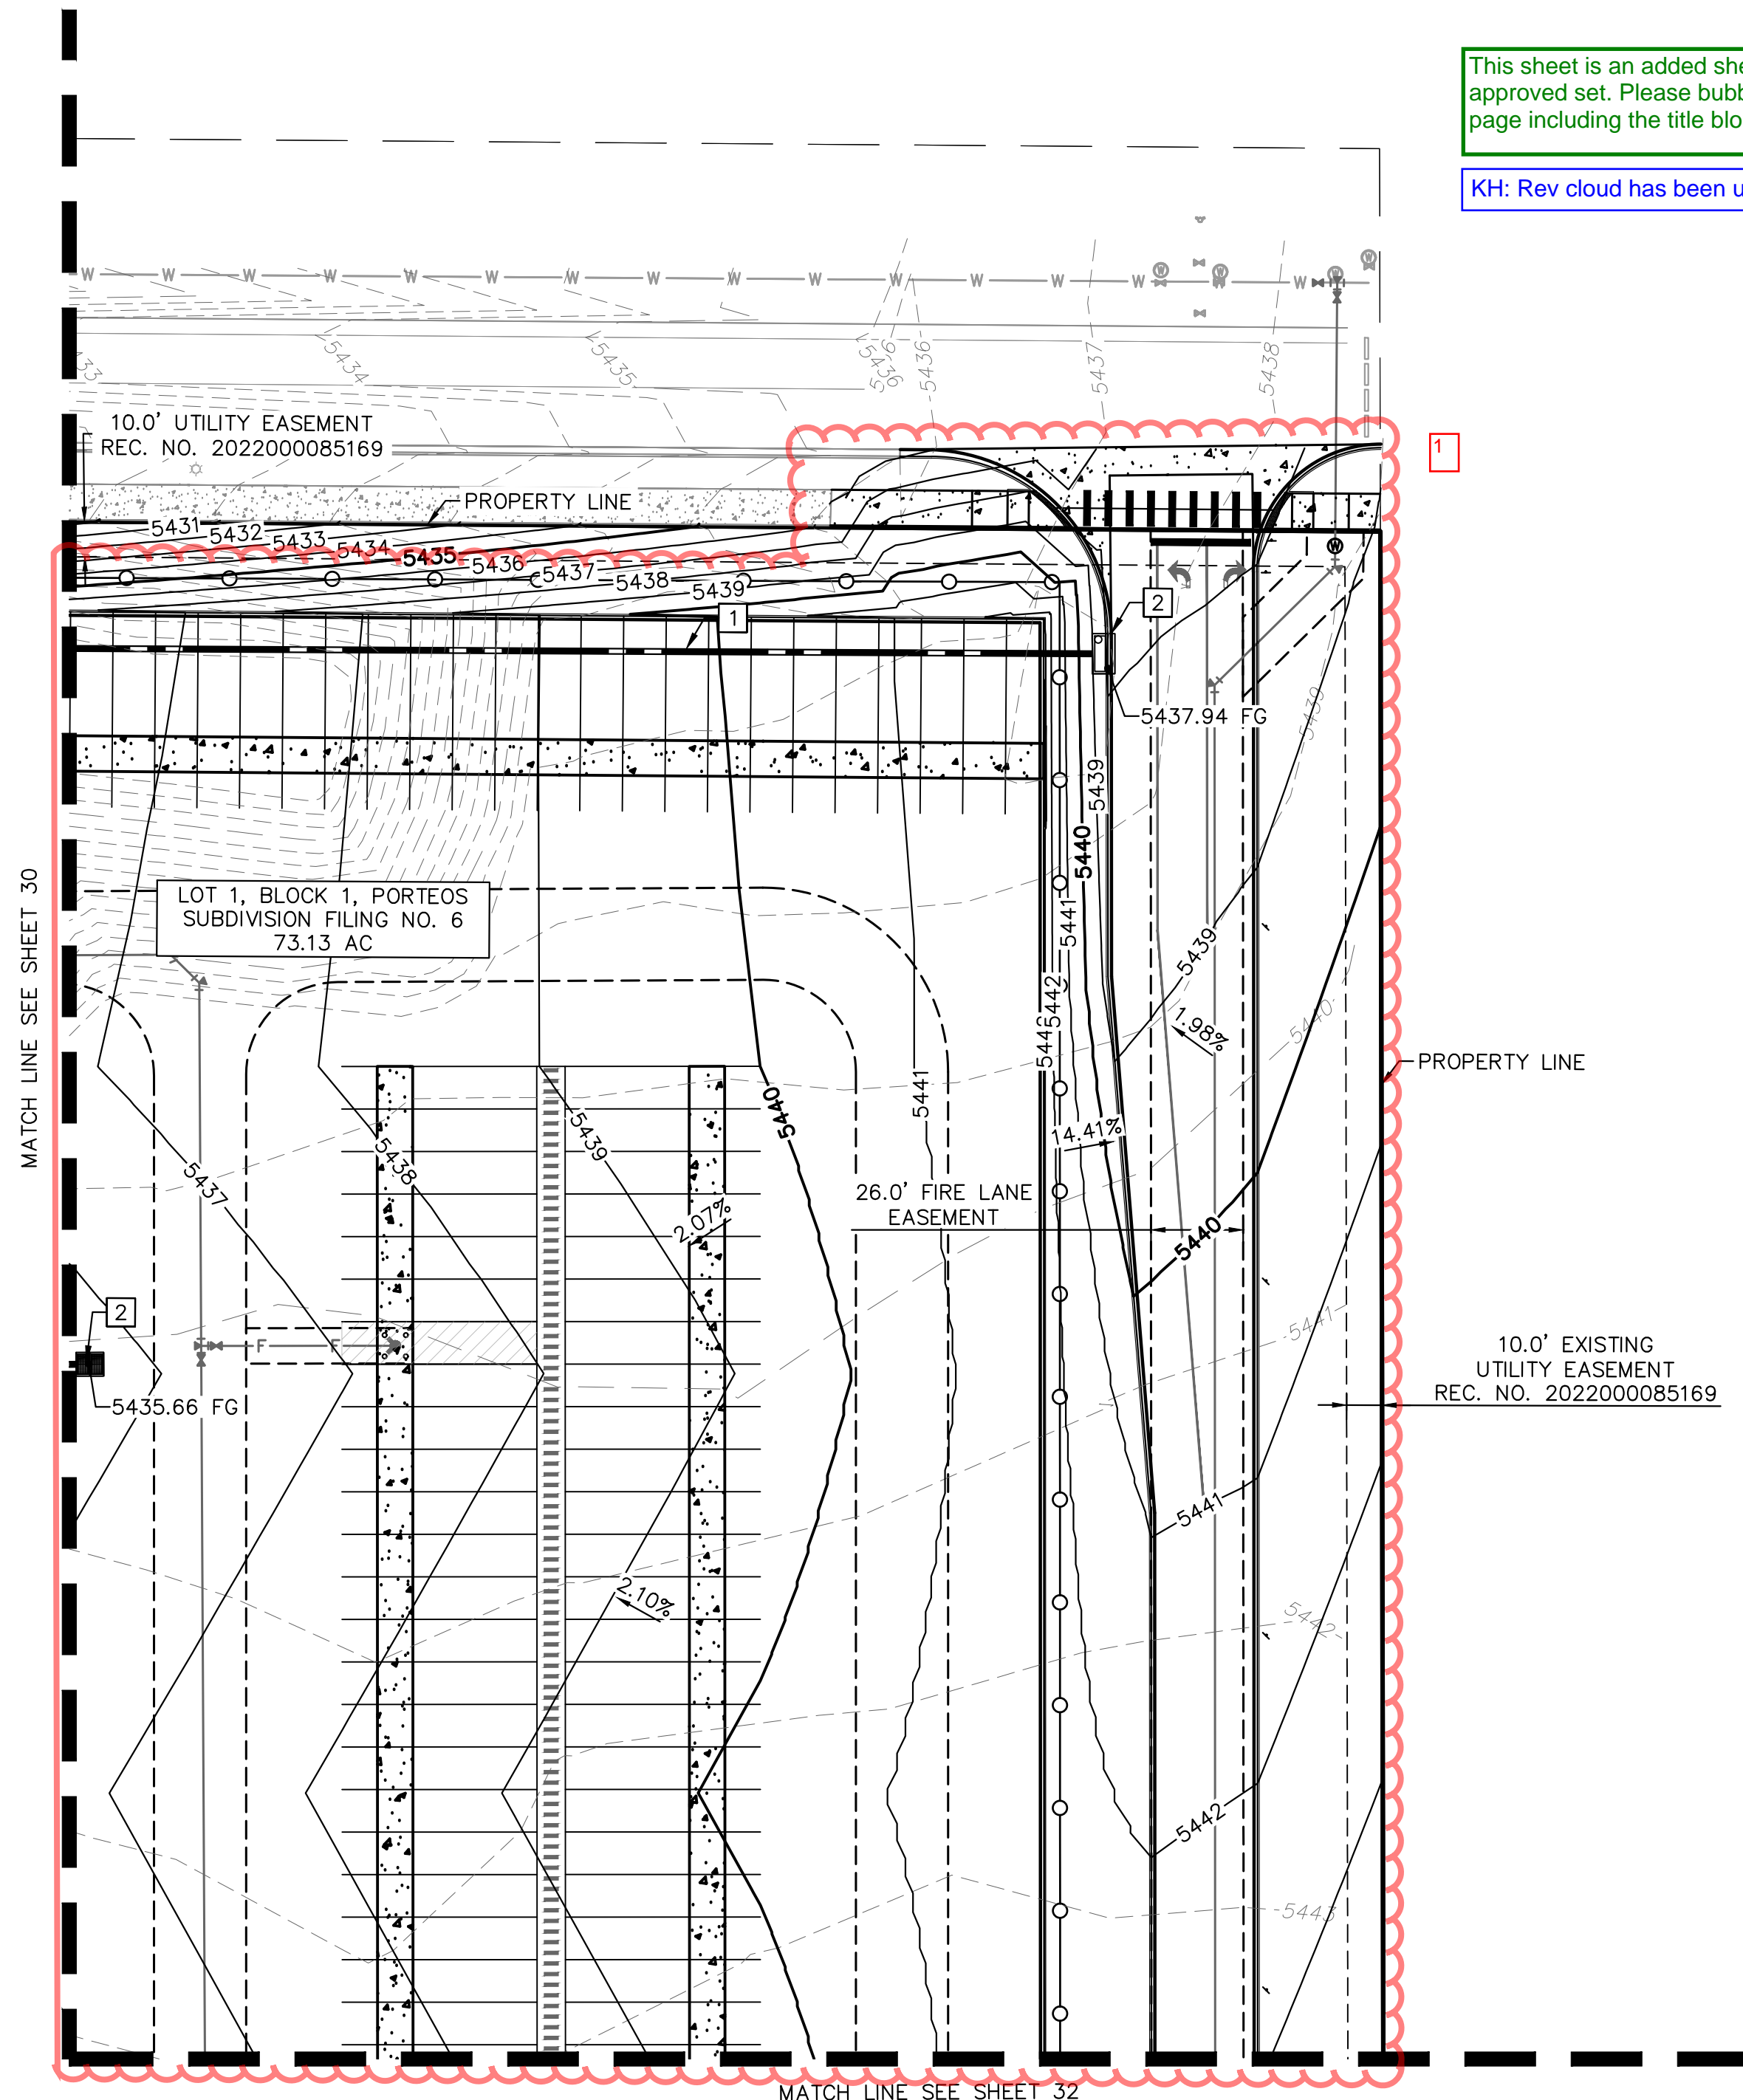

Kimley»Horn

KIMLEY-HORN AND ASSOCIATES, INC.
6205 S. WILLOW
Greenwood Village, CO 80111 (303) 228-2300


PORTEOS INDUSTRIAL AT PORTEOS
CITY OF AURORA, COUNTY OF ADAMS
SITE PLAN AMENDMENT
DETAILED GRADING PLAN

DATE: 03/22/2024
DESIGNED BY: CAO
DRAWN BY: AGM
CHECKED BY: BJC



FILE NO.
196617002_GD DTL-PA-1
PROJECT NO.
196617002

SHEET NO.

K:\DEN_Civil\196617002 DIA1\CADD\PlanSheets\CSP\196617002_GD DTL-DIA I.dwg Mavis, August 3/27/2024 10:14 AM

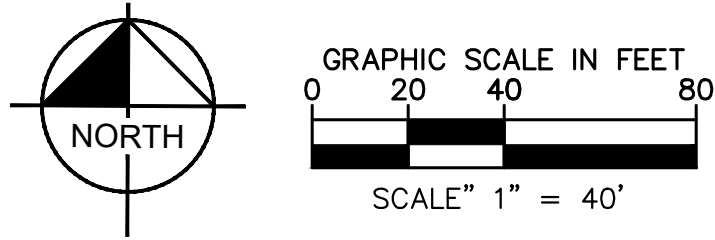

PORTEOS INDUSTRIAL AT PORTEOS
SITE PLAN AMENDMENT
LOCATED IN THE NW ¼ OF SECTION 9,
TOWNSHIP 3 SOUTH, RANGE 65 WEST OF THE 6TH P.M.,
CITY OF AURORA, ADAMS COUNTY, STATE OF COLORADO

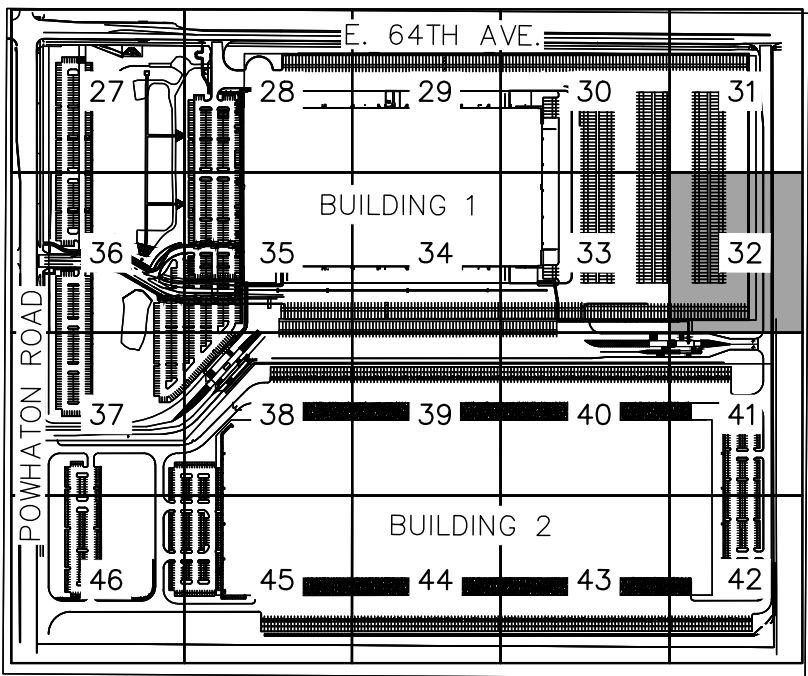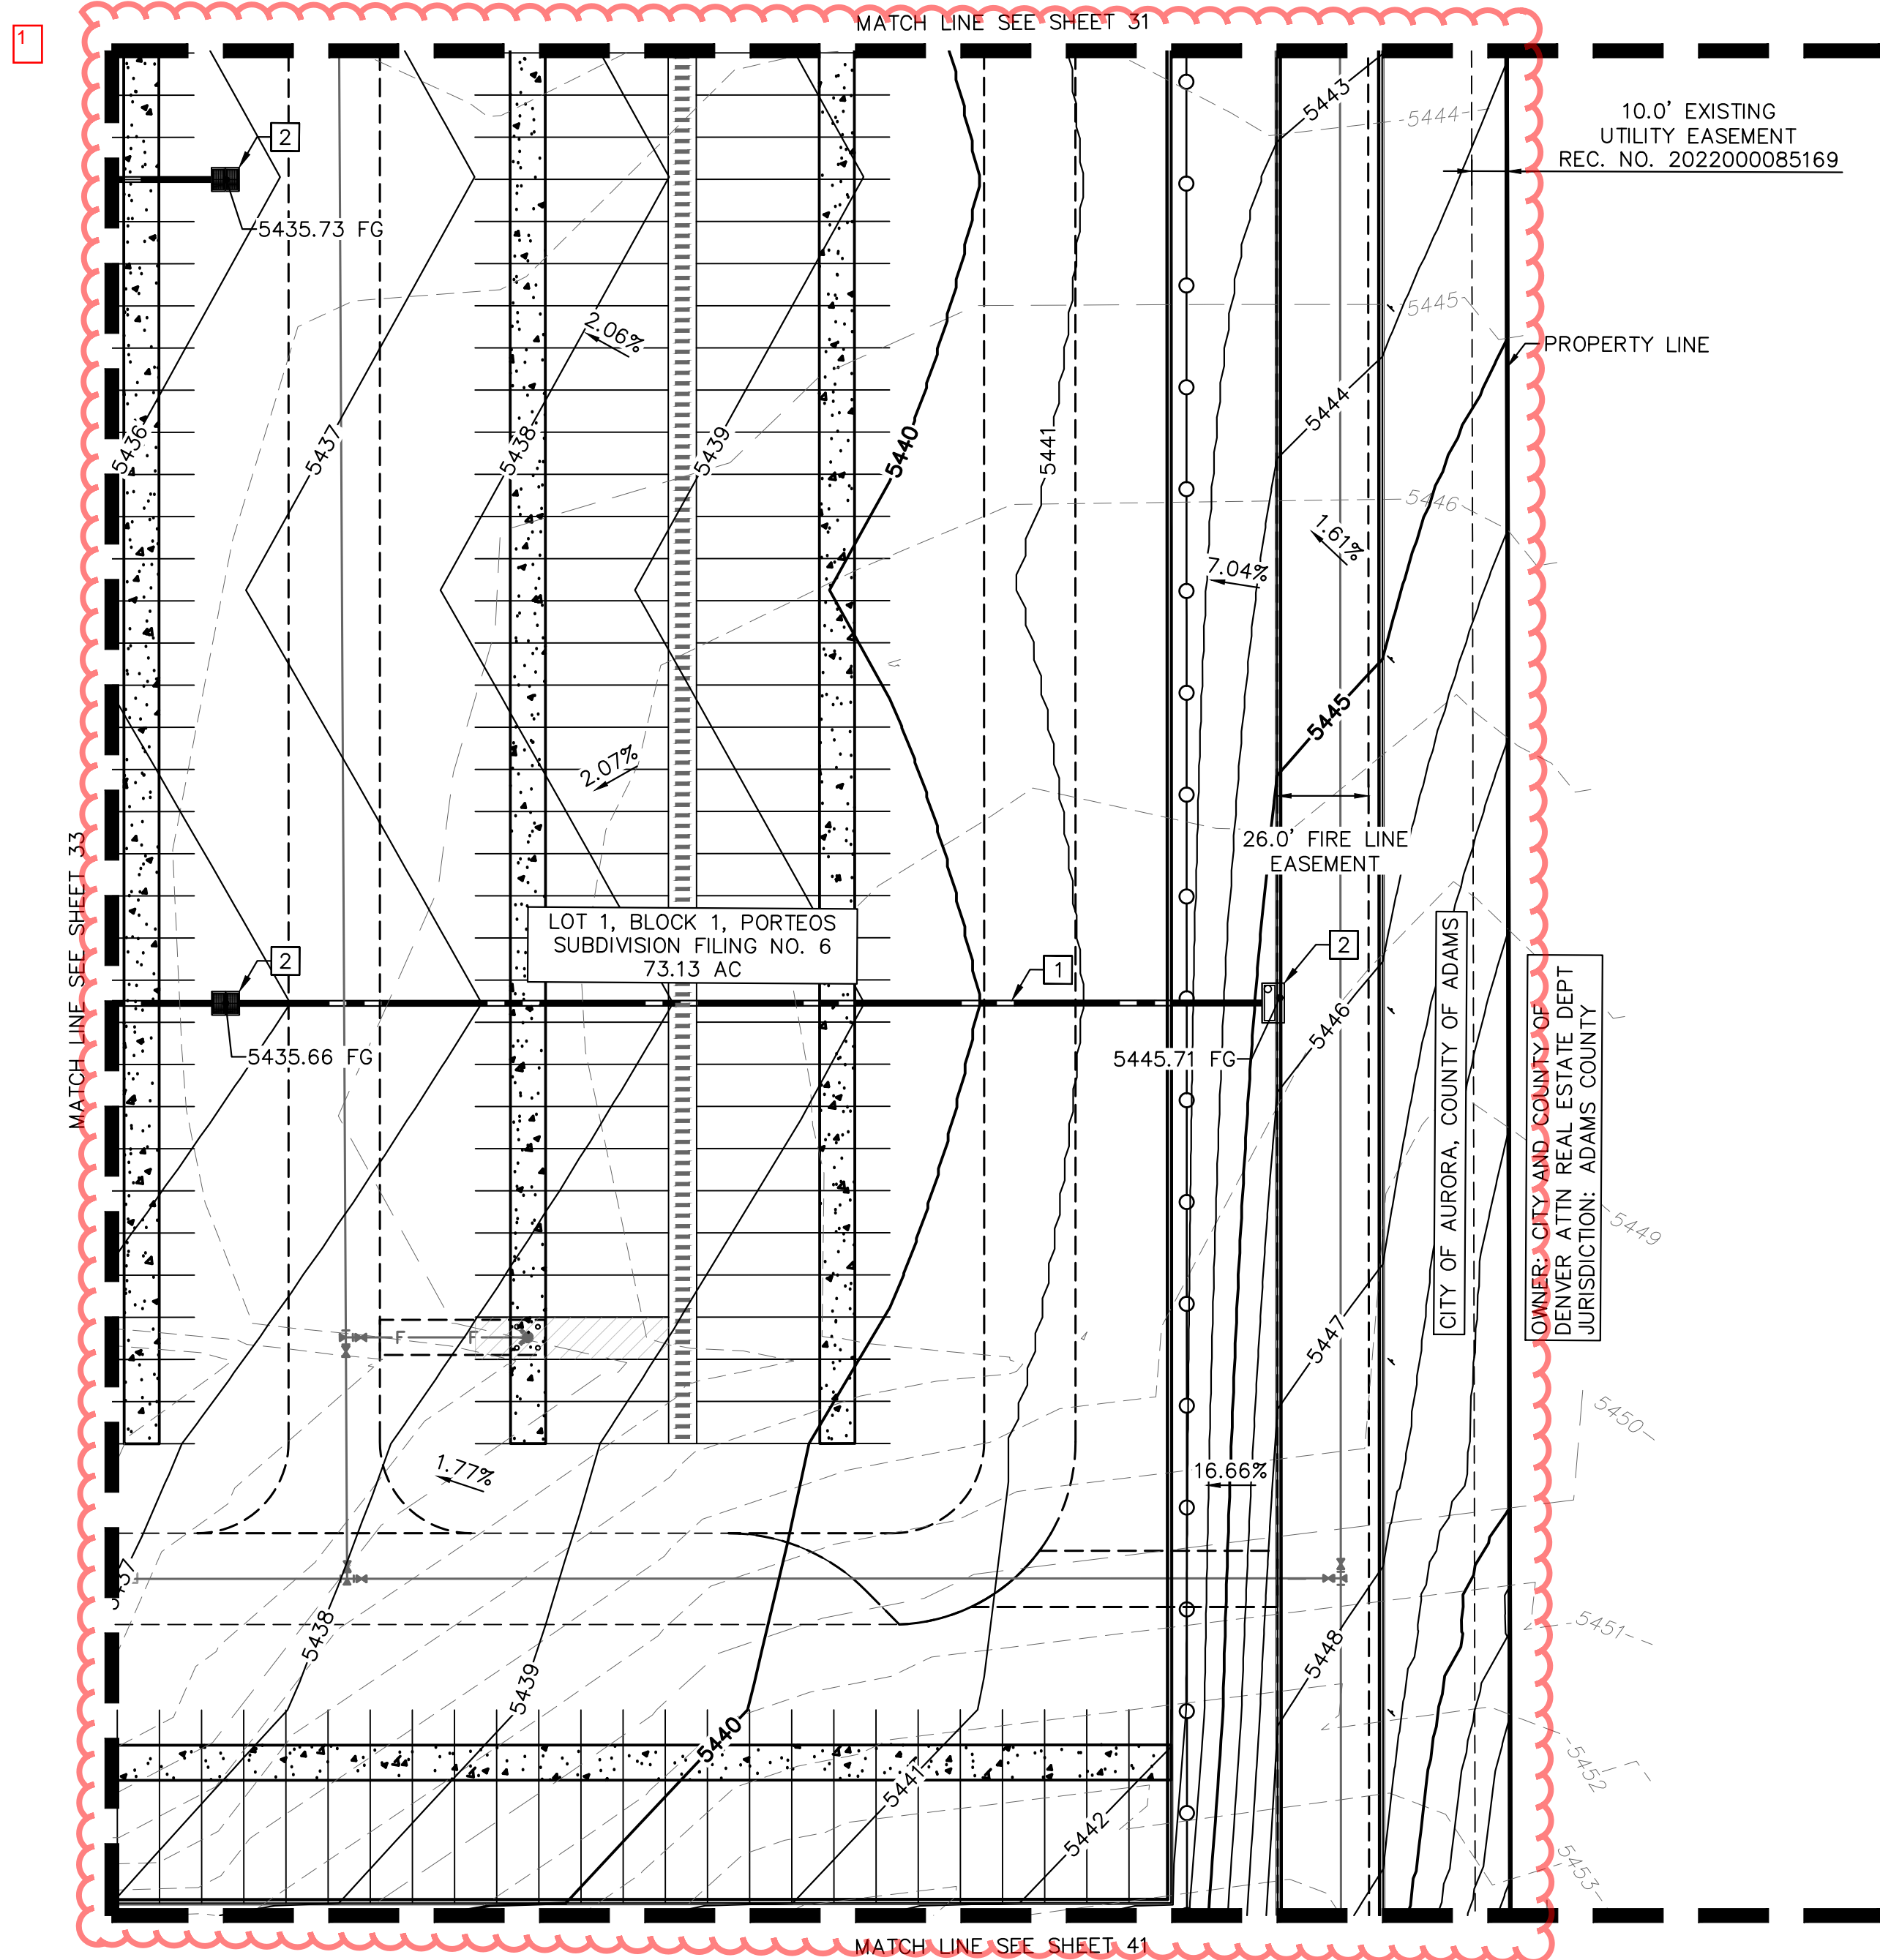

KEYMAP
NTS

LEGEND

- PROPERTY LINE
- EASEMENT LINE
- XXXX - - - - EXISTING CONTOUR
- XXXX - - - - PROPOSED CONTOUR
- CONCRETE CURB & GUTTER
- AR - - - - ACCESSIBLE ROUTE
- PAVEMENT SAWCUT LINE
- X.XX% SLOPE ARROW

GRADING PLAN KEYNOTES

- 1 STORM SEWER
- 2 STORM INLET
- 3 STORM MANHOLE
- 4 ROOF DRAIN
- 5 FLARED END SECTION
- 6 FOREBAY

GRADING PLAN NOTES

- GRADES ADJACENT TO THE BUILDING SHALL BE A MINIMUM OF 1% FOR THE FIRST 10 FEET FOR IMPERVIOUS AREA AND A MINIMUM OF 5% FOR PERVIOUS AREA PER COA CRITERIA. UNLESS OTHERWISE NOTED.
- STORMWATER INFRASTRUCTURE OWNERSHIP SHALL BE DESIGNATED BY THE CONSTRUCTION DOCUMENTS.
- MAXIMUM 2% SLOPE IN ANY DIRECTION AT HANDICAP PARKING SPACES.
- THE MAXIMUM LONGITUDINAL SLOPE WITHIN A FIRE LANE EASEMENT SHALL NOT EXCEED 10%. THE TRANSVERSE SLOPE SHALL GENERALLY HAVE A 2% BUT NOT EXCEEDING 4%. THE RESULTANT SLOPE SHALL NOT EXCEED 10%.


SHEET NO.		FILE NO.		DATE: 03/22/2024		PORTEOS INDUSTRIAL AT PORTEOS					Kimley»Horn																																																																																																																																																																																																																																																																																																																																																																																																																																																																																																																																																																																																																																																																																																																																																																																																																																																																																																																																																																																																																																																																																																																																																																																																						
-----------	--	----------	--	------------------	--	-------------------------------	--	--	--	--	-------------	--	--	
Kimley»Horn

KIMLEY-HORN AND ASSOCIATES, INC.
6205 S. HANCOCK
GREENWOOD VILLAGES, CO 80111 (303) 228-2300


CHANG
ES
SO
3/25/24
BJS

K:\DEN_Civil\196617002 DIA1\CADD\PlanSheets\CSP\196617002_GD DTL-DIA I.dwg Mavis, August 3/27/2024 10:15 AM

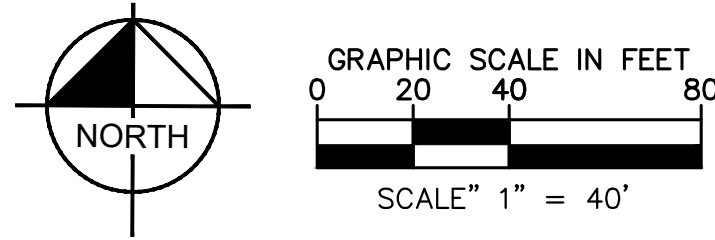

PORTEOS INDUSTRIAL AT PORTEOS SITE PLAN AMENDMENT

LOCATED IN THE NW $\frac{1}{4}$ OF SECTION 9,
TOWNSHIP 3 SOUTH, RANGE 65 WEST OF THE 6TH P.M.,
CITY OF AURORA, ADAMS COUNTY, STATE OF COLORADO

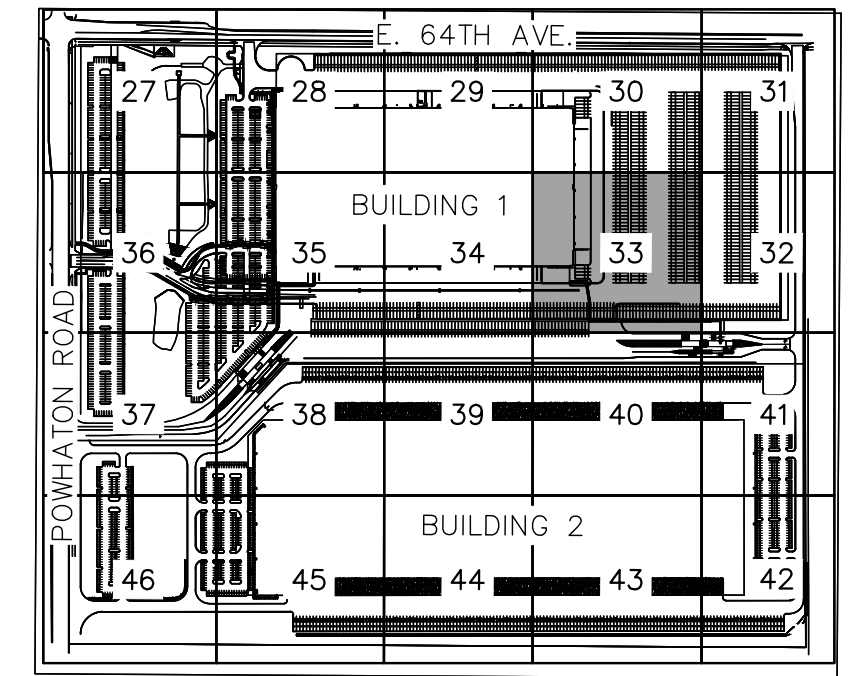

LEGEND


- PROPERTY LINE
- EASEMENT LINE
- XXXX - - - EXISTING CONTOUR
- XXXX - - - PROPOSED CONTOUR
- CONCRETE CURB & GUTTER
- AR ACCESSIBLE ROUTE
- PAVEMENT SAWCUT LINE
- X.XX% SLOPE ARROW

GRADING PLAN KEYNOTES

- 1 STORM SEWER
- 2 STORM INLET
- 3 STORM MANHOLE
- 4 ROOF DRAIN
- 5 FLARED END SECTION
- 6 FOREBAY

GRADING PLAN NOTES

- GRADES ADJACENT TO THE BUILDING SHALL BE A MINIMUM OF 1% FOR THE FIRST 10 FEET FOR IMPERVIOUS AREA AND A MINIMUM OF 5% FOR PERVIOUS AREA PER COA CRITERIA. UNLESS OTHERWISE NOTED.
- STORMWATER INFRASTRUCTURE OWNERSHIP SHALL BE DESIGNATED BY THE CONSTRUCTION DOCUMENTS.
- MAXIMUM 2% SLOPE IN ANY DIRECTION AT HANDICAP PARKING SPACES.
- THE MAXIMUM LONGITUDINAL SLOPE WITHIN A FIRE LANE EASEMENT SHALL NOT EXCEED 10%. THE TRANSVERSE SLOPE SHALL GENERALLY HAVE A 2% BUT NOT EXCEEDING 4%. THE RESULTANT SLOPE SHALL NOT EXCEED 10%.

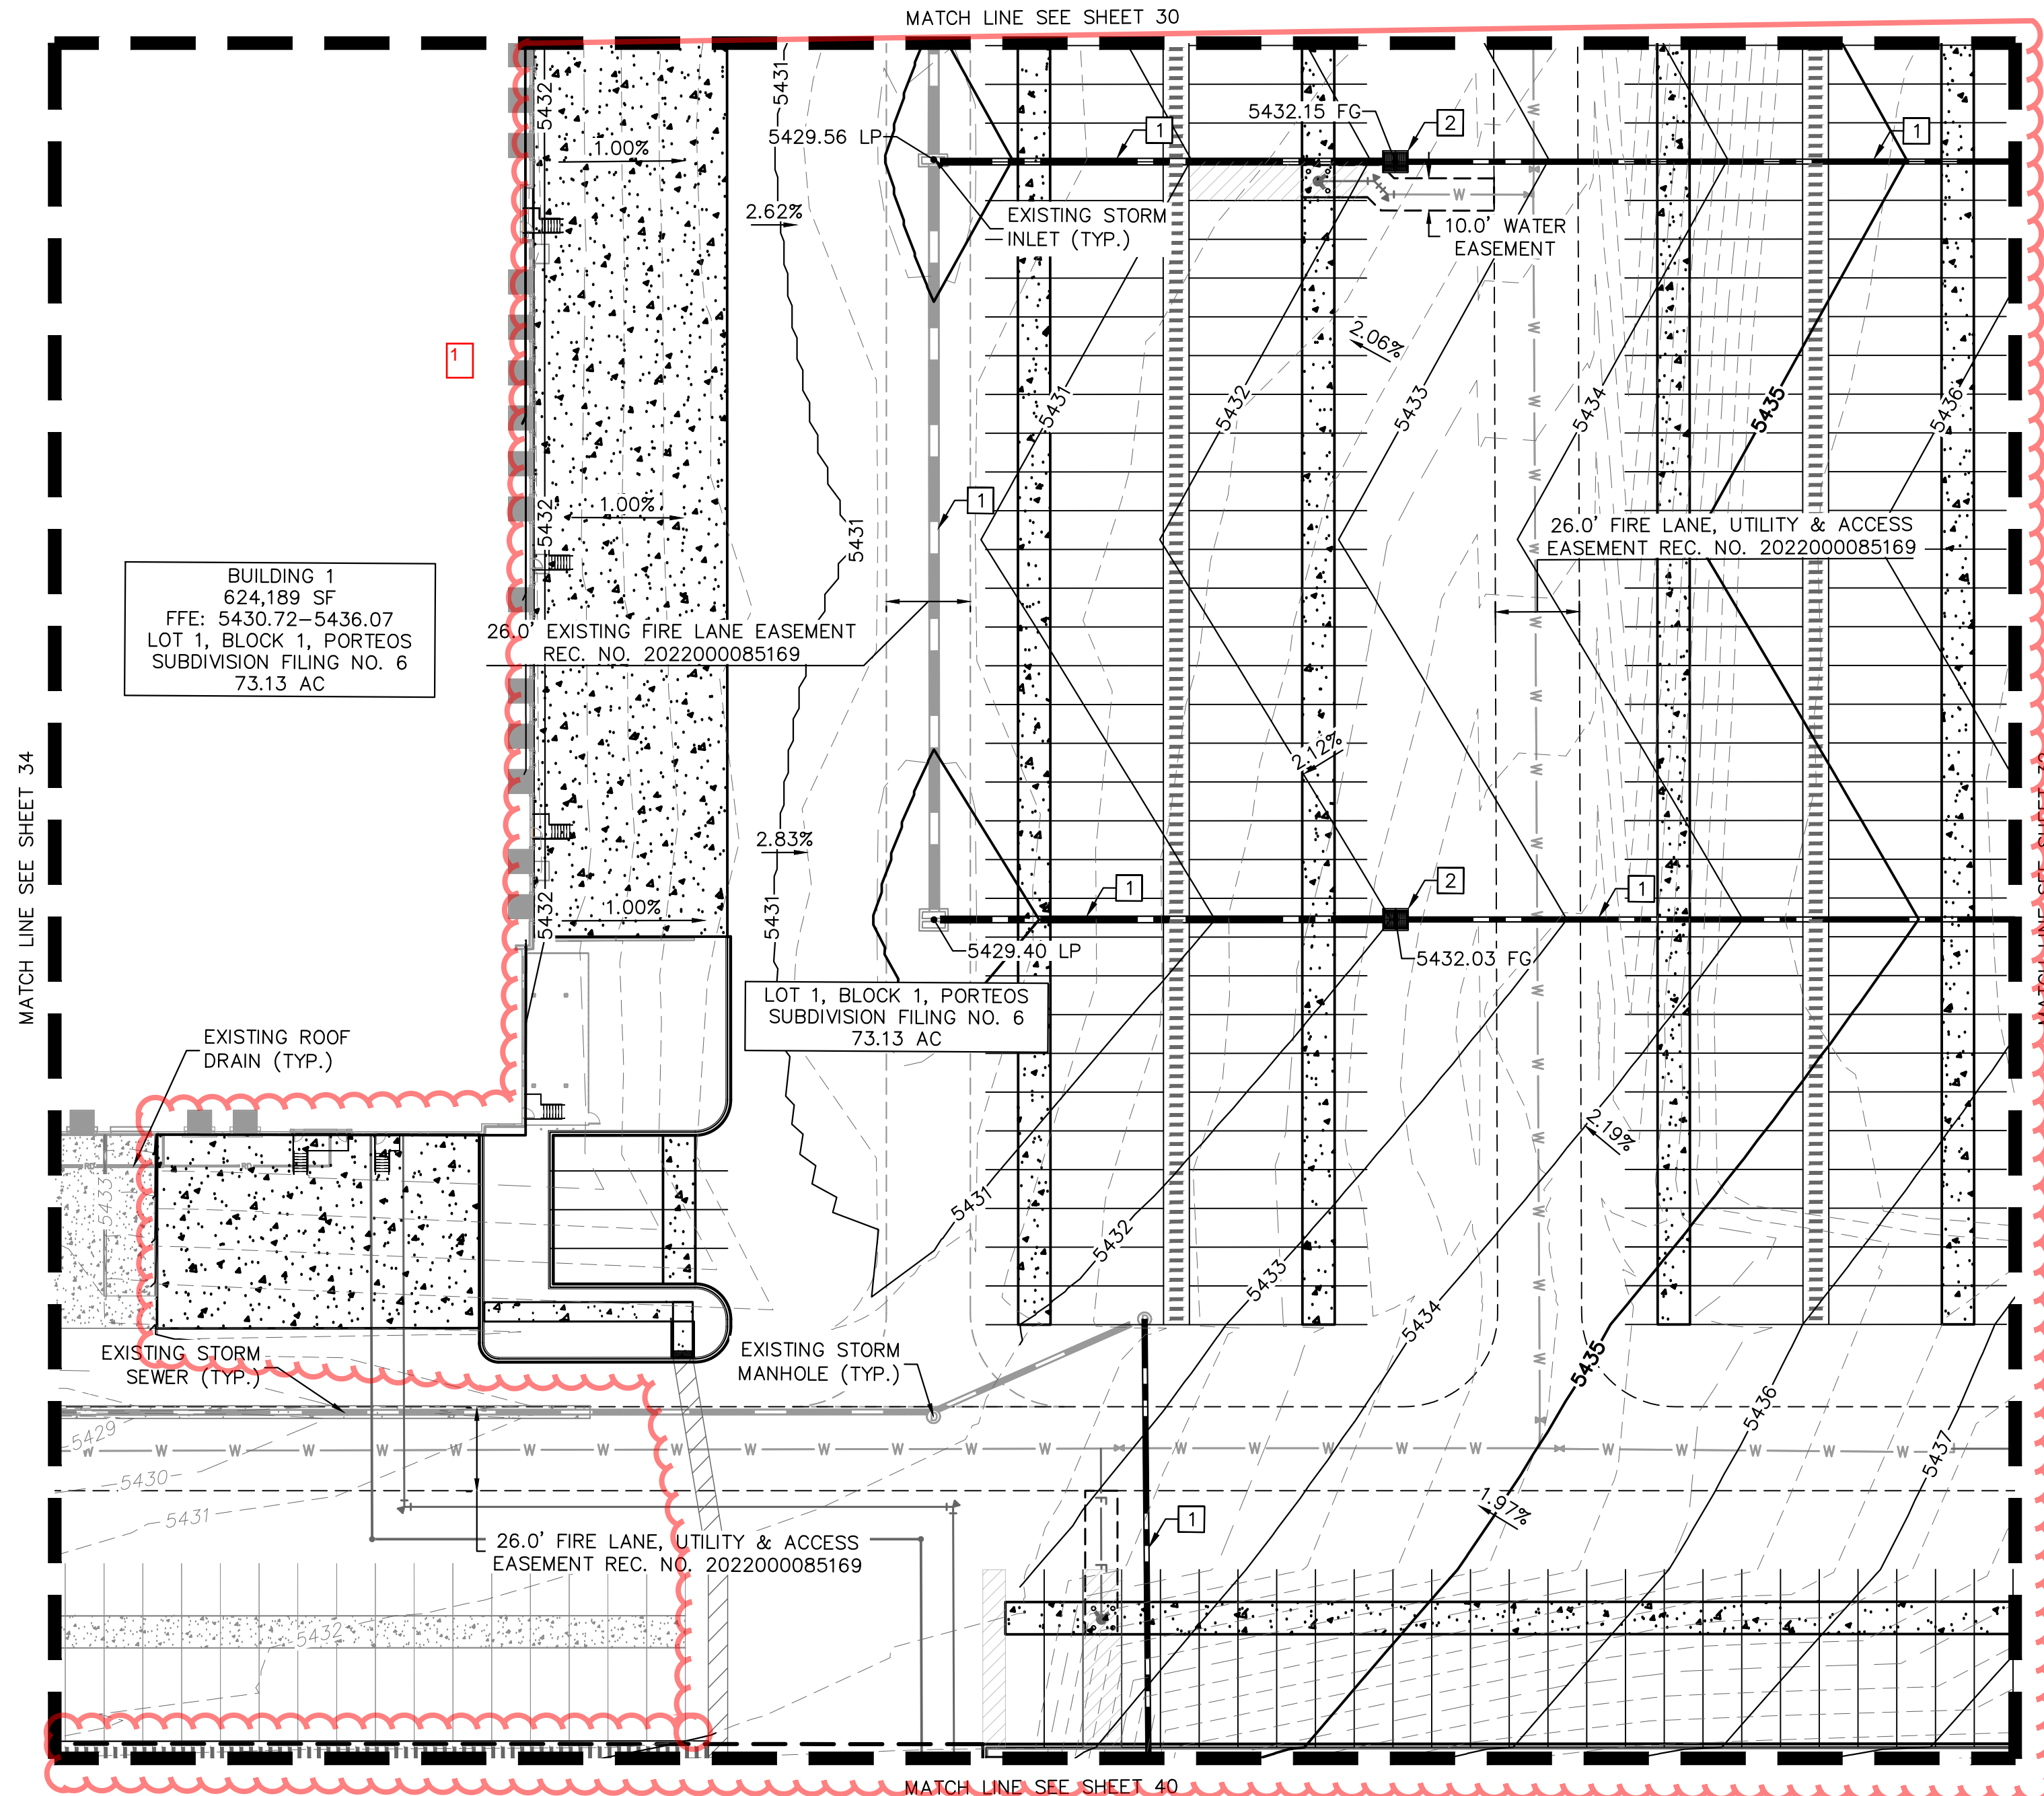

Kimley»Horn
KIMLEY-HORN AND ASSOCIATES, INC.
6205 S. HARRISON
Greenwood Village, CO 80111 (303) 228-2300


PORTEOS INDUSTRIAL AT PORTEOS
CITY OF AURORA, COUNTY OF ADAMS
SITE PLAN AMENDMENT
DETAILED GRADING PLAN

DATE: 03/22/2024
DESIGNED BY: CAO
DRAWN BY: AGM
CHECKED BY: BUC

FILE NO.
196617002_GD DTL-DIA I
PROJECT NO.
196617002

SHEET NO.

K:\DEN_Civil\196617002 DIA1\CADD\PlanSheets\CSP\196617002_GD DTL-DIA I.dwg Mavis, August 3/27/2024 10:15 AM

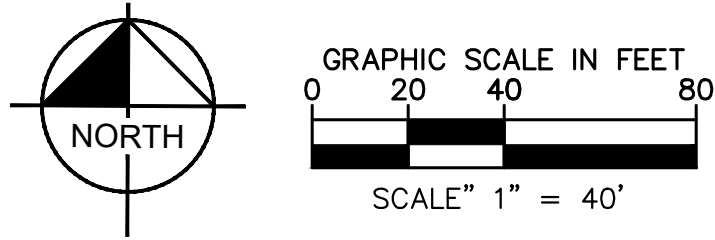


PORTEOS INDUSTRIAL AT PORTEOS
SITE PLAN AMENDMENT
LOCATED IN THE NW $\frac{1}{4}$ OF SECTION 9,
TOWNSHIP 3 SOUTH, RANGE 65 WEST OF THE 6TH P.M.,
CITY OF AURORA, ADAMS COUNTY, STATE OF COLORADO

MATCH LINE SEE SHEET 29


BUILDING 1
624,189 SF
FFE: 5430.72-5436.07
LOT 1, BLOCK 1, PORTEOS SUBDIVISION FILING NO. 6
73.13 AC

MATCH LINE SEE SHEET 35

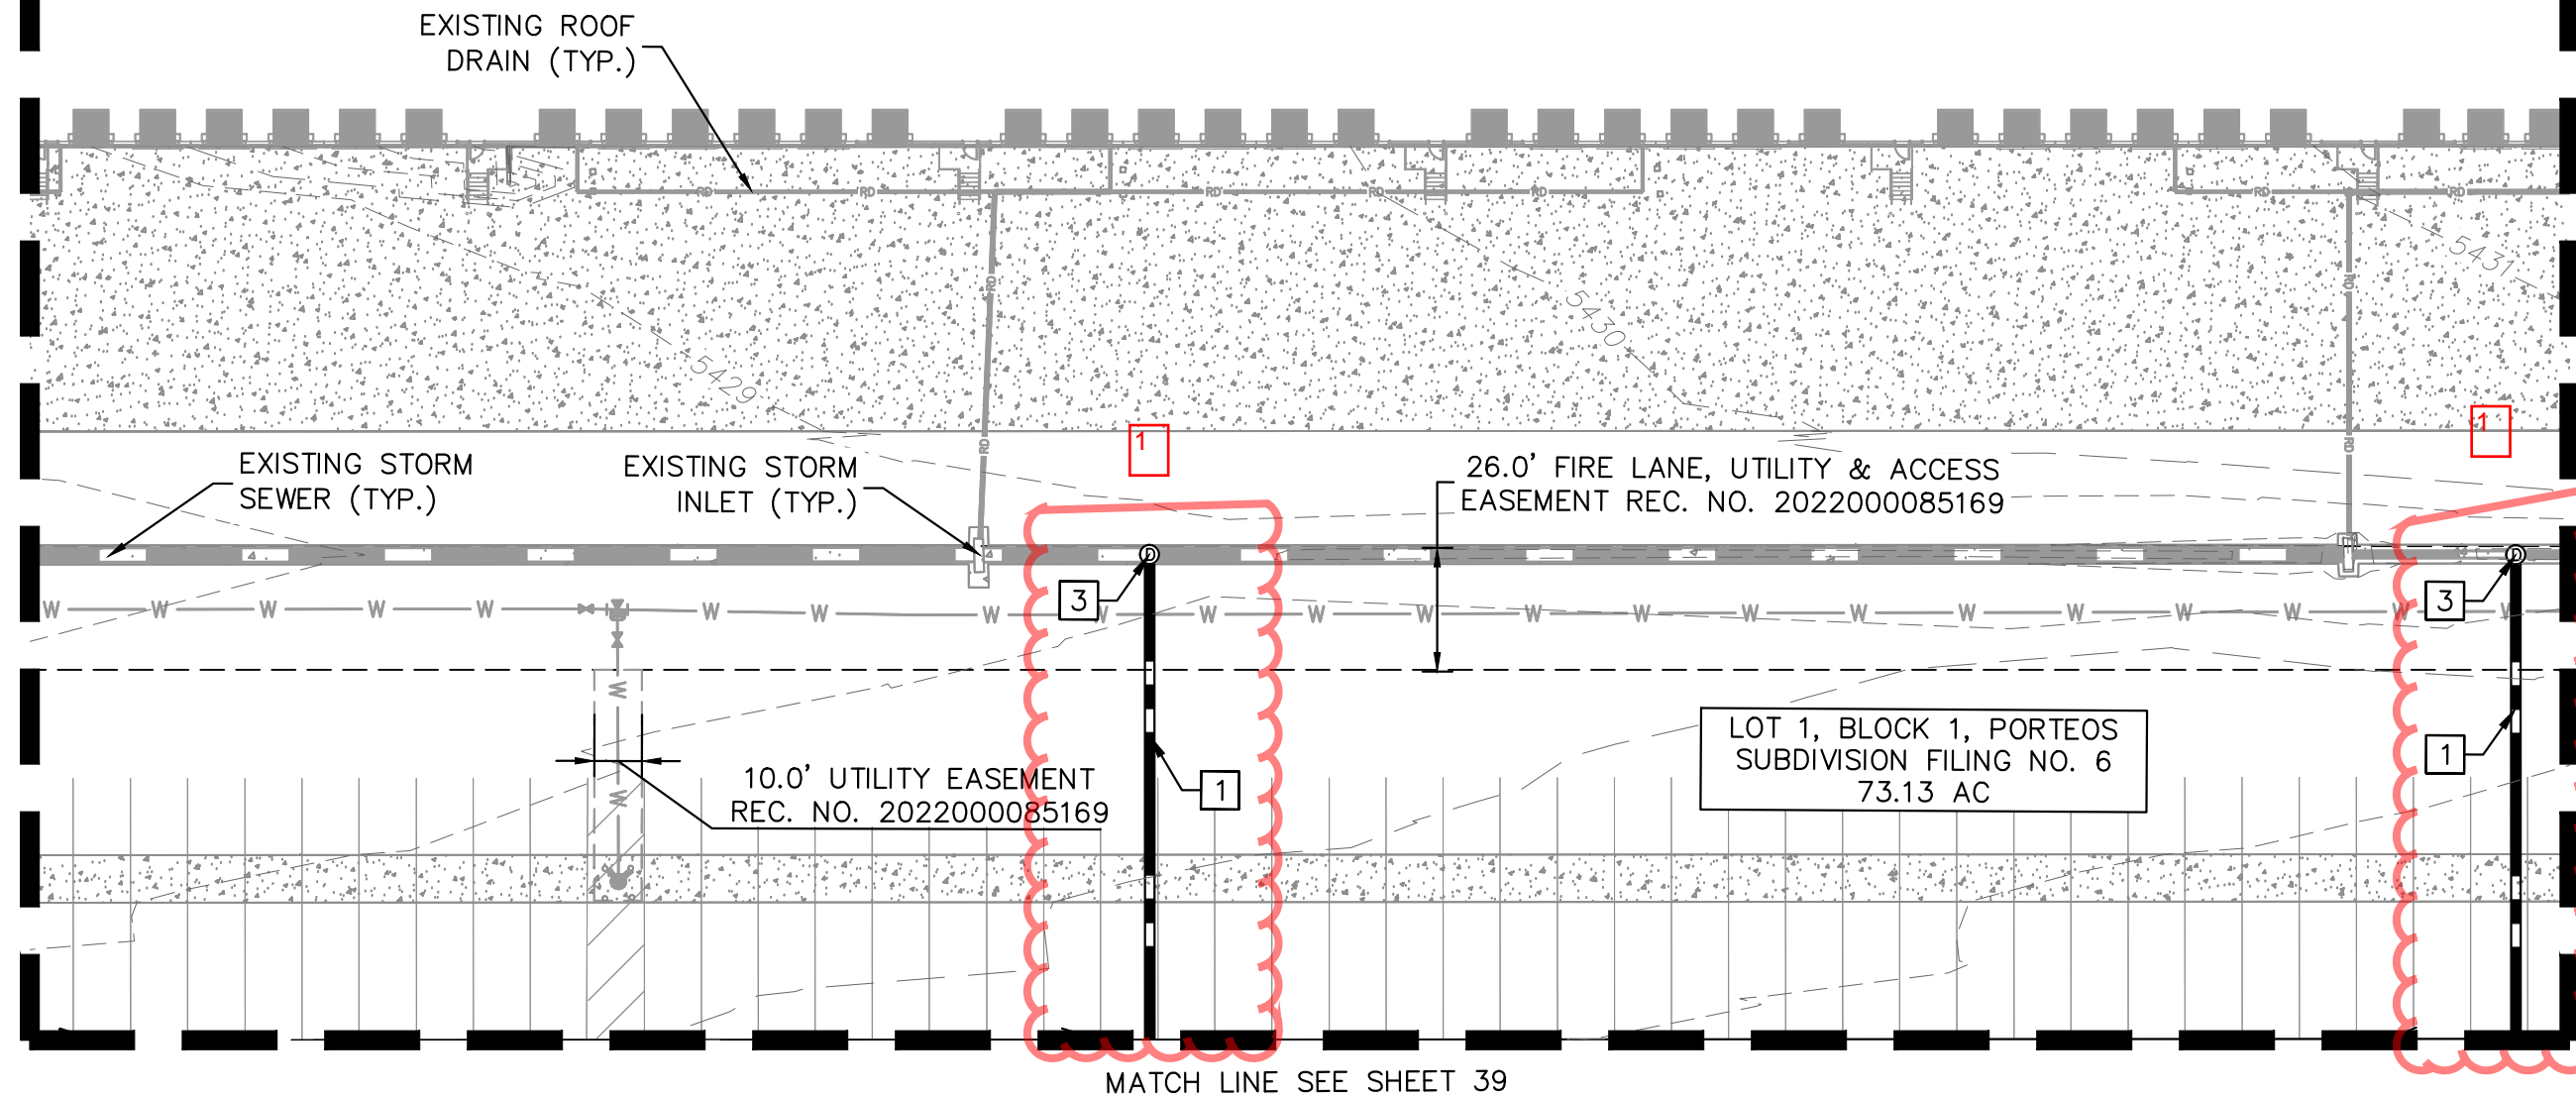

MATCH LINE SEE SHEET 39

MATCH LINE SEE SHEET 33

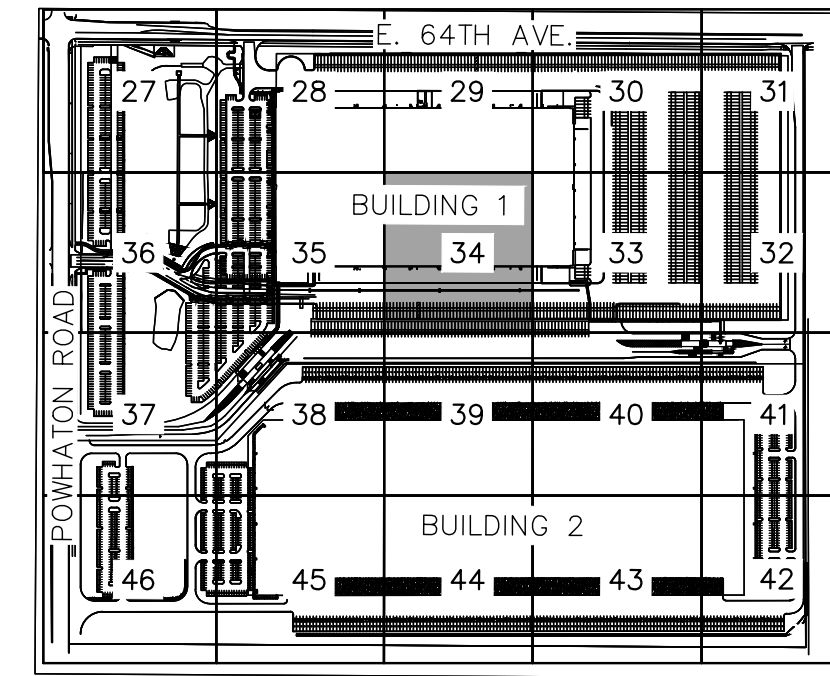

KEYMAP
NTS

LEGEND

- PROPERTY LINE
- EASEMENT LINE
- XXXX - - - EXISTING CONTOUR
- XXXX - - - PROPOSED CONTOUR
- CONCRETE CURB & GUTTER
- AR - - - ACCESSIBLE ROUTE
- PAVEMENT SAWCUT LINE
- X.XX% SLOPE ARROW

GRADING PLAN KEYNOTES

- 1 STORM SEWER
- 2 STORM INLET
- 3 STORM MANHOLE
- 4 ROOF DRAIN
- 5 FLARED END SECTION
- 6 FOREBAY

GRADING PLAN NOTES

- GRADES ADJACENT TO THE BUILDING SHALL BE A MINIMUM OF 1% FOR THE FIRST 10 FEET FOR IMPERVIOUS AREA AND A MINIMUM OF 5% FOR PERVIOUS AREA PER COA CRITERIA. UNLESS OTHERWISE NOTED.
- STORMWATER INFRASTRUCTURE OWNERSHIP SHALL BE DESIGNATED BY THE CONSTRUCTION DOCUMENTS.
- MAXIMUM 2% SLOPE IN ANY DIRECTION AT HANDICAP PARKING SPACES.
- THE MAXIMUM LONGITUDINAL SLOPE WITHIN A FIRE LANE EASEMENT SHALL NOT EXCEED 10%. THE TRANSVERSE SLOPE SHALL GENERALLY HAVE A 2% BUT NOT EXCEEDING 4%. THE RESULTANT SLOPE SHALL NOT EXCEED 10%.

Kimley»Horn
KIMLEY-HORN AND ASSOCIATES, INC.
6205 S. WILLOW
GREENWOOD VILLAGE, CO 80111 (303) 228-2300


PORTEOS INDUSTRIAL AT PORTEOS
CITY OF AURORA, COUNTY OF ADAMS
SITE PLAN AMENDMENT
DETAILED GRADING PLAN

DATE: 03/22/2024
DESIGNED BY: CAO
DRAWN BY: AGM
CHECKED BY: BUC

FILE NO.
196617002_GD DTL-DIA I
PROJECT NO.
196617002


SHEET NO.

K:\DEN_Civil\196617002 DIA1\CADD\PlanSheets\CSP\196617002_GD DTL-DIA I.dwg Mavis, August 3/27/2024 10:15 AM

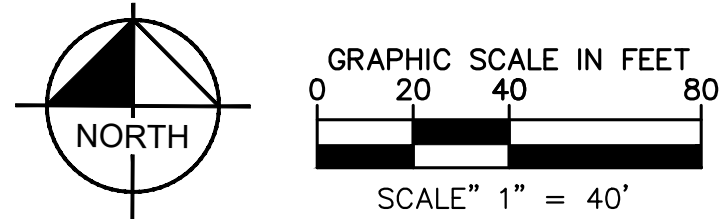

PORTEOS INDUSTRIAL AT PORTEOS SITE PLAN AMENDMENT

LOCATED IN THE NW $\frac{1}{4}$ OF SECTION 9,
TOWNSHIP 3 SOUTH, RANGE 65 WEST OF THE 6TH P.M.,
CITY OF AURORA, ADAMS COUNTY, STATE OF COLORADO

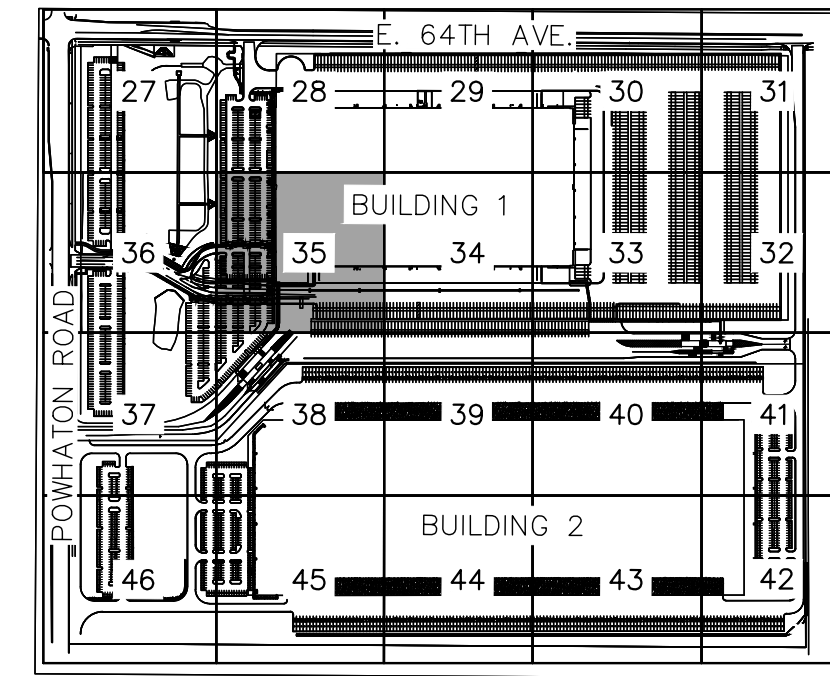

LEGEND


- PROPERTY LINE
- EASEMENT LINE
- XXXX - - - EXISTING CONTOUR
- XXXX - - - PROPOSED CONTOUR
- CONCRETE CURB & GUTTER
- AR - - - ACCESSIBLE ROUTE
- PAVEMENT SAWCUT LINE
- X.XX% SLOPE ARROW

GRADING PLAN KEYNOTES

- 1 STORM SEWER
- 2 STORM INLET
- 3 STORM MANHOLE
- 4 ROOF DRAIN
- 5 FLARED END SECTION
- 6 FOREBAY

GRADING PLAN NOTES

- GRADES ADJACENT TO THE BUILDING SHALL BE A MINIMUM OF 1% FOR THE FIRST 10 FEET FOR IMPERVIOUS AREA AND A MINIMUM OF 5% FOR PERVIOUS AREA PER COA CRITERIA. UNLESS OTHERWISE NOTED.
- STORMWATER INFRASTRUCTURE OWNERSHIP SHALL BE DESIGNATED BY THE CONSTRUCTION DOCUMENTS.
- MAXIMUM 2% SLOPE IN ANY DIRECTION AT HANDICAP PARKING SPACES.
- THE MAXIMUM LONGITUDINAL SLOPE WITHIN A FIRE LANE EASEMENT SHALL NOT EXCEED 10%. THE TRANSVERSE SLOPE SHALL GENERALLY HAVE A 2% BUT NOT EXCEEDING 4%. THE RESULTANT SLOPE SHALL NOT EXCEED 10%.

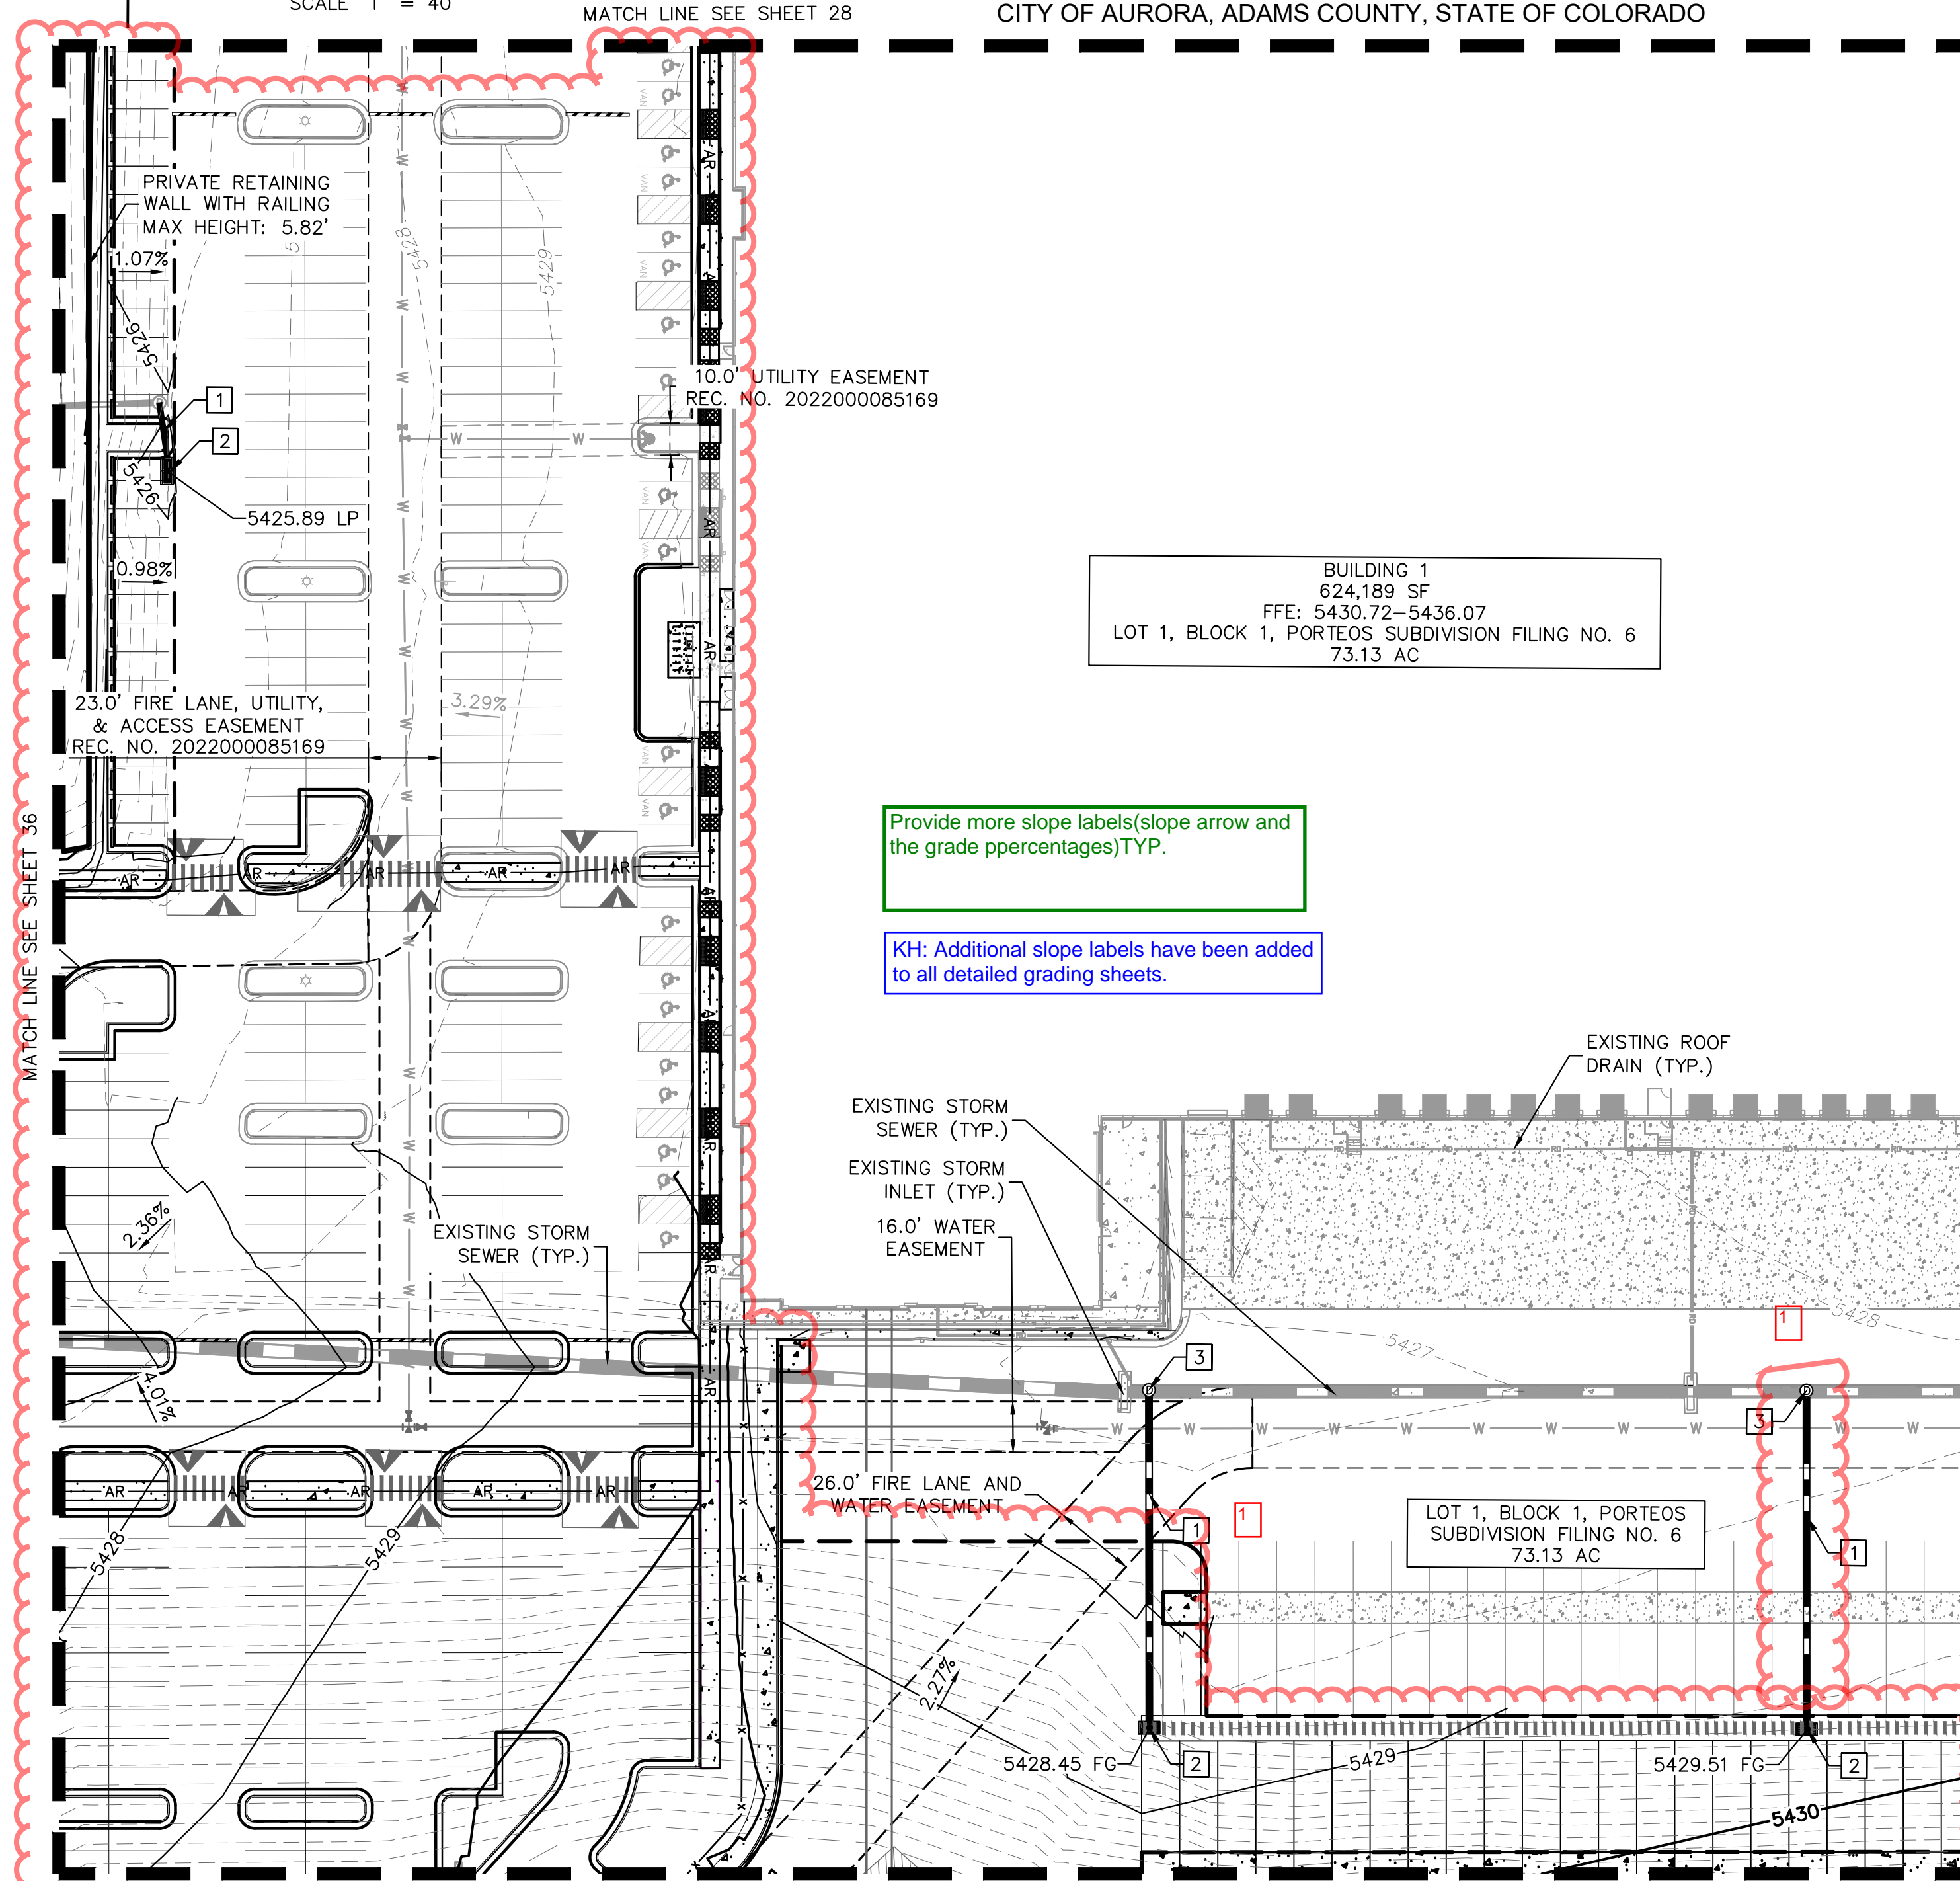

Provide more slope labels(slope arrow and the grade ppercentages)TYP.

KH: Additional slope labels have been added to all detailed grading sheets.

Kimley»Horn
KIMLEY-HORN AND ASSOCIATES, INC.
6205 S. W. 11th Ave.
Greenwood Village, CO 80111 (303) 228-2300


PORTEOS INDUSTRIAL AT PORTEOS
CITY OF AURORA, COUNTY OF ADAMS
SITE PLAN AMENDMENT
DETAILED GRADING PLAN

DATE: 03/22/2024
DESIGNED BY: CAO
DRAWN BY: AGM
CHECKED BY: BUC

FILE NO.
196617002_GD DTL-DIA I
PROJECT NO.
196617002

SHEET NO.


K:\DEN_Civil\196617002 DIA1\CADD\PlanSheets\CSP\196617002_GD DTL-DIA I.dwg OKeefe, Sam 3/27/2024 3:03 PM

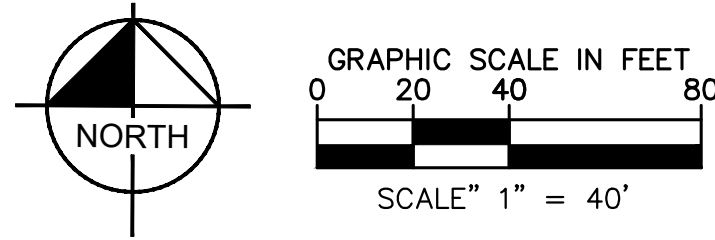

PORTEOS INDUSTRIAL AT PORTEOS

SITE PLAN AMENDMENT

LOCATED IN THE NW $\frac{1}{4}$ OF SECTION 9,
TOWNSHIP 3 SOUTH, RANGE 65 WEST OF THE 6TH P.M.,
CITY OF AURORA, ADAMS COUNTY, STATE OF COLORADO

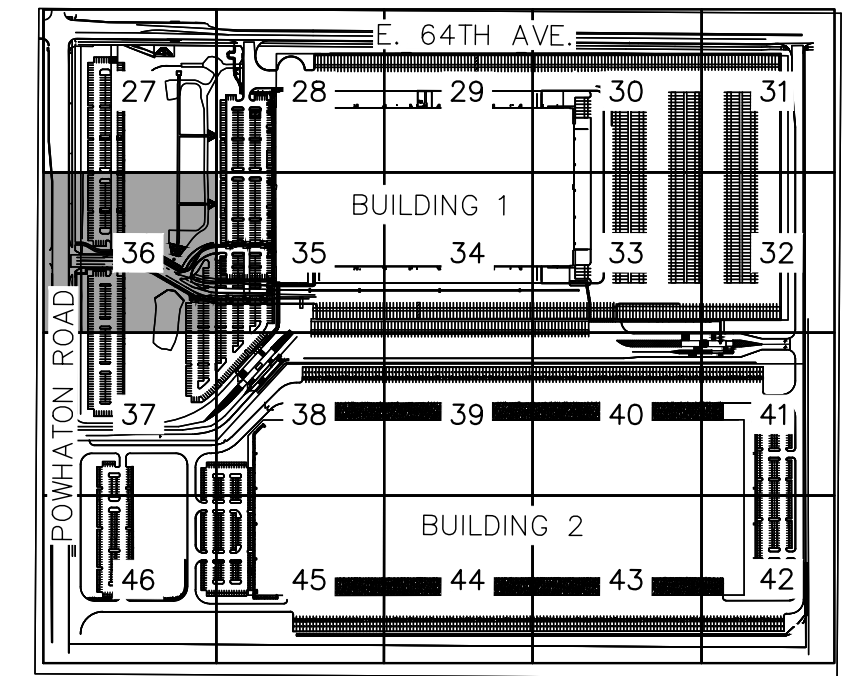

KEYMAP
NTS

LEGEND


- PROPERTY LINE
- EASEMENT LINE
- XXXX - - - - EXISTING CONTOUR
- XXXX - - - - PROPOSED CONTOUR
- CONCRETE CURB & GUTTER
- AR - - - - ACCESSIBLE ROUTE
- PAVEMENT SAWCUT LINE
- X.XX% SLOPE ARROW

GRADING PLAN KEYNOTES

- 1 STORM SEWER
- 2 STORM INLET
- 3 STORM MANHOLE
- 4 ROOF DRAIN
- 5 FLARED END SECTION
- 6 FOREBAY

GRADING PLAN NOTES

1. GRADES ADJACENT TO THE BUILDING SHALL BE A MINIMUM OF 1% FOR THE FIRST 10 FEET FOR IMPERVIOUS AREA AND A MINIMUM OF 5% FOR PERVIOUS AREA PER COA CRITERIA. UNLESS OTHERWISE NOTED.
2. STORMWATER INFRASTRUCTURE OWNERSHIP SHALL BE DESIGNATED BY THE CONSTRUCTION DOCUMENTS.
3. MAXIMUM 2% SLOPE IN ANY DIRECTION AT HANDICAP PARKING SPACES.
4. THE MAXIMUM LONGITUDINAL SLOPE WITHIN A FIRE LANE EASEMENT SHALL NOT EXCEED 10%. THE TRANSVERSE SLOPE SHALL GENERALLY HAVE A 2% BUT NOT EXCEEDING 4%. THE RESULTANT SLOPE SHALL NOT EXCEED 10%.

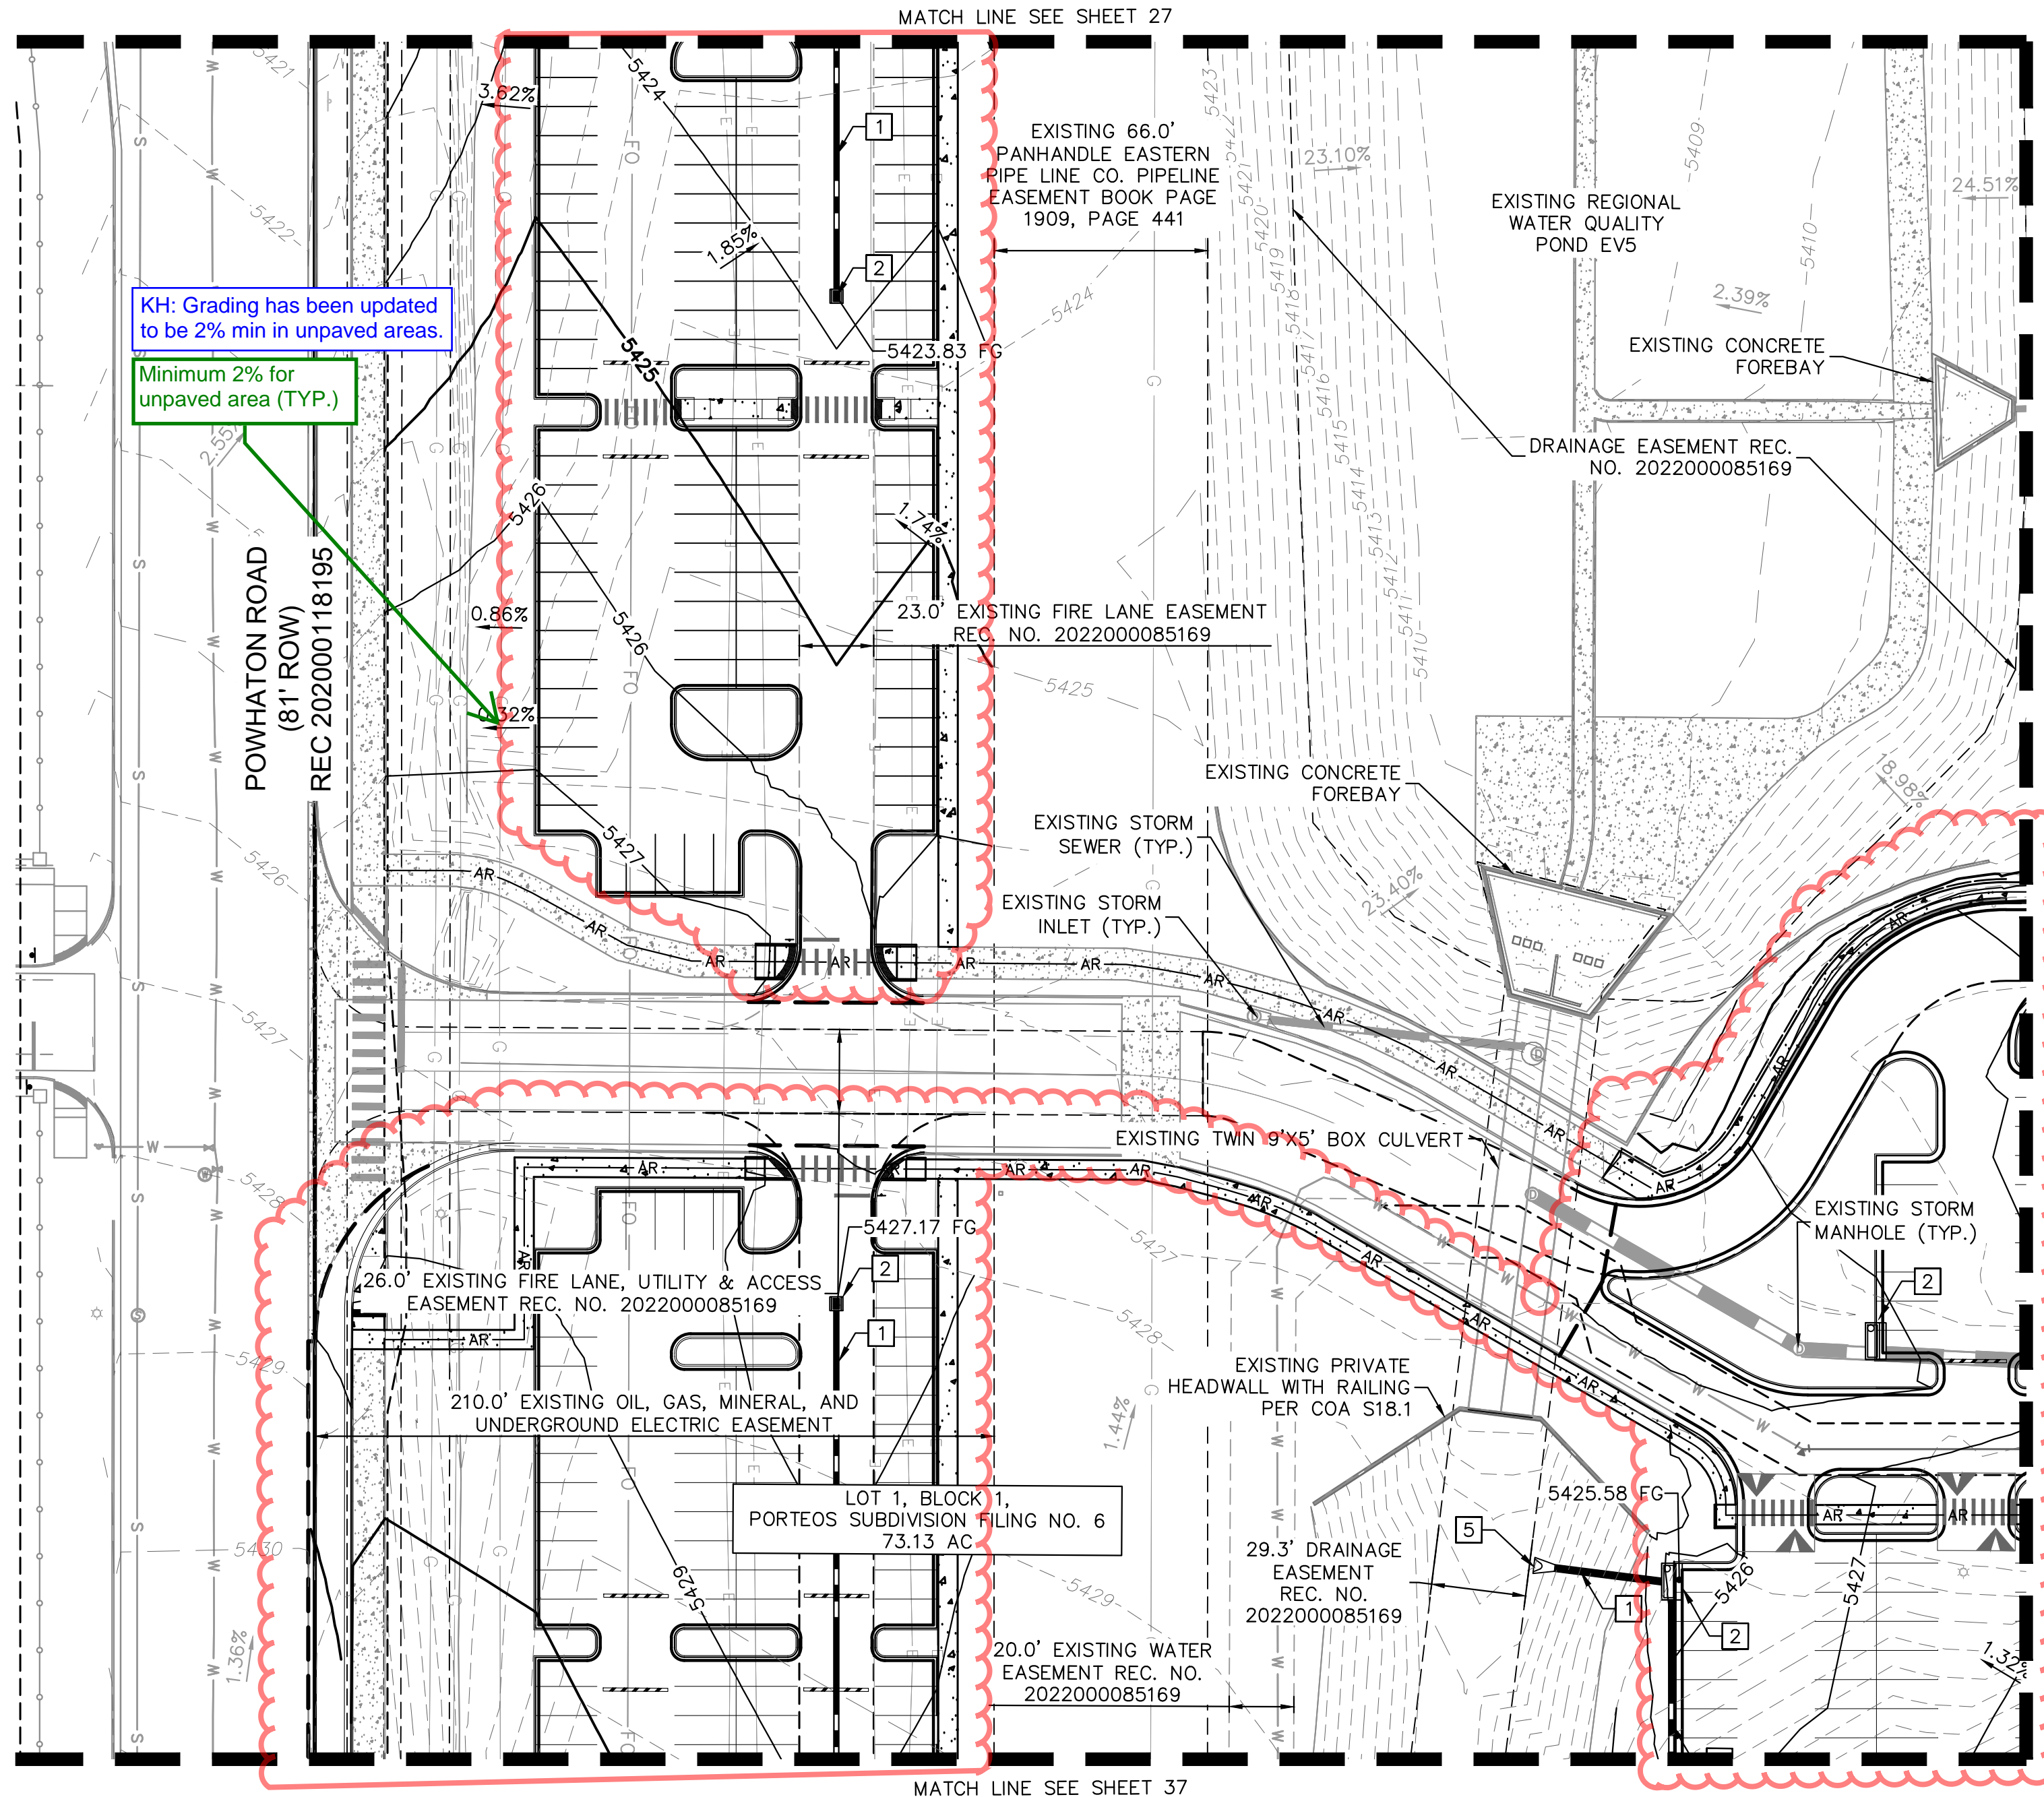

Kimley»Horn
KIMLEY-HORN AND ASSOCIATES, INC.
6205 S. HARRISON
GREENWOOD VILLAGES, CO 80111 (303) 228-2300


PORTEOS INDUSTRIAL AT PORTEOS
CITY OF AURORA, COUNTY OF ADAMS
SITE PLAN AMENDMENT
DETAILED GRADING PLAN

DATE: 03/22/2024
DESIGNED BY: CAO
DRAWN BY: AGM
CHECKED BY: BUC

FILE NO.
196617002_GD DTL-DIA I
PROJECT NO.
196617002



SHEET NO.

K:\DEN_Civil\196617002 DIA1\CADD\PlanSheets\CSP\196617002_GD DTL-DIA II.dwg OKeeffe, Sam 3/27/2024 3:04 PM

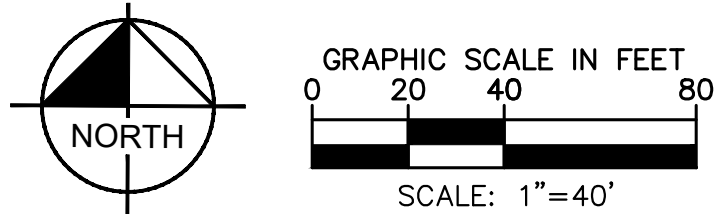

PORTEOS INDUSTRIAL AT PORTEOS SITE PLAN AMENDMENT

LOCATED IN THE NW 1/4 OF SECTION 9,
TOWNSHIP 3 SOUTH, RANGE 65 WEST OF THE 6TH P.M.,
CITY OF AURORA, ADAMS COUNTY, STATE OF COLORADO

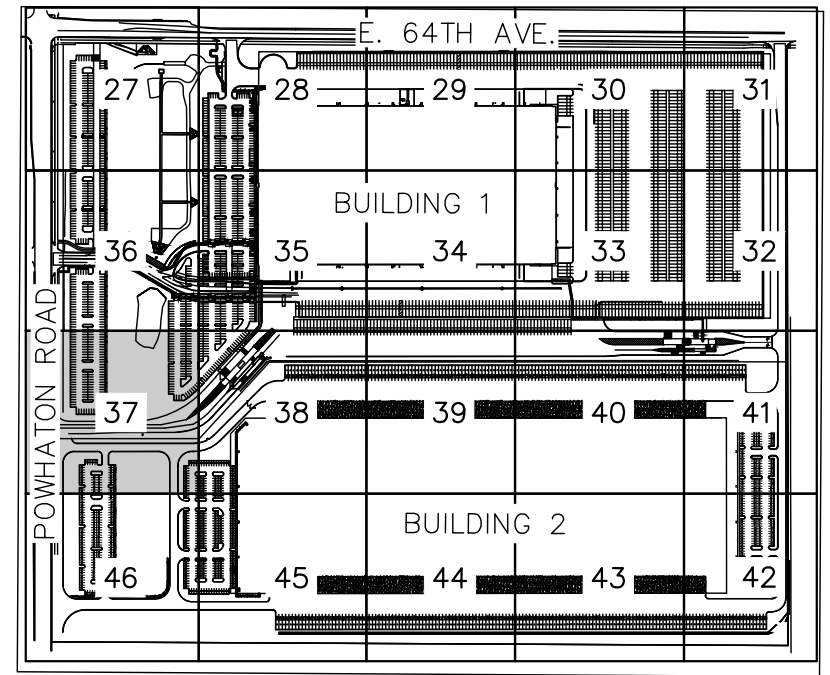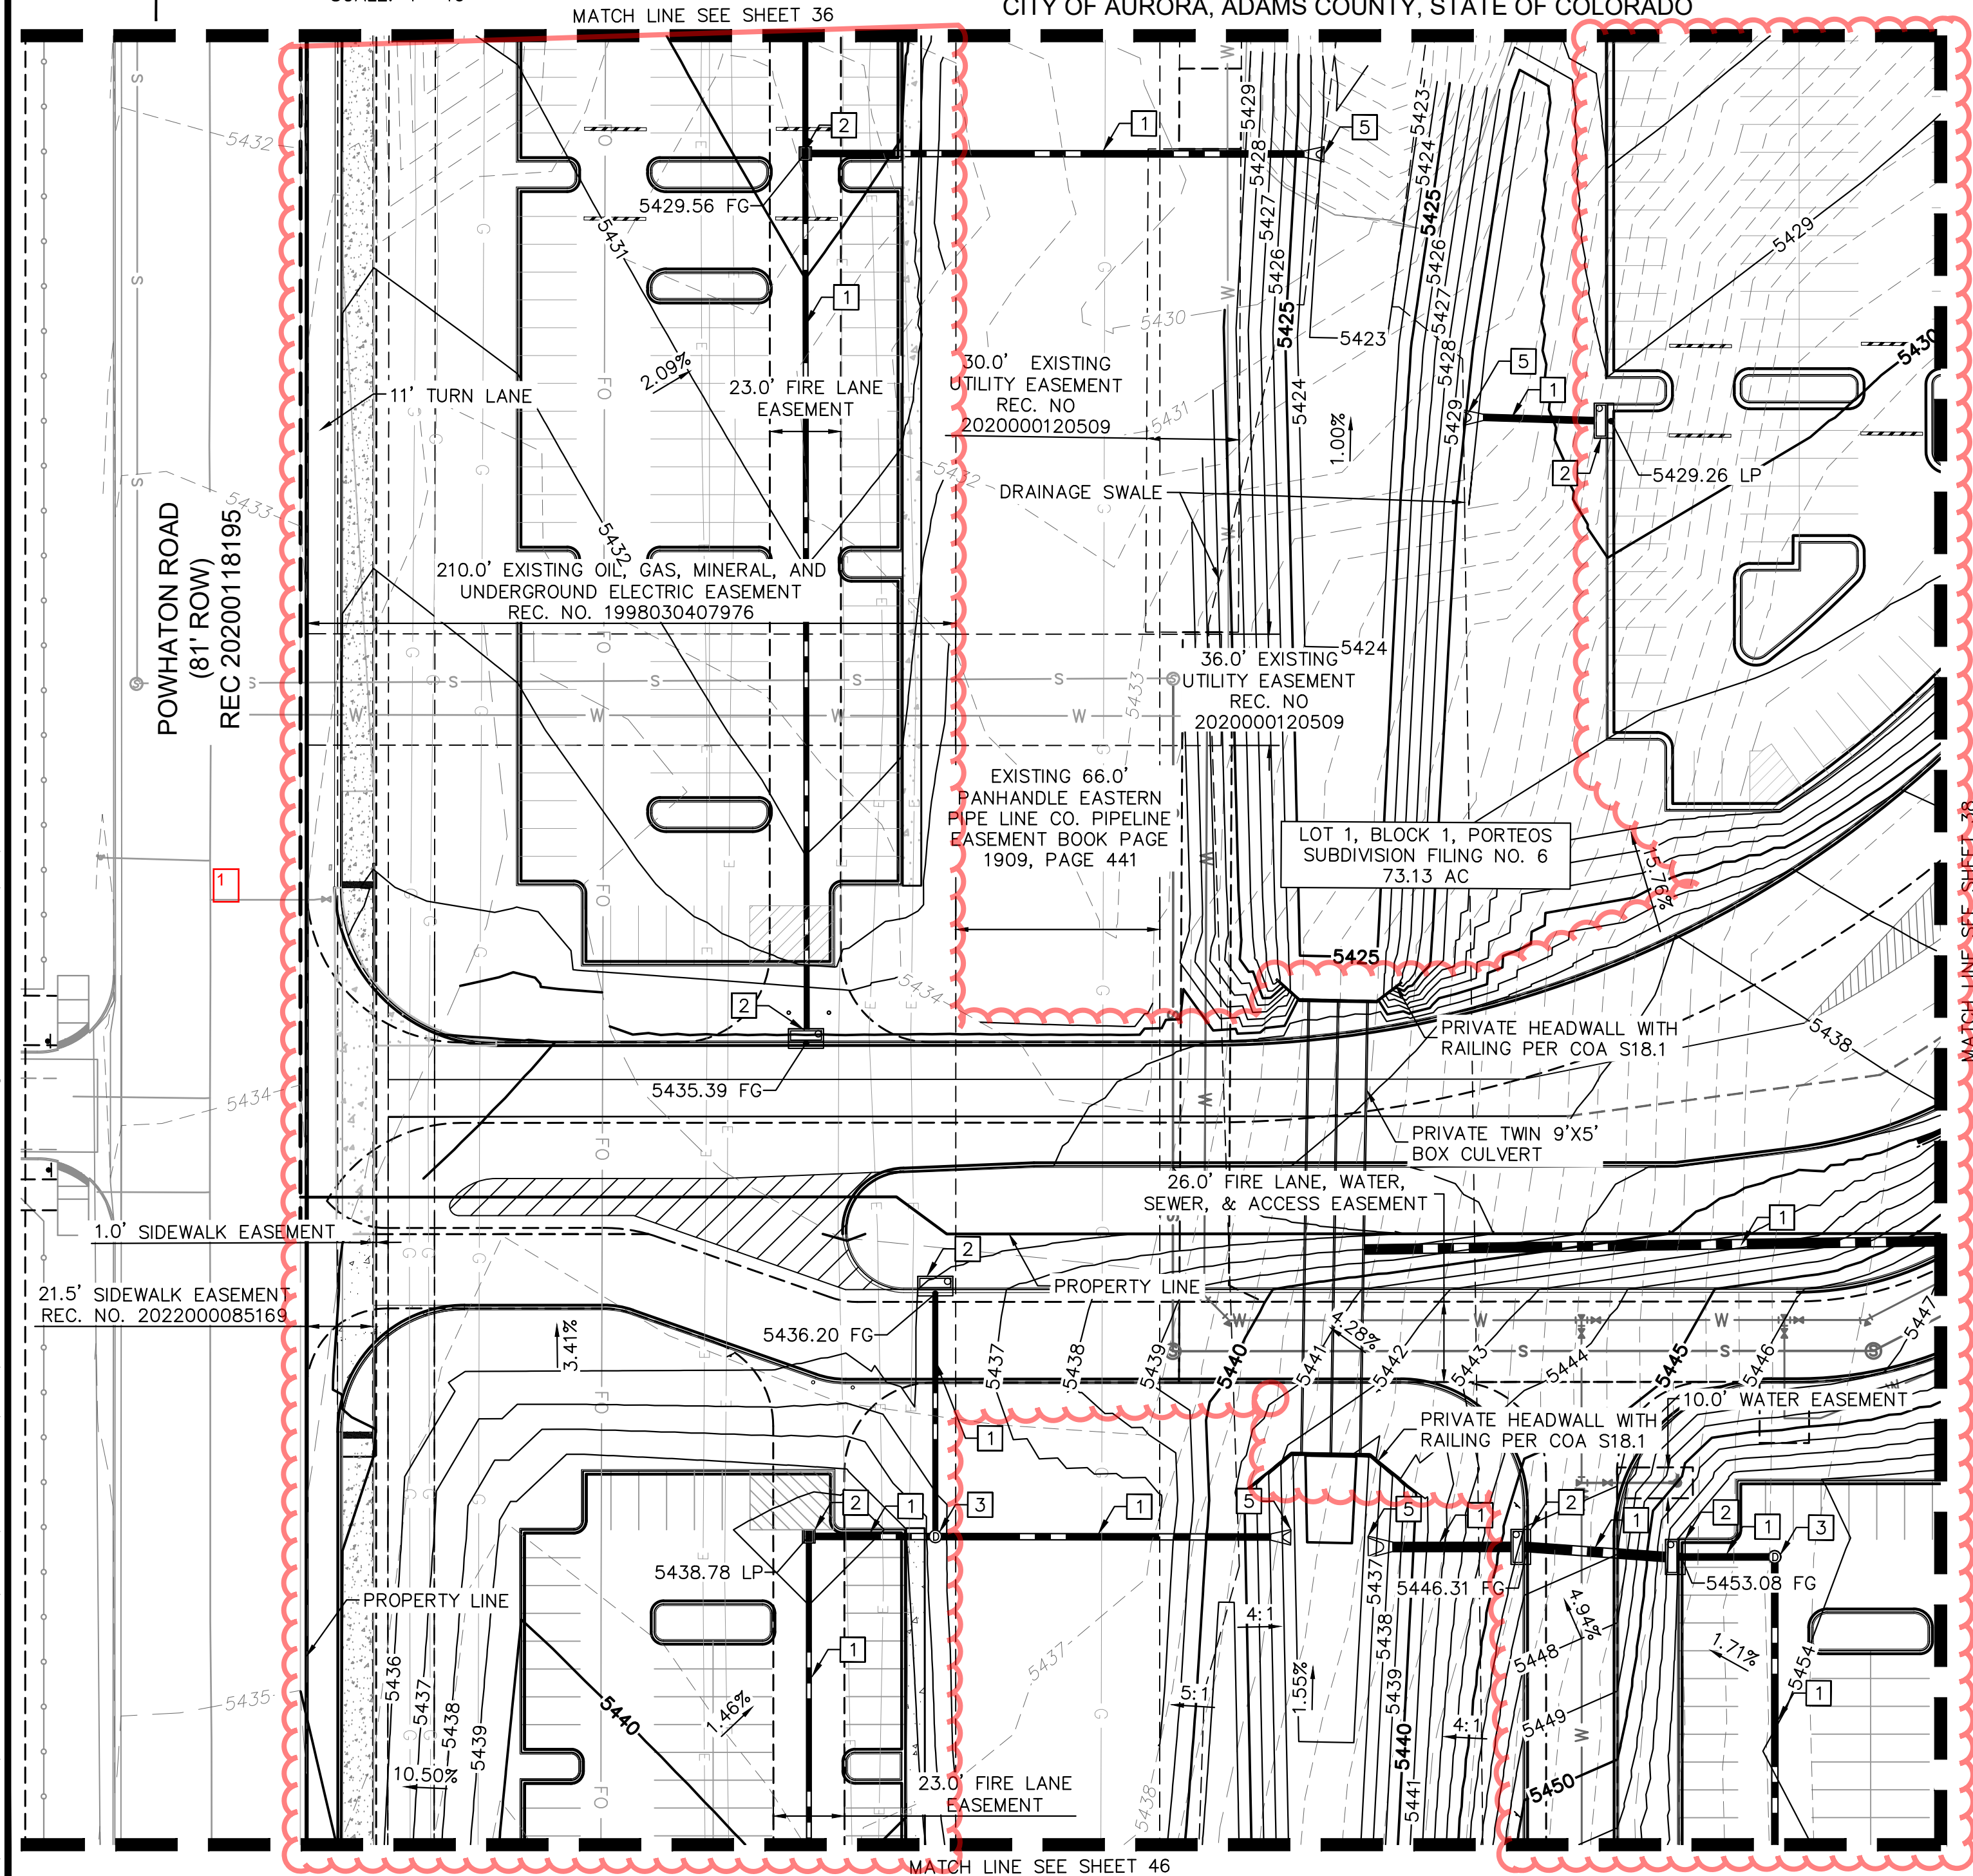

LEGEND

- PROPERTY LINE
- EASEMENT LINE
- EXISTING CONTOUR
- PROPOSED CONTOUR
- CONCRETE CURB & GUTTER
- ACCESSIBLE ROUTE
- PAVEMENT SAWCUT LINE
- SLOPE ARROW

GRADING PLAN KEYNOTES

- 1 STORM SEWER
- 2 STORM INLET
- 3 STORM MANHOLE
- 4 ROOF DRAIN
- 5 FLARED END SECTION
- 6 FOREBAY

GRADING PLAN NOTES

- GRADES ADJACENT TO THE BUILDING SHALL BE A MINIMUM OF 1% FOR THE FIRST 10 FEET FOR IMPERVIOUS AREA AND A MINIMUM OF 5% FOR PERVIOUS AREA PER COA CRITERIA. UNLESS OTHERWISE NOTED.
- STORMWATER INFRASTRUCTURE OWNERSHIP SHALL BE DESIGNATED BY THE CONSTRUCTION DOCUMENTS.
- MAXIMUM 2% SLOPE IN ANY DIRECTION AT HANDICAP PARKING SPACES.
- THE MAXIMUM LONGITUDINAL SLOPE WITHIN A FIRE LANE EASEMENT SHALL NOT EXCEED 10%. THE TRANSVERSE SLOPE SHALL GENERALLY HAVE A 2% BUT NOT EXCEEDING 4%. THE RESULTANT SLOPE SHALL NOT EXCEED 10%.

CHANG
ES
SO
3/25/24
BJS


FILE NO. 196617002_GD DTL-DIA II	DATE: 03/22/2024	DESIGNED BY: CAO DRAWN BY: AGM CHECKED BY: BUC	BY DATE APPR
PROJECT NO. 196617002			
SHEET NO. 37	REVISION		

Kimley»Horn


KIMLEY-HORN AND ASSOCIATES, INC.
6205 S. WILLOW
Greenwood Village, CO 80111 (303) 228-2300

PORTEOS INDUSTRIAL AT PORTEOS
CITY OF AURORA, COUNTY OF ADAMS
SITE PLAN AMENDMENT
DETAILED GRADING PLAN

K:\DEN_Civil\196617002 DIA1\CADD\PlanSheets\CSP\196617002_GD DTL-DIA II.dwg OKeeffe, Sam 3/27/2024 1:09 PM


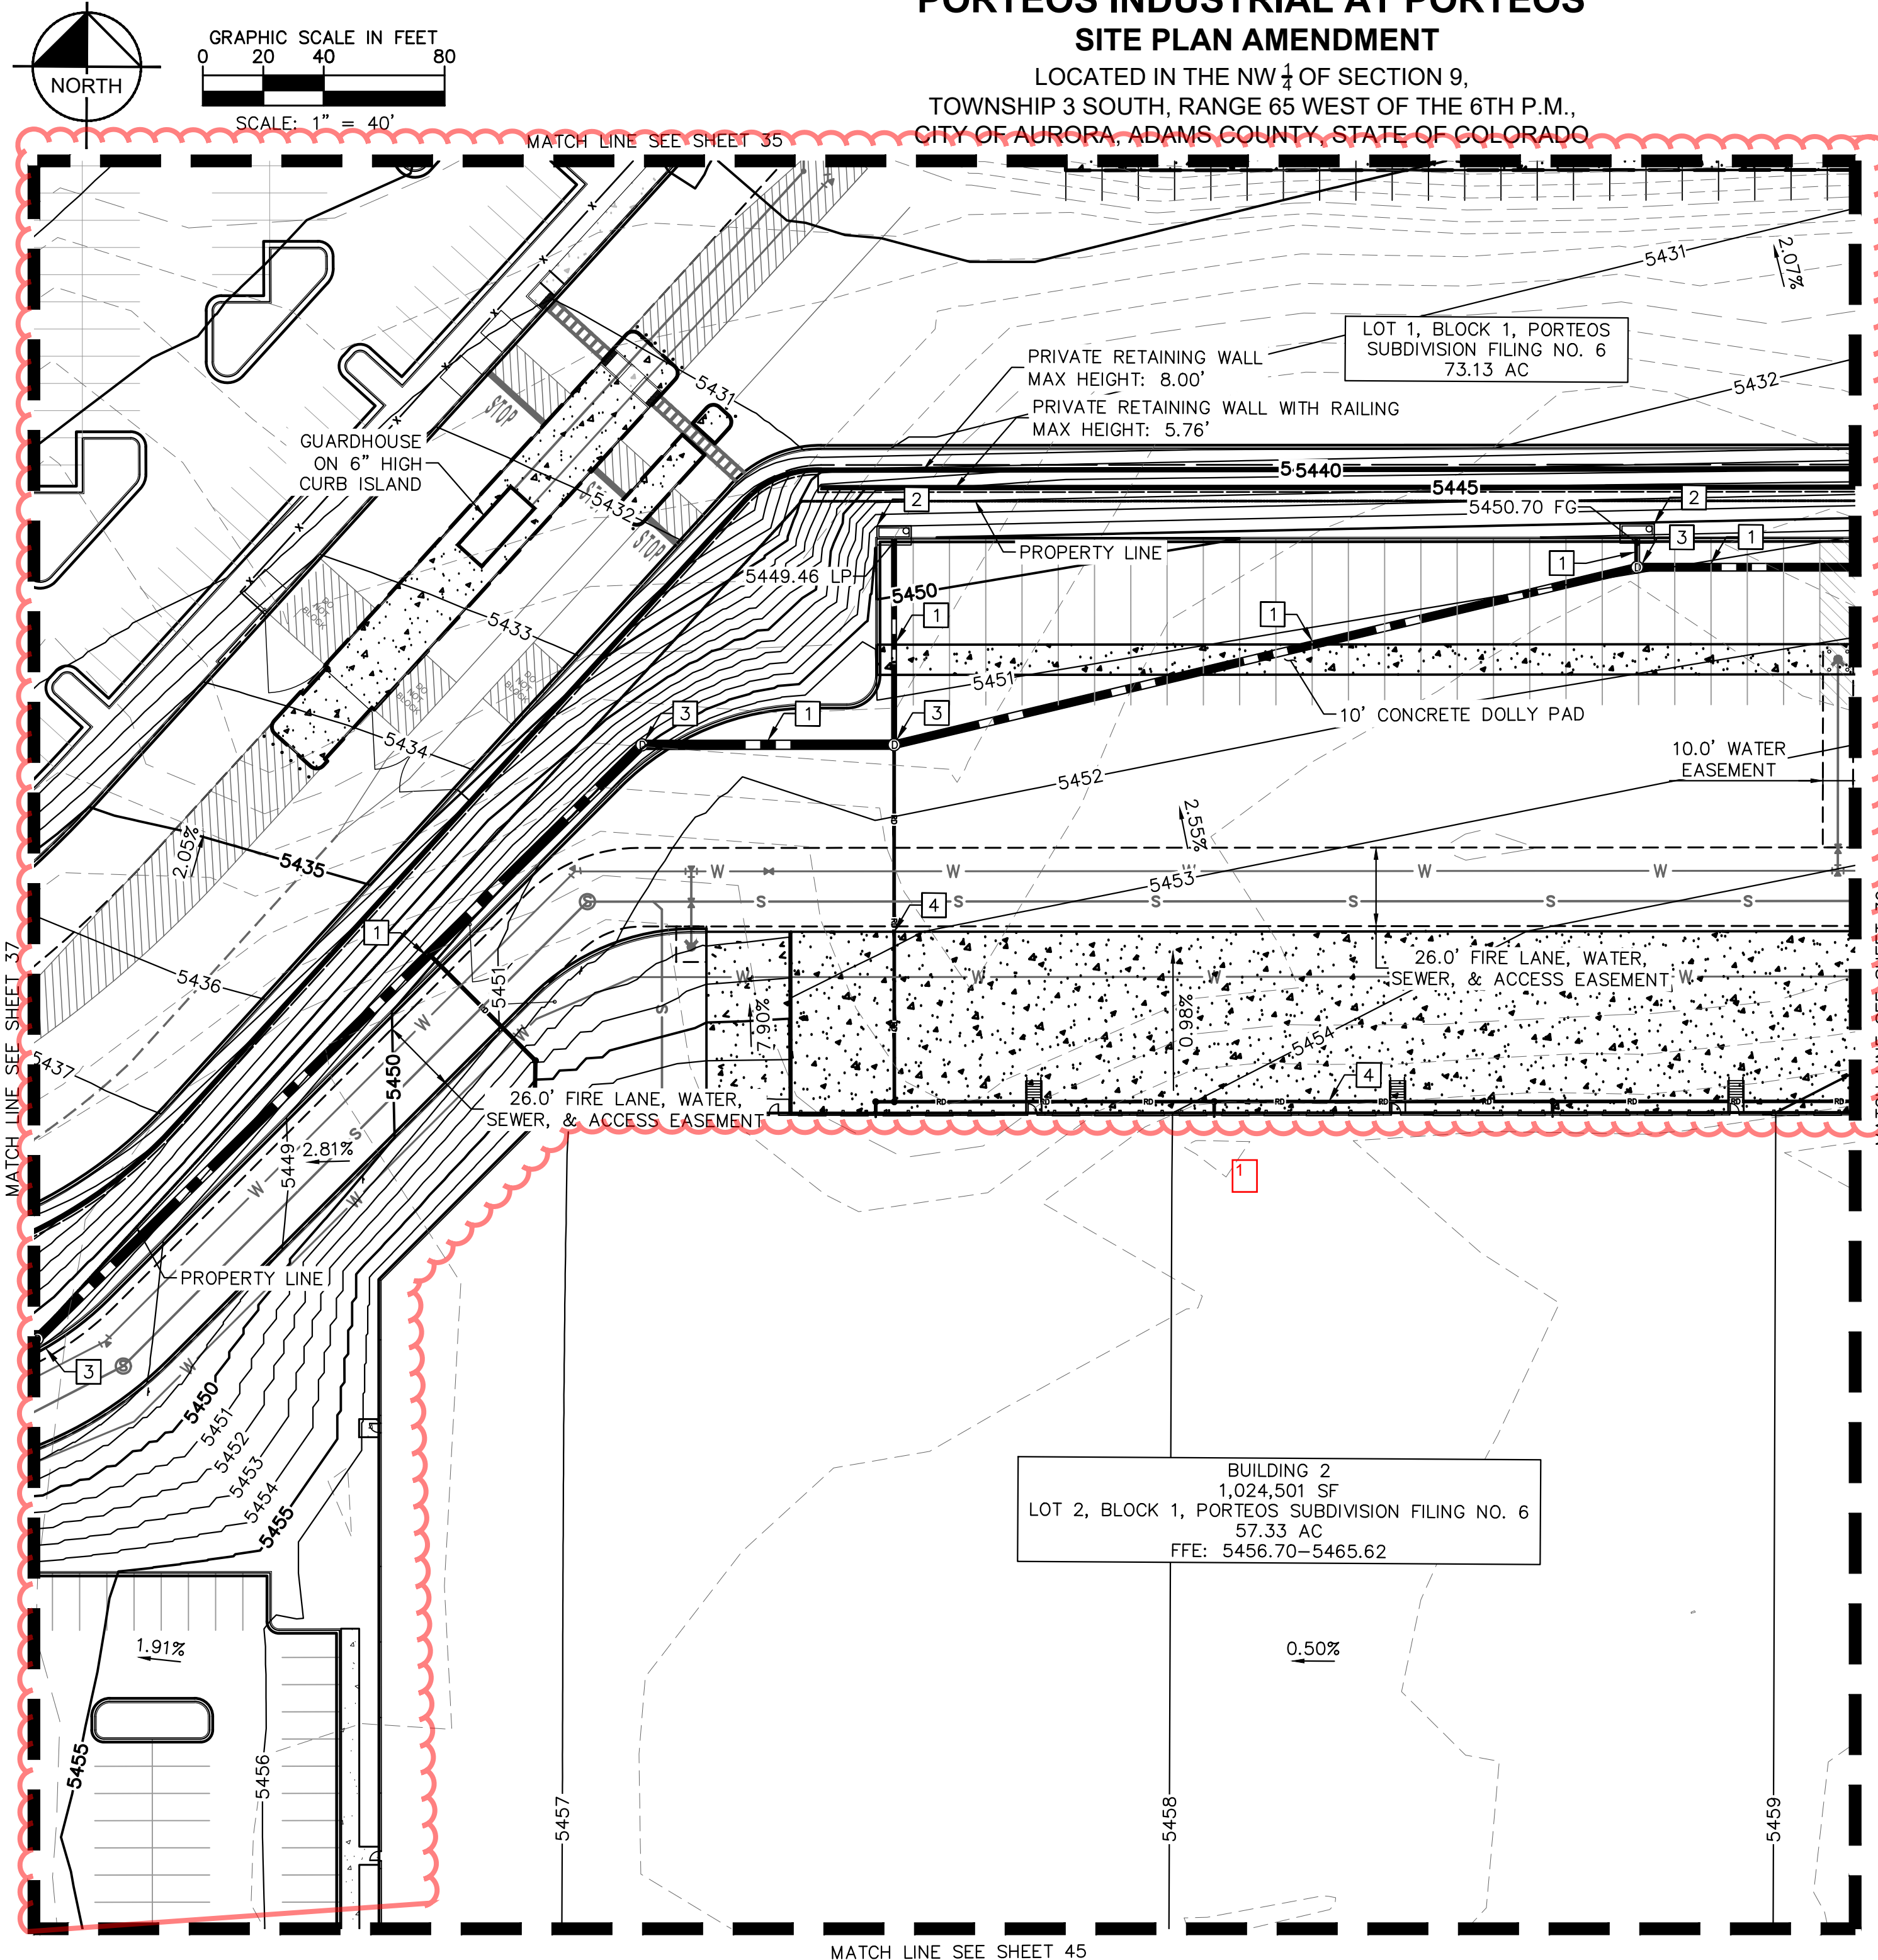


K:\DEN_Civil\196617002 DIA1\CADD\PlanSheets\CSP\196617002_GD DTL-DIA II.dwg OKeeffe, Sam 3/27/2024 1:09 PM

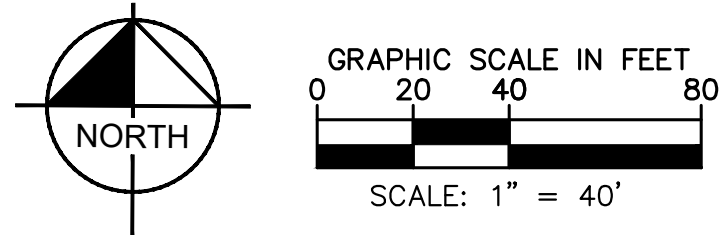

PORTEOS INDUSTRIAL AT PORTEOS SITE PLAN AMENDMENT

LOCATED IN THE NW $\frac{1}{4}$ OF SECTION 9,
TOWNSHIP 3 SOUTH, RANGE 65 WEST OF THE 6TH P.M.,
CITY OF AURORA, ADAMS COUNTY, STATE OF COLORADO

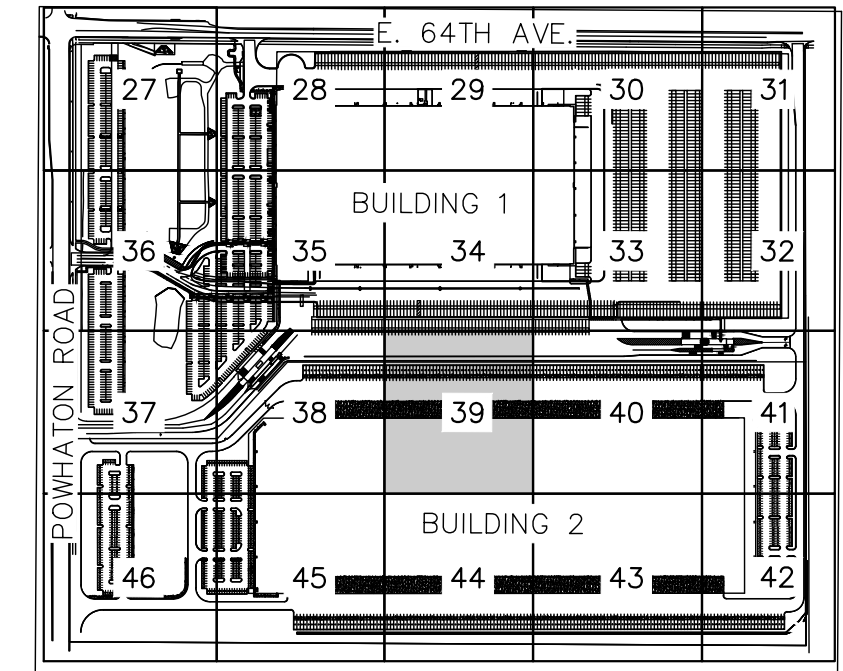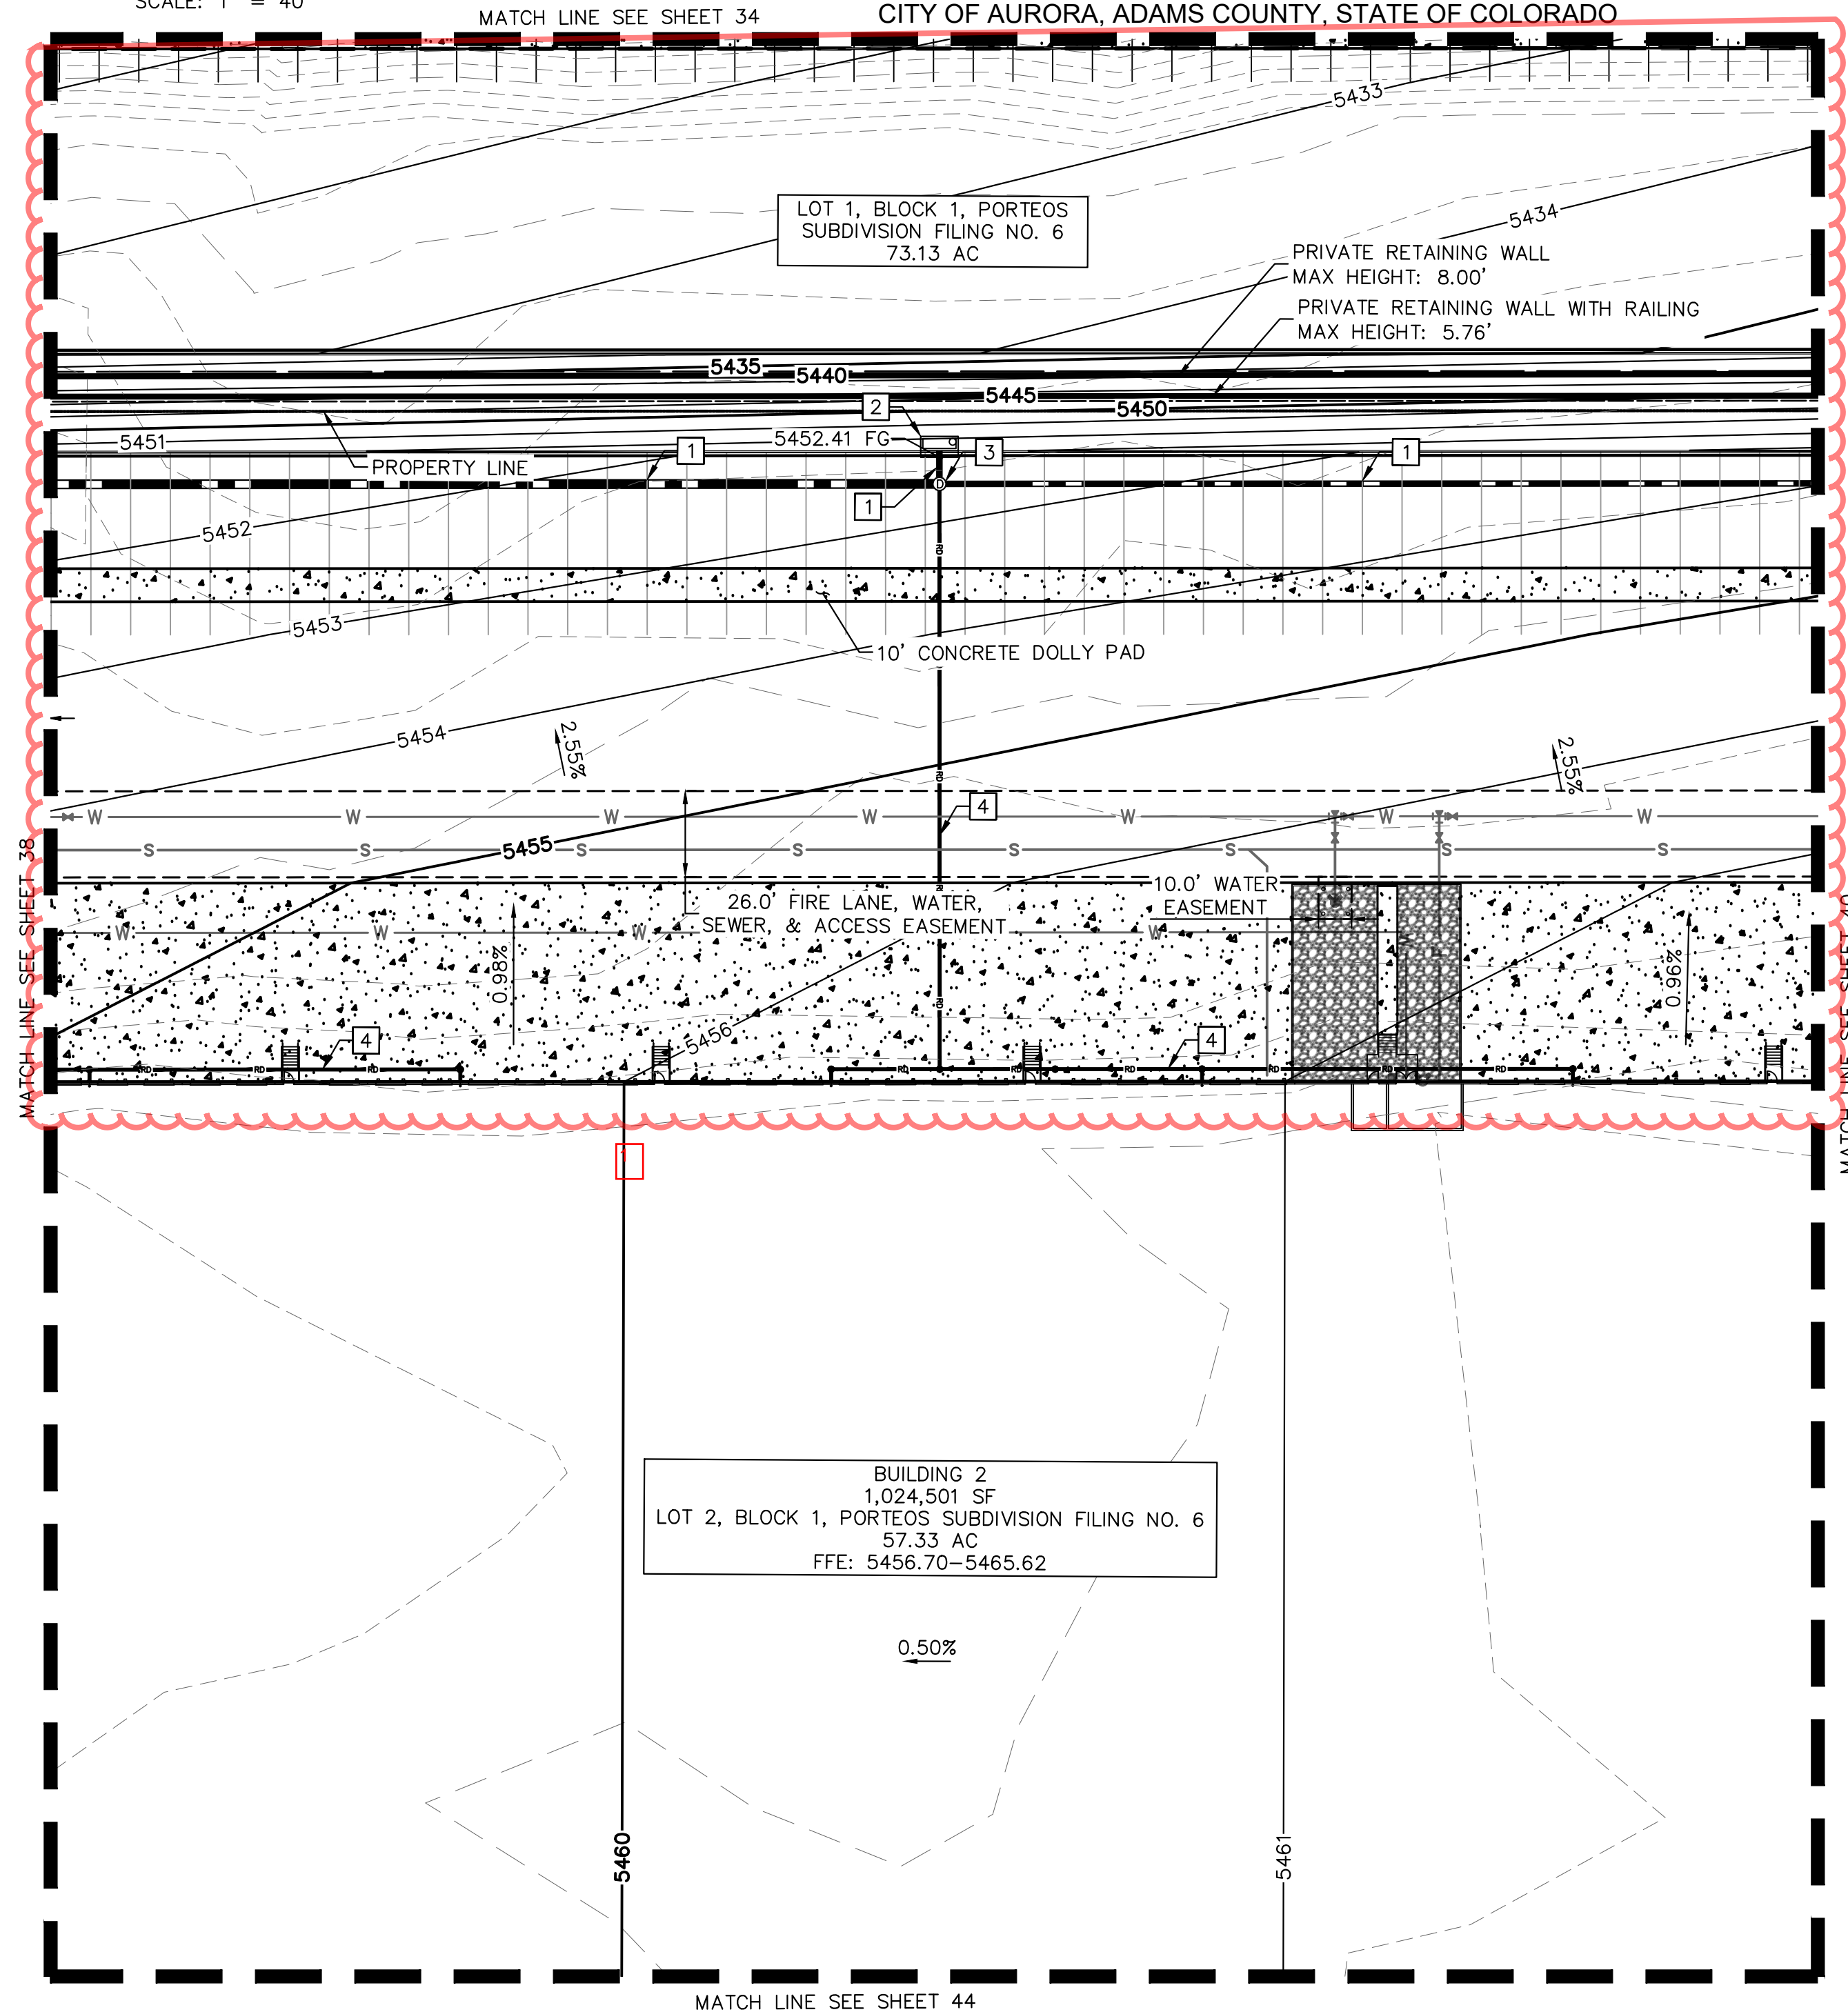

KEYMAP
NTS

LEGEND

- PROPERTY LINE
- EASEMENT LINE
- XXXX - - - - EXISTING CONTOUR
- XXXX - - - - PROPOSED CONTOUR
- CONCRETE CURB & GUTTER
- AR - - - - ACCESSIBLE ROUTE
- - - - PAVEMENT SAWCUT LINE
- X.XX% SLOPE ARROW

GRADING PLAN KEYNOTES

- 1 STORM SEWER
- 2 STORM INLET
- 3 STORM MANHOLE
- 4 ROOF DRAIN
- 5 FLARED END SECTION
- 6 FOREBAY

GRADING PLAN NOTES

- GRADES ADJACENT TO THE BUILDING SHALL BE A MINIMUM OF 1% FOR THE FIRST 10 FEET FOR IMPERVIOUS AREA AND A MINIMUM OF 5% FOR PERVIOUS AREA PER COA CRITERIA. UNLESS OTHERWISE NOTED.
- STORMWATER INFRASTRUCTURE OWNERSHIP SHALL BE DESIGNATED BY THE CONSTRUCTION DOCUMENTS.
- MAXIMUM 2% SLOPE IN ANY DIRECTION AT HANDICAP PARKING SPACES.
- THE MAXIMUM LONGITUDINAL SLOPE WITHIN A FIRE LANE EASEMENT SHALL NOT EXCEED 10%. THE TRANSVERSE SLOPE SHALL GENERALLY HAVE A 2% BUT NOT EXCEEDING 4%. THE RESULTANT SLOPE SHALL NOT EXCEED 10%.

Kimley»Horn
KIMLEY-HORN AND ASSOCIATES, INC.
6205 S. HARRISON
GREENWOOD VILLAGE, CO 80111 (303) 228-2300


PORTEOS INDUSTRIAL AT PORTEOS
CITY OF AURORA, COUNTY OF ADAMS
SITE PLAN AMENDMENT
DETAILED GRADING PLAN

DATE: 03/22/2024
DESIGNED BY: CAO
DRAWN BY: AGM
CHECKED BY: BJC

FILE NO.
196617002_GD DTL-DIA II
PROJECT NO.
196617002



SHEET NO.

K:\DEN_Civil\196617002 DIA1\CADD\PlanSheets\CSP\196617002_GD DTL-DIA II.dwg OKeeffe, Sam 3/27/2024 1:09 PM

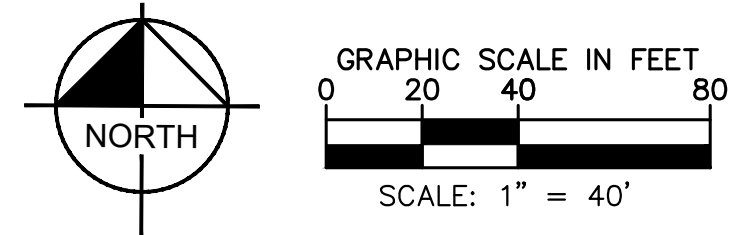

PORTEOS INDUSTRIAL AT PORTEOS SITE PLAN AMENDMENT

LOCATED IN THE NW $\frac{1}{4}$ OF SECTION 9,
TOWNSHIP 3 SOUTH, RANGE 65 WEST OF THE 6TH P.M.,
CITY OF AURORA, ADAMS COUNTY, STATE OF COLORADO

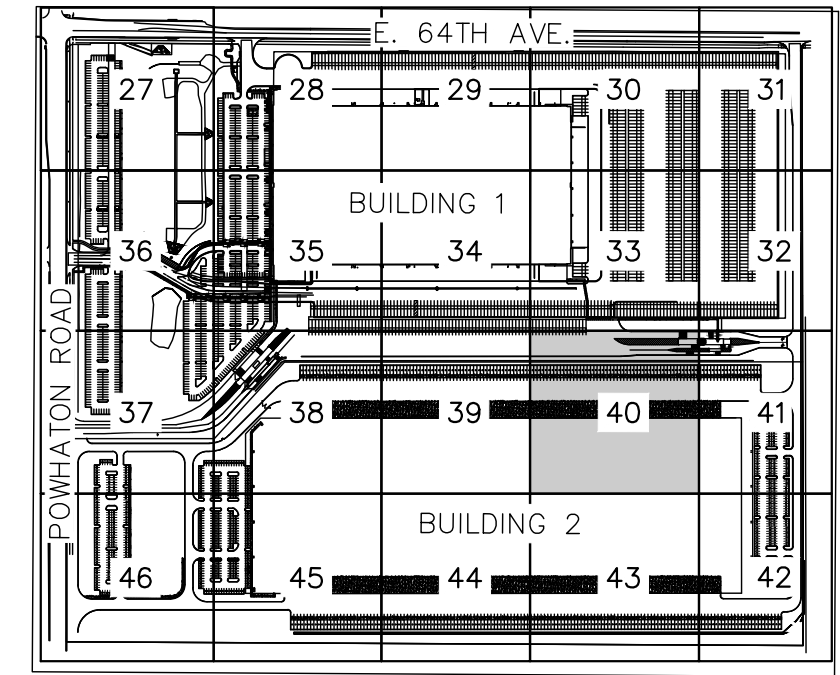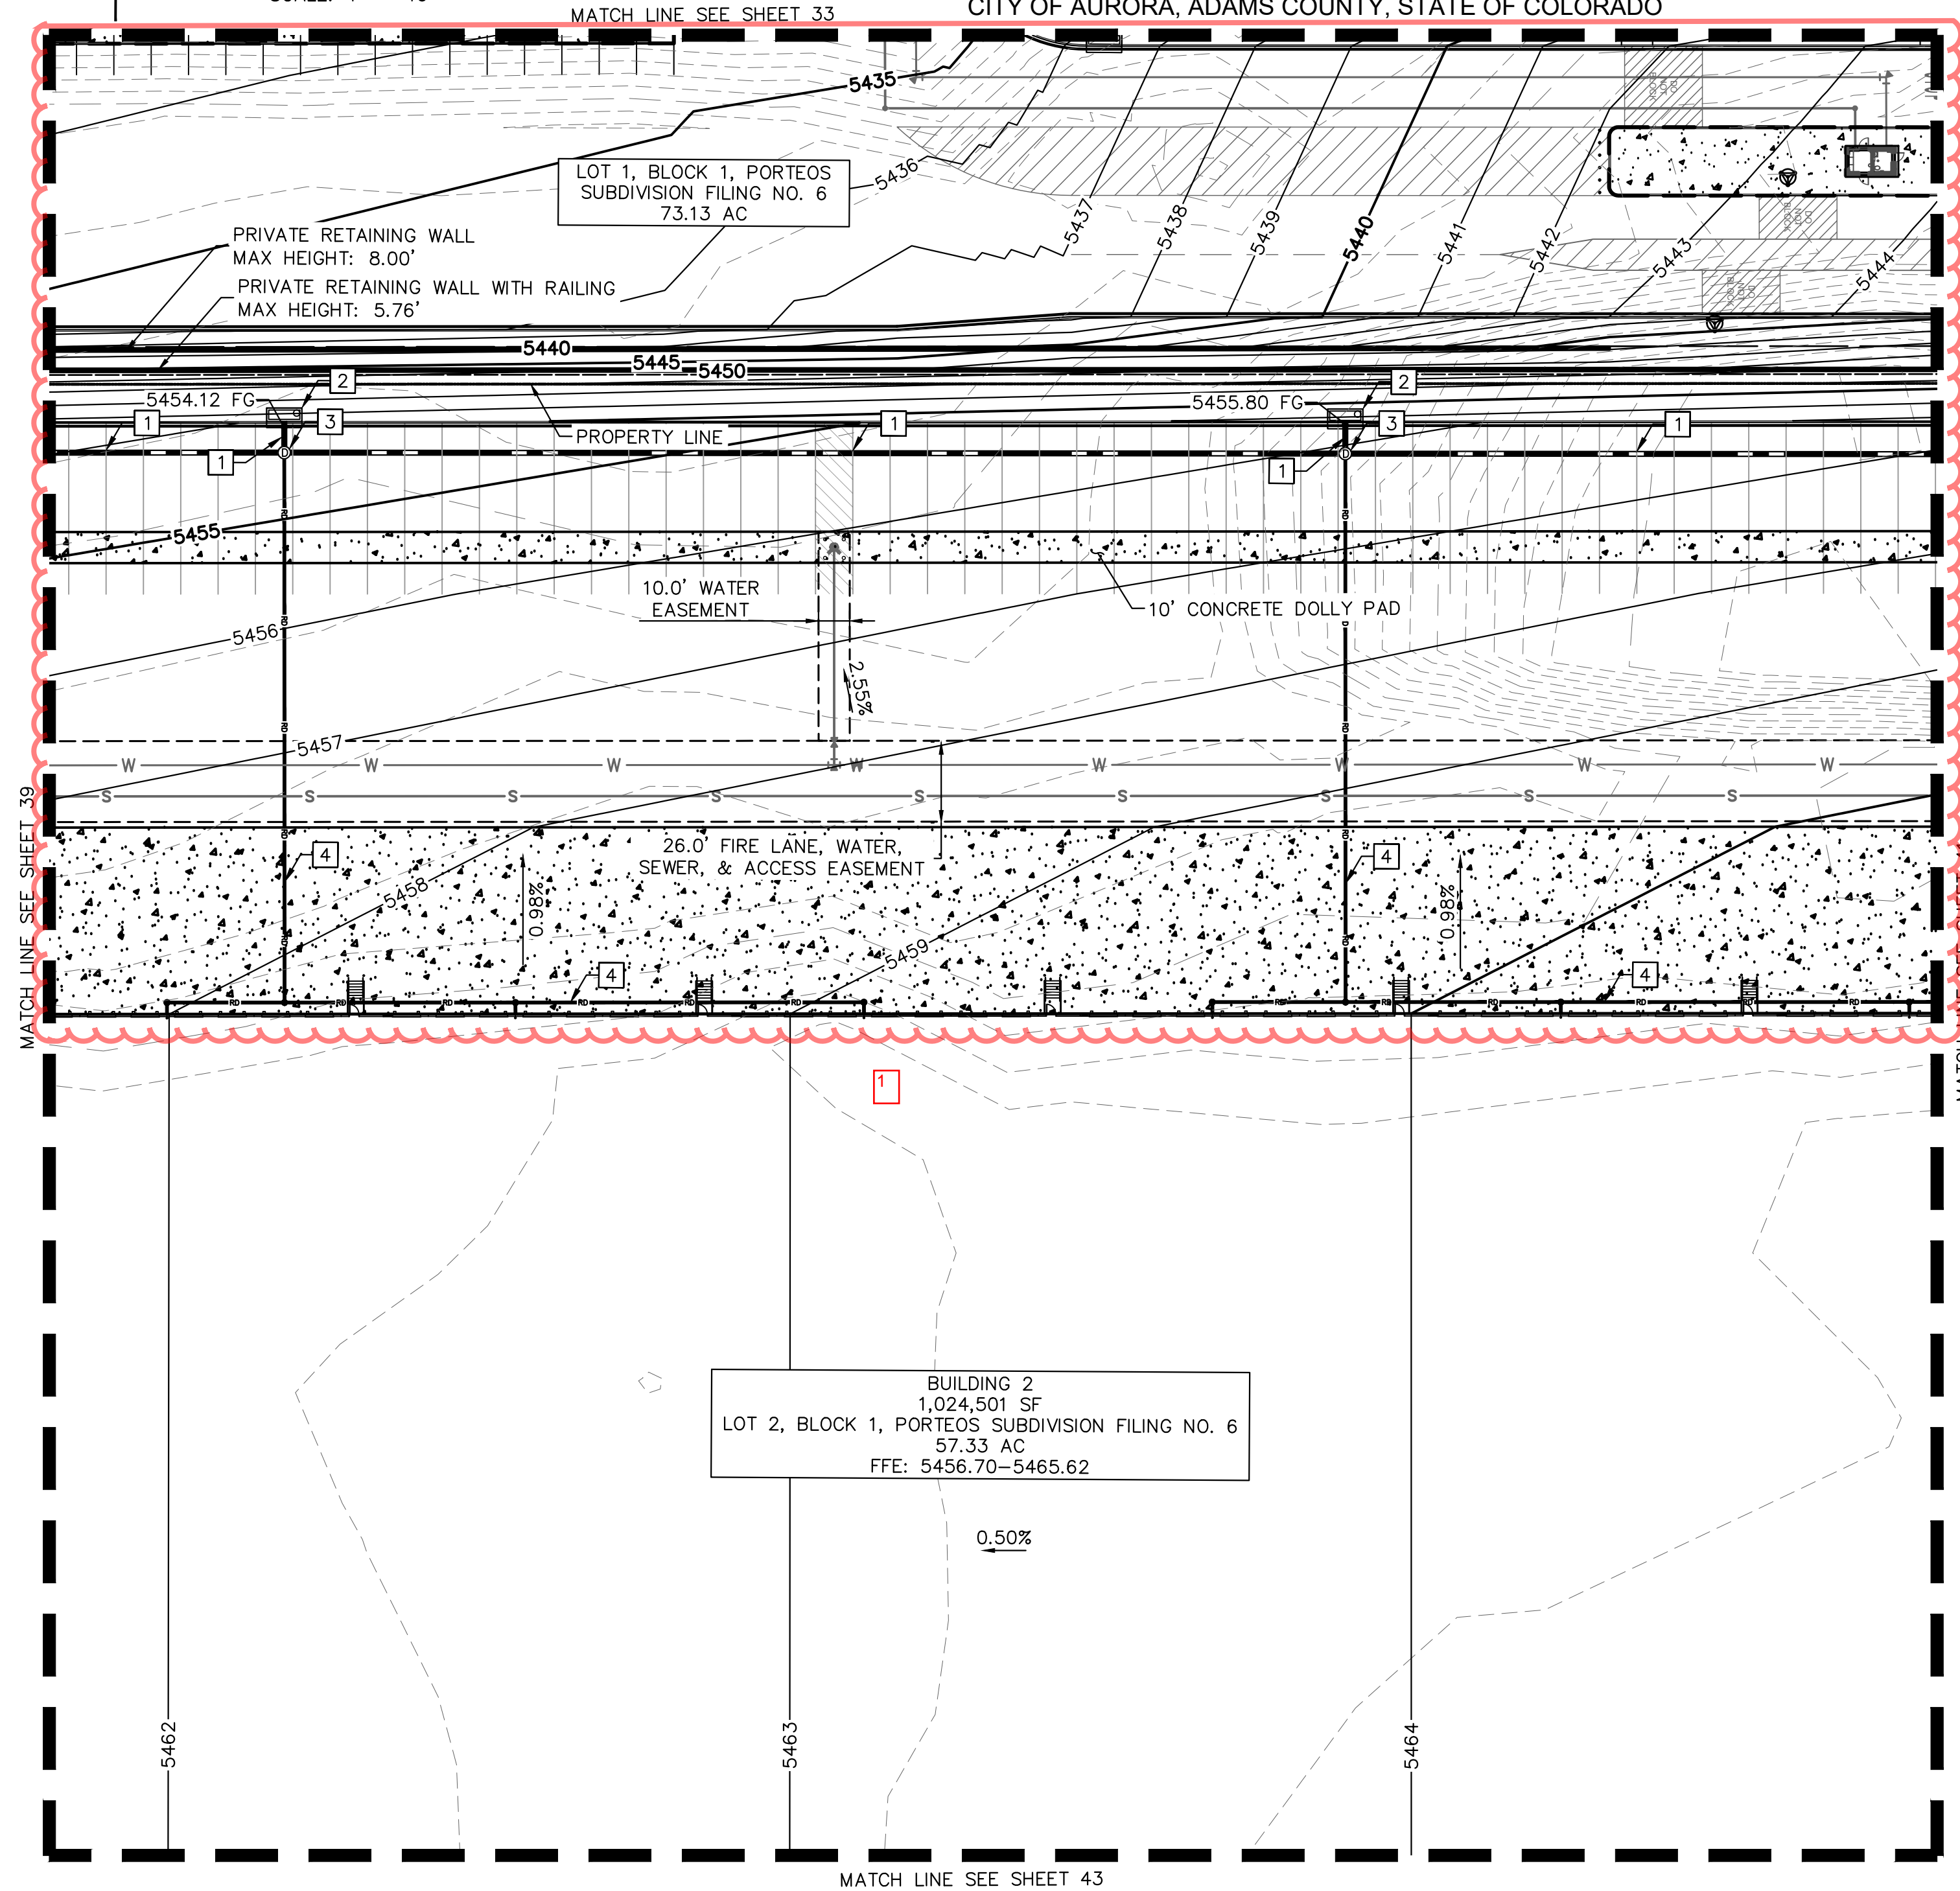

KEYMAP
NTS

LEGEND

- PROPERTY LINE
- EASEMENT LINE
- XXXX EXISTING CONTOUR
- XXXX PROPOSED CONTOUR
- CONCRETE CURB & GUTTER
- AR ACCESSIBLE ROUTE
- PAVEMENT SAWCUT LINE
- X.XX% SLOPE ARROW

GRADING PLAN KEYNOTES

- 1 STORM SEWER
- 2 STORM INLET
- 3 STORM MANHOLE
- 4 ROOF DRAIN
- 5 FLARED END SECTION
- 6 FOREBAY

GRADING PLAN NOTES

- GRADES ADJACENT TO THE BUILDING SHALL BE A MINIMUM OF 1% FOR THE FIRST 10 FEET FOR IMPERVIOUS AREA AND A MINIMUM OF 5% FOR PERVIOUS AREA PER COA CRITERIA. UNLESS OTHERWISE NOTED.
- STORMWATER INFRASTRUCTURE OWNERSHIP SHALL BE DESIGNATED BY THE CONSTRUCTION DOCUMENTS.
- MAXIMUM 2% SLOPE IN ANY DIRECTION AT HANDICAP PARKING SPACES.
- THE MAXIMUM LONGITUDINAL SLOPE WITHIN A FIRE LANE EASEMENT SHALL NOT EXCEED 10%. THE TRANSVERSE SLOPE SHALL GENERALLY HAVE A 2% BUT NOT EXCEEDING 4%. THE RESULTANT SLOPE SHALL NOT EXCEED 10%.

Kimley»Horn
KIMLEY-HORN AND ASSOCIATES, INC.
6205 S. HARRISON
GREENWOOD VILLAGE, CO 80111 (303) 228-2300



PORTEOS INDUSTRIAL AT PORTEOS
CITY OF AURORA, COUNTY OF ADAMS
SITE PLAN AMENDMENT
DETAILED GRADING PLAN

DATE: 03/22/2024
DESIGNED BY: CAO
DRAWN BY: AGM
CHECKED BY: BJC

FILE NO.
196617002_GD DTL-DIA II
PROJECT NO.
196617002



SHEET NO.

K:\DEN_Civil\196617002 DIA1\CADD\PlanSheets\CSP\196617002_GD DTL-DIA II.dwg OKeeffe, Sam 3/27/2024 1:10 PM

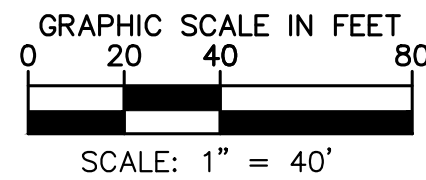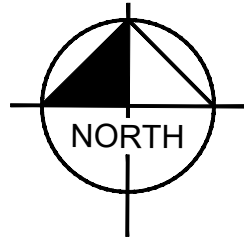

PORTEOS INDUSTRIAL AT PORTEOS SITE PLAN AMENDMENT

LOCATED IN THE NW $\frac{1}{4}$ OF SECTION 9,
TOWNSHIP 3 SOUTH, RANGE 65 WEST OF THE 6TH P.M.,
CITY OF AURORA, ADAMS COUNTY, STATE OF COLORADO

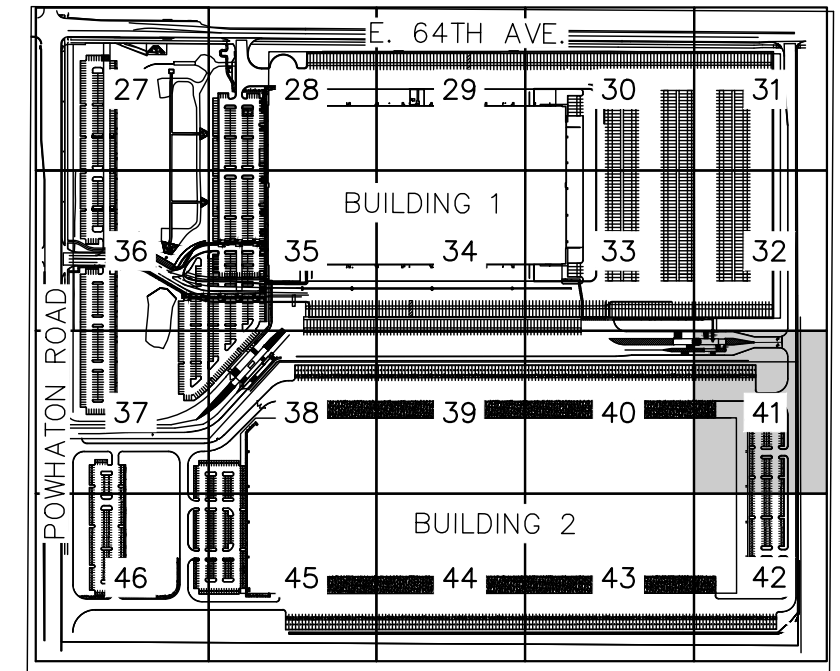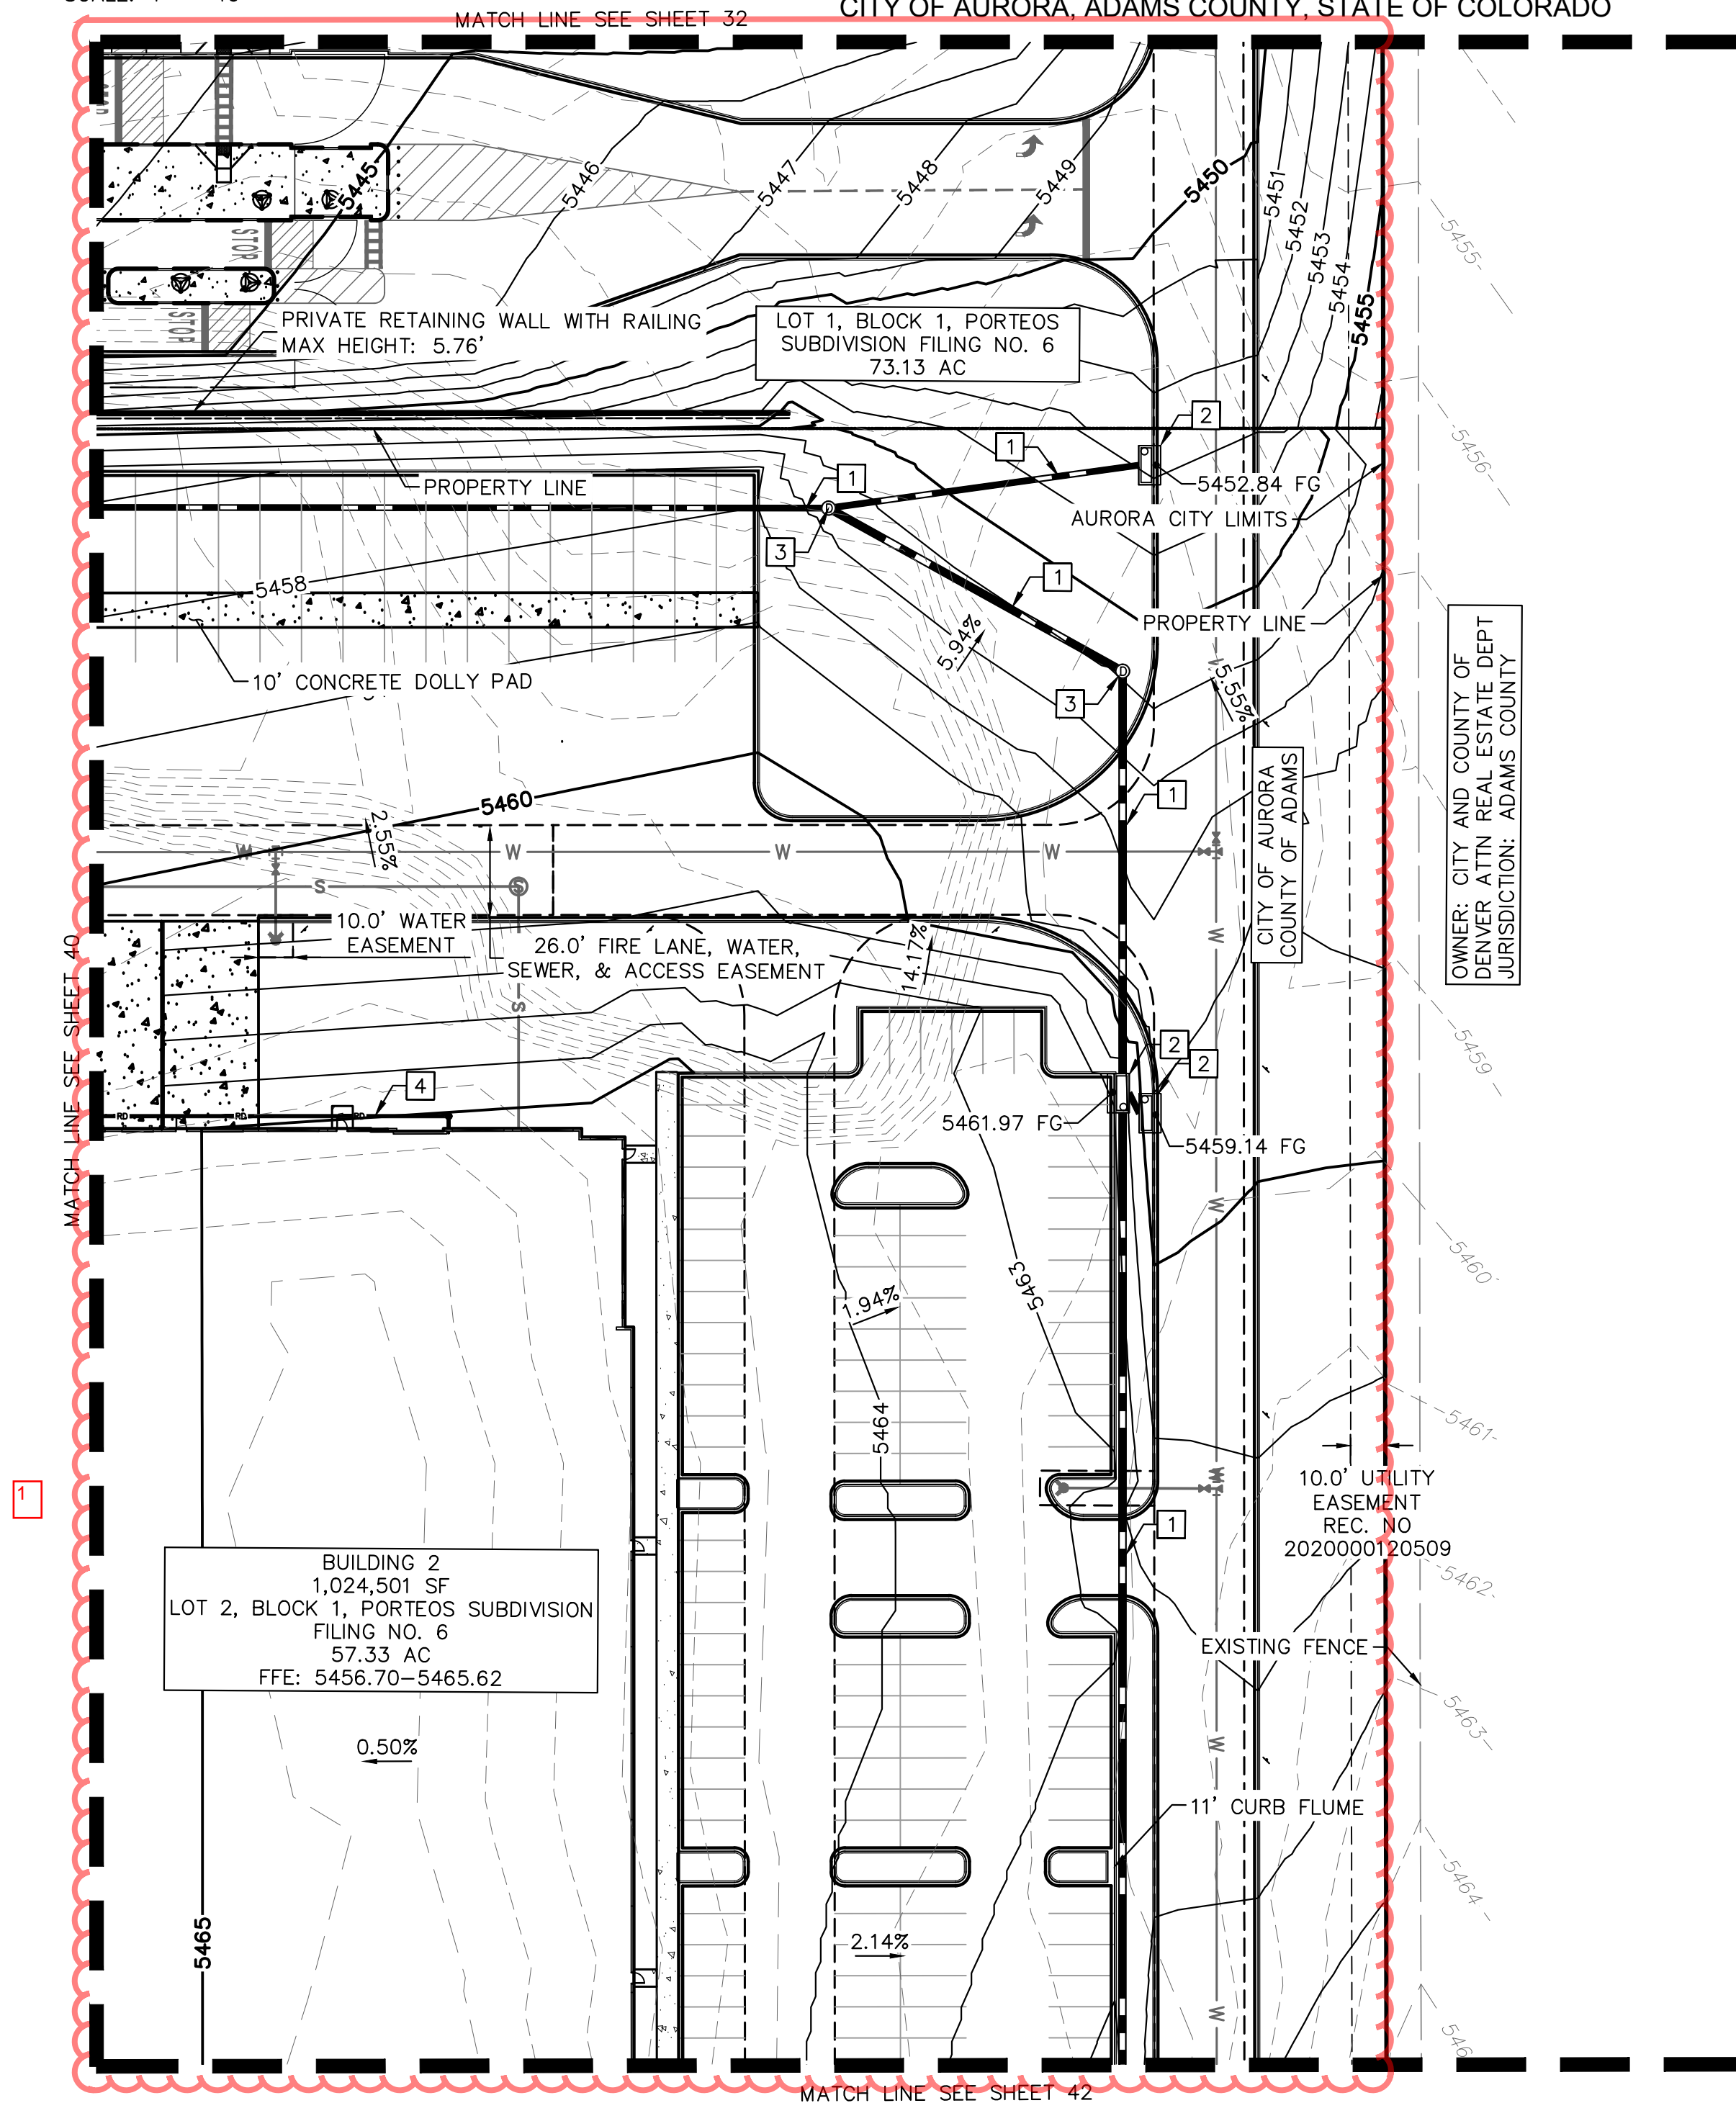

LEGEND

- PROPERTY LINE
- EASEMENT LINE
- XXXX EXISTING CONTOUR
- XXXX PROPOSED CONTOUR
- CONCRETE CURB & GUTTER
- AR ACCESSIBLE ROUTE
- PAVEMENT SAWCUT LINE
- X.XX% SLOPE ARROW

GRADING PLAN KEYNOTES

- 1 STORM SEWER
- 2 STORM INLET
- 3 STORM MANHOLE
- 4 ROOF DRAIN
- 5 FLARED END SECTION
- 6 FOREBAY

GRADING PLAN NOTES

- GRADES ADJACENT TO THE BUILDING SHALL BE A MINIMUM OF 1% FOR THE FIRST 10 FEET FOR IMPERVIOUS AREA AND A MINIMUM OF 5% FOR PERVIOUS AREA PER COA CRITERIA, UNLESS OTHERWISE NOTED.
- STORMWATER INFRASTRUCTURE OWNERSHIP SHALL BE DESIGNATED BY THE CONSTRUCTION DOCUMENTS.
- MAXIMUM 2% SLOPE IN ANY DIRECTION AT HANDICAP PARKING SPACES.
- THE MAXIMUM LONGITUDINAL SLOPE WITHIN A FIRE LANE EASEMENT SHALL NOT EXCEED 10%. THE TRANSVERSE SLOPE SHALL GENERALLY HAVE A 2% BUT NOT EXCEEDING 4%. THE RESULTANT SLOPE SHALL NOT EXCEED 10%.

Kimley»Horn

KIMLEY-HORN AND ASSOCIATES, INC.
6205 S. HANCOCK
Greenwood Village, CO 80111 (303) 228-2300



PORTEOS INDUSTRIAL AT PORTEOS
CITY OF AURORA, COUNTY OF ADAMS
SITE PLAN AMENDMENT
DETAILED GRADING PLAN

DATE: 03/22/2024
DESIGNED BY: CAO
DRAWN BY: AGM
CHECKED BY: BJC

FILE NO.
196617002_GD DTL-DIA II
PROJECT NO.
196617002



SHEET NO.

K:\DEN_Civil\196617002 DIA1\CADD\PlanSheets\CSP\196617002_GD DTL-DA II.dwg Movis, August 3/27/2024 10:18 AM

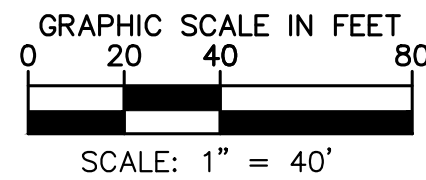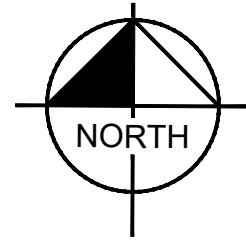

PORTEOS INDUSTRIAL AT PORTEOS SITE PLAN AMENDMENT

LOCATED IN THE NW $\frac{1}{4}$ OF SECTION 9,
TOWNSHIP 3 SOUTH, RANGE 65 WEST OF THE 6TH P.M.,
CITY OF AURORA, ADAMS COUNTY, STATE OF COLORADO

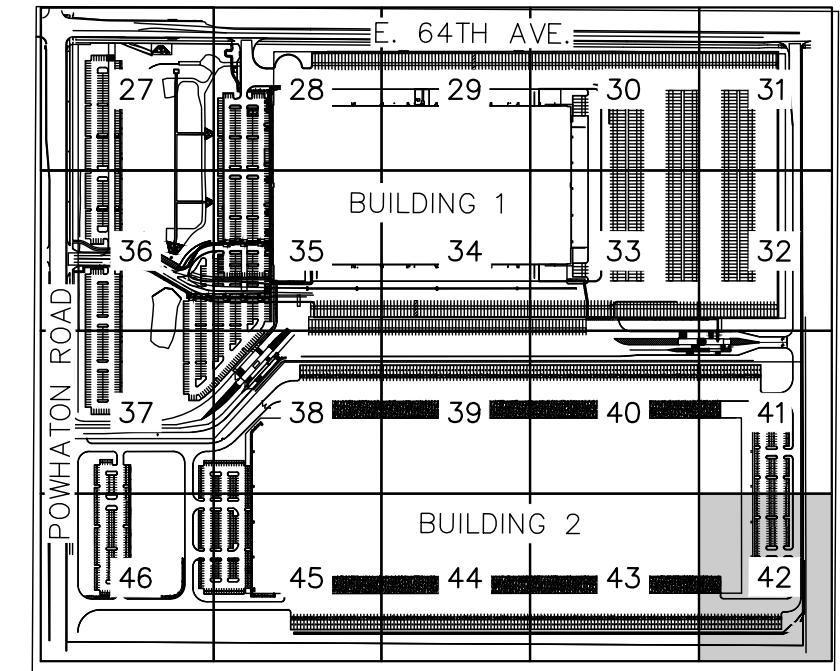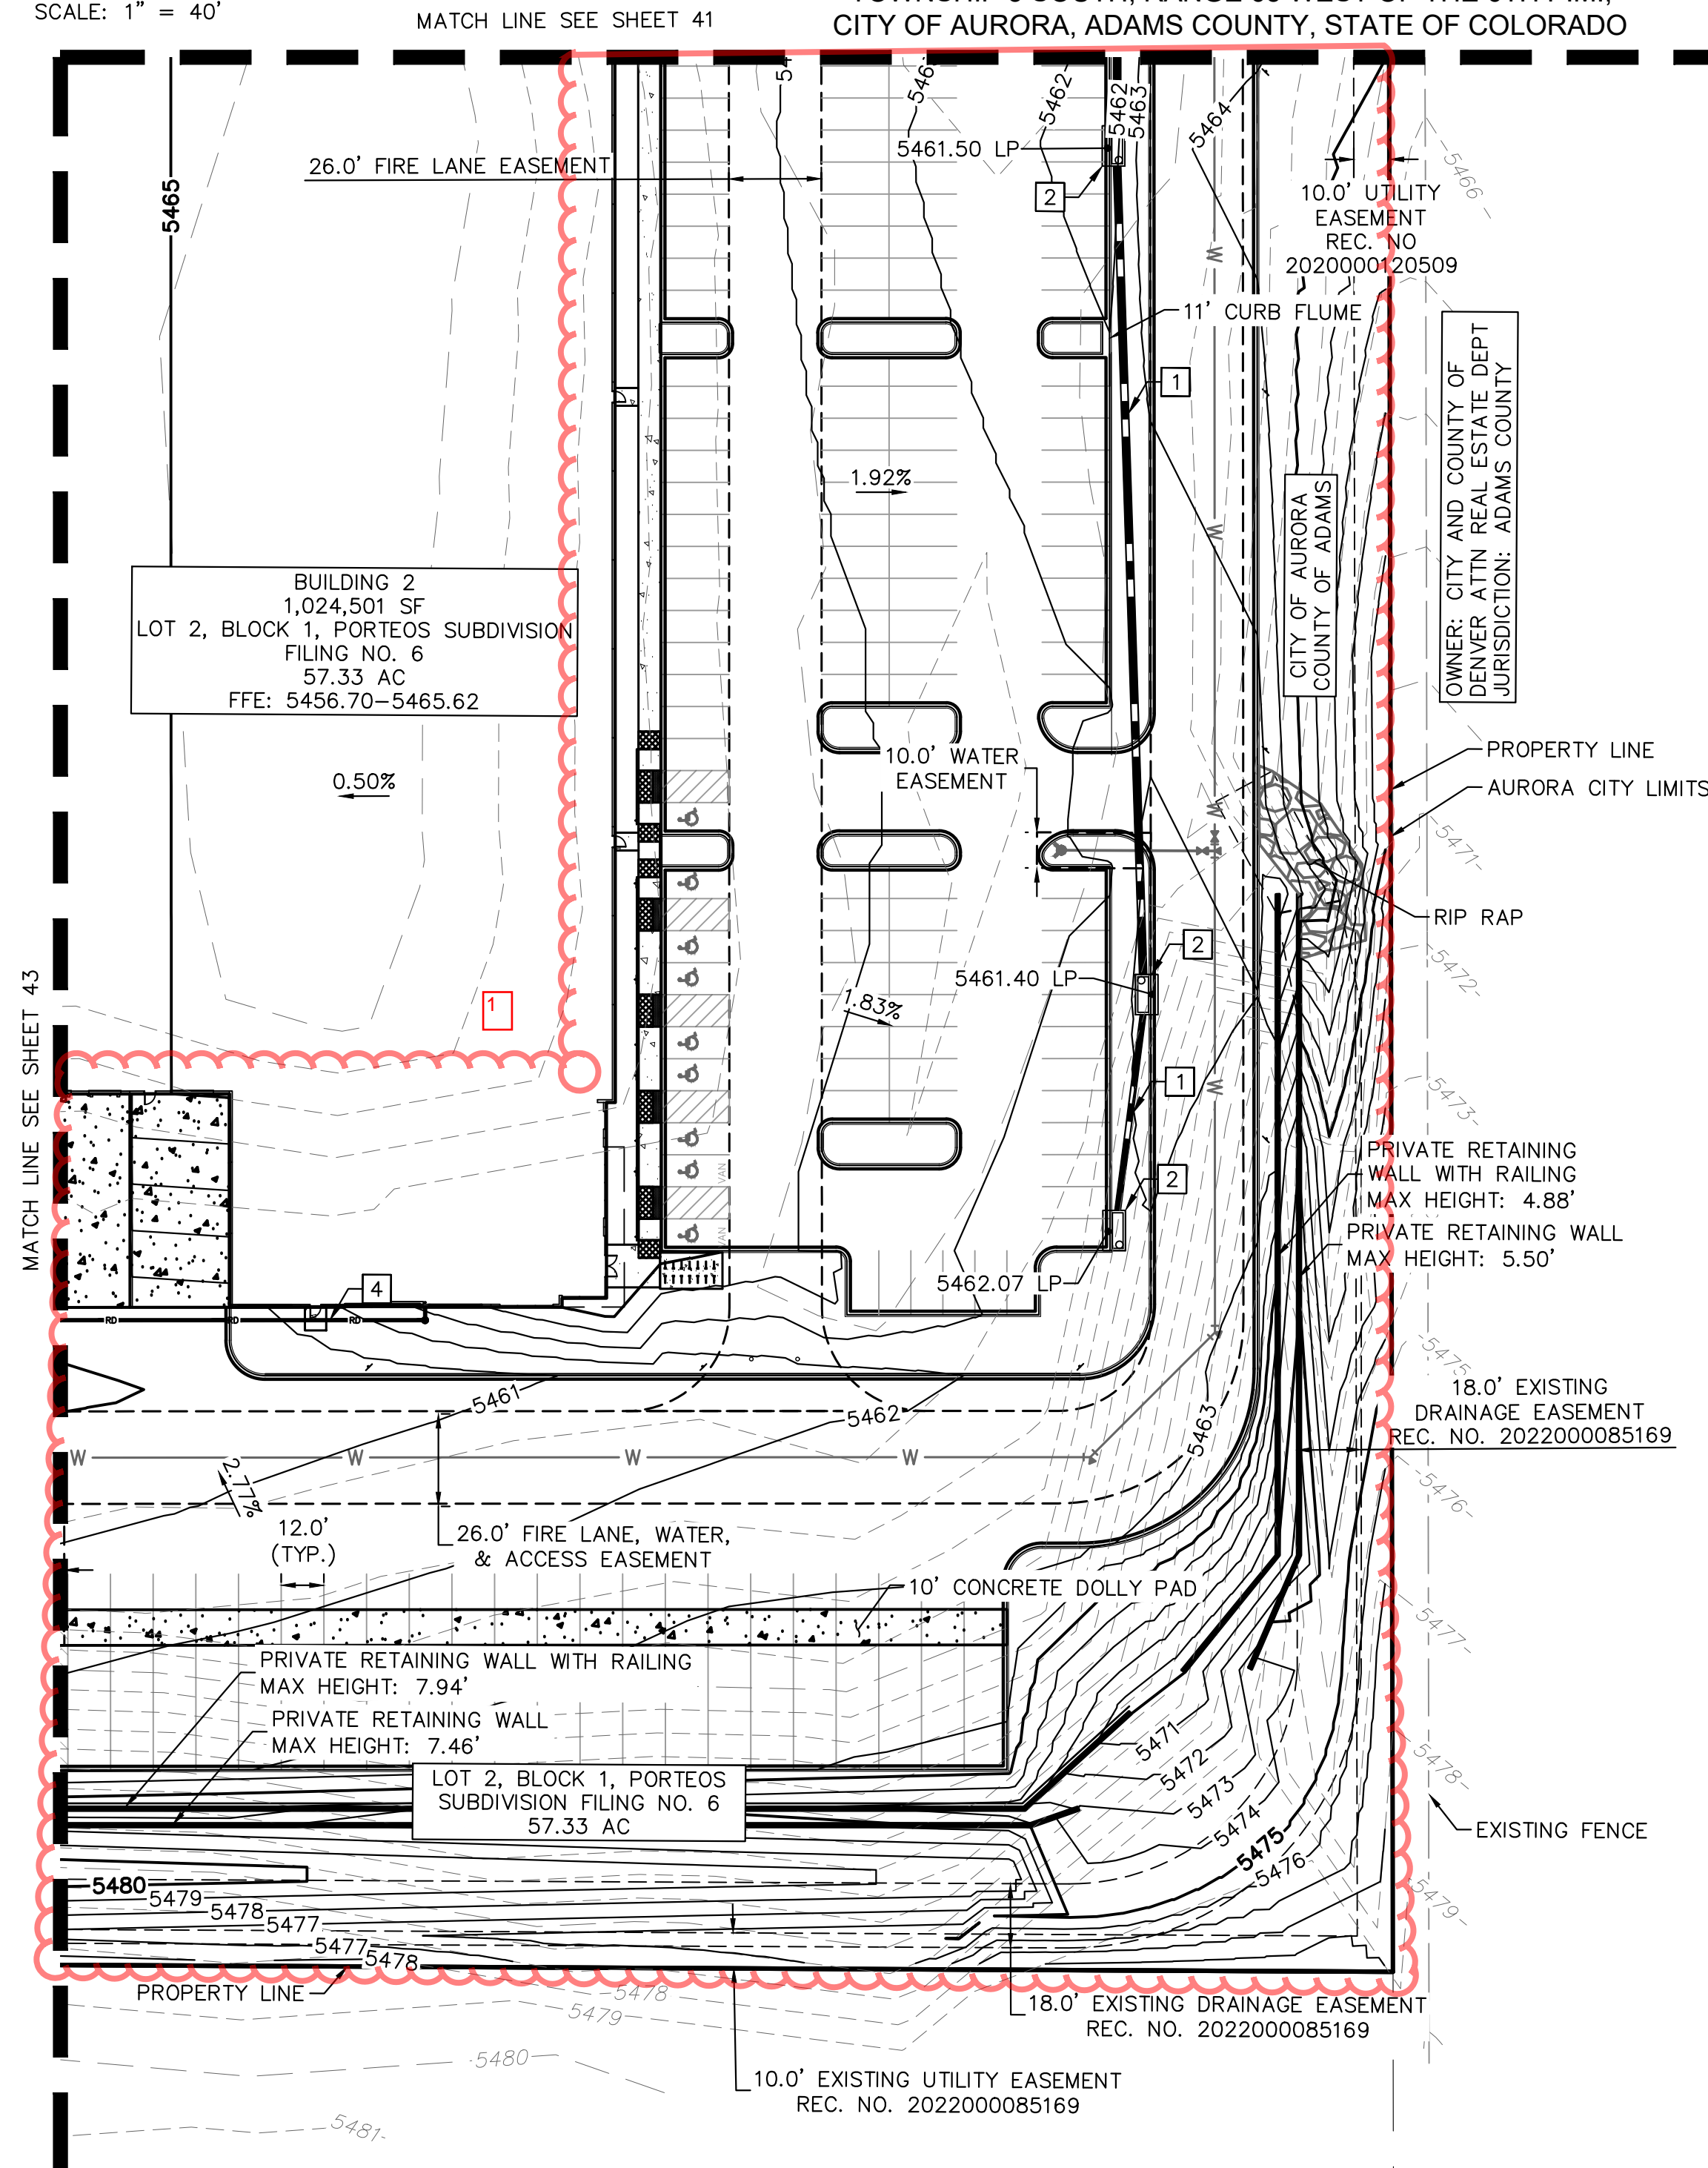

LEGEND

- PROPERTY LINE
- EASEMENT LINE
- XXXX EXISTING CONTOUR
- XXXX PROPOSED CONTOUR
- CONCRETE CURB & GUTTER
- AR ACCESSIBLE ROUTE
- PAVEMENT SAWCUT LINE
- X.XX% SLOPE ARROW

GRADING PLAN KEYNOTES

- 1 STORM SEWER
- 2 STORM INLET
- 3 STORM MANHOLE
- 4 ROOF DRAIN
- 5 FLARED END SECTION
- 6 FOREBAY

GRADING PLAN NOTES

- GRADES ADJACENT TO THE BUILDING SHALL BE A MINIMUM OF 1% FOR THE FIRST 10 FEET FOR IMPERVIOUS AREA AND A MINIMUM OF 5% FOR PERVIOUS AREA PER COA CRITERIA. UNLESS OTHERWISE NOTED.
- STORMWATER INFRASTRUCTURE OWNERSHIP SHALL BE DESIGNATED BY THE CONSTRUCTION DOCUMENTS.
- MAXIMUM 2% SLOPE IN ANY DIRECTION AT HANDICAP PARKING SPACES.
- THE MAXIMUM LONGITUDINAL SLOPE WITHIN A FIRE LANE EASEMENT SHALL NOT EXCEED 10%. THE TRANSVERSE SLOPE SHALL GENERALLY HAVE A 2% BUT NOT EXCEEDING 4%. THE RESULTANT SLOPE SHALL NOT EXCEED 10%.

Kimley»Horn
KIMLEY-HORN AND ASSOCIATES, INC.
6205 S. WATKINS
Greenwood Village, CO 80111 (303) 228-2300

PORTEOS INDUSTRIAL AT PORTEOS
CITY OF AURORA, COUNTY OF ADAMS
SITE PLAN AMENDMENT
DETAILED GRADING PLAN

DATE: 03/22/2024
DESIGNED BY: CAO
DRAWN BY: AGM
CHECKED BY: BJC


FILE NO.
196617002_GD DTL-DA II
PROJECT NO.
196617002

SHEET NO.


K:\DEN_Civil\196617002 DIA1\CADD\PlanSheets\CSP\196617002_GD DTL-DIA II.dwg Movis, August 3/27/2024 10:18 AM

MATCH LINE SEE SHEET 44

MATCH LINE SEE SHEET 42

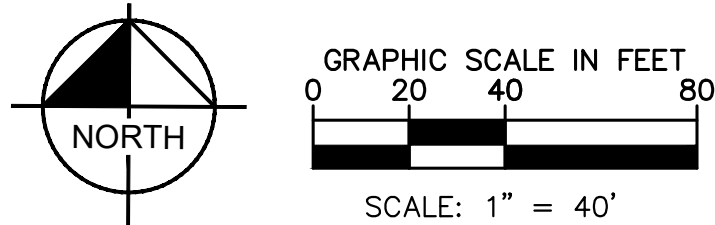

PORTEOS INDUSTRIAL AT PORTEOS
SITE PLAN AMENDMENT
LOCATED IN THE NW $\frac{1}{4}$ OF SECTION 9,
TOWNSHIP 3 SOUTH, RANGE 65 WEST OF THE 6TH P.M.,
CITY OF AURORA, ADAMS COUNTY, STATE OF COLORADO

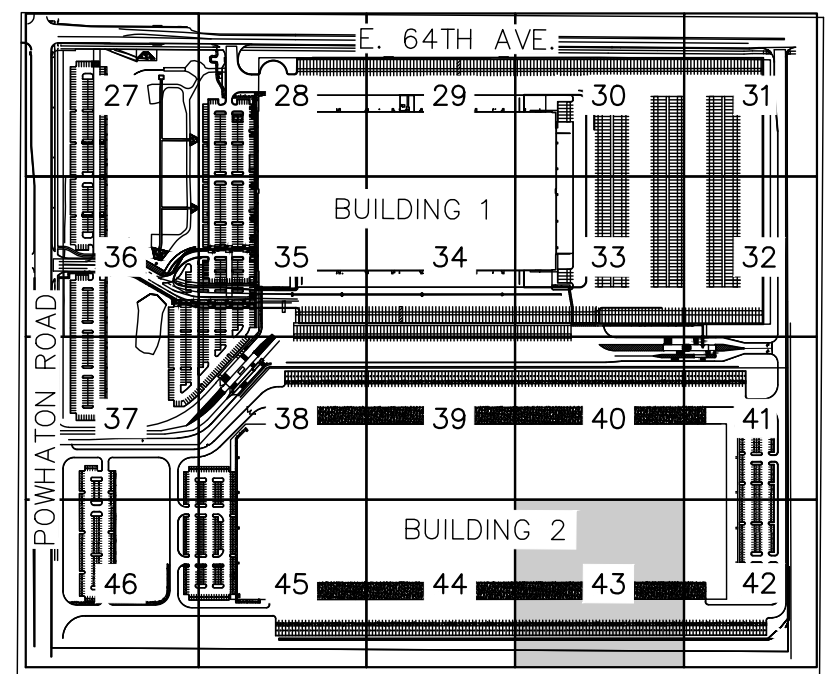

- LEGEND**
- PROPERTY LINE
 - EASEMENT LINE
 - XXXX EXISTING CONTOUR
 - XXXX PROPOSED CONTOUR
 - CONCRETE CURB & GUTTER
 - AR ACCESSIBLE ROUTE
 - PAVEMENT SAWCUT LINE
 - X.XX% SLOPE ARROW

GRADING PLAN KEYNOTES

- 1 STORM SEWER
- 2 STORM INLET
- 3 STORM MANHOLE
- 4 ROOF DRAIN
- 5 FLARED END SECTION
- 6 FOREBAY

GRADING PLAN NOTES

- GRADES ADJACENT TO THE BUILDING SHALL BE A MINIMUM OF 1% FOR THE FIRST 10 FEET FOR IMPERVIOUS AREA AND A MINIMUM OF 5% FOR PERVIOUS AREA PER COA CRITERIA. UNLESS OTHERWISE NOTED.
- STORMWATER INFRASTRUCTURE OWNERSHIP SHALL BE DESIGNATED BY THE CONSTRUCTION DOCUMENTS.
- MAXIMUM 2% SLOPE IN ANY DIRECTION AT HANDICAP PARKING SPACES.
- THE MAXIMUM LONGITUDINAL SLOPE WITHIN A FIRE LANE EASEMENT SHALL NOT EXCEED 10%. THE TRANSVERSE SLOPE SHALL GENERALLY HAVE A 2% BUT NOT EXCEEDING 4%. THE RESULTANT SLOPE SHALL NOT EXCEED 10%.

Kimley»Horn
KIMLEY-HORN AND ASSOCIATES, INC.
6205 S. W. 11TH AVE.
GREENWOOD VILLAGE, CO 80111 (303) 228-2300


PORTEOS INDUSTRIAL AT PORTEOS
CITY OF AURORA, COUNTY OF ADAMS
SITE PLAN AMENDMENT
DETAILED GRADING PLAN

DATE: 03/22/2024
DESIGNED BY: CAO
DRAWN BY: AGM
CHECKED BY: BJC


FILE NO.
196617002_GD DTL-DIA II

PROJECT NO.
196617002

SHEET NO.
43


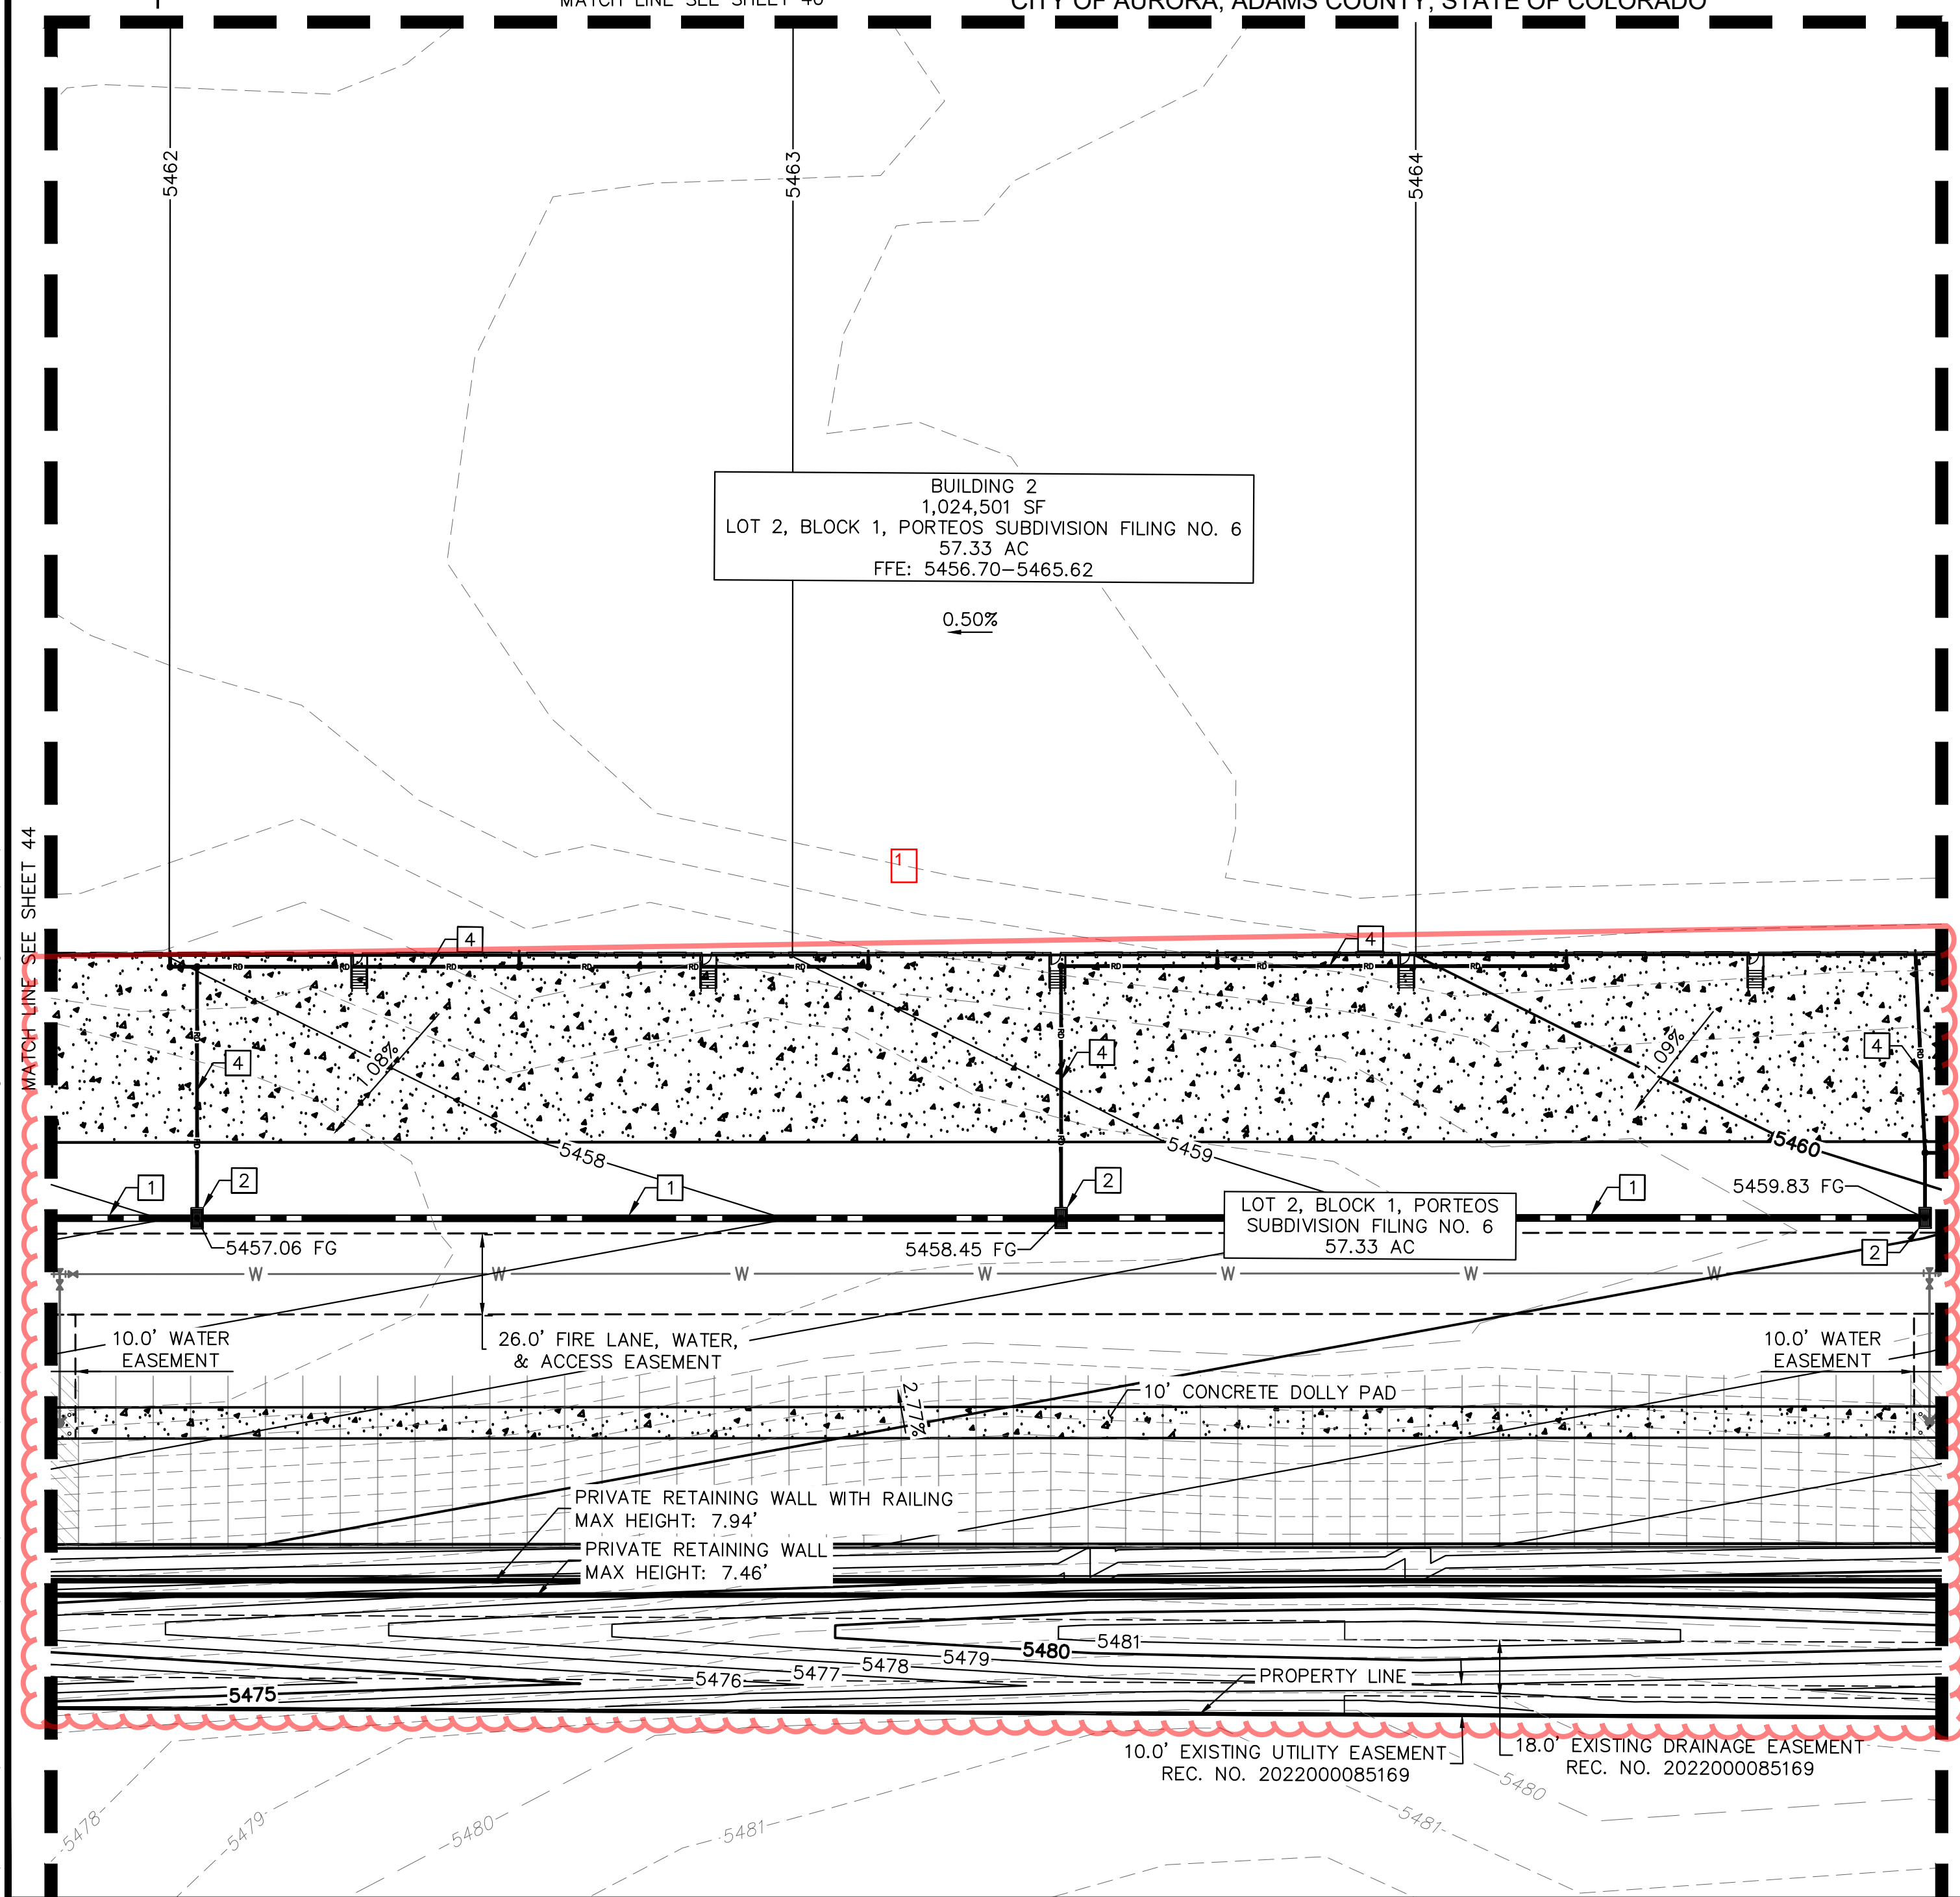


K:\DEN_Civil\196617002 DIA\ CADD\PlanSheets\CSP\196617002_GD DTL-DIA II.dwg Movis, August 3/27/2024 10:18 AM

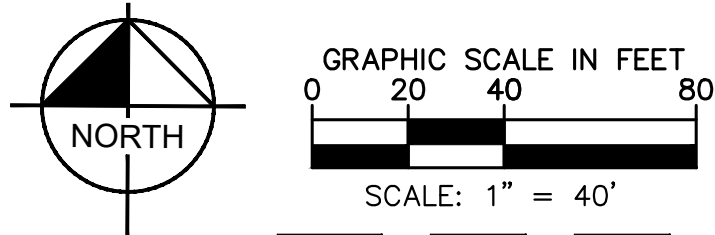

PORTEOS INDUSTRIAL AT PORTEOS SITE PLAN AMENDMENT

LOCATED IN THE NW $\frac{1}{4}$ OF SECTION 9,
TOWNSHIP 3 SOUTH, RANGE 65 WEST OF THE 6TH P.M.,
CITY OF AURORA, ADAMS COUNTY, STATE OF COLORADO

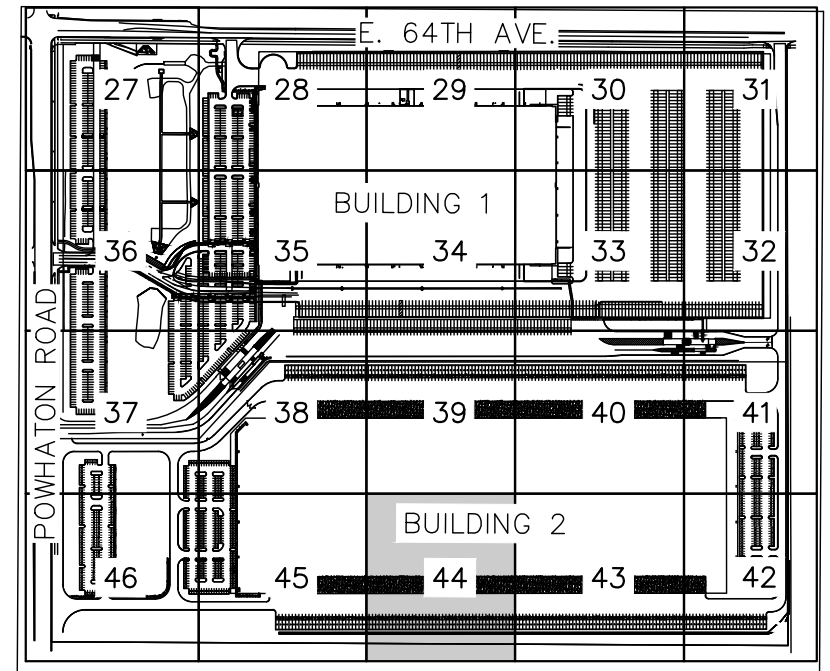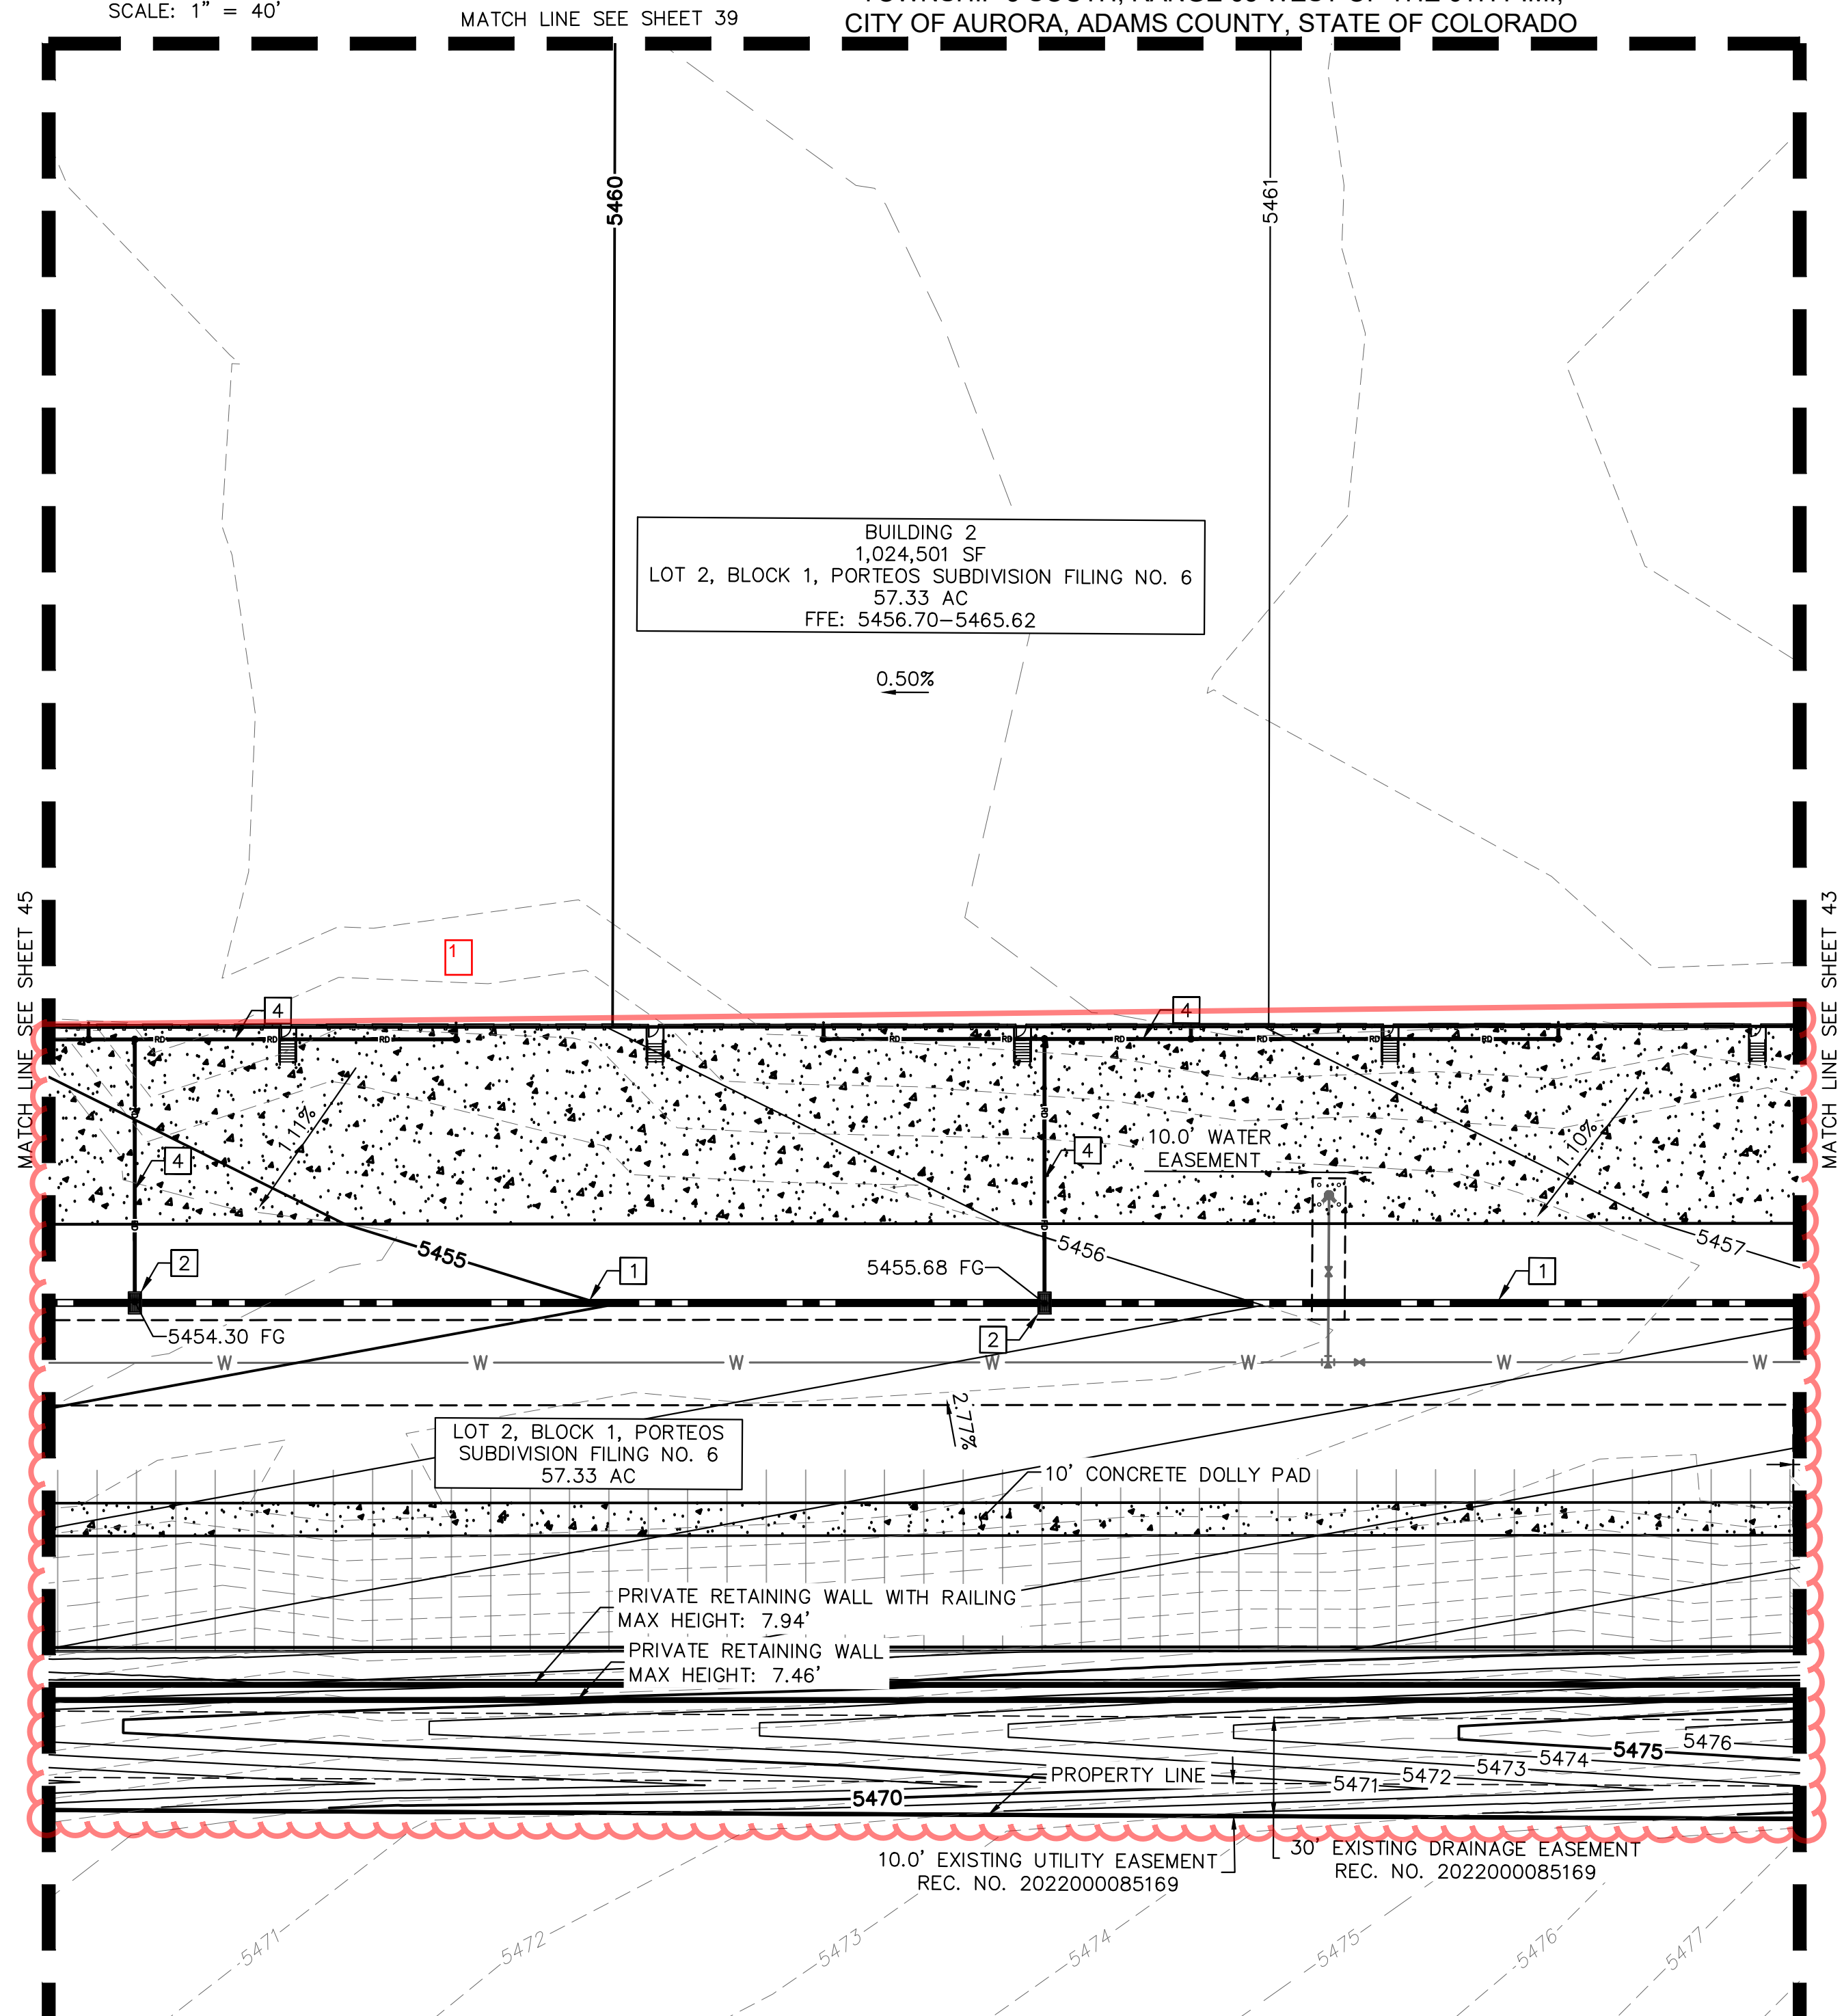

KEYMAP
NTS

LEGEND

- PROPERTY LINE
- EASEMENT LINE
- XXXX EXISTING CONTOUR
- XXXX PROPOSED CONTOUR
- CONCRETE CURB & GUTTER
- AR ACCESSIBLE ROUTE
- PAVEMENT SAWCUT LINE
- X.XX% SLOPE ARROW

GRADING PLAN KEYNOTES

- 1 STORM SEWER
- 2 STORM INLET
- 3 STORM MANHOLE
- 4 ROOF DRAIN
- 5 FLARED END SECTION
- 6 FOREBAY

GRADING PLAN NOTES

- GRADES ADJACENT TO THE BUILDING SHALL BE A MINIMUM OF 1% FOR THE FIRST 10 FEET FOR IMPERVIOUS AREA AND A MINIMUM OF 5% FOR PERVIOUS AREA PER COA CRITERIA. UNLESS OTHERWISE NOTED.
- STORMWATER INFRASTRUCTURE OWNERSHIP SHALL BE DESIGNATED BY THE CONSTRUCTION DOCUMENTS.
- MAXIMUM 2% SLOPE IN ANY DIRECTION AT HANDICAP PARKING SPACES.
- THE MAXIMUM LONGITUDINAL SLOPE WITHIN A FIRE LANE EASEMENT SHALL NOT EXCEED 10%. THE TRANSVERSE SLOPE SHALL GENERALLY HAVE A 2% BUT NOT EXCEEDING 4%. THE RESULTANT SLOPE SHALL NOT EXCEED 10%.

CHANG
ES
SO
3/25/24
BJS

NO.	REVISION	BY	DATE	APPR

Kimley»Horn

KIMLEY-HORN AND ASSOCIATES, INC.
6205 S. W. 11th Ave.
Greenwood Village, CO 80111 (303) 228-2300

PORTEOS INDUSTRIAL AT PORTEOS
CITY OF AURORA, COUNTY OF ADAMS
SITE PLAN AMENDMENT
DETAILED GRADING PLAN

FILE NO.
196617002_GD DTL-DA II

PROJECT NO.
196617002

DATE: 03/22/2024

DESIGNED BY: CAO



DRAWN BY: AGM

CHECKED BY: BJC

SHEET NO.

44

K:\DEN_Civil\196617002 DIA1\CADD\PlanSheets\CSP\196617002_GD DTL-DIA II.dwg Movis, August 3/27/2024 10:18 AM

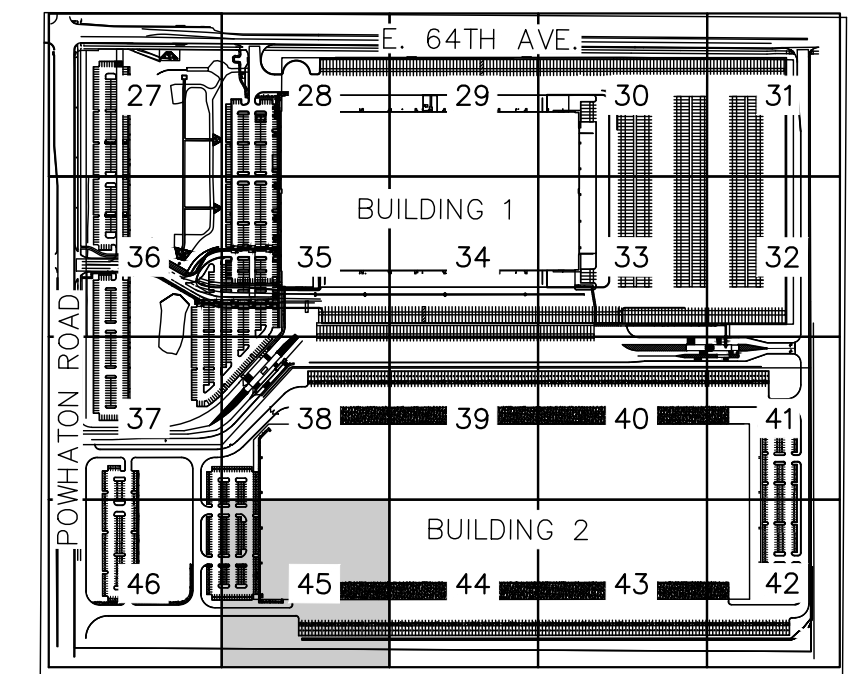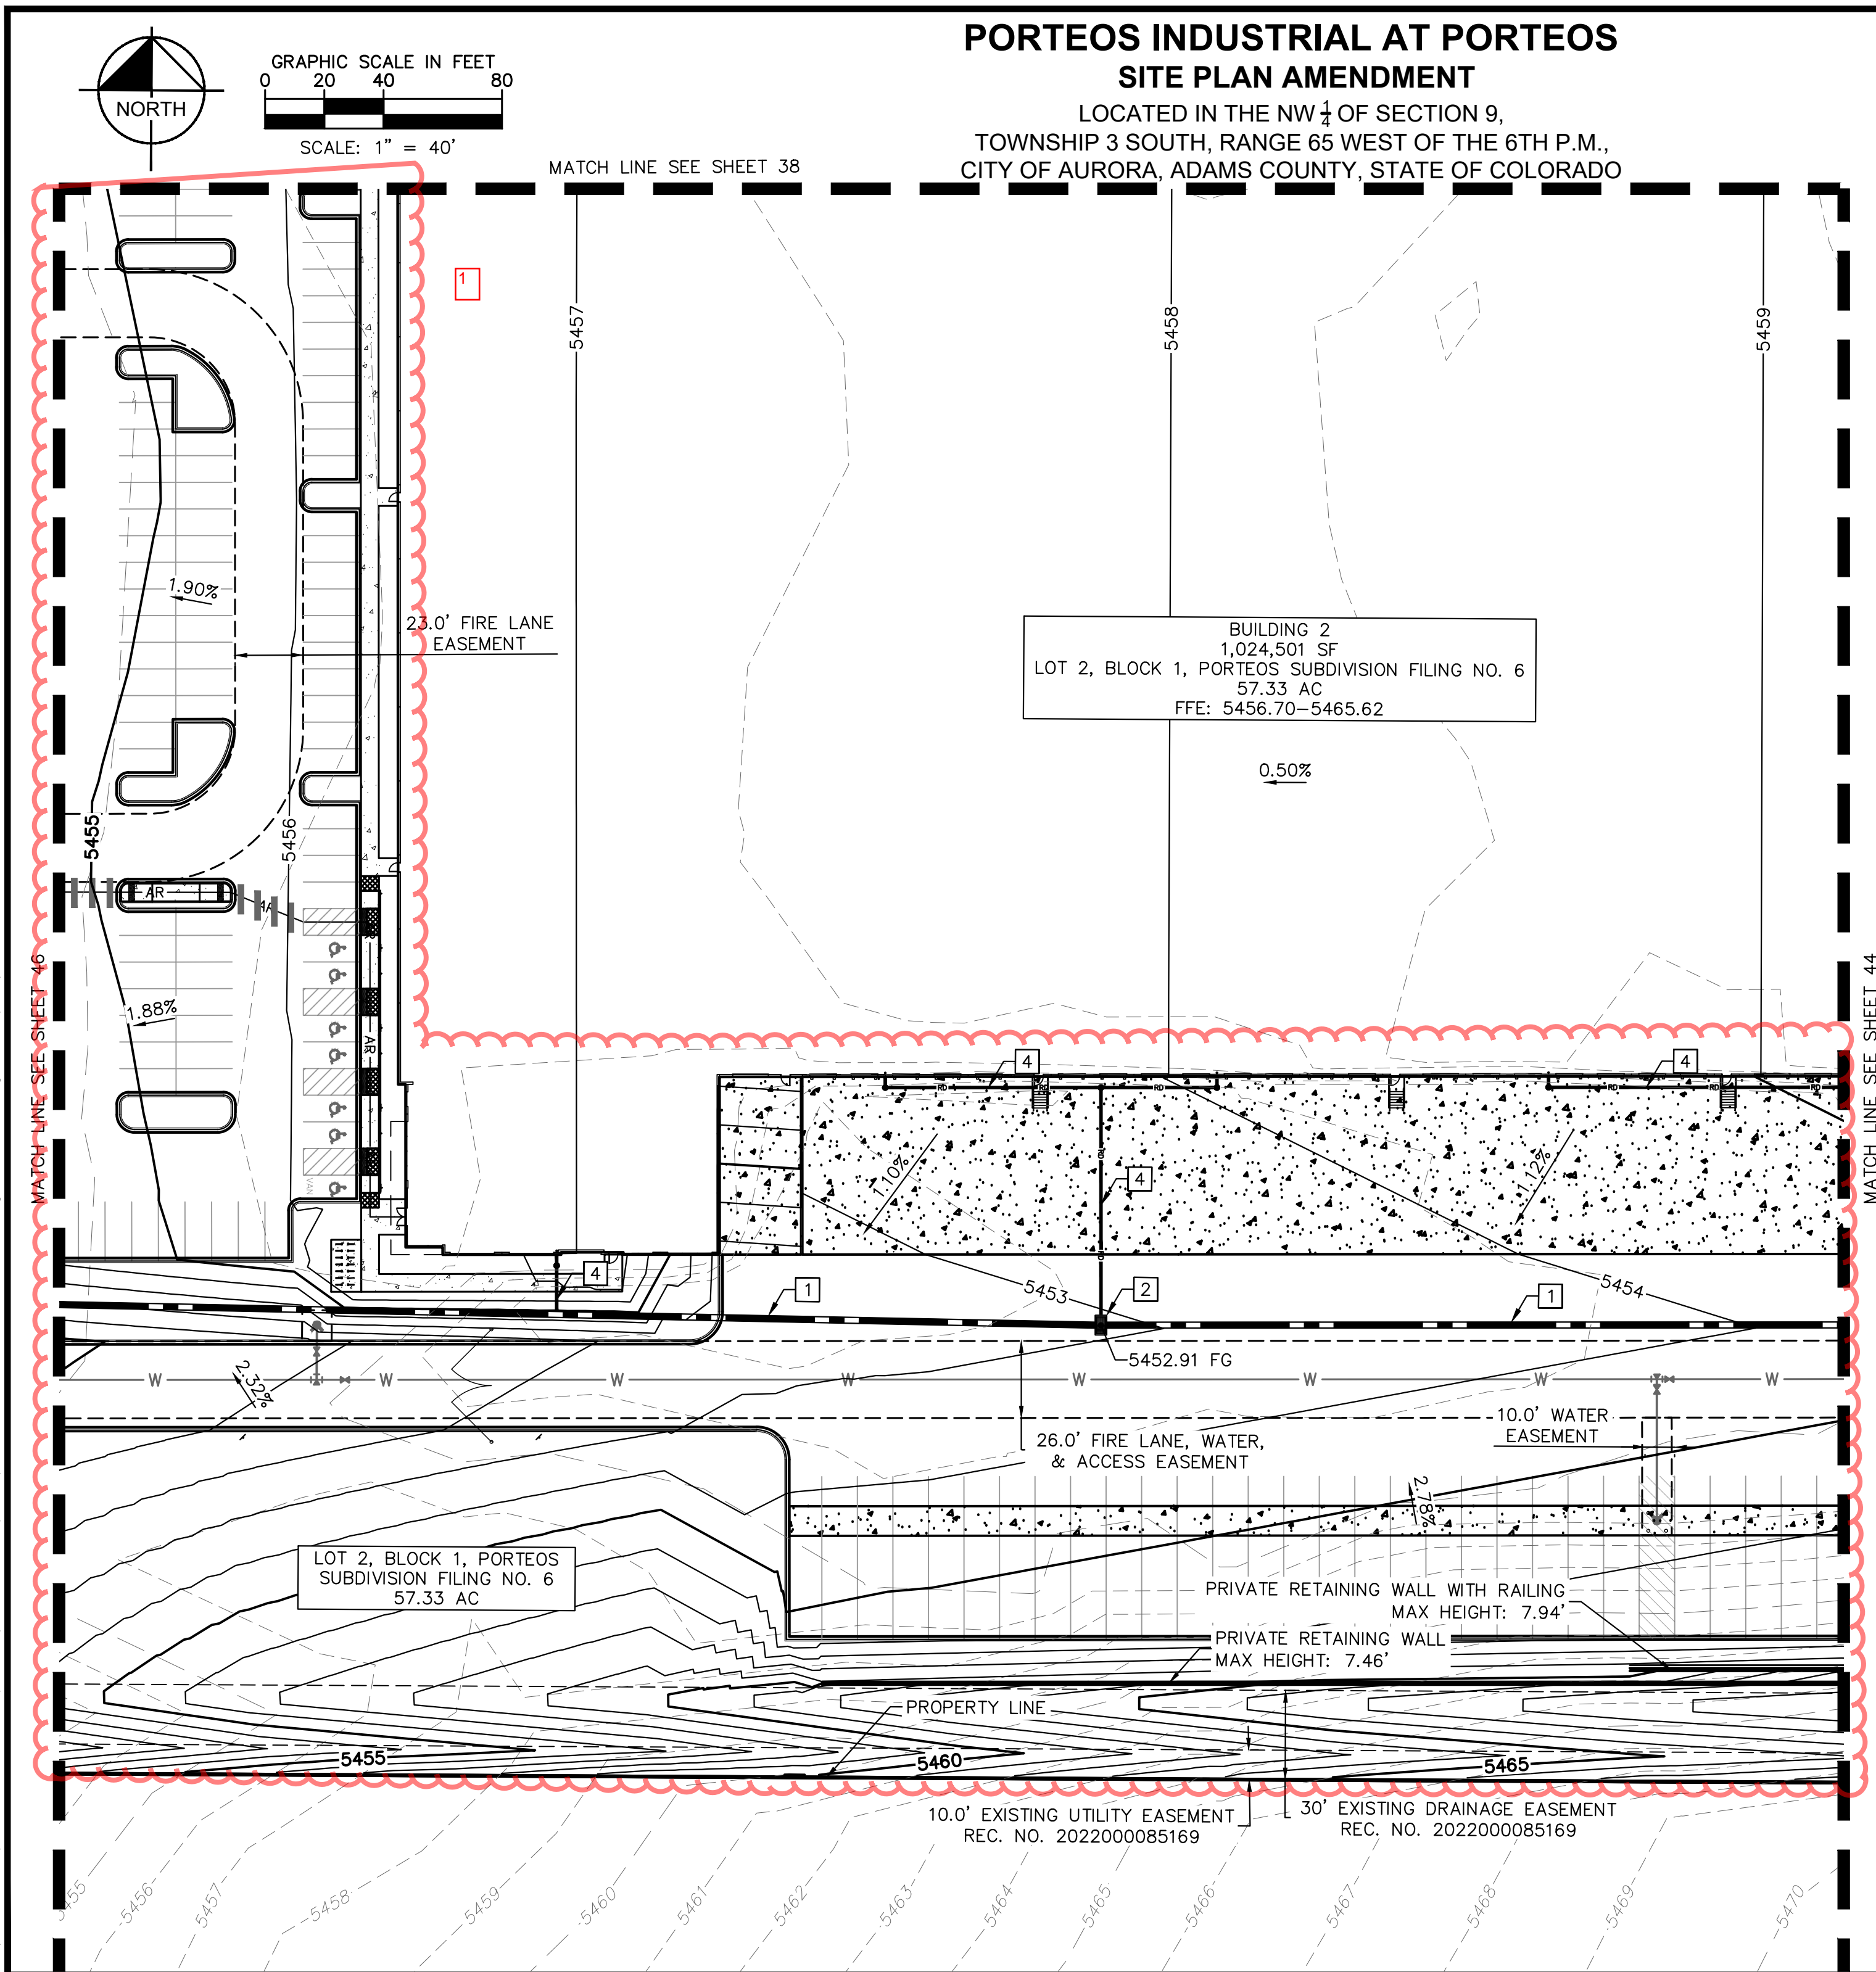

LEGEND

- PROPERTY LINE
- EASEMENT LINE
- EXISTING CONTOUR
- PROPOSED CONTOUR
- CONCRETE CURB & GUTTER
- ACCESSIBLE ROUTE
- PAVEMENT SAWCUT LINE
- SLOPE ARROW

- GRADING PLAN KEYNOTES**
- 1 STORM SEWER
 - 2 STORM INLET
 - 3 STORM MANHOLE
 - 4 ROOF DRAIN
 - 5 FLARED END SECTION
 - 6 FOREBAY

- GRADING PLAN NOTES**
- GRADES ADJACENT TO THE BUILDING SHALL BE A MINIMUM OF 1% FOR THE FIRST 10 FEET FOR IMPERVIOUS AREA AND A MINIMUM OF 5% FOR PERVIOUS AREA PER COA CRITERIA. UNLESS OTHERWISE NOTED.
 - STORMWATER INFRASTRUCTURE OWNERSHIP SHALL BE DESIGNATED BY THE CONSTRUCTION DOCUMENTS.
 - MAXIMUM 2% SLOPE IN ANY DIRECTION AT HANDICAP PARKING SPACES.
 - THE MAXIMUM LONGITUDINAL SLOPE WITHIN A FIRE LANE EASEMENT SHALL NOT EXCEED 10%. THE TRANSVERSE SLOPE SHALL GENERALLY HAVE A 2% BUT NOT EXCEEDING 4%. THE RESULTANT SLOPE SHALL NOT EXCEED 10%.

Kimley»Horn

KIMLEY-HORN AND ASSOCIATES, INC.
6205 S. W. 11th Ave.
Greenwood Village, CO 80111 (303) 228-2300

PORTEOS INDUSTRIAL AT PORTEOS
CITY OF AURORA, COUNTY OF ADAMS
SITE PLAN AMENDMENT
DETAILED GRADING PLAN

DATE: 03/22/2024
DESIGNED BY: CAO
DRAWN BY: AGM
CHECKED BY: BJC



FILE NO. 196617002_GD DTL-DA II
PROJECT NO. 196617002

SHEET NO. 45

NO.	REVISION	BY	DATE	APPROVED

PORTEOS INDUSTRIAL AT PORTEOS SITE PLAN AMENDMENT

LOCATED IN THE NW $\frac{1}{4}$ OF SECTION 9,
TOWNSHIP 3 SOUTH, RANGE 65 WEST OF THE 6TH P.M.,
CITY OF AURORA, ADAMS COUNTY, STATE OF COLORADO

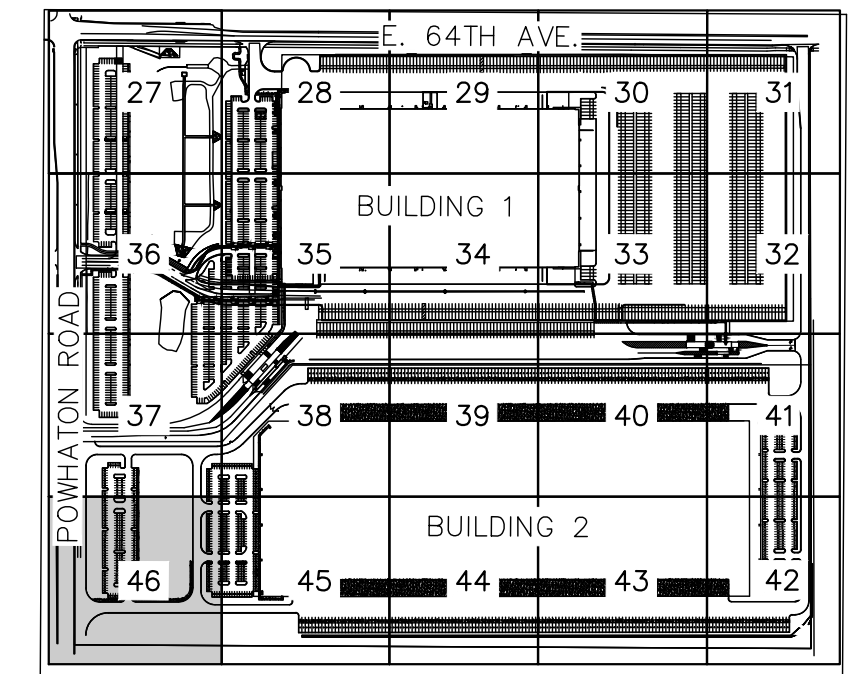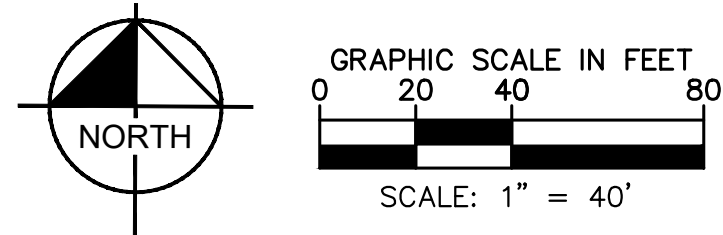









KEYMAP

NTS



LEGEND


- | | |
|---|------------------------|
|  | PROPERTY LINE |
|  | EASEMENT LINE |
|  | EXISTING CONTOUR |
|  | PROPOSED CONTOUR |
|  | CONCRETE CURB & GUTTER |
|  | ACCESSIBLE ROUTE |
|  | PAVEMENT SAWCUT LINE |
|  | SLOPE ARROW |

GRADING PLAN KEYNOTES

- 1 STORM SEWER
- 2 STORM INLET
- 3 STORM MANHOLE
- 4 ROOF DRAIN
- 5 FLARED END SECTION
- 6 FOREBAY



GRADING PLAN NOTES

1. GRADES ADJACENT TO THE BUILDING SHALL BE A MINIMUM OF 1% FOR THE FIRST 10 FEET FOR IMPERVIOUS AREA AND A MINIMUM OF 5% FOR PERVIOUS AREA PER COA CRITERIA. UNLESS OTHERWISE NOTED.
2. STORMWATER INFRASTRUCTURE OWNERSHIP SHALL BE DESIGNATED BY THE CONSTRUCTION DOCUMENTS.
3. MAXIMUM 2% SLOPE IN ANY DIRECTION AT HANDICAP PARKING SPACES.
4. THE MAXIMUM LONGITUDINAL SLOPE WITHIN A FIRE LANE EASEMENT SHALL NOT EXCEED 10%. THE TRANSVERSE SLOPE SHALL GENERALLY HAVE A 2% BUT NOT EXCEEDING 4%. THE RESULTANT SLOPE SHALL NOT EXCEED 10%.

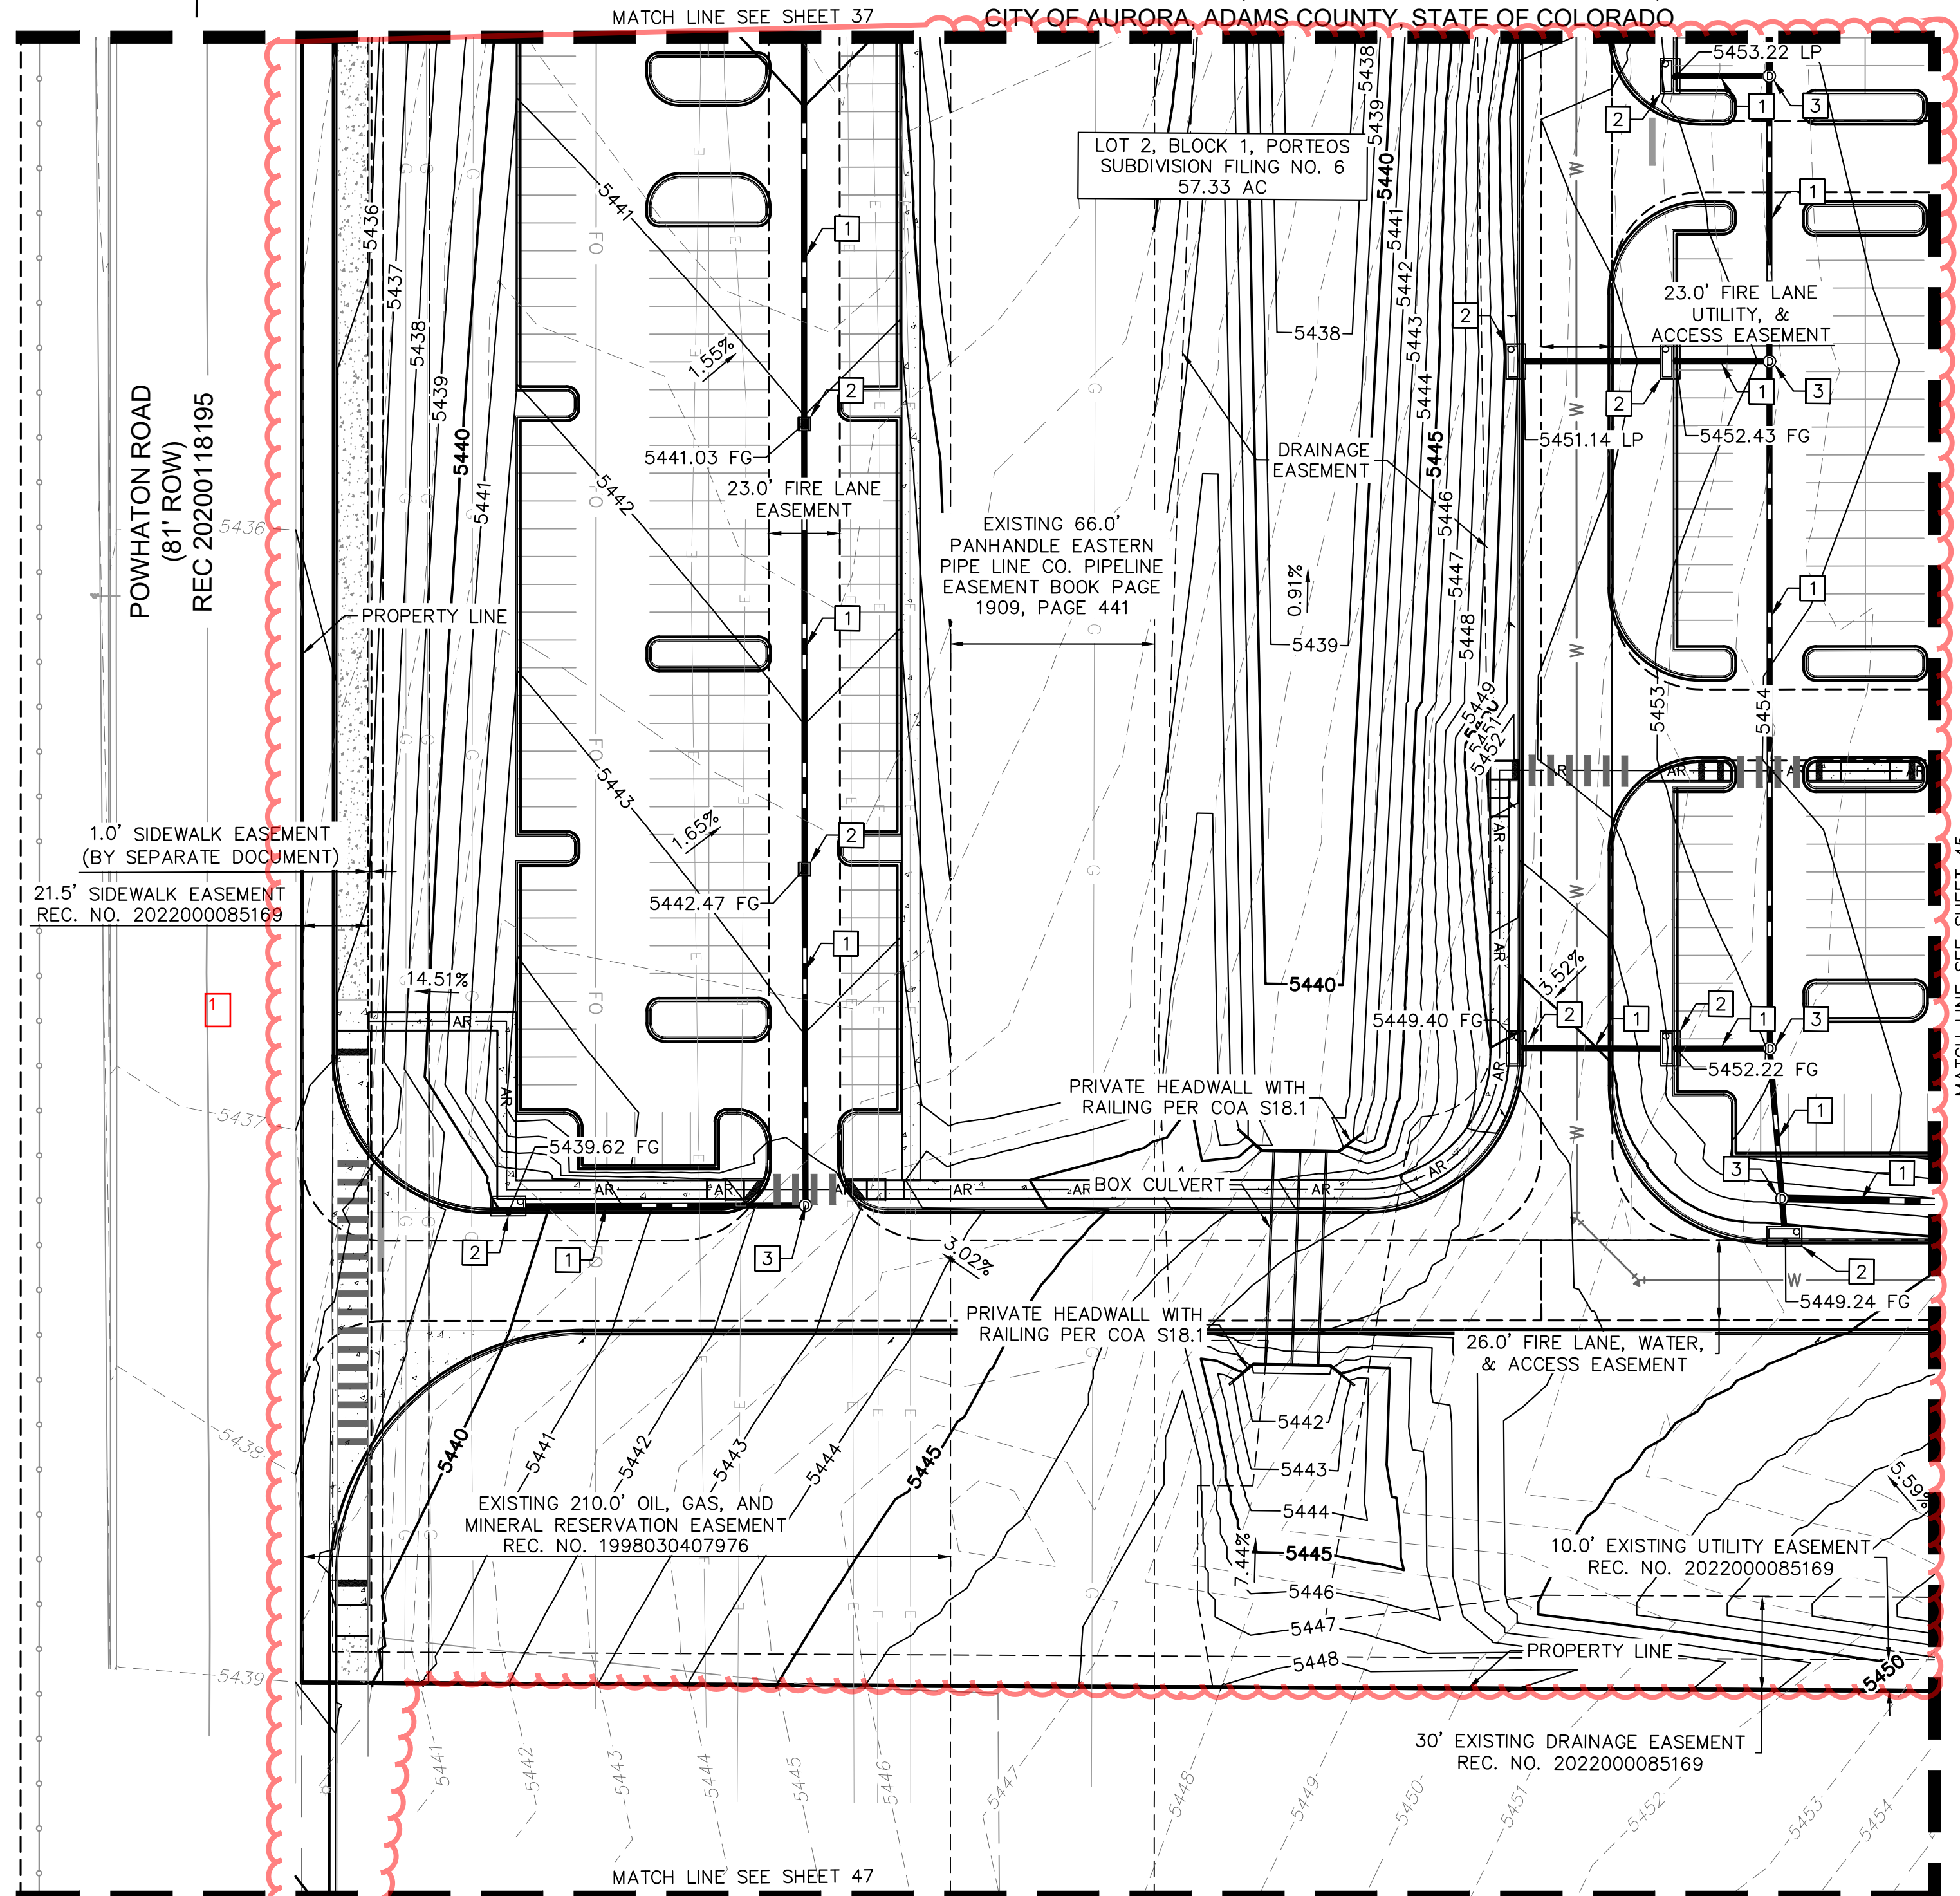


K:\DEN_Civil\196617002 DIA1\CADD\PlanSheets\CSP\196617002_GD DTL-DIA ll.dwg OKeefe, Sam 3/27/2024 3:05 PM

k:\DEN_Civil\196617002 DIA1\CADD\PlanSheets\CSP\196617002_GD DTL-DIA II.dwg OKeeffe, Sam 3/27/2024 3:05 PM

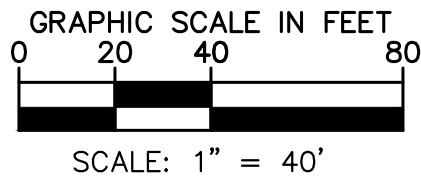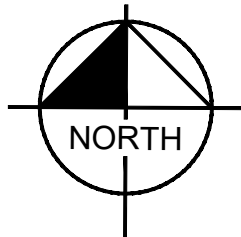


PORTEOS INDUSTRIAL AT PORTEOS
SITE PLAN AMENDMENT
LOCATED IN THE NW $\frac{1}{4}$ OF SECTION 9,
TOWNSHIP 3 SOUTH, RANGE 65 WEST OF THE 6TH P.M.,
CITY OF AURORA, ADAMS COUNTY, STATE OF COLORADO

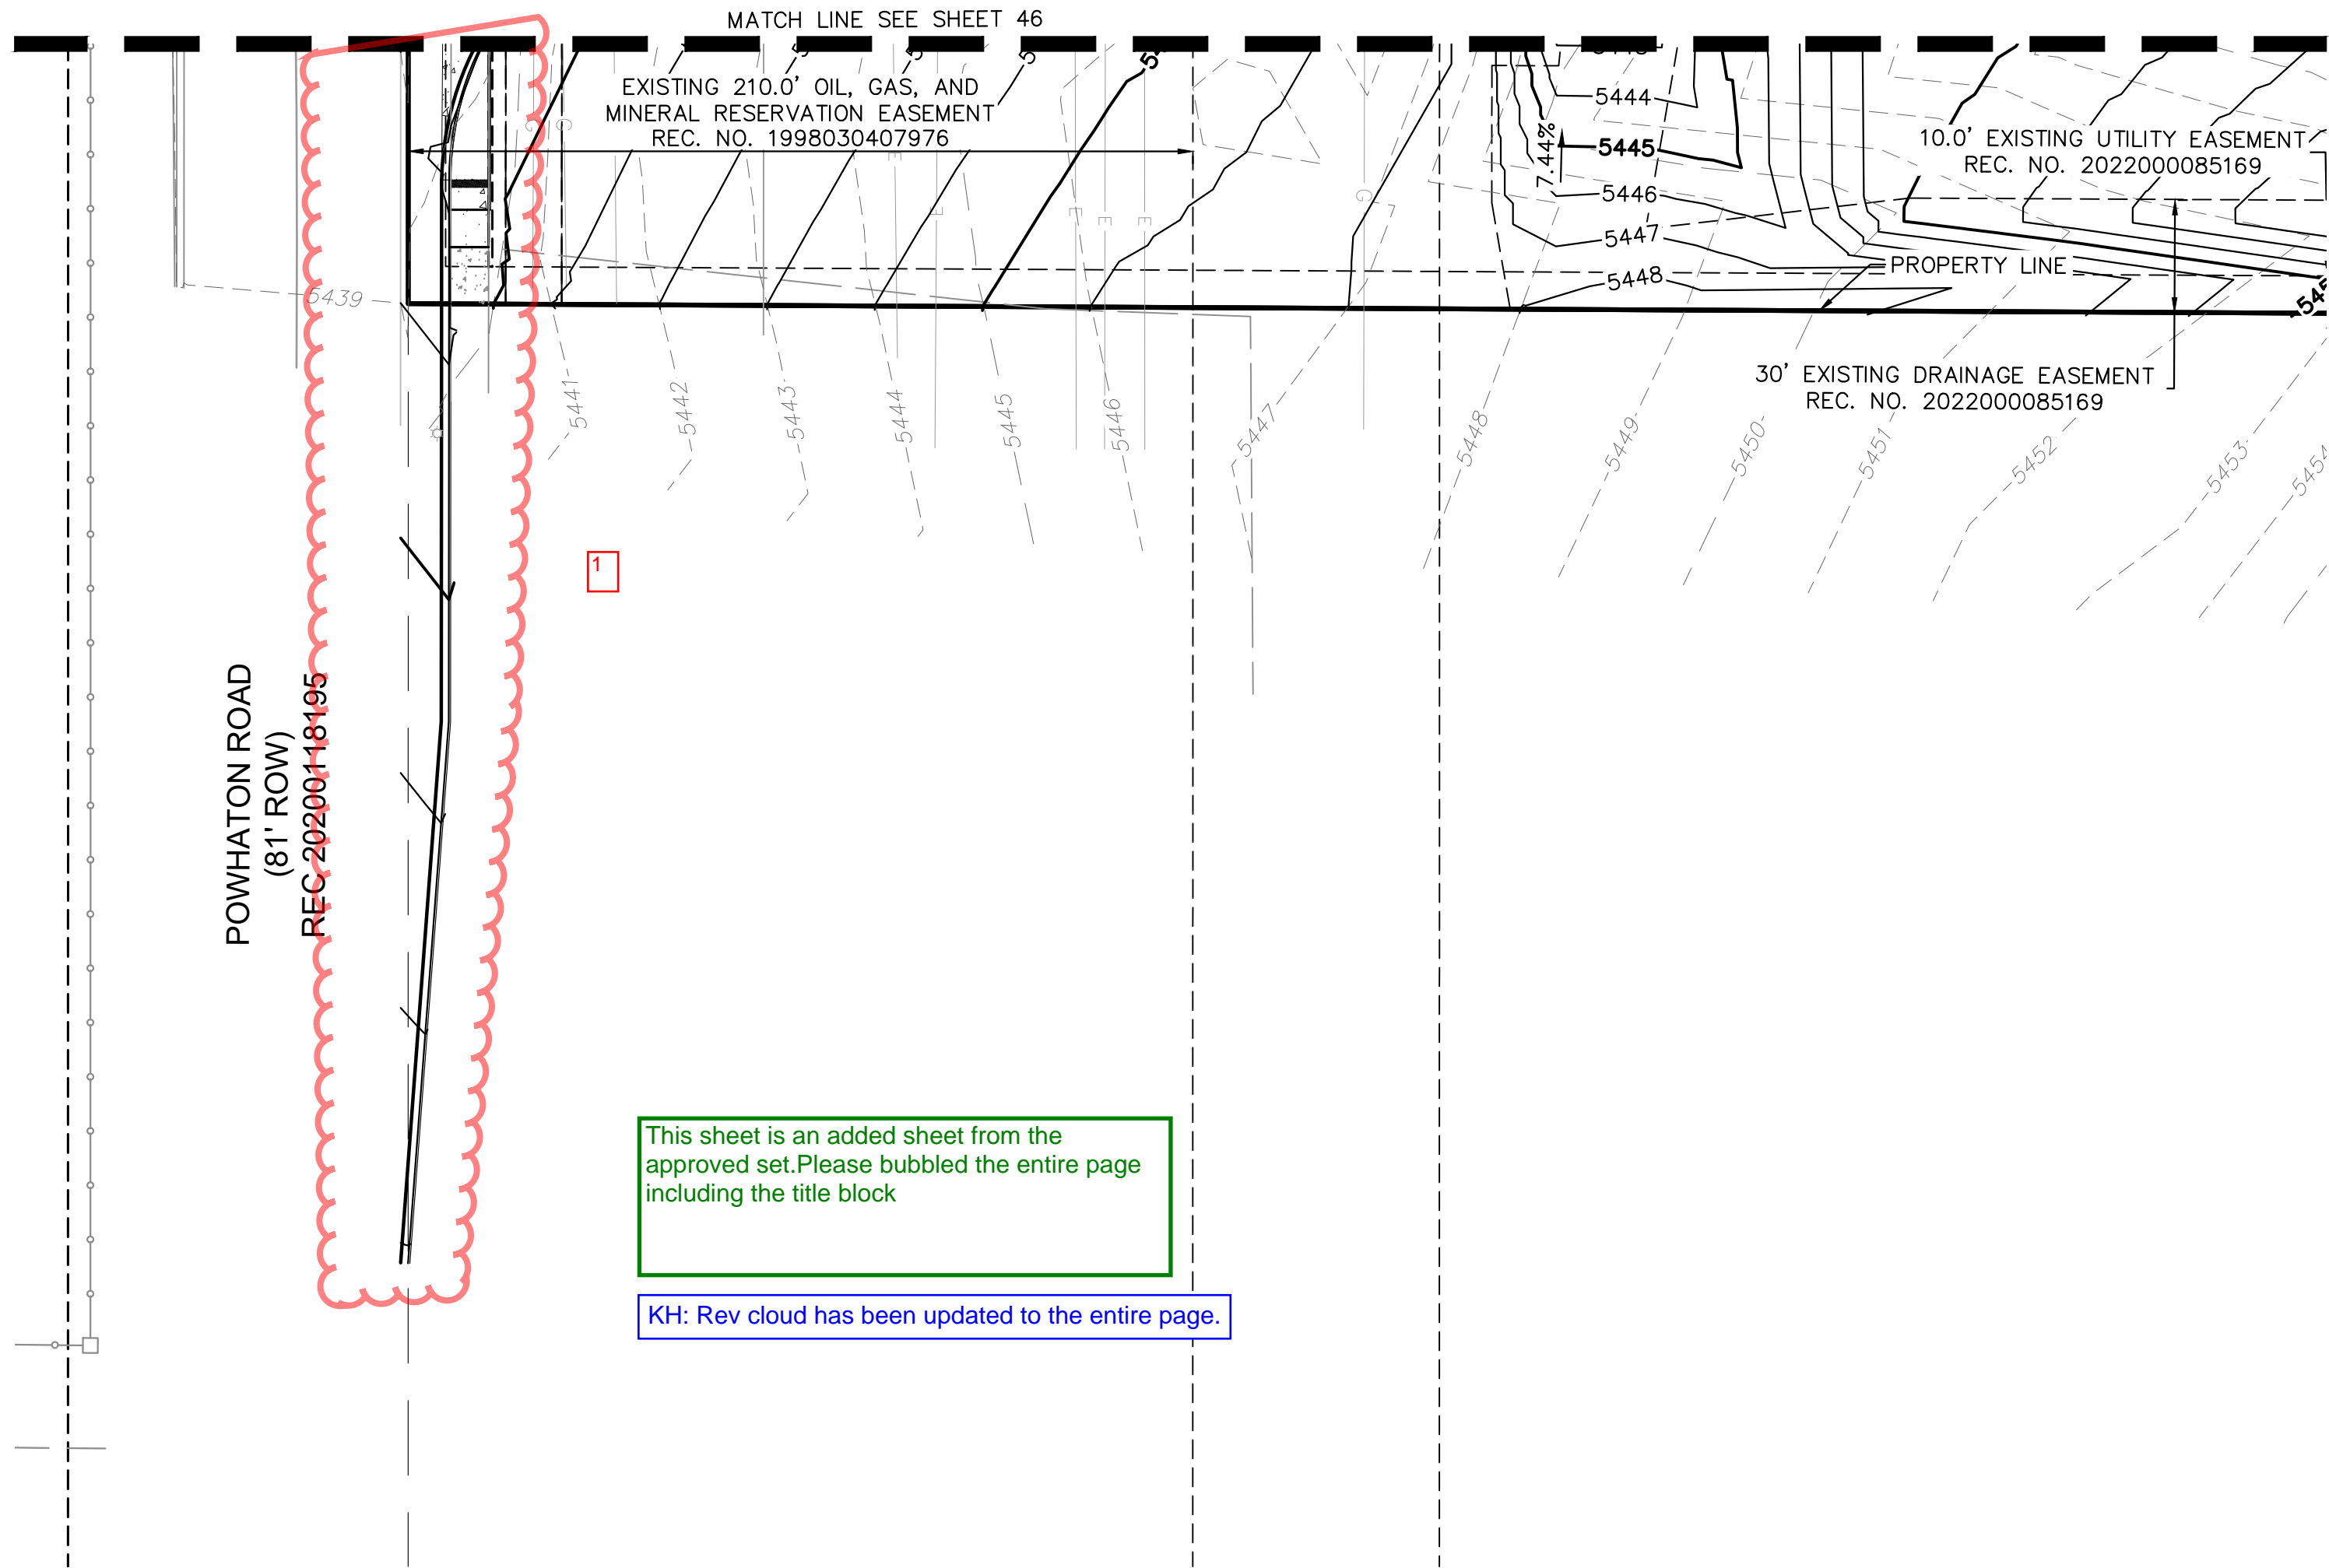

This sheet is an added sheet from the approved set. Please bubbled the entire page including the title block

KH: Rev cloud has been updated to the entire page.

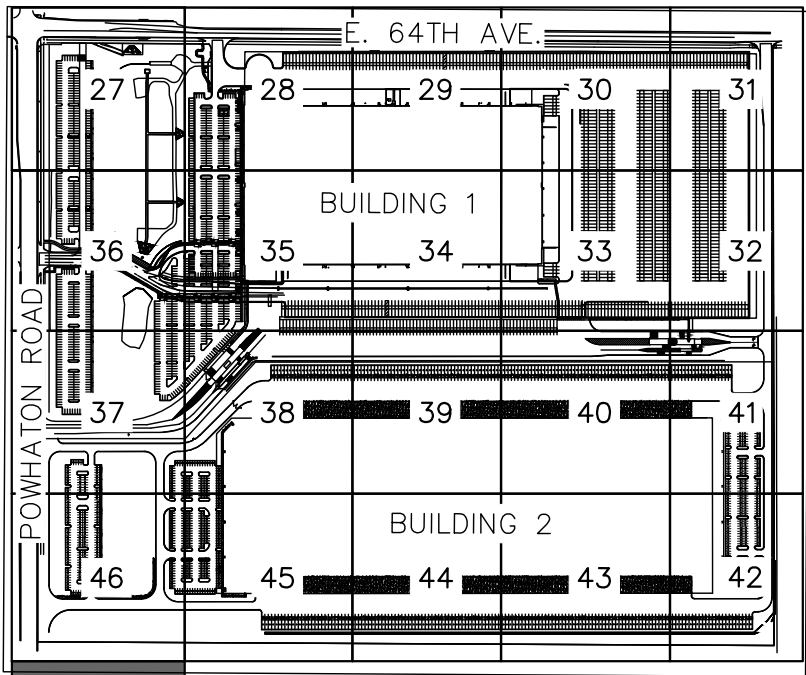

KEYMAP
NTS

LEGEND

- PROPERTY LINE
- EASEMENT LINE
- XXXX EXISTING CONTOUR
- XXXX PROPOSED CONTOUR
- CONCRETE CURB & GUTTER
- AR ACCESSIBLE ROUTE
- PAVEMENT SAWCUT LINE
- X.XX% SLOPE ARROW

GRADING PLAN KEYNOTES

- 1 STORM SEWER
- 2 STORM INLET
- 3 STORM MANHOLE
- 4 ROOF DRAIN
- 5 FLARED END SECTION
- 6 FOREBAY

GRADING PLAN NOTES

1. GRADES ADJACENT TO THE BUILDING SHALL BE A MINIMUM OF 1% FOR THE FIRST 10 FEET FOR IMPERVIOUS AREA AND A MINIMUM OF 5% FOR PERVIOUS AREA PER COA CRITERIA. UNLESS OTHERWISE NOTED.
2. STORMWATER INFRASTRUCTURE OWNERSHIP SHALL BE DESIGNATED BY THE CONSTRUCTION DOCUMENTS.
3. MAXIMUM 2% SLOPE IN ANY DIRECTION AT HANDICAP PARKING SPACES.
4. THE MAXIMUM LONGITUDINAL SLOPE WITHIN A FIRE LANE EASEMENT SHALL NOT EXCEED 10%. THE TRANSVERSE SLOPE SHALL GENERALLY HAVE A 2% BUT NOT EXCEEDING 4%. THE RESULTANT SLOPE SHALL NOT EXCEED 10%.

Kimley»Horn
KIMLEY-HORN AND ASSOCIATES, INC.
6205 S. W. 11TH AVE.
GREENWOOD VILLAGE, CO 80111

PORTEOS INDUSTRIAL AT PORTEOS
CITY OF AURORA, COUNTY OF ADAMS
SITE PLAN AMENDMENT
DETAILED GRADING PLAN

DATE: 03/22/2024
DESIGNED BY: CAO
DRAWN BY: AGM
CHECKED BY: BJC

FILE NO.
196617002_GD DTL-DIA II
PROJECT NO.
196617002

SHEET NO.

47

1 SITE
LAYER
ES
\$0
3/25/2
BJC

BY


REVISION

NO.


K:\DEN_Civil\196617002 DIA1\CADD\PlanSheets\CSP\196617002_UT_OV.dwg Cooney, Brad 3/27/2024 11:16 AM

PORTEOS INDUSTRIAL AT PORTEOS SITE PLAN AMENDMENT

LOCATED IN THE NW ¼ OF SECTION 9,
TOWNSHIP 3 SOUTH, RANGE 65 WEST OF THE 6TH P.M.,
CITY OF AURORA, ADAMS COUNTY, STATE OF COLORADO

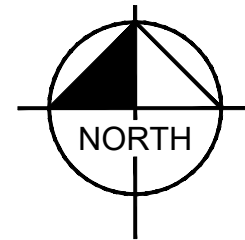

GRAPHIC SCALE IN FEET
0 100 200 400
SCALE: 1" = 200'

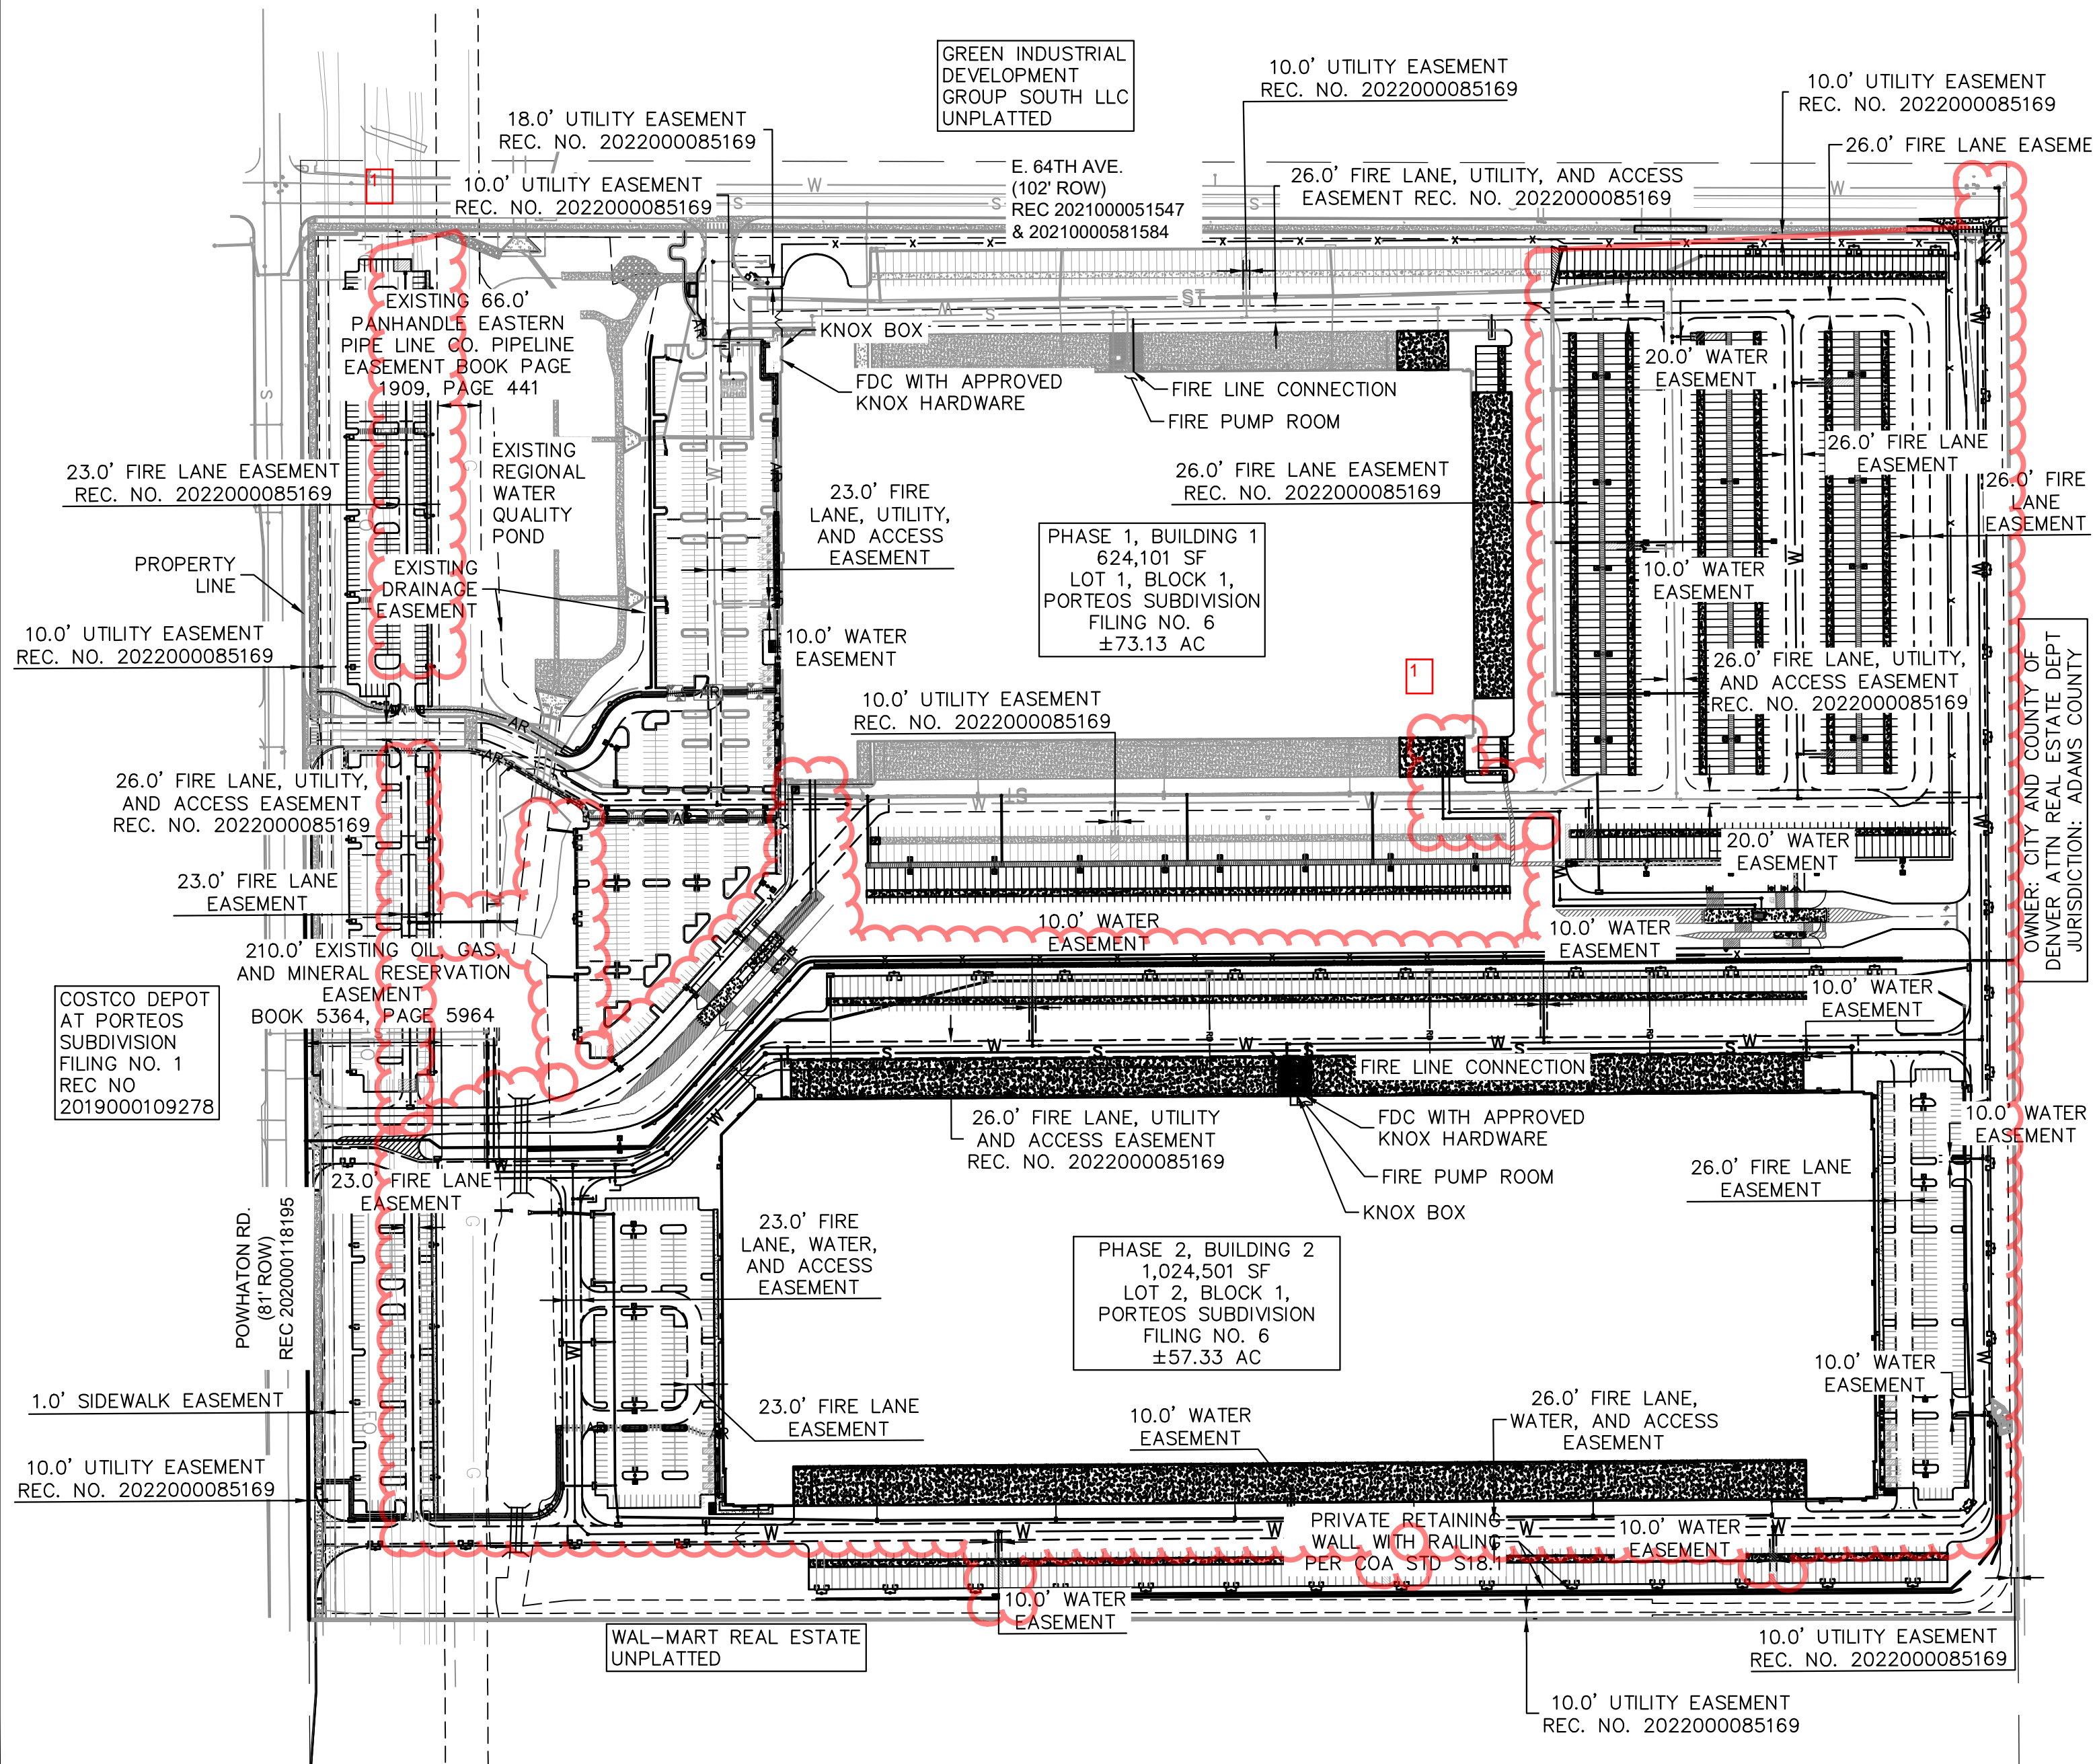

LEGEND

- PROPERTY LINE
- PROPOSED EASEMENT LINE
- EXISTING EASEMENT LINE
- EXISTING STORM SEWER
- PROPOSED STORM SEWER
- EXISTING WATER LINE
- PROPOSED WATER LINE
- PROPOSED WATER METER
- EXISTING FIRE HYDRANT
- PROPOSED FIRE HYDRANT ASSEMBLY PER COA STD DETAIL 206
- PROPOSED GATE VALVE
- PROPOSED TEE W/ THRUST BLOCK
- PROPOSED BEND W/ THRUST BLOCK
- PROPOSED FDC W/ KNOX HARDWARE
- EXISTING SANITARY SEWER
- PROPOSED SANITARY SEWER

NOTE:
1. STORMWATER INFRASTRUCTURE OWNERSHIP SHALL BE DESIGNATED BY THE CONSTRUCTION DOCUMENTS.

Kimley»Horn
KIMLEY-HORN AND ASSOCIATES, INC.
6205 S. W. 11th Ave.
Greenwood Village, CO 80111 (303) 228-2300


PORTEOS INDUSTRIAL AT PORTEOS
CITY OF AURORA, COUNTY OF ADAMS
SITE PLAN AMENDMENT
OVERALL UTILITY PLAN

DATE: 03/22/2024
DESIGNED BY: CAO
DRAWN BY: AGM
CHECKED BY: BJC


FILE NO.
196617002_UT_OV
PROJECT NO.
196617002

SHEET NO.

K:\DEN_Civil\196617002 DIA1\CADD\PlanSheets\CSP\196617002_UT DTL-DIA I.dwg Cooney, Brad 3/27/2024 11:26 AM

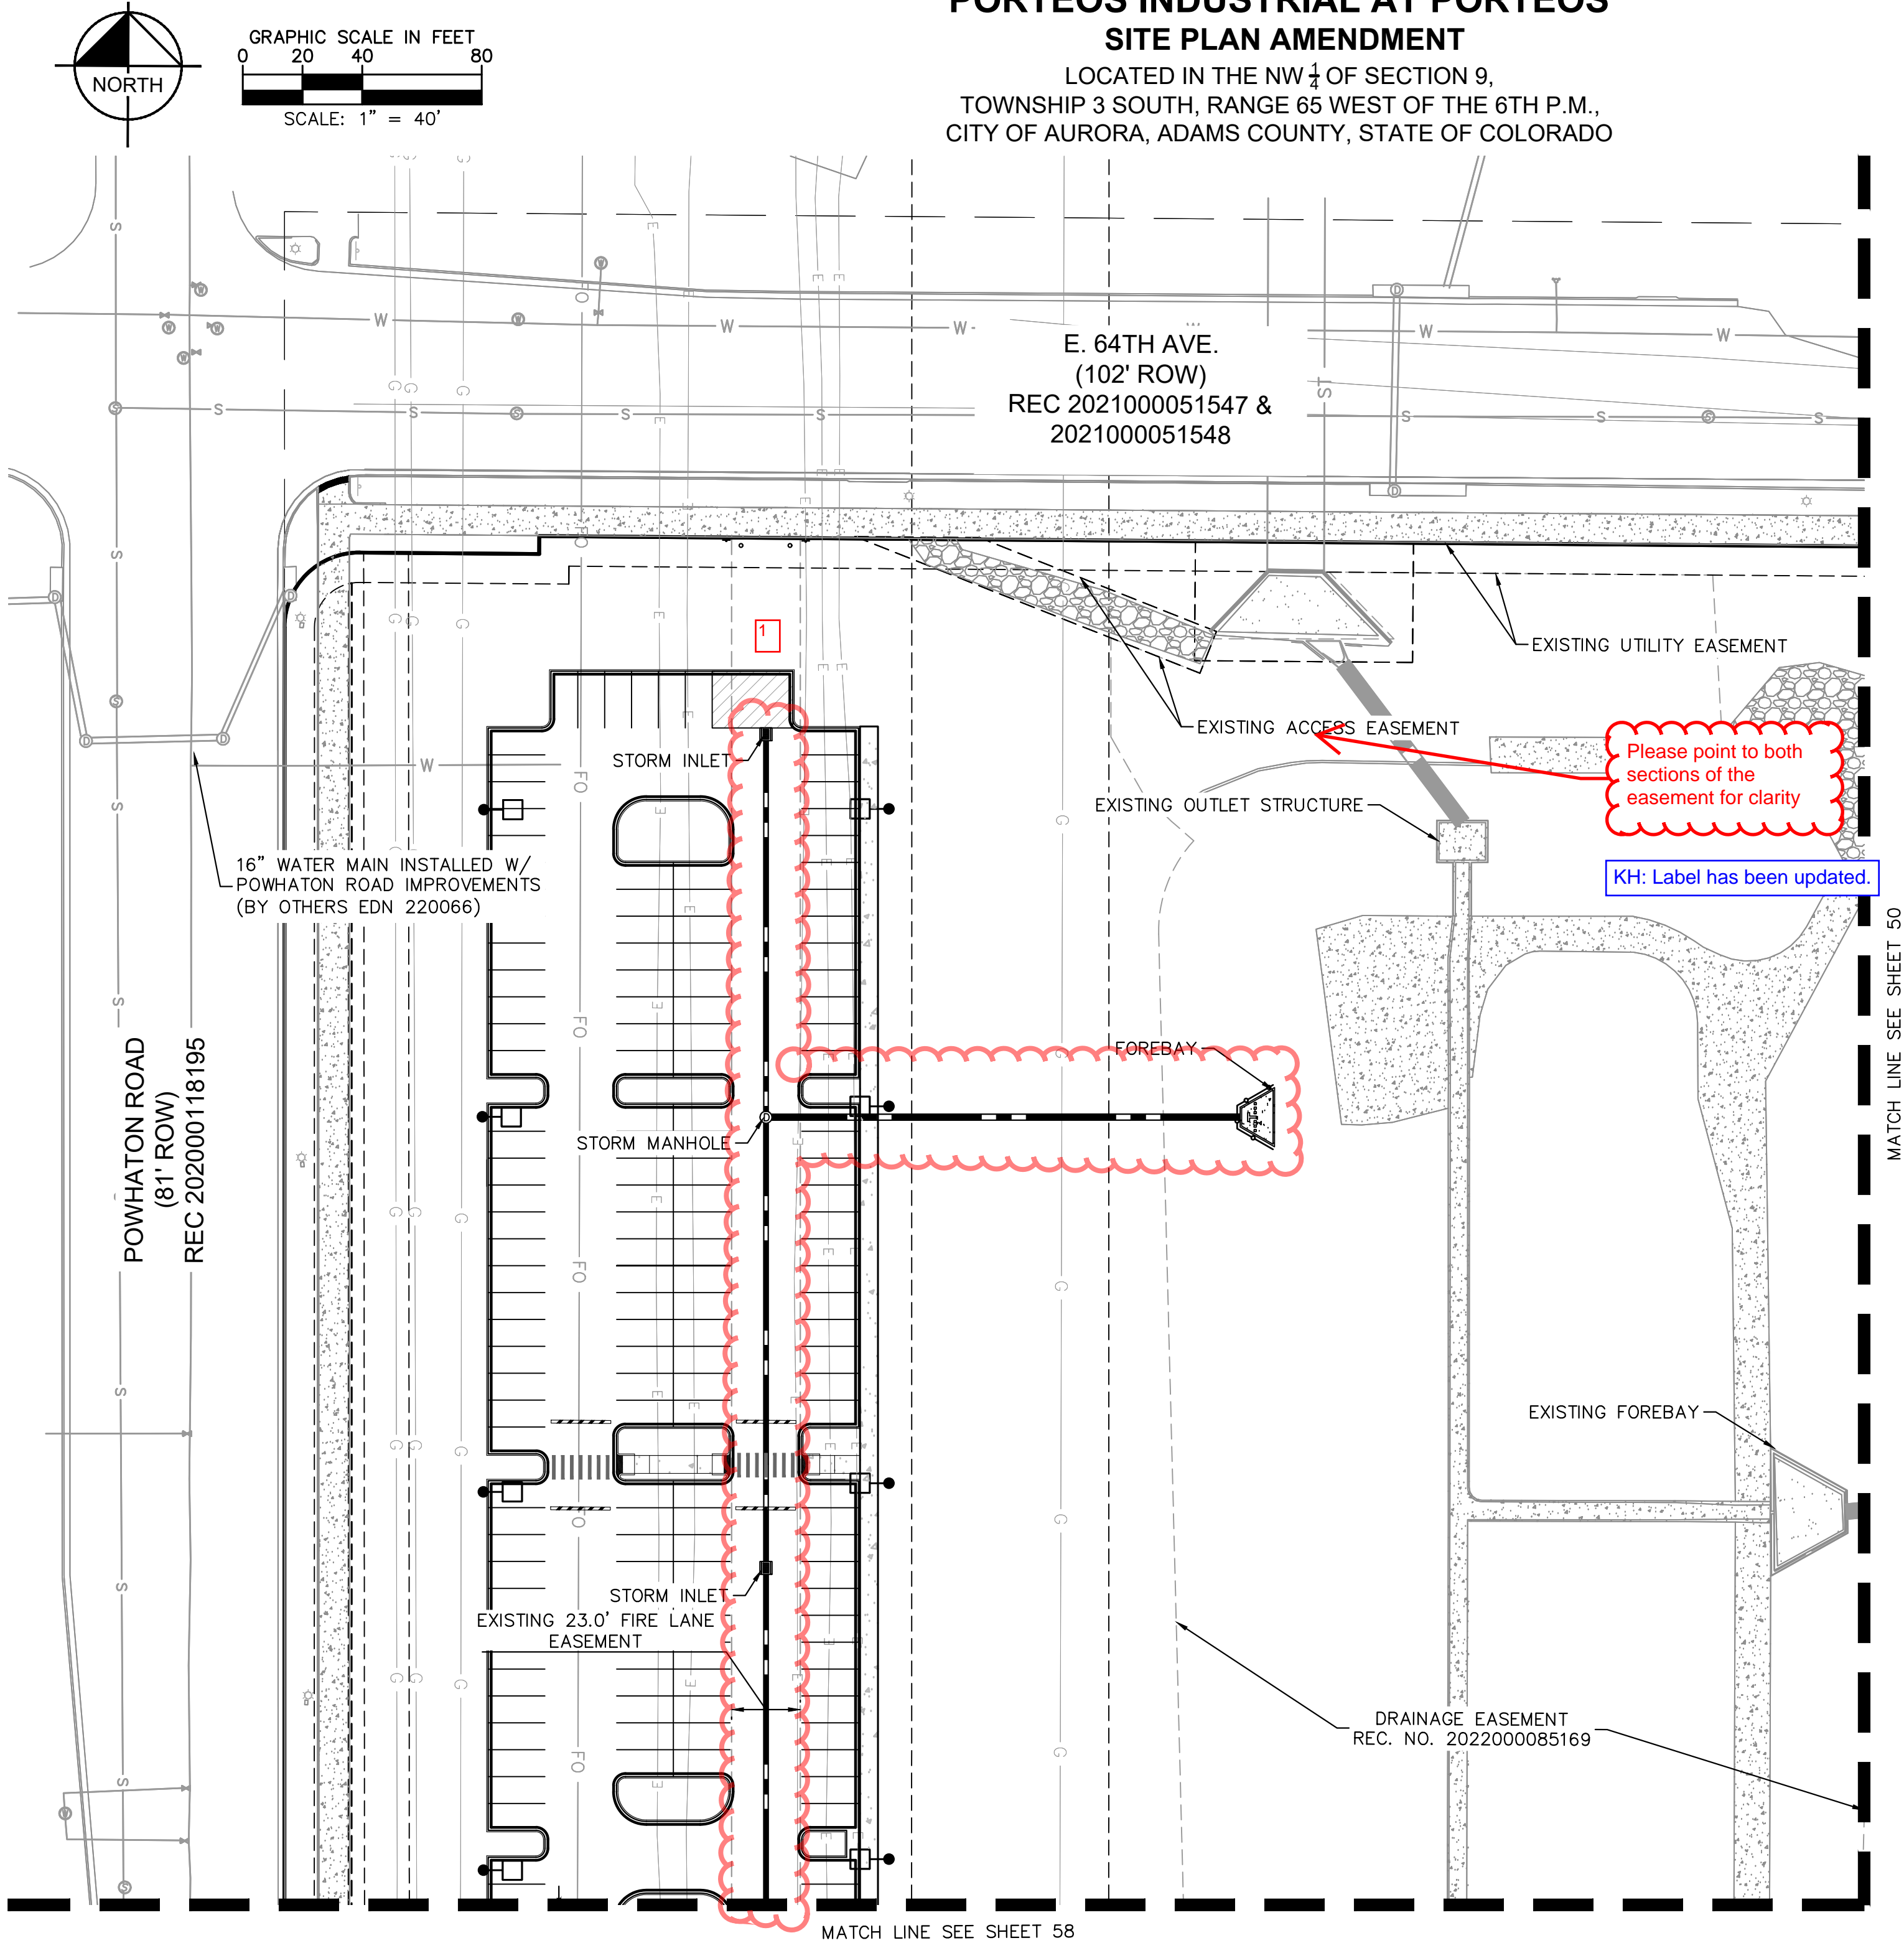

PORTEOS INDUSTRIAL AT PORTEOS
SITE PLAN AMENDMENT
LOCATED IN THE NW ¼ OF SECTION 9,
TOWNSHIP 3 SOUTH, RANGE 65 WEST OF THE 6TH P.M.,
CITY OF AURORA, ADAMS COUNTY, STATE OF COLORADO

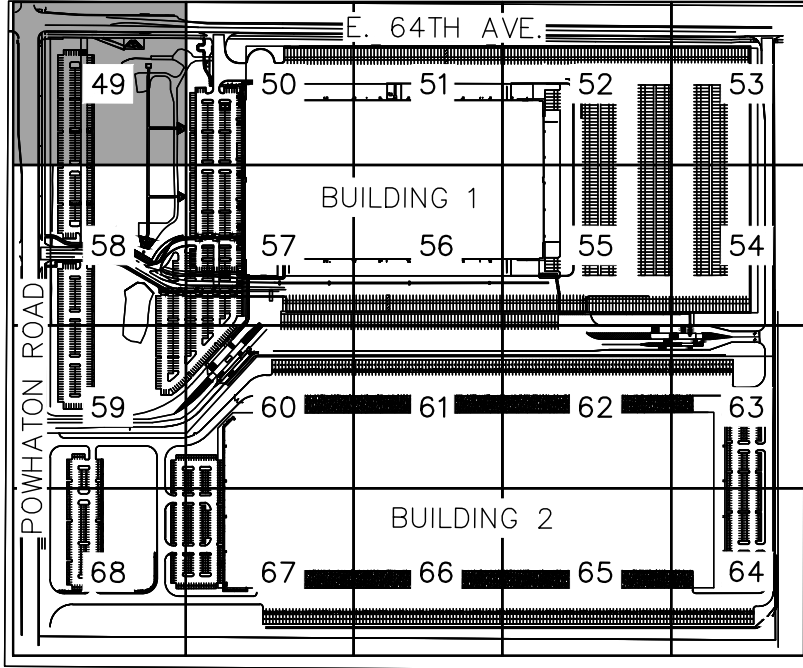

- LEGEND**
- PROPERTY LINE
 - PROPOSED EASEMENT LINE
 - EXISTING EASEMENT LINE
 - EXISTING STORM SEWER
 - PROPOSED STORM SEWER
 - EXISTING WATER LINE
 - PROPOSED WATER LINE
 - PROPOSED WATER METER
 - EXISTING FIRE HYDRANT
 - PROPOSED FIRE HYDRANT ASSEMBLY PER COA STD DETAIL 206
 - PROPOSED GATE VALVE
 - PROPOSED TEE W/ THRUST BLOCK
 - PROPOSED BEND W/ THRUST BLOCK
 - PROPOSED FDC W/ KNOX HARDWARE
 - EXISTING SANITARY SEWER
 - PROPOSED SANITARY SEWER

- UTILITY NOTES**
- PROPOSED SANITARY SEWER PIPE
 - PROPOSED SANITARY SEWER MANHOLE
 - PROPOSED SANITARY SEWER SERVICE LINE
 - PROPOSED WATER MAIN
 - PROPOSED WATER SERVICE LINE
 - PROPOSED FIRE SERVICE LINE
 - PROPOSED FIRE HYDRANT AND BOLLARD ASSEMBLY PER COA STD DETAIL 208
 - PROPOSED FDC W/ APPROVED KNOX HARDWARE
 - PROPOSED KNOX BOX
 - PROPOSED FIRE HYDRANT ASSEMBLY PER COA STD DETAIL 208

NOTE:
1. STORMWATER INFRASTRUCTURE OWNERSHIP SHALL BE DESIGNATED BY THE CONSTRUCTION DOCUMENTS.

Kimley»Horn
KIMLEY-HORN AND ASSOCIATES, INC.
6205 S. HARRISON
GREENWOOD VILLAGE, CO 80111 (303) 228-2300

PORTEOS INDUSTRIAL AT PORTEOS
CITY OF AURORA, COUNTY OF ADAMS
SITE PLAN AMENDMENT
DETAILED UTILITY PLAN


DATE: 03/22/2024
DESIGNED BY: CAO
DRAWN BY: AGM
CHECKED BY: BUC

FILE NO.
196617002_UT DTL-DIA I
PROJECT NO.
196617002

SHEET NO.

NO.	REVISION	BY	DATE	APPROVED

K:\DEN_Civil\196617002 DIA1\CADD\PlanSheets\CSP\196617002_UT DTL-DIA I.dwg Cooney, Brad 3/27/2024 11:27 AM

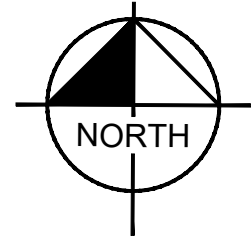

GRAPHIC SCALE IN FEET
0 20 40 80
SCALE: 1" = 40'

PORTEOS INDUSTRIAL AT PORTEOS SITE PLAN AMENDMENT

LOCATED IN THE NW $\frac{1}{4}$ OF SECTION 9,
TOWNSHIP 3 SOUTH, RANGE 65 WEST OF THE 6TH P.M.,
CITY OF AURORA, ADAMS COUNTY, STATE OF COLORADO

E. 64TH AVE.
(102' ROW)
REC 2021000051547 &
2021000051548

KEYMAP



LEGEND

- PROPERTY LINE
- PROPOSED EASEMENT LINE
- EXISTING EASEMENT LINE
- EXISTING STORM SEWER
- PROPOSED STORM SEWER
- EXISTING WATER LINE
- PROPOSED WATER LINE
- PROPOSED WATER METER
- EXISTING FIRE HYDRANT
- PROPOSED FIRE HYDRANT ASSEMBLY PER COA STD DETAIL 206
- PROPOSED GATE VALVE
- PROPOSED TEE W/ THRUST BLOCK
- PROPOSED BEND W/ THRUST BLOCK
- PROPOSED FDC W/ KNOX HARDWARE
- EXISTING SANITARY SEWER
- PROPOSED SANITARY SEWER

UTILITY NOTES

- PROPOSED SANITARY SEWER PIPE
- PROPOSED SANITARY SEWER MANHOLE
- PROPOSED SANITARY SEWER SERVICE LINE
- PROPOSED WATER MAIN
- PROPOSED WATER SERVICE LINE
- PROPOSED FIRE SERVICE LINE
- PROPOSED FIRE HYDRANT AND BOLLARD ASSEMBLY PER COA STD DETAIL 208
- PROPOSED FDC W/ APPROVED KNOX HARDWARE
- PROPOSED KNOX BOX
- PROPOSED FIRE HYDRANT ASSEMBLY PER COA STD DETAIL 208

NOTE:

1. STORMWATER INFRASTRUCTURE OWNERSHIP SHALL BE DESIGNATED BY THE CONSTRUCTION DOCUMENTS.

MATCH LINE SEE SHEET 51

MATCH LINE SEE SHEET 57

EXISTING 41.3' FIRE
LANE, UTILITY, &
ACCESS EASEMENT

EXISTING INLET

EXISTING WATER MAIN

23.0' FIRE LANE, UTILITY,
& ACCESS EASEMENT

STORM INLET

EXISTING WATER MAIN

18.0' UTILITY EASEMENT
REC. NO. 2022000085169

EXISTING IRRIGATION METER

18.0' UTILITY EASEMENT
REC. NO. 2022000085169

EXISTING DOMESTIC METER

26.0' FIRE LANE, UTILITY,
& ACCESS EASEMENT


10.0' UTILITY EASEMENT
REC. NO. 2022000085169

EXISTING DOMESTIC METER

Typical Comment: Please update naming to
specific type of utility. For example, "23' Fire
Lane, Water & Access Easement"

KH: Proposed easement labels have been updated
to call out utility type. Rec. No. has been added to
existing easements.

BUILDING 1
624,101 SF
LOT 1, BLOCK 1,
PORTEOS SUBDIVISION FILING
NO. 6
73.13 AC

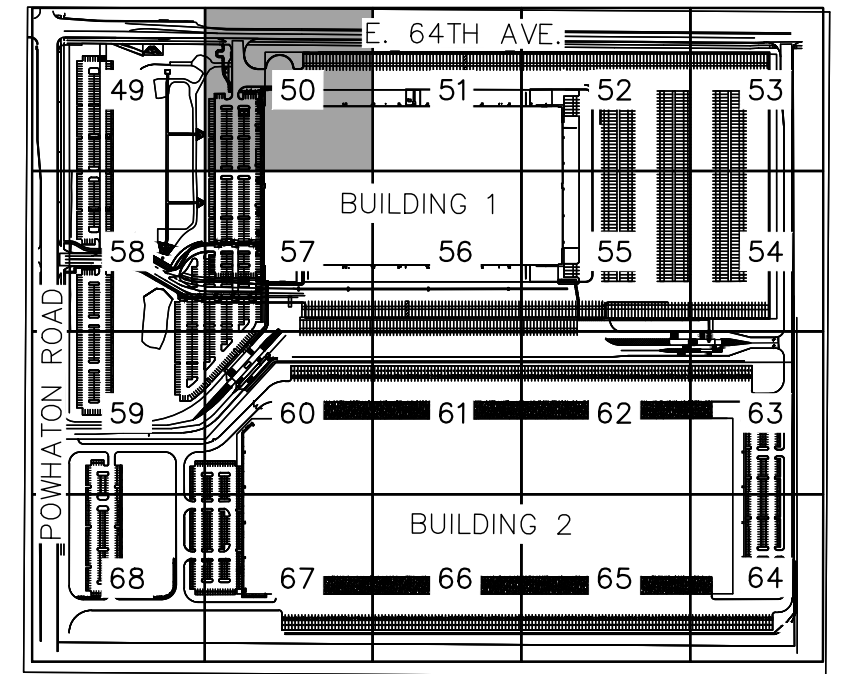

Kimley»Horn

KIMLEY-HORN AND ASSOCIATES, INC.
6205 S. W. 11TH AVE.
GREENWOOD VILLAGE, CO 80111 (303) 228-2300

PORTEOS INDUSTRIAL AT PORTEOS
CITY OF AURORA, COUNTY OF ADAMS
SITE PLAN AMENDMENT
DETAILED UTILITY PLAN


DATE: 03/22/2024
DESIGNED BY: CAO
DRAWN BY: AGM
CHECKED BY: BUC

FILE NO.
196617002_UT DTL-DIA I
PROJECT NO.
196617002



SHEET NO.

50

K:\DEN_Civil\196617002 DIA1\CADD\PlanSheets\CSP\196617002_UT DTL-DIA 1.dwg Cooney, Brad 3/27/2024 11:28 AM

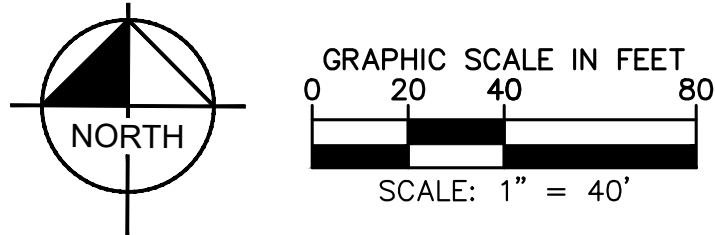

PORTEOS INDUSTRIAL AT PORTEOS
SITE PLAN AMENDMENT
LOCATED IN THE NW $\frac{1}{4}$ OF SECTION 9,
TOWNSHIP 3 SOUTH, RANGE 65 WEST OF THE 6TH P.M.,
CITY OF AURORA, ADAMS COUNTY, STATE OF COLORADO

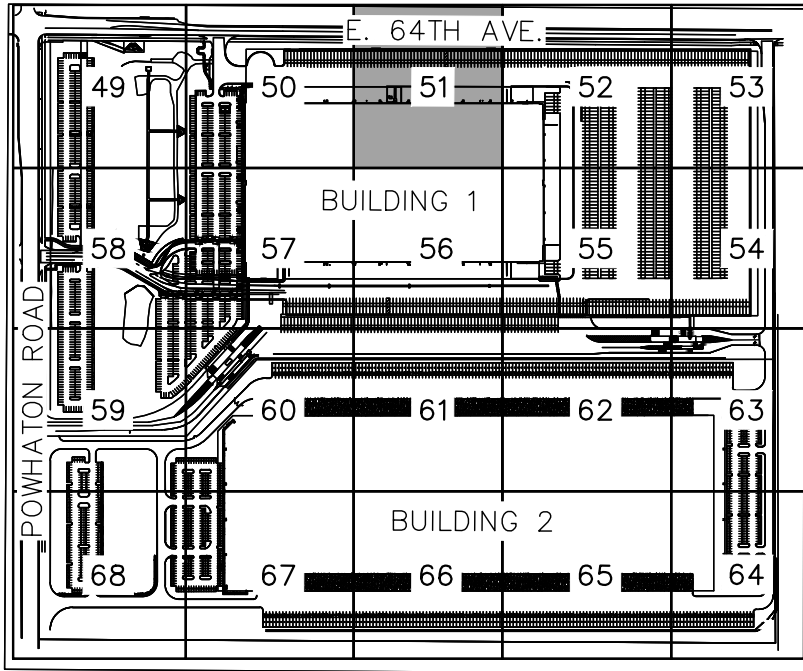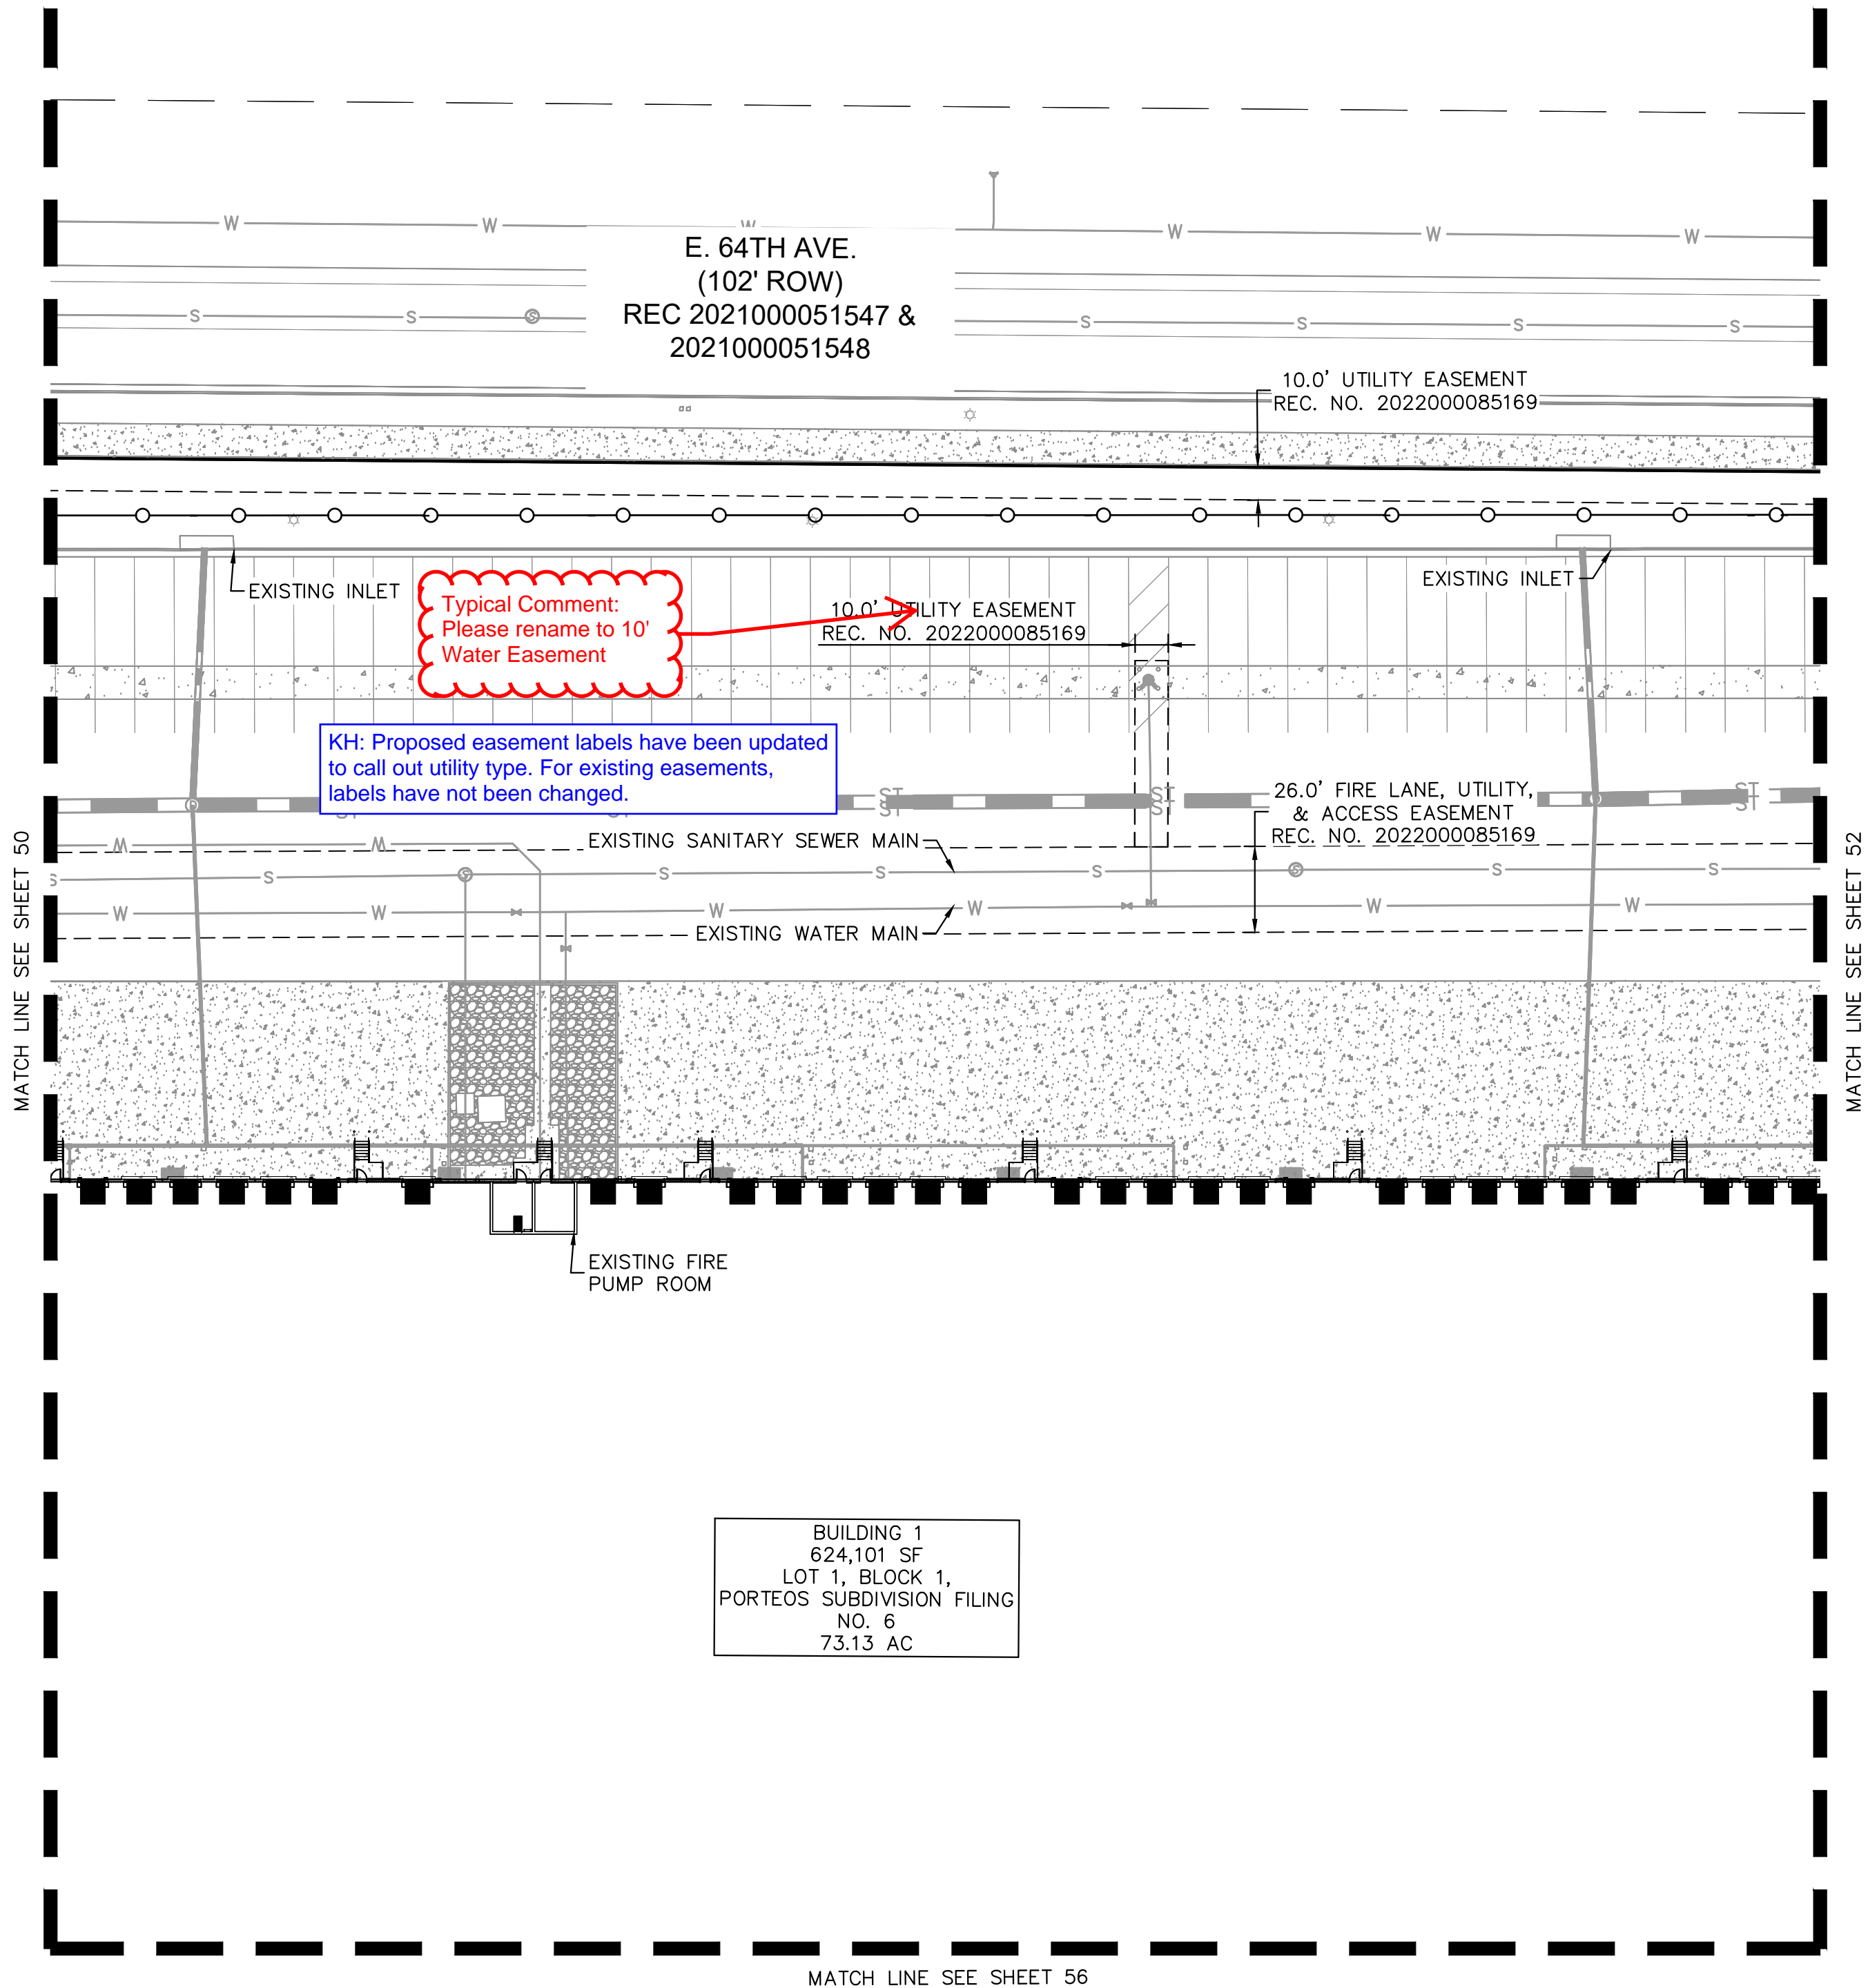


- KEYMAP**
- LEGEND**
- PROPERTY LINE
 - PROPOSED EASEMENT LINE
 - EXISTING EASEMENT LINE
 - EXISTING STORM SEWER
 - PROPOSED STORM SEWER
 - EXISTING WATER LINE
 - PROPOSED WATER LINE
 - PROPOSED WATER METER
 - EXISTING FIRE HYDRANT
 - PROPOSED FIRE HYDRANT ASSEMBLY PER COA STD DETAIL 206
 - PROPOSED GATE VALVE
 - PROPOSED TEE W/ THRUST BLOCK
 - PROPOSED BEND W/ THRUST BLOCK
 - PROPOSED FDC W/ KNOX HARDWARE
 - EXISTING SANITARY SEWER
 - PROPOSED SANITARY SEWER

- UTILITY NOTES**
- PROPOSED SANITARY SEWER PIPE
 - PROPOSED SANITARY SEWER MANHOLE
 - PROPOSED SANITARY SEWER SERVICE LINE
 - PROPOSED WATER MAIN
 - PROPOSED WATER SERVICE LINE
 - PROPOSED FIRE SERVICE LINE
 - PROPOSED FIRE HYDRANT AND BOLLARD ASSEMBLY PER COA STD DETAIL 208
 - PROPOSED FDC W/ APPROVED KNOX HARDWARE
 - PROPOSED KNOX BOX
 - PROPOSED FIRE HYDRANT ASSEMBLY PER COA STD DETAIL 208

NOTE:
1. STORMWATER INFRASTRUCTURE OWNERSHIP SHALL BE DESIGNATED BY THE CONSTRUCTION DOCUMENTS.


CHANG ES SO 3/25/24 BJS		APPR	DATE	BY	REVISION	NO.
Kimley»Horn KIMLEY-HORN AND ASSOCIATES, INC. 6205 S. HARRISON Greenwood Village, CO 80111 (303) 228-2300		PORTEOS INDUSTRIAL AT PORTEOS CITY OF AURORA, COUNTY OF ADAMS SITE PLAN AMENDMENT DETAILED UTILITY PLAN				
FILE NO. 196617002_UT DTL-DIA 1	PROJECT NO. 196617002	DATE 03/22/2024	DESIGNED BY: CAO	DRAWN BY: AGM	CHECKED BY: BJC	
SHEET NO. 51						

K:\DEN_Civil\196617002 DIA1\CADD\PlanSheets\CSP\196617002_UT DTL-DIA I.dwg Cooney, Brad 3/27/2024 11:29 AM

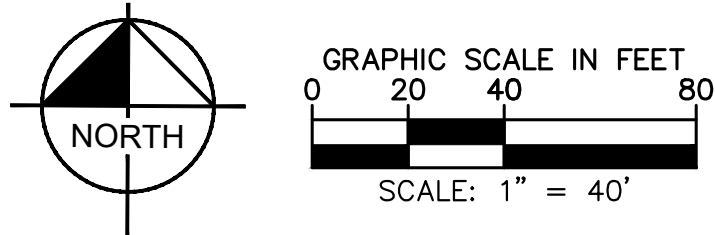

PORTEOS INDUSTRIAL AT PORTEOS SITE PLAN AMENDMENT

LOCATED IN THE NW $\frac{1}{4}$ OF SECTION 9,
TOWNSHIP 3 SOUTH, RANGE 65 WEST OF THE 6TH P.M.,
CITY OF AURORA, ADAMS COUNTY, STATE OF COLORADO

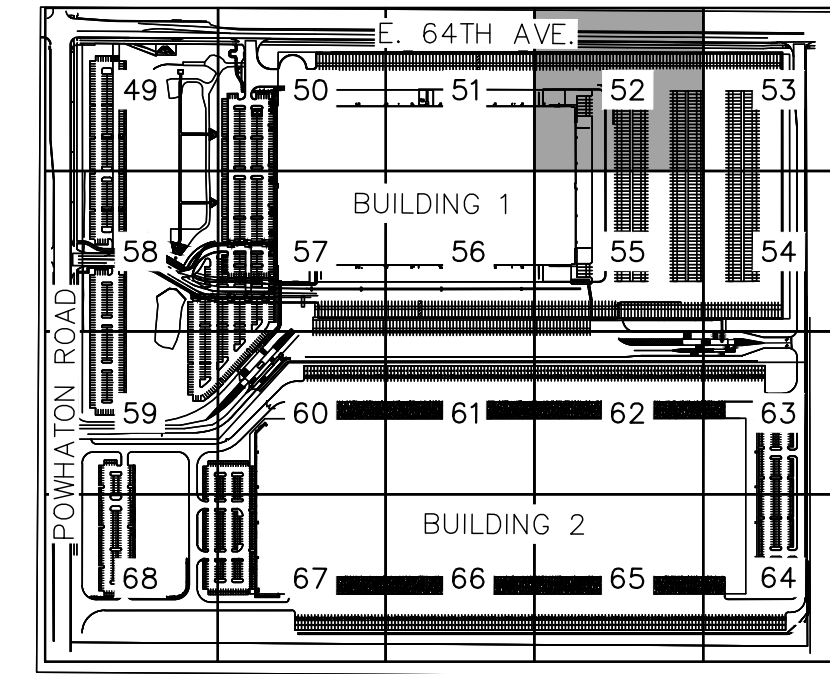


LEGEND

- PROPERTY LINE
- PROPOSED EASEMENT LINE
- EXISTING EASEMENT LINE
- EXISTING STORM SEWER
- PROPOSED STORM SEWER
- EXISTING WATER LINE
- PROPOSED WATER LINE
- PROPOSED WATER METER
- EXISTING FIRE HYDRANT
- PROPOSED FIRE HYDRANT ASSEMBLY PER COA STD DETAIL 206
- PROPOSED GATE VALVE
- PROPOSED TEE W/ THRUST BLOCK
- PROPOSED BEND W/ THRUST BLOCK
- PROPOSED FDC W/ KNOX HARDWARE
- EXISTING SANITARY SEWER
- PROPOSED SANITARY SEWER

UTILITY NOTES

- PROPOSED SANITARY SEWER PIPE
- PROPOSED SANITARY SEWER MANHOLE
- PROPOSED SANITARY SEWER SERVICE LINE
- PROPOSED WATER MAIN
- PROPOSED WATER SERVICE LINE
- PROPOSED FIRE SERVICE LINE
- PROPOSED FIRE HYDRANT AND BOLLARD ASSEMBLY PER COA STD DETAIL 208
- PROPOSED FDC W/ APPROVED KNOX HARDWARE
- PROPOSED KNOX BOX
- PROPOSED FIRE HYDRANT ASSEMBLY PER COA STD DETAIL 208

NOTE:
1. STORMWATER INFRASTRUCTURE OWNERSHIP SHALL BE DESIGNATED BY THE CONSTRUCTION DOCUMENTS.

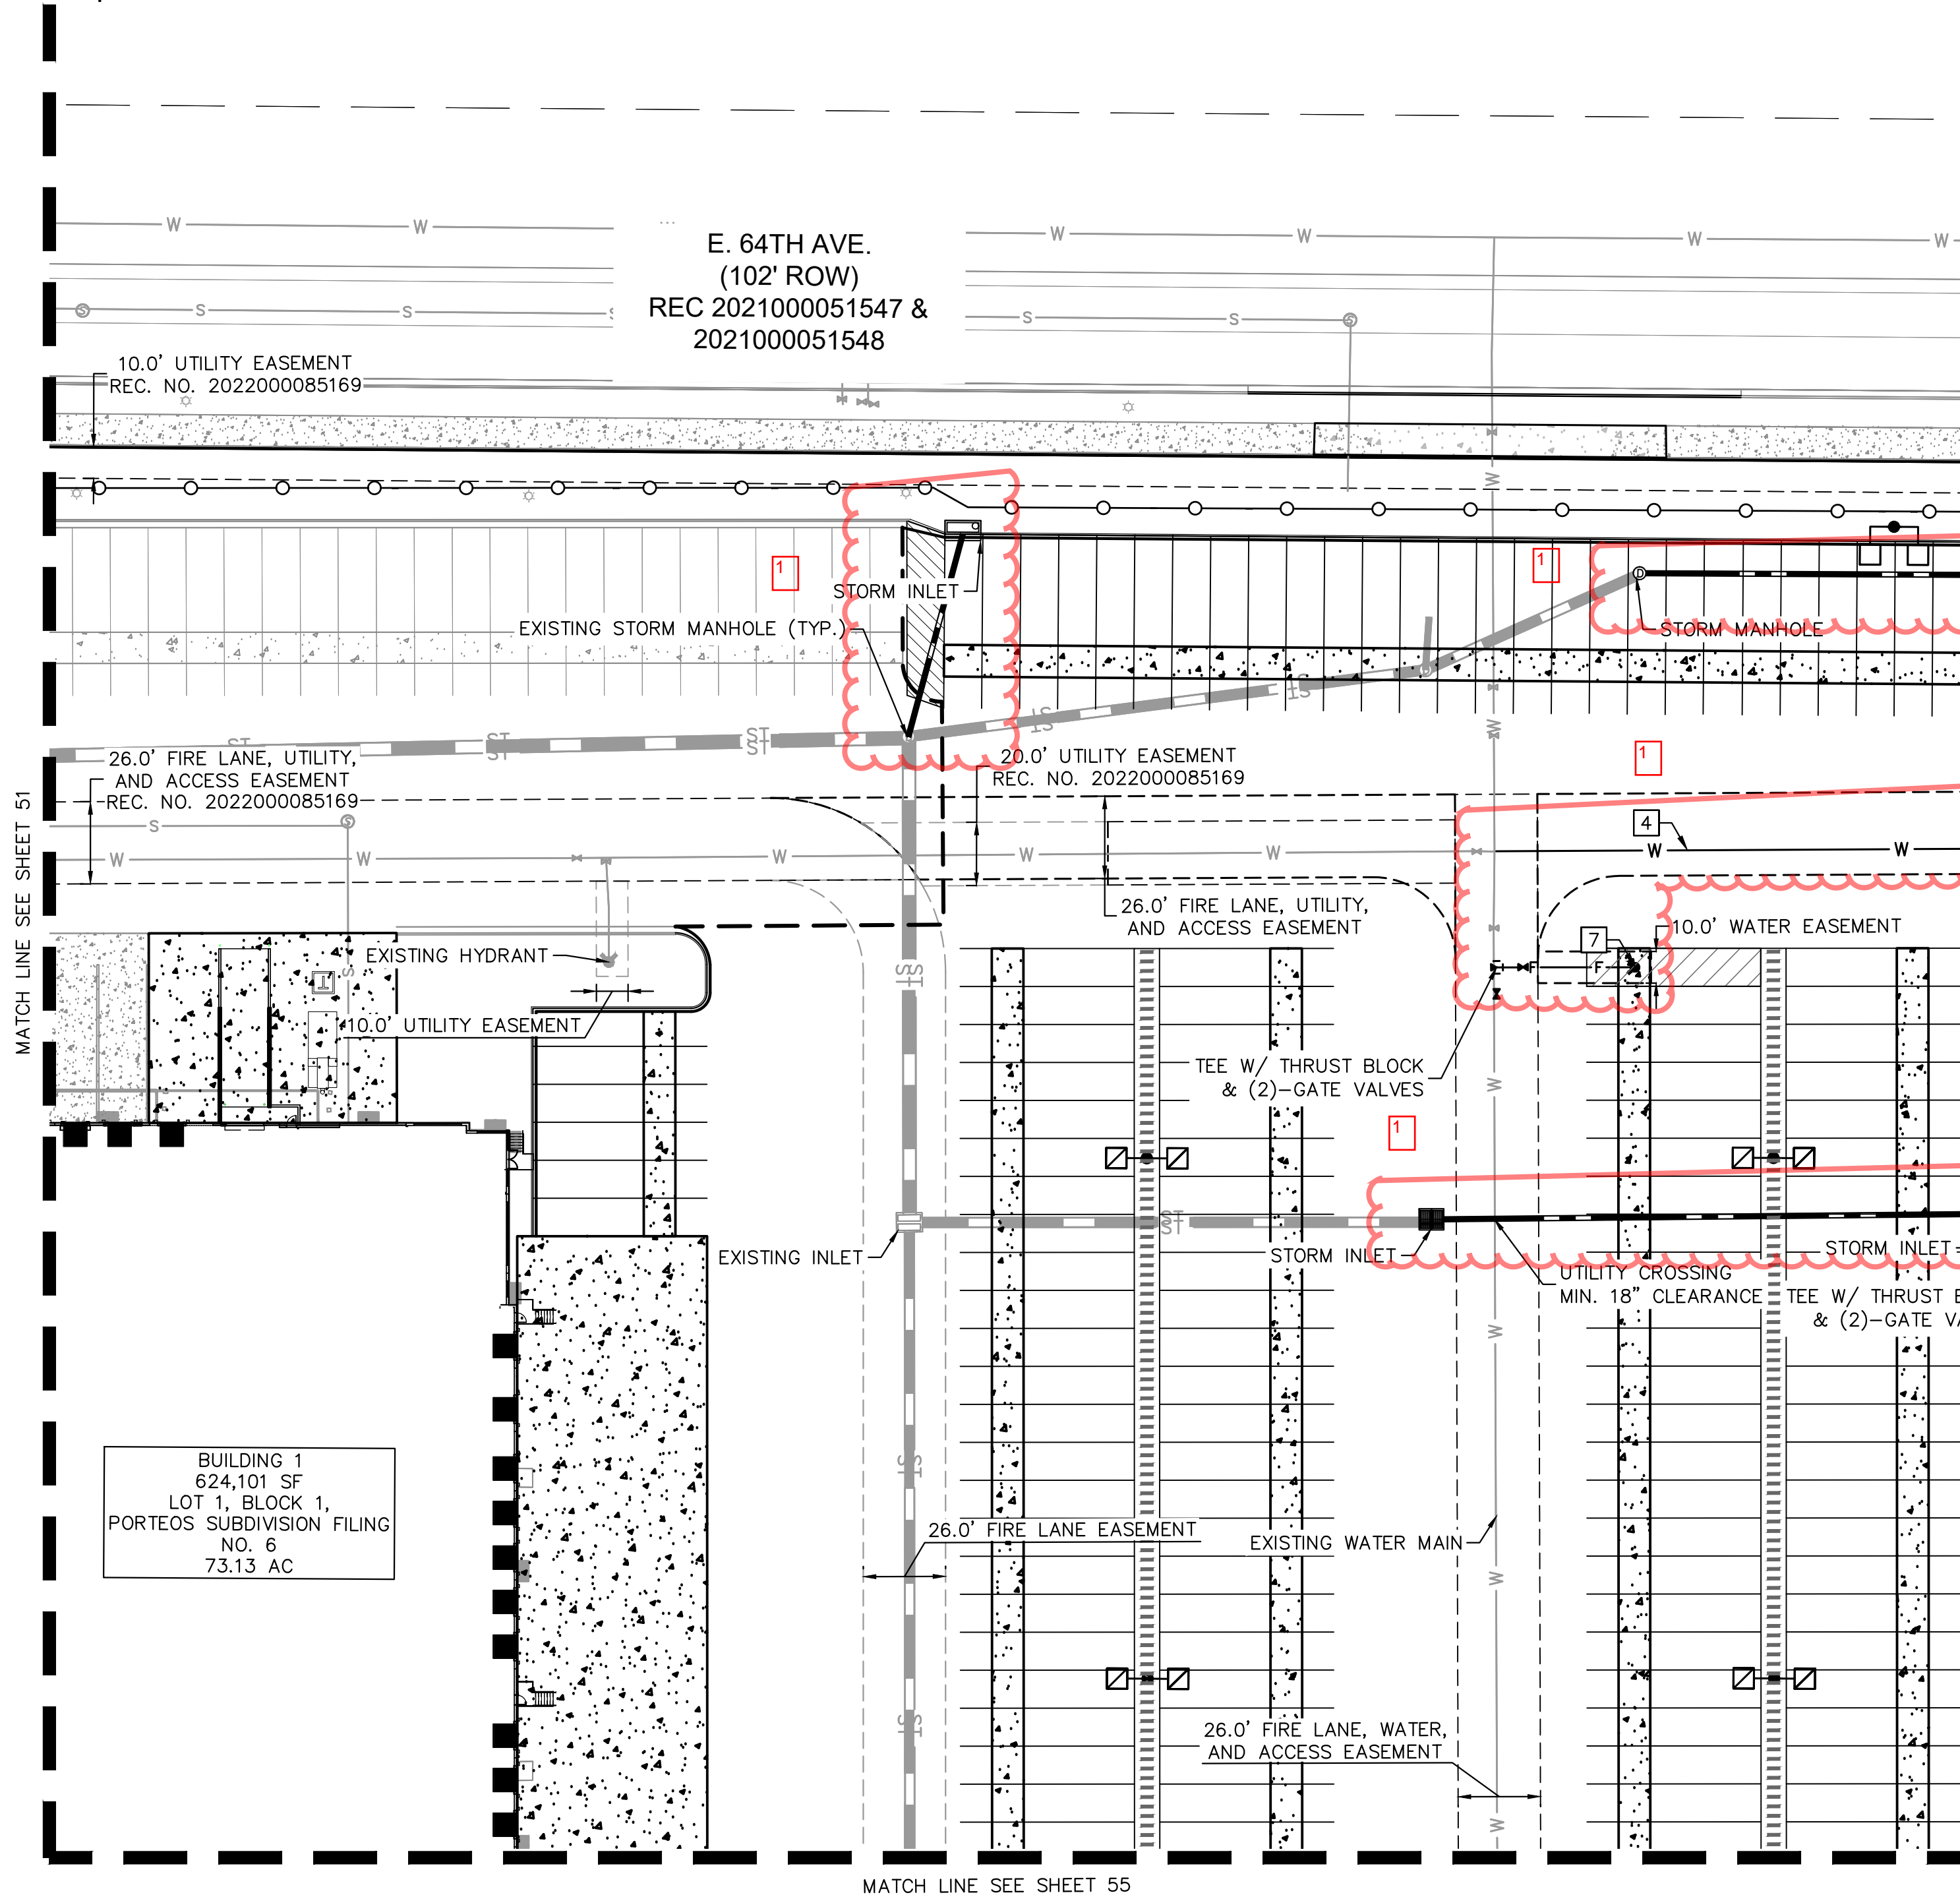

Kimley»Horn

KIMLEY-HORN AND ASSOCIATES, INC.
6205 S. W. 11TH AVE.
GREENWOOD VILLAGE, CO 80111 (303) 228-2300

PORTEOS INDUSTRIAL AT PORTEOS
CITY OF AURORA, COUNTY OF ADAMS
SITE PLAN AMENDMENT
DETAILED UTILITY PLAN


DATE: 03/22/2024
DESIGNED BY: CAO
DRAWN BY: AGM
CHECKED BY: BUC

FILE NO.
196617002_UT DTL-DIA I
PROJECT NO.
196617002

SHEET NO.




52

K:\DEN_Civil\196617002 DIA1\CADD\PlanSheets\CSP\196617002_UT DTL-DIA I.dwg Cooney, Brad 3/27/2024 11:31 AM

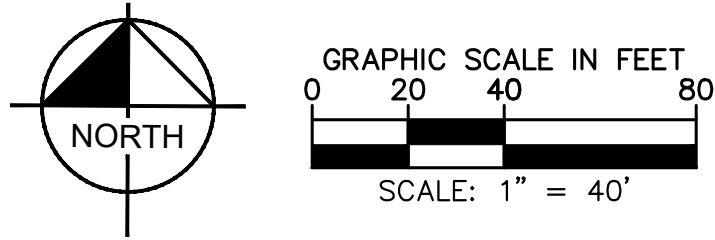

PORTEOS INDUSTRIAL AT PORTEOS SITE PLAN AMENDMENT

LOCATED IN THE NW $\frac{1}{4}$ OF SECTION 9,
TOWNSHIP 3 SOUTH, RANGE 65 WEST OF THE 6TH P.M.,
CITY OF AURORA, ADAMS COUNTY, STATE OF COLORADO

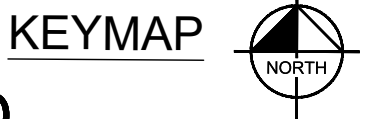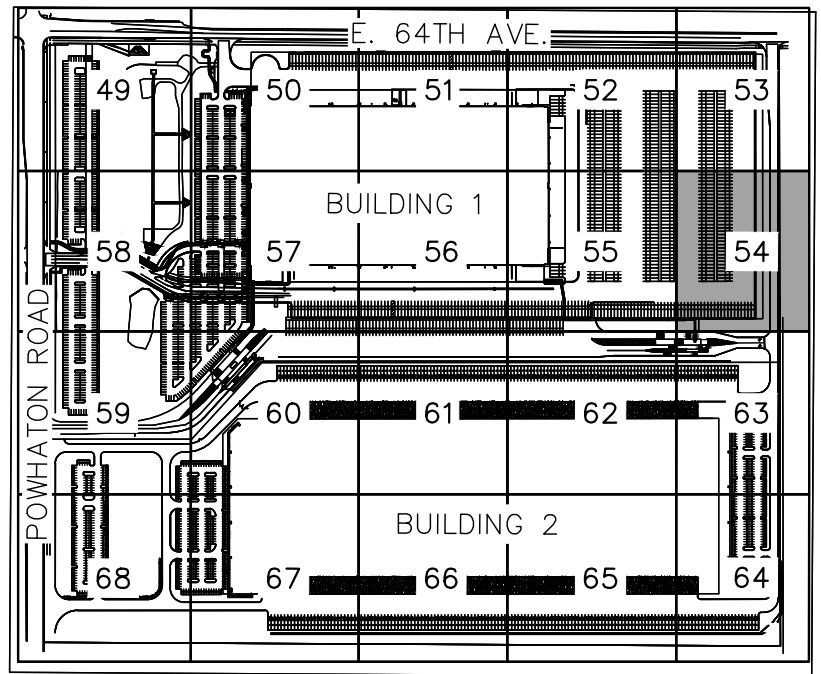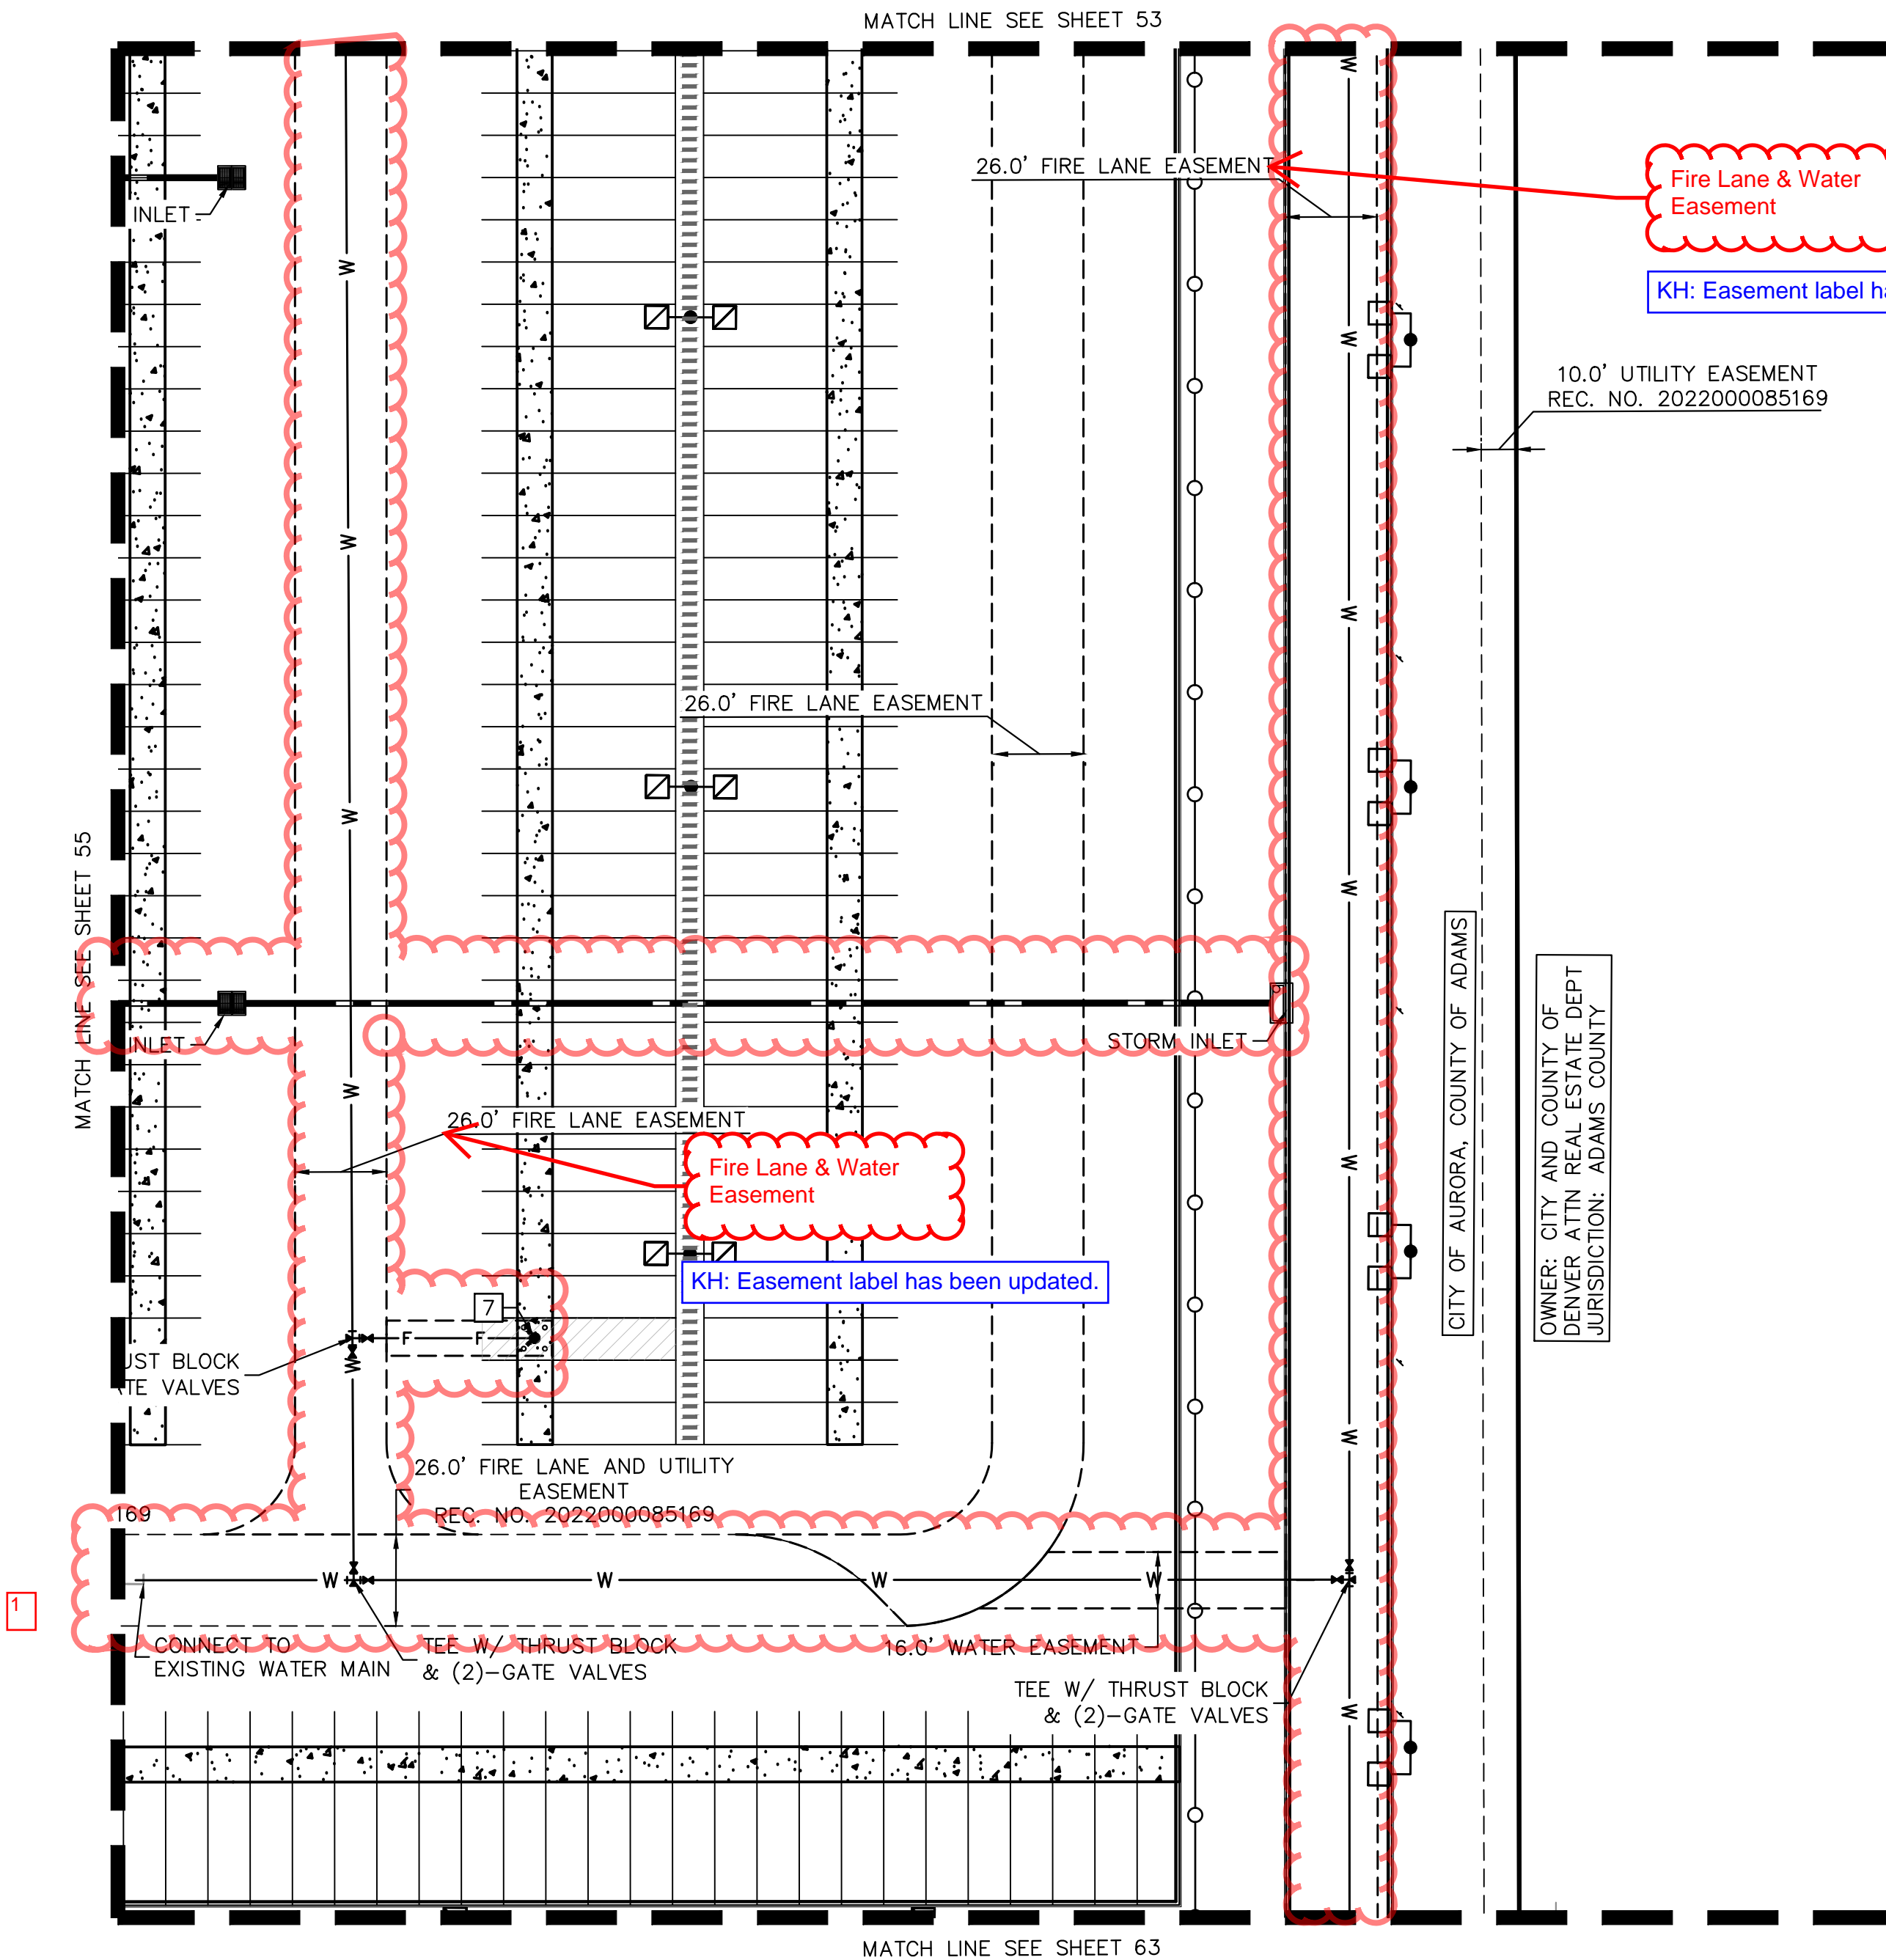

LEGEND

- PROPERTY LINE
- PROPOSED EASEMENT LINE
- EXISTING EASEMENT LINE
- EXISTING STORM SEWER
- PROPOSED STORM SEWER
- EXISTING WATER LINE
- PROPOSED WATER LINE
- PROPOSED WATER METER
- EXISTING FIRE HYDRANT
- PROPOSED FIRE HYDRANT ASSEMBLY PER COA STD DETAIL 206
- PROPOSED GATE VALVE
- PROPOSED TEE W/ THRUST BLOCK
- PROPOSED BEND W/ THRUST BLOCK
- PROPOSED FDC W/ KNOX HARDWARE
- EXISTING SANITARY SEWER
- PROPOSED SANITARY SEWER

UTILITY NOTES

- PROPOSED SANITARY SEWER PIPE
- PROPOSED SANITARY SEWER MANHOLE
- PROPOSED SANITARY SEWER SERVICE LINE
- PROPOSED WATER MAIN
- PROPOSED WATER SERVICE LINE
- PROPOSED FIRE SERVICE LINE
- PROPOSED FIRE HYDRANT AND BOLLARD ASSEMBLY PER COA STD DETAIL 208
- PROPOSED FDC W/ APPROVED KNOX HARDWARE
- PROPOSED KNOX BOX
- PROPOSED FIRE HYDRANT ASSEMBLY PER COA STD DETAIL 208

NOTE:
1. STORMWATER INFRASTRUCTURE OWNERSHIP SHALL BE DESIGNATED BY THE CONSTRUCTION DOCUMENTS.

Kimley»Horn
KIMLEY-HORN AND ASSOCIATES, INC.
6205 S. HANCOCK AVE.
GREENWOOD VILLAGE, CO 80111 (303) 228-2300

PORTEOS INDUSTRIAL AT PORTEOS
CITY OF AURORA, COUNTY OF ADAMS
SITE PLAN AMENDMENT
DETAILED UTILITY PLAN

DATE: 03/22/2024
DESIGNED BY: CAO
DRAWN BY: AGM
CHECKED BY: BJC


FILE NO.
196617002_UT DTL-DIA I
PROJECT NO.
196617002

SHEET NO.
54

NO.	REVISION	BY	DATE	APPR


CHANG
ES
SO
3/25/24
BJS

K:\DEN_Civil\196617002 DIA\1\CADD\PlanSheets\CSP\196617002_UT DTL-DIA I.dwg Cooney, Brad 3/27/2024 11:32 AM

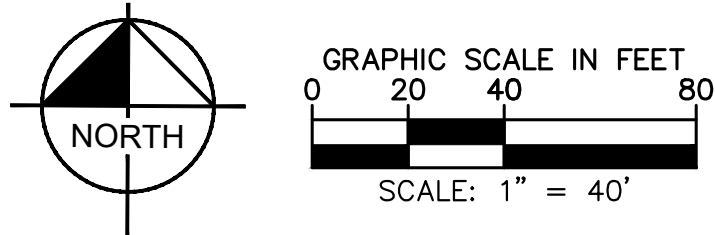

PORTEOS INDUSTRIAL AT PORTEOS SITE PLAN AMENDMENT

LOCATED IN THE NW $\frac{1}{4}$ OF SECTION 9,
TOWNSHIP 3 SOUTH, RANGE 65 WEST OF THE 6TH P.M.,
CITY OF AURORA, ADAMS COUNTY, STATE OF COLORADO

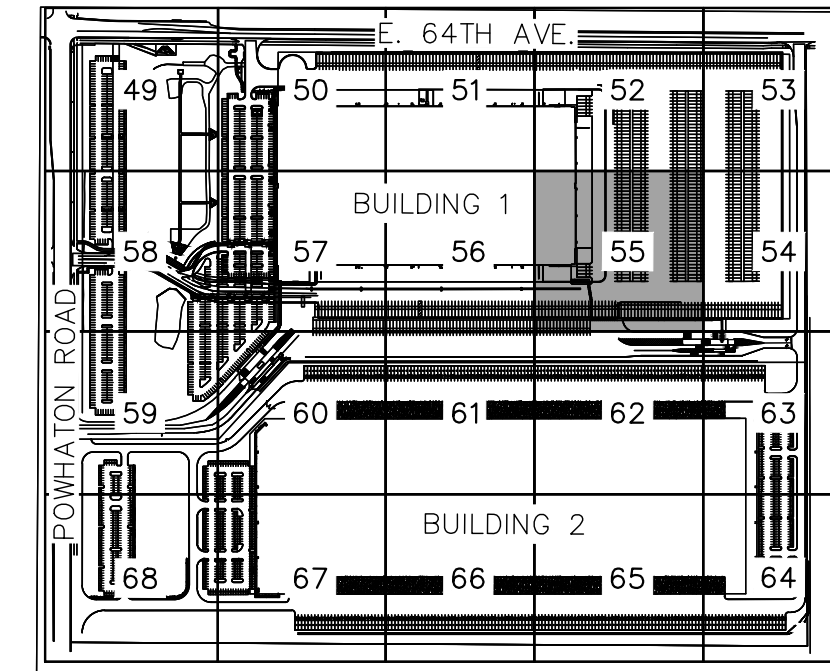


LEGEND

- PROPERTY LINE
- PROPOSED EASEMENT LINE
- EXISTING EASEMENT LINE
- EXISTING STORM SEWER
- PROPOSED STORM SEWER
- EXISTING WATER LINE
- PROPOSED WATER LINE
- PROPOSED WATER METER
- EXISTING FIRE HYDRANT
- PROPOSED FIRE HYDRANT ASSEMBLY PER COA STD DETAIL 206
- PROPOSED GATE VALVE
- PROPOSED TEE W/ THRUST BLOCK
- PROPOSED BEND W/ THRUST BLOCK
- PROPOSED FDC W/ KNOX HARDWARE
- EXISTING SANITARY SEWER
- PROPOSED SANITARY SEWER

UTILITY NOTES

- PROPOSED SANITARY SEWER PIPE
- PROPOSED SANITARY SEWER MANHOLE
- PROPOSED SANITARY SEWER SERVICE LINE
- PROPOSED WATER MAIN
- PROPOSED WATER SERVICE LINE
- PROPOSED FIRE SERVICE LINE
- PROPOSED FIRE HYDRANT AND BOLLARD ASSEMBLY PER COA STD DETAIL 208
- PROPOSED FDC W/ APPROVED KNOX HARDWARE
- PROPOSED KNOX BOX
- PROPOSED FIRE HYDRANT ASSEMBLY PER COA STD DETAIL 208

NOTE:
1. STORMWATER INFRASTRUCTURE OWNERSHIP SHALL BE DESIGNATED BY THE CONSTRUCTION DOCUMENTS.

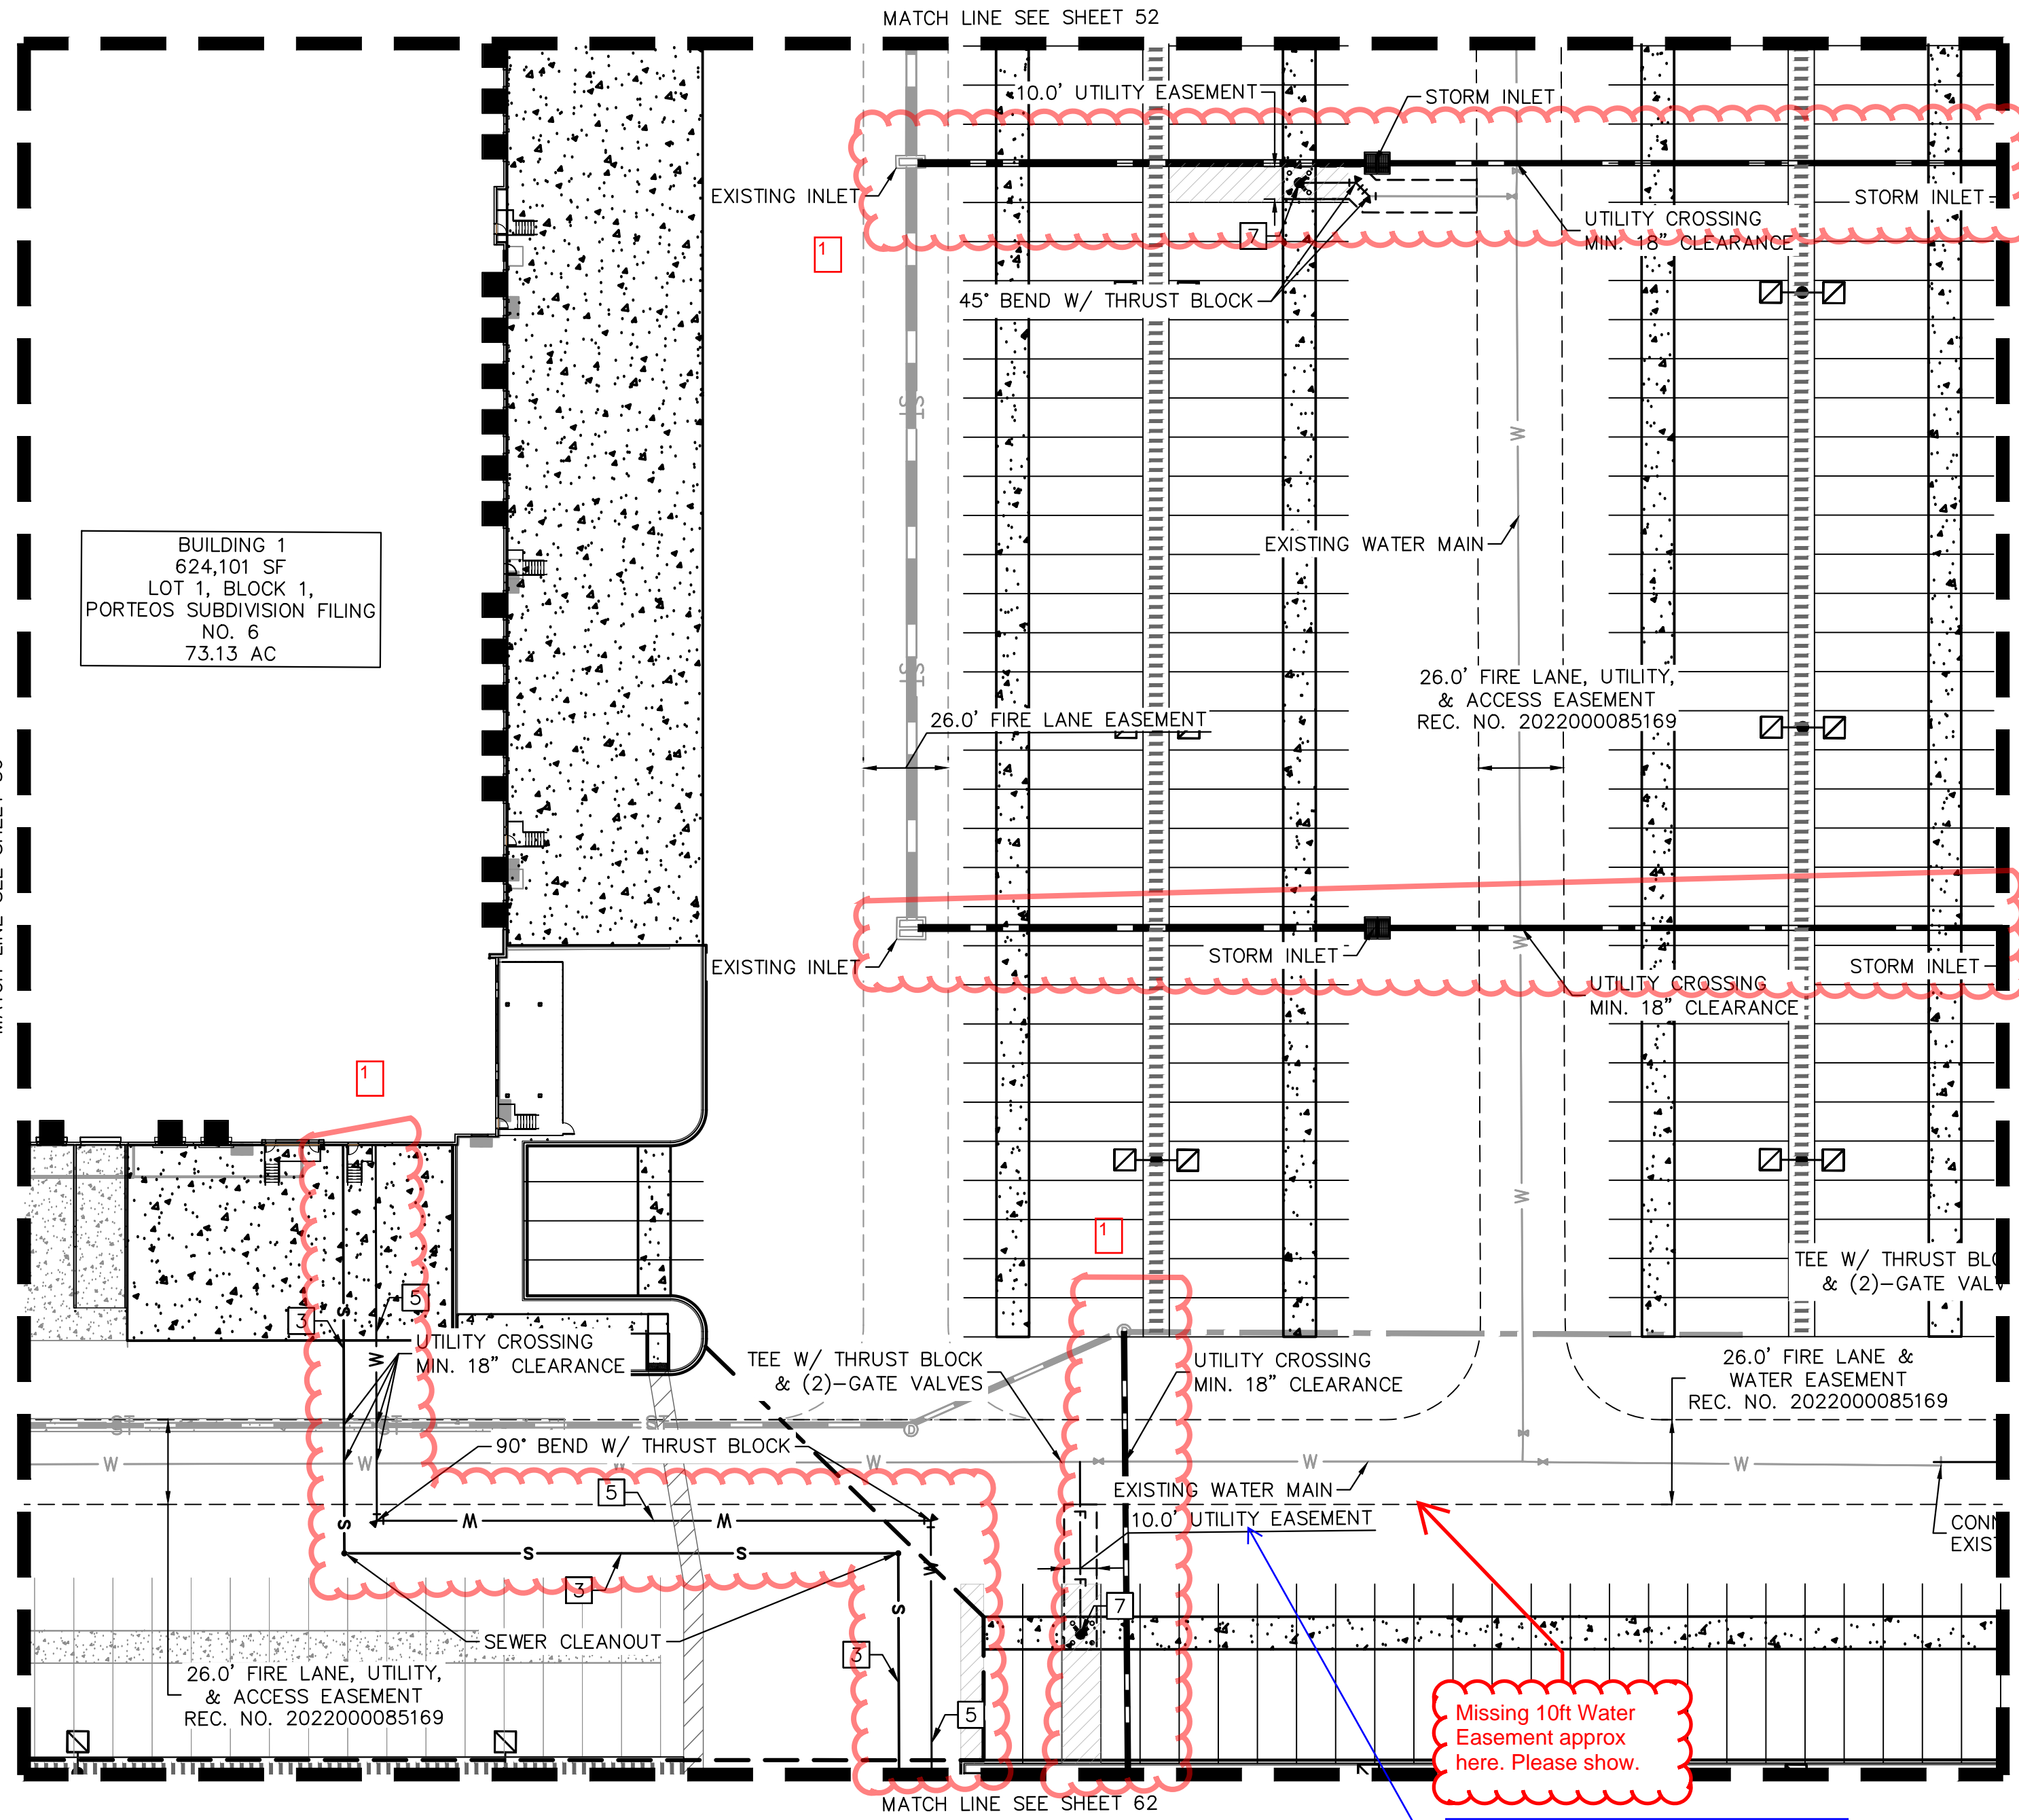

Missing 10ft Water Easement approx here. Please show.

KH: Easement is being vacated and replaced with proposed 10ft water esmt.

Kimley»Horn
KIMLEY-HORN AND ASSOCIATES, INC.
6205 S. WILLOW AVE.
GREENWOOD VILLAGE, CO 80111 (303) 228-2300


PORTEOS INDUSTRIAL AT PORTEOS
CITY OF AURORA, COUNTY OF ADAMS
SITE PLAN AMENDMENT
DETAILED UTILITY PLAN

DATE: 03/22/2024
DESIGNED BY: CAO
DRAWN BY: AGM
CHECKED BY: BUC


FILE NO. 196617002-UT DTL-DIA I
PROJECT NO. 196617002

SHEET NO. 55

K:\DEN_Civil\196617002 DIA1\CADD\PlanSheets\CSP\196617002_UT DTL-DIA I.dwg Cooney, Brad 3/27/2024 11:33 AM

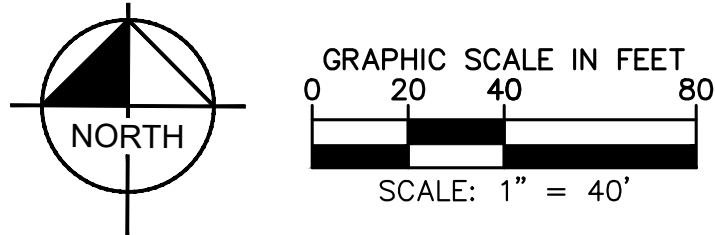

PORTEOS INDUSTRIAL AT PORTEOS
SITE PLAN AMENDMENT
LOCATED IN THE NW ¼ OF SECTION 9,
TOWNSHIP 3 SOUTH, RANGE 65 WEST OF THE 6TH P.M.,
CITY OF AURORA, ADAMS COUNTY, STATE OF COLORADO

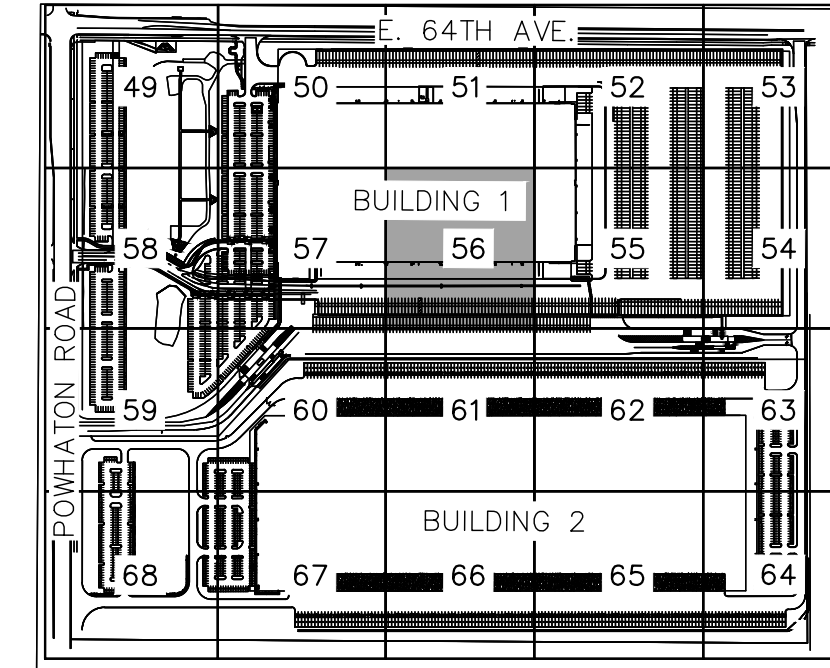


LEGEND

- PROPERTY LINE
- - - PROPOSED EASEMENT LINE
- - - EXISTING EASEMENT LINE
- EXISTING STORM SEWER
- PROPOSED STORM SEWER
- W — EXISTING WATER LINE
- W — PROPOSED WATER LINE
- [W] PROPOSED WATER METER
- EXISTING FIRE HYDRANT
- PROPOSED FIRE HYDRANT ASSEMBLY PER COA STD DETAIL 206
- PROPOSED GATE VALVE
- PROPOSED TEE W/ THRUST BLOCK
- PROPOSED BEND W/ THRUST BLOCK
- PROPOSED FDC W/ KNOX HARDWARE
- S — EXISTING SANITARY SEWER
- S — PROPOSED SANITARY SEWER

UTILITY NOTES

- 1 PROPOSED SANITARY SEWER PIPE
- 2 PROPOSED SANITARY SEWER MANHOLE
- 3 PROPOSED SANITARY SEWER SERVICE LINE
- 4 PROPOSED WATER MAIN
- 5 PROPOSED WATER SERVICE LINE
- 6 PROPOSED FIRE SERVICE LINE
- 7 PROPOSED FIRE HYDRANT AND BOLLARD ASSEMBLY PER COA STD DETAIL 208
- 8 PROPOSED FDC W/ APPROVED KNOX HARDWARE
- 9 PROPOSED KNOX BOX
- 10 PROPOSED FIRE HYDRANT ASSEMBLY PER COA STD DETAIL 208

NOTE:
1. STORMWATER INFRASTRUCTURE OWNERSHIP SHALL BE DESIGNATED BY THE CONSTRUCTION DOCUMENTS.

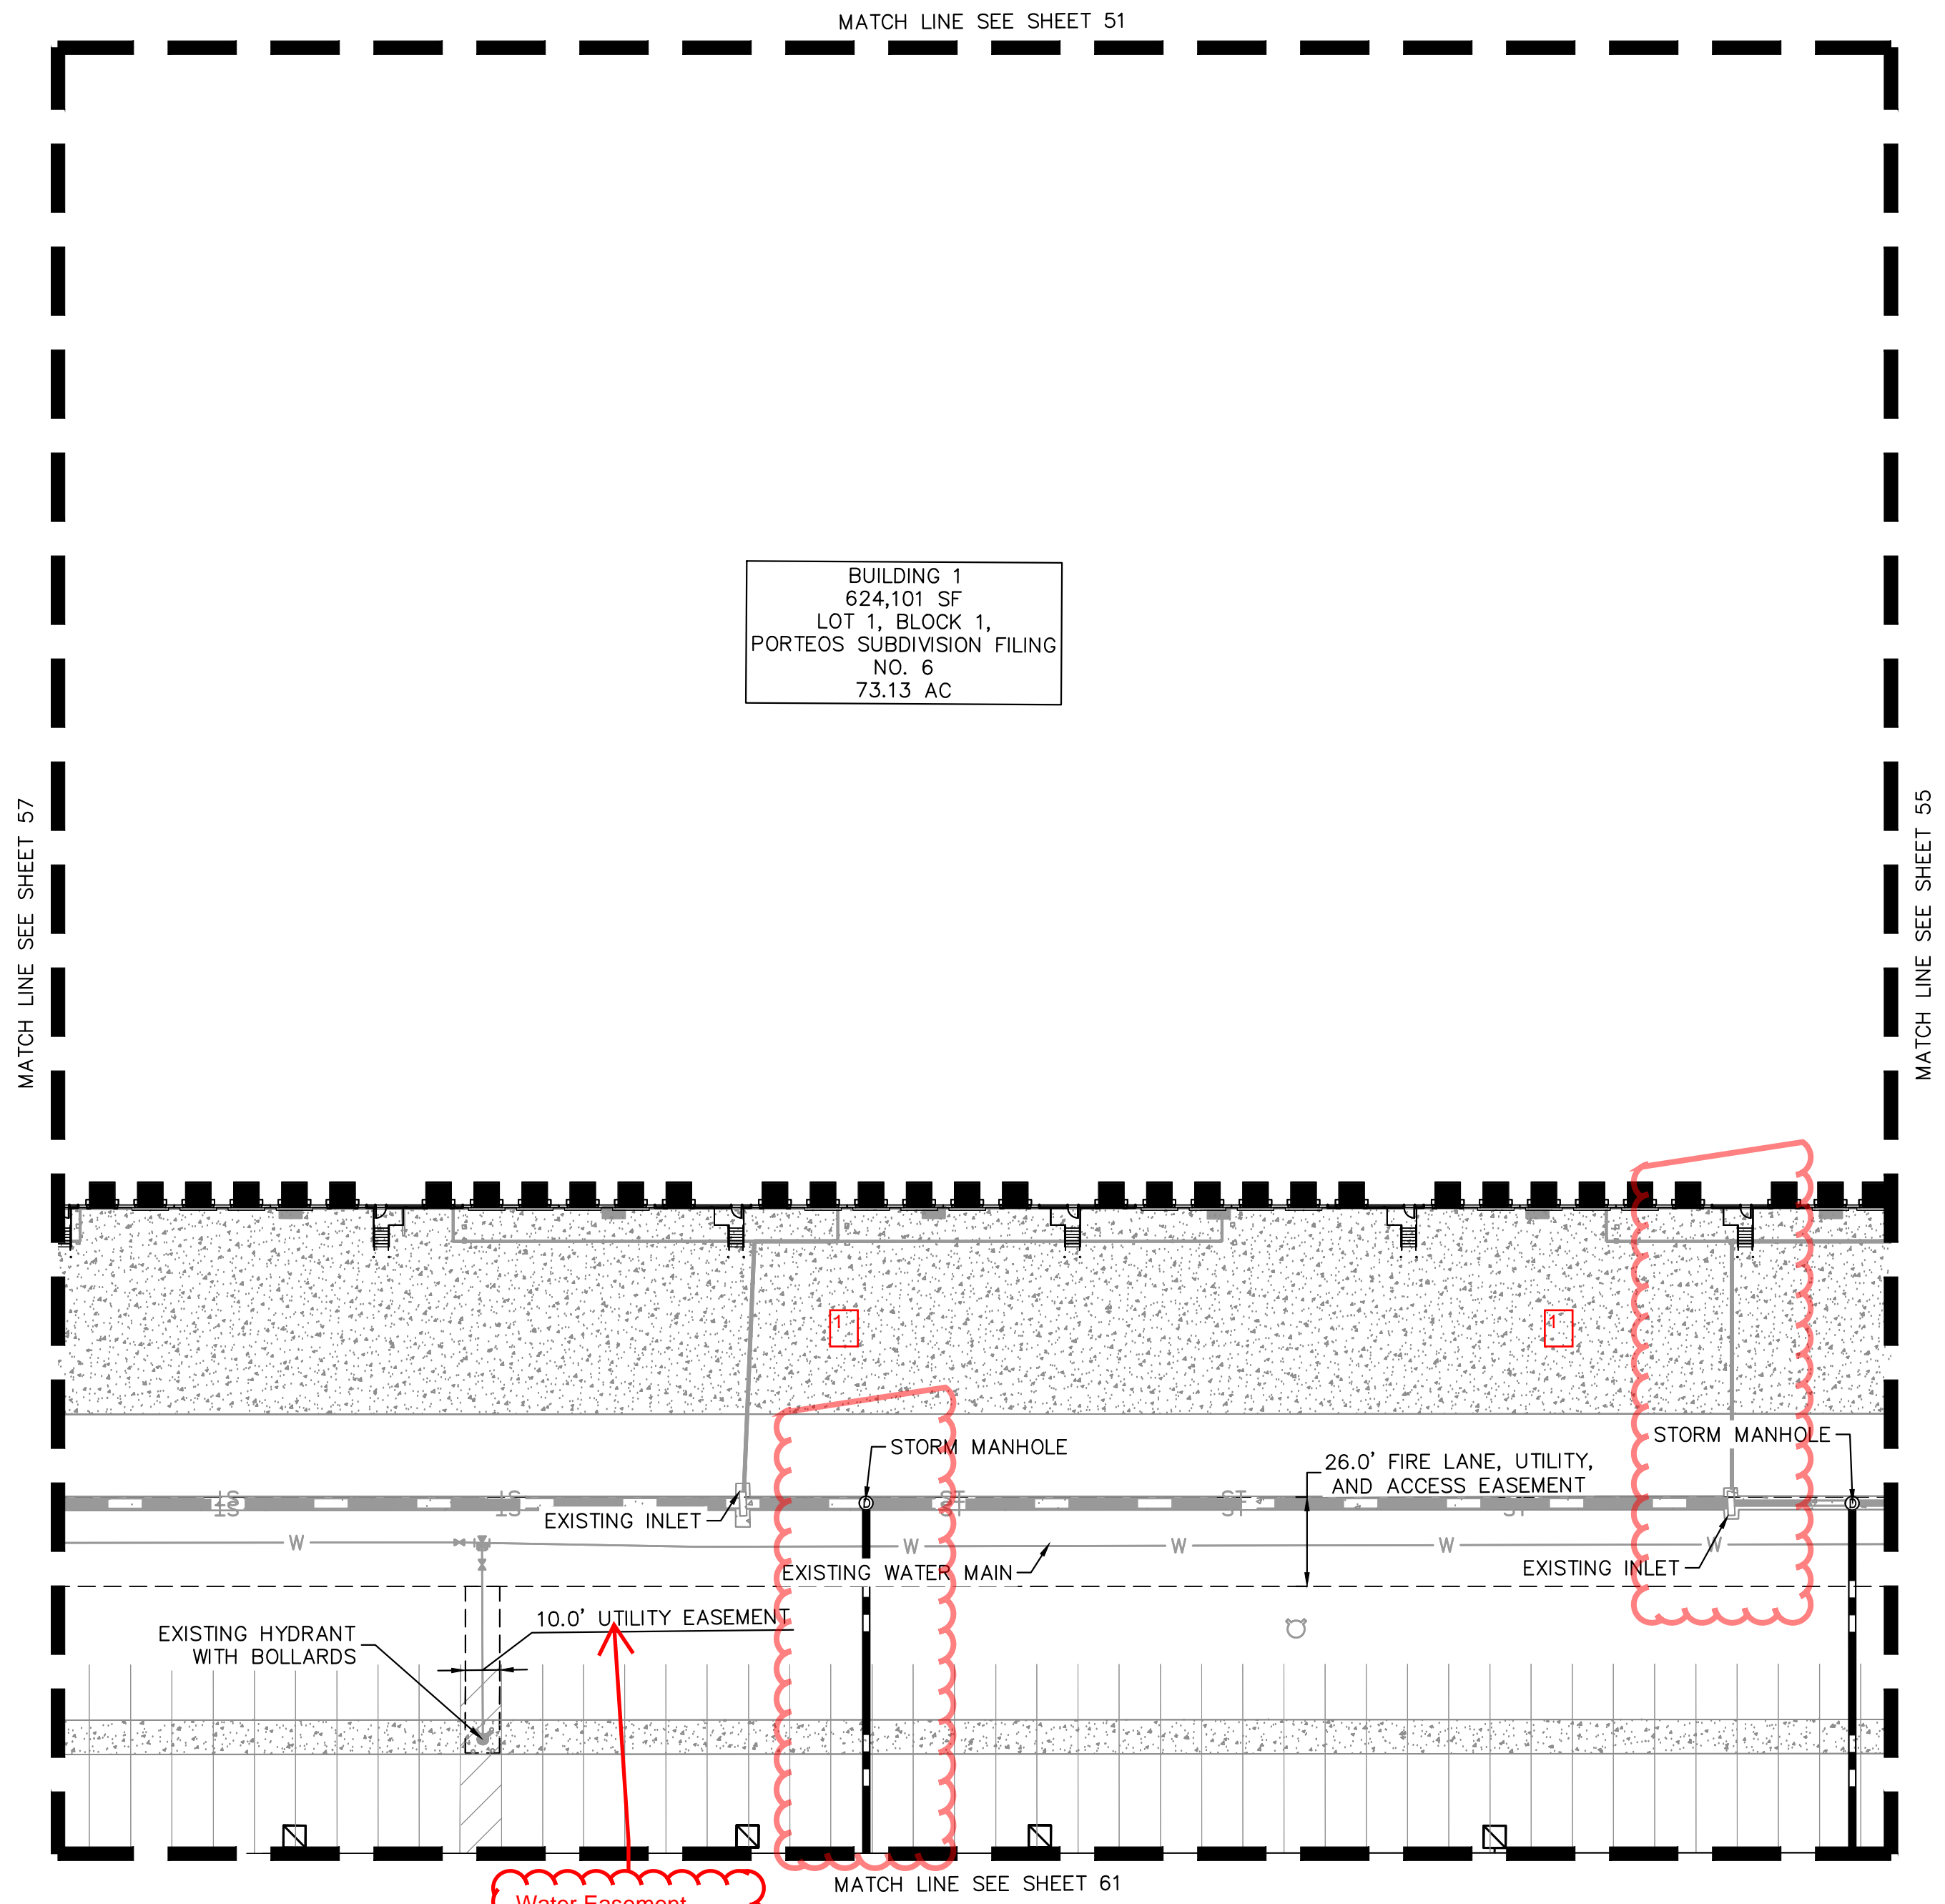

Water Easement

KH: This is an existing utility easement, label has been updated with rec. no..

Kimley»Horn
KIMLEY-HORN AND ASSOCIATES, INC.
6205 S. W. 11th Ave.
Greenwood Village, CO 80111 (303) 228-2300


PORTEOS INDUSTRIAL AT PORTEOS
CITY OF AURORA, COUNTY OF ADAMS
SITE PLAN AMENDMENT
DETAILED UTILITY PLAN

DATE: 03/22/2024
DESIGNED BY: CAO
DRAWN BY: AGM
CHECKED BY: BJC

FILE NO. 196617002_UT DTL-DIA I
PROJECT NO. 196617002

SHEET NO. 56


K:\DEN_Civil\196617002 DIA1\CADD\PlanSheets\CSP\196617002_UT DTL-DIA I.dwg Cooney, Brad 3/27/2024 11:34 AM

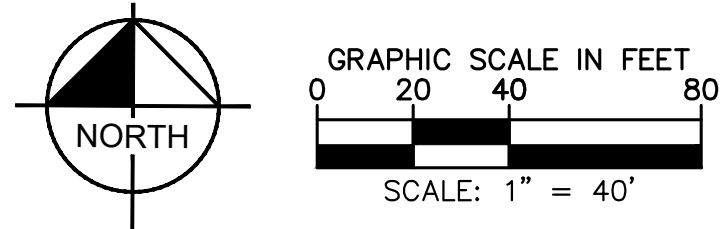

PORTEOS INDUSTRIAL AT PORTEOS SITE PLAN AMENDMENT


LOCATED IN THE NW $\frac{1}{4}$ OF SECTION 9,
TOWNSHIP 3 SOUTH, RANGE 65 WEST OF THE 6TH P.M.,
CITY OF AURORA, ADAMS COUNTY, STATE OF COLORADO

MATCH LINE SEE SHEET 50

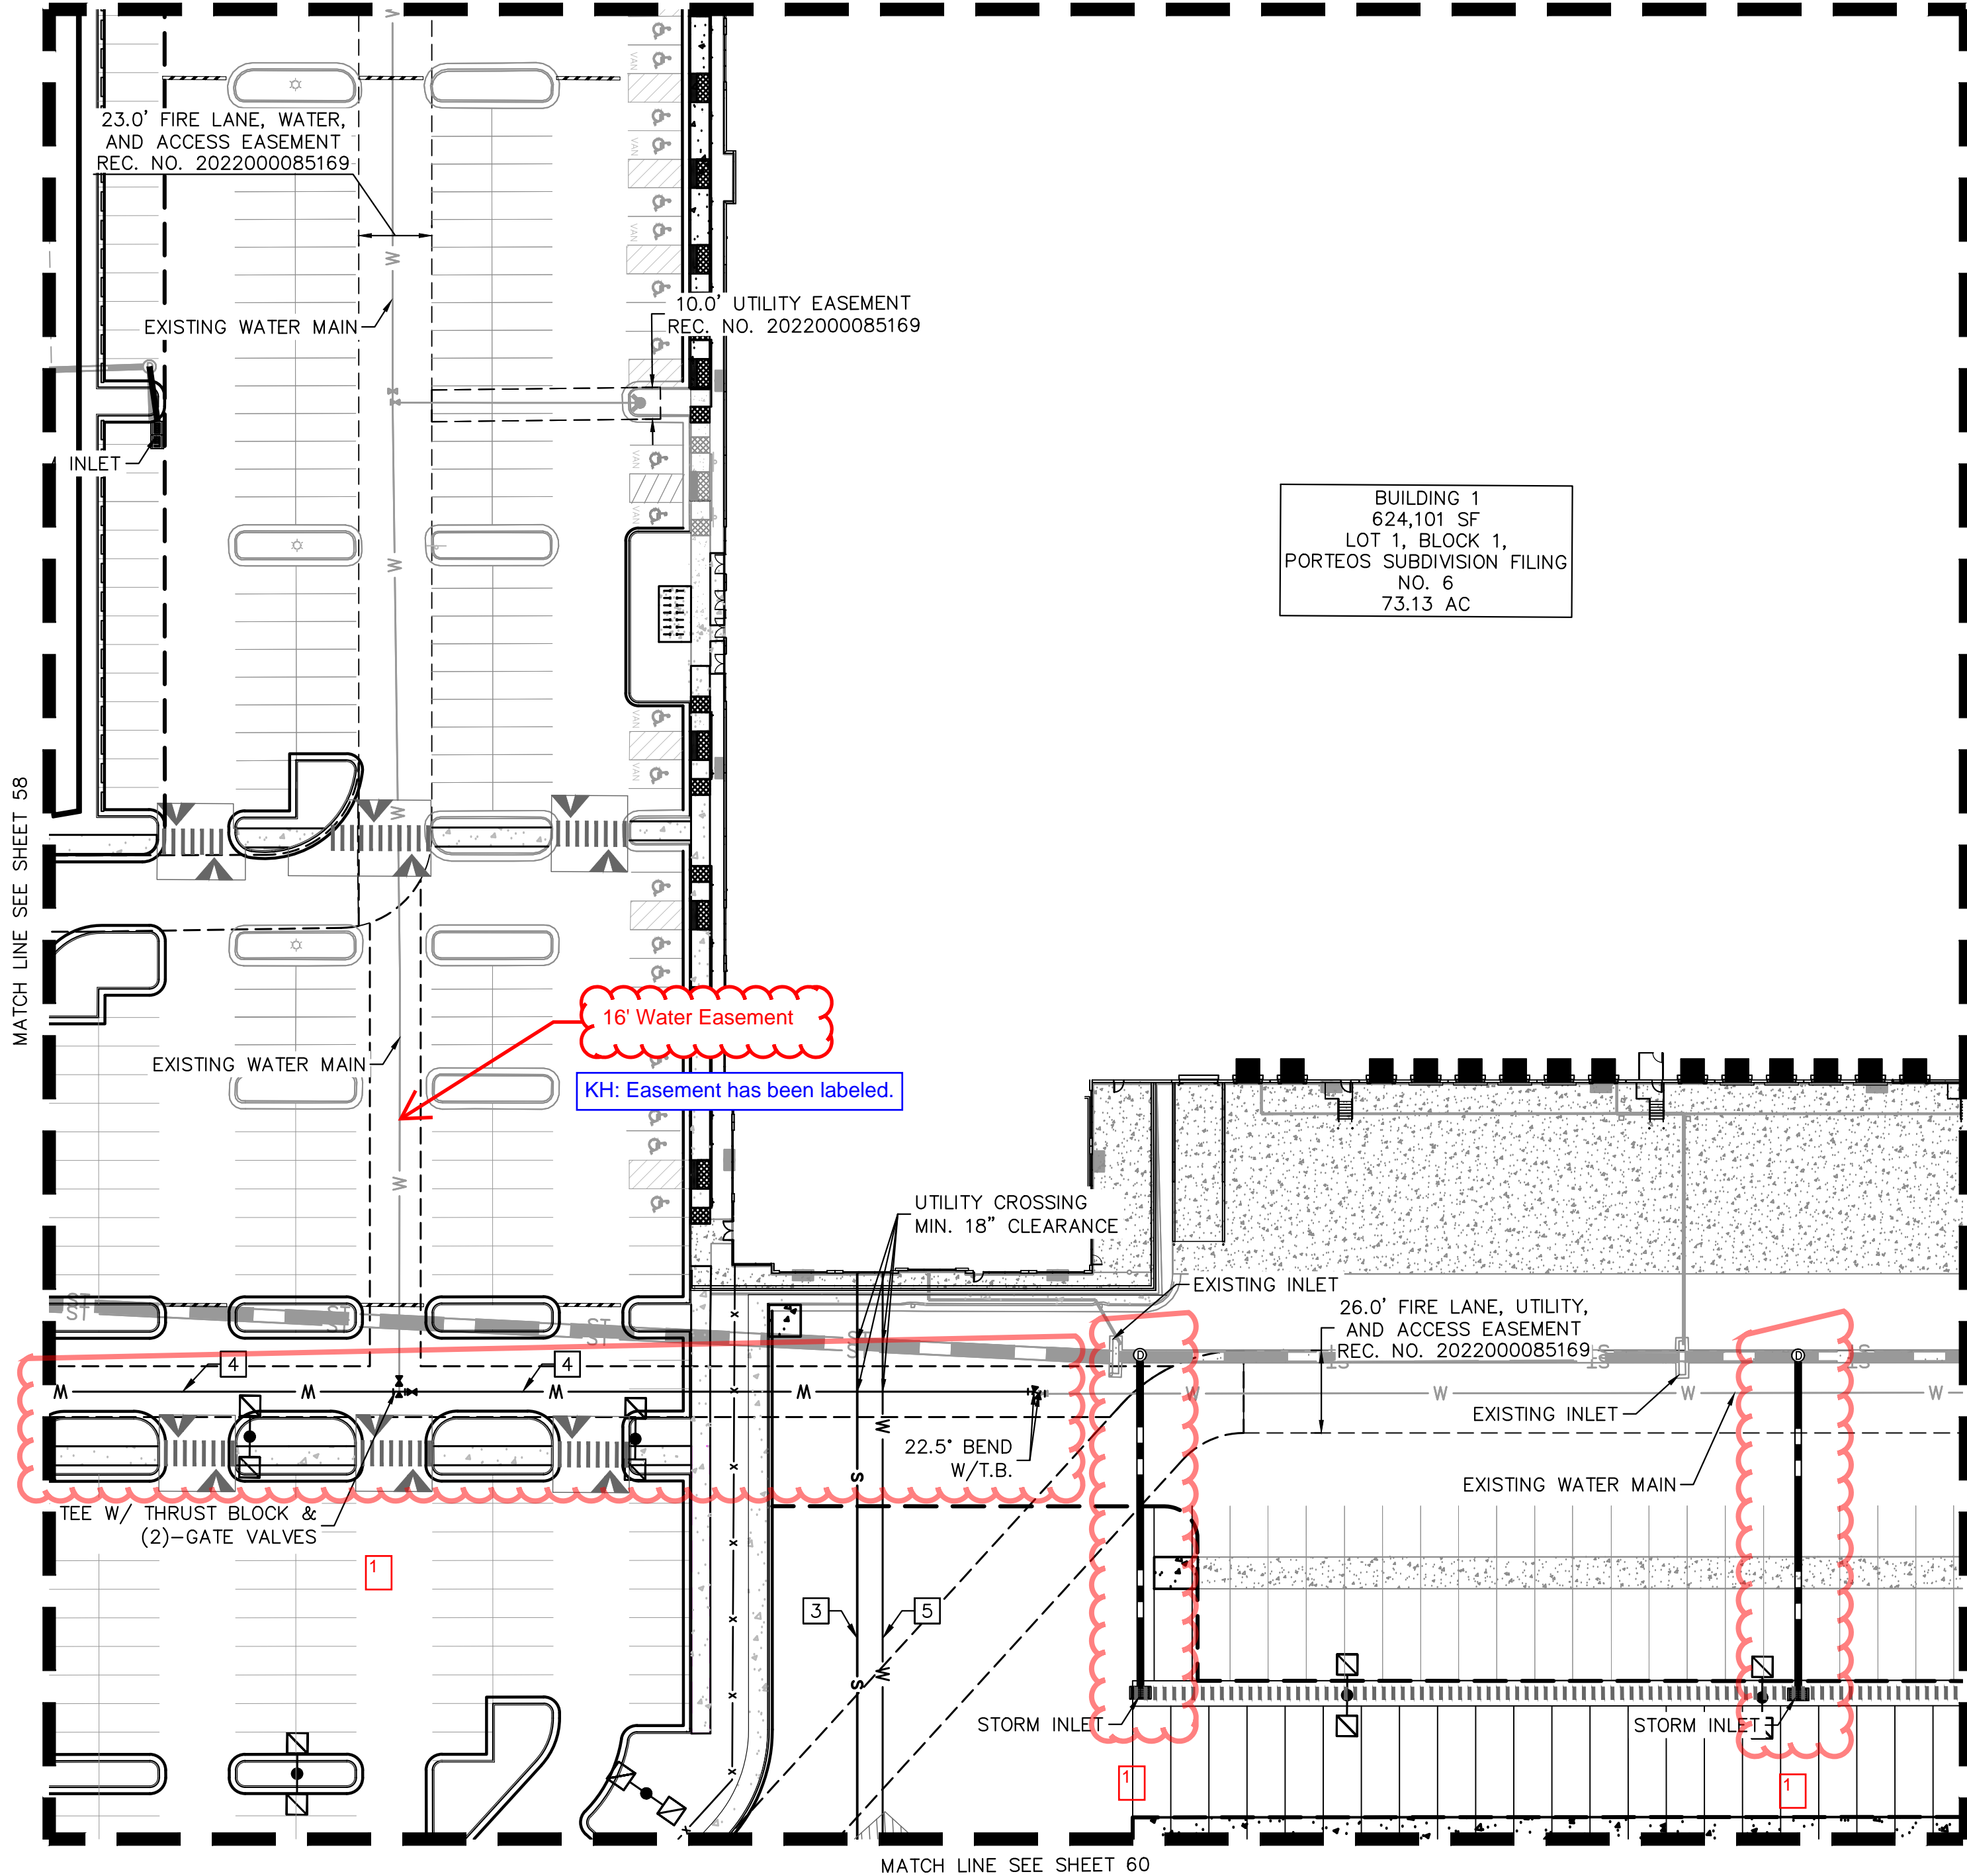

16' Water Easement

KH: Easement has been labeled.

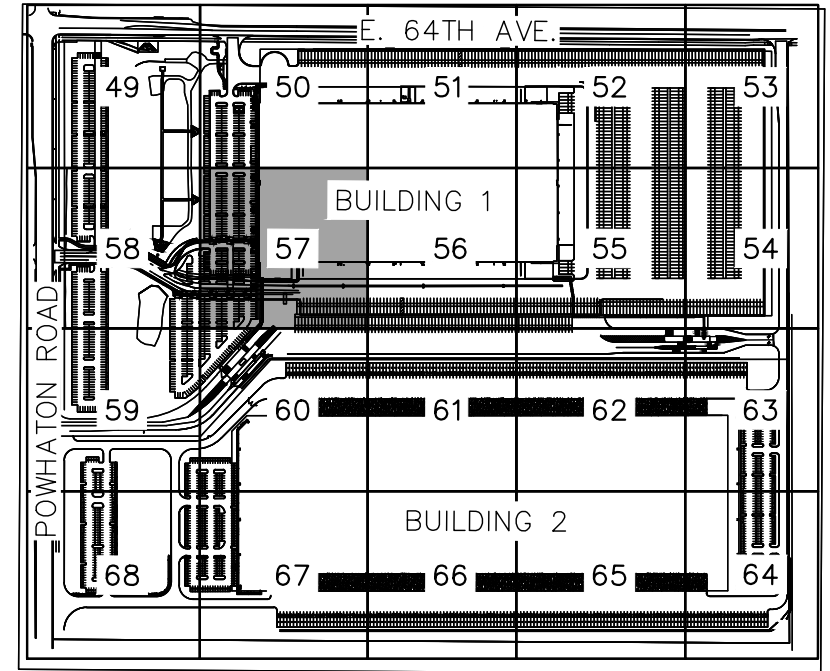

LEGEND

- PROPERTY LINE
- PROPOSED EASEMENT LINE
- EXISTING EASEMENT LINE
- EXISTING STORM SEWER
- PROPOSED STORM SEWER
- EXISTING WATER LINE
- PROPOSED WATER LINE
- PROPOSED WATER METER
- EXISTING FIRE HYDRANT
- PROPOSED FIRE HYDRANT ASSEMBLY PER COA STD DETAIL 206
- PROPOSED GATE VALVE
- PROPOSED TEE W/ THRUST BLOCK
- PROPOSED BEND W/ THRUST BLOCK
- PROPOSED FDC W/ KNOX HARDWARE
- EXISTING SANITARY SEWER
- PROPOSED SANITARY SEWER

UTILITY NOTES

- PROPOSED SANITARY SEWER PIPE
- PROPOSED SANITARY SEWER MANHOLE
- PROPOSED SANITARY SEWER SERVICE LINE
- PROPOSED WATER MAIN
- PROPOSED WATER SERVICE LINE
- PROPOSED FIRE SERVICE LINE
- PROPOSED FIRE HYDRANT AND BOLLARD ASSEMBLY PER COA STD DETAIL 208
- PROPOSED FDC W/ APPROVED KNOX HARDWARE
- PROPOSED KNOX BOX
- PROPOSED FIRE HYDRANT ASSEMBLY PER COA STD DETAIL 208

NOTE:
1. STORMWATER INFRASTRUCTURE OWNERSHIP SHALL BE DESIGNATED BY THE CONSTRUCTION DOCUMENTS.

Kimley»Horn
KIMLEY-HORN AND ASSOCIATES, INC.
6205 S. W. 11th Ave.
Greenwood Village, CO 80111 (303) 228-2300

PORTEOS INDUSTRIAL AT PORTEOS
CITY OF AURORA, COUNTY OF ADAMS
SITE PLAN AMENDMENT
DETAILED UTILITY PLAN


DATE: 03/22/2024
DESIGNED BY: CAO
DRAWN BY: AGM
CHECKED BY: BUC

FILE NO.
196617002_UT DTL-DIA I
PROJECT NO.
196617002

SHEET NO.
57

NO.	REVISION	BY	DATE	APPROVED


K:\DEN_Civil\196617002 DIA1\CADD\PlanSheets\CSP\196617002_UT DTL-DIA I.dwg Cooney, Brad 3/27/2024 11:34 AM

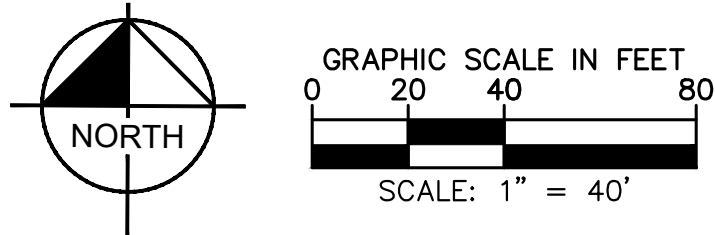

PORTEOS INDUSTRIAL AT PORTEOS

SITE PLAN AMENDMENT

LOCATED IN THE NW $\frac{1}{4}$ OF SECTION 9,
TOWNSHIP 3 SOUTH, RANGE 65 WEST OF THE 6TH P.M.,
CITY OF AURORA, ADAMS COUNTY, STATE OF COLORADO

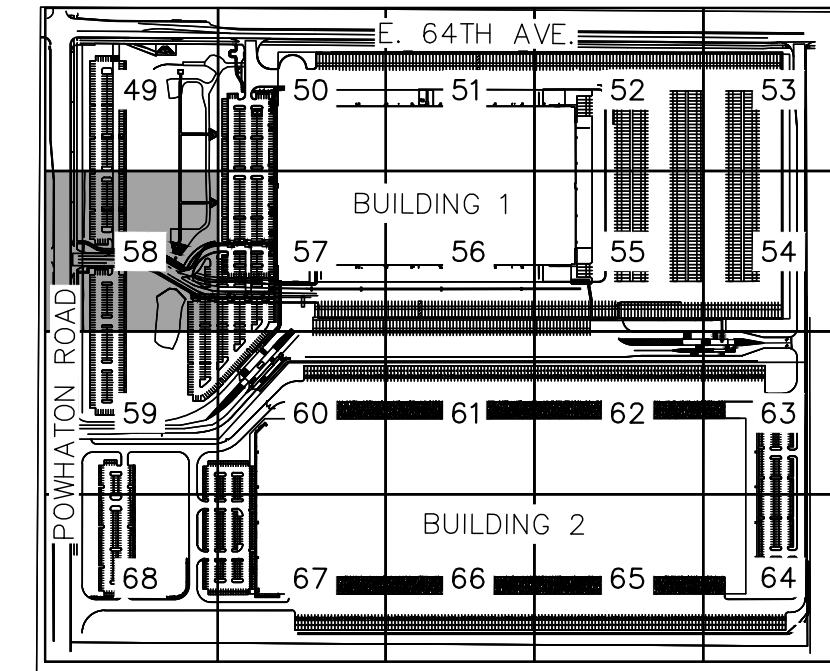


LEGEND

- PROPERTY LINE
- PROPOSED EASEMENT LINE
- EXISTING EASEMENT LINE
- EXISTING STORM SEWER
- PROPOSED STORM SEWER
- EXISTING WATER LINE
- PROPOSED WATER LINE
- PROPOSED WATER METER
- EXISTING FIRE HYDRANT
- PROPOSED FIRE HYDRANT ASSEMBLY PER COA STD DETAIL 206
- PROPOSED GATE VALVE
- PROPOSED TEE W/ THRUST BLOCK
- PROPOSED BEND W/ THRUST BLOCK
- PROPOSED FDC W/ KNOX HARDWARE
- EXISTING SANITARY SEWER
- PROPOSED SANITARY SEWER

UTILITY NOTES

- PROPOSED SANITARY SEWER PIPE
- PROPOSED SANITARY SEWER MANHOLE
- PROPOSED SANITARY SEWER SERVICE LINE
- PROPOSED WATER MAIN
- PROPOSED WATER SERVICE LINE
- PROPOSED FIRE SERVICE LINE
- PROPOSED FIRE HYDRANT AND BOLLARD ASSEMBLY PER COA STD DETAIL 208
- PROPOSED FDC W/ APPROVED KNOX HARDWARE
- PROPOSED KNOX BOX
- PROPOSED FIRE HYDRANT ASSEMBLY PER COA STD DETAIL 208

NOTE:
1. STORMWATER INFRASTRUCTURE OWNERSHIP SHALL BE DESIGNATED BY THE CONSTRUCTION DOCUMENTS.

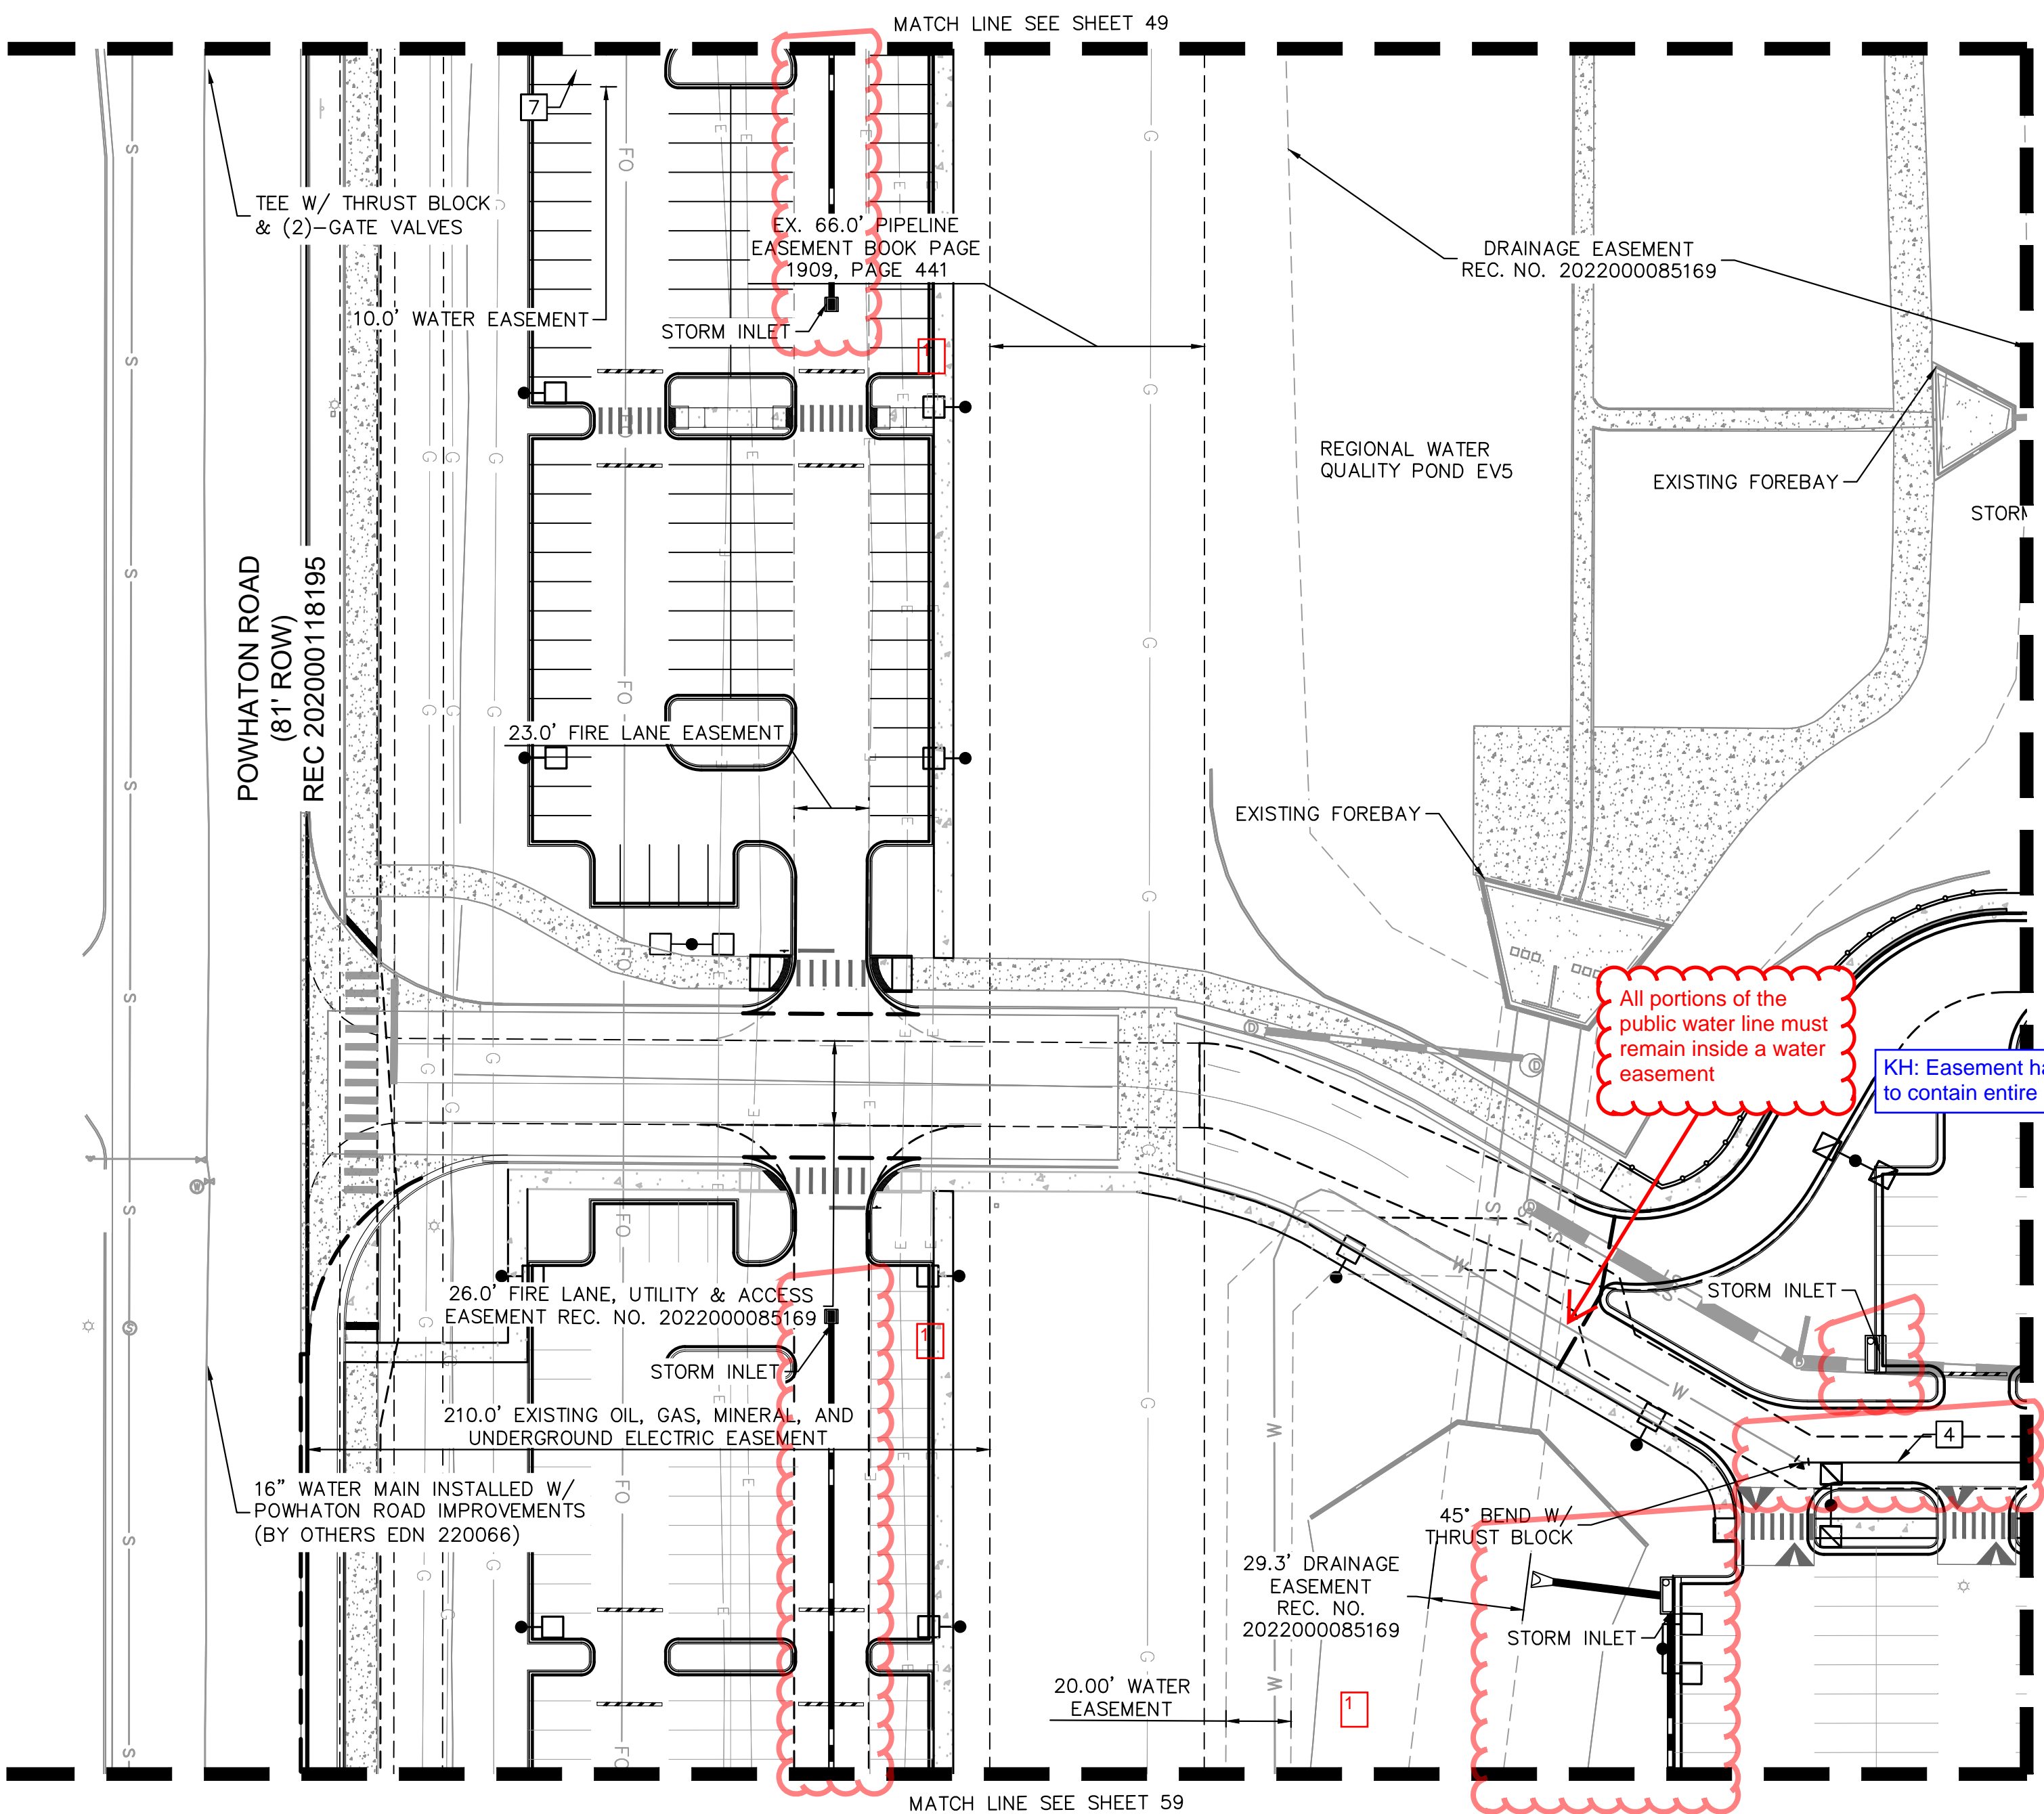

All portions of the public water line must remain inside a water easement

KH: Easement has been updated to contain entire public water main.

Kimley»Horn
KIMLEY-HORN AND ASSOCIATES, INC.
6205 S. W. 10th Ave., Suite 200
Greenwood Village, CO 80111 (303) 228-2300


PORTEOS INDUSTRIAL AT PORTEOS
CITY OF AURORA, COUNTY OF ADAMS
SITE PLAN AMENDMENT
DETAILED UTILITY PLAN

DATE: 03/22/2024
DESIGNED BY: CAO
DRAWN BY: AGM
CHECKED BY: BUC

FILE NO.
196617002_UT DTL-DIA I
PROJECT NO.
196617002

SHEET NO.
58


K:\DEN_Civil\196617002 DIA1\CADD\PlanSheets\CSP\196617002_UT DTL-DIA II.dwg OKeeffe, Sam 3/27/2024 7:44 AM

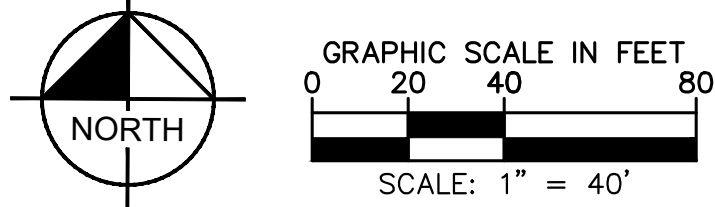

PORTEOS INDUSTRIAL AT PORTEOS

SITE PLAN AMENDMENT

LOCATED IN THE NW ¼ OF SECTION 9,
TOWNSHIP 3 SOUTH, RANGE 65 WEST OF THE 6TH P.M.,
CITY OF AURORA, ADAMS COUNTY, STATE OF COLORADO

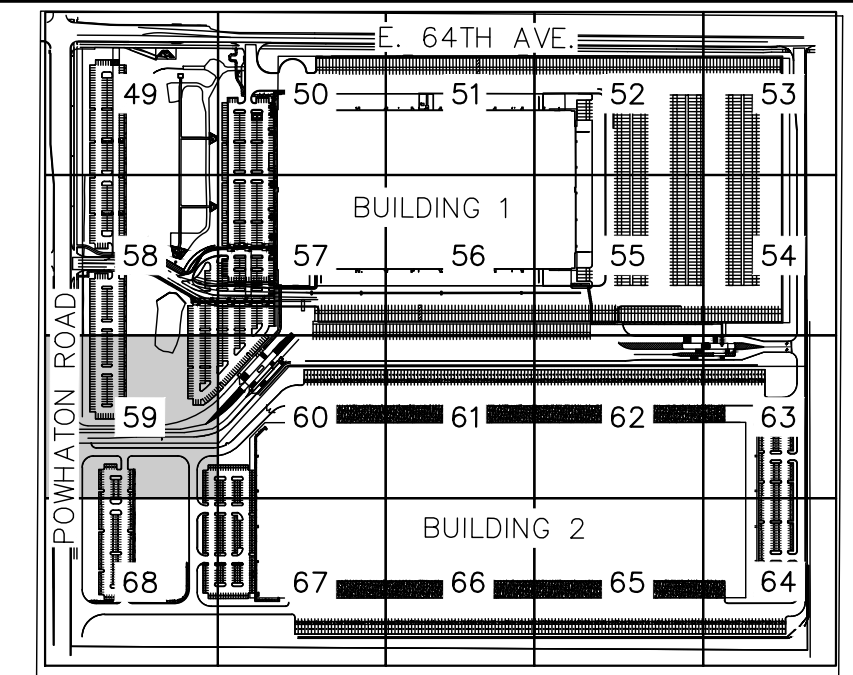

KEYMAP

LEGEND

- PROPERTY LINE
- PROPOSED EASEMENT LINE
- EXISTING EASEMENT LINE
- EXISTING STORM SEWER
- PROPOSED STORM SEWER
- EXISTING WATER LINE
- PROPOSED WATER LINE
- PROPOSED WATER METER
- EXISTING FIRE HYDRANT
- PROPOSED FIRE HYDRANT ASSEMBLY PER COA STD DETAIL 206
- PROPOSED GATE VALVE
- PROPOSED TEE W/ THRUST BLOCK
- PROPOSED BEND W/ THRUST BLOCK
- PROPOSED FDC W/ KNOX HARDWARE
- EXISTING SANITARY SEWER
- PROPOSED SANITARY SEWER

UTILITY NOTES

- PROPOSED SANITARY SEWER PIPE
- PROPOSED SANITARY SEWER MANHOLE
- PROPOSED SANITARY SEWER SERVICE LINE
- PROPOSED WATER MAIN
- PROPOSED WATER SERVICE LINE
- PROPOSED FIRE SERVICE LINE
- PROPOSED FIRE HYDRANT AND BOLLARD ASSEMBLY PER COA STD DETAIL 208
- PROPOSED FDC W/ APPROVED KNOX HARDWARE
- PROPOSED KNOX BOX
- PROPOSED FIRE HYDRANT ASSEMBLY PER COA STD DETAIL 208

NOTE:
1. STORMWATER INFRASTRUCTURE OWNERSHIP SHALL BE DESIGNATED BY THE CONSTRUCTION DOCUMENTS.

KH: Easement label has been added.


Please label as 16' Water Easement

Typical Comment: Please show water main sizes.

KH: Water main sizes have been labeled.

This is labeled as a 23' Fire Lane, Water, and Access Easement on the plat. Please be consistent with all labels and types of easements.

KH: Plat and CSP have been updated to show consistent labels.


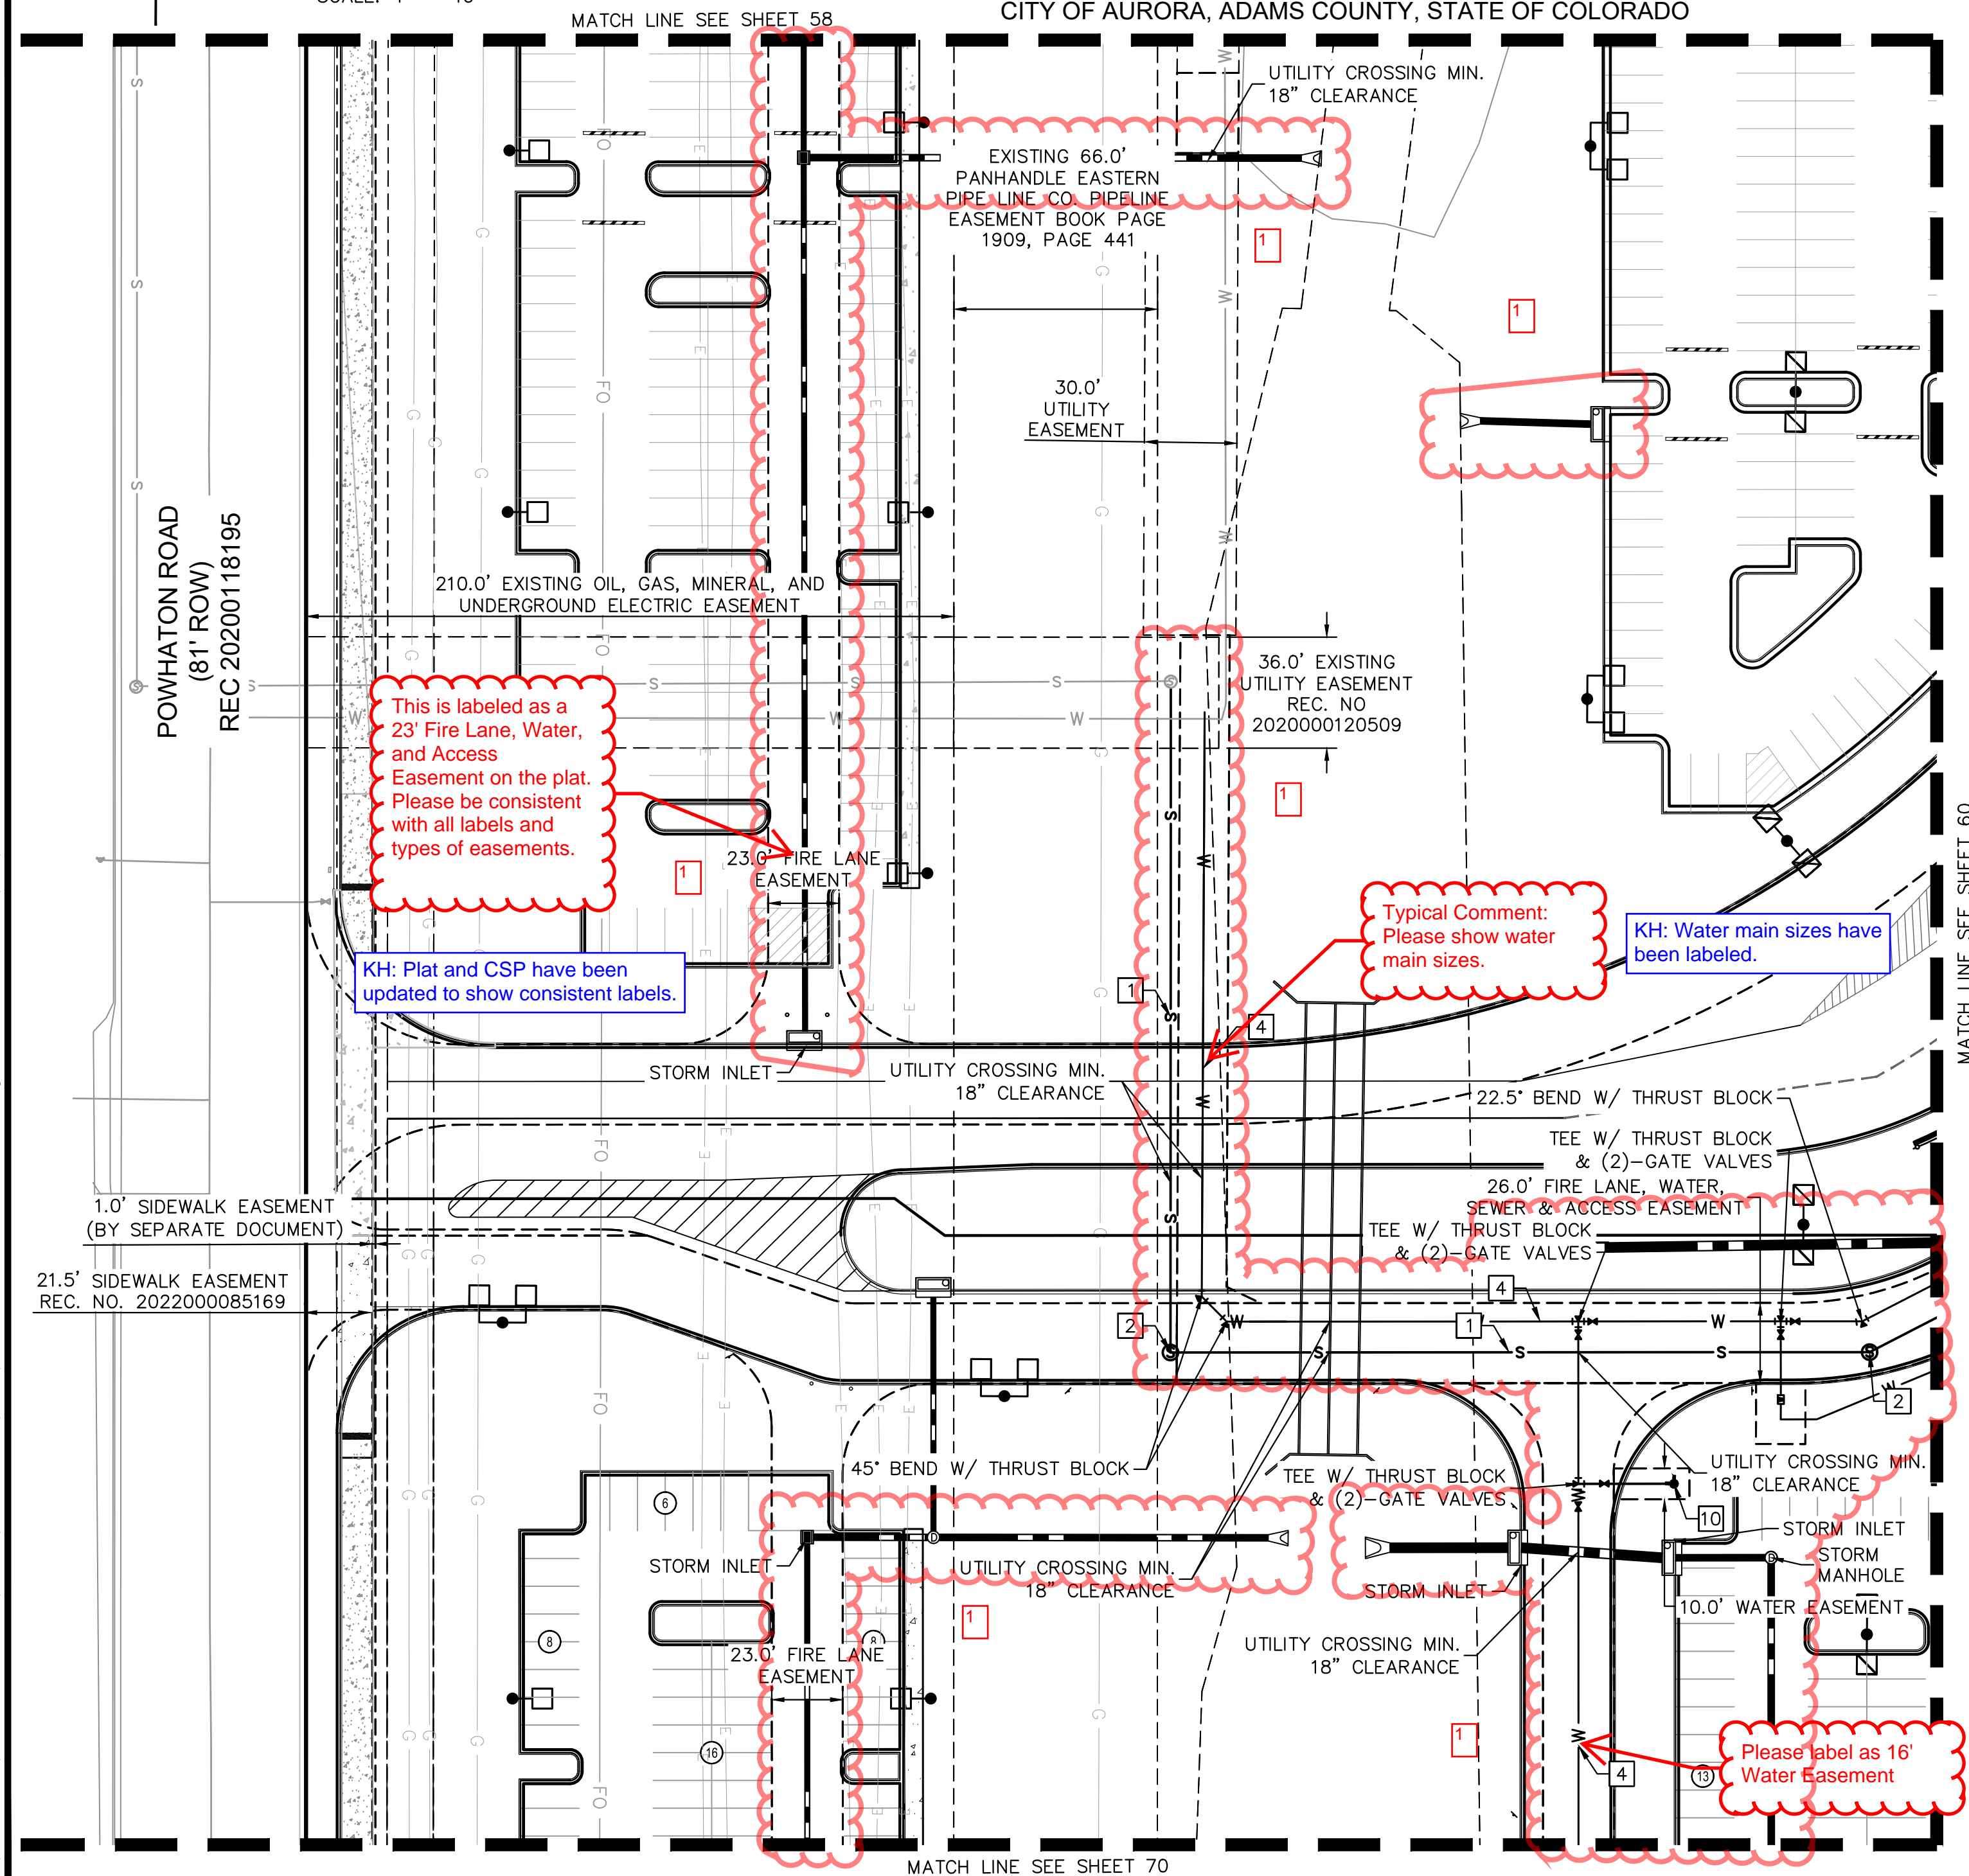


Kimley»Horn
KIMLEY-HORN AND ASSOCIATES, INC.
6205 S. WATKINS AVE.
GREENWOOD VILLAGE, CO 80111 (303) 228-2300

PORTEOS INDUSTRIAL AT PORTEOS
CITY OF AURORA, COUNTY OF ADAMS
SITE PLAN AMENDMENT
DETAILED UTILITY PLAN

FILE NO. 196617002_UT DTL-DIA II	DATE 03/22/2024
PROJECT NO. 196617002	DESIGNED BY: CAO
	DRAWN BY: AGM
	CHECKED BY: BUC
SHEET NO. 59	

K:\DEN_Civil\196617002 DIA\CADD\PlanSheets\CSP\196617002_UT DTL-DIA II.dwg OKeeffe, Sam 3/27/2024 7:44 AM

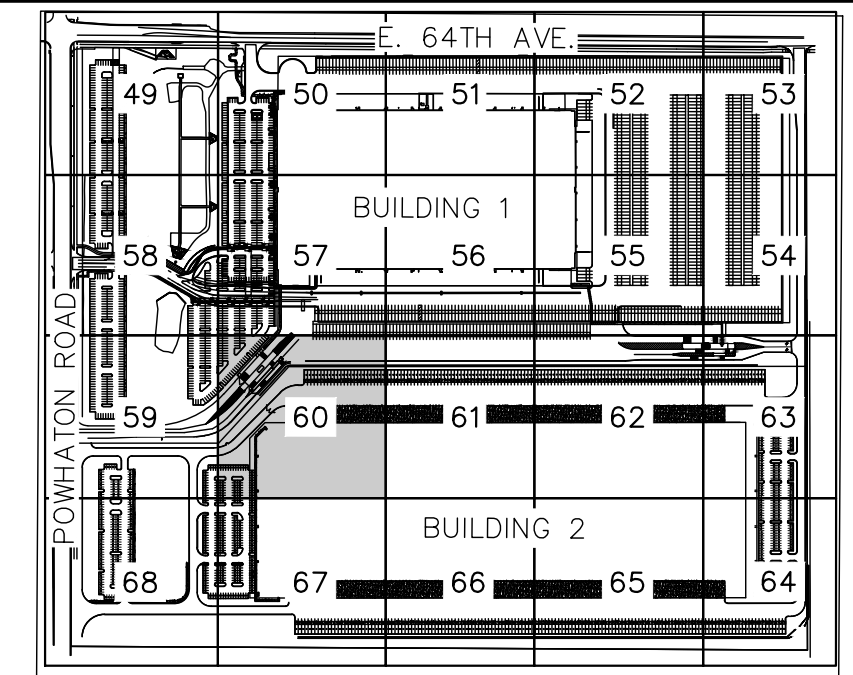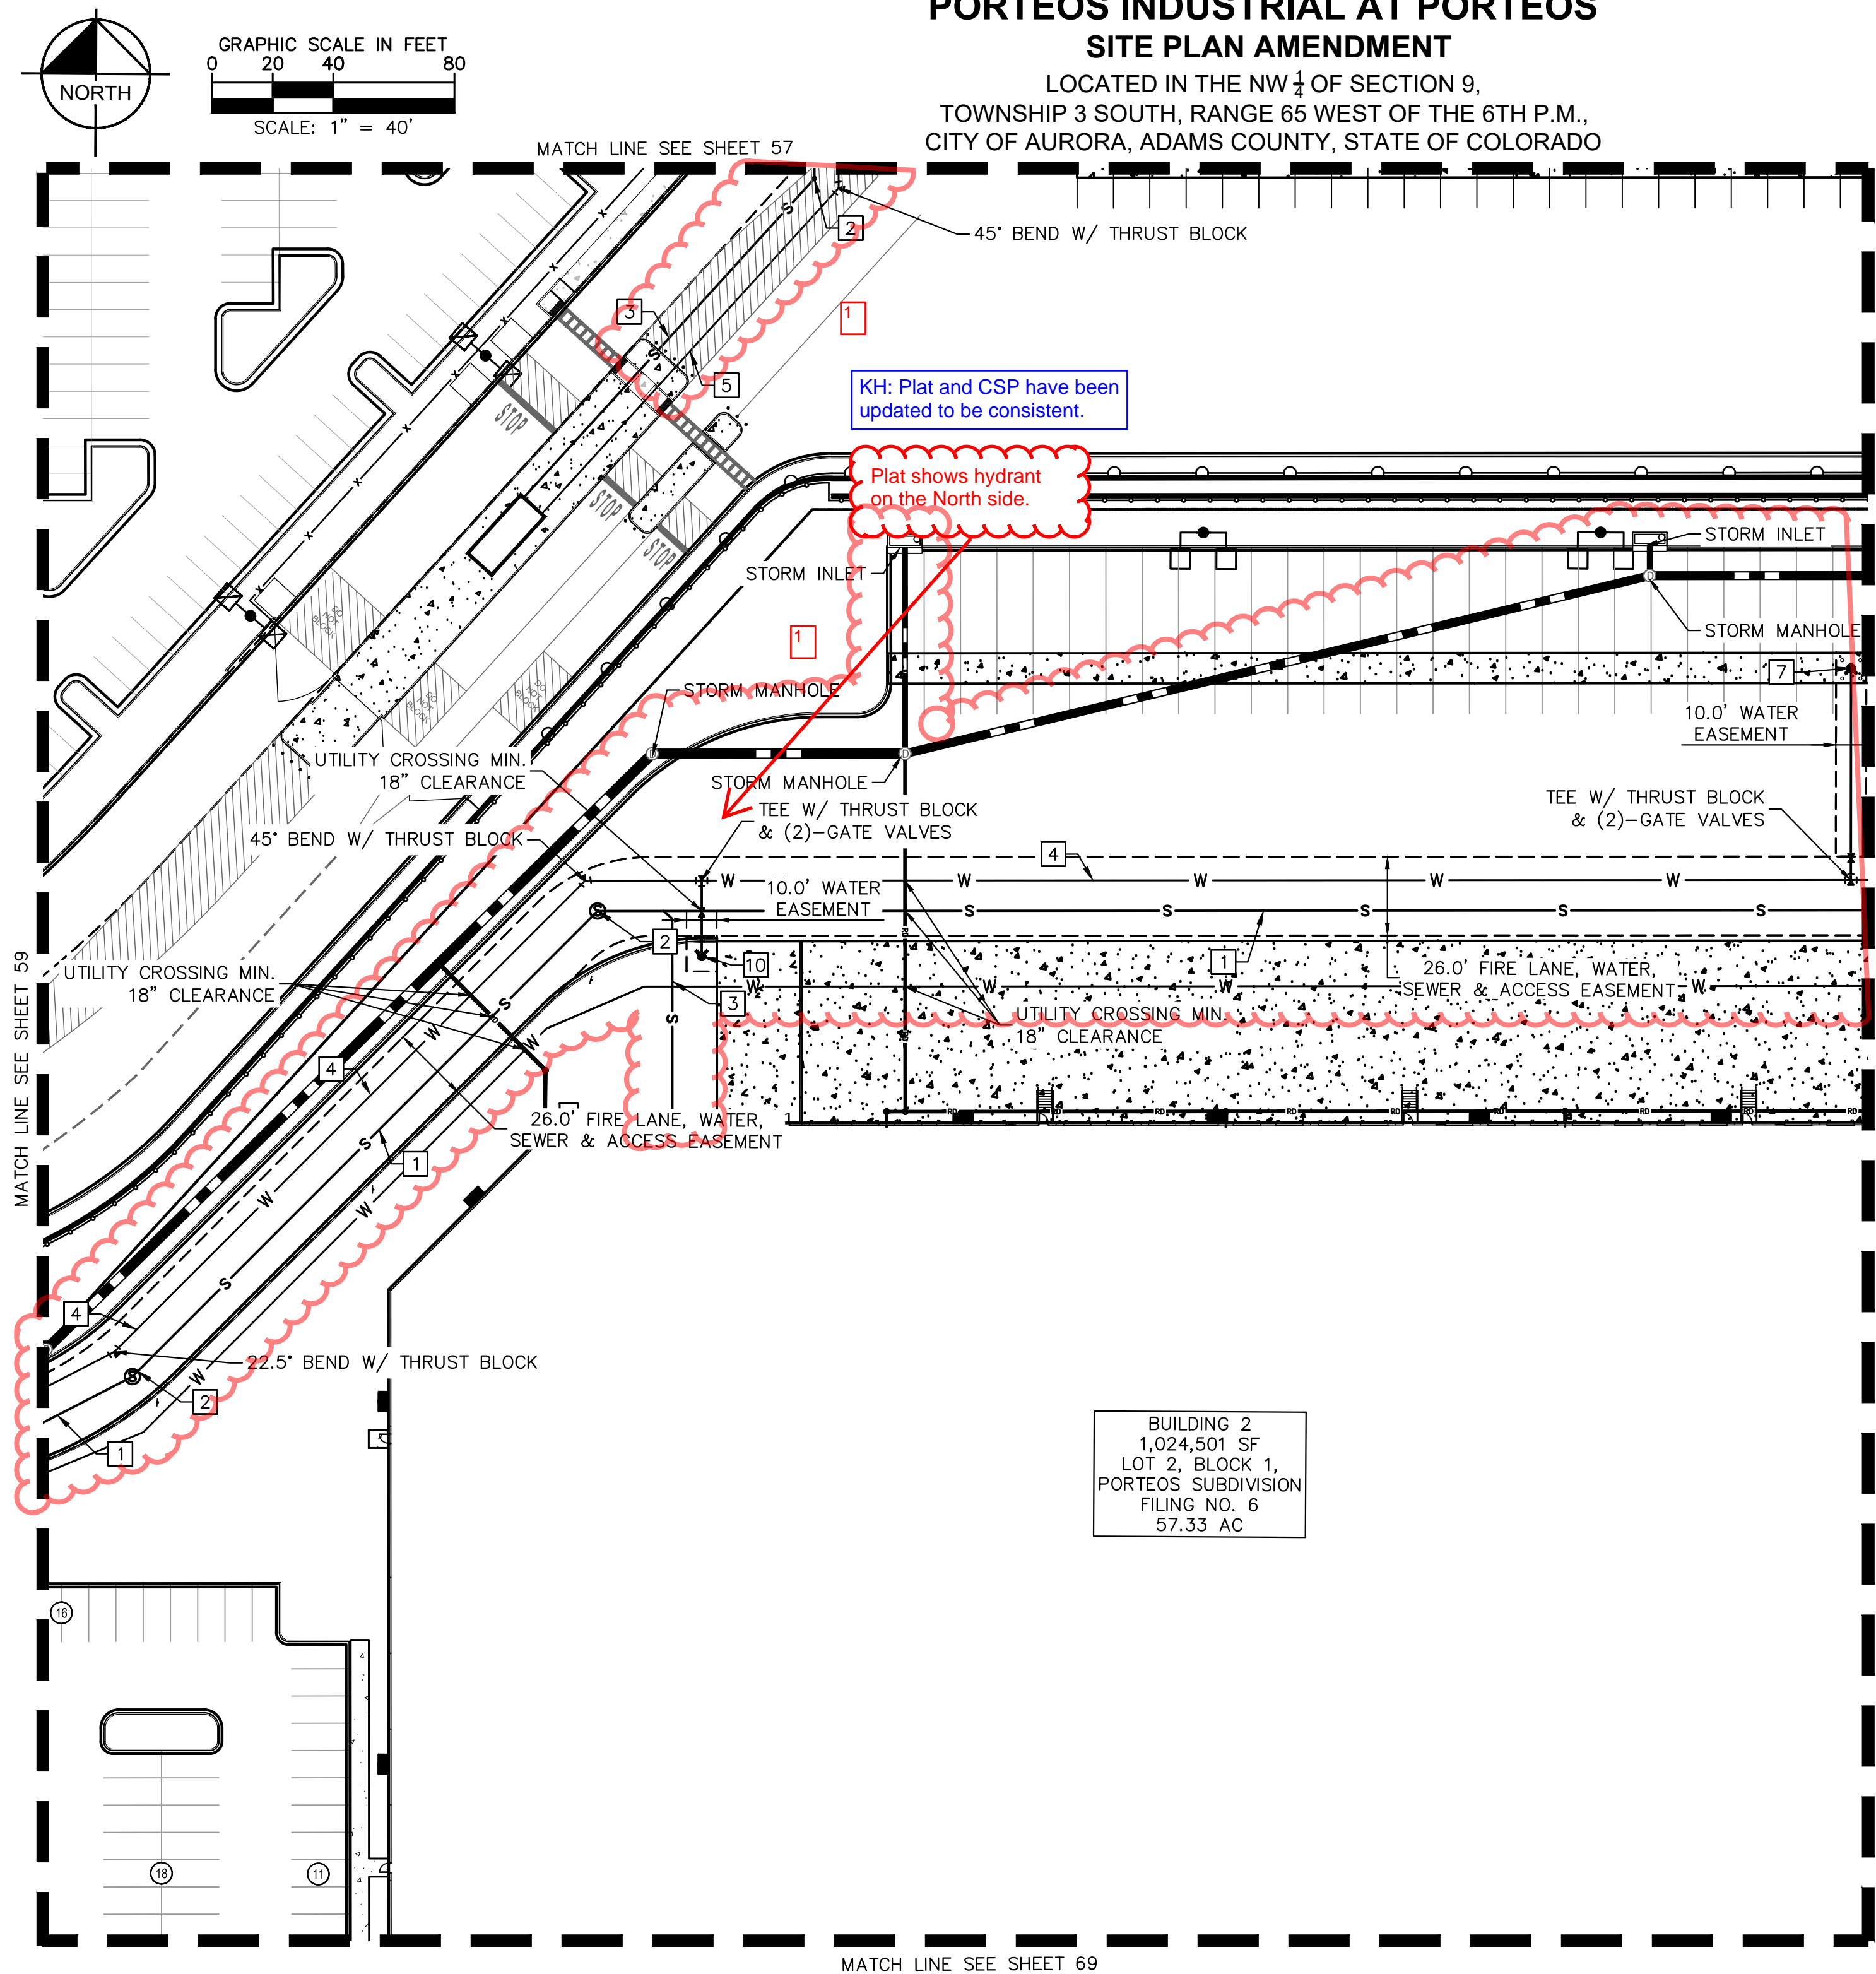


- KEYMAP**
- LEGEND**
- PROPERTY LINE
 - PROPOSED EASEMENT LINE
 - EXISTING EASEMENT LINE
 - EXISTING STORM SEWER
 - PROPOSED STORM SEWER
 - EXISTING WATER LINE
 - PROPOSED WATER LINE
 - PROPOSED WATER METER
 - EXISTING FIRE HYDRANT
 - PROPOSED FIRE HYDRANT ASSEMBLY PER COA STD DETAIL 206
 - PROPOSED GATE VALVE
 - PROPOSED TEE W/ THRUST BLOCK
 - PROPOSED BEND W/ THRUST BLOCK
 - PROPOSED FDC W/ KNOX HARDWARE
 - EXISTING SANITARY SEWER
 - PROPOSED SANITARY SEWER

- UTILITY NOTES**
- PROPOSED SANITARY SEWER PIPE
 - PROPOSED SANITARY SEWER MANHOLE
 - PROPOSED SANITARY SEWER SERVICE LINE
 - PROPOSED WATER MAIN
 - PROPOSED WATER SERVICE LINE
 - PROPOSED FIRE SERVICE LINE
 - PROPOSED FIRE HYDRANT AND BOLLARD ASSEMBLY PER COA STD DETAIL 208
 - PROPOSED FDC W/ APPROVED KNOX HARDWARE
 - PROPOSED KNOX BOX
 - PROPOSED FIRE HYDRANT ASSEMBLY PER COA STD DETAIL 208

NOTE:
1. STORMWATER INFRASTRUCTURE OWNERSHIP SHALL BE DESIGNATED BY THE CONSTRUCTION DOCUMENTS.


FILE NO. 196617002_UT DTL-DA II		DATE: 03/22/2024	PORTEOS INDUSTRIAL AT PORTEOS				Kimley»»Horn							
PROJECT NO. 196617002		DESIGNED BY: CAO DRAWN BY: AGM CHECKED BY: BJC	CITY OF AURORA, COUNTY OF ADAMS SITE PLAN AMENDMENT DETAILED UTILITY PLAN				KIMLEY-HORN AND ASSOCIATES, INC. 6200 S. Syracuse Way #300 Greenwood Village, CO 80111 303 228-2300							
SHEET NO. 60							NO.				REVISION	BY	DATE	APPR

K:\DEN_Civil\196617002 DIA1\CADD\PlanSheets\CSP\196617002_UT DTL-DIA II.dwg OKeeffe, Sam 3/27/2024 7:45 AM


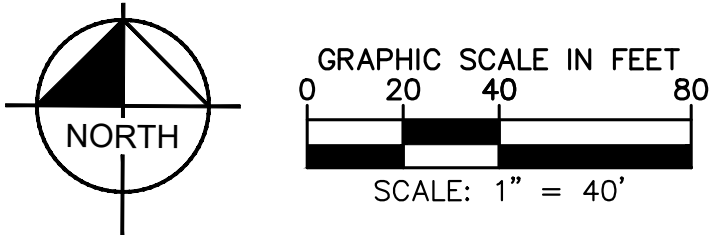


PORTEOS INDUSTRIAL AT PORTEOS SITE PLAN AMENDMENT

LOCATED IN THE NW $\frac{1}{4}$ OF SECTION 9,
TOWNSHIP 3 SOUTH, RANGE 65 WEST OF THE 6TH P.M.,
CITY OF AURORA, ADAMS COUNTY, STATE OF COLORADO

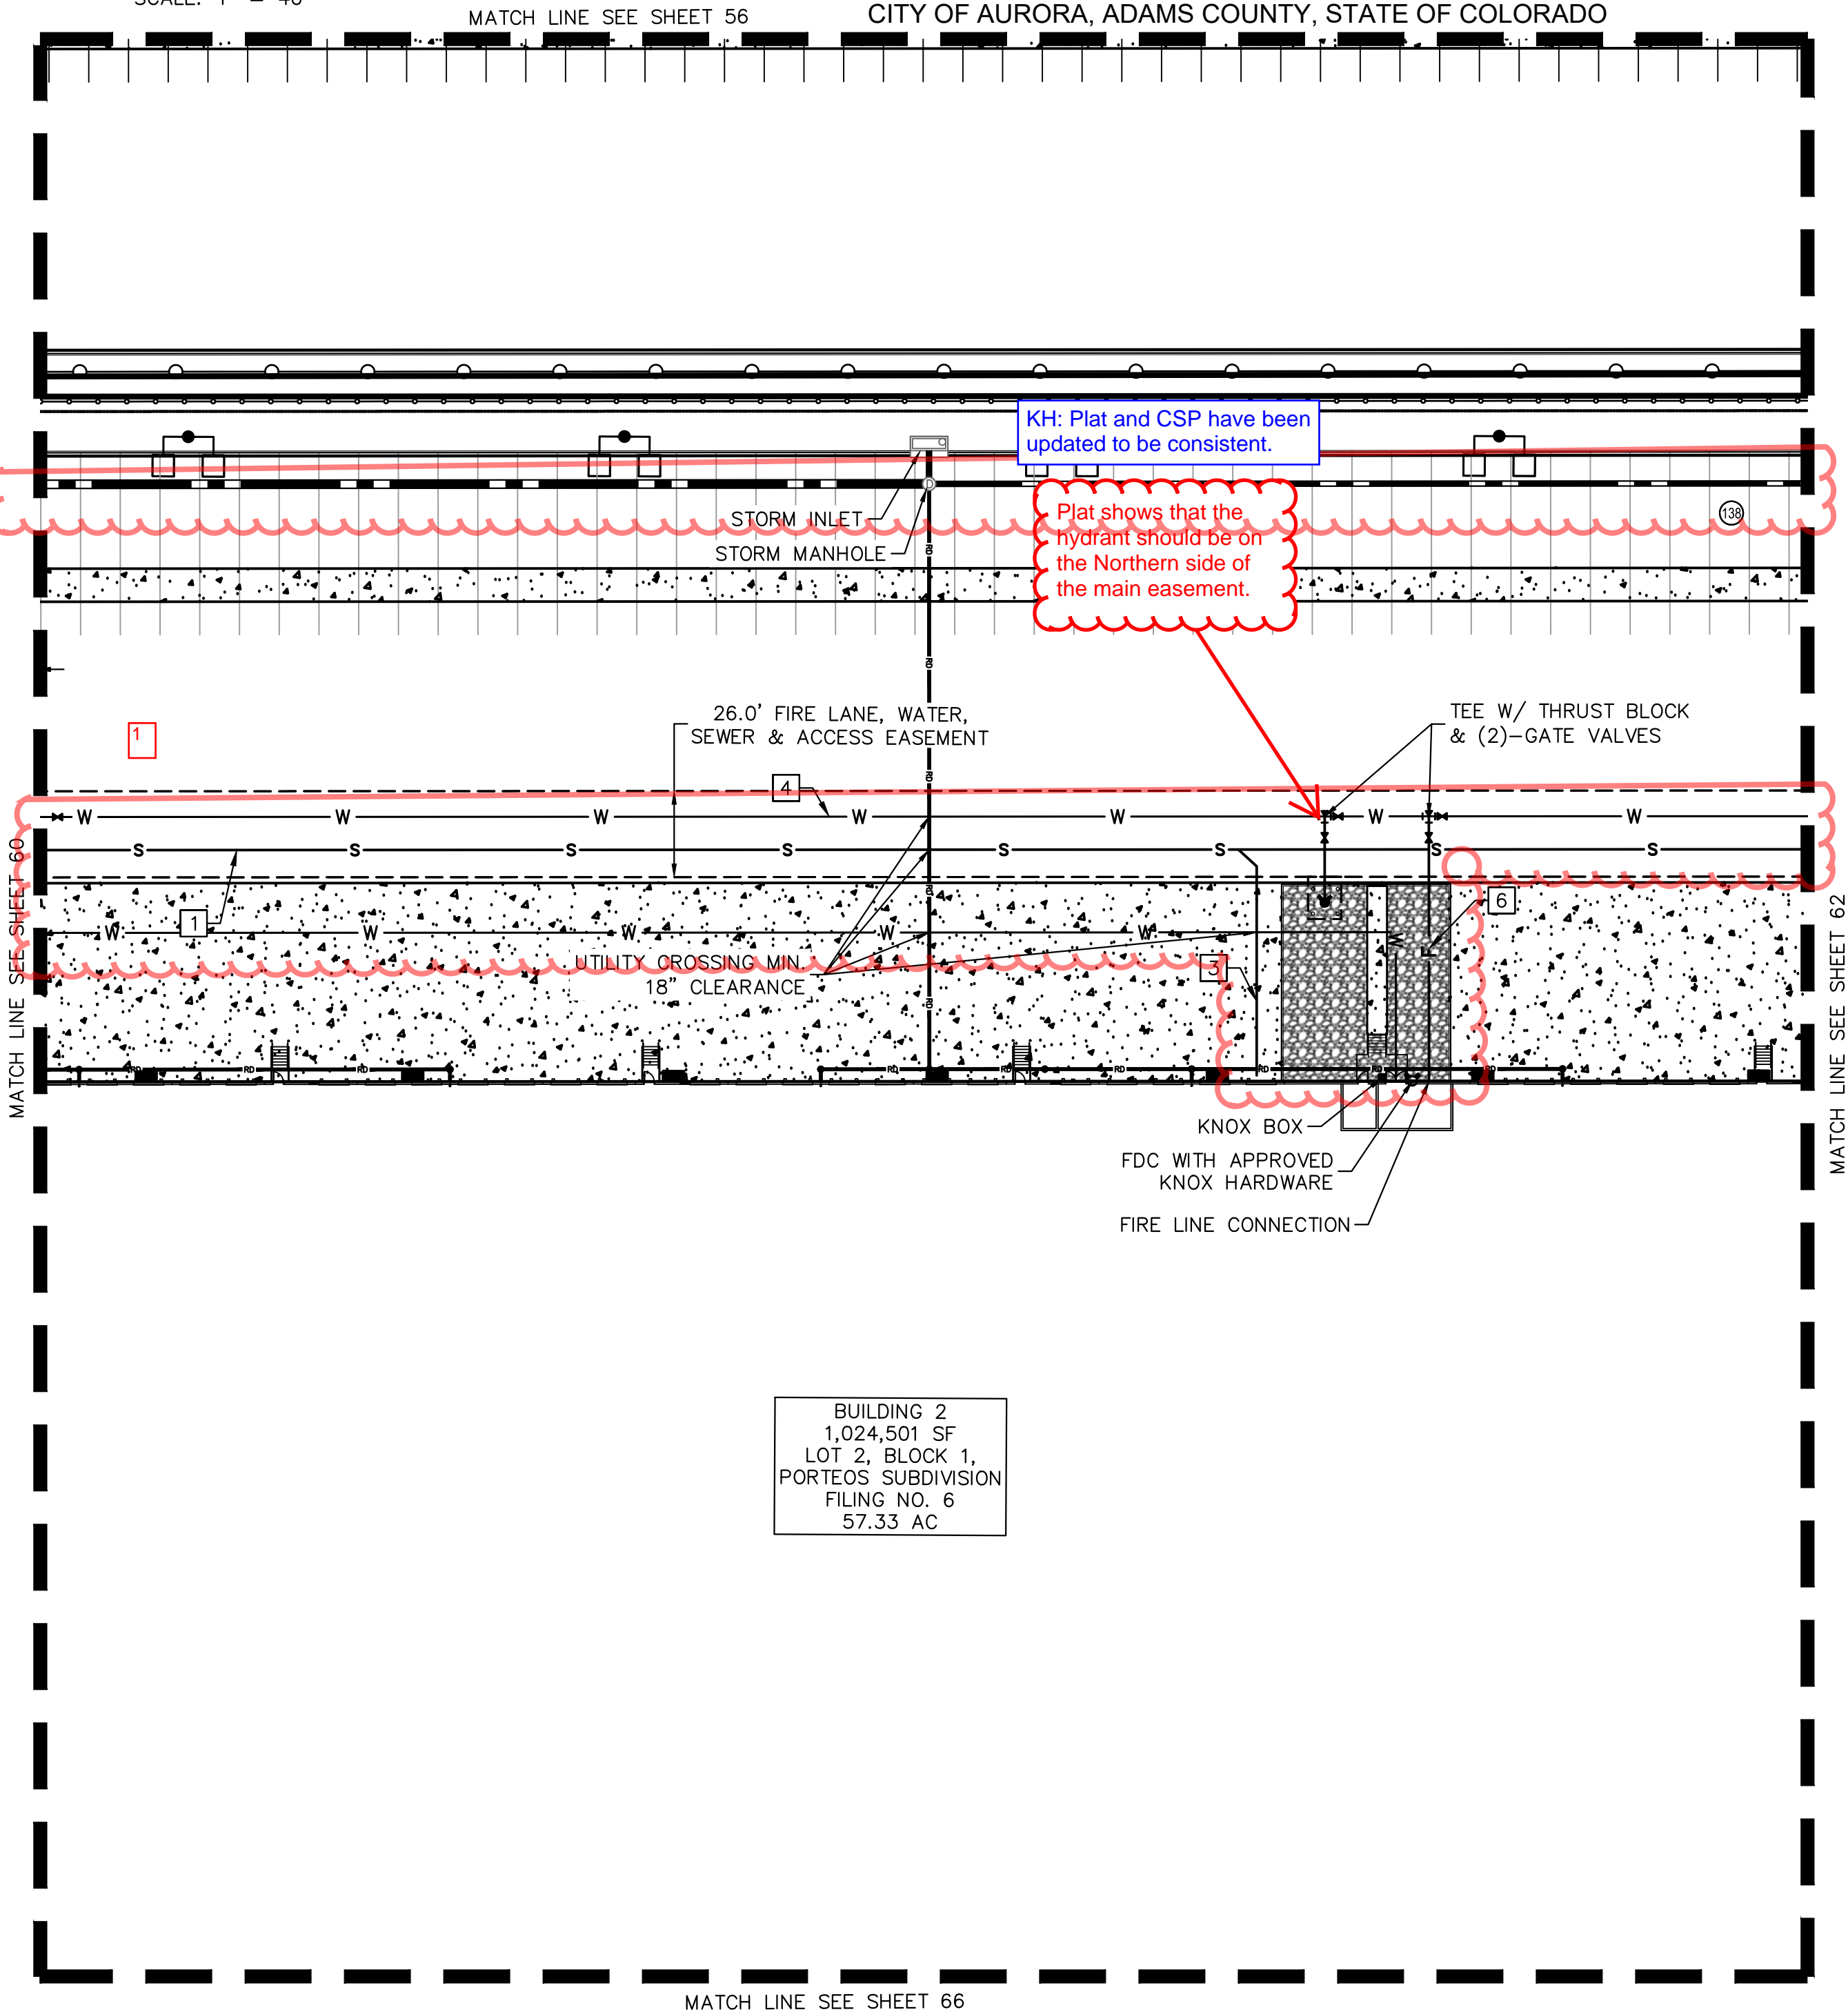

BUILDING 2
1,024,501 SF
LOT 2, BLOCK 1,
PORTEOS SUBDIVISION
FILING NO. 6
57.33 AC

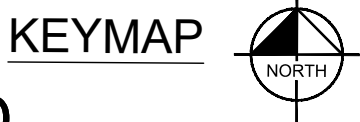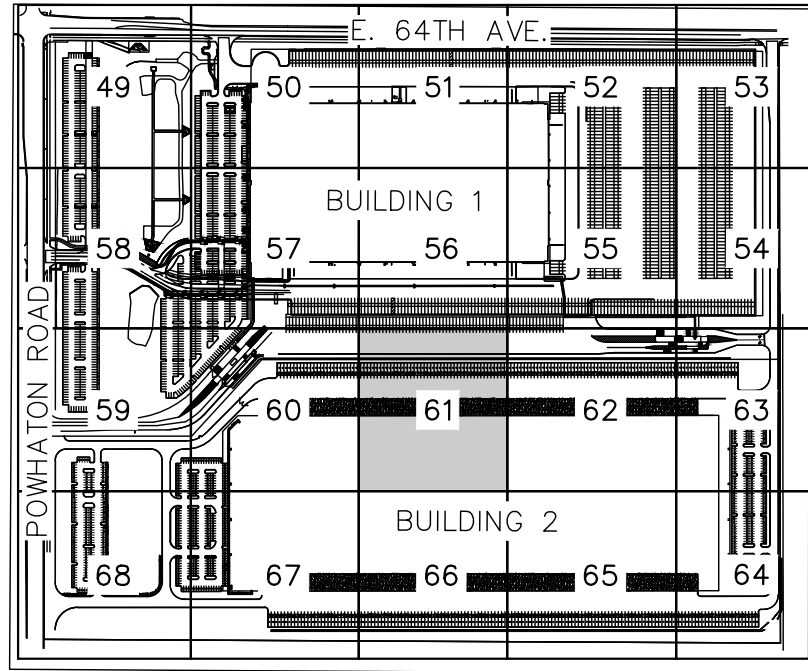

LEGEND

- PROPERTY LINE
- PROPOSED EASEMENT LINE
- EXISTING EASEMENT LINE
- EXISTING STORM SEWER
- PROPOSED STORM SEWER
- EXISTING WATER LINE
- PROPOSED WATER LINE
- PROPOSED WATER METER
- EXISTING FIRE HYDRANT
- PROPOSED FIRE HYDRANT ASSEMBLY PER COA STD DETAIL 206
- PROPOSED GATE VALVE
- PROPOSED TEE W/ THRUST BLOCK
- PROPOSED BEND W/ THRUST BLOCK
- PROPOSED FDC W/ KNOX HARDWARE
- EXISTING SANITARY SEWER
- PROPOSED SANITARY SEWER

UTILITY NOTES

- PROPOSED SANITARY SEWER PIPE
- PROPOSED SANITARY SEWER MANHOLE
- PROPOSED SANITARY SEWER SERVICE LINE
- PROPOSED WATER MAIN
- PROPOSED WATER SERVICE LINE
- PROPOSED FIRE SERVICE LINE
- PROPOSED FIRE HYDRANT AND BOLLARD ASSEMBLY PER COA STD DETAIL 208
- PROPOSED FDC W/ APPROVED KNOX HARDWARE
- PROPOSED KNOX BOX
- PROPOSED FIRE HYDRANT ASSEMBLY PER COA STD DETAIL 208

NOTE:
1. STORMWATER INFRASTRUCTURE OWNERSHIP SHALL BE DESIGNATED BY THE CONSTRUCTION DOCUMENTS.

Kimley»Horn
KIMLEY-HORN AND ASSOCIATES, INC.
6205 S. W. 11th Ave.
Greenwood Village, CO 80111 (303) 228-2300

PORTEOS INDUSTRIAL AT PORTEOS
CITY OF AURORA, COUNTY OF ADAMS
SITE PLAN AMENDMENT
DETAILED UTILITY PLAN


DATE: 03/22/2024
DESIGNED BY: CAO
DRAWN BY: AGM
CHECKED BY: BJC

FILE NO.
196617002_UT DTL-DIA II
PROJECT NO.
196617002

SHEET NO.


NO.	REVISION	BY	DATE	APPROVED

k:\DEN_Civil\196617002 DIA1\CADD\PlanSheets\CSP\196617002_UT DTL-DIA II.dwg OKeeffe, Sam 3/27/2024 7:45 AM

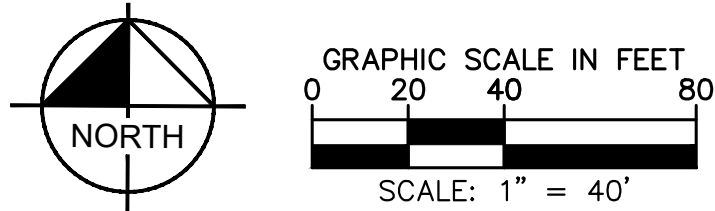

PORTEOS INDUSTRIAL AT PORTEOS SITE PLAN AMENDMENT

LOCATED IN THE NW $\frac{1}{4}$ OF SECTION 9,
TOWNSHIP 3 SOUTH, RANGE 65 WEST OF THE 6TH P.M.,
CITY OF AURORA, ADAMS COUNTY, STATE OF COLORADO

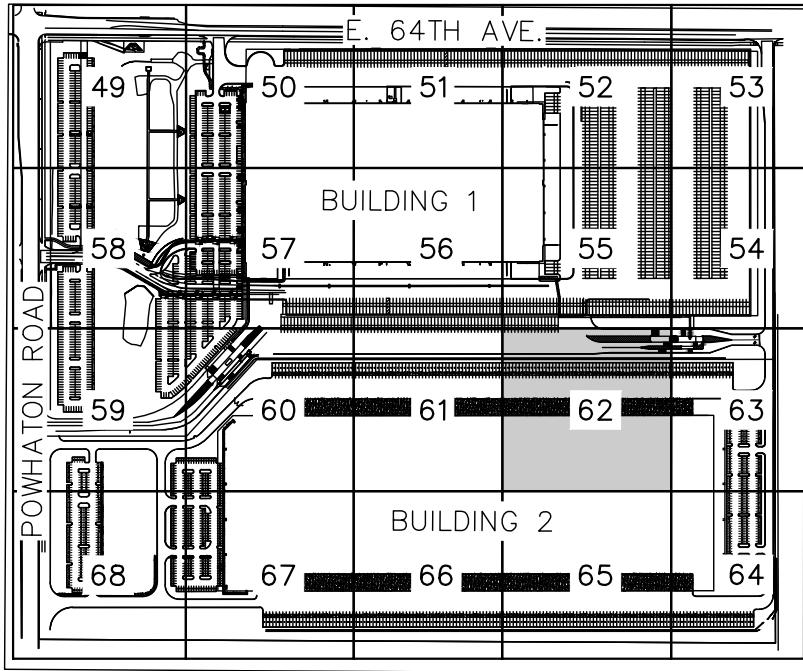

LEGEND

- PROPERTY LINE
- PROPOSED EASEMENT LINE
- EXISTING EASEMENT LINE
- EXISTING STORM SEWER
- PROPOSED STORM SEWER
- EXISTING WATER LINE
- PROPOSED WATER LINE
- PROPOSED WATER METER
- EXISTING FIRE HYDRANT
- PROPOSED FIRE HYDRANT ASSEMBLY PER COA STD DETAIL 206
- PROPOSED GATE VALVE
- PROPOSED TEE W/ THRUST BLOCK
- PROPOSED BEND W/ THRUST BLOCK
- PROPOSED FDC W/ KNOX HARDWARE
- EXISTING SANITARY SEWER
- PROPOSED SANITARY SEWER

UTILITY NOTES

- PROPOSED SANITARY SEWER PIPE
- PROPOSED SANITARY SEWER MANHOLE
- PROPOSED SANITARY SEWER SERVICE LINE
- PROPOSED WATER MAIN
- PROPOSED WATER SERVICE LINE
- PROPOSED FIRE SERVICE LINE
- PROPOSED FIRE HYDRANT AND BOLLARD ASSEMBLY PER COA STD DETAIL 208
- PROPOSED FDC W/ APPROVED KNOX HARDWARE
- PROPOSED KNOX BOX
- PROPOSED FIRE HYDRANT ASSEMBLY PER COA STD DETAIL 208

NOTE:
1. STORMWATER INFRASTRUCTURE OWNERSHIP SHALL BE DESIGNATED BY THE CONSTRUCTION DOCUMENTS.

BUILDING 2
1,024,501 SF
LOT 2, BLOCK 1,
PORTEOS SUBDIVISION
FILING NO. 6
57.33 AC

Kimley»Horn
KIMLEY-HORN AND ASSOCIATES, INC.
6205 S. W. 10TH AVE.
GREENWOOD VILLAGE, CO 80111 (303) 228-2300


PORTEOS INDUSTRIAL AT PORTEOS
CITY OF AURORA, COUNTY OF ADAMS
SITE PLAN AMENDMENT
DETAILED UTILITY PLAN

DATE: 03/22/2024
DESIGNED BY: CAO
DRAWN BY: AGM
CHECKED BY: BJC

FILE NO.
196617002_UT DTL-DIA II
PROJECT NO.
196617002

SHEET NO.

K:\DEN_Civil\196617002 DIA1\CADD\PlanSheets\CSP\196617002_UT DTL-DIA II.dwg OKeeffe, Sam 3/27/2024 7:46 AM

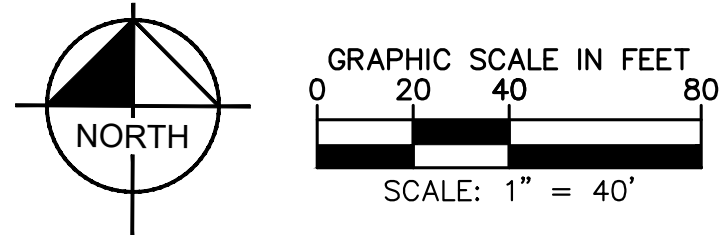

PORTEOS INDUSTRIAL AT PORTEOS SITE PLAN AMENDMENT


LOCATED IN THE NW $\frac{1}{4}$ OF SECTION 9,
TOWNSHIP 3 SOUTH, RANGE 65 WEST OF THE 6TH P.M.,
CITY OF AURORA, ADAMS COUNTY, STATE OF COLORADO

KH: Plat and CSP have been updated to be consistent.

Plat shows hydrant on the North of the main easement. Please be consistent.

TYP: Please provide water main sizes.

KH: Labels have been added for water main size.

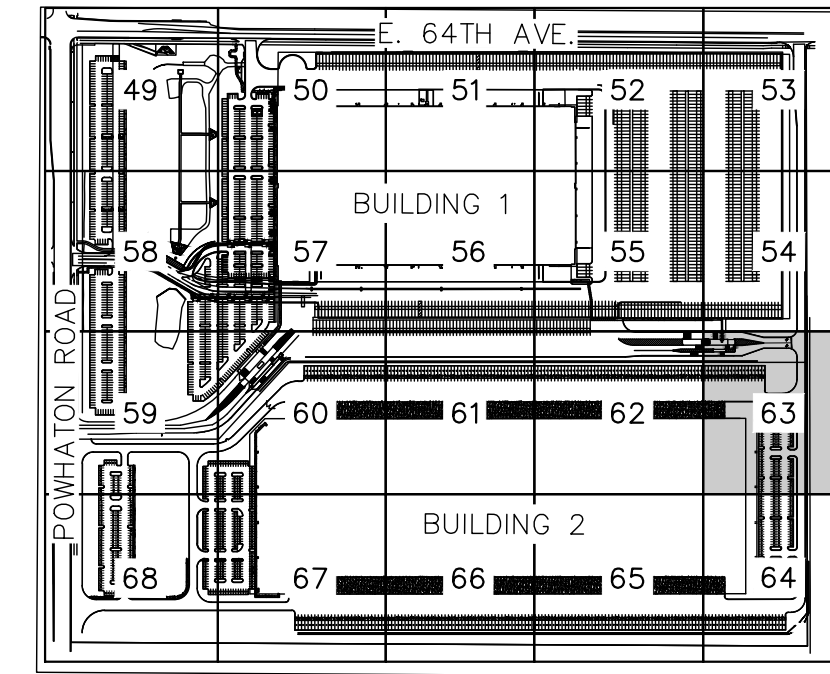

LEGEND

- PROPERTY LINE
- PROPOSED EASEMENT LINE
- EXISTING EASEMENT LINE
- EXISTING STORM SEWER
- PROPOSED STORM SEWER
- EXISTING WATER LINE
- PROPOSED WATER LINE
- PROPOSED WATER METER
- EXISTING FIRE HYDRANT
- PROPOSED FIRE HYDRANT ASSEMBLY PER COA STD DETAIL 206
- PROPOSED GATE VALVE
- PROPOSED TEE W/ THRUST BLOCK
- PROPOSED BEND W/ THRUST BLOCK
- PROPOSED FDC W/ KNOX HARDWARE
- EXISTING SANITARY SEWER
- PROPOSED SANITARY SEWER

UTILITY NOTES

- PROPOSED SANITARY SEWER PIPE
- PROPOSED SANITARY SEWER MANHOLE
- PROPOSED SANITARY SEWER SERVICE LINE
- PROPOSED WATER MAIN
- PROPOSED WATER SERVICE LINE
- PROPOSED FIRE SERVICE LINE
- PROPOSED FIRE HYDRANT AND BOLLARD ASSEMBLY PER COA STD DETAIL 208
- PROPOSED FDC W/ APPROVED KNOX HARDWARE
- PROPOSED KNOX BOX
- PROPOSED FIRE HYDRANT ASSEMBLY PER COA STD DETAIL 208

NOTE:
1. STORMWATER INFRASTRUCTURE OWNERSHIP SHALL BE DESIGNATED BY THE CONSTRUCTION DOCUMENTS.

Kimley»Horn
KIMLEY-HORN AND ASSOCIATES, INC.
6205 S. W. 11th Ave.
Greenwood Village, CO 80111 (303) 228-2300



PORTEOS INDUSTRIAL AT PORTEOS
CITY OF AURORA, COUNTY OF ADAMS
SITE PLAN AMENDMENT
DETAILED UTILITY PLAN

DATE: 03/22/2024
DESIGNED BY: CAO
DRAWN BY: AGM
CHECKED BY: BUC

FILE NO.
196617002_UT DTL-DIA II
PROJECT NO.
196617002



SHEET NO.
61

k:\DEN_Civil\196617002 DIA\CADD\PlanSheets\CSP\196617002_UT DTL-DIA II.dwg OKeeffe, Sam 3/27/2024 7:46 AM

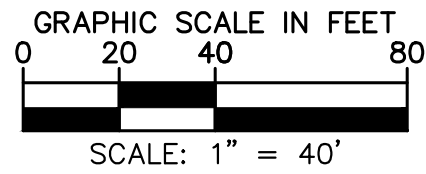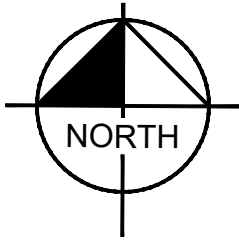

PORTEOS INDUSTRIAL AT PORTEOS SITE PLAN AMENDMENT

LOCATED IN THE NW $\frac{1}{4}$ OF SECTION 9,
TOWNSHIP 3 SOUTH, RANGE 65 WEST OF THE 6TH P.M.,
CITY OF AURORA, ADAMS COUNTY, STATE OF COLORADO

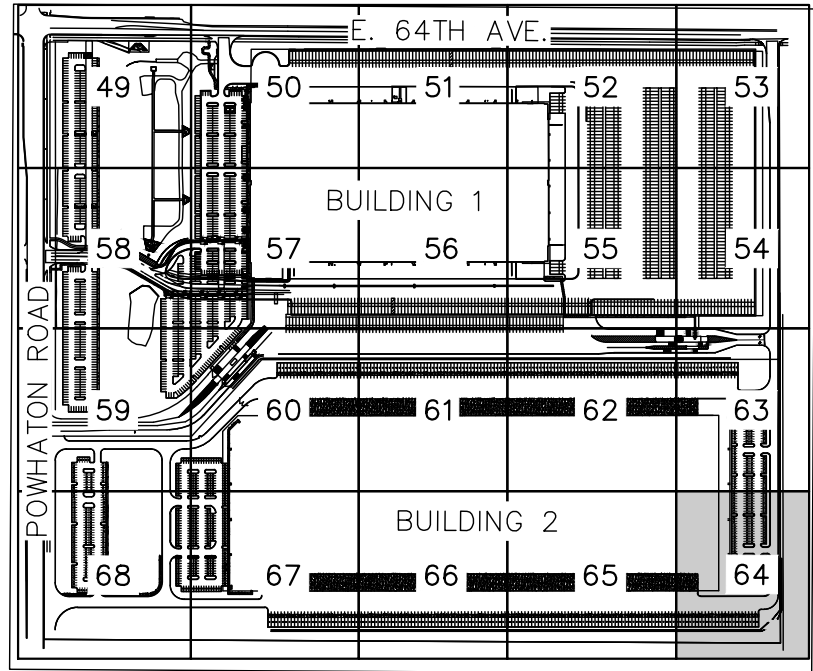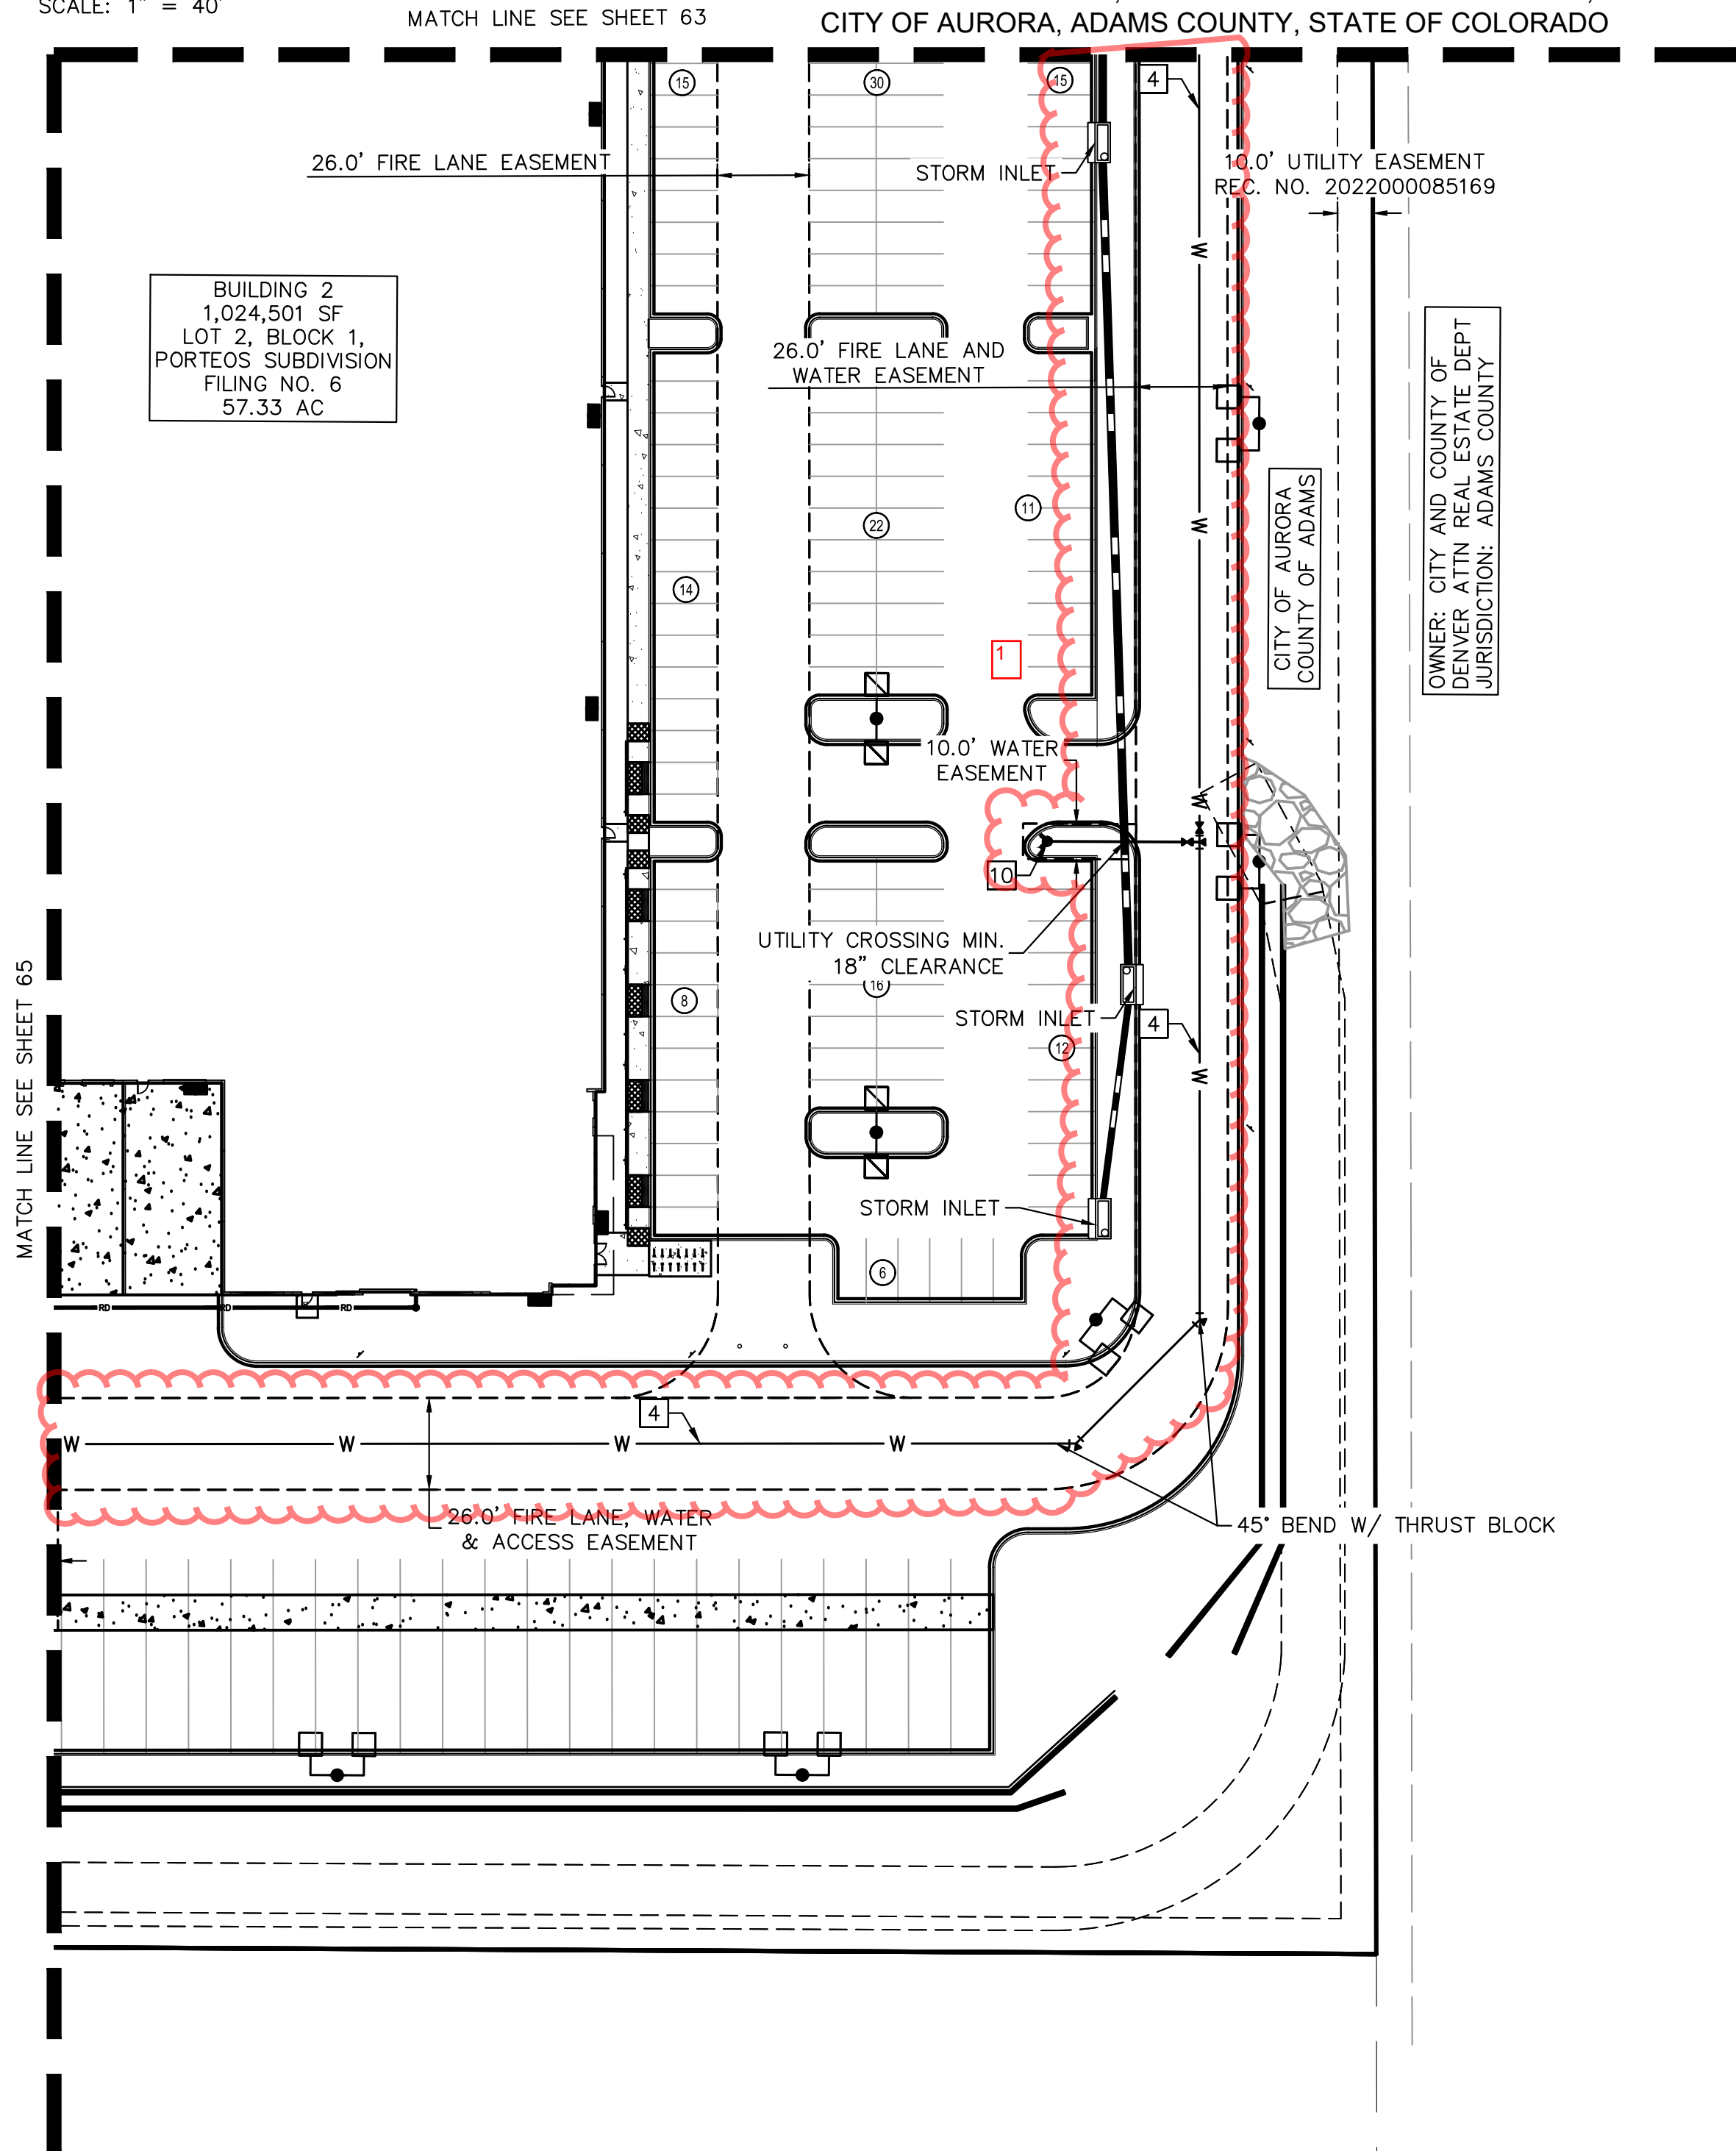

KEYMAP



LEGEND

- PROPERTY LINE
- PROPOSED EASEMENT LINE
- EXISTING EASEMENT LINE
- EXISTING STORM SEWER
- PROPOSED STORM SEWER
- EXISTING WATER LINE
- PROPOSED WATER LINE
- PROPOSED WATER METER
- EXISTING FIRE HYDRANT
- PROPOSED FIRE HYDRANT ASSEMBLY PER COA STD DETAIL 206
- PROPOSED GATE VALVE
- PROPOSED TEE W/ THRUST BLOCK
- PROPOSED BEND W/ THRUST BLOCK
- PROPOSED FDC W/ KNOX HARDWARE
- EXISTING SANITARY SEWER
- PROPOSED SANITARY SEWER

UTILITY NOTES

- 1 PROPOSED SANITARY SEWER PIPE
- 2 PROPOSED SANITARY SEWER MANHOLE
- 3 PROPOSED SANITARY SEWER SERVICE LINE
- 4 PROPOSED WATER MAIN
- 5 PROPOSED WATER SERVICE LINE
- 6 PROPOSED FIRE SERVICE LINE
- 7 PROPOSED FIRE HYDRANT AND BOLLARD ASSEMBLY PER COA STD DETAIL 208
- 8 PROPOSED FDC W/ APPROVED KNOX HARDWARE
- 9 PROPOSED KNOX BOX
- 10 PROPOSED FIRE HYDRANT ASSEMBLY PER COA STD DETAIL 208



NOTE:
1. STORMWATER INFRASTRUCTURE OWNERSHIP SHALL BE DESIGNATED BY THE CONSTRUCTION DOCUMENTS.

CHANG
ES
SO
3/25/24
P369

FILE NO. 196617002_UT DTL-DA II	PROJECT NO. 196617002	DATE 03/22/2024	DESIGNED BY: CAO	DRAWN BY: AGM	CHECKED BY: BJC
SHEET NO. 62		PORTEOS INDUSTRIAL AT PORTEOS CITY OF AURORA, COUNTY OF ADAMS SITE PLAN AMENDMENT DETAILED UTILITY PLAN			
NO.		REVISION	BY	DATE	APPROVED

Kimley»Horn
KIMLEY-HORN AND ASSOCIATES, INC.
6205 S. WATKINS AVE.
GREENWOOD VILLAGE, CO 80111 (303) 228-2300

K:\DEN_Civil\196617002 DIA1\CADD\PlanSheets\CSP\196617002_UT DTL-DIA II.dwg OKeeffe, Sam 3/27/2024 7:47 AM

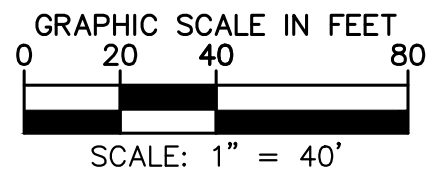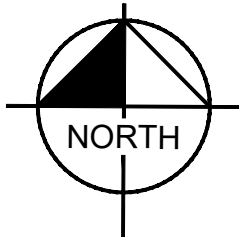

MATCH LINE SEE SHEET 62

PORTEOS INDUSTRIAL AT PORTEOS


SITE PLAN AMENDMENT

LOCATED IN THE NW $\frac{1}{4}$ OF SECTION 9,
TOWNSHIP 3 SOUTH, RANGE 65 WEST OF THE 6TH P.M.,
CITY OF AURORA, ADAMS COUNTY, STATE OF COLORADO


BUILDING 2
1,024,501 SF
LOT 2, BLOCK 1,
PORTEOS SUBDIVISION
FILING NO. 6
57.33 AC

KH: Plat and CSP have been
updated to be consistent.

Plat shows hydrants
alternating North and
South of the main

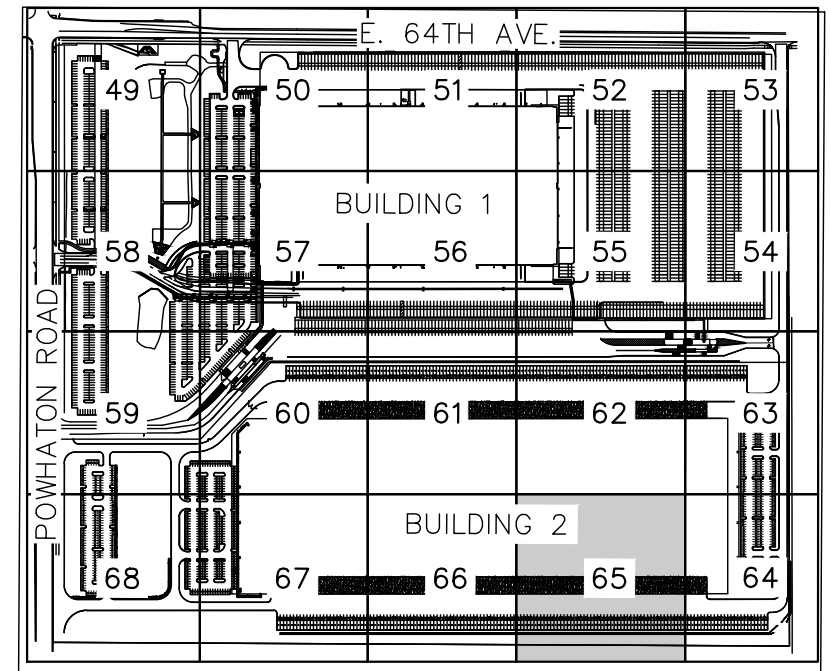

KEYMAP

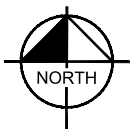

LEGEND

- PROPERTY LINE
- PROPOSED EASEMENT LINE
- EXISTING EASEMENT LINE
- EXISTING STORM SEWER
- PROPOSED STORM SEWER
- EXISTING WATER LINE
- PROPOSED WATER LINE
- PROPOSED WATER METER
- EXISTING FIRE HYDRANT
- PROPOSED FIRE HYDRANT ASSEMBLY
PER COA STD DETAIL 206
- PROPOSED GATE VALVE
- PROPOSED TEE W/ THRUST BLOCK
- PROPOSED BEND W/ THRUST BLOCK
- PROPOSED FDC W/ KNOX HARDWARE
- EXISTING SANITARY SEWER
- PROPOSED SANITARY SEWER

UTILITY NOTES

- PROPOSED SANITARY SEWER PIPE
- PROPOSED SANITARY SEWER MANHOLE
- PROPOSED SANITARY SEWER SERVICE LINE
- PROPOSED WATER MAIN
- PROPOSED WATER SERVICE LINE
- PROPOSED FIRE SERVICE LINE
- PROPOSED FIRE HYDRANT AND BOLLARD
ASSEMBLY PER COA STD DETAIL 208
- PROPOSED FDC W/ APPROVED KNOX HARDWARE
- PROPOSED KNOX BOX
- PROPOSED FIRE HYDRANT ASSEMBLY PER COA
STD DETAIL 208

NOTE:

1. STORMWATER INFRASTRUCTURE OWNERSHIP SHALL BE
DESIGNATED BY THE CONSTRUCTION DOCUMENTS.

Kimley»Horn

KIMLEY-HORN AND ASSOCIATES, INC.
6205 S. W. 11th Ave.
Greenwood Village, CO 80111 (303) 228-2300



PORTEOS INDUSTRIAL AT PORTEOS
CITY OF AURORA, COUNTY OF ADAMS
SITE PLAN AMENDMENT
DETAILED UTILITY PLAN

DATE: 03/22/2024
DESIGNED BY: CAO
DRAWN BY: AGM
CHECKED BY: BJC

FILE NO.
196617002_UT DTL-DIA II
PROJECT NO.
196617002

SHEET NO.

K:\DEN_Civil\196617002 DIA\ CADD\PlanSheets\CSP\196617002_UT DTL-DIA II.dwg OKeeffe, Sam 3/27/2024 7:47 AM

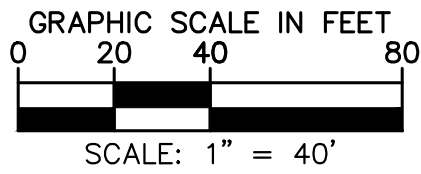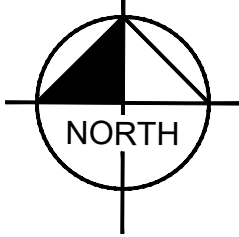

MATCH LINE SEE SHEET 61


PORTEOS INDUSTRIAL AT PORTEOS

SITE PLAN AMENDMENT


LOCATED IN THE NW $\frac{1}{4}$ OF SECTION 9,
TOWNSHIP 3 SOUTH, RANGE 65 WEST OF THE 6TH P.M.,
CITY OF AURORA, ADAMS COUNTY, STATE OF COLORADO

BUILDING 2
1,024,501 SF
LOT 2, BLOCK 1,
PORTEOS SUBDIVISION
FILING NO. 6
57.33 AC

MATCH LINE SEE SHEET 69

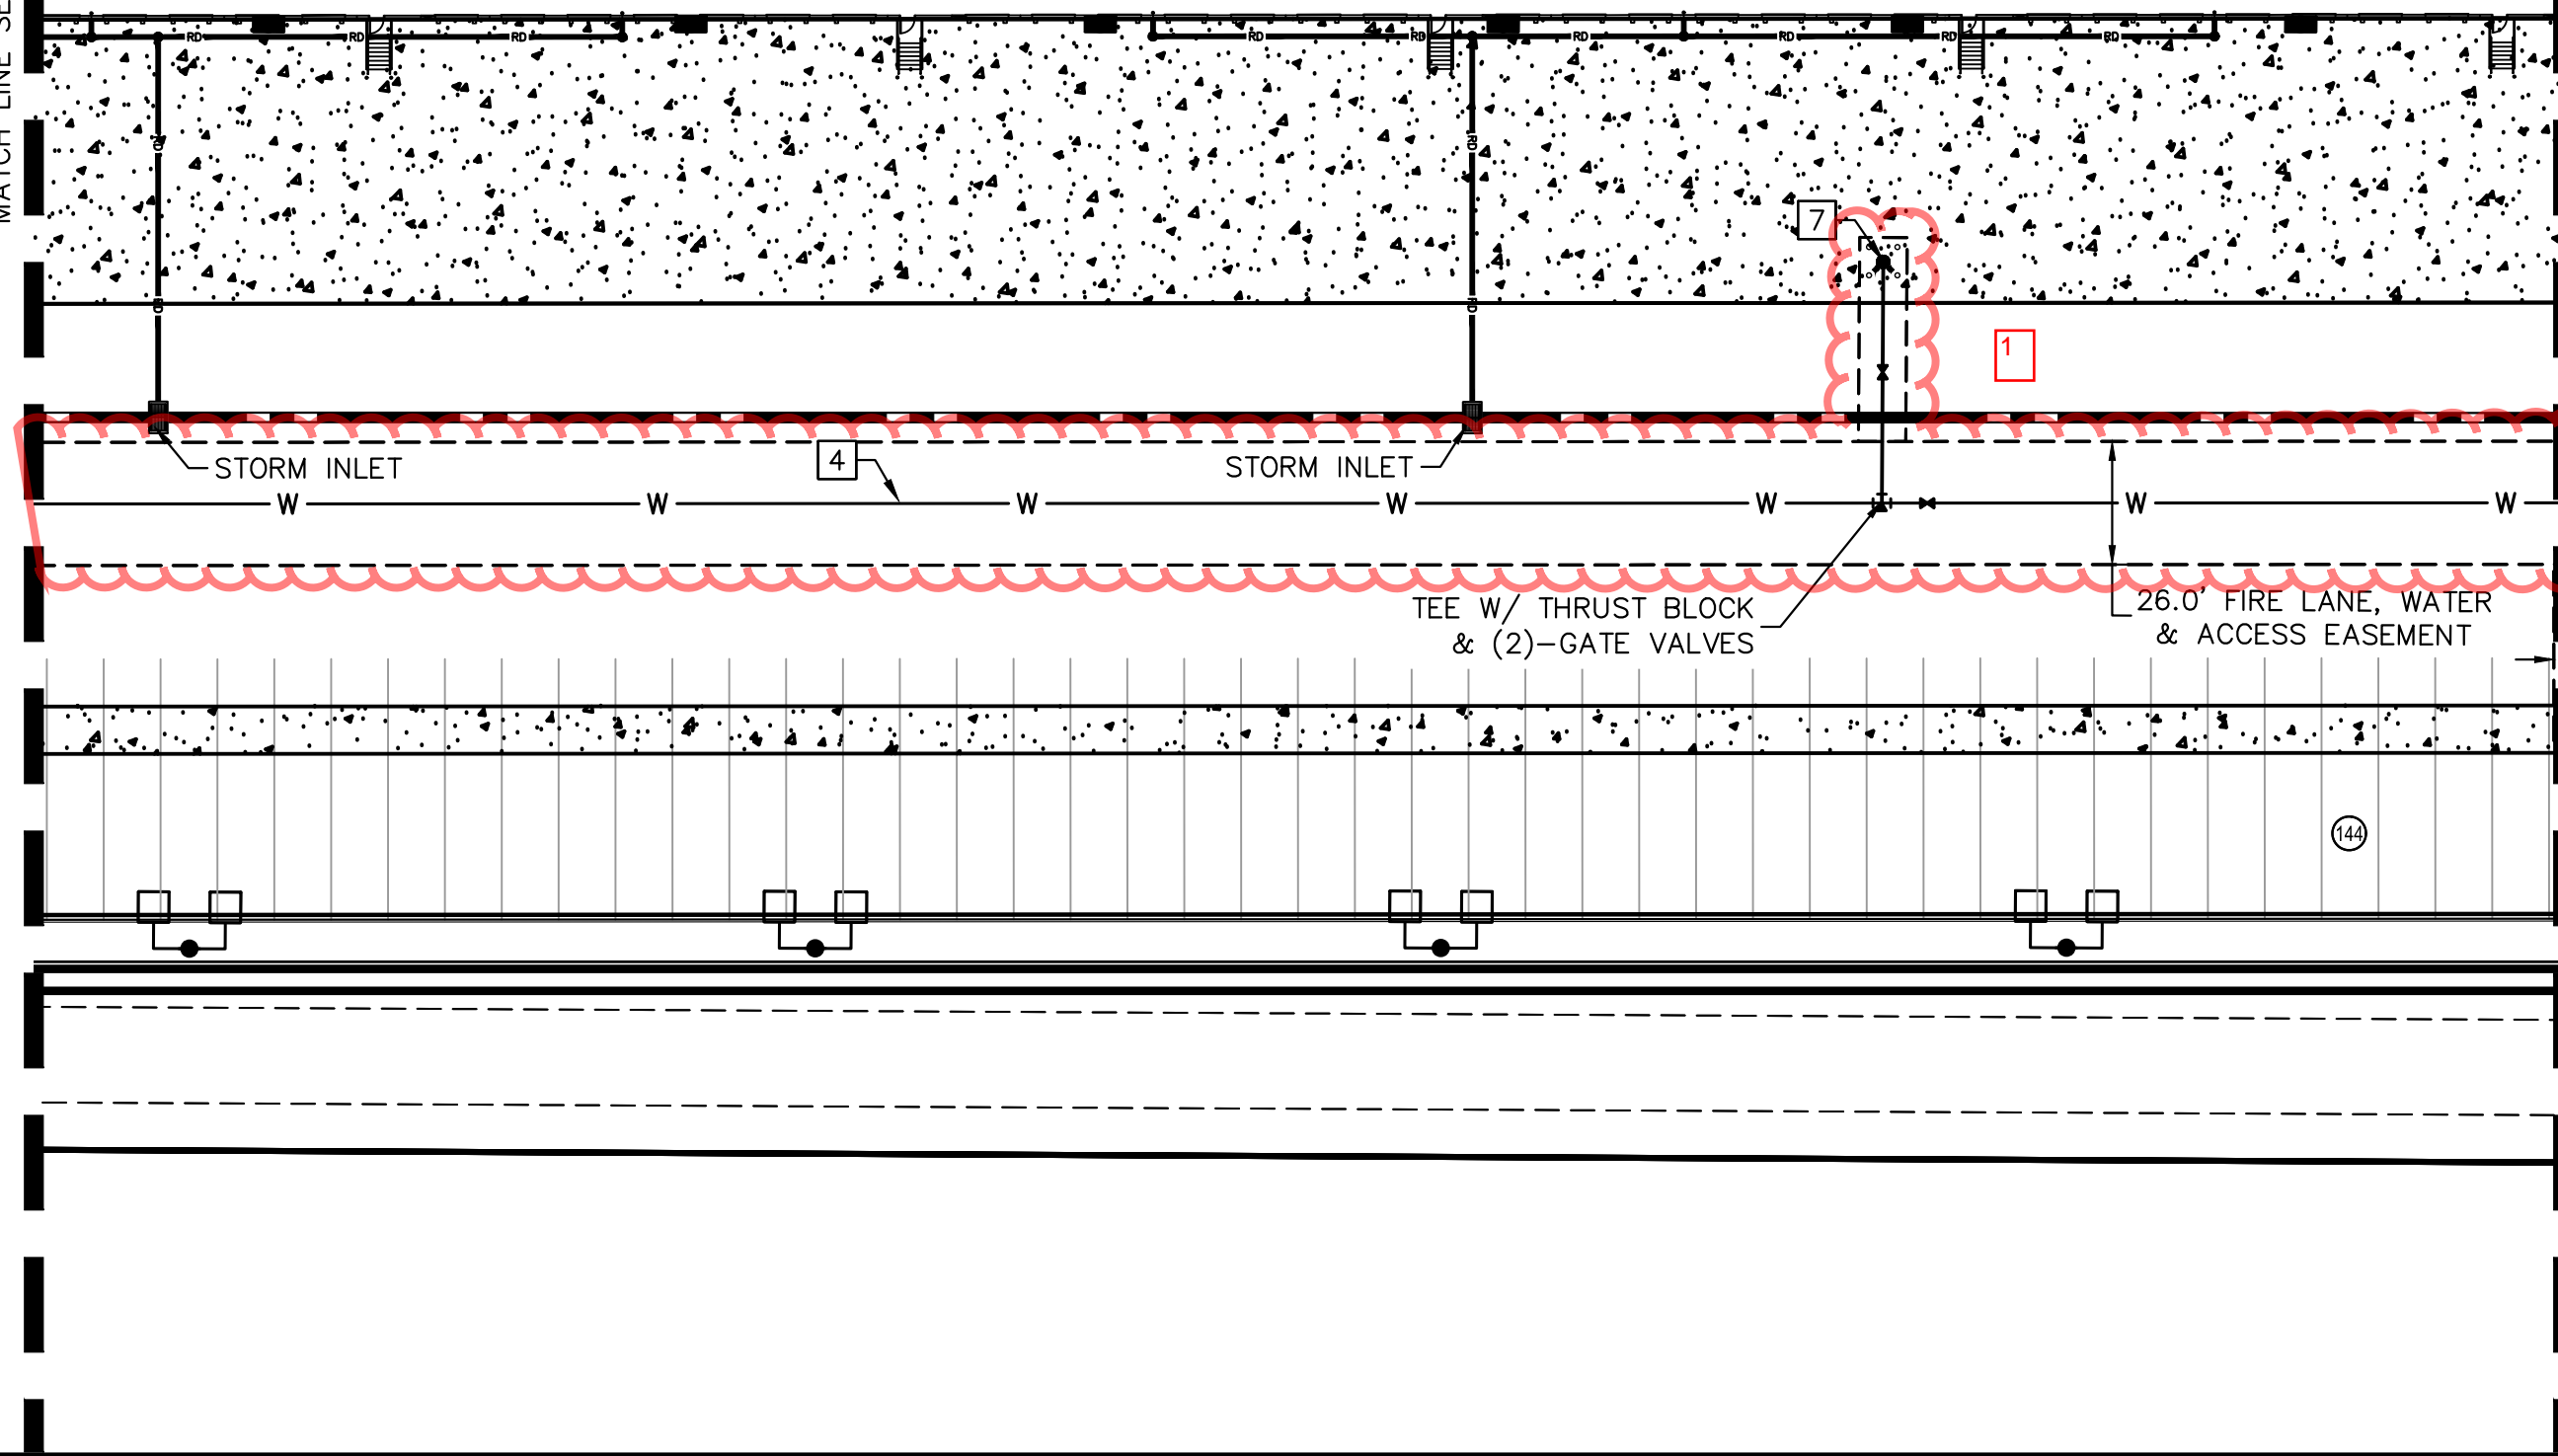

MATCH LINE SEE SHEET 65

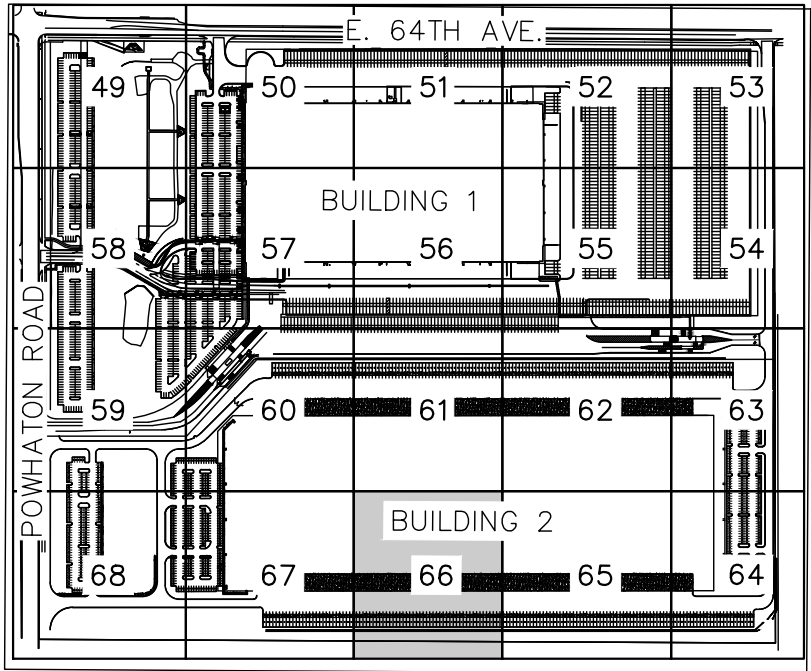

KEYMAP



LEGEND

- PROPERTY LINE
- PROPOSED EASEMENT LINE
- EXISTING EASEMENT LINE
- EXISTING STORM SEWER
- PROPOSED STORM SEWER
- EXISTING WATER LINE
- PROPOSED WATER LINE
- PROPOSED WATER METER
- EXISTING FIRE HYDRANT
- PROPOSED FIRE HYDRANT ASSEMBLY PER COA STD DETAIL 206
- PROPOSED GATE VALVE
- PROPOSED TEE W/ THRUST BLOCK
- PROPOSED BEND W/ THRUST BLOCK
- PROPOSED FDC W/ KNOX HARDWARE
- EXISTING SANITARY SEWER
- PROPOSED SANITARY SEWER

UTILITY NOTES

- PROPOSED SANITARY SEWER PIPE
- PROPOSED SANITARY SEWER MANHOLE
- PROPOSED SANITARY SEWER SERVICE LINE
- PROPOSED WATER MAIN
- PROPOSED WATER SERVICE LINE
- PROPOSED FIRE SERVICE LINE
- PROPOSED FIRE HYDRANT AND BOLLARD ASSEMBLY PER COA STD DETAIL 208
- PROPOSED FDC W/ APPROVED KNOX HARDWARE
- PROPOSED KNOX BOX
- PROPOSED FIRE HYDRANT ASSEMBLY PER COA STD DETAIL 208

NOTE:
1. STORMWATER INFRASTRUCTURE OWNERSHIP SHALL BE DESIGNATED BY THE CONSTRUCTION DOCUMENTS.

Kimley»Horn

KIMLEY-HORN AND ASSOCIATES, INC.
6205 S. W. 11th Ave.
Greenwood Village, CO 80111 (303) 228-2300


PORTEOS INDUSTRIAL AT PORTEOS
CITY OF AURORA, COUNTY OF ADAMS
SITE PLAN AMENDMENT
DETAILED UTILITY PLAN

DATE: 03/22/2024
DESIGNED BY: CAO
DRAWN BY: AGM
CHECKED BY: BUC

FILE NO.
196617002_UT DTL-DIA II
PROJECT NO.
196617002

SHEET NO.

K:\DEN_Civil\196617002 DIA1\CADD\PlanSheets\CSP\196617002_UT DTL-DIA II.dwg OKeeffe, Sam 3/27/2024 7:47 AM

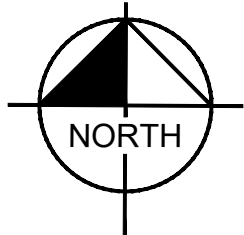

GRAPHIC SCALE IN FEET
0 20 40 80
SCALE: 1" = 40'

PORTEOS INDUSTRIAL AT PORTEOS SITE PLAN AMENDMENT

LOCATED IN THE NW $\frac{1}{4}$ OF SECTION 9,
TOWNSHIP 3 SOUTH, RANGE 65 WEST OF THE 6TH P.M.,
CITY OF AURORA, ADAMS COUNTY, STATE OF COLORADO

MATCH LINE SEE SHEET 60

BUILDING 2
1,024,501 SF
LOT 2, BLOCK 1,
PORTEOS SUBDIVISION
FILING NO. 6
57.33 AC

23.0' FIRE LANE
EASEMENT

10.0' WATER
EASEMENT


TEE W/ THRUST BLOCK
& (2)-GATE VALVES

26.0' FIRE LANE, WATER
& ACCESS EASEMENT


10.0' WATER
EASEMENT

TEE W/ THRUST BLOCK
& (2)-GATE VALVES

STORM INLET

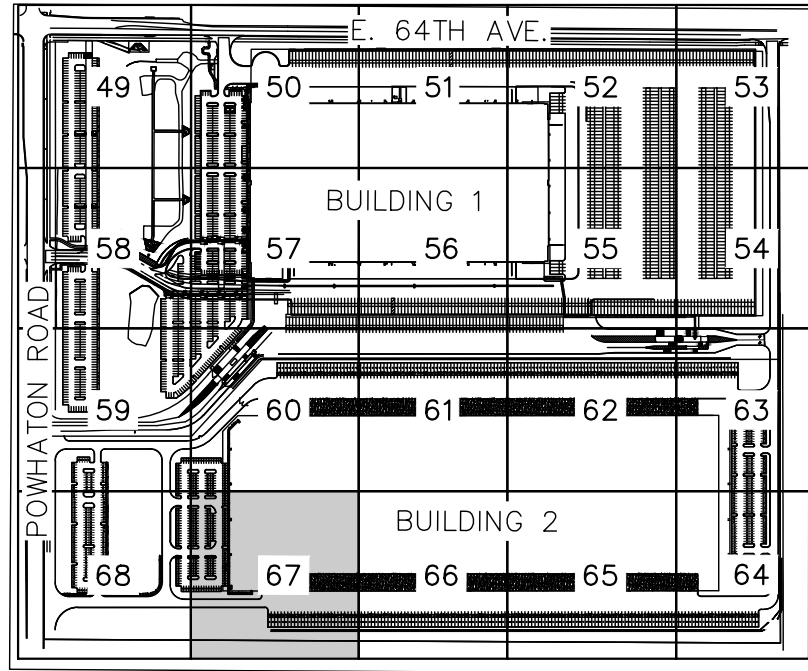

KEYMAP

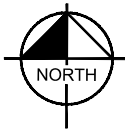

LEGEND

- PROPERTY LINE
- PROPOSED EASEMENT LINE
- EXISTING EASEMENT LINE
- EXISTING STORM SEWER
- PROPOSED STORM SEWER
- EXISTING WATER LINE
- PROPOSED WATER LINE
- PROPOSED WATER METER
- EXISTING FIRE HYDRANT
- PROPOSED FIRE HYDRANT ASSEMBLY PER COA STD DETAIL 206
- PROPOSED GATE VALVE
- PROPOSED TEE W/ THRUST BLOCK
- PROPOSED BEND W/ THRUST BLOCK
- PROPOSED FDC W/ KNOX HARDWARE
- EXISTING SANITARY SEWER
- PROPOSED SANITARY SEWER

UTILITY NOTES

- PROPOSED SANITARY SEWER PIPE
- PROPOSED SANITARY SEWER MANHOLE
- PROPOSED SANITARY SEWER SERVICE LINE
- PROPOSED WATER MAIN
- PROPOSED WATER SERVICE LINE
- PROPOSED FIRE SERVICE LINE
- PROPOSED FIRE HYDRANT AND BOLLARD ASSEMBLY PER COA STD DETAIL 208
- PROPOSED FDC W/ APPROVED KNOX HARDWARE
- PROPOSED KNOX BOX
- PROPOSED FIRE HYDRANT ASSEMBLY PER COA STD DETAIL 208

NOTE:
1. STORMWATER INFRASTRUCTURE OWNERSHIP SHALL BE DESIGNATED BY THE CONSTRUCTION DOCUMENTS.

Kimley»Horn
KIMLEY-HORN AND ASSOCIATES, INC.
6205 S. W. 11th Ave.
Greenwood Village, CO 80111 (303) 228-2300



PORTEOS INDUSTRIAL AT PORTEOS
CITY OF AURORA, COUNTY OF ADAMS
SITE PLAN AMENDMENT
DETAILED UTILITY PLAN

DATE: 03/22/2024
DESIGNED BY: CAO
DRAWN BY: AGM
CHECKED BY: BJC

FILE NO.
196617002_UT DTL-DIA II
PROJECT NO.
196617002

SHEET NO.



K:\DEN_Civil\196617002 DIA\CADD\PlanSheets\CSP\196617002_UT DTL-DIA II.dwg Cooney, Brad 3/27/2024 2:48 PM

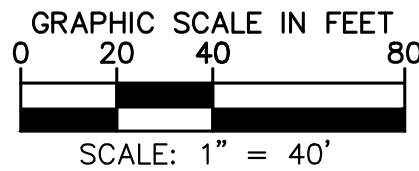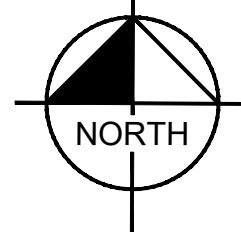


PORTEOS INDUSTRIAL AT PORTEOS

SITE PLAN AMENDMENT

LOCATED IN THE NW $\frac{1}{4}$ OF SECTION 9,
TOWNSHIP 3 SOUTH, RANGE 65 WEST OF THE 6TH P.M.,
CITY OF AURORA, ADAMS COUNTY, STATE OF COLORADO

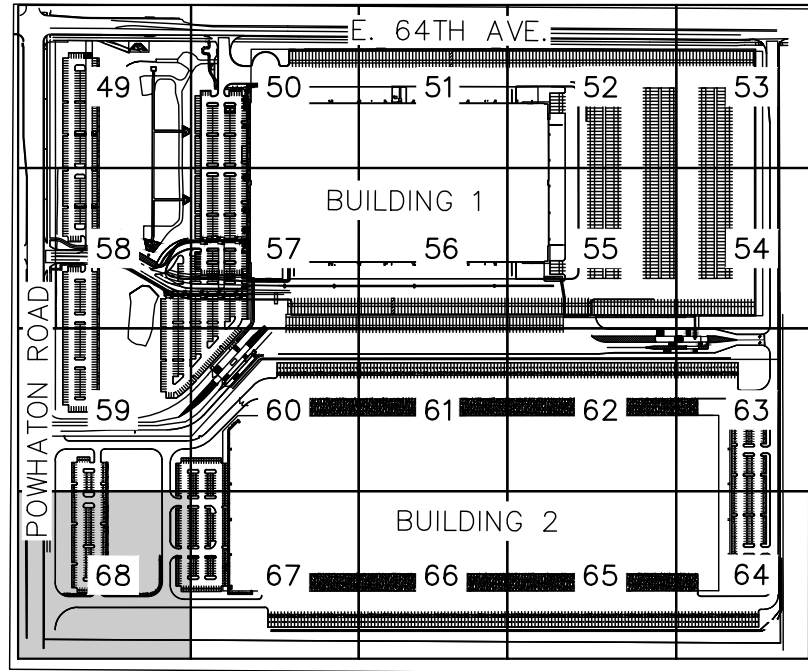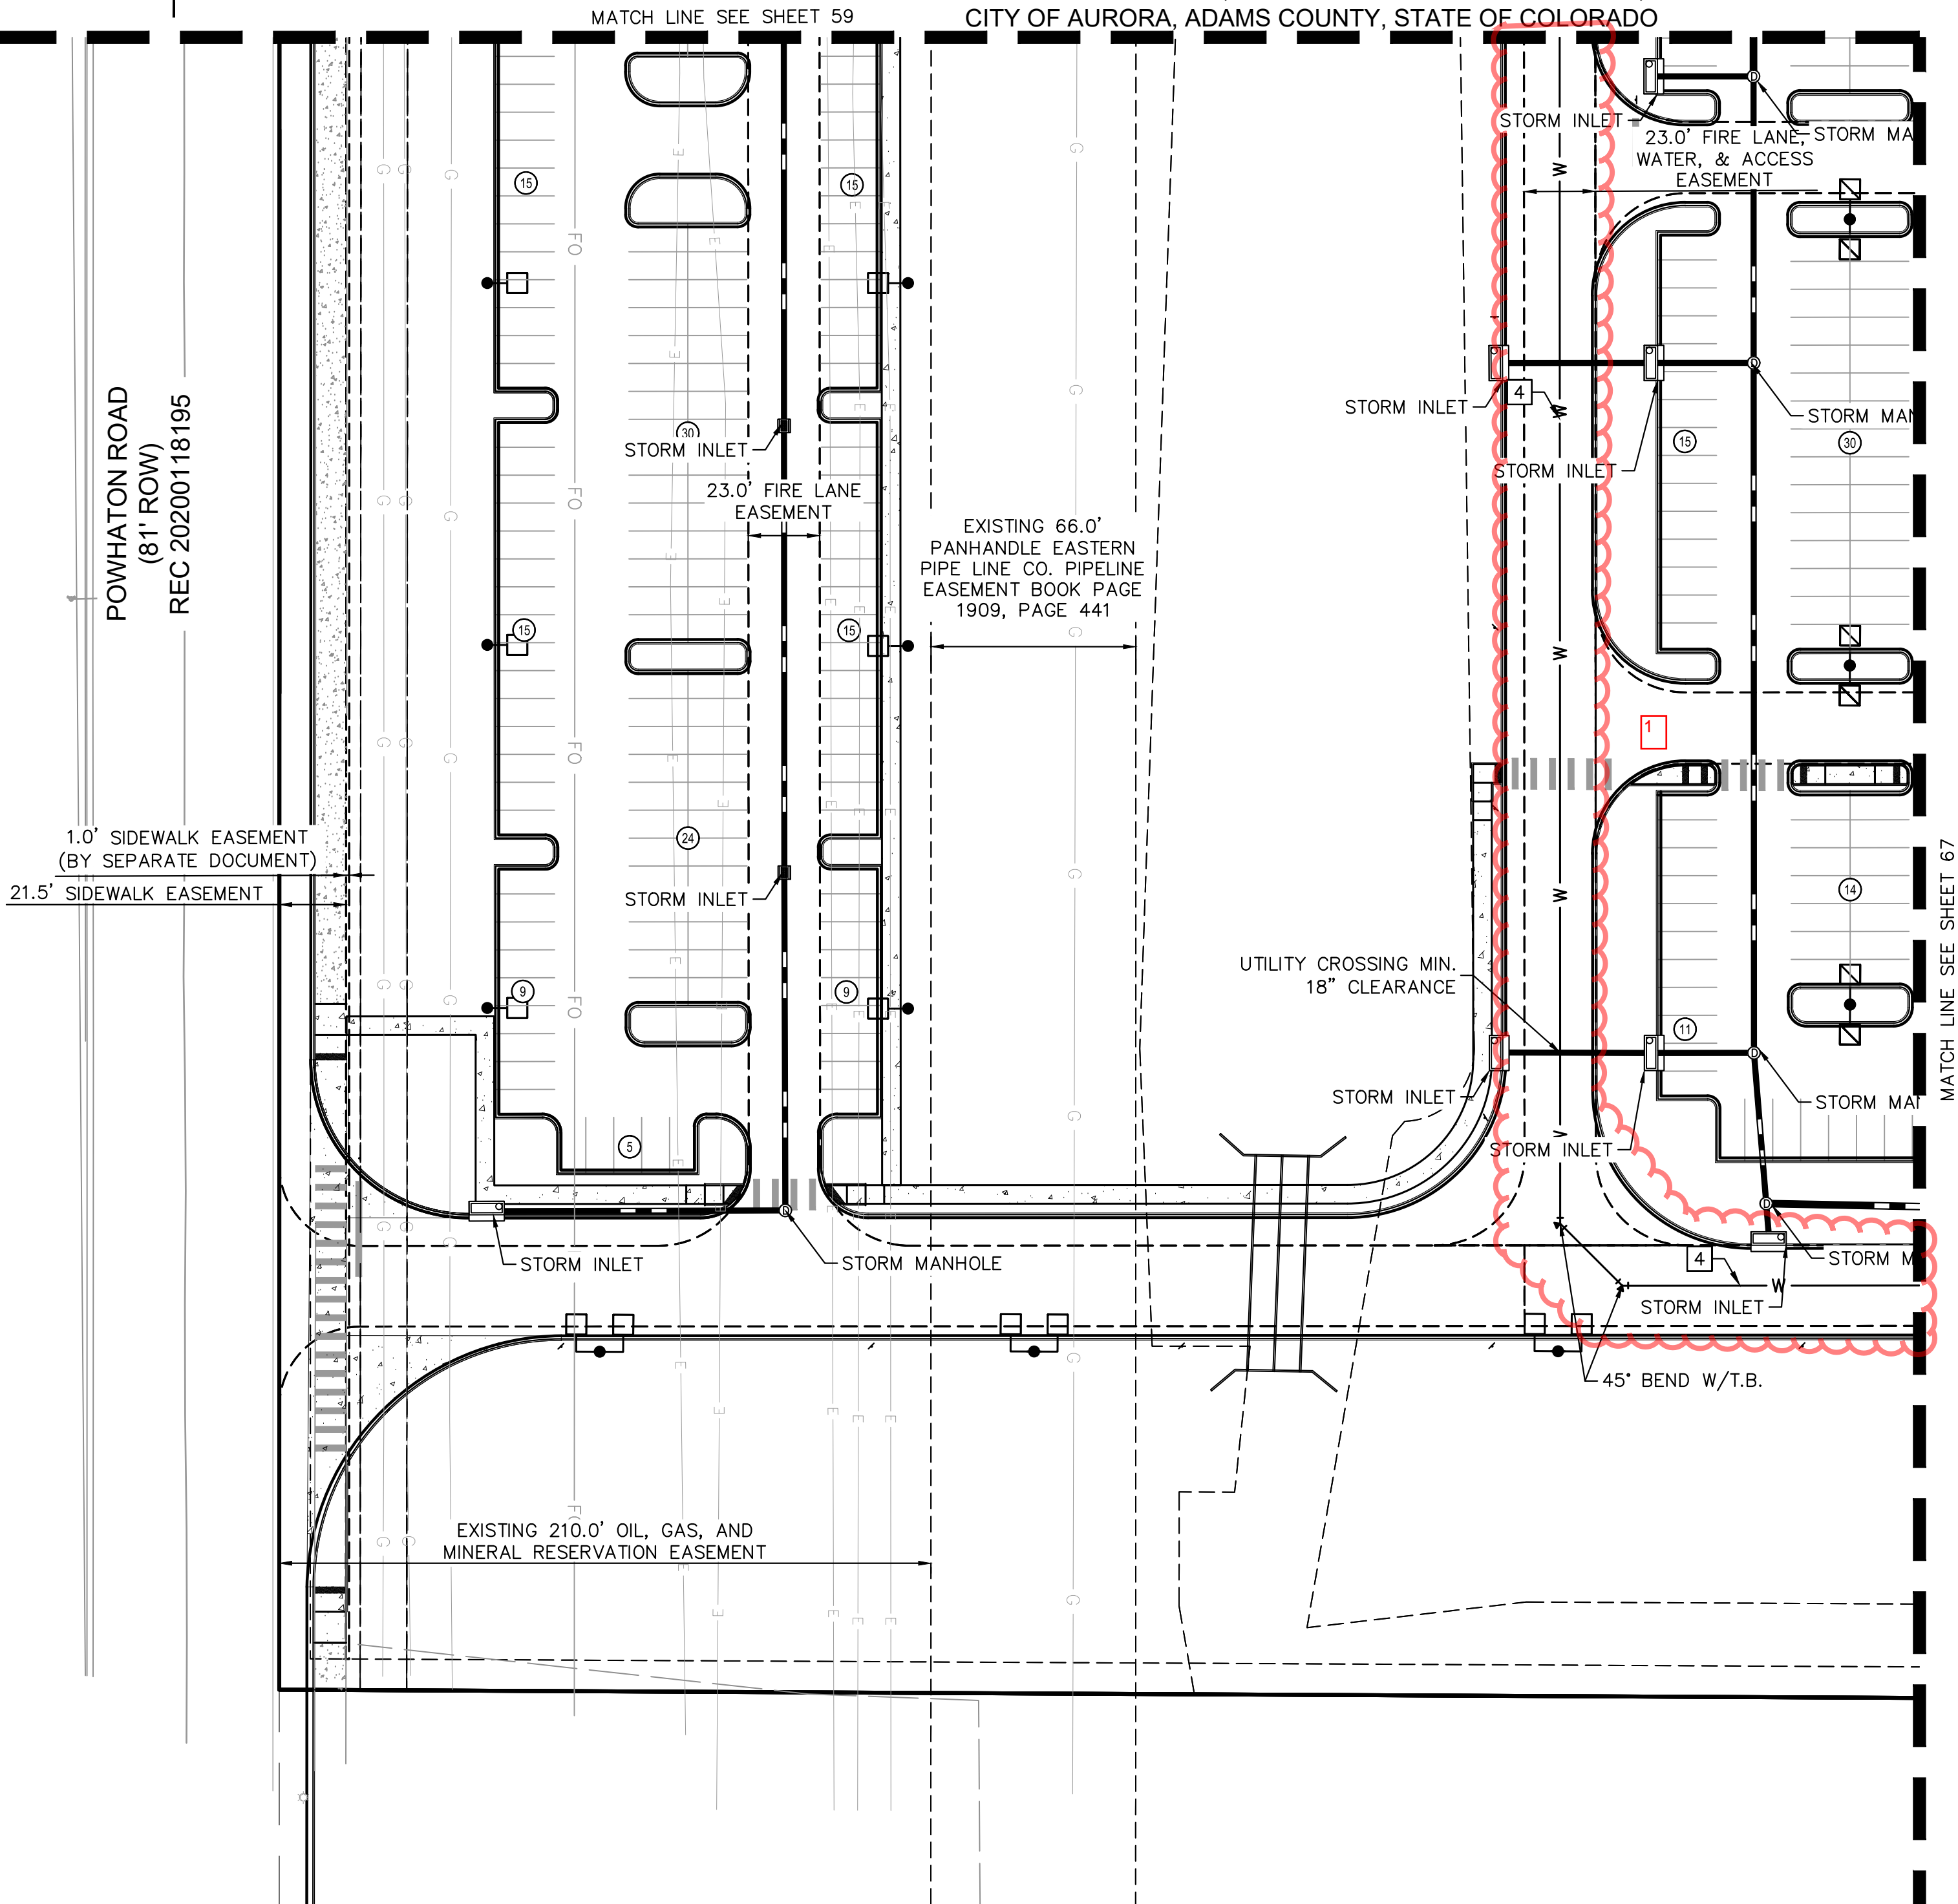

KEYMAP

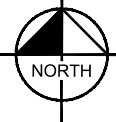

LEGEND

- PROPERTY LINE
- PROPOSED EASEMENT LINE
- EXISTING EASEMENT LINE
- EXISTING STORM SEWER
- PROPOSED STORM SEWER
- EXISTING WATER LINE
- PROPOSED WATER LINE
- PROPOSED WATER METER
- EXISTING FIRE HYDRANT
- PROPOSED FIRE HYDRANT ASSEMBLY PER COA STD DETAIL 206
- PROPOSED GATE VALVE
- PROPOSED TEE W/ THRUST BLOCK
- PROPOSED BEND W/ THRUST BLOCK
- PROPOSED FDC W/ KNOX HARDWARE
- EXISTING SANITARY SEWER
- PROPOSED SANITARY SEWER

UTILITY NOTES

- PROPOSED SANITARY SEWER PIPE
- PROPOSED SANITARY SEWER MANHOLE
- PROPOSED SANITARY SEWER SERVICE LINE
- PROPOSED WATER MAIN
- PROPOSED WATER SERVICE LINE
- PROPOSED FIRE SERVICE LINE
- PROPOSED FIRE HYDRANT AND BOLLARD ASSEMBLY PER COA STD DETAIL 208
- PROPOSED FDC W/ APPROVED KNOX HARDWARE
- PROPOSED KNOX BOX
- PROPOSED FIRE HYDRANT ASSEMBLY PER COA STD DETAIL 208

NOTE:
1. STORMWATER INFRASTRUCTURE OWNERSHIP SHALL BE DESIGNATED BY THE CONSTRUCTION DOCUMENTS.

Kimley»Horn

KIMLEY-HORN AND ASSOCIATES, INC.
6205 S. HARRISON
Greenwood Village, CO 80111 (303) 228-2300

PORTEOS INDUSTRIAL AT PORTEOS
CITY OF AURORA, COUNTY OF ADAMS
SITE PLAN AMENDMENT
DETAILED UTILITY PLAN

DATE: 03/22/2024
DESIGNED BY: CAO
DRAWN BY: AGM
CHECKED BY: BJC

FILE NO.
196617002_UT DTL-DA II
PROJECT NO.
196617002

SHEET NO.

NO.	REVISION	BY	DATE	APPROVED