

## Responses to comments are provided in blue

**Re: Second Submission Review – Nick’s Convenience – Jackson Gap at Porteos – Site Plan and Plat Application**  
Number: **DA-1903-35**  
Case Numbers: **2023-6040-00, 2023-3038-00**

### *Second Submission Review*

#### **PLANNING DEPARTMENT COMMENTS**

##### **1. Community Questions, Comments, and Concerns**

1A. There are no community comments on this first review cycle.  
**Comment noted.**

##### **2. Completeness and Clarity of the Application**

2A. There were no more completeness or clarity comments on this application.  
**Comment noted.**

##### **3. Zoning and Land Use Comments**

3A. There were no more zoning or land use comments on this review.  
**Comment noted.**

##### **4. Streets and Pedestrian Issues**

4A. There were no more streets or pedestrian issues on this review.  
**Comment noted.**

##### **5. Parking Issues**

5A. There were no parking issues identified on this review.  
**Comment noted.**

##### **6. Architectural and Urban Design Issues**

[Site Plan Page 9 & Color Elevations Page 2]

6A. A roof form or height variation is required for roofs, including canopy roofs. Variation is required every 60 ft, so this will only be needed on the front and rear elevations. The added cornice, while appreciated, does not vary along the length of the canopy.  
**The canopy has been revised to include a 2 foot high raised portion in the center of the canopy.**

##### **7. Signage Issues**

7A. There were no more signage comments on this review.  
**Comment noted.**

##### **8. Landscaping Issues** (Kelly Bish / 303-739-7189 / kbish@auroragov.org / Comments in bright teal)

[Site Plan Page 2]

8A. Call out/label the retaining walls.  
**The retaining walls have been labeled.**

[Site Plan Page 3]

8B. Provide spot elevations for the top and bottom of wall.  
**Label added for screen wall with height above finish grade. More information is provided on the Landscape Plans.**

[Site Plan Page 5]

8C. There are too many of the same shrub being proposed. Select a different shrub for some of the locations. There are a lot of Broom and Snowberry.  
**An additional shrub species has been added.**

- 8D. The City Landscape Notes appear on this sheet and sheet 5. Only one set is necessary.  
**The notes were added as requested in the last round of comments. They have now been removed from this sheet.**
- 8E. Provide a variety for the Chokeberry.  
**Chokeberry has been removed.**
- 8F. Add the five required landscape notes as found in The Landscape Reference Manual found on line.  
**The notes have been added.**
- 8G. No more than 40% of the total shrub requirement may be specified as ornamental grasses. This quantity exceeds the maximum permitted by code. No more than five percent may be provided as perennials.  
**The plan has been revised to show only shrubs. Please note, Arctostaphylos uva-ursi is a shrub, not a perennial.**
- 8H. There are Oregon Grape Holly proposed on the west side of the building and they tend to like some shade in hotter climates. This will receive a lot of direct sunlight on hot summer days.  
**These shrubs will be shaded from the west, south, and east, as well as by the ornamental trees planted among them, so we need something that can accept the sun that this area will get while the trees are young as well as the shade that will come at maturity. We have switched these plants out to another shrub also known for that ability. These have been replaced by Arctostaphylos.**
- 8I. What is the dark line and can it be turned off?  
**The dark line has been removed.**
- 8J. Provide color and different texture around the sign. Code requires the entrances to have enhanced landscaping which is typically tied to the signage. Refer to Section 146-4.7.5. L. Site Entryways and Intersections.  
**The planting has been revised as requested. Please note, the code section language does not require planting at the signage, only at entries and intersections, which had already been provided.**
- 8K. Place the taller plant material in the back and the shorter plant material in the front. See landscape plan for reference.  
**The shrubs have been relocated as requested.**
- 8L. Provide a taller plant along the exterior of the trash enclosure to supplement the concrete masonry unit wall that is proposed. Preferably evergreen plantings.  
**Evergreens have been added as requested.**
- 8M. Update the ornamental grass quantity.  
**The calamagrostis has been removed.**
- 8N. The landscape buffer should be measured just to the curb line of the development and NOT internal to the site.  
**The buffer line has been moved as requested. Please note, this comment is requiring a different approach from that required by the code, which reads:**
- b. The required depth of a street frontage landscape buffer is measured inward from the back of sidewalk or from a public or private right-of-way when a sidewalk is not present. On private streets with no right-of-way line, the street frontage buffer depth shall be measured inward from the back of the sidewalk or if no sidewalk exists, the buffer is measured from the back of the nearest curb line. See Figure 4.7-13.**
- [Site Plan Page 6]
- 8O. Update the landscape tables per the comments provided.  
**The landscape tables have been updated.**

8P. Provide a more definitive detail of the proposed walls. Provide material, height, and color. Will it match the aesthetic/masonry treatment proposed for the building?

**The details have been revised.**

9. Addressing (Phil Turner / 303-739-7357 / pturner@auroragov.org)

9A. There were no more comments from Addressing on this review.

**Comment noted.**

## **REFERRAL COMMENTS FROM OTHER DEPARTMENTS AND AGENCIES**

10. Civil Engineering (Julie Bingham / 303-739-7403 / jbingham@auroragov.org / Comments in green)

[Site Plan Page 1]

10A. Please add the following note: "The Infrastructure Site Plan (ISP) and civil plans for the associated infrastructure must be approved prior to the issuance of building permits. Construction shown on the civil plans for the ISP for associated infrastructure must be initially accepted by the City prior to the issuance of Temporary Certificate of Occupancy (TCO) or Certificate of Occupancy (CO) per the approved Public Improvement Plan."

**The note has been added as requested.**

[Site Plan Page 3]

10B. Remove cross pans from the site plan submittal. They will be reviewed/approved as part of the civil plans.

**Comment noted and completed.**

10C. Provide a typical section for the wall. Identify the max height and material. Walls over 30" require hand railing. Label added for screen wall with height above finish grade. More information provided on landscape plans.

**A 1'-8" max height retaining wall is called out and labeled at this location. Additional information is provided on the Landscape Plans.**

11. Traffic Engineering (Dean Kaiser / 303-739-7584 / djkaiser@auroragov.org / Comments in amber)

[Site Plan Page 2]

11A. Add key note #13 to the crosswalk.

**Added as requested.**

11B. Need R3-5b, RIGHT TURN ONLY sign (will try and get it on the RSN 1726166 Porteos PA-9A-9C Civils which are currently in review). [2 comments]

**Added as requested.**

11C. Add "& Street Name Sign".

**Added as requested.**

11D. Repeat comment, intersection sight triangles required and need to be illustrated on landscaping plan as well. [2 comments]

**Added as requested.**

[Site Plan Page 5]

11E. Show intersection sight triangles. [2 comments]

**Added as requested.**

[Traffic Analysis Page 1]

11F. Minor edit needed for Trip Gen tables, also need graphic figure of trip distribution and site trips on roadway network.

**Comment acknowledged. Individual responses provided to comments below.**

[Traffic Analysis Page 4]

11G. Add note that this was for a 3,500 sf convenience store, ITE subcategory 2-4k facility.

**Note added.**

11H. Add note that this is for the proposed 6,200 sf convenience store, ITE subcategory 5.5-10k facility.  
**Note added.**

[Traffic Analysis Page 5]

11I. Reviewed, accept values as presented.  
**Comment acknowledged.**

[Traffic Analysis Page 6]

11J. Provide a graphic figure depicting trip distribution and trip assignment from the site onto the roadway network around the intersection of 64th & Jackson Gap as well as the site accesses.  
**Site generated trip distribution/assignment figure added.**

[Truck Route Exhibit]

11K. Need to illustrate EB right turn in from 64th Ave.  
**The truck route has been revised as requested.**

11L. Is gas tanker truck the same size and wheelbase as a WB-50? If not, need to provide its template as well.  
**The WB-50 is industry standard for tanker trucks.**

12. Fire / Life Safety (Stephen Kirchner / 303-739-7489 / stkirchn@auroragov.org / Comments in blue)

[Site Plan Page 2]

12A. Add fire lane sign here.  
**Added as requested.**

12B. Rotate all fire lane signs according to information provided.  
**Completed.**

12C. Per drawing below, there is an existing hydrant on this side approximately 150' to the north of this intersection.  
**The existing hydrant has been noted on the plans.**

[Site Plan Page 3]

12D. Provide transverse and longitudinal spot elevations in accessible route.  
**Additional grade labels have been added along the accessible route.**

[Site Plan Page 4]

12E. Combine label to Fire Lane, Access and Utility Easement. [2 comments]  
**These are two separate easements of different widths that are being processed as separate documents by the overall Porteos developer. Labels and widths reflect documents that have been through several rounds of review with the City and are near being finalized.**

[Site Plan Page 5]

12F. Label Emergency Shutoff switches. Make sure access to switches is not obstructed by landscape.  
**The Emergency Fuel Shutoff switches have been labeled as requested.**

[Site Plan Page 10]

12G. Show accessible route on photometric plan.  
**The accessible route has been added to the Photometric Plan as requested.**

13. Aurora Water (Daniel Pershing / 303-739-7646 / ddpershi@aurorgov.org/ Comments in red)

[Site Plan Page 1]

13A. The site plan will not be approved by Aurora Water until the preliminary drainage report is approved.  
**Comment noted.**

[Site Plan Page 4]

13B. Please label and dimension 10 ft water easements covering the meter and hydrant

**Completed.**

- 13C. This manhole creates an acute angle for the inlet to the west. Please update the configuration to a 90-degree angle within this manhole.

**This has been realigned with an additional manhole.**

**14. TAPS/Aurora Water** (Diana Porter / 303-739-7395 / dsporter@auroragov.org)

- 14A. Unpaid tap fees totaling \$2,034.40 are due prior to mylar recordation.

**Comment noted.**

**15. Land Development Services** (Maurice Brooks / 303-739-7294 / mbrooks@auroragov.org / Comments in magenta)

- 15A. Comments from Land Development Review are forthcoming. Please reach out to the reviewer directly for updates.

**Comment noted.**

**16. Xcel Energy** (Donna George / 303-571-3306 / donna.l.george@xcelenergy.com)

- 16A. There were no more comments from Xcel Energy on this review.

**Comment noted.**

**17. Denver International Airport** (Brodie Ayers / 303-342-2804 / brodie.ayers@flydenver.com) [Repeated Comments]

- 17A. The proposed development is within the “10,000’ Critical Area for Wildlife-Attractant Separation Area” for the final build-out of future DEN Runways, as defined by the Federal Aviation Administration (FAA). The USDA Wildlife Biologist assigned to DEN assist in implementing DEN's Wildlife Hazard Management Plan and have requested coordination as this project progresses. USDA and DEN will provide assistance with the requirements outlined in the current version of FAA Advisory Circular 150/5200-33C (see link below). DEN also requests that the landscape plan include maintenance of trees and grasses to reduce attractants for wildlife such as raptor species, blackbirds/starlings, and geese. Fruit-producing trees and shrubs should be avoided. Water quality ponds/detention structures must be designed to meet a 40-hour drain time following a 100-year event.  
[https://www.faa.gov/airports/resources/advisory\\_circulars/index.cfm/go/document.current/documentnumber/150\\_5200-33](https://www.faa.gov/airports/resources/advisory_circulars/index.cfm/go/document.current/documentnumber/150_5200-33).

**Comment noted. The site has been designed to comply with the requirements identified.**

- 17B. The site is found within/under the navigable airspace associated with DEN, as promulgated and regulated by the Federal Aviation Administration (FAA) under 14 CFR Part 77, Objects Affecting the Navigable Airspace. Based on Part 77 and the development site location, the proponent is required to file notice with the FAA, via the FAA Form 7460-1 process (Notice of Proposed Construction or Alteration), of any structure or temporary construction equipment (e.g., cranes) that penetrate Part 77 surfaces. The FAA website from which the need for the 7460 process can be determined (“Notice Criteria Tool”) and/or the filing can be initiated is:

<https://oeaaa.faa.gov/oeaaa/external/portal.jsp>.

**Comment noted. The required FAA forms will be submitted as required.**

# SITE PLAN - NICK'S CONVENIENCE

LOT 1, BLOCK 1, PORTEOS PA-9A SUBDIVISION FILING NO. 1  
LOCATED IN A PORTION OF THE NORTH ONE-HALF OF SECTION 8,  
TOWNSHIP 3 SOUTH, RANGE 65 WEST OF THE 6th P.M.  
CITY OF AURORA, COUNTY OF ADAMS, STATE OF COLORADO

## LEGAL DESCRIPTION

A PART OF UNPLATTED LAND, SITUATED IN THE NORTHWEST 1/4 OF SECTION 8, TOWNSHIP 3 SOUTH, RANGE 65 WEST OF THE 6TH PRINCIPAL MERIDIAN, CITY OF AURORA, COUNTY OF ADAMS, STATE OF COLORADO, MORE PARTICULARLY DESCRIBED AS FOLLOWS:

COMMENCING AT THE 42' CENTERLINE RANGE POINT LOCATED IN EAST 64TH AVENUE AND JACKSON GAP STREET; THENCE S49°52'37"E A DISTANCE OF 87.35 FEET TO A POINT ON THE SOUTH RIGHT-OF-WAY LINE OF EAST 64TH AVENUE AS DESCRIBED IN SPECIAL WARRANTY DEED RECORDED IN THE ADAMS COUNTY CLERK AND RECORDER'S OFFICE UNDER RECEPTION NUMBER 201900043876 AND THE POINT OF BEGINNING;

THENCE S89°47'23"E CONTIGUOUS WITH SAID SOUTH RIGHT-OF-WAY LINE A DISTANCE OF 235.00 FEET;

THENCE S00°12'37"W DEPARTING SAID SOUTH RIGHT-OF-WAY LINE A DISTANCE OF 275.02 FEET;

THENCE N89°47'23"W A DISTANCE OF 260.00 FEET TO THE EAST RIGHT-OF-WAY LINE OF JACKSON GAP STREET AS DESCRIBED IN PORTEOS SUBDIVISION FILING NO. 1 IN SAID RECORDS UNDER RECEPTION NUMBER 2013000094501;

THENCE N00°12'37"E CONTIGUOUS WITH SAID EAST RIGHT-OF-WAY LINE A DISTANCE OF 250.02 FEET TO A TANGENT 25.00 FOOT RADIUS CURVE WHOSE CHORD BEARS N45°12'47"E A DISTANCE OF 35.36 FEET;

THENCE NORTHEASTERLY ALONG SAID CURVE, THROUGH A CENTRAL ANGLE OF 90°00'00", AN ARC DISTANCE OF 39.27 FEET TO THE POINT OF BEGINNING.

PARCEL CONTAINS (71,371 SQUARE FEET) 1.63845 ACRES, MORE OR LESS.

PARCEL TO BE PLATTED AS LOT 1, BLOCK 1, PORTEOS PA-9A SUBDIVISION FILING NO.1.

## CITY CONTACT

### CITY MANAGER'S OFFICE:

OFFICE OF DEVELOPMENT ASSISTANCE  
JAZMINE MARTE  
(303) 739-7385

### PLANNING:

ZONING AND PLAN REVIEW  
ERIK GATES  
(303) 739-7132

### LANDSCAPE DESIGN

KELLY BISH  
(303) 739-7189

### PARKS, RECREATION, AND OPEN SPACE:

FORESTRY  
JACQUE CHOMIAK  
(303) 739-7189

### AURORA WATER:

IMAN GHAZALI

### PUBLIC WORKS

TRAFFIC DIVISION  
DEAN KAISER  
(303) 739-7267

### ROADWAY & PUBLIC IMPROVEMENTS

ENGINEERING DIVISION  
JULIE BINGHAM  
(303) 739-7403

### LIFE SAFETY AND BUILDING DIVISION


WILLIAM POLK  
(303) 739-7371

### REAL PROPERTY DIVISION

MAURICE BROOKS  
(303) 739-7294

### OIL AND GAS DIVISION

JEFFREY MOORE  
(303) 739-7676

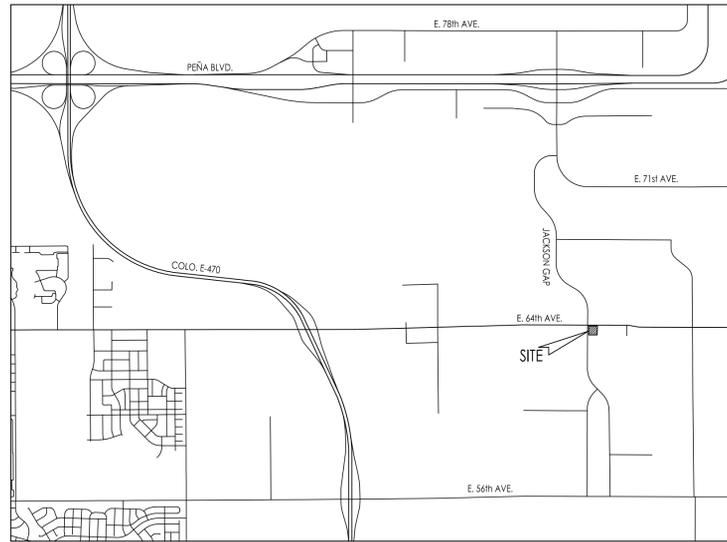

### VICINITY MAP

1" = ONE-HALF MILE

## TABLE OF CONTENTS

- COVER SHEET
- SITE PLAN AND SITE DETAILS
- GRADING PLAN
- UTILITY PLAN
- LANDSCAPE PLAN
- LANDSCAPE NOTES
- LANDSCAPE SPECIFICATIONS
- BUILDING ELEVATIONS
- CANOPY AND TRASH ENCLOSURE ELEVATIONS
- PHOTOMETRICS

The site plan will not be approved by Aurora Water until the preliminary drainage report is approved.

Comment Noted

## DEVELOPMENT TEAM

### OWNER/DEVELOPER:

JACKSON GAP INVESTMENTS INC.  
6180 S. OAK HILL WAY  
AURORA, CO 80016  
(303) 895-1639  
MOHINDER (NICK) SANDHU

### ARCHITECT:

THE DIMENSION GROUP  
5600 S. QUEBEC STREET  
SUITE 205B  
GREENWOOD VILLAGE, COLORADO 80111  
(720) 536-3180  
STAYTON R. WOOD, AIA

### CIVIL ENGINEER:

THE DIMENSION GROUP  
5600 S. QUEBEC STREET  
SUITE 205B  
GREENWOOD VILLAGE, COLORADO 80111  
(720) 536-3180  
JOEL TOMPKINS, PE

### LANDSCAPE ARCHITECT:

EVERGREEN DESIGN GROUP, INC.  
1755 TELSTAR DR., SUITE 300  
COLORADO SPRINGS, COLORADO 80920  
(800) 680-6630  
LISA CUTSHAW, PLA

### SURVEYOR:

ENGINEERING SERVICE COMPANY  
14190 E. EVANS AVENUE  
AURORA, COLORADO 80014  
(303) 337-1393  
JUSTIN CONNER, PLS

## AMENDMENTS

### Completed

Please add the following note:  
"The Infrastructure Site Plan (ISP) and civil plans for the associated infrastructure must be approved prior to the issuance of building permits. Construction shown on the civil plans for the ISP for associated infrastructure must be initially accepted by the City prior to the issuance of Temporary Certificate of Occupancy (TCO) or Certificate of Occupancy (CO) per the approved Public Improvement Plan."

## DATA BLOCK

LAND AREA WITHIN PROPERTY LINES	71,370 S.F. [ 1.638 ACRE ]
NUMBER OF BUILDINGS	1
BUILDING (CANOPY) HEIGHT	24'-11" [ 19'-5" ]
TOTAL BUILDING COVERAGE AND GFA	6,212 S.F. (8.7%) [ 4,284 S.F. (6.0%) ]
HARD SURFACE AREA	36,572 S.F. (51.3%)
LANDSCAPE AREA	19,136 S.F. (26.8%)
SIDEWALKS AND PATIOS	5,166 S.F. (7.2%)
PRESENT ZONING CLASSIFICATION	AD SUBAREA C
IBC CONSTRUCTION TYPE	VB
OCCUPANY TYPE	M
MAXIMUM PERMITTED/ALLOWABLE SIGN AREA	200 S.F.
PROPOSED TOTAL SIGN AREA	200 S.F.
PROPOSED NUMBER OF SIGNS	5
PARKING SPACES REQUIRED	16
PARKING SPACES PROVIDED	21
ACCESSIBLE SPACES REQUIRED	1
ACCESSIBLE SPACES PROVIDED	1
VAN ACCESSIBLE SPACES PROVIDED	1
LOADING SPACES REQUIRED	N/A
LOADING SPACES PROVIDED	0

## SIGNATURE BLOCK

THIS SITE PLAN AND ANY AMENDMENTS HERETO, UPON APPROVAL BY THE CITY OF AURORA AND RECORDING, SHALL BE BINDING UPON THE APPLICANTS THEREFORE, THEIR SUCCESSORS AND ASSIGNS. THIS PLAN SHALL LIMIT AND CONTROL THE ISSUANCE AND VALIDITY OF ALL BUILDING PERMITS, AND SHALL RESTRICT AND LIMIT THE CONSTRUCTION, LOCATION, USE, OCCUPANCY AND OPERATION OF ALL LAND AND STRUCTURES WITHIN THIS PLAN TO ALL CONDITIONS, REQUIREMENTS, LOCATIONS AND LIMITATIONS SET FORTH HEREIN. ABANDONMENT, WITHDRAWAL OR AMENDMENT OF THIS PLAN MAY BE PERMITTED ONLY UPON APPROVAL OF THE CITY OF AURORA.

IN WITNESS WHEREOF \_\_\_\_\_ HAS CAUSED THESE  
(CORPORATION, COMPANY, OR INDIVIDUAL)

PRESENT TO BE EXECUTED THIS \_\_\_\_\_ DAY OF \_\_\_\_\_ AD, \_\_\_\_\_

BY: \_\_\_\_\_  
(PRINCIPALS OR OWNERS)

CORPORATE  
SEAL

STATE OF COLORADO )

COUNTY OF \_\_\_\_\_

THE FOREGOING INSTRUMENT WAS ACKNOWLEDGED BEFORE ME THIS \_\_\_\_\_ DAY OF \_\_\_\_\_ AD, \_\_\_\_\_

BY: \_\_\_\_\_  
(PRINCIPALS OR OWNERS)

WITNESS MY HAND AND OFFICIAL SEAL

\_\_\_\_\_  
(NOTARY PUBLIC)

NOTARY  
SEAL

MY COMMISSION EXPIRES \_\_\_\_\_  
NOTARY BUSINESS ADDRESS: \_\_\_\_\_

## CITY OF AURORA APPROVAL

CITY ATTORNEY: \_\_\_\_\_ DATE: \_\_\_\_\_

PLANNING DIRECTOR: \_\_\_\_\_ DATE: \_\_\_\_\_

DATABASE APPROVAL: \_\_\_\_\_

## RECORDER'S CERTIFICATION

ACCEPTED FOR FILING IN THE OFFICE OF THE CLERK AND RECORDER OF \_\_\_\_\_

COLORADO AT \_\_\_\_\_ O'CLOCK M, THIS \_\_\_\_\_ DAY OF \_\_\_\_\_ AD, \_\_\_\_\_

CLERK AND RECORDER: \_\_\_\_\_ DEPUTY: \_\_\_\_\_

[Ent: 24x-36TB (Nick's PA-9a) dwg  
Drawing name: L: Nick's Investments\22-126 - Aurora, CO - 64th & Jackson Gap\02\_Civil\CAD\SP\01 - Nick's - Cover.dwg Oct 05, 2023 - 4:56pm]

## PROJECT BASIS OF BEARING

BEARINGS ARE BASED ON THE 42' RANGE LINE IN JACKSON GAP STREET, BETWEEN EAST 64TH AVENUE AND APPROXIMATELY EAST 60TH AVENUE, AS SHOWN ON THE PLAT OF PORTEOS SUBDIVISION FILING NO. 1 RECORDED ON NOVEMBER 1, 2013 IN THE ADAMS COUNTY CLERK AND RECORDER'S OFFICE UNDER RECEPTION NUMBER 2013000094501 AND IS ASSUMED TO BEAR N00°12'37" E 1328.19 FEET AND BOUNDED BY A FOUND 2-1/2" ALUMINUM CAP IN RANGE BOX STAMPED "PLS 23899" AT THE NORTH END AND BY A FOUND 2-1/2" ALUMINUM CAP IN RANGE BOX STAMPED "PLS 23899" AT THE SOUTH END.

DESCRIPTION	DATE	INITIAL SUBMITTAL	RESPONSE TO COMMENTS	UPDATE
	07/14/2023			
	10/06/2023			

drawn by JDT  
designed by JDT  
approved by -  
project no. -

COVER SHEET  
NICK'S CONVENIENCE  
xxxxxx E. 64th AVENUE  
AURORA, COLORADO

SHEET

1




# SITE PLAN - NICK'S CONVENIENCE

LOT 1, BLOCK 1, PORTEOS PA-9A SUBDIVISION FILING NO. 1  
 LOCATED IN A PORTION OF THE NORTH ONE-HALF OF SECTION 8,  
 TOWNSHIP 3 SOUTH, RANGE 65 WEST OF THE 6th P.M.  
 CITY OF AURORA, COUNTY OF ADAMS, STATE OF COLORADO

DATE	DESCRIPTION
07/14/2023	INITIAL SUBMITTAL
10/06/2023	RESPONSE TO COMMENTS UPDATE

drawn by	JDT
designed by	JDT
approved by	
project no.	

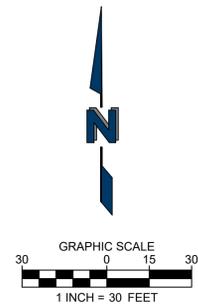

### LEGEND

- PARCEL BOUNDARY
- ADJACENT PROPERTY
- SECTION LINE
- EASEMENT LINE
- EXISTING/METRO PROVIDED MAJOR CONTOUR
- EXISTING/METRO PROVIDED MINOR CONTOUR
- PROPOSED MAJOR CONTOUR
- PROPOSED MINOR CONTOUR
- PROPOSED CONCRETE PAVING
- ADA PATH
- DOWN GRADIENT

### KEY NOTES


- ① PROPOSED 6,000 SQUARE FOOT "ALL IN ONE" CONVENIENCE STORE. REFER TO SITE SPECIFIC GEOTECHNICAL ANALYSIS FOR SELECT FILL, SUBGRADE PREPARATION, AND FOUNDATION DESIGN REQUIREMENTS.
- ② BUILDING ADJACENT SIDEWALK AND PATIO, NO GRADES GREATER THAN 2% IN ANY DIRECTION EXCEPT WITHIN CURB RAMP.
- ③ EIGHT (8) MULTI-PRODUCT FUEL DISPENSERS UNDER A CANOPY AND ONE (1) HIGH SPEED DIESEL DISPENSER EXTERIOR TO; NO GRADES GREATER THAN 2% IN ANY DIRECTION.
- ④ HANDICAP PARKING AREA; NO GRADES GREATER THAN 2% IN ANY DIRECTION.
- ⑤ CONCRETE PAVING OVER FUEL STORAGE TANKS CONSTRUCTED AT NO GRADES GREATER THAN 2% IN ANY DIRECTION.
- ⑥ PROPOSED PERIPHERAL SIDEWALKS CONSTRUCTED AT LESS THAN OR EQUAL TO 5% LONGITUDINAL GRADE AND 2% CROSS SLOPE.
- ⑦ PROPOSED AREA INLET.
- ⑧ PROPOSED STORM DRAIN PIPING GREATER THAN OR EQUAL TO 12-INCHES DIAMETER.
- ⑨ STORM DRAIN IMPROVEMENTS PROVIDED BY THE METRO DISTRICT AND DESIGNATED AS COLLECTION POINTS FOR RUNOFF FROM THE PROPOSED SITE. PROPOSED TRASH ENCLOSURE.
- ⑩ LANDSCAPE AREAS NOT TO EXCEED 4 HORIZONTAL TO 1 VERTICAL.

### PROJECT BENCHMARK

COA ID: 3543055W02  
 ELEVATION US FEET: 5406.213  
 DESCRIPTION: NGS MONUMENT LYNNE (PID = DH9171), THE MARK IS A PUNCH HOLE, TOP CENTER ON A 21.0 FT LONG STAINLESS STEEL ROD DRIVEN TO REFUSAL, ENCASED IN A 3.0 FT LONG GREASED SLEEVE, ENCLOSED IN A 6-INCH PVC PIPE WITH LOGO UID, SURROUNDED BY A CONCRETE COLLAR FLUSH WITH THE GROUND. TO REACH THE STATION EXIT PENNA BOULEVARD GOING NORTH AT JACKSON GAP RD. SOUTH ON JACKSON GAP RD 0.8 MI TO A POINT, (JACKSON GAP TURNS INTO 71ST AVE AT THE CURVE). DRIVE SOUTH THRU THE FIELD 0.3 MI TO THE STATION. IT IS 27.7 FT NORTH OF A GAS LINE MARKER, 14.8 FT NORTHWEST OF A MANHOLE, 11.6 FT WEST SOUTHWEST OF A VENT PIPE. (COA PUBLISHED DATE 09/05/07).

### GRADING NOTES

1. ALL CUT, FILL, IMPORT, COMPACTION, FOUNDATION, OR OTHER SUBGRADE PREPARATION SHALL COMPLY WITH THE RECOMMENDATIONS OF THE GEOTECHNICAL ENGINEERING REPORT PREPARED SPECIFICALLY FOR THIS SITE WORK.
2. PROPOSED CONTOUR ELEVATION LABELS HAVE BEEN TRUNCATED; ADD 5400 TO SHOWN VALUE TO GET CORRECT NAVD 88 ELEVATION.
3. PROPOSED STORM DRAINS ARE PRIVATE AND SHALL BE MAINTAINED BY THE PROPERTY OWNER.
4. CONTOURS SHOWN ARE FOR FINISHED PAVING, SIDEWALK, SLAB, OR GROUND.
5. THE CONTRACTOR IS RESPONSIBLE FOR PROVIDING HIS OWN ESTIMATE OF EARTHWORK QUANTITIES.
6. THE MAXIMUM PERMISSIBLE LONGITUDINAL GRADE FOR FIRE LANES IS 10%. THE MAXIMUM TRANSVERSE GRADE FOR A FIRE LANE IS FOUR PERCENT WITH A RESULTANT MAXIMUM SLOPE OF TEN PERCENT.
7. MINIMUM SLOPE ON UNPAVED AREAS IS 2%. MINIMUM SLOPE ON ASPHALT IS 1%, AND MINIMUM SLOPE ON CONCRETE IS 0.5%.
8. THE SLOPE AWAY FROM THE BUILDING SHALL HAVE A MINIMUM GRADE OF FIVE (5) PERCENT FOR THE FIRST TEN FEET OR TO THE PROPERTY LINE, WHICHEVER OCCURS FIRST, THEN A MINIMUM OF TWO (2) PERCENT UNTIL THE SLOPE REACHES THE SWALE AROUND THE BUILDING. IF PHYSICAL OBSTRUCTIONS OR LOT LINES PROHIBIT THE TEN FEET OF HORIZONTAL DISTANCE, A FIVE (5) PERCENT SLOPE SHALL BE PROVIDED TO AN APPROVED ALTERNATIVE METHOD OF DIVERTING STORM RUNOFF AWAY FROM THE FOUNDATION. IMPERVIOUS SURFACES WITHIN TEN FEET OF THE BUILDING FOUNDATION SHALL BE SLOPED A MINIMUM OF TWO (2) PERCENT AWAY FROM THE BUILDING.
9. ELEVATIONS LISTED HAVE BEEN TRUNCATED, TO ADJUST THE ELEVATIONS, ADD 5000'.

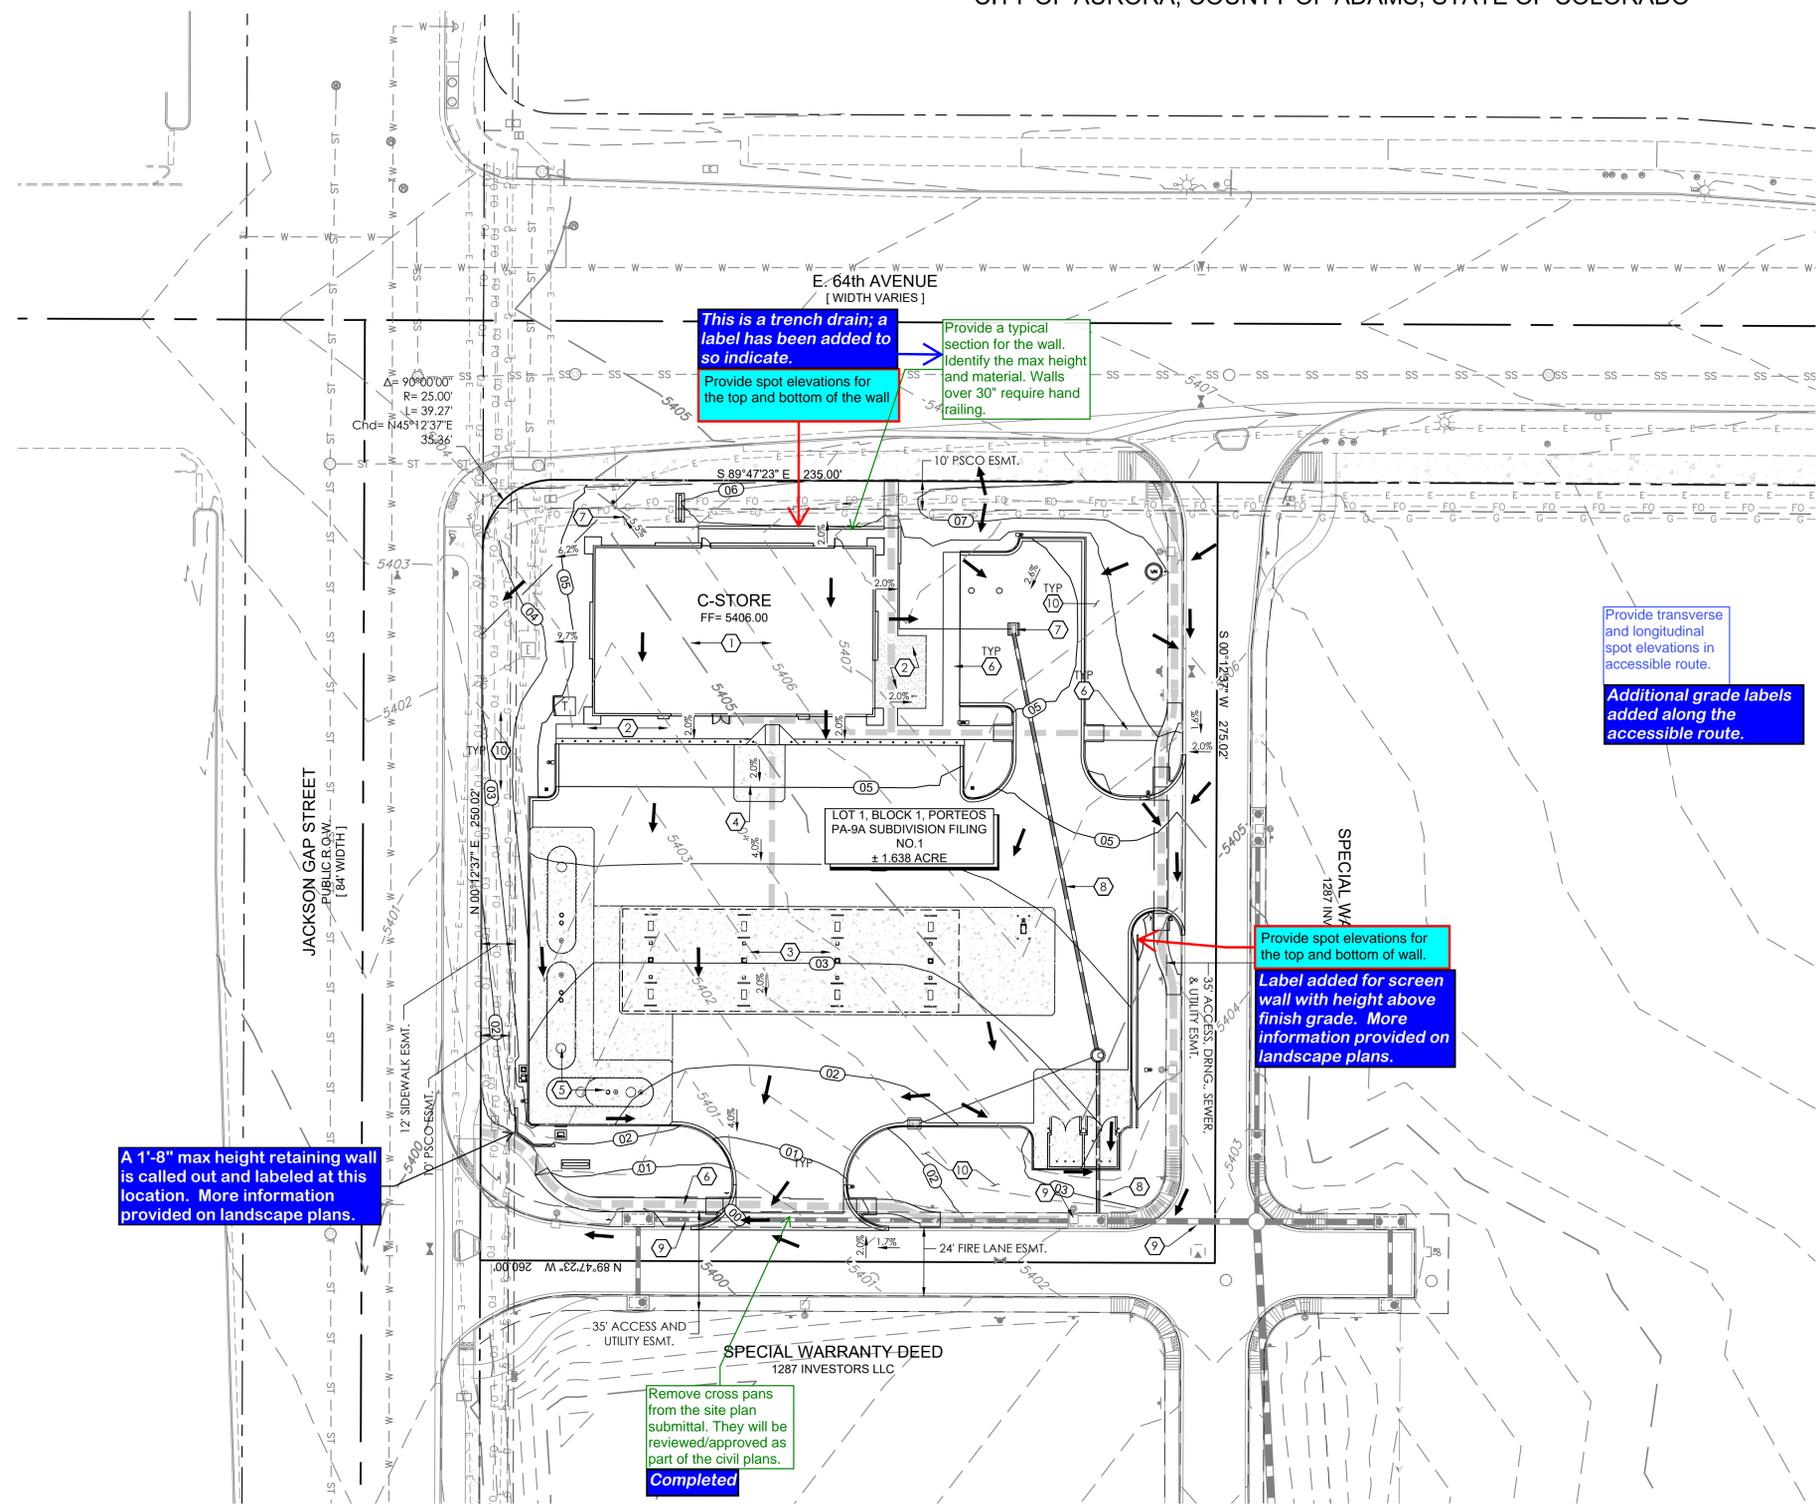

This is a trench drain; a label has been added to so indicate.  
 Provide spot elevations for the top and bottom of the wall.  
 Provide a typical section for the wall. Identify the max height and material. Walls over 30" require hand railing.

Provide transverse and longitudinal spot elevations in accessible route.  
 Additional grade labels added along the accessible route.

Provide spot elevations for the top and bottom of wall.  
 Label added for screen wall with height above finish grade. More information provided on landscape plans.


A 1'-8" max height retaining wall is called out and labeled at this location. More information provided on landscape plans.

Remove cross pans from the site plan submittal. They will be reviewed/approved as part of the civil plans.  
 Completed

[C-Base.dwg] [V-Base (Portees).dwg] [3-Base.dwg] [3-Base.dwg] [Ent. 24x36TB (Nicks PA-9a).dwg] [3-Base.dwg]  
 Drawing name: L: Nicks Investments\C22-126 - Aurora, CO - 64th & Jackson Gap\02\_Civil\CAD\SP\03 - Nicks - Grading.dwg Oct. 05, 2023 - 6:25pm

# SITE PLAN - NICK'S CONVENIENCE

LOT 1, BLOCK 1, PORTEOS PA-9A SUBDIVISION FILING NO. 1  
 LOCATED IN A PORTION OF THE NORTH ONE-HALF OF SECTION 8,  
 TOWNSHIP 3 SOUTH, RANGE 65 WEST OF THE 6th P.M.  
 CITY OF AURORA, COUNTY OF ADAMS, STATE OF COLORADO

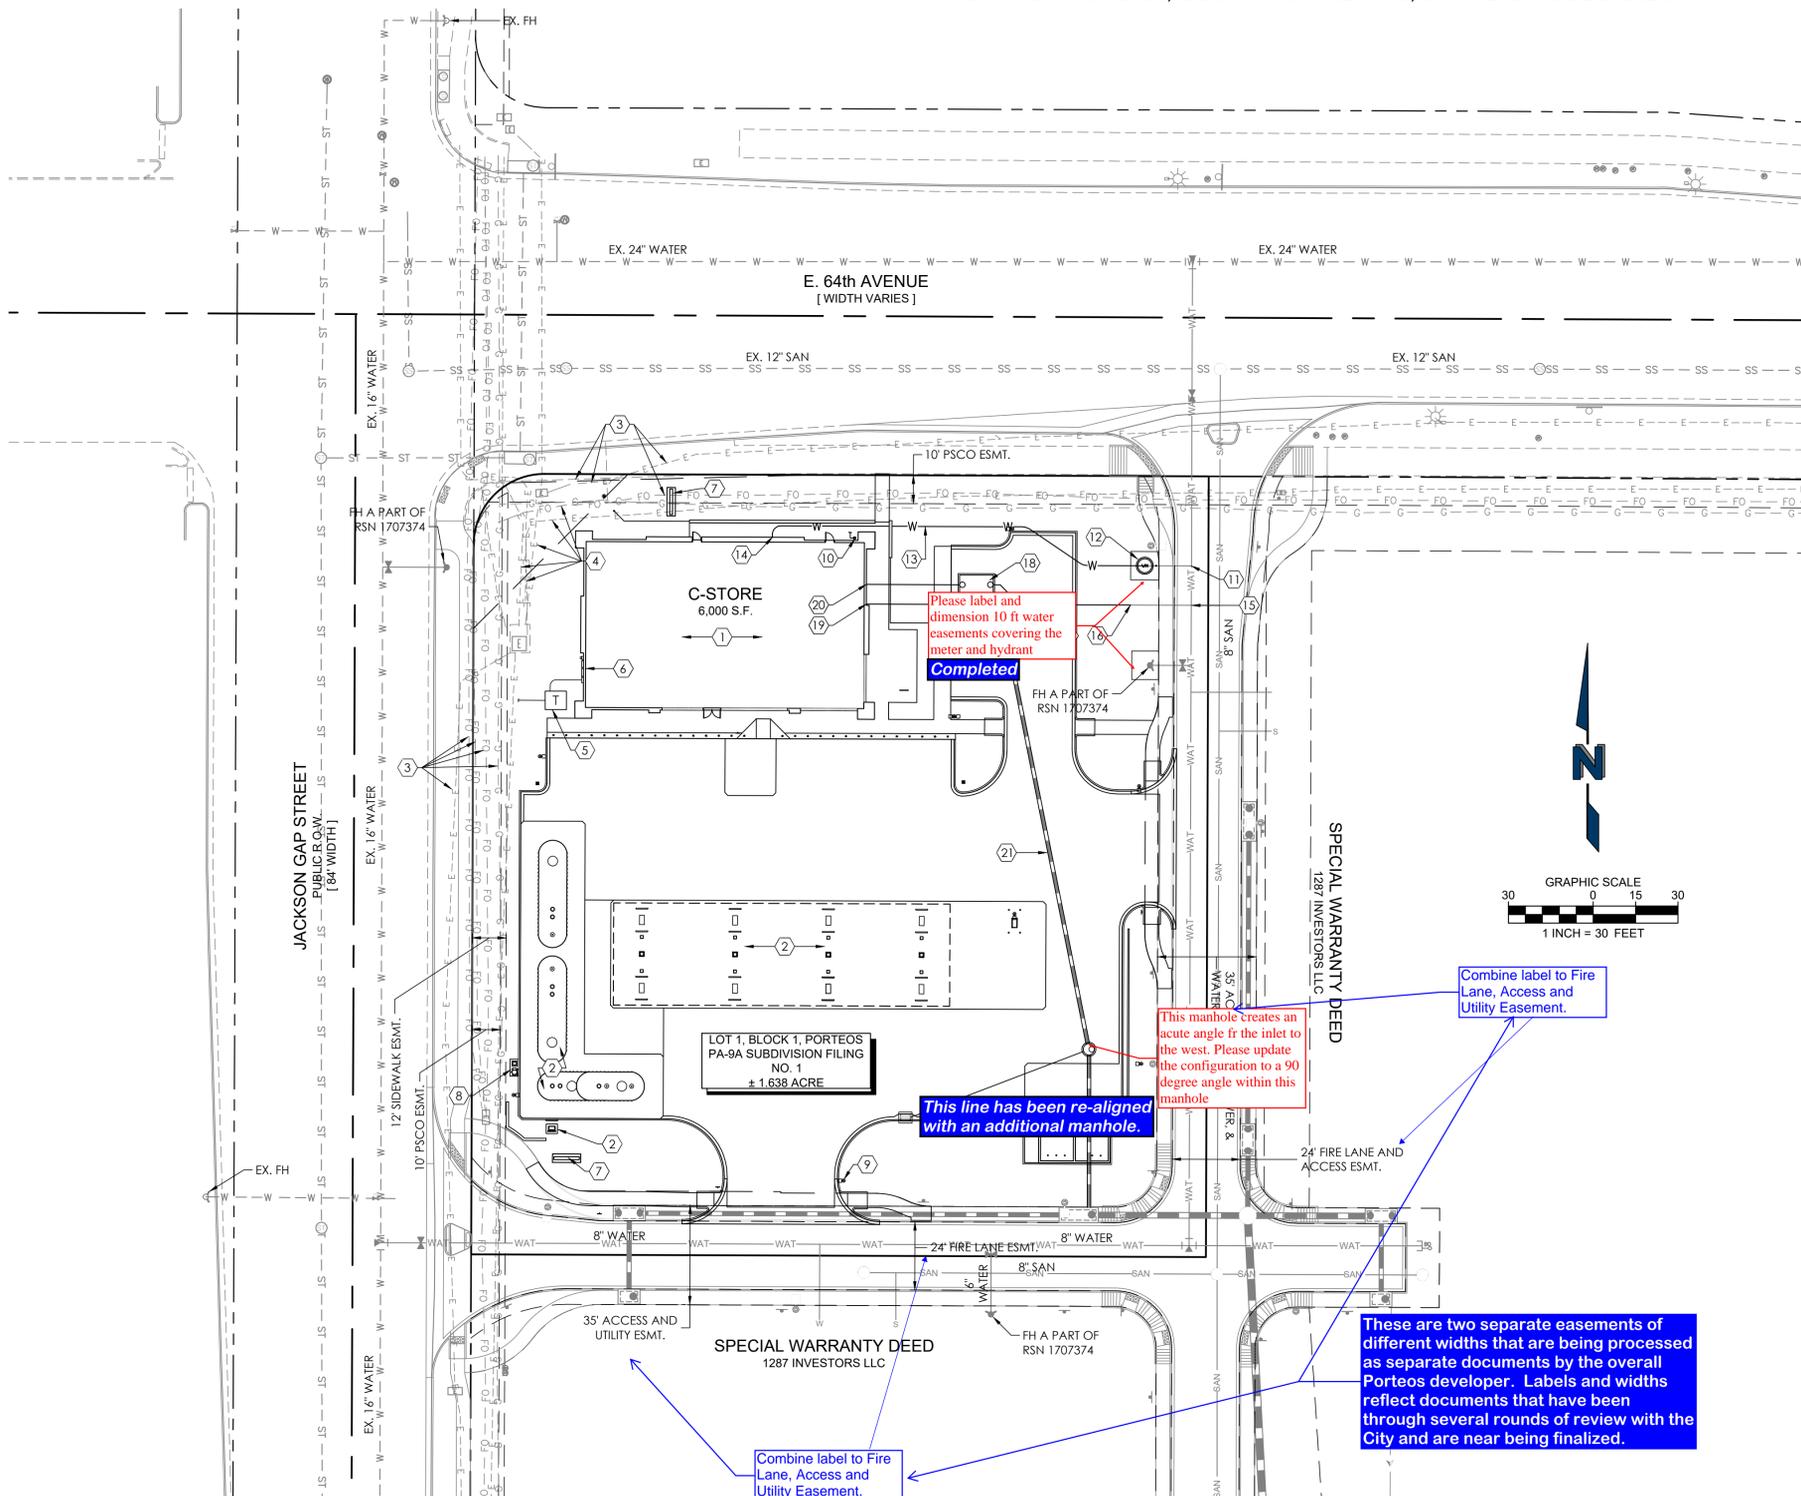

## LEGEND

—	PARCEL BOUNDARY	— WAT —	AURORA WATER PROVIDED WATER LINE
- - -	ADJACENT PROPERTY	— SAN —	AURORA WATER PROVIDED SANITARY LINE
- - - - -	SECTION LINE	— ST —	AURORA WATER PROVIDED STORM LINE
- - - - -	EASEMENT LINE	— W —	PROPOSED WATER SERVICE
- - - - -	EXISTING ELECTRIC LINE	— SS —	PROPOSED SANITARY SERVICE
- - - - -	EXISTING GAS LINE		
- - - - -	EXISTING FIBRE OPTIC LINE		
- - - - -	EXISTING WATER LINE		
- - - - -	EXISTING SANITARY LINE		
- - - - -	EXISTING STORM LINE		

## KEY NOTES

- PROPOSED 6,000 SQUARE FOOT "ALL IN ONE" CONVENIENCE STORE. INTERNAL UTILITIES TO BE PROVIDED WITH BUILDING PLANS SUBMITTAL.
- PROPOSED FUELING FACILITIES. UTILITIES TO BE PROVIDED WITH SEPARATE BUILDING PLANS SUBMITTALS.
- EXISTING DRY UTILITIES IN EASEMENTS OR PUBLIC RIGHT-OF-WAY TO REMAIN AND BE PROTECTED THROUGHOUT CONSTRUCTION.
- EXISTING DRY UTILITIES ON PRIVATE PROPERTY TO BE RELOCATED AS NECESSARY. OWNER TO COORDINATE WITH THE APPROPRIATE PROVIDER.
- PROPOSED TRANSFORMER LOCATION; PRIMARY AND SECONDARY POWER SERVICE TO BE COORDINATED WITH THE UTILITY PROVIDER. COMMUNICATIONS TO CO-TRENCH OR, IF NECESSARY, COORDINATED SEPARATELY.
- PROPOSED LOCATION OF BUILDING MOUNTED PRIMARY DISCONNECT, C/T, AND ELECTRIC METER.
- PROPOSED MONUMENT SIGNS, POWER AND COMMUNICATIONS TO BE PROVIDED WITH BUILDING PLANS SUBMITTAL.
- PROPOSED AIR AND VACUUM SERVICE. POWER TO BE PROVIDED WITH BUILDING PLANS SUBMITTAL.
- PROPOSED SITE LIGHTING. POWER PLAN TO BE PART OF BUILDING PLANS SUBMITTAL.
- PROPOSED LOCATION GAS SERVICE METER; SERVICE LINES TO BE COORDINATED WITH THE UTILITY PROVIDER.
- AURORA WATER PROVIDED 1.5-INCH DIAMETER WATER SERVICE TAP, STUB-IN, AND CORPORATION STOP.
- PROPOSED LOCATION OF 1.5-INCH WATER METER AND METER PIT.
- PROPOSED ROUTING OF 2-INCH (UP-SIZED) WATER SERVICE.
- WATER SERVICE POINT OF ENTRY TO THE BUILDING; BACKFLOW TO BE PROVIDED INTERNALLY AND DEMONSTRATED IN THE BUILDING PLANS SUBMITTAL.
- PROVIDED, PORTEOS PA-9A ISP, 6-INCH DIAMETER SANITARY SEWER SERVICE TEE AND STUB-IN.
- PROVIDED, PORTEOS PA-9A ISP, STUB-IN LOCATION AND SITE CONNECTION TO SANITARY SEWER SERVICE.
- PROPOSED ON-SITE D3034 PVC SANITARY SEWER SERVICE ROUTING.
- PROPOSED GREASE INTERCEPTOR; TO BE SIZED AS A PART OF THE BUILDING PLANS SUBMITTAL.
- DOMESTIC EFFLUENT POINT OF DEPARTURE FROM THE BUILDING; EXACT LOCATION AND ELEVATION TO BE DEMONSTRATED IN THE BUILDING PLANS SUBMITTAL.
- KITCHEN EFFLUENT POINT OF DEPARTURE FROM THE BUILDING; EXACT LOCATION AND ELEVATION TO BE DEMONSTRATED IN THE BUILDING PLANS SUBMITTAL.
- PROPOSED STORM DRAINS. REFER TO SHEET 3 FOR INFORMATION.

## UTILITY NOTES

- EXISTING ABOVE GROUND UTILITIES ARE ILLUSTRATED BASED ON INFORMATION SHOWN ON A SURVEY OF THE PROPERTY EXECUTED BY OTHERS. UNDERGROUND UTILITIES ARE ILLUSTRATED BASED ON THE SURVEY, BY OTHERS, OF SURFACE FEATURES AND RECORD DATA AND SHOULD NOT BE RELIED UPON AS COMPLETE OR EXACT.
- PROPOSED DRY UTILITY INFORMATION SHOWN ON THESE PLANS (GAS, ELECTRIC, CABLE, PHONE, FIBER, ETC.) IS SHOWN FOR INFORMATION ONLY. FINAL LOCATIONS TO BE COORDINATED WITH THE PROVIDING UTILITY COMPANIES PRIOR TO INSTALLATION.
- WHEN WATER AND SEWER LINES ARE INSTALLED IN PROXIMITY TO ONE ANOTHER, SUCH INSTALLATION SHALL BE IN STRICT ACCORDANCE WITH THE RULES AND REGULATIONS OF THE JURISDICTIONAL AUTHORITY. SPECIAL ATTENTION IS CALLED TO REQUIREMENTS FOR BOTH LATERAL AND VERTICAL SEPARATION BETWEEN WATER AND SEWER FACILITIES.
- WET UTILITY IMPROVEMENTS ARE TO BE INSTALLED IN ACCORDANCE WITH THE STANDARDS, SPECIFICATIONS AND DETAILS FOR WATER AND SEWER CONSTRUCTION OF THE APPROPRIATE AUTHORITY HAVING JURISDICTION LOCAL TO THE PROJECT SITE. THIS INCLUDES, BUT IS NOT LIMITED TO:
  - WATER AND SANITARY SEWER MATERIALS.
  - TRENCH SUBGRADE, BACKFILL, COMPACTION, AND TESTING REQUIREMENTS.
  - REFER, ALSO, TO THE GEOTECHNICAL INVESTIGATION SPECIFIC TO THE SITE.
  - WATER AND SANITARY SEWER DISINFECTING AND TESTING REQUIREMENTS.
  - MINIMUM AND MAXIMUM COVER CONSTRAINTS.
  - CATHODIC PROTECTION REQUIREMENTS.
- PROPOSED 8" WATER AND SEWER LINES WITHIN PRIVATE DRIVES SHALL BE CONSTRUCTED UNDER RSN#1707374.

DATE	DESCRIPTION
07/14/2023 <td>INITIAL SUBMITTAL</td>	INITIAL SUBMITTAL
10/06/2023	RESPONSE TO COMMENTS UPDATE

drawn by: JDT  
 designed by: JDT  
 approved by:   
 project no.:

UTILITY PLAN  
 NICK'S CONVENIENCE  
 xxxxxx E. 64th AVENUE  
 AURORA, COLORADO


[C-Base.dwg] [V-Base (Porteos).dwg] [ent\_24x36TB (Nicks PA-9a).dwg] [ent\_24x36TB (Nicks PA-9a).dwg]  
 Drawing name: L:\Nicks Investments\C22-126 - Aurora, CO - 64th & Jackson Gap\02\_Civil\CAD\SP\04 - Nicks - Utility.dwg Oct. 05, 2023 - 6:28pm



Table with columns: DATE, DESCRIPTION

drawn by LC, designed by LC, approved by LC/RM, project no.

LANDSCAPE PLANTING PLAN, NICK'S CONVENIENCE, xxxxxx E. 64th AVENUE, AURORA, COLORADO

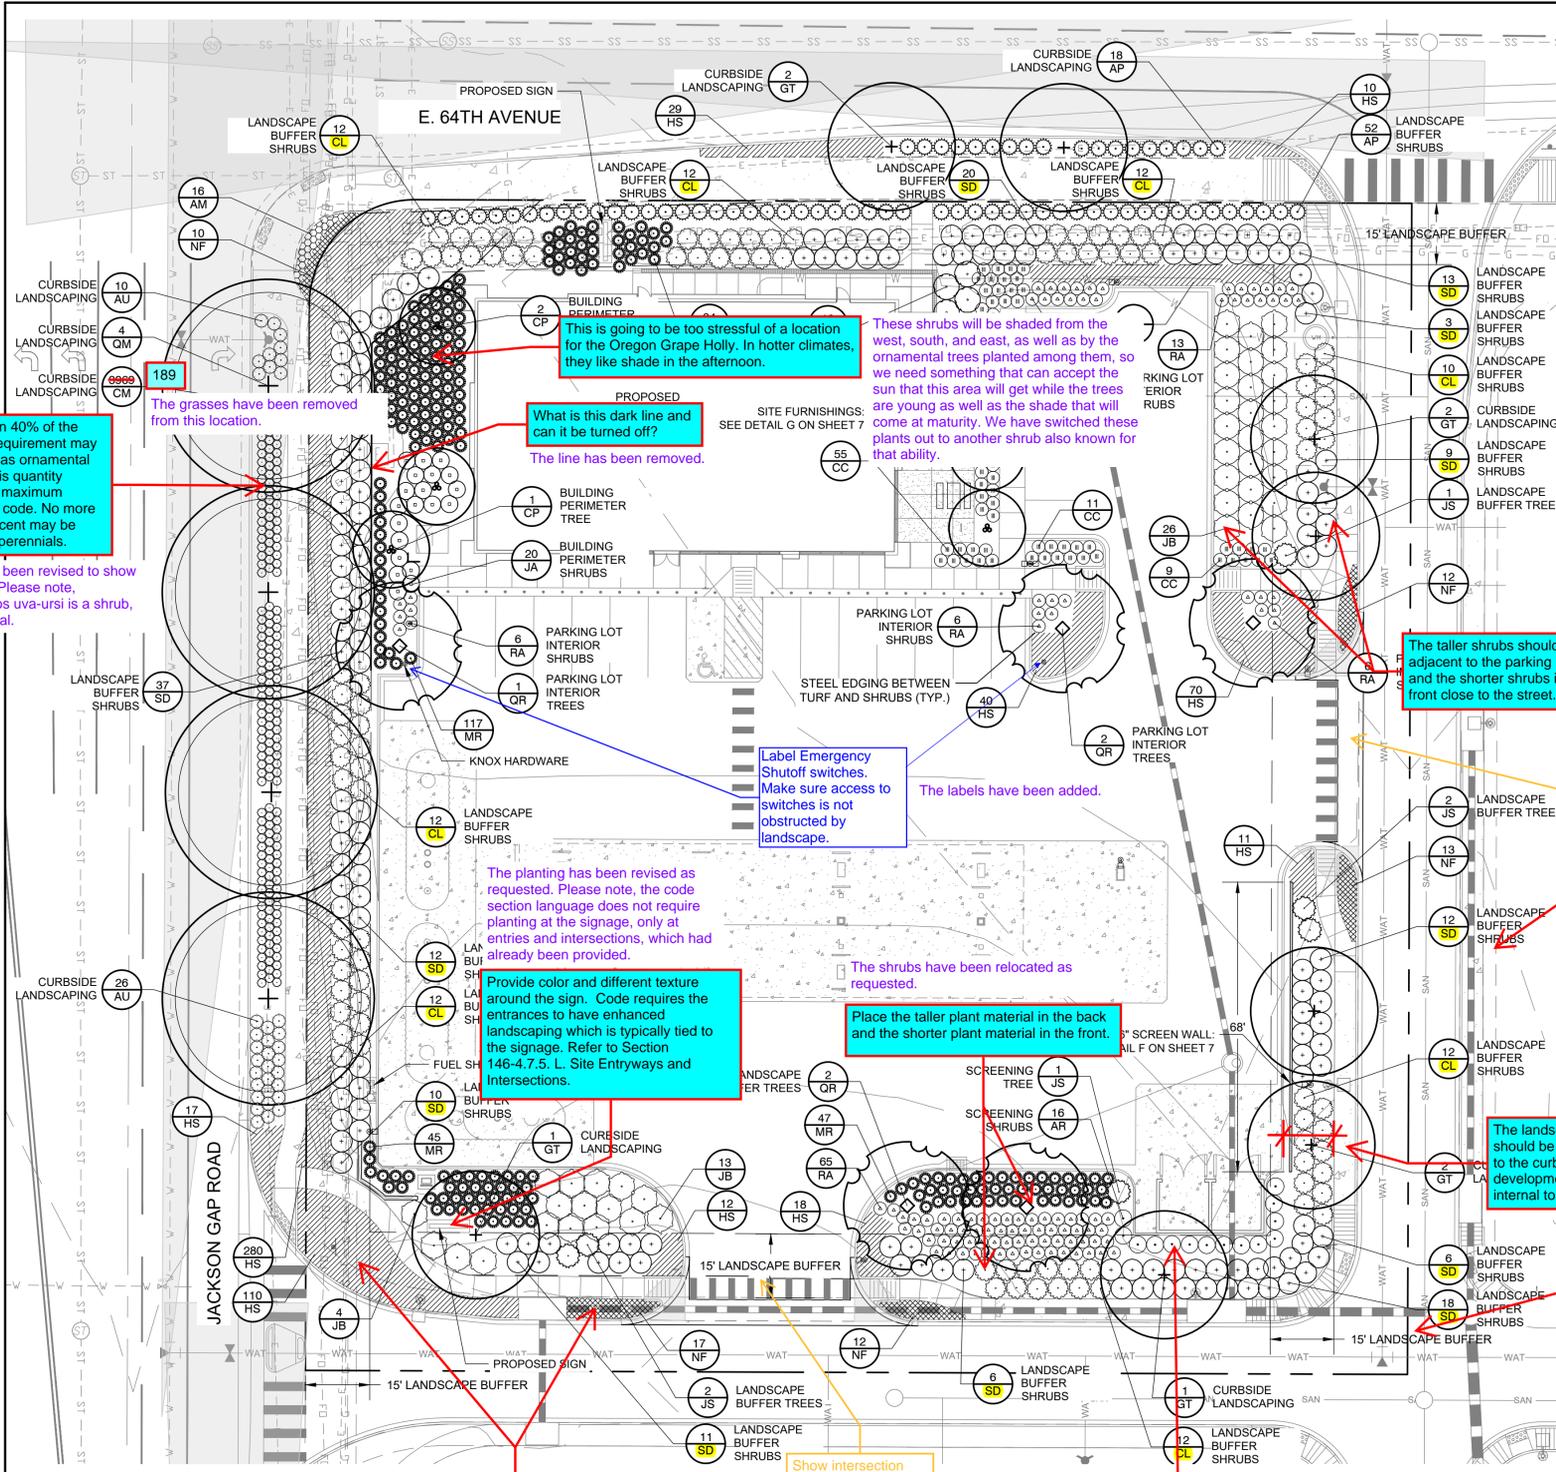

There is too much of the same shrub being used on this landscape plan. Select a different shrub for some of these locations. There is a lot of Broom and Snowberry being used.

These notes appear here and on Sheet 5. Only one set is necessary.

The notes were added as requested in the last round of comments. They have now been removed from this sheet.

An additional shrub species has been added to the list and took the place of multiple clusters of Symphoricarpos and Cytisus.

CITY LANDSCAPE NOTES

- THE LANDSCAPE PLAN MUST REFLECT THE LOCATION OF ALL FIRE HYDRANTS, KNOX HARDWARE, AND FIRE DEPARTMENT CONNECTIONS TO ENSURE THAT THESE DEVICES ARE NOT PHYSICALLY OR VISUALLY OBSTRUCTED FROM RESPONDING FIRE CREWS...

PLANT SCHEDULE table with columns: SYMBOL, KEY, QTY, BOTANICAL NAME, COMMON NAME, SIZE, SPACING, NATIVE, WATER USE, NOTES

No more than 40% of the total shrub requirement may be specified as ornamental grasses. This quantity exceeds the maximum permitted by code. No more than five percent may be provided as perennials.

The plan has been revised to show only shrubs. Please note, Arctostaphylos uva-ursi is a shrub, not a perennial.

This is going to be too stressful of a location for the Oregon Grape Holly. In hotter climates, they like shade in the afternoon.

These shrubs will be shaded from the west, south, and east, as well as by the ornamental trees planted among them, so we need something that can accept the sun that this area will get while the trees are young as well as the shade that will come at maturity...

What is this dark line and can it be turned off? The line has been removed.

The taller shrubs should be adjacent to the parking lot and the shorter shrubs in the front close to the street.

The shrubs have been relocated as requested.

Show intersection sight triangles

The sight triangles have been added as requested.

Again, too many of the exact same shrub

An additional shrub species has been added to the list and took the place of multiple clusters of Symphoricarpos and Cytisus.

What variety?

The species would be fine without specifying a named variety, but this plant has been removed from the schedule due to another comment.

The landscape buffer should be measured just to the curb line of the development and NOT internal to the site.

The buffer line has been moved as requested. Please note, this comment is requiring a different approach from that required by the code, which reads:

b. The required depth of a street frontage landscape buffer is measured inward from the back of sidewalk or from a public or private right-of-way when a sidewalk is not present. On private streets with no right-of-way line, the street frontage buffer depth shall be measured inward from the back of the sidewalk or if no sidewalk exists, the buffer is measured from the back of the nearest curb line. See Figure 4.7-13.

Update the grass quantity.

The calamagrostis has been removed.

The curbside landscape cannot be all perennials and ornamental grasses. Add this area to the landscape tables.

The sight triangles have been added as requested.

Provide a taller plant along here to supplement the concrete masonry unit wall that is proposed. Preferably evergreen plantings.

Evergreens have been added as requested.

- 4. ALL PLANTS SHARING SIMILAR HYDROZONE CHARACTERISTICS SHALL BE PLACED ON A VALVE SPECIFIC TO THAT HYDROZONE. 5. THE IRRIGATION SYSTEM SHALL BE DESIGNED AND INSTALLED TO THE MAXIMUM EXTENT POSSIBLE TO CONSERVE WATER...

ROOT BARRIERS


THE CONTRACTOR SHALL INSTALL ROOT BARRIERS NEAR ALL NEWLY-PLANTED TREES THAT ARE LOCATED WITHIN FIVE (5) FEET OF PAVING OR CURBS. ROOT BARRIERS SHALL BE "CENTURY" OR "DEEP-ROOT" 24" DEEP PANELS (OR EQUAL). BARRIERS SHALL BE LOCATED IMMEDIATELY ADJACENT TO HARDSCAPE...

MULCHES

AFTER ALL PLANTING IS COMPLETE, CONTRACTOR SHALL INSTALL 3" THICK LAYER OF 1-1/2" SHREDDED WOOD MULCH, NATURAL (UNDYED), OVER LANDSCAPE FABRIC IN ALL PLANTING AREAS (EXCEPT FOR TURF AND SEEDING AREAS). CONTRACTOR SHALL SUBMIT SAMPLES OF ALL MULCHES TO LANDSCAPE ARCHITECT AND OWNER FOR APPROVAL PRIOR TO CONSTRUCTION...

Add the five required landscape notes as found in The Landscape Reference Manual found on line.

Completed

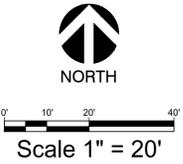

NOTE: PRINTED DRAWING SIZE MAY HAVE CHANGED FROM ORIGINAL. VERIFY SCALE USING BAR SCALE ABOVE.

SEE SHEET 6 FOR LANDSCAPE CALCULATIONS

NON-RESIDENTIAL BUILDING ELEVATION LANDSCAPING INFORMATION				
ELEVATION	LENGTH	TREE EQUIVALENT REQUIRED (1 PER 40 LF)	TREES PROVIDED	SHRUBS PROVIDED (10 SHRUBS PER TREE EQUIVALENT)
NORTH	100 LF	3	0	30
EAST	60 LF	2	2	0
SOUTH	100 LF	3	2	10
WEST	60 LF	2	2	0

NOTE: ON THE NORTH SIDE OF THE BUILDING, WE ASK TO COUNT THE SHRUBS THAT ARE PART OF THE DOUBLE-ROW, TRIANGULARLY SPACED HEDGE TOWARD THE BUILDING ELEVATION LANDSCAPING. THIS IS BECAUSE THE HEDGE TAKES UP MOST OF THE SPACE AVAILABLE, AND WE CAN'T PLANT THE THREE REQUIRED TREES BECAUSE OF THE PRESENCE OF A GAS LINE.

**CITY LANDSCAPE NOTES**

- THE LANDSCAPE PLAN MUST REFLECT THE LOCATION OF ALL FIRE HYDRANTS, KNOX HARDWARE, AND FIRE DEPARTMENT CONNECTIONS TO ENSURE THAT THESE DEVICES ARE NOT PHYSICALLY OR VISUALLY OBSTRUCTED FROM RESPONDING FIRE CREWS. THE SEPARATION REQUIREMENTS FROM FIRE DEPARTMENT CONNECTIONS AND FIRE HYDRANTS MUST MEET BOTH FIRE LIFE SAFETY (TYPICALLY 5 FEET AND NO MATERIAL GREATER THAN 2 FEET IN HEIGHT) AND LANDSCAPING REQUIREMENTS. LANDSCAPING MATERIAL CANNOT BE OMITTED OR REDUCED BASED ON THE INSTALLATION OF FIRE HYDRANT(S) WITHIN A PARKING LOT ISLAND OR PLANT BED. IT IS RECOMMENDED THAT THE ISLAND OR PLANT BED BE CONSTRUCTED LARGE ENOUGH TO ADEQUATELY ACCOMMODATE BOTH LANDSCAPING MATERIAL AND FIRE HYDRANTS IN ORDER TO COMPLY WITH ALL CITY STANDARDS.
- AN 5-FOOT CLEAR SPACE SHALL BE MAINTAINED AROUND THE CIRCUMFERENCE OF FIRE HYDRANTS.
- LANDSCAPING MATERIAL SHOWN WITHIN THE SITE PLAN CANNOT ENCROACH INTO ROADWAYS THAT ARE DEDICATED (OR DESIGNATED) AS FIRE LANE EASEMENTS (OR CORRIDORS).

**LANDSCAPE CALCULATIONS**

TOTAL LANDSCAPE AREA PROVIDED: 21,852 SF (INCLUDES ALL PLANTED AREAS SHOWN ON PLAN)  
 % TURF: 0% (MAX 33% OF TOTAL LANDSCAPE AREA)

**CURBSIDE LANDSCAPING, JACKSON GAP ROAD, DETACHED SIDEWALK:**

FRONTAGE LENGTH: 165 LF  
 PL ~~1,670 SF~~ 1,670 SF  
 STI The plan and requirements have been updated. The actual area per CAD take-off is 1,663 sf.  
 SH 4 STREET TREES (1 PER 40 LF)  
 4 STREET TREES  
 SHRUBS PROVIDED: 45 SHRUBS (1 PER 40 SF)

The current design includes 189 ornamental grasses and some perennials and no shrubs. Please update the landscape plan to reflect the correct plant material per code.

**CURBSIDE LANDSCAPING, E 64TH AVENUE, DETACHED SIDEWALK:**

FRONTAGE LENGTH: 81 LF  
 PL ~~581 SF~~ 581 SF  
 STI The plan and requirements have been updated. The actual area per CAD take-off is 567 sf.  
 SH 2 STREET TREES (1 PER 40 LF)  
 2 STREET TREES  
 SHRUBS PROVIDED: 18 SHRUBS (1 PER 40 SF)

This is inaccurate. Arctostaphylos uva-ursi is a shrub, not a perennial. The plan has been revised to remove all ornamental grasses from this bed and provide only shrubs, including Arctostaphylos uva-ursi. The shrubs have to be able to withstand the initial level of sun they will be exposed to as well as the shade that will come as the trees mature. They also have to be short enough to allow for visibility in the sight triangle.

**CURBSIDE LANDSCAPING, EAST PROPERTY LINE, ATTACHED SIDEWALK:**

FRONTAGE LENGTH: 121 LF  
 STREET TREES REQUIRED: 3 STREET TREES (1 PER 40 LF)  
 STREET TREES PROVIDED: 3 STREETS

This is not attached the entire length.

The plan and calculations have been revised.

**CURBSIDE LANDSCAPING, SOUTH PROPERTY LINE, ATTACHED SIDEWALK:**

FRONTAGE LENGTH: 77 LF  
 STREET TREES REQUIRED: 2 TREES (1 PER 40 LF)  
 STREET TREES PROVIDED: 2 TREES

**STREET FRONTAGE LANDSCAPE BUFFER, JACKSON GAP ROAD, 15' WIDTH**

FRONTAGE LENGTH: 199 LF  
 TREES ~~5~~ 5 TREES (1 PER 40 LF)  
 TR been updated.  
 SHRUB EQUIVALENTS PROVIDED: 50 SHRUBS (10 5-GAL SHRUBS PER TREE)  
 SHRUBS REQUIRED: 50 SHRUBS (10 PER 40 LF)  
 SHRUBS PROVIDED: 43 SHRUBS

- NOTE:
- A DOUBLE ROW HEDGE WITH TRIANGULAR PLANTING WAS PROVIDED, WHICH ALLOWED THE WIDTH OF THE BUFFER TO BE REDUCED FROM 20' TO 15'.
  - SHRUB EQUIVALENTS ARE PROVIDED IN LIEU OF TREES DUE TO THE PRESENCE OF GAS LINES AND WET UTILITIES IN THE BUFFER.

**STREET FRONTAGE LANDSCAPE BUFFER, E. 64TH AVENUE**

FRONTAGE LENGTH: 200 LF  
 TREES REQUIRED: 5 TREES (1 PER 40 LF)  
 TREES PROVIDED: 0 TREES - SEE EQUIVALENTS  
 SHRUB EQUIVALENTS PROVIDED: 71 SHRUBS (10 5-GAL SHRUBS PER TREE)  
 SHRUBS REQUIRED: 50 SHRUBS (10 PER 40 LF)  
 SHRUBS PROVIDED: 50 SHRUBS

- NOTE:
- A DOUBLE ROW HEDGE WITH TRIANGULAR PLANTING WAS PROVIDED, WHICH ALLOWED THE WIDTH OF THE BUFFER TO BE REDUCED FROM 20' TO 15'.
  - SHRUB EQUIVALENTS ARE PROVIDED IN LIEU OF TREES DUE TO THE PRESENCE OF GAS LINES AND WET UTILITIES IN THE BUFFER.

**STREET FRONTAGE LANDSCAPE BUFFER, EAST PROPERTY LINE (PRIVATE DRIVE)**

FRONTAGE LENGTH: 149 LF  
 TREES REQUIRED: 4 TREES (1 PER 40 LF)  
 TREES PROVIDED: 4 TREES (INCLUDING THE EVERGREEN TREES)  
 EVERGREEN TREES PROVIDED: 3 EVERGREEN TREES  
 SHRUBS REQUIRED: 15 SHRUBS (5 PER 40 LF)  
 SHRUBS PROVIDED: 52 SHRUBS

The requirement has been updated.

Update this requirement

Why is this 5 shrubs per 40lf? This is a street frontage buffer and the requirement is 1 tree and 10 shrubs per 40 lf. The UDO does not distinguish buffer requirements between private streets vs. public.

The requirement has been updated.

**STREET FRONTAGE LANDSCAPE BUFFER, SOUTH PROPERTY LINE (PRIVATE DRIVE)**

FRONTAGE LENGTH: 143 LF  
 TREES REQUIRED: 4 TREES (1 PER 40 LF)  
 TREES PROVIDED: 4 TREES (INCLUDING THE EVERGREEN TREES)  
 EVERGREEN TREES PROVIDED: 2 EVERGREEN TREES  
 SHRUBS REQUIRED: 10 SHRUBS (10 PER 40 LF)  
 SHRUBS PROVIDED: 47 SHRUBS

NOTE: A DOUBLE ROW HEDGE WITH TRIANGULAR PLANTING WAS PROVIDED, WHICH ALLOWED THE WIDTH OF THE BUFFER TO BE REDUCED FROM 20' TO 15'.

**BUILDING PERIMETER LANDSCAPING**

SEE TABLE TITLED "NON-RESIDENTIAL BUILDING ELEVATION LANDSCAPING INFORMATION", THIS SHEET

**PARKING LOT PERIMETER SCREENING**

SCREENING IS PROVIDED BY THE HEDGE INCLUDED IN THE STREET FRONTAGE LANDSCAPE BUFFERS.

**SCREENING OF DUMPSTER ENCLOSURE**

LENGTH OF ENCLOSURE: 55 LF  
 TREES REQUIRED: 1 TREES (1 PER 40 LF)  
 TREES PROVIDED: 1 TREES  
 SHRUBS REQUIRED: 14 SHRUBS (10 PER 40 LF)  
 SHRUBS PROVIDED: 14 SHRUBS



(800) 680-6630  
 1600 Broadway, Suite 1600  
 Denver, CO 80202  
 www.EvergreenDesignGroup.com



ALL IN ONE

NOT FOR CONSTRUCTION

DATE	01/16/2023	10/04/2023						

drawn by LC  
 designed by LC  
 approved by LC/RM  
 project no. -

LANDSCAPE NOTES  
 NICK'S CONVENIENCE  
 xxxxxx E. 64th AVENUE  
 AURORA, COLORADO






EXTERIOR MATERIALS SCHEDULE (NOT ALL MATERIALS IN SCHEDULE ARE USED)		
NO.	MATERIAL	MANUF.-COLOR
N-1	HANDCRAFTED VENEER STONE	STONE STYLER - PA MASONRY
N-2	FIBERON COMPOSITE WOOD PANELING	FIBERON - MORA
CMU-1	SPLIT-FACE CONCRETE MASONRY UNIT	BASALITE - SPLIT FACE - EBONY
E-1	THREE COAT STUCCO SYSTEM	THREE COAT STUCCO SYSTEM - STAINLESS
E-2	THREE COAT STUCCO SYSTEM	THREE COAT STUCCO SYSTEM - FLINT
S-1	ALUMINUM STOREFRONT GLAZING	METAL ACCENTS - SW 7675 'SEAL SKIN'
P-3	PREFINISHED PARAPET CAP	20 GA. PREFINISHED METAL CAP- DARK BRONZE
C-1	PREFINISHED ALUMINUM CANOPY	MAPES LUMISHADE CANOPY - ALUMINUM-BAKED ENAMEL W/ REAR GUTTER CONNECTIONS
C-2	FUELING CANOPY	20 GA. PREFINISHED METAL - DARK BRONZE


Table 4.8-8 Façade Character Elements for Four-Sided Building Design				
BUILDING FACE	Mixed-Use and Multifamily Residential Districts			
	PRIMARY FAÇADE	SECONDARY FAÇADE	MINOR FAÇADE	MINOR FAÇADE
<b>Massing</b>				
General	3	2	1	
Wall offset (min. 3 ft.)	X	X	X	
Wall/parapet height change (min. 3 ft.)	X	X	X	
Roof form change				
Upper floor setback				
Wall notch (min. 12 in.)	X	X	X	
<b>Materials</b>				
General	2	2	1	
Change in material	X	X	X	
Change in color	X	X	X	
Change in texture	X	X	X	
Use of masonry (min. 40% of façade)				
Use of panelized materials (min. 40% of façade)				
Variety of window sizes				
Transparency and glazing (min 70% transparent glass)				
<b>Human Scale</b>				
General	3	2	1	
Architectural detailing	X	X	X	
Display cases on ground floor (for mixed-use)				
Building-mounted lighting fixtures	X	X	X	
Awnings or shutters	X	X	X	
Entry definition (pronounced massing/roof form, stoop, porch, etc.)	X	X	X	
Building corner enhancements	X	X	X	
Wall art				
Balconies				
Landscape wall/decorative screen for vines				

A roof form or height variation is required for roofs, including canopy roofs. Variation is required every 60 ft, so this will only be needed on the front and rear elevations. The added cornice, while appreciated, does not vary along the length of the canopy.


The canopy has been revised to include a 2 foot high raised portion in the center of the canopy

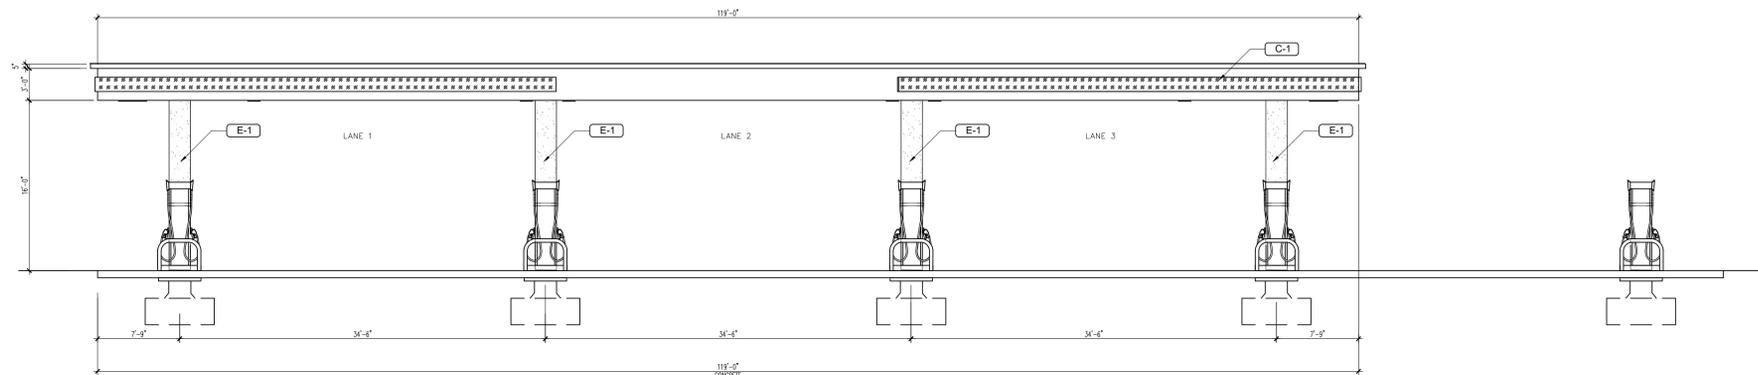


5 ELEVATION - SOUTH  
1/4" = 1'-0"

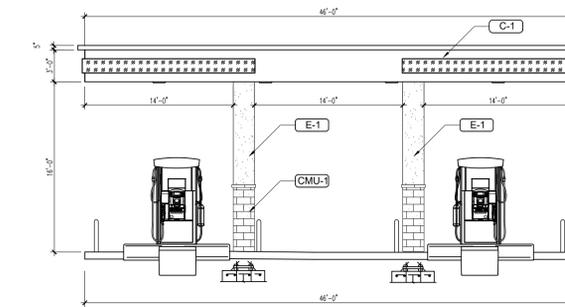


6 ELEVATION - EAST  
1/4" = 1'-0"

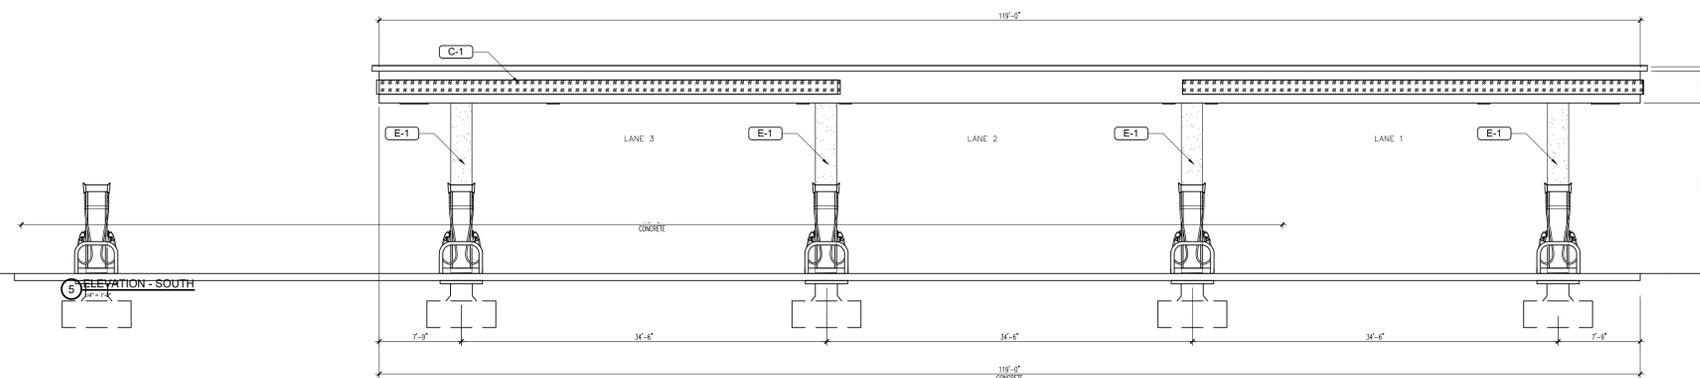


7 ELEVATION - NORTH  
1/4" = 1'-0"

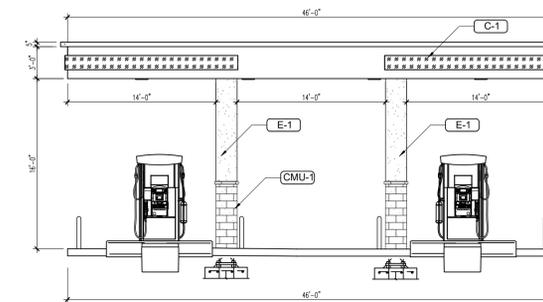


8 ELEVATION - WEST  
1/4" = 1'-0"

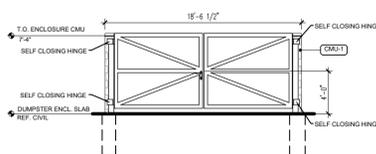


9 FRONT DUMPSTER ENCL. ELEVATION  
1/4" = 1'-0"

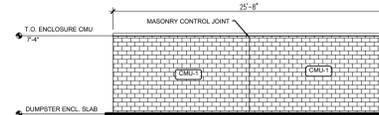

10 REAR DUMPSTER ENCL. ELEVATION  
3/8" = 1'-0"

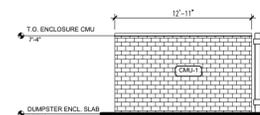

11 SIDE DUMPSTER ENCL. ELEVATION  
3/8" = 1'-0"

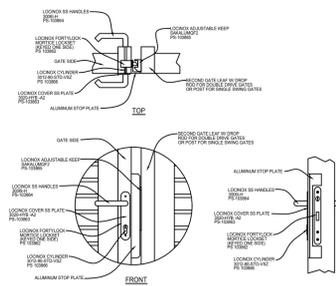

12 SELF CLOSING LATCH DETAIL  
1/8"

PROJECT NUMBER	C 22-126	
DRAWING ISSUANCE	10.10.2023	
DRAWN BY:	XX	
CHECKED BY:	XX	
DRAWING REVISIONS		
NO.	DESCRIPTION	DATE

DRAWING SEAL





10.10.2023  
DRAWING TITLE  
EXTERIOR ELEVATIONS

DRAWING NUMBER




# SITE PLAN - NICK'S CONVENIENCE

LOT 1, BLOCK 1, PORTEOS PA-9A SUBDIVISION FILING NO. 1  
 LOCATED IN A PORTION OF THE NORTH ONE-HALF OF SECTION 8,  
 TOWNSHIP 3 SOUTH, RANGE 65 WEST OF THE 6th P.M.  
 CITY OF AURORA, COUNTY OF ADAMS, STATE OF COLORADO

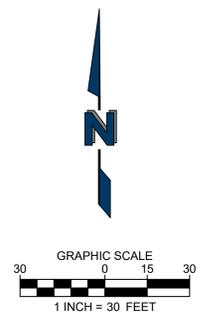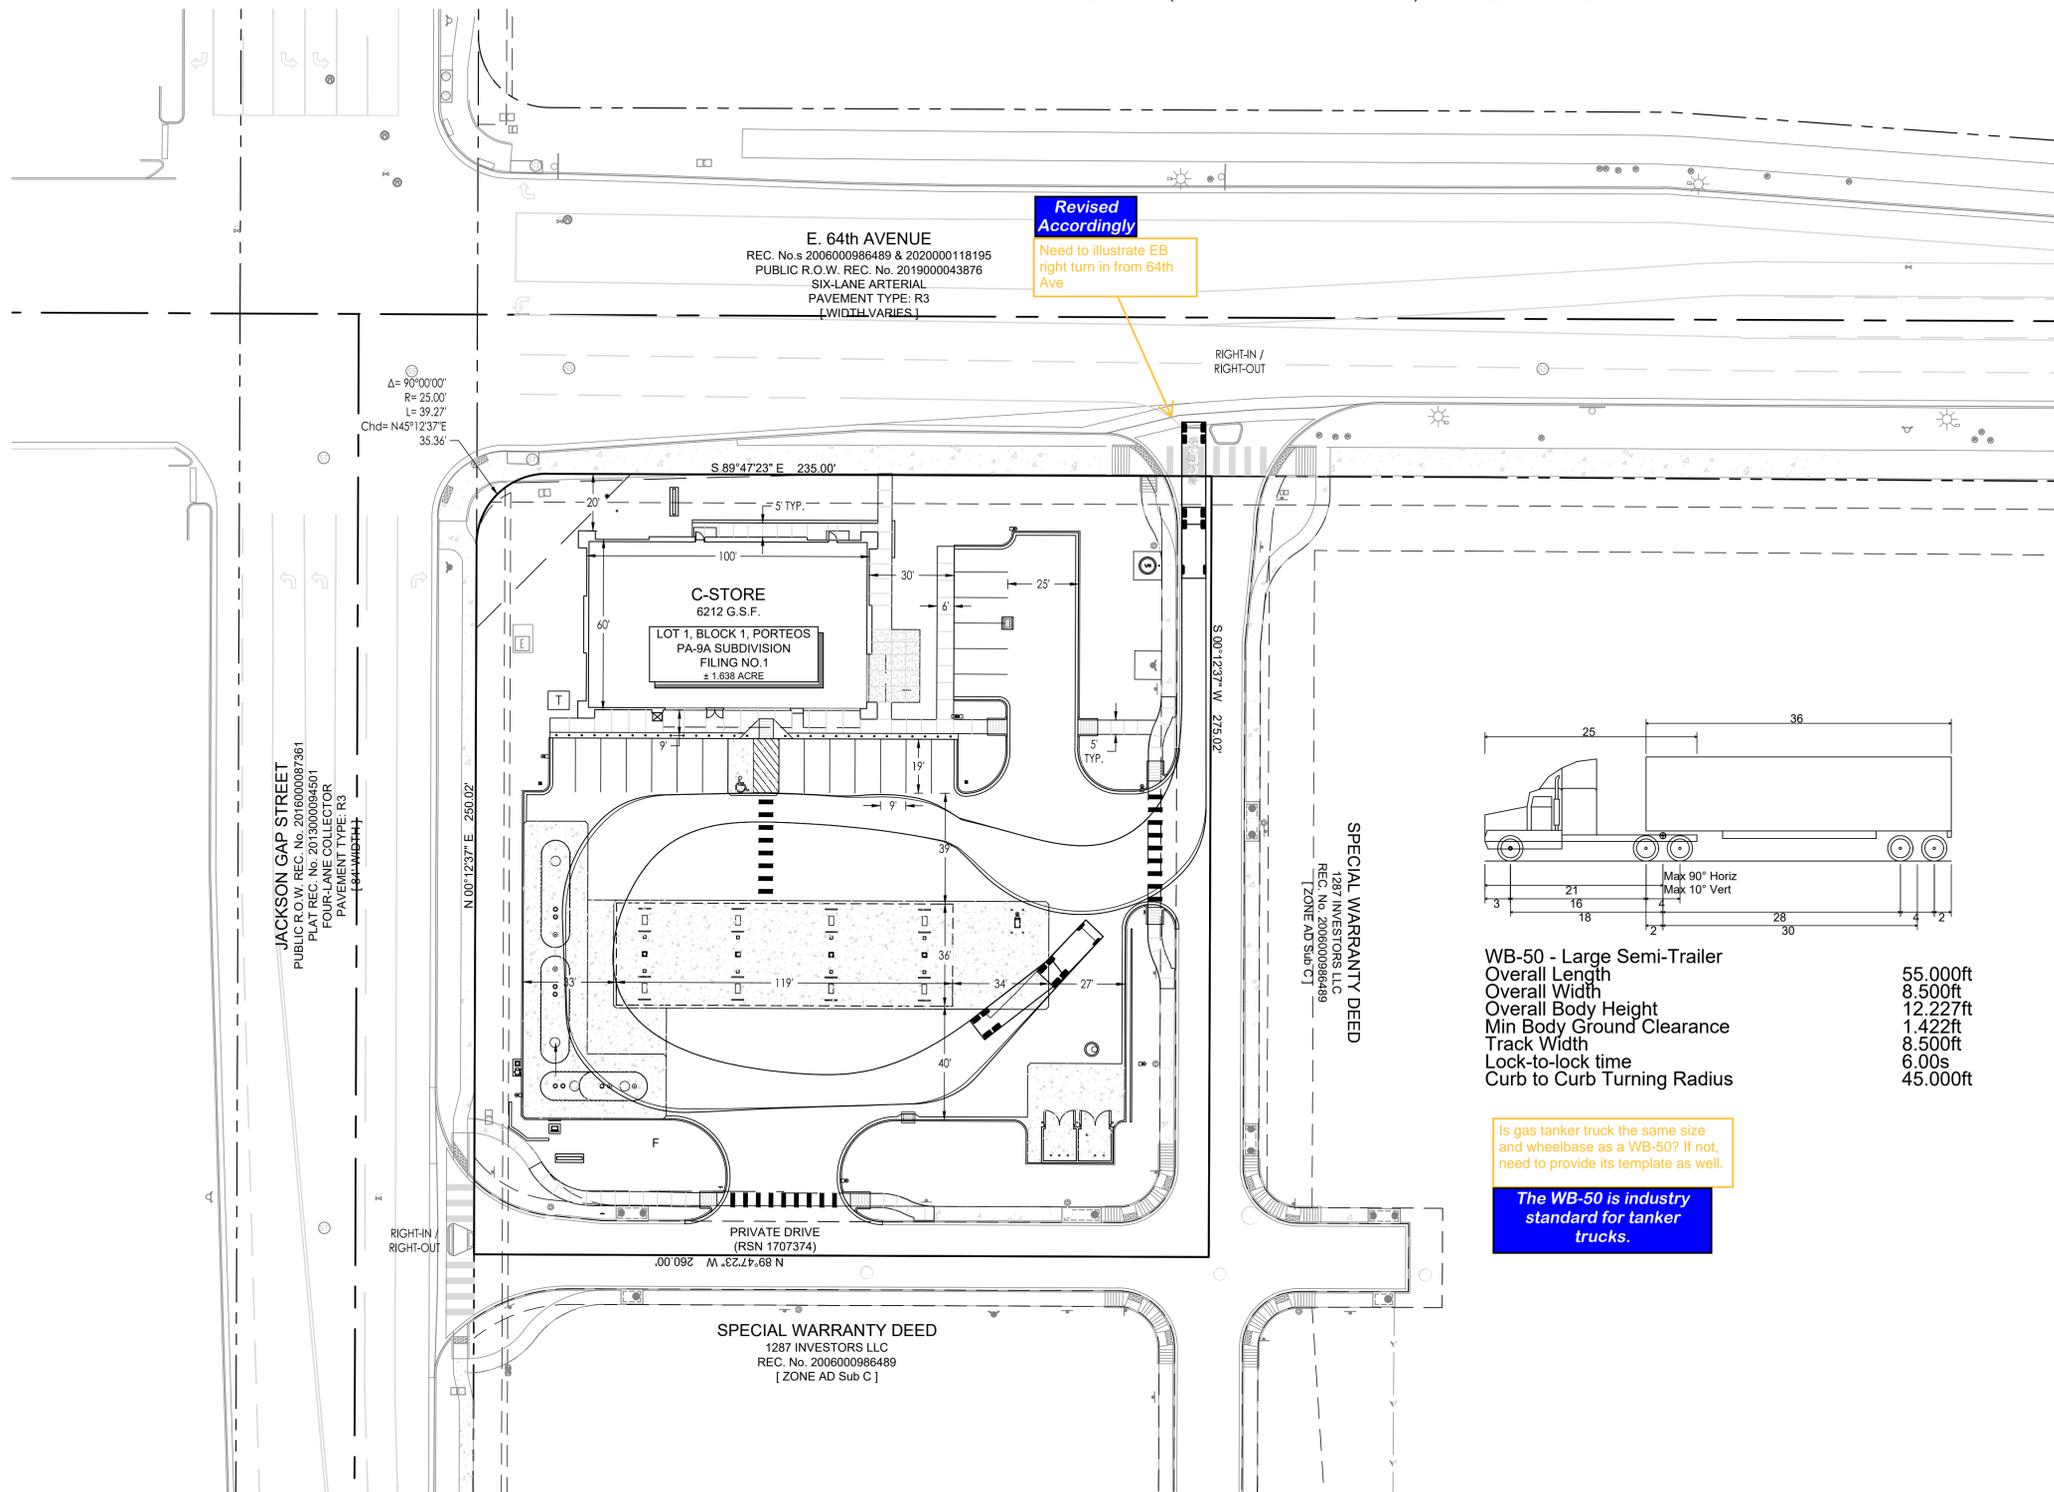

**LEGEND**

[Symbol]	PARCEL BOUNDARY
[Symbol]	ADJACENT PROPERTY
[Symbol]	SECTION LINE
[Symbol]	EASEMENT LINE
[Symbol]	ADA PATH OF TRAVEL
[Symbol]	PUBLIC STREET STRIPING
[Symbol]	PROPOSED SITE STRIPING
[Symbol]	PUBLIC REGULATORY SIGNS
[Symbol]	STREET LIGHTING/BY-OTHERS
[Symbol]	PROPOSED SITE LIGHTING
[Symbol]	PROPOSED KNOX BOX
[Symbol]	EMERGENCY FUEL SHUT-OFF
[Symbol]	CURB & GUTTER EXISTING/BY-OTHERS
[Symbol]	PROPOSED CURB & GUTTER
[Symbol]	SIDEWALK EXISTING / BY-OTHERS
[Symbol]	PROPOSED SIDEWALK
[Symbol]	PROPOSED ASPHALT PAVING
[Symbol]	PROPOSED CONCRETE PAVING
[Symbol]	SITE TRIANGLES
[Symbol]	BUILDING SETBACK LINE
[Symbol]	ADA PATH

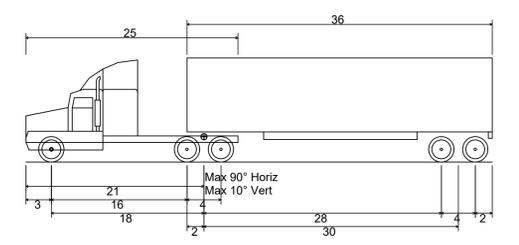

Is gas tanker truck the same size and wheelbase as a WB-50? If not, need to provide its template as well.

**The WB-50 is industry standard for tanker trucks.**

[C-Base.dwg] [V-Base (Porteos).dwg] [ent 24x36TB (Nicks PA-9a).dwg] [wb-50 circulation of C-Base (2023-06-06).dwg]  
 Drawing name: L:\Nicks Investments\C22-126 - Aurora, CO - 64th & Jackson Gap\02 Civil\CAD\SP\Truck Exhibit.dwg Oct. 05, 2023 - 9:39pm

DATE	DESCRIPTION
07/14/2023	INITIAL SUBMITTAL
10/06/2023	RESPONSE TO COMMENTS UPDATE
	drawn by JDT
	designed by JDT
	approved by -
	project no. -

**TRUCK MANEUVER EXHIBIT**

**NICK'S CONVENIENCE**  
 xxxxxx E. 64th AVENUE  
 AURORA, COLORADO



October 5, 2023

Steve Cromer  
The Dimension Group  
5600 S Quebec Street, Suite 205B  
Greenwood Village, Colorado 80111

2023-10-25 (DJK)  
Minor edit needed for Trip Gen tables, also need graphic figure of trip distribution and site trips on roadway network.

Comment acknowledged. Individual responses provided to comments below.

**RE: Nick's Convenience – Jackson Gap  
Traffic Generation Comparison and Impact Analysis  
Aurora, Colorado**

Dear Steve,

SM ROCHA, LLC is pleased to provide traffic generation information for the development entitled Nick's Convenience – Jackson Gap. This development is located on the southeast corner of Jackson Gap Street and E 64<sup>th</sup> Avenue in Aurora, Colorado.

This information has been revised to address City Staff review comments dated August 22, 2023, regarding referenced traffic studies, traffic generation comparison, and pass-by rates.

The intent of this analysis is to present traffic volumes likely generated by the proposed development, provide a traffic volume comparison to previous land use assumptions approved for the development site within the Porteos PA 9A/9C Transportation Impact Study<sup>1</sup>, and consider potential impacts to the adjacent roadway network. This analysis is also provided to include an updated traffic signal warrant analysis at the intersection of Jackson Gap Street and E 64<sup>th</sup> Avenue.

The following is a summary of analysis results.

### **Site Description and Access**

Land for the development is currently vacant and surrounded by open space and a mix of commercial and industrial land uses. The proposed development is understood to entail the new construction of an approximate 6,200-square foot gas station convenience store supporting 16 fueling positions.

Proposed access to the development is provided at the following locations: one right-in / right-out access onto Jackson Gap Street (referred to as Access A) and one right-in / right-out access onto E 64<sup>th</sup> Avenue (referred to as Access B). Access A and Access B will operate as shared access drives with future commercial developments within the overall area.

General site and access locations are shown on Figure 1. A site plan, as prepared by The Dimension Group, is shown on Figure 2. This plan is provided for illustrative purposes only.

<sup>1</sup> Porteos PA 9A/9C in Aurora: Transportation Impact Study, Felsburg Holt & Ullevig, February 2023.



North  
Not to Scale



**NICK'S CONVENIENCE - JACKSON GAP**  
*Traffic Generation Analysis*  
**SM ROCHA, LLC**  
*Traffic and Transportation Consultants*

**Figure 1**  
**SITE LOCATION**



### Vehicle Trip Generation

Standard traffic generation characteristics compiled by the Institute of Transportation Engineers (ITE) in their report entitled Trip Generation Manual, 11<sup>th</sup> Edition, were applied to the proposed land use in order to estimate the average daily traffic (ADT) and peak hour vehicle trips. A vehicle trip is defined as a one-way vehicle movement from point of origin to point of destination.

Table 1 presents average trip generation rates for the development area proposed. Use of average trip generation rates presents a conservative analysis. ITE land use code 945 (Convenience Store / Gas Station) was used for analysis because of its best fit to the proposed land use.

**Table 1 – Trip Generation Rates**

ITE CODE	LAND USE	UNIT	TRIP GENERATION RATES						
			24 HOUR	AM PEAK HOUR			PM PEAK HOUR		
				ENTER	EXIT	TOTAL	ENTER	EXIT	TOTAL
945	Convenience Store/Gas Station	VFP	345.75	15.80	15.80	31.60	13.45	13.45	26.90

Key: VFP = Vehicle Fueling Positions.  
 Note: All data and calculations above are subject to being rounded to nearest value.

Table 2 summarizes the projected ADT and peak hour traffic volumes likely generated by the land use area proposed and provides comparison to traffic volume estimates of the previously approved land use.

**Table 2 – Trip Generation Summary**

Add note that this was for a 3,500 sf convenience store, ITE subcategory 2-4k facility

Note added.

LAND USE	SIZE		TOTAL TRIPS GENERATED						
			24 HOUR	AM PEAK HOUR			PM PEAK HOUR		
				ENTER	EXIT	TOTAL	ENTER	EXIT	TOTAL
<i>Site Development - Previously Approved</i>									
945	Convenience Store/Gas Station	16 VFP	3,383	128	129	257	147	148	295
<i>Previously Approved Total:</i>			3,383	128	129	257	147	148	295
<i>Site Development - Proposed</i>									
945	Convenience Store/Gas Station	16 VFP	5,532	253	253	506	215	215	430
<i>Proposed Total:</i>			5,532	253	253	506	215	215	430
<i>Difference Total:</i>			2,149	125	124	249	68	67	135

Key: VFP = Vehicle Fueling Positions.  
 Note: All data and calculations above are subject to being rounded to nearest value.

Add note that this is for the proposed 6,200 sf convenience store, ITE subcategory 5.5-10k facility

Note added.

proposed development area has the potential to generate approximately 5,532 those occurring during the morning peak hour and 430 during the afternoon

### Adjustments to Trip Generation Rates

A development of this type is likely to attract pass-by trips from the adjacent roadway system. ITE defines a pass-by trip as an intermediate stop on the way from an origin to a primary trip destination without a route diversion. Due to this behavior, pass-by trips are not considered as “new” traffic generated by the development since the trips are already present on the roadway network enroute to their primary destination.

Pass-by trips are especially common to service stations with convenience store land uses given the convenience provided by these businesses on the way to another primary destination such as a place of work or home. For example, published ITE pass-by and diverted link trip data from ITE’s Trip Generation Handbook, 3<sup>rd</sup> Edition, indicates an average trip generation reduction rate of 62 percent during the AM peak traffic hour and 56 percent during the PM peak traffic hour as typical to convenience store / gas station land uses.

Reviewed, accept values as presented

Upon consideration of the proposed land use, pursuant to ITE average data to the proposed land use in order to account for pass-by trip generation. ITE average pass-by trip percentages used are presented in Table 3. It is noted that the approved Porteos PA 9A/9C traffic study did not apply reductions due to pass-by trips. However, pass-by rates were applied to the previously approved trip generation in order to provide for a more accurate comparison.

Comment acknowledged.

Table 3 illustrates projected ADT, AM Peak Hour, and PM Peak Hour traffic volumes likely generated by the proposed development upon build-out with reductions applied due to pass-by trips. Average daily (24-Hour) pass-by trip percentages were estimated as the average between the AM and PM peak hour rates indicated by ITE.

**Table 3 – Trip Generation Summary with Reductions**

ITE CODE	LAND USE	SIZE	TOTAL NEW TRIPS GENERATED							
			24 HOUR	AM PEAK HOUR			PM PEAK HOUR			
				ENTER	EXIT	TOTAL	ENTER	EXIT	TOTAL	
<u>Site Development - Previously Approved</u>										
			<i>Pass-By Trip Reduction:</i>	59%	62%	62%	62%	56%	56%	56%
945	Convenience Store/Gas Station	16 VFP	1,387	49	49	98	65	65	130	
			<i>Previously Approved Total:</i>	1,387	49	49	98	65	65	130
<u>Site Development - Proposed</u>										
			<i>Pass-By Trip Reduction:</i>	59%	62%	62%	62%	56%	56%	56%
945	Convenience Store/Gas Station	16 VFP	2,268	96	96	192	95	95	189	
			<i>Proposed Total:</i>	2,268	96	96	192	95	95	189
			<b><i>Difference Total:</i></b>	<b>881</b>	<b>47</b>	<b>47</b>	<b>94</b>	<b>30</b>	<b>30</b>	<b>60</b>

Key: VFP = Vehicle Fueling Positions.  
 Note: All data and calculations above are subject to being rounded to nearest value.

Upon build-out and with consideration for pass-by trip reductions, Table 3 illustrates that the proposed development has the potential to generate approximately 2,268 daily trips with 192 of those occurring during the morning peak hour and 189 during the afternoon peak hour. Compared to the previously approved land use, this represents a potential increase in site traffic generation of approximately 881 new daily trips with 94 of those occurring during the morning peak hour and 60 during the afternoon peak hour.

It is noted that the proposed development accommodates an approximate 6,200 square foot convenience store, compared to the previously approved 3,500 square foot development. ITE trip generation rates consider both vehicle fueling positions and square-footage of the development, therefore gas station/convenience store developments with the same amount of vehicle fueling positions will likely experience different site-generated trip rates if the convenience stores have different footprints. As a result, the proposed convenience store/gas station is expected to generate more trips than that previously approved.

agreed

Comment acknowledged.

### Trip Generation Distribution and Assignment

Overall directional distribution of site-generated traffic was determined based on existing area land uses, the site location within the City, and the available roadway network. Site-generated traffic is anticipated to be distributed through each proposed access. Distribution along Jackson Gap Street is general and assumed to be 50 percent to/from the north and 15 percent to/from the south. Distribution along E 64<sup>th</sup> Avenue is assumed to be 30 percent to/from the west and 5 percent to/from the east. Additional pass-by trip distribution is assumed to include vehicle routes heading east along E 64<sup>th</sup> Avenue and north along Jackson Gap Street. Distribution percentages utilized for pass-by trips are anticipated to be 50 percent from the west and the south.

Traffic assignment is how the site-generated and distributed trips are expected to be loaded on the roadway network. Applying assumed trip distribution patterns to site-generated traffic provides the peak hour trip volume assignments for the proposed accesses. These volumes are then divided further upon travel through adjacent roadways serving the overall development area. Table 4 below uses the difference in trip generation volumes from Table 3 and denotes projected traffic volumes at each proposed access and the adjacent intersection.

It is to be noted that the overall site-generated trip assignments shown in Table 4 represent the combination of both primary trip generation and pass-by trips. Due to the application of pass-by trips, some negative site-generated trips are shown at the study intersections. These negative trips are the result of redistributing existing through volumes along Jackson Gap Street and E 64<sup>th</sup> Avenue to site-generated ingress volumes.

Provide a graphic figure depicting trip distribution and trip assignment from the site onto the roadway network around the intersection of 64th & Jackson Gap as well as the site accesses.

Site generated trip distribution/assignment figure added.

**Table 4 – Site Generated Trip Assignment**

DEVELOPMENT ACCESS TURNING MOVEMENTS	AM PEAK HOUR		PM PEAK HOUR	
	Inbound Volume	Outbound Volume	Inbound Volume	Outbound Volume
Access A / Jackson Gap Street				
Westbound Right	-	61	-	34
Northbound Through	-39	-	-19	-
Northbound Right	53	-	27	-
Southbound Through	7	7	4	5
Access B / E 64th Avenue				
Eastbound Through	-39	-	-19	-
Eastbound Right	72	-	41	-
Westbound Through	-	21	-	14
Northbound Right	-	63	-	33
E 64th Avenue / Jackson Gap Street				
Eastbound Through	12	-	8	-
Eastbound Right	2	-	1	-
Westbound Left	3	7	2	5
Westbound Through	-	7	-	5
Westbound Right	-	7	-	4
Northbound Left	-	7	-	5
Northbound Through	-	16	-	10
Southbound Left	21	-	14	-
Southbound Through	2	-	1	-

**Development Impacts**

As Tables 3 and 4 show, there is an increase in peak hour traffic volumes anticipated for the proposed development. These volumes are expected to have a potential impact for when signalization at the intersection of Jackson Gap Street and E 64<sup>th</sup> Avenue may be warranted.

## **Total Traffic Signal Warrant – Year 2025**

For purposes of this study, it is anticipated that development construction would be completed by end of Year 2025. In order to conduct a signal warrant analysis for Year 2025 total traffic conditions, traffic volumes were obtained from the Porteos PA 9A/9C Transportation Impact Study. Short-term total volumes were obtained from the reference study which also account for projected trips from future developments in the area. These volumes were then added to the site-generated trips for this development in order to project Year 2025 total traffic volumes for the Jackson Gap Street and E 64<sup>th</sup> Avenue intersection.

These total volumes were then used to conduct a signal warrant analysis for the Jackson Gap Street and E 64<sup>th</sup> Avenue intersection in order to review potential for traffic signal control. Analysis results conclude that the intersection was found to be above the minimum vehicle volumes required to meet Warrant 3 – Peak Hour, from the Manual on Uniform Traffic Control Devices (MUTCD)<sup>2</sup>, for the installation of a traffic signal. Warrant study worksheets are provided for reference in Attachment A.

Warrant 3 is intended for use at locations where traffic conditions are such that for a minimum of one hour on an average day, the minor-street (E 64<sup>th</sup> Avenue) traffic suffers undue delay when entering or crossing the major street (Jackson Gap Street). This assumption provides for a conservative analysis. Said intersection should be monitored further by City Staff as area development occurs to determine when signalization installation is appropriate.

---

<sup>2</sup> Manual on Uniform Traffic Control Devices, 2009 Edition, Federal Highway Administration, May 2012.

## Conclusion

This analysis assessed traffic generation for the Nick's Convenience – Jackson Gap development, provided a traffic volume comparison to previous land use assumptions approved for the development site, and considered potential impacts to the adjacent roadway network.

It is our professional opinion that the proposed site-generated traffic is expected to create minimal negative impact to traffic operations for the surrounding roadway network and proposed site accesses, as well as at the Jackson Gap Street intersection with E 64<sup>th</sup> Avenue. Signal warrant analysis concludes that a traffic signal is warranted at the Jackson Gap Street and E 64<sup>th</sup> Avenue intersection under projected Year 2025 total traffic conditions.

We trust that our findings will assist in the planning and approval of the Nick's Convenience - Jackson Gap development. Please contact us should further assistance be needed.

Sincerely,

**SM ROCHA, LLC**  
*Traffic and Transportation Consultants*



Megan Bock, EIT  
Traffic Engineer




Fred Lantz, PE  
Traffic Engineer

**ATTACHMENT A**

**Warrant Analysis Forms**

**Figure 4C-3. Warrant 3, Peak Hour**

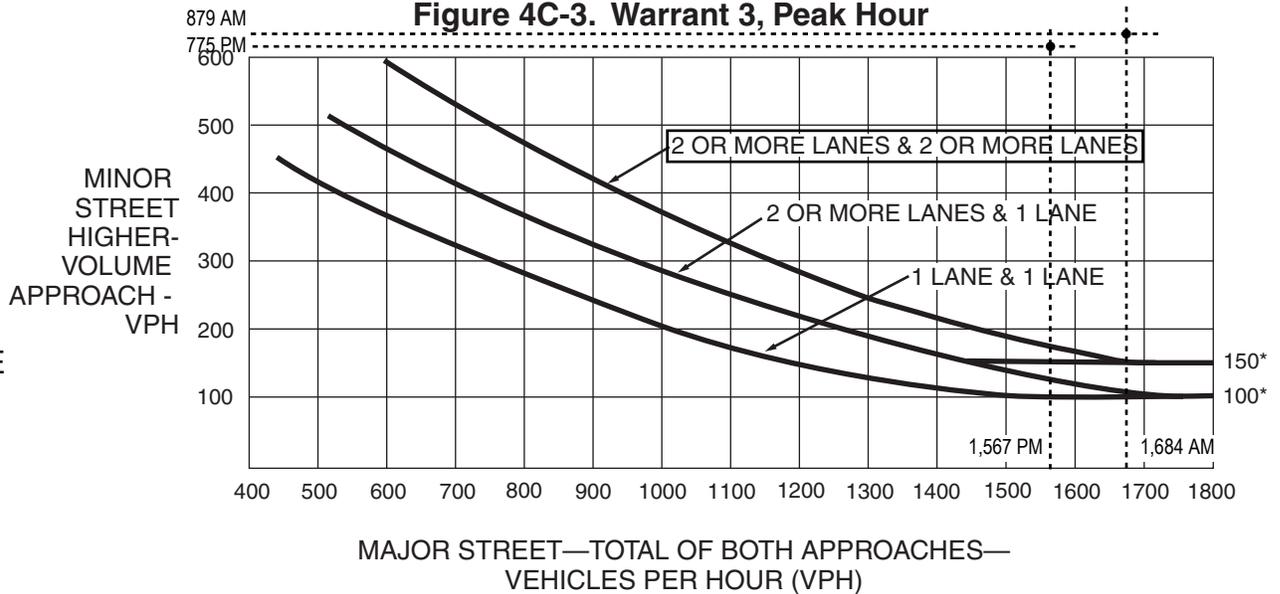


\*Note: 150 vph applies as the lower threshold volume for a minor-street approach with two or more lanes and 100 vph applies as the lower threshold volume for a minor-street approach with one lane.

JACKSON GAP STREET (40 MPH)

Note: 100% right turn reduction applied along Jackson Gap Street.

**Figure 4C-4. Warrant 3, Peak Hour (70% Factor)**

(COMMUNITY LESS THAN 10,000 POPULATION OR ABOVE 40 MPH ON MAJOR STREET)

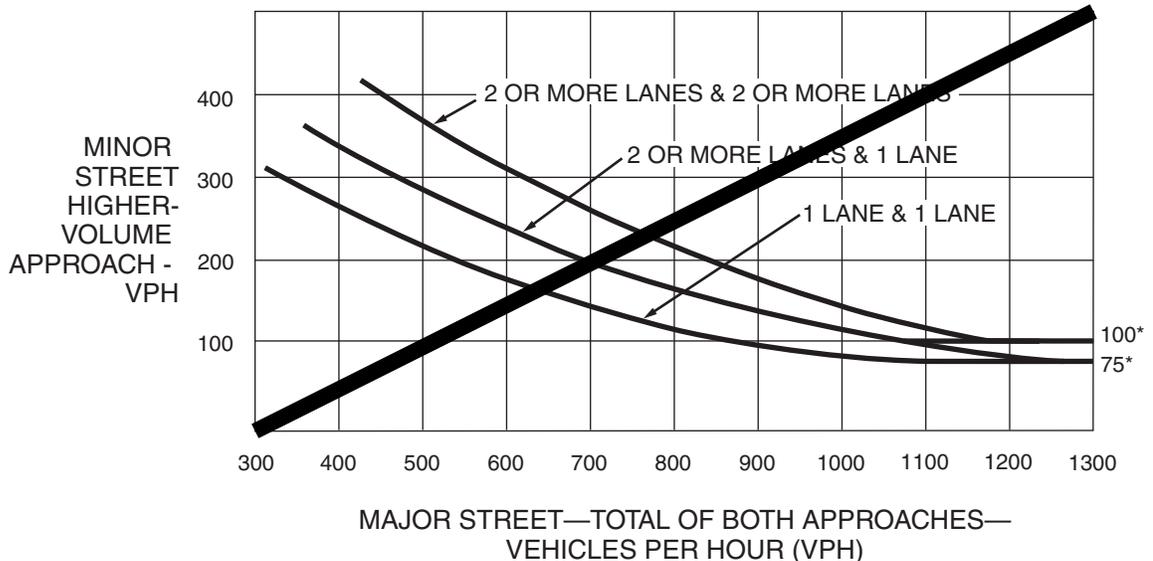

\*Note: 100 vph applies as the lower threshold volume for a minor-street approach with two or more lanes and 75 vph applies as the lower threshold volume for a minor-street approach with one lane.