

# NATURAL GAS & CRUDE OIL PIPELINE GATHERING SYSTEM

## AS-BUILT SITE PLAN

### CRESTONE PEAK RESOURCES MIDSTREAM LLC

SECTIONS 19, 20, 29, 30, 32, 33, & 34, TOWNSHIP 3 SOUTH, RANGE 64 WEST, SECTIONS 13,15, 22, 23, 24, 25, 26, 27, 33, & 34, TOWNSHIP 3 SOUTH, RANGE 65 WEST, OF THE SIXTH PRINCIPAL MERIDIAN, CITY OF AURORA, ADAMS COUNTY, STATE OF COLORADO  
SECTIONS 3, 15, 17, 20, 21, 22, 25, 26, 27 & 28, TOWNSHIP 4 SOUTH, RANGE 65 WEST, SECTIONS 18, 19 & 30, TOWNSHIP 4 SOUTH, RANGE 64 WEST OF THE SIXTH PRINCIPAL MERIDIAN, CITY OF AURORA, ARAPAHOE COUNTY, STATE OF COLORADO

#### AS-BUILT SITE PLAN NOTES:

- TOTAL LENGTH OF GATHERING SYSTEM = 33 MILES.
- ALL INTERESTED PARTIES ARE HEREBY ALERTED THAT THIS SITE PLAN IS SUBJECT TO ADMINISTRATIVE CHANGES AND AS SHOWN ON THE ORIGINAL SITE PLAN ON FIELD IN THE AURORA CITY PLANNING OFFICE AT THE MUNICIPAL BUILDING. A COPY OF THE OFFICIAL CURRENT PLAN MAY BE PURCHASED THERE. LIKEWISE, SITE PLANS ARE REQUIRED TO AGREE WITH THE APPROVED SUBDIVISION PLAT OF RECORD AT THE TIME OF A BUILDING PERMIT, AND IF NOT MUST BE AMENDED TO AGREE WITH THE PLAT AS NEEDED, OR VICE VERSA.
- ERRORS IN APPROVED SITE PLANS RESULTING FROM COMPUTATIONS OF INCONSISTENCIES IN THE DRAWINGS MADE BY THE APPLICANT ARE THE RESPONSIBILITY OF THE APPLICANT OF RECORD. WHERE FOUND, THE CURRENT MINIMUM CODE REQUIREMENTS WILL APPLY AT THE TIME OF BUILDING PERMIT. PLEASE BE SURE THAT ALL PLAN COMPUTATIONS ARE CORRECT.
- ALL REPRESENTATIONS AND COMMITMENTS MADE BY APPLICANT AT PUBLIC HEARINGS, REGARDING THIS PLAN, ARE BINDING UPON THE APPLICANT, AND ITS HEIRS, SUCCESSORS, AND ASSIGNS.
- THE CITY OF AURORA REQUIRES PLAN AND PROFILES (P&P) OF THE PROPOSED PIPELINE AT CITY OF AURORA RIGHTS-OF-WAY AND EASEMENTS WITH ALL LICENSE AGREEMENTS AND CIVIL PLAN SUBMITTALS. THE P&PS SHALL SHOW ALL EXISTING AND KNOWN PROPOSED UTILITIES WITH VERIFIED ELEVATIONS BASED ON PRE-DESIGN POT-HOLING AND DEMONSTRATE THE REQUIRED MINIMUM HORIZONTAL AND VERTICAL UTILITY CLEARANCES ARE BEING MET.
- AS-BUILT DRAWINGS SHALL BE PROVIDED TO THE CITY OF AURORA WITHIN 30 DAYS OF FINAL CONSTRUCTION IN A FORMAT THAT MEETS THE LATEST CITY OF AURORA CAD DATA SUBMITTAL STANDARDS.
- PIPELINES CONSTRUCTED THROUGH COLLECTORS OR LOCALS SHALL PROVIDE 15' OF COVER MINIMUM, UNLESS OTHERWISE STATED ON PLANS. IF A CROSSING WILL NOT MEET MINIMUM COVER, A VARIANCE REQUEST WILL BE REQUIRED.
- PIPELINES CONSTRUCTED THROUGH ARTERIALS SHALL PROVIDE 20' OF COVER MINIMUM, UNLESS OTHERWISE STATED ON PLANS. IF A CROSSING WILL NOT MEET MINIMUM COVER, A VARIANCE REQUEST WILL BE REQUIRED.
- DISTURBED GROUND TO BE RETURNED TO EXISTING ELEVATIONS.
- IN THE EVENT GROUNDWATER IS ENCOUNTERED DURING PIPELINE CONSTRUCTION, CONTRACTOR SHALL NOTIFY THE CITY OF AURORA AND BE PREPARED TO REPORT THE LOCATION AND DEPTH OF THE GROUNDWATER. ADDITIONALLY, IF DEWATERING OF THE TRENCH IS NECESSARY, A DEWATERING PERMIT FROM COLORADO DEPARTMENT OF PUBLIC HEALTH AND ENVIRONMENT MAY BE REQUIRED.
- A FLOODPLAIN DEVELOPMENT PERMIT IS REQUIRED FOR ALL WORK WITHIN A FEMA DESIGNATED FLOODPLAIN.
- UPON REMOVING A GATHERING SYSTEM OR FLOWLINE FROM SERVICE, ALL SEGMENTS MUST BE REMOVED OR ABANDONED IN PLACE USING FLOWFILL OR SIMILAR.
- ALL AMENDMENTS TO THIS SITE PLAN SHALL UTILIZE EASEMENTS THAT DO NOT SIGNIFICANTLY ENCUMBER CURBSIDE LANDSCAPING OR STREET FRONTAGE LANDSCAPE BUFFERS FOR FUTURE DEVELOPMENTS. THIS CAN BE DONE BY EITHER LOCATING ALL EASEMENTS OUTSIDE OF THESE IDENTIFIED AREAS OR INCLUDING EASEMENT LANGUAGE THAT ALLOWS SUFFICIENT PLANTINGS (AS DETERMINED BY THE CITY LANDSCAPE ARCHITECT) TO BE INSTALLED WITHIN EASEMENTS.
- THE GATHERING SYSTEM AND FLOWLINE WILL NOT HAVE ANY UNDUE ADVERSE EFFECTS ON EXISTING AND FUTURE DEVELOPMENT OF THE SURROUNDING AREA AS SET FORTH IN APPLICABLE CITY MASTER PLANS. THE DESIGN OF THE PROPOSED GATHERING SYSTEM AND FLOWLINE MITIGATES NEGATIVE IMPACTS ON THE SURROUNDING AREA TO THE GREATEST EXTENT FEASIBLE. THE DISTURBED AREA SHALL BE MAINTAINED DURING CONSTRUCTION BY THE APPLICANT OR PROPERTY OWNER IN SUCH A MANNER TO CONTROL SOIL EROSION, DUST AND THE GROWTH OF NOXIOUS WEEDS.

#### NATURAL GAS & CRUDE OIL PIPELINE GATHERING SYSTEM AS-BUILT SITE PLAN CRESTONE PEAK RESOURCES MIDSTREAM LLC

THIS SITE PLAN AND ANY AMENDMENTS HERETO, UPON APPROVAL BY THE CITY OF AURORA AND RECORDING, SHALL BE BINDING UPON THE APPLICANTS THEREFORE, THEIR SUCCESSORS AND ASSIGNS. THIS PLAN SHALL LIMIT AND CONTROL THE ISSUANCE AND VALIDITY OF ALL BUILDING PERMITS, AND SHALL RESTRICT AND LIMIT THE CONSTRUCTION, LOCATION, USE, OCCUPANCY AND OPERATION OF ALL LAND AND STRUCTURES WITHIN THIS PLAN TO ALL CONDITIONS, REQUIREMENTS, LOCATIONS AND LIMITATIONS SET FORTH HEREIN. ABANDONMENT, WITHDRAWAL OR AMENDMENT OF THIS PLAN MAY BE PERMITTED ONLY UPON APPROVAL OF THE CITY OF AURORA.

IN WITNESS WHEREOF, \_\_\_\_\_ HAS CAUSED THESE  
(CORPORATION, COMPANY, OR INDIVIDUAL)

PRESENTS TO BE EXECUTED THIS \_\_\_\_\_ DAY OF \_\_\_\_\_ AD, 20\_\_\_\_.

BY: \_\_\_\_\_  
(PRINCIPALS OR OWNERS)

STATE OF \_\_\_\_\_, JSS

COUNTY OF \_\_\_\_\_

THE FOREGOING INSTRUMENT WAS ACKNOWLEDGED BEFORE ME THIS \_\_\_\_\_ DAY OF \_\_\_\_\_ AD, 20\_\_\_\_ BY


\_\_\_\_\_  
(PRINCIPALS OR OWNERS)

WITNESS MY HAND AND SEAL

\_\_\_\_\_  
(NOTARY PUBLIC)

MY COMMISSION EXPIRES: \_\_\_\_\_

NOTARY BUSINESS ADDRESS: \_\_\_\_\_

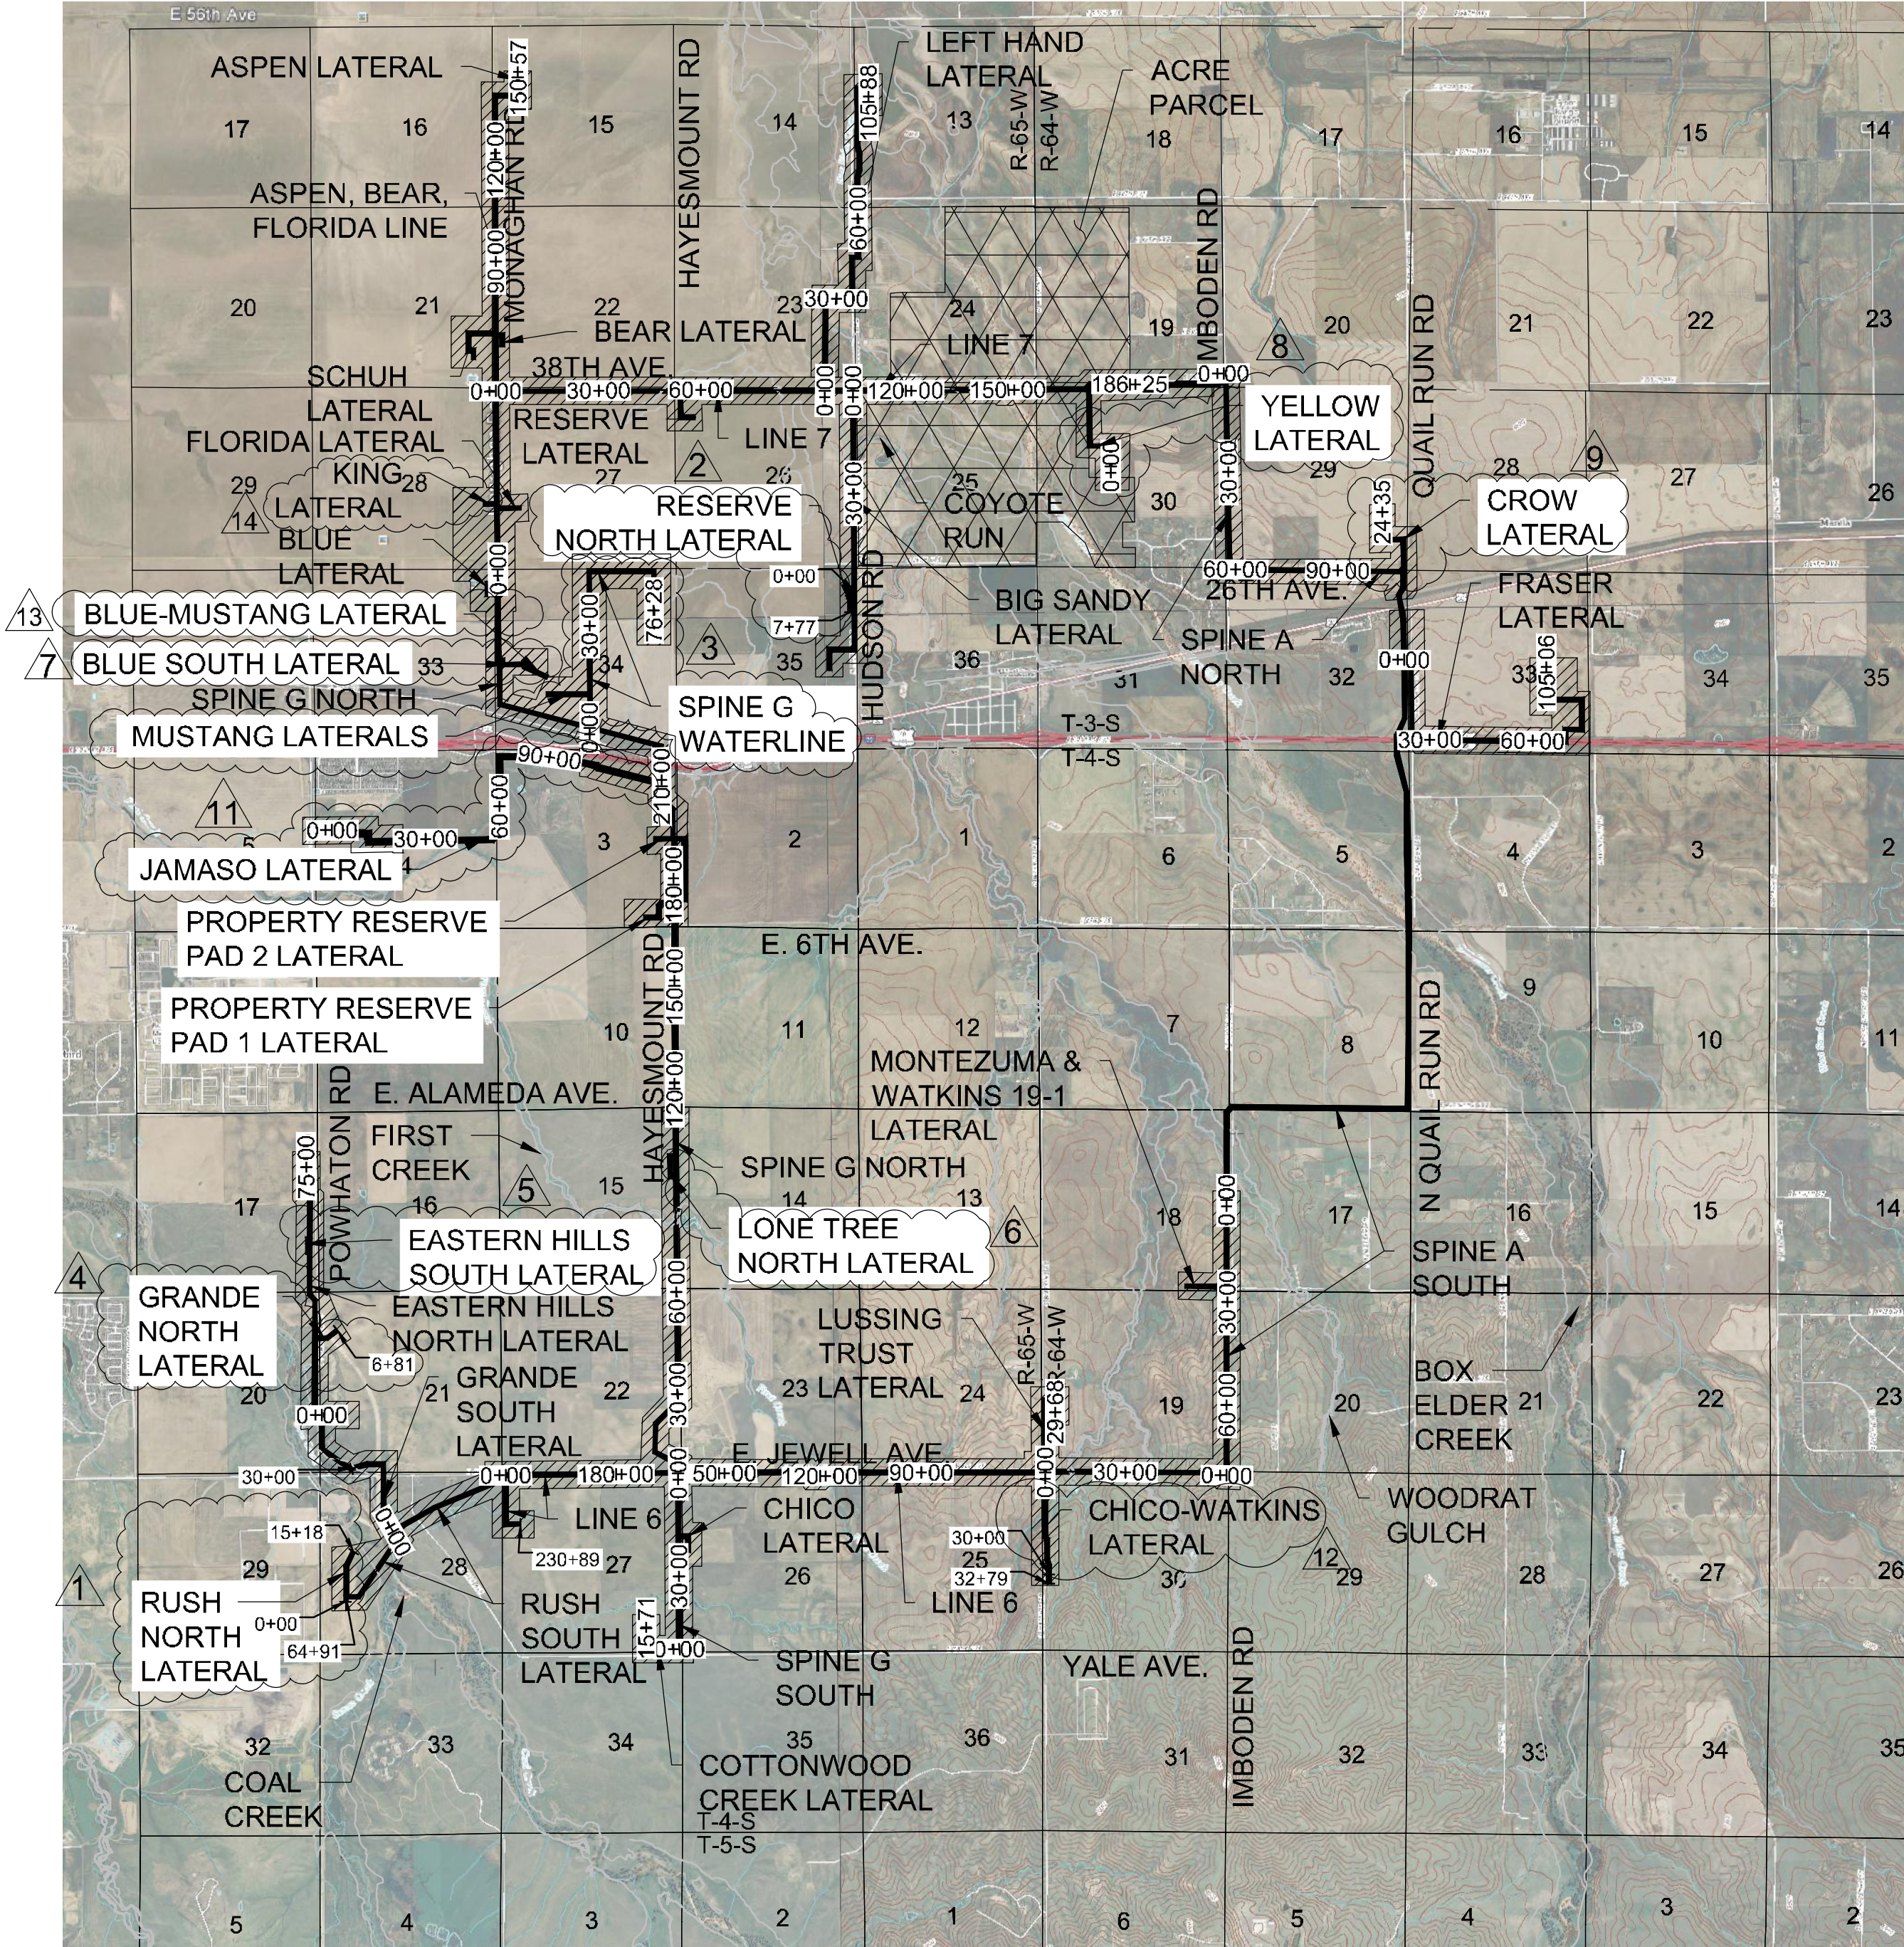


VICINITY MAP

SCALE: 1" = 4,000 FT.

#### SHEET INDEX

- COVER SHEET
- CITY OF AURORA LIMITS & ZONING
- CITY OF AURORA NEIGHBORHOOD MAP
- APPURTENANCE SITE & FEMA FLOODPLAIN MAP
- SPINE A SOUTH 0+00 TO 80+61, LINE 6 0+00 TO 2+50, WATKINS 19-1 LATERAL & MONTEZUMA LATERAL
- LINE 6 2+50 TO 137+50, LUSSING TRUST LATERAL 0+00 TO 5+00, & WATKINS 30-5 LATERAL 0+00 TO 2+50
- LUSSING TRUST LATERAL 5+00 TO 29+68 & CHICO-WATKINS LATERAL 2+50 TO 32+79
- LINE 6 137+50 TO 230+89 & RUSH SOUTH LATERAL 0+00 TO 4+50
- RUSH SOUTH LATERAL 4+50 TO 52+50 & GRANDE SOUTH LATERAL 0+00 TO 5+00 & RUSH NORTH LATERAL 0+00 TO 4+50
- GRANDE SOUTH LATERAL 5+00 TO 50+42 & EASTERN HILLS NORTH LATERAL 5+50 TO 27+50
- EASTERN HILLS NORTH LATERAL 27+50 TO 75+58 & EASTERN HILLS SOUTH LATERAL
- SPINE G SOUTH 2+00 TO 51+35, CHICO LATERAL, & COTTONWOOD CREEK LATERAL 0+00 TO 15+71
- SPINE G NORTH 2+00 TO 101+50, SUNSET GRIMM MOTOCROSS LATERAL, & LONE TREE NORTH LATERAL
- SPINE G NORTH 101+50 TO 222+50, PROPERTY RESERVE PAD 1 LATERAL, & PROPERTY RESERVE PAD 2 LATERAL
- SPINE G NORTH 222+50 TO 303+05, BLUE LATERAL 0+00 TO 14+30, ASPEN, BEAR, FLORIDA LINE 0+00 TO 1+50, & SPINE G WATERLINE/MUSTANG STATION LATERALS
- ASPEN, BEAR, FLORIDA LINE 1+50 TO 56+50, KING LATERAL, FLORIDA LATERAL, & LINE 7 0+00 TO 2+00
- ASPEN, BEAR, FLORIDA LINE 56+50 TO 127+50, SCHUH LATERAL, & BEAR LATERAL
- ASPEN, BEAR, FLORIDA LINE 127+50 TO 150+57 & LINE 7 2+00 TO 50+50
- LINE 7 50+50 TO 118+50, RESERVE LATERAL, LEFT HAND LATERAL 0+00 TO 3+50, & BIG SANDY LATERAL 0+00 TO 4+50
- LINE 7 118+50 TO 186+25 & LEFT HAND LATERAL 3+50 TO 31+50
- LEFT HAND LATERAL 31+50 TO 105+88
- BIG SANDY LATERAL 4+50 TO 89+14 & RESERVE NORTH LATERAL 0+00 TO 7+77
- SPINE A NORTH 0+00 TO 111+50 & CROW LATERAL 0+00 TO 2+50
- SPINE A NORTH 111+50 TO 135+61 & FRASER LATERAL 0+00 TO 72+50
- FRASER LATERAL 72+50 TO 105+06
- CITY OF AURORA FUTURE ROW CROSS SECTIONS
- RUSH NORTH LATERAL 4+50 TO 15+48
- SPINE G WATERLINE & MUSTANG STATION LATERALS
- GRANDE NORTH LATERAL 1+50 TO 6+81
- BLUE SOUTH LATERAL 0+00 TO 8+89
- YELLOW LATERAL 0+00 TO 19+50
- CROW LATERAL 2+50 TO 24+35
- JAMASO LATERAL 0+00 TO 26+00 & 100+00 TO 124+90

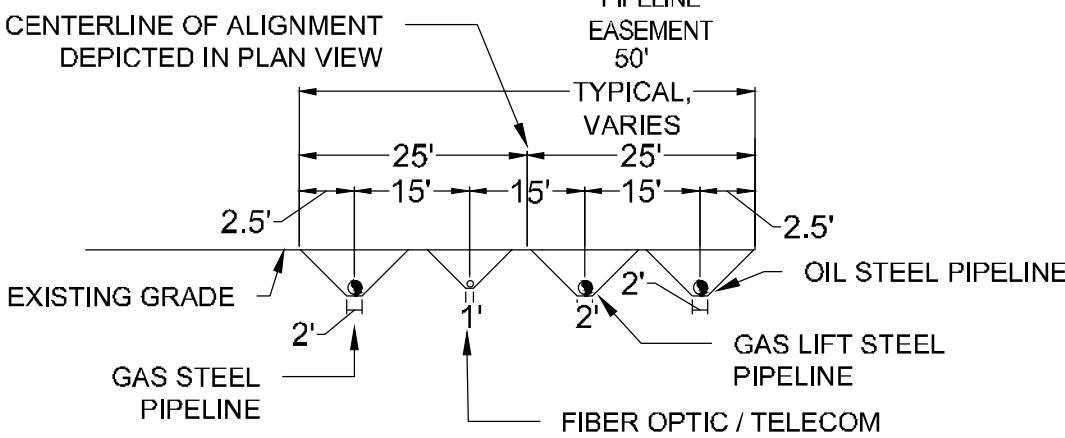

TYPICAL PIPELINE EASEMENT SECTION  
N.T.S.

#### LEGEND

- EXISTING TREE
- ABOVE GROUND APPURTENANCE SITE (GRAVEL)
- EXISTING ROAD RIGHT-OF-WAY
- EXISTING PIPELINE EASEMENT
- FENCE
- SECTION LINE
- PROPERTY LINE
- EXISTING ROAD
- EXISTING MAJOR CONTOURS
- EXISTING MINOR CONTOURS

#### CITY OF AURORA APPROVALS

CITY ATTORNEY: \_\_\_\_\_ DATE: \_\_\_\_\_  
PLANNING DIRECTOR: \_\_\_\_\_ DATE: \_\_\_\_\_  
PLANNING COMMISSIONER: \_\_\_\_\_ DATE: \_\_\_\_\_  
CITY COUNCIL: \_\_\_\_\_ DATE: \_\_\_\_\_  
ATTEST: \_\_\_\_\_ DATE: \_\_\_\_\_  
(CITY CLERK)  
DATABASE APPROVAL DATE: \_\_\_\_\_

#### COUNTY RECORDATION

RECORDER'S CERTIFICATE:  
ACCEPTED FOR FILING IN THE OFFICE OF THE CLERK AND RECORDER OF COLORADO AT \_\_\_\_\_ O'CLOCK \_\_\_\_\_ M, THIS \_\_\_\_\_ DAY OF \_\_\_\_\_ AD, \_\_\_\_\_.  
CLERK AND RECORDER \_\_\_\_\_ DEPUTY: \_\_\_\_\_

#### AMENDMENTS:

- 02/08/2021 - RUSH NORTH LATERAL (1,500 FEET)
- 02/09/2021 - RESERVE NORTH LATERAL (800 FEET)
- 05/04/2021 - SPINE G WATERLINE (6,930 FEET) & MUSTANG STATION LATERALS (2,250 FEET)
- 08/10/2021 - GRANDE NORTH LATERAL (685 FEET)
- 10/25/2021 - EASTERN HILLS SOUTH LATERAL (650 FEET)
- 10/26/2021 - LONE TREE NORTH LATERAL (130 FEET)
- 11/12/2021 - BLUE SOUTH LATERAL (900 FEET)
- 11/13/2021 - YELLOW LATERAL (1,650 FEET)
- 02/04/2022 - CROW LATERAL (2,500 FEET)
- 03/23/2022 - ADDITION OF CRUDE OIL ON THE TITLE/BORDER
- 10/13/2022 - JAMASO LATERAL (12,440 FEET)
- 03/29/2024 - CHICO-WATKINS LATERAL (710 FEET)
- 04/05/2024 - BLUE-MUSTANG LATERAL (740 FEET)
- 07/10/2024 - KING LATERAL MODIFICATION

NO.	DATE	BY	REVISIONS
1	04-05-24	NCW	ADD BLUE-MUSTANG LATERAL
2	02-29-24	NCW	ADD CHICO-WATKINS LATERAL
3	02-29-24	NCW	ADD JAMASO LATERAL
4	02-29-24	NCW	ADD CROW LATERAL
5	02-29-24	NCW	ADD YELLOW LATERAL
6	02-29-24	NCW	ADD EASTERN HILLS SOUTH LATERAL
7	02-29-24	NCW	ADD LONE TREE NORTH LATERAL
8	02-29-24	NCW	ADD RESERVE NORTH LATERAL
9	02-29-24	NCW	ADD RUSH NORTH LATERAL
10	02-29-24	NCW	ADD KING LATERAL MODIFICATION

**Westwood**



CRESTONE PEAK RESOURCES MIDSTREAM LLC  
ATTN: NATHAN BENNETT  
955 W. 1ST ST., STE 3700  
DENVER, CO 80202  
PHONE: (303) 312-8166

NATURAL GAS & CRUDE OIL PIPELINE  
GATHERING SYSTEM  
AS-BUILT SITE PLAN  
CRESTONE PEAK RESOURCES MIDSTREAM LLC  
COVER SHEET

SCALE: NCW  
AS SHOWN  
FILE NO: KSW  
DATE: 09/19/2020

SHEET NUMBER  
1



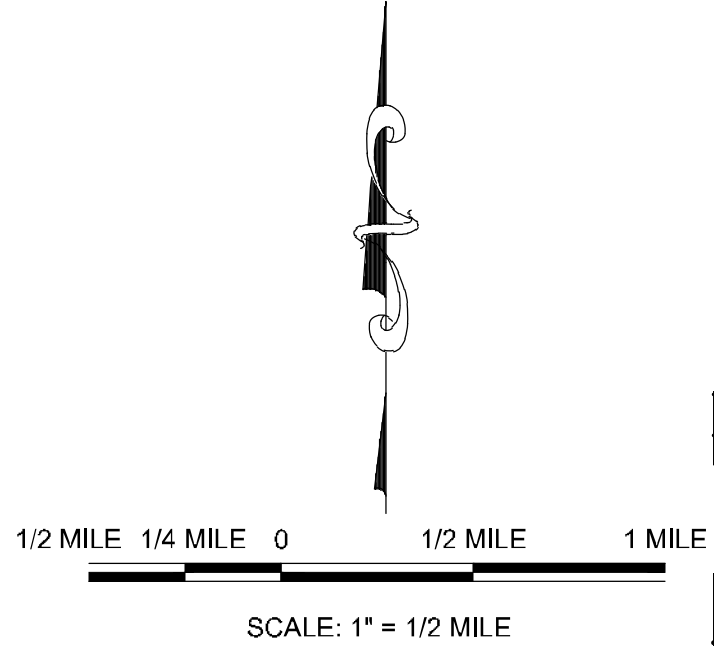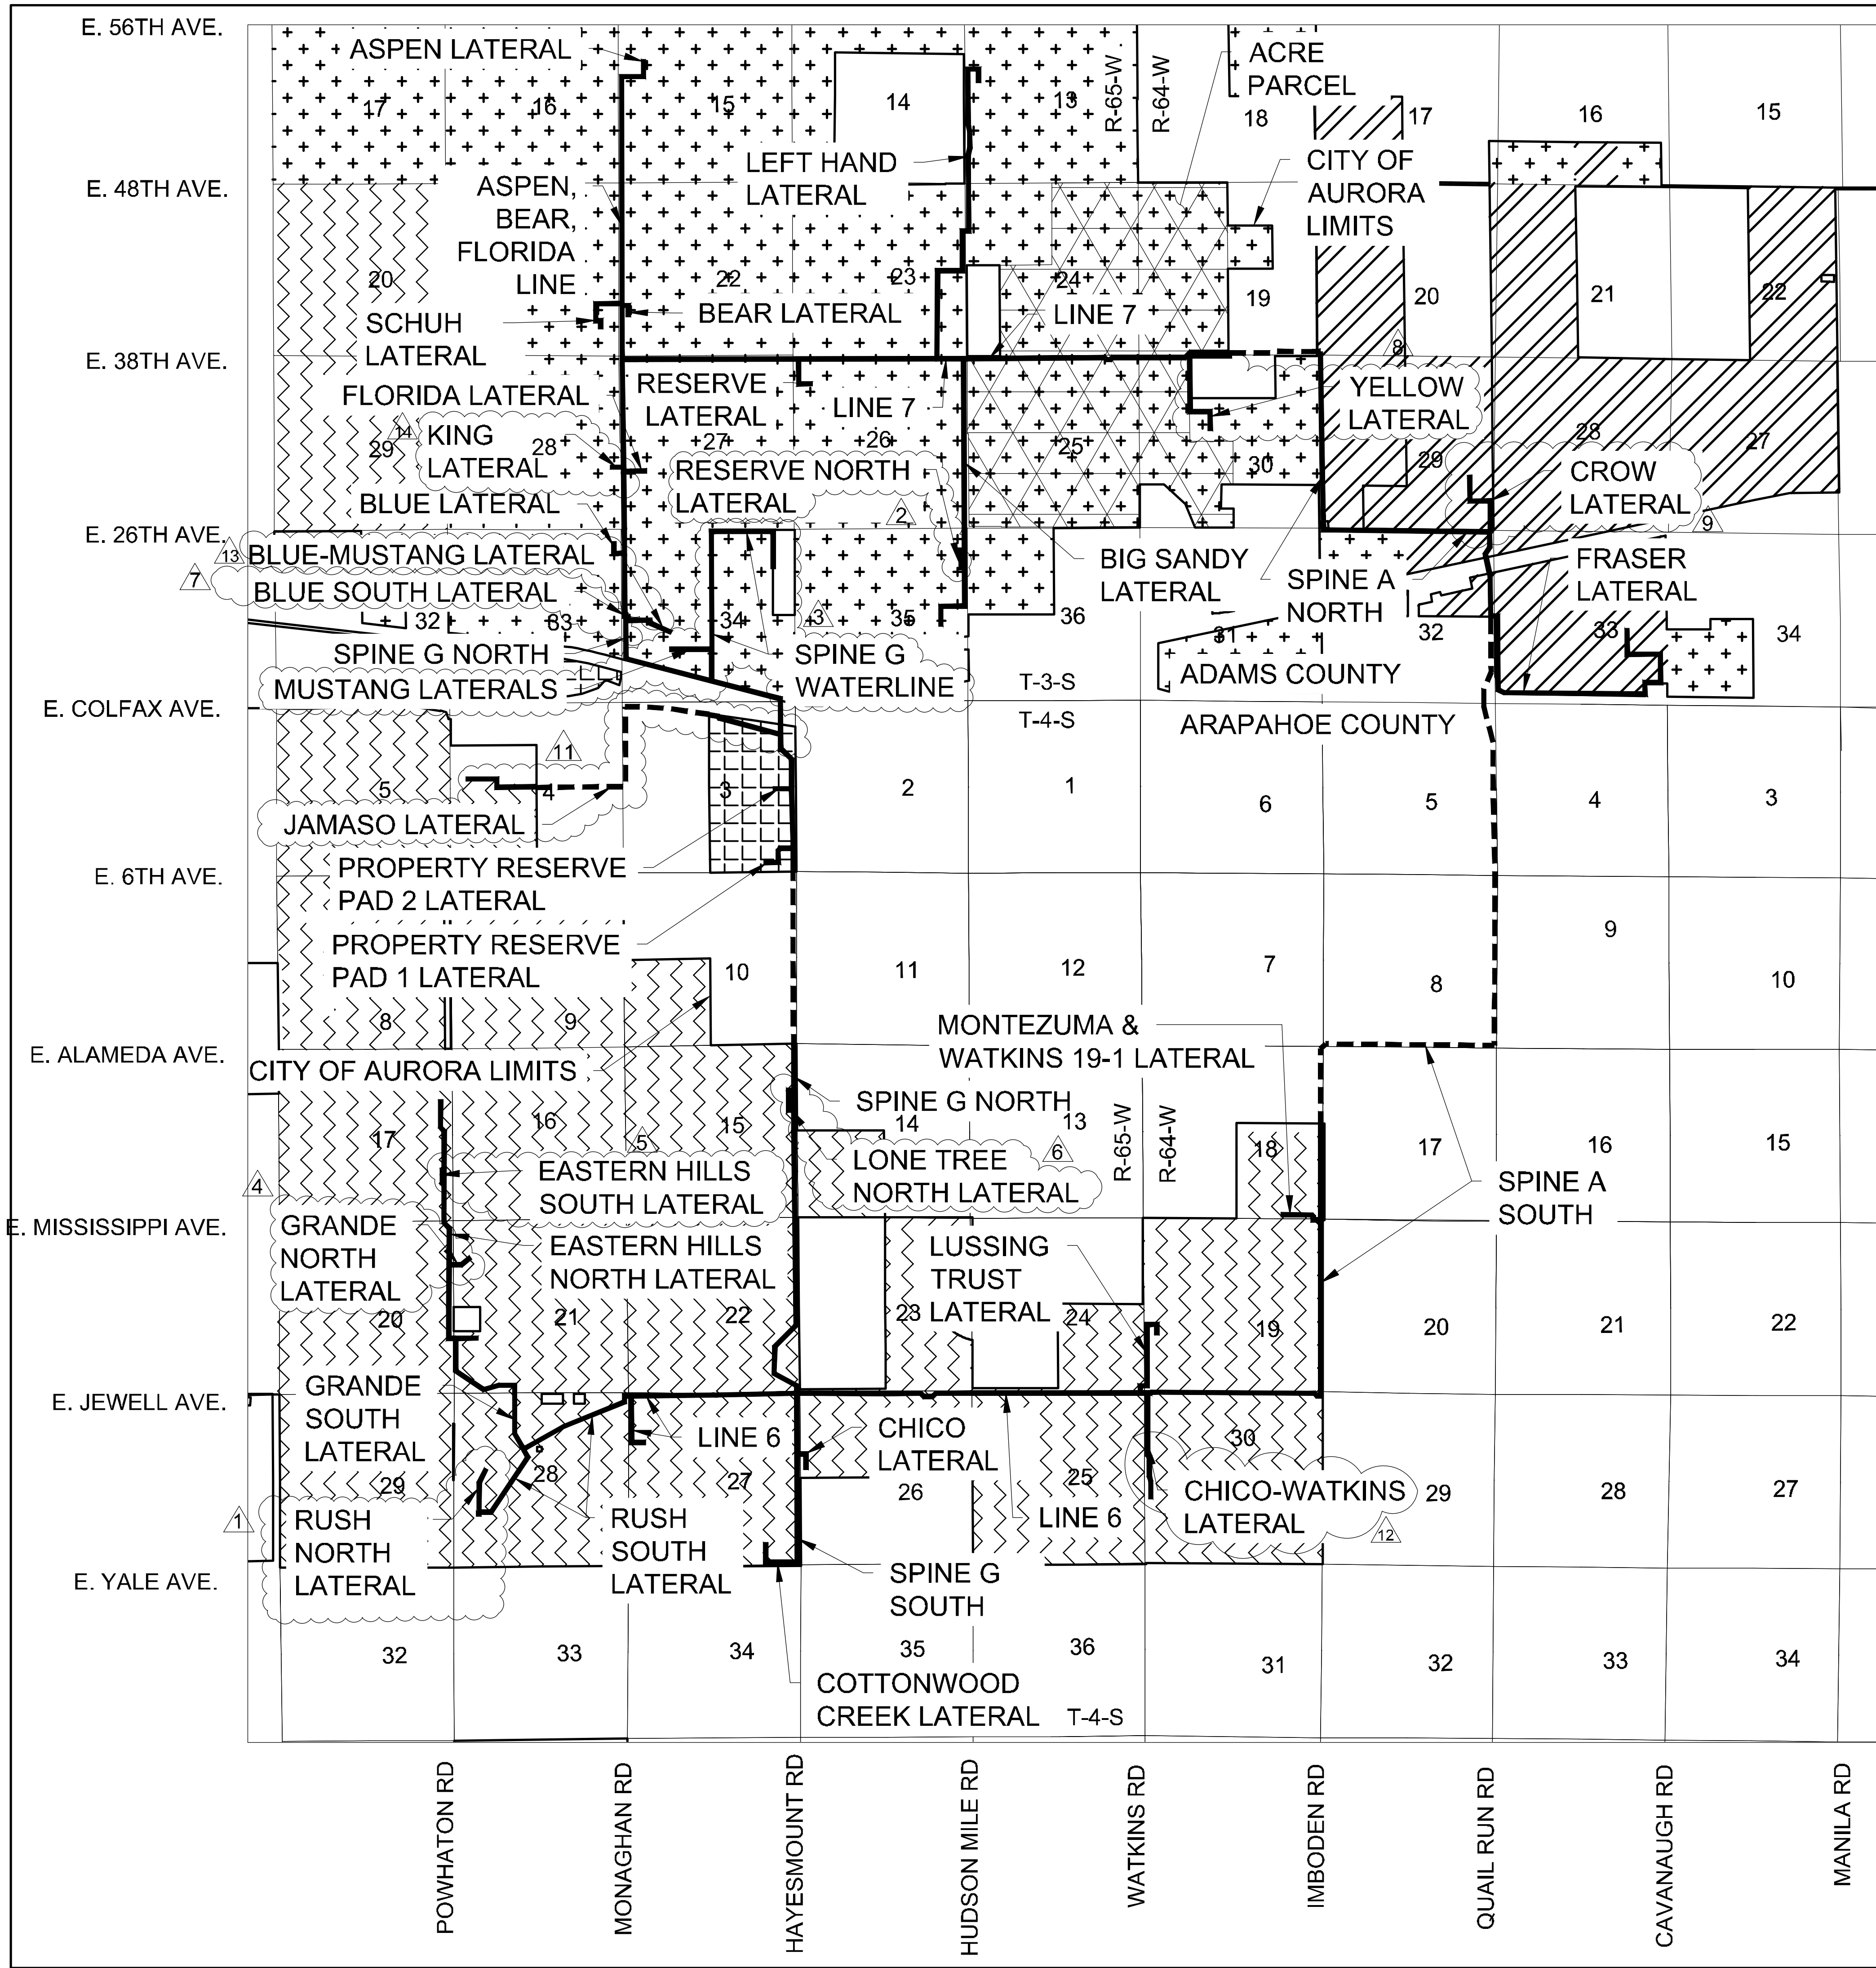

- LEGEND**
- PIPELINE WITHIN CITY OF AURORA LIMITS
  - PIPELINE OUTSIDE CITY OF AURORA LIMITS
  - MU-A - MIXED USE AIRPORT
  - AD - AIRPORT DISTRICT
  - I-2 - INDUSTRIAL DISTRICT
  - R-2 - MEDIUM-DENSITY RESIDENTIAL DISTRICT

- NOTES**
- ALL AMENDMENTS TO THIS SITE PLAN SHALL UTILIZE EASEMENTS THAT DO NOT SIGNIFICANTLY ENCUMBER CURBSIDE LANDSCAPING OR STREET FRONTAGE LANDSCAPE BUFFERS FOR FUTURE DEVELOPMENTS. THIS CAN BE DONE BY EITHER LOCATING ALL EASEMENTS OUTSIDE OF THESE IDENTIFIED AREAS OR INCLUDING EASEMENT LANGUAGE THAT ALLOWS SUFFICIENT PLANTINGS (AS DETERMINED BY THE CITY LANDSCAPE ARCHITECT) TO BE INSTALLED WITHIN EASEMENTS.
  - THE GATHERING SYSTEM AND FLOWLINE WILL NOT HAVE ANY UNDUE ADVERSE EFFECTS ON EXISTING AND FUTURE DEVELOPMENT OF THE SURROUNDING AREA AS SET FORTH IN APPLICABLE CITY MASTER PLANS. THE DESIGN OF THE PROPOSED GATHERING SYSTEM AND FLOWLINE MITIGATES NEGATIVE IMPACTS ON THE SURROUNDING AREA TO THE GREATEST EXTENT FEASIBLE. THE DISTURBED AREA SHALL BE MAINTAINED DURING CONSTRUCTION BY THE APPLICANT OR PROPERTY OWNER IN SUCH A MANNER TO CONTROL SOIL EROSION, DUST AND THE GROWTH OF NOXIOUS WEEDS.

No.	Revisions	Date	Appr.
1			
2			
3			
**Westwood**

10333 E DRY CREEK RD  
SUITE 400  
ENGLEWOOD, CO 80112  
TEL: 720.482.9526

CRESTONE PEAK RESOURCES MIDSTREAM LLC  
ATTN: NATHAN BENNETT  
555 17TH ST, STE 3700  
DENVER, CO 80202  
PHONE: (303) 312-8166

NATURAL GAS & CRUDE OIL PIPELINE  
GATHERING SYSTEM  
AS-BUILT SITE PLAN  
CRESTONE PEAK RESOURCES MIDSTREAM LLC  
CITY OF AURORA LIMITS & ZONING

SCALE:  
AS SHOWN

DRAWN BY:  
NCW

CHECKED BY:  
KRW

DATE:  
08/19/2020



FILE NO:  
8.13.0330001

**2**

SHEET NUMBER

City Limits - Amendment #14.20g



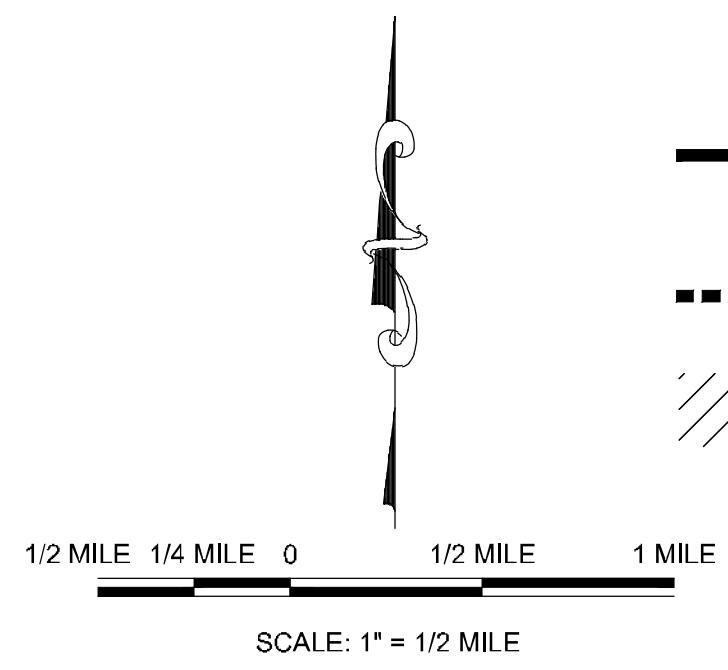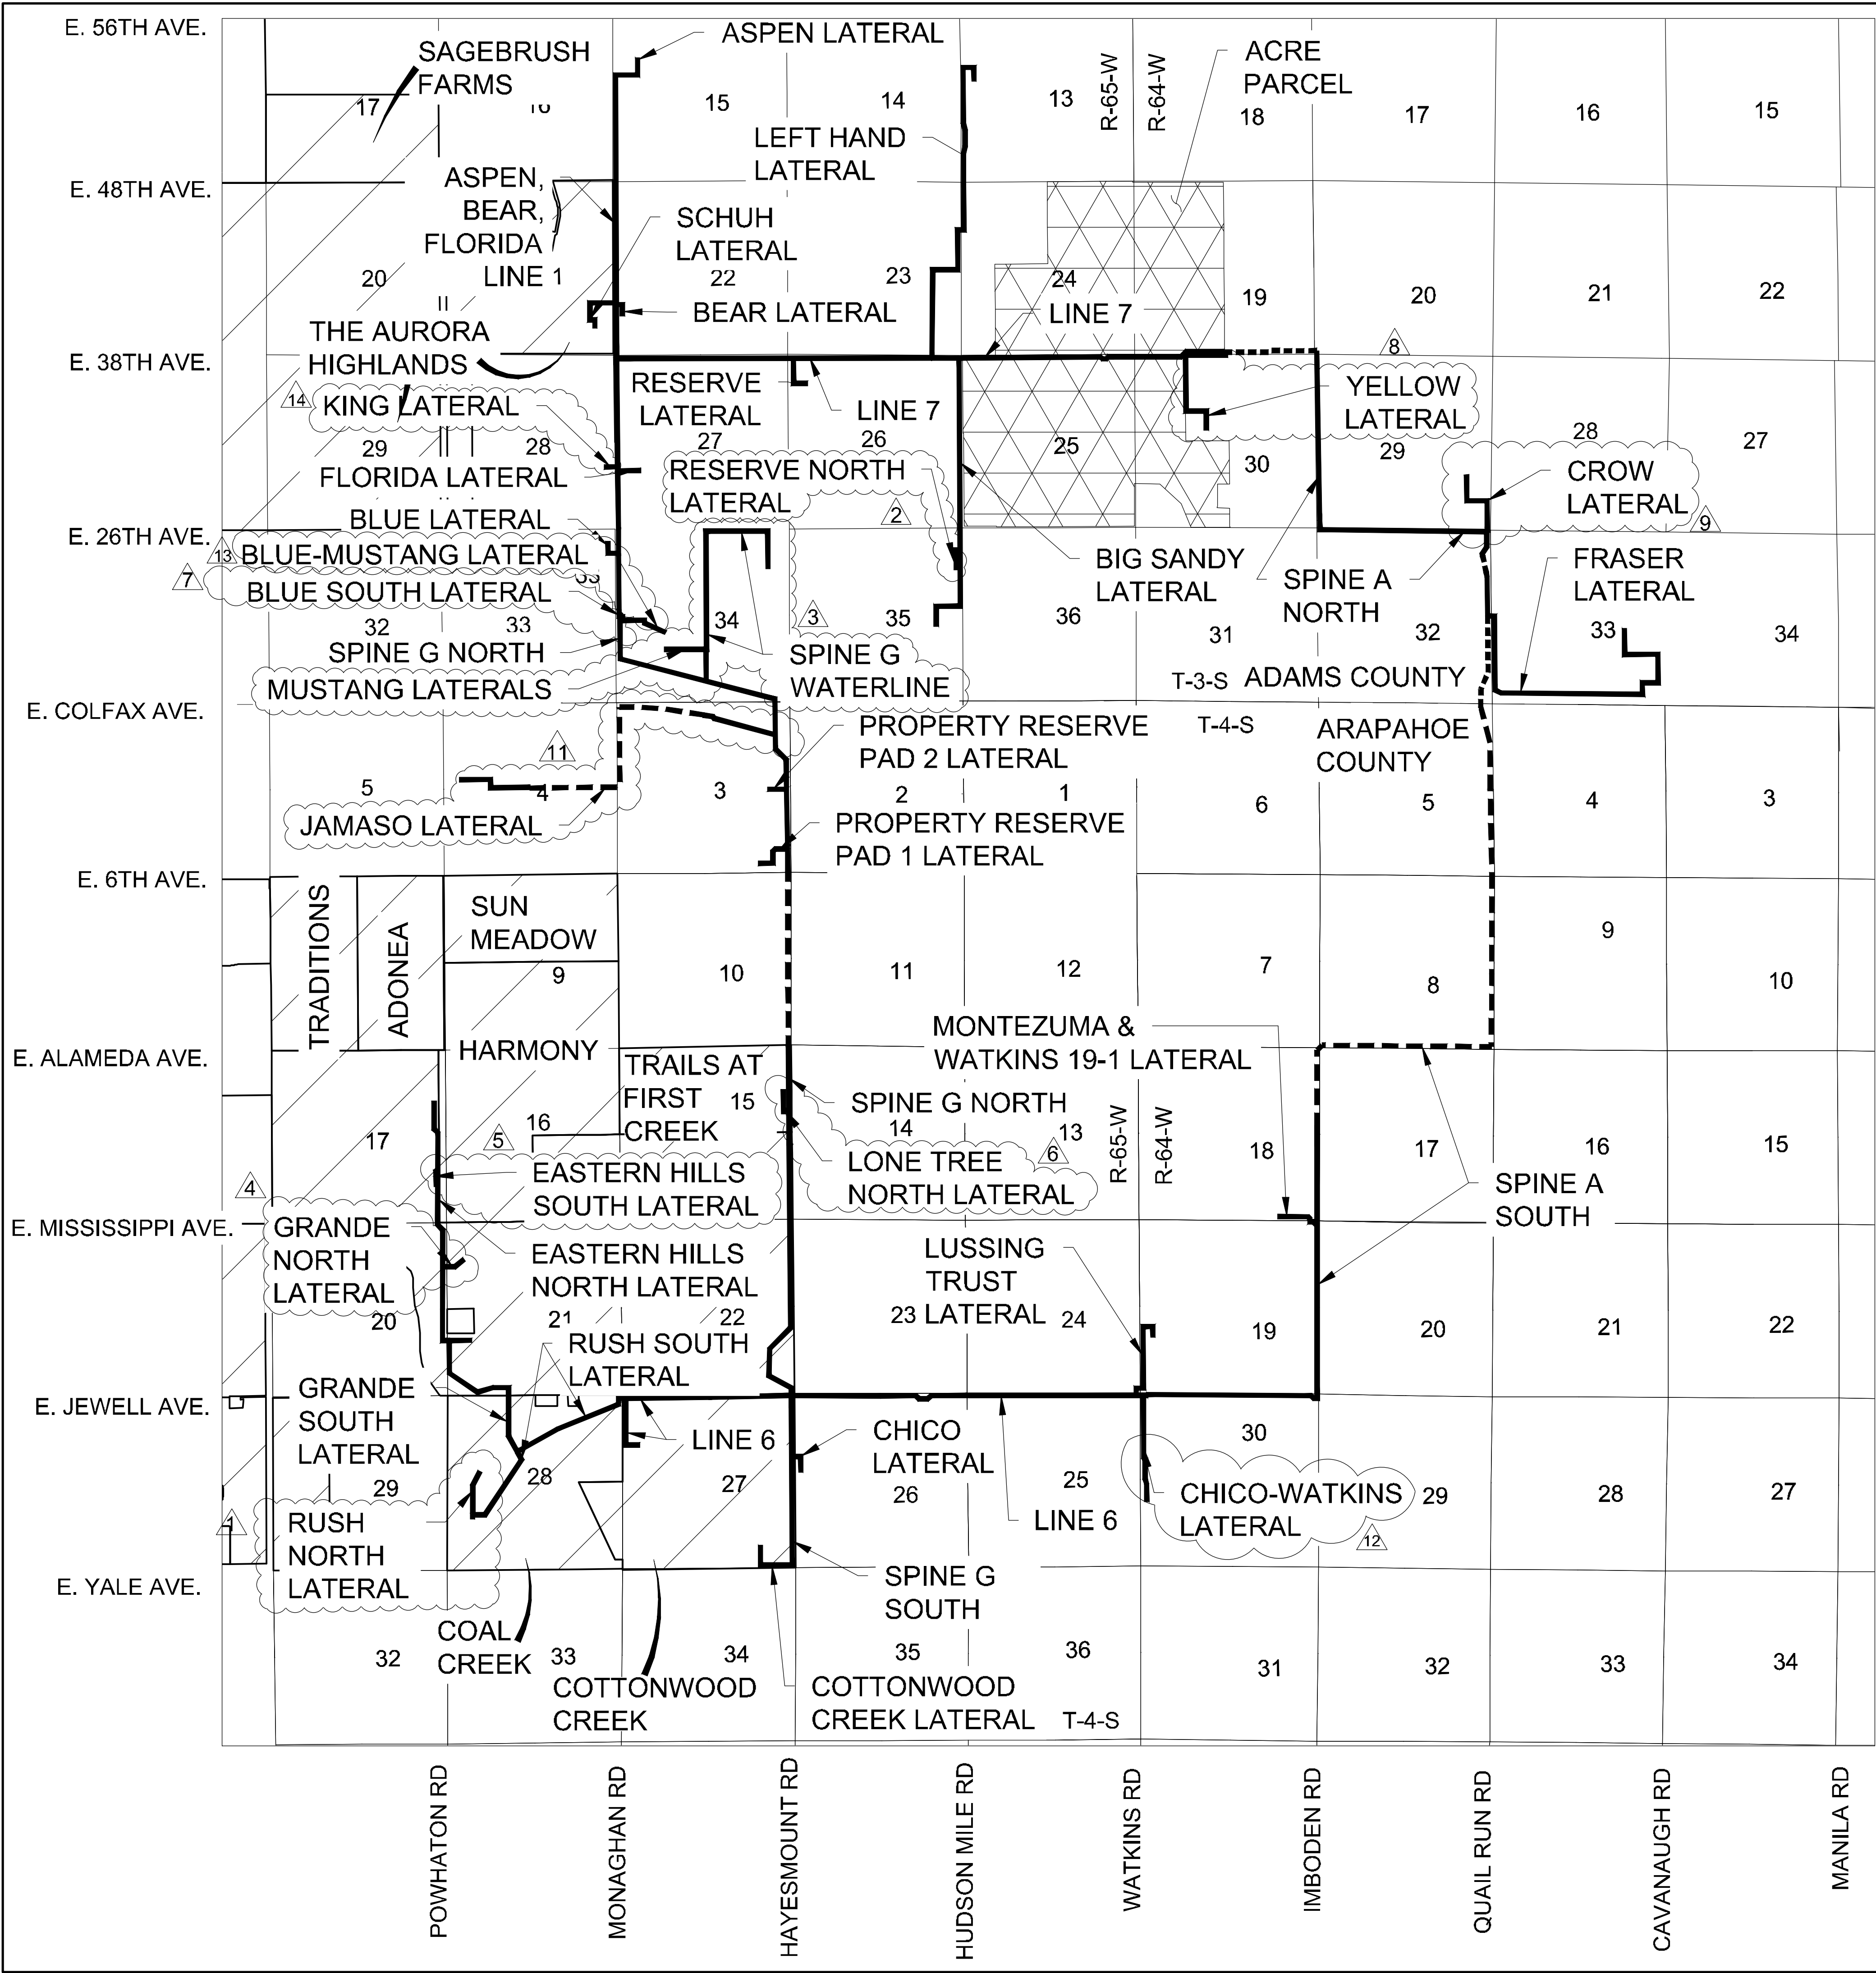

LEGEND	
	PIPELINE WITHIN CITY OF AURORA LIMITS
	PIPELINE OUTSIDE CITY OF AURORA LIMITS
	EXISTING NEIGHBORHOOD

- 1
- NOTES

  - ALL AMENDMENTS TO THIS SITE PLAN SHALL UTILIZE EASEMENTS THAT DO NOT SIGNIFICANTLY ENCUMBER CURBSIDE LANDSCAPING OR STREET FRONTAGE LANDSCAPE BUFFERS FOR FUTURE DEVELOPMENTS. THIS CAN BE DONE BY EITHER LOCATING ALL EASEMENTS OUTSIDE OF THESE IDENTIFIED AREAS OR INCLUDING EASEMENT LANGUAGE THAT ALLOWS SUFFICIENT PLANTINGS (AS DETERMINED BY THE CITY LANDSCAPE ARCHITECT) TO BE INSTALLED WITHIN EASEMENTS.
  - THE GATHERING SYSTEM AND FLOWLINE WILL NOT HAVE ANY UNDUE ADVERSE EFFECTS ON EXISTING AND FUTURE DEVELOPMENT OF THE SURROUNDING AREA AS SET FORTH IN APPLICABLE CITY MASTER PLANS. THE DESIGN OF THE PROPOSED GATHERING SYSTEM AND FLOWLINE MITIGATES NEGATIVE IMPACTS ON THE SURROUNDING AREA TO THE GREATEST EXTENT FEASIBLE. THE DISTURBED AREA SHALL BE MAINTAINED DURING CONSTRUCTION BY THE APPLICANT OR PROPERTY OWNER IN SUCH A MANNER TO CONTROL SOIL EROSION, DUST AND THE GROWTH OF NOXIOUS WEEDS.

NO.	DATE	INITIALS	REVISIONS
1	04-26-21	NCW	1. KING LATERAL MODIFICATION
2	04-26-21	NCW	2. BLUE-MUSTANG LATERAL
3	05-26-21	NCW	3. CHICO-WATKINS LATERAL
4	05-26-21	NCW	4. JAMASO LATERAL
5	05-26-21	NCW	5. ADONEA LATERAL
6	05-26-21	NCW	6. CROW LATERAL
7	05-26-21	NCW	7. SUN MEADOW LATERAL
8	05-26-21	NCW	8. HARMONY LATERAL
9	05-26-21	NCW	9. TRAILS AT FIRST CREEK LATERAL
10	05-26-21	NCW	10. EASTERN HILLS SOUTH LATERAL
11	05-26-21	NCW	11. EASTERN HILLS NORTH LATERAL
12	05-26-21	NCW	12. LONE TREE NORTH LATERAL
13	05-26-21	NCW	13. LUSSING TRUST LATERAL
14	05-26-21	NCW	14. CHICO LATERAL
15	05-26-21	NCW	15. SPINE G SOUTH
16	05-26-21	NCW	16. COTTONWOOD CREEK LATERAL
17	05-26-21	NCW	17. LINE 6
18	05-26-21	NCW	18. CHICO-WATKINS LATERAL
19	05-26-21	NCW	19. SPINE G NORTH
20	05-26-21	NCW	20. MONTEZUMA & WATKINS 19-1 LATERAL
21	05-26-21	NCW	21. SPINE A SOUTH
22	05-26-21	NCW	22. SPINE A NORTH
23	05-26-21	NCW	23. SPINE G WATERLINE
24	05-26-21	NCW	24. PROPERTY RESERVE PAD 1 LATERAL
25	05-26-21	NCW	25. PROPERTY RESERVE PAD 2 LATERAL
26	05-26-21	NCW	26. JAMASO LATERAL
27	05-26-21	NCW	27. ADONEA LATERAL
28	05-26-21	NCW	28. CROW LATERAL
29	05-26-21	NCW	29. SUN MEADOW LATERAL
30	05-26-21	NCW	30. HARMONY LATERAL
31	05-26-21	NCW	31. TRAILS AT FIRST CREEK LATERAL
32	05-26-21	NCW	32. EASTERN HILLS SOUTH LATERAL
33	05-26-21	NCW	33. EASTERN HILLS NORTH LATERAL
34	05-26-21	NCW	34. LONE TREE NORTH LATERAL
35	05-26-21	NCW	35. LUSSING TRUST LATERAL
36	05-26-21	NCW	36. CHICO LATERAL
37	05-26-21	NCW	37. SPINE G SOUTH
38	05-26-21	NCW	38. COTTONWOOD CREEK LATERAL
39	05-26-21	NCW	39. LINE 6
40	05-26-21	NCW	40. CHICO-WATKINS LATERAL
41	05-26-21	NCW	41. SPINE G NORTH
42	05-26-21	NCW	42. MONTEZUMA & WATKINS 19-1 LATERAL
43	05-26-21	NCW	43. SPINE A SOUTH
44	05-26-21	NCW	44. SPINE A NORTH
45	05-26-21	NCW	45. SPINE G WATERLINE
46	05-26-21	NCW	46. PROPERTY RESERVE PAD 1 LATERAL
47	05-26-21	NCW	47. PROPERTY RESERVE PAD 2 LATERAL
48	05-26-21	NCW	48. JAMASO LATERAL
49	05-26-21	NCW	49. ADONEA LATERAL
50	05-26-21	NCW	50. CROW LATERAL
51	05-26-21	NCW	51. SUN MEADOW LATERAL
52	05-26-21	NCW	52. HARMONY LATERAL
53	05-26-21	NCW	53. TRAILS AT FIRST CREEK LATERAL
54	05-26-21	NCW	54. EASTERN HILLS SOUTH LATERAL
55	05-26-21	NCW	55. EASTERN HILLS NORTH LATERAL
56	05-26-21	NCW	56. LONE TREE NORTH LATERAL
57	05-26-21	NCW	57. LUSSING TRUST LATERAL
58	05-26-21	NCW	58. CHICO LATERAL
59	05-26-21	NCW	59. SPINE G SOUTH
60	05-26-21	NCW	60. COTTONWOOD CREEK LATERAL
61	05-26-21	NCW	61. LINE 6
62	05-26-21	NCW	62. CHICO-WATKINS LATERAL
63	05-26-21	NCW	63. SPINE G NORTH
64	05-26-21	NCW	64. MONTEZUMA & WATKINS 19-1 LATERAL
65	05-26-21	NCW	65. SPINE A SOUTH
66	05-26-21	NCW	66. SPINE A NORTH
67	05-26-21	NCW	67. SPINE G WATERLINE
68	05-26-21	NCW	68. PROPERTY RESERVE PAD 1 LATERAL
69	05-26-21	NCW	69. PROPERTY RESERVE PAD 2 LATERAL
70	05-26-21	NCW	70. JAMASO LATERAL
71	05-26-21	NCW	71. ADONEA LATERAL
72	05-26-21	NCW	72. CROW LATERAL
73	05-26-21	NCW	73. SUN MEADOW LATERAL
74	05-26-21	NCW	74. HARMONY LATERAL
75	05-26-21	NCW	75. TRAILS AT FIRST CREEK LATERAL
76	05-26-21	NCW	76. EASTERN HILLS SOUTH LATERAL
77	05-26-21	NCW	77. EASTERN HILLS NORTH LATERAL
78	05-26-21	NCW	78. LONE TREE NORTH LATERAL
79	05-26-21	NCW	79. LUSSING TRUST LATERAL
80	05-26-21	NCW	80. CHICO LATERAL
81	05-26-21	NCW	81. SPINE G SOUTH
82	05-26-21	NCW	82. COTTONWOOD CREEK LATERAL
83	05-26-21	NCW	83. LINE 6
84	05-26-21	NCW	84. CHICO-WATKINS LATERAL
85	05-26-21	NCW	85. SPINE G NORTH
86	05-26-21	NCW	86. MONTEZUMA & WATKINS 19-1 LATERAL
87	05-26-21	NCW	87. SPINE A SOUTH
88	05-26-21	NCW	88. SPINE A NORTH
89	05-26-21	NCW	89. SPINE G WATERLINE
90	05-26-21	NCW	90. PROPERTY RESERVE PAD 1 LATERAL
91	05-26-21	NCW	91. PROPERTY RESERVE PAD 2 LATERAL
92	05-26-21	NCW	92. JAMASO LATERAL
93	05-26-21	NCW	93. ADONEA LATERAL
94	05-26-21	NCW	94. CROW LATERAL
95	05-26-21	NCW	95. SUN MEADOW LATERAL
96	05-26-21	NCW	96. HARMONY LATERAL
97	05-26-21	NCW	97. TRAILS AT FIRST CREEK LATERAL
98	05-26-21	NCW	98. EASTERN HILLS SOUTH LATERAL
99	05-26-21	NCW	99. EASTERN HILLS NORTH LATERAL
100	05-26-21	NCW	100. LONE TREE NORTH LATERAL

**Westwood**

CRESTONE PEAK RESOURCES MIDSTREAM LLC  
ATTN: NATHAN BENNETT  
555 W. 1ST ST., STE 3700  
DENVER, CO 80202  
PHONE: (303) 312-8166



NATURAL GAS & CRUDE OIL PIPELINE  
GATHERING SYSTEM  
AS-BUILT SITE PLAN  
CRESTONE PEAK RESOURCES MIDSTREAM LLC  
CITY OF AURORA NEIGHBORHOOD MAP

SCALE:  
AS SHOWN  
FILE NO:  
8.13.0330001  
DATE:  
09/19/2020





SHEET NUMBER  
3  
DRAWN BY:  
NCW  
CHECKED BY:  
KRW  
DATE:  
09/19/2020

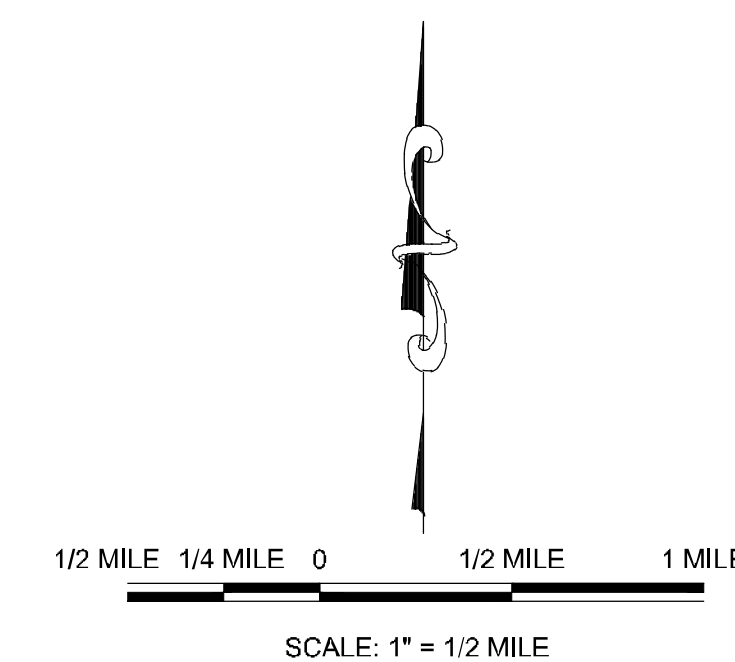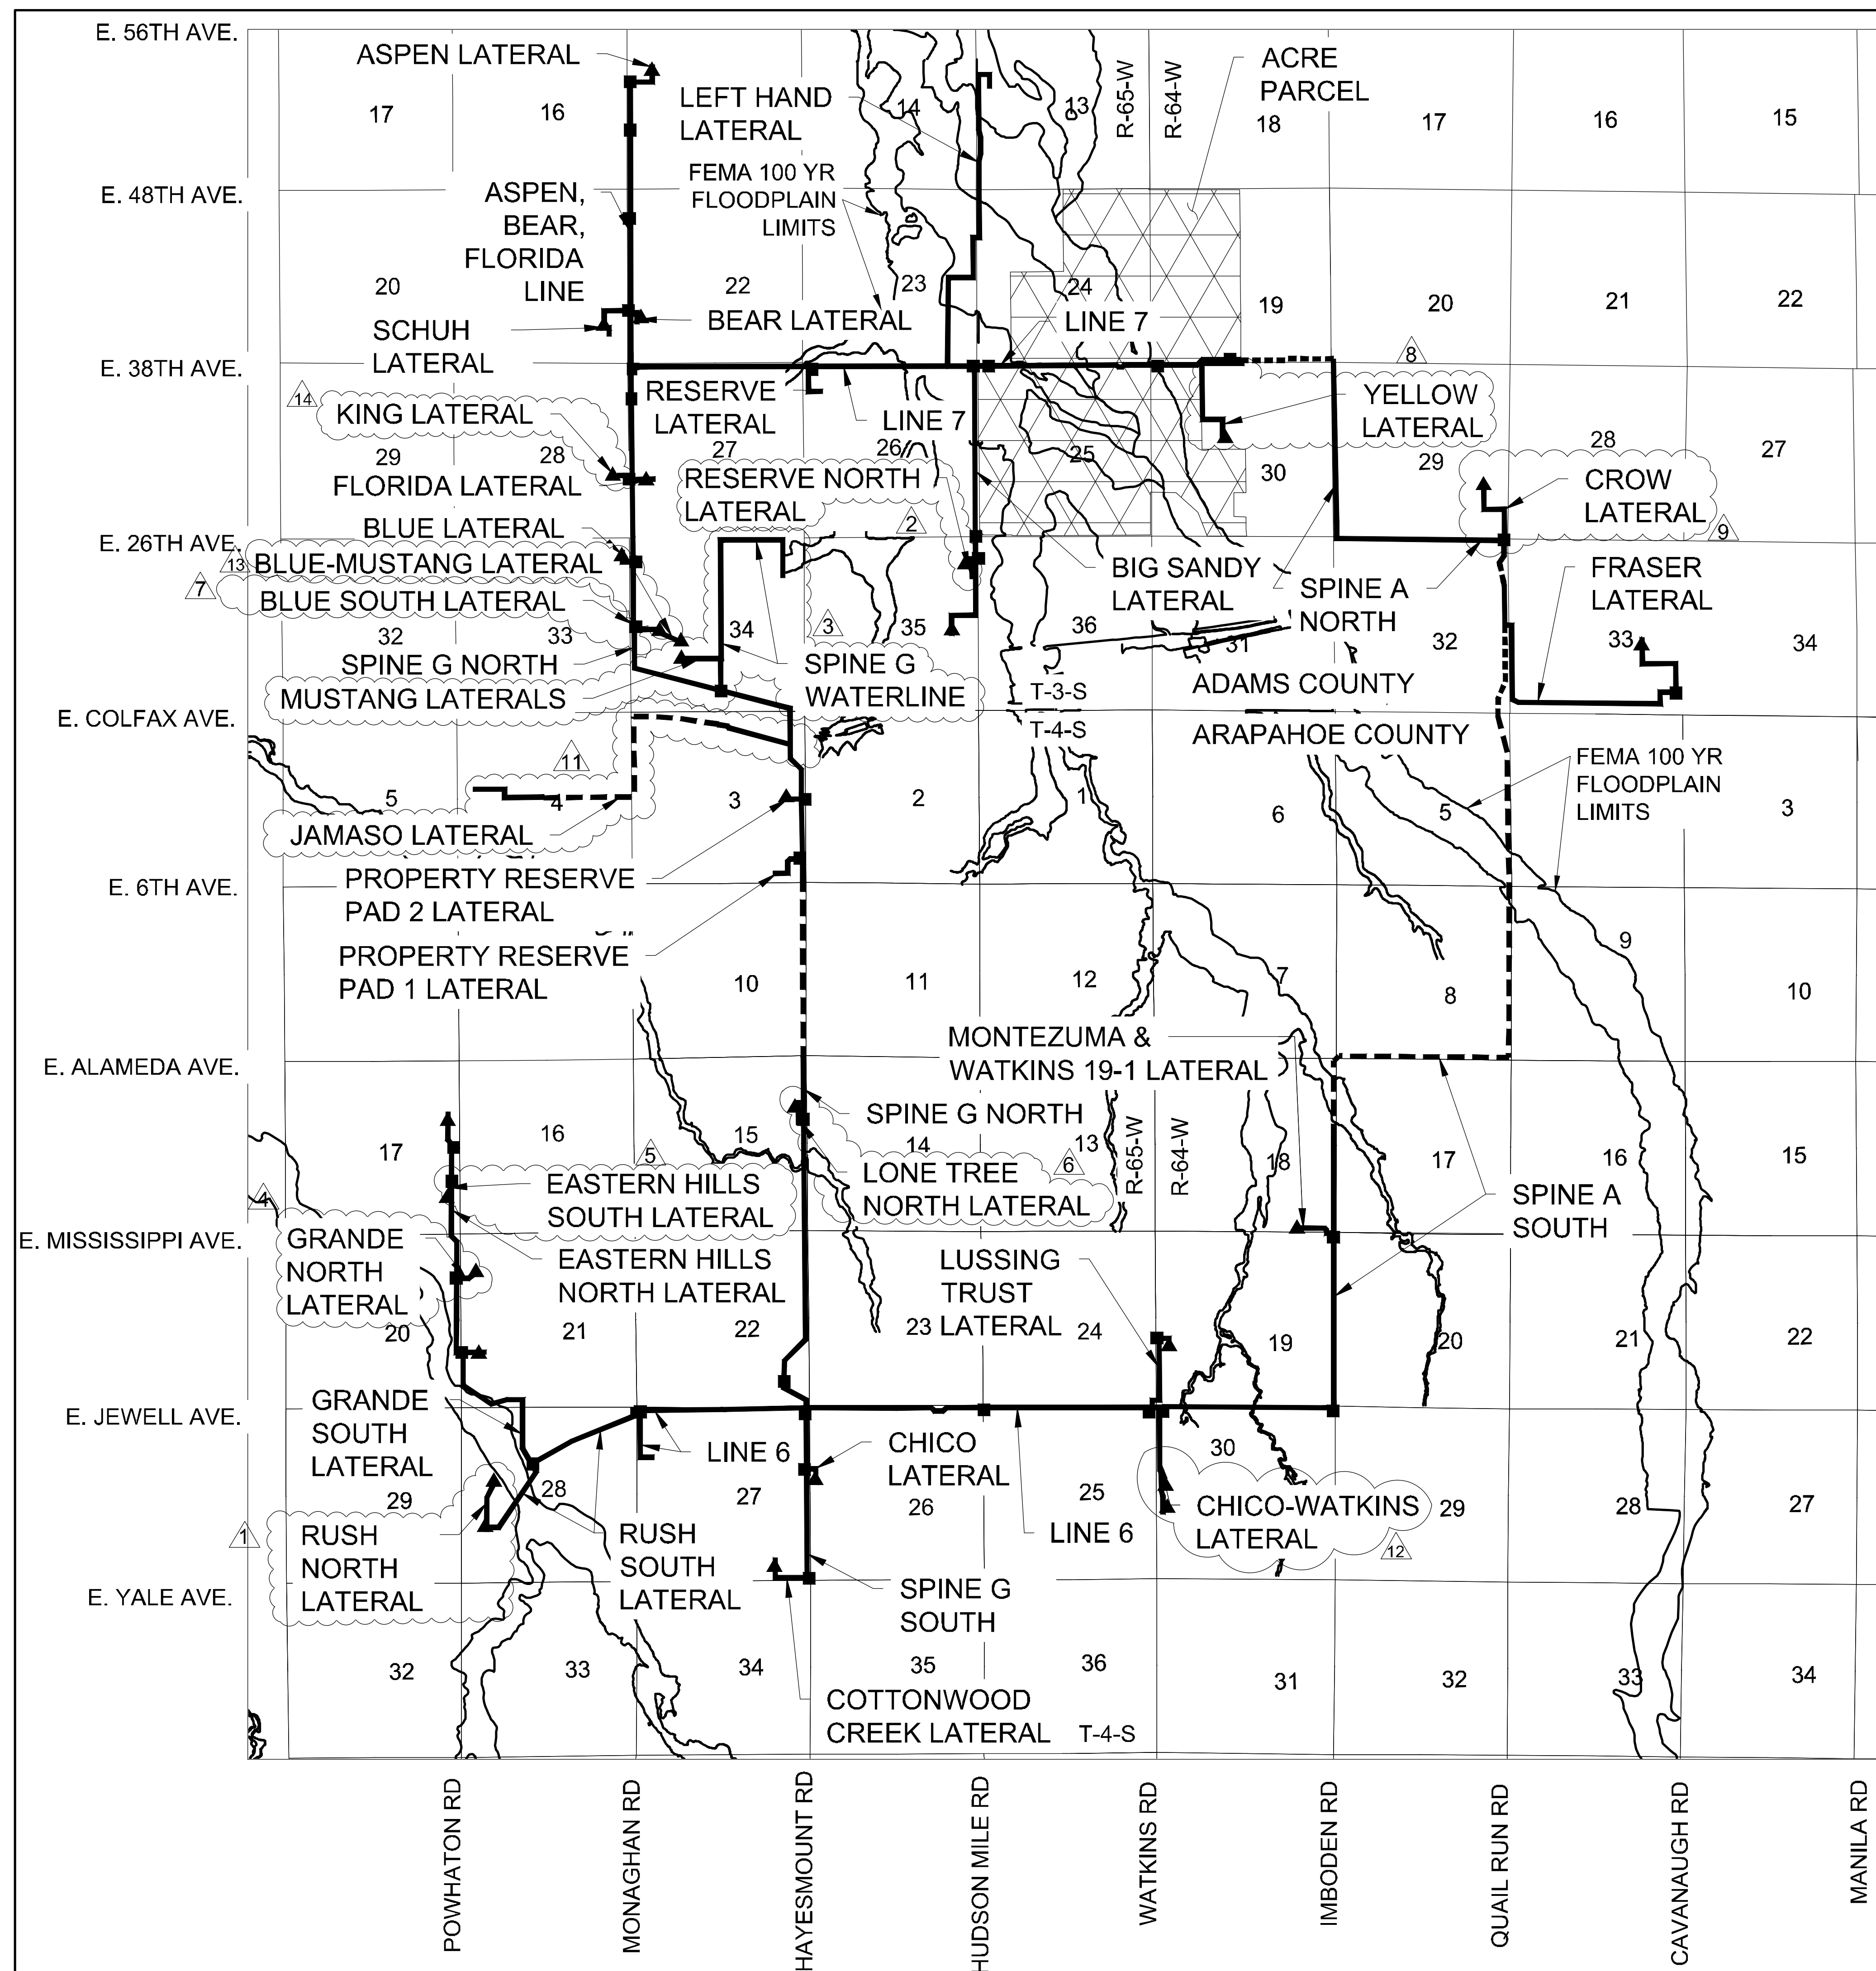Neighborhoods - Amendment #12.dwg





LEGEND

	PIPELINE WITHIN CITY OF AURORA LIMITS
	PIPELINE OUTSIDE CITY OF AURORA LIMITS
	ABOVE GROUND APPURTENANCE SITE LOCATIONS WITHIN CITY OF AURORA
	WELL PAD APPURTENANCE SITE LOCATIONS WITHIN CITY OF AURORA



ABOVE GROUND APPURTENANCE EQUIPMENT EXAMPLE

- NOTES**
- ALL AMENDMENTS TO THIS SITE PLAN SHALL UTILIZE EASEMENTS THAT DO NOT SIGNIFICANTLY ENCUMBER CURBSIDE LANDSCAPING OR STREET FRONTAGE LANDSCAPE BUFFERS FOR FUTURE DEVELOPMENTS. THIS CAN BE DONE BY EITHER LOCATING ALL EASEMENTS OUTSIDE OF THESE IDENTIFIED AREAS OR INCLUDING EASEMENT LANGUAGE THAT ALLOWS SUFFICIENT PLANTINGS (AS DETERMINED BY THE CITY LANDSCAPE ARCHITECT) TO BE INSTALLED WITHIN EASEMENTS.
  - THE GATHERING SYSTEM AND FLOWLINE WILL NOT HAVE ANY UNDUE ADVERSE EFFECTS ON EXISTING AND FUTURE DEVELOPMENT OF THE SURROUNDING AREA AS SET FORTH IN APPLICABLE CITY MASTER PLANS. THE DESIGN OF THE PROPOSED GATHERING SYSTEM AND FLOWLINE MITIGATES NEGATIVE IMPACTS ON THE SURROUNDING AREA TO THE GREATEST EXTENT FEASIBLE. THE DISTURBED AREA SHALL BE MAINTAINED DURING CONSTRUCTION BY THE APPLICANT OR PROPERTY OWNER IN SUCH A MANNER TO CONTROL SOIL EROSION, DUST AND THE GROWTH OF NOXIQUIS WEEDS.

SHEET NUMBER  <b>4</b>	DRAWN BY:	SCALE:	NATURAL GAS & CRUDE OIL PIPELINE GATHERING SYSTEM AS-BUILT SITE PLAN CRESTONE PEAK RESOURCES MIDSTREAM LLC APPURTENANCE SITE & FEMA FLOODPLAIN MAP	CRESTONE PEAK RESOURCES MIDSTREAM LLC ATTN: NATHAN BENNETT 555 WEST ST. STE 3700 DENVER, CO 80202 PHONE: (303) 312-8166	 10333 E DRY CREEK RD. DENVER, CO 80231 ENGLEWOOD, CO 80112 TEL: 720.482.9328 Westwoods.com Westwood Professional Serv/ces, Inc.	14	KING LATERAL MODIFICATION	07-10-24	NEW
	CHECKED BY:	AS SHOWN				13	CHICO-WATKINS LATERAL	02-28-21	NEW
	FILE NO:					12	JAWASO LATERAL	10-12-20	NEW
	DATE:	08/19/2020				11	CROW LATERAL	05-04-22	NEW
						10	DE OIL ON TITTE / BORDER		
						9	YELLOW LATERAL	11-13-21	NEW
						8	BULL SOUTH LATERAL	11-13-21	NEW
						7	ELLEN HILLS SOUTH LATERAL	11-13-21	NEW
						6	EASTERN HILLS SOUTH LATERAL	10-21-21	NEW
						5	GRANITE NORTH LATERAL	08-10-21	NEW
						4	RESERVE NORTH LATERAL	02-20-21	NEW
						3	RESERVE NORTH LATERAL	02-20-21	NEW
						2	BUSH NORTH LATERAL	02-20-21	NEW
						1	BUSH NORTH LATERAL	02-20-21	NEW



