

KAISER AURORA CENTRETECH PARK SUBDIVISION
FILING NO. 2

A RESUBDIVISION OF LOT 1 AND 2, BLOCK 1, KAISER AURORA CENTRETECH PARK SUBDIVISION FILING NO. 1, LOT 4
BLOCK 1 AURORA CENTRETECH PARK SUBDIVISION FILING NO. 3 AND A PORTION OF VACATED EAST FIRST AVENUE,
BEING LOCATED IN THE SOUTHEAST QUARTER OF SECTION 8, TOWNSHIP 4 SOUTH, RANGE 66 WEST 6TH P.M.
SITUATED
CITY OF AURORA, COUNTY OF ARAPAHOE, STATE OF COLORADO

SHEET 1 OF 2

LEGAL DESCRIPTION AND DEDICATIONS

KNOW ALL PEOPLE BY THESE PRESENTS THAT THE UNDERSIGNED WARRANT THEY ARE THE OWNERS OF A PARCEL OF LAND BEING A PORTION OF KAISER AURORA CENTRETECH PARK SUBDIVISION FILING NO. 1, AND A PORTION OF AURORA CENTRETECH PARK SUBDIVISION FILING NO. 3, TOGETHER WITH A PORTION OF VACATED EAST FIRST AVENUE, LOCATED IN THE SOUTHEAST QUARTER OF SECTION 8, TOWNSHIP 4 SOUTH, RANGE 66 WEST OF THE 6TH PRINCIPAL MERIDIAN, COUNTY OF ARAPAHOE, STATE OF COLORADO, MORE PARTICULARLY DESCRIBED AS FOLLOWS:

BEARINGS ARE BASED ON THE EAST LINE OF THE NORTHEAST QUARTER OF SAID SECTION 8 PER THE CITY OF AURORA HORIZONTAL CONTROL SHEET 09H AS BEARING SOUTH 00°41'59" EAST, A DISTANCE OF 240.62 FEET BETWEEN THE FOLLOWING DESCRIBED MONUMENTS:

- THE EAST QUARTER CORNER OF SECTION 8 BEING A FOUND 3.25" ALUMINUM CAP, PLS 22100 IN RANGE BOX MATCHING MONUMENT RECORD FILED 6/30/07
 - THE CENTER QUARTER CORNER OF SECTION 8 BEING A FOUND 3.25" ALUMINUM CAP, PLS 22100 IN RANGE BOX MATCHING MONUMENT RECORD FILED 6/30/07
- COMMENCING AT SAID EASTER QUARTER CORNER OF SECTION 8;
- THENCE ALONG SAID NORTH LINE OF THE SOUTHEAST QUARTER SOUTH 89°57'19" WEST, A DISTANCE OF 55.12 FEET TO THE WESTERLY RIGHT-OF-WAY OF AIRPORT BOULEVARD AND THE POINT OF BEGINNING;
- THENCE ALONG SAID WESTERLY RIGHT-OF-WAY SOUTH 00°00'30" WEST, A DISTANCE OF 550.00 FEET TO THE NORTHERLY RIGHT-OF-WAY OF EAST CENTRETECH PARKWAY;
- THENCE ALONG SAID NORTHERLY RIGHT-OF-WAY THE FOLLOWING FOUR (4) COURSES AND DISTANCES:
- THENCE ALONG A CURVE TO THE RIGHT HAVING A RADIUS OF 25.00 FEET, A CENTRAL ANGLE OF 90°00'00", WHOSE CHORD BEARS SOUTH 45°00'30" WEST A DISTANCE OF 35.36 FEET, FOR AN ARC DISTANCE OF 39.27 FEET;
 - THENCE NORTH 89°59'30" WEST, A DISTANCE OF 95.00 FEET;
 - THENCE SOUTH 86°55'18" WEST, A DISTANCE OF 130.00 FEET;
 - THENCE NORTH 89°59'30" WEST, A DISTANCE OF 960.63 FEET TO THE SOUTHWEST CORNER OF SAID LOT 1, BLOCK 1 KAISER AURORA CENTRETECH PARK SUBDIVISION FILING NO. 1;
- THENCE ALONG THE WESTERLY LINE OF SAID LOT 1 NORTH 00°00'30" EAST, A DISTANCE OF 580.88 FEET TO SAID NORTHERLY LINE OF SAID SOUTHEAST QUARTER OF SECTION 8;
- THENCE ALONG SAID NORTHERLY LINE NORTH 89°57'19" EAST, A DISTANCE OF 1,210.44 FEET TO THE POINT OF BEGINNING. CONTAINING 702,370 SQUARE FEET OR 16.124 ACRES, MORE OR LESS.

HAVE LAID OUT, PLATTED, AND SUBDIVIDED THE SAME INTO LOTS AND A BLOCK AS SHOWN ON THIS PLAT UNDER THE NAME AND STYLE OF KAISER AURORA CENTRETECH PARK SUBDIVISION FILING NO. 2, AND BY THESE PRESENTS DO HEREBY DEDICATE TO THE CITY OF AURORA, COLORADO, FOR THE PERPETUAL USE OF THE PUBLIC, THE STREETS, AND EASEMENTS, AS SHOWN HEREON AND NOT PREVIOUSLY DEDICATED TO THE PUBLIC.

(Advisory Comment) Send in the updated Title Commitment to be dated within 30 calendar days of the plat approval date. (This Commitment should be submitted at the time of your final submittal of the electronic Plat for recording.)

(Advisory Comment) Send in the Certificate of Taxes Due show they are paid in full up to and through the plat approval date of recording. Obtained from the County Treasurer's office. (This Certificate of Taxes should be submitted at the time of your final submittal of the electronic Plat for recording.)

(Advisory Comment) Be advised - sometimes the margins or scale factor may not match the County or City standards as stated in the Subdivision Plat Checklist. If any of these factors are misaligned or scale does not match the drawing information, then this may cause the plat to be sent back and corrected and thus adding time to your submittal. And in turn, you may need to update the Title Commitment to bring it within the 30-day time limit. Please check these items before sending the plat in for recording.

Send in the closure sheet for the description.

Send in the State Monument Records for the aliquot corners used in the plat.

See the red line comments on the plat and site plan.

COVENANTS

THE UNDERSIGNED OWNER(S), FOR THEMSELVES, THEIR HEIRS, SUCCESSORS AND ASSIGNS, COVENANT AND AGREE WITH THE CITY OF AURORA AND ANY PORTION OF THE PLATTED LAND SHOWN HEREIN SHALL BE OCCUPIED OR USED UNLESS AND UNTIL ALL PUBLIC IMPROVEMENTS, AS DEFINED BY CHAPTER 146 OF THE CITY CODE OF AURORA, COLORADO, ARE IN PLACE AND ACCEPTED BY THE CITY OR CASH FUNDS OR OTHER SECURITY FOR THE SAME ARE ESCROWED WITH THE CITY OF AURORA AND A CERTIFICATE OF OCCUPANCY HAS BEEN ISSUED BY THE CITY;

ALL ELECTRICAL, COMMUNITY UTILITY LINES AND SERVICES, AND STREET LIGHTING CIRCUITS, EXCEPT AS PROVIDED IN SECTION 126-505 OF THE CITY CODE AS THE SAME MAY BE AMENDED FROM TIME TO TIME, SHALL BE INSTALLED UNDERGROUND;

ALL CROSSINGS OR ENCROACHMENTS, INCLUDING BUT NOT LIMITED, TO PRIVATE LANDSCAPE IRRIGATION SYSTEMS, UNDERDRAINS, OR PRIVATE UTILITIES INTO EASEMENTS OWNED BY THE CITY OF AURORA ARE ACKNOWLEDGED BY THE UNDERSIGNED AS BEING SUBJECT TO THE CITY OF AURORA'S USE AND OCCUPANCY OF SAID EASEMENTS AND RIGHTS-OF-WAY. THE UNDERSIGNED, THEIR SUCCESSORS AND ASSIGNS, HEREBY AGREE TO INDEMNIFY AND HOLD HARMLESS THE CITY OF AURORA FOR ANY LOSS, DAMAGE, OR REPAIR TO PRIVATE LANDSCAPE IRRIGATION SYSTEMS, UNDERDRAINS, OR PRIVATE UTILITIES THAT MAY RESULT FORM THE CITY OF AURORA'S USE AND OCCUPANCY OR EXERCISE OF ITS RIGHTS IN SAID EASEMENTS AND RIGHTS-OF-WAY. THE UNDERSIGNED, ITS SUCCESSORS AND ASSIGNS, FURTHER AGREES TO REMOVE, REPAIR, REPLACE, RELOCATE, MODIFY, OR OTHERWISE ADJUST SAID PRIVATE LANDSCAPE IRRIGATION SYSTEMS, UNDERDRAINS, PRIVATE DETENTION POND AND DRAINAGE FEATURES, OR PRIVATE UTILITIES UPON REQUEST FROM THE CITY OF AURORA AND AT NO EXPENSE TO THE CITY OF AURORA.

GENERAL NOTES

- ALL BEARINGS CONTAINED HEREIN ARE BASED ON THE NORTH LINE OF THE SOUTHEAST QUARTER OF SECTION 8 BEING ASSUMED TO BEAR N89°57'19"E AS SHOWN AND DESCRIBED HEREON.
- ALL DIMENSIONS SHOWN HEREON ARE IN U.S. SURVEY FEET. ALL BEARINGS SHOWN HEREON ARE IN DEGREE-MINUTES-SECONDS.
- ANY PERSON WHO KNOWINGLY REMOVES, ALTERS OR DEFACES ANY PUBLIC LAND SURVEY MONUMENT OR LAND SURVEY BOUNDARY MONUMENT OR ACCESSORY COMMITS A CLASS TWO (2) MISDEMEANOR PURSUANT TO STATE STATUE 18-4-508, C.R.S.
- NOTICE: ACCORDING TO COLORADO LAW YOU MUST COMMENCE ANY LEGAL ACTION BASED UPON ANY DEFECT IN THIS SURVEY WITHIN THREE YEARS AFTER YOU FIRST DISCOVER SUCH DEFECT. IN NO EVENT MAY ANY ACTION BASED UPON ANY DEFECT IN THIS SURVEY BE COMMENCED MORE THAN TEN YEARS FROM THE DATE OF CERTIFICATION SHOWN HEREON.
- THIS SURVEY DOES NOT CONSTITUTE A TITLE SEARCH BY RICK ENGINEERING TO DETERMINE OWNERSHIP OF EASEMENTS OF RECORD. FOR ALL INFORMATION REGARDING EASEMENTS, RIGHTS-OF-WAY AND TITLE OF RECORD, RICK ENGINEERING RELIED UPON COMMITMENT NO. NCS-1188048-SF, ISSUED BY FIRST AMERICAN TITLE INSURANCE COMPANY NATIONAL COMMERCIAL SERVICES AND HAVING AN EFFECTIVE DATE OF AUGUST 8, 2023 AT 5:00 P.M.
- RIGHT-OF-WAY FOR INGRESS AND EGRESS FOR SERVICE AND EMERGENCY VEHICLES IS GRANTED OVER, ACROSS, ON, AND THROUGH ANY AND ALL PRIVATE ROADS, WAYS, AND FIRE LANES NOW OR HEREAFTER ESTABLISHED ON THE DESCRIBED PROPERTY. THE SAME ARE HEREBY DESIGNATED AS FIRE LANES AND EMERGENCY AND SERVICE VEHICLE ROADS, AND SHALL BE POSTED "NO PARKING - FIRE LANE".
- THIS PLAT DOES NOT CHANGE THE EASEMENTS AS SHOWN ON THE PLATS OF KAISER AURORA CENTRETECH PARK SUBDIVISION FILING NO. 1, RECEPTION NO. R2684606 OR AURORA CENTRETECH PARK SUBDIVISION FILING NO. 3, RECEPTION NO. R2250416 OF VILLAGE AT CITY CENTER SUBDIVISION FILING NO. 1, RECORDED AT RECEPTION NO. B2136512. THE PURPOSE OF THIS PLAT IS TO REVISE LOT LINES TO CREATE 2 LOTS INSTEAD OF 3 LOTS AND A VACATED PORTION OF EAST FIRST AVENUE. NO OTHER CHANGES ARE MADE HEREBY.
- THE EASEMENT AREA WITHIN EACH LOT IS TO BE CONTINUOUSLY MAINTAINED BY THE OWNER OF THE LOT EXCEPTING THE CITY OF AURORA FROM SUCH RESPONSIBILITY. ANY STRUCTURES INCONSISTENT WITH THE USE GRANTED IN THE EASEMENT ARE PROHIBITED.
- DATE OF FIELDWORK: 9/8/2023

OWNER

BY: KAISER FOUNDATION HEALTH PLAN OF COLORADO, A COLORADO NON-PROFIT CORPORATION


BY: _____
NAME: _____
TITLE: _____

NOTARY

STATE OF _____)
COUNTY OF _____)SS
THE FOREGOING INSTRUMENT WAS ACKNOWLEDGED BEFORE ME THIS _____ DAY OF _____, 20____, BY _____
WITNESS MY HAND AND SEAL _____
MY COMMISSION EXPIRES _____

10. All owners of Lots or Tracts adjacent to (insert names of any arterial, collector, and continuous Type I local streets here) shall be required to comply with requirements of the Aurora City Code restricting the ability to build a fence along those streets or the types and sizes of fences that can be built along those streets.

11. The owners or occupants of the lands herein described shall have no right or cause of action, either in law or in equity, for damages or injury to any person or property arising out of or resulting directly or indirectly, from the overflight of aircraft, or for damages or injury to any person or property resulting from any noise, nuisance, vibrations of any kind or description resulting, directly or indirectly, from aircraft overflights provided, that nothing contained in the foregoing easement shall divest the owners or occupants, their heirs, successors administrators or assigns, of any right or cause of action for damages to any person or property resulting from the negligent operation of aircraft overflights over the described premises at any altitude above ground level.

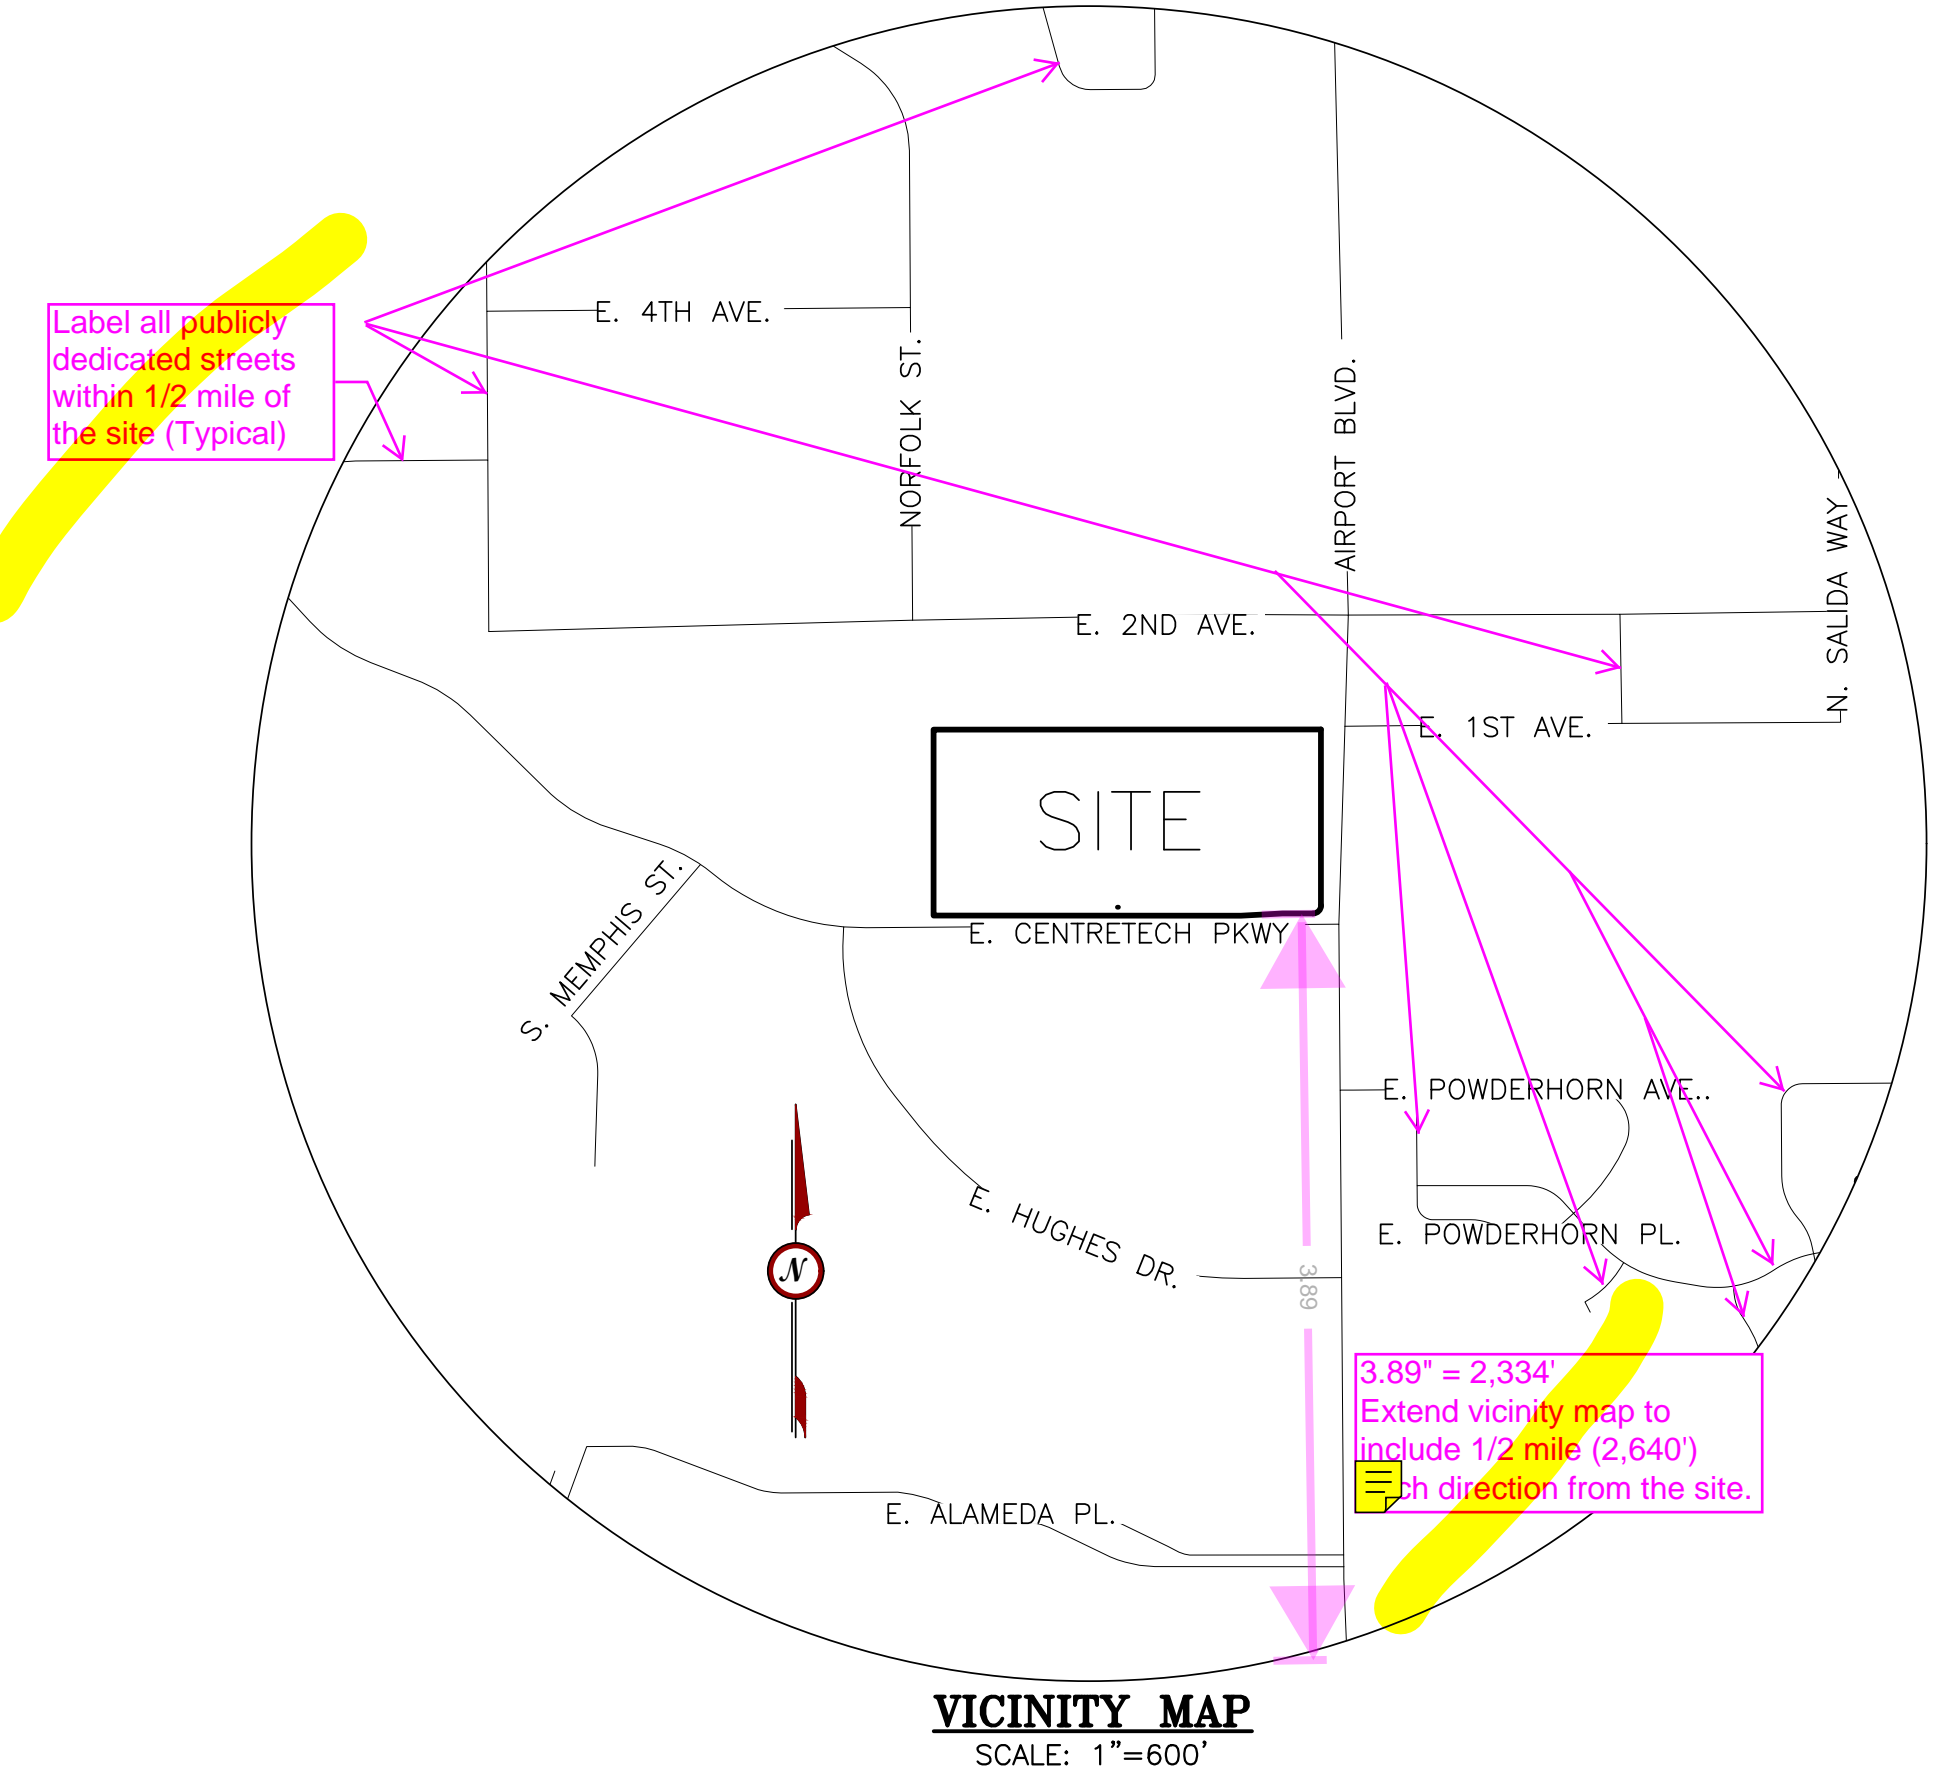

CITY OF AURORA APPROVALS

THE FOREGOING INSTRUMENT IS APPROVED FOR FILING AND CONVEYANCE OF STREETS, AND EASEMENTS, AS SHOWN HEREON AND IS ACCEPTED BY THE CITY OF AURORA, COLORADO, THIS _____ DAY OF _____, 20____AD, SUBJECT TO THE CONDITION THAT THE CITY SHALL UNDERTAKE MAINTENANCE OF ANY SUCH STREETS ONLY AFTER CONSTRUCTION HAS BEEN COMPLETED BY THE SUBDIVIDER TO CITY OF AURORA SPECIFICATIONS.

CITY ENGINEER _____ DATE _____
PLANNING DIRECTOR _____ DATE _____

SURVEYOR'S CERTIFICATE

I HEREBY CERTIFY I WAS IN RESPONSIBLE CHARGE OF THE SURVEY WORK USED IN THE PREPARATION OF THIS PLAT; THE POSITIONS OF THE PLATTED POINTS SHOWN HEREON HAVE AN ACCURACY OF NOT LESS THAN ONE (1) FOOT IN TEN THOUSAND (10,000) FEET PRIOR TO ADJUSTMENTS; AND ALL BOUNDARY MONUMENTS AND CONTROL CORNERS SHOWN HEREON WERE IN PLACE AS DESCRIBED ON MARCH 13, 2020. THIS SURVEY IS NOT A GUARANTY OR WARRANTY, EITHER EXPRESSED OR IMPLIED.

ROBERT J. HENNESSY, P.L.S. 34580, LICENSED COLORADO LAND SURVEYOR
FOR AND ON BEHALF OF RICK ENGINEERING COMPANY

RECORDER'S CERTIFICATE

ACCEPTED FOR FILING IN THE OFFICE OF THE COUNTY CLERK AND RECORDER OF ARAPAHOE COUNTY, COLORADO ON THIS _____ DAY OF _____, 20____AD AT _____ O'CLOCK _____ M.

COUNTY CLERK AND RECORDER

DEPUTY

FILE NO. _____

MAP NO. _____

RECEPTION NO.: _____

REVISIONS			
NO.	DESCRIPTION	DATE	BY
#	#	#	#
#	#	#	#
RICK
ENGINEERING COMPANY
5690 WEBSTER ST
ARVADA, CO 80002
PH. (303) 423-6036

KAISER AURORA CENTRETECH PARK SUBDIVISION

FILING NO. 2

A RESUBDIVISION OF LOT 1 AND 2, BLOCK 1, KAISER AURORA CENTRETECH PARK SUBDIVISION FILING NO. 1, LOT 4
BLOCK 1 AURORA CENTRETECH PARK SUBDIVISION FILING NO. 3 AND A PORTION OF VACATED EAST FIRST AVENUE,
BEING LOCATED IN THE SOUTHEAST QUARTER OF SECTION 8, TOWNSHIP 4 SOUTH, RANGE 66 WEST 6TH P.M.
CITY OF AURORA, COUNTY OF ARAPAHOE, STATE OF COLORADO

SHEET 2 OF 2

CENTER 1/4 CORNER OF
SECTION 8 FOUND 3.25"
ALUMINUM CAP, PLS
22100 IN RANGE BOX
MATCHING MONUMENT
RECORD FILED 6/30/07

Add 2nd tie out distance per
COA 2023 Subdivision Plat
Checklist Item #13.d.(6)

Please incorporate the
inside turning radii at
the north end of the
existing Fire Lane and
Utility Easement.

FOUND #5 REBAR
& 1.5" ALUMINUM
CAP PLS 10734
0.3' BG

RECEPTION
NO. R2694397

FOUND #5
REBAR & 1.5"
ALUMINUM CAP
PLS 10734
0.1' AG, HELD
FOR LINE FOR
WEST
BOUNDARY,
NOT ACCEPTED
FOR CORNER,
MONUMENT
LIES 0.3'
SOUTHERLY OF
CORNER
POSITION.

Add bearing to conflicting monument and provide
reason for not accepting per COA 2023 Subdivision
Plat Checklist Item #12.1
Documenting New and Existing Monuments. If a
monument is set, as a result of a land survey, that
represents the same corner or control corner of an existing
monument, the professional land surveyor setting the new
monument shall, on the resulting land survey plat, make
note of the reason the professional land surveyor did not
accept the existing monument. (see AES Rule 1.6.E.4.a.)

Please clearly
identify which
Lot Line is being
removed on the
plans.

Add monument symbols to legend?

SECTION CORNER AS
DESCRIBED
BOUNDARY MONUMENT AS
DESCRIBED

SET #5x18" REBAR & 1.5"
PLASTIC CAP PLS 34580

BG=BELOW GROUND
AG=ABOVE GROUND
REC.=RECEPTION

LEGEND

SECTION CORNER AS DESCRIBED	SECTION LINE
BOUNDARY MONUMENT AS DESCRIBED	BOUNDARY LINE
SET #5x18" REBAR & 1.5" PLASTIC CAP PLS 34580	LOT LINE
BG=BELOW GROUND AG=ABOVE GROUND REC.=RECEPTION	ADJOINER LOT LINE
	VACATED LOT LINE
	EASEMENT
	PEDESTRIAN EASEMENT
	ROAD CENTERLINE
	BACK OF CURB

this lot line has not been vacated. the
vacated portion of 1st ave adjacent to
the lot is shown. not a part of this
survey

May require note on sheet 1 (See COA 2023
Subdivision Plat Checklist Item #12.d.)

Label as Firelane and
Water Easement

Label these lines, if
they are old lot lines
remove per COA
13.d.(5).

Label as Water
Easement (TYP)

Show distances
to the nearest
0.01' (Typical)

LOT 1
367592 SQ. FT.
8.439 ACRES±

BLOCK 1


LOT 2
334778 SQ. FT.
7.685 ACRES±

BLOCK 1

Is ROW being
dedicated here? GIS
appears to indicate
that approximately 25'
of ROW would have to
be dedicated here for
the property line to
match this.

Describe all
stamping?

Show opposing ROW per COA
2023 Subdivision Plat Checklist
Item #14

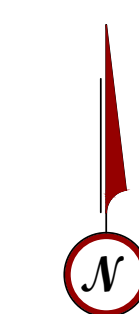

60 0 30 60 120
ORIGINAL SCALE: 1"= 60' HORIZ.

RICK
ENGINEERING COMPANY
5690 WEBSTER ST.
ARVADA, CO 80002
PH. (303) 423-6036