


SABLE BLVD. TOWNHOMES SITE PLAN

SABLE BLVD. TOWNHOMES SUBDIVISION FILING NO. 1
SITUATED IN THE NE 1/4 OF SECTION 31, T.3S., R.66W. OF THE 6TH P.M.
CITY OF AURORA, COUNTY OF ADAMS, STATE OF COLORADO

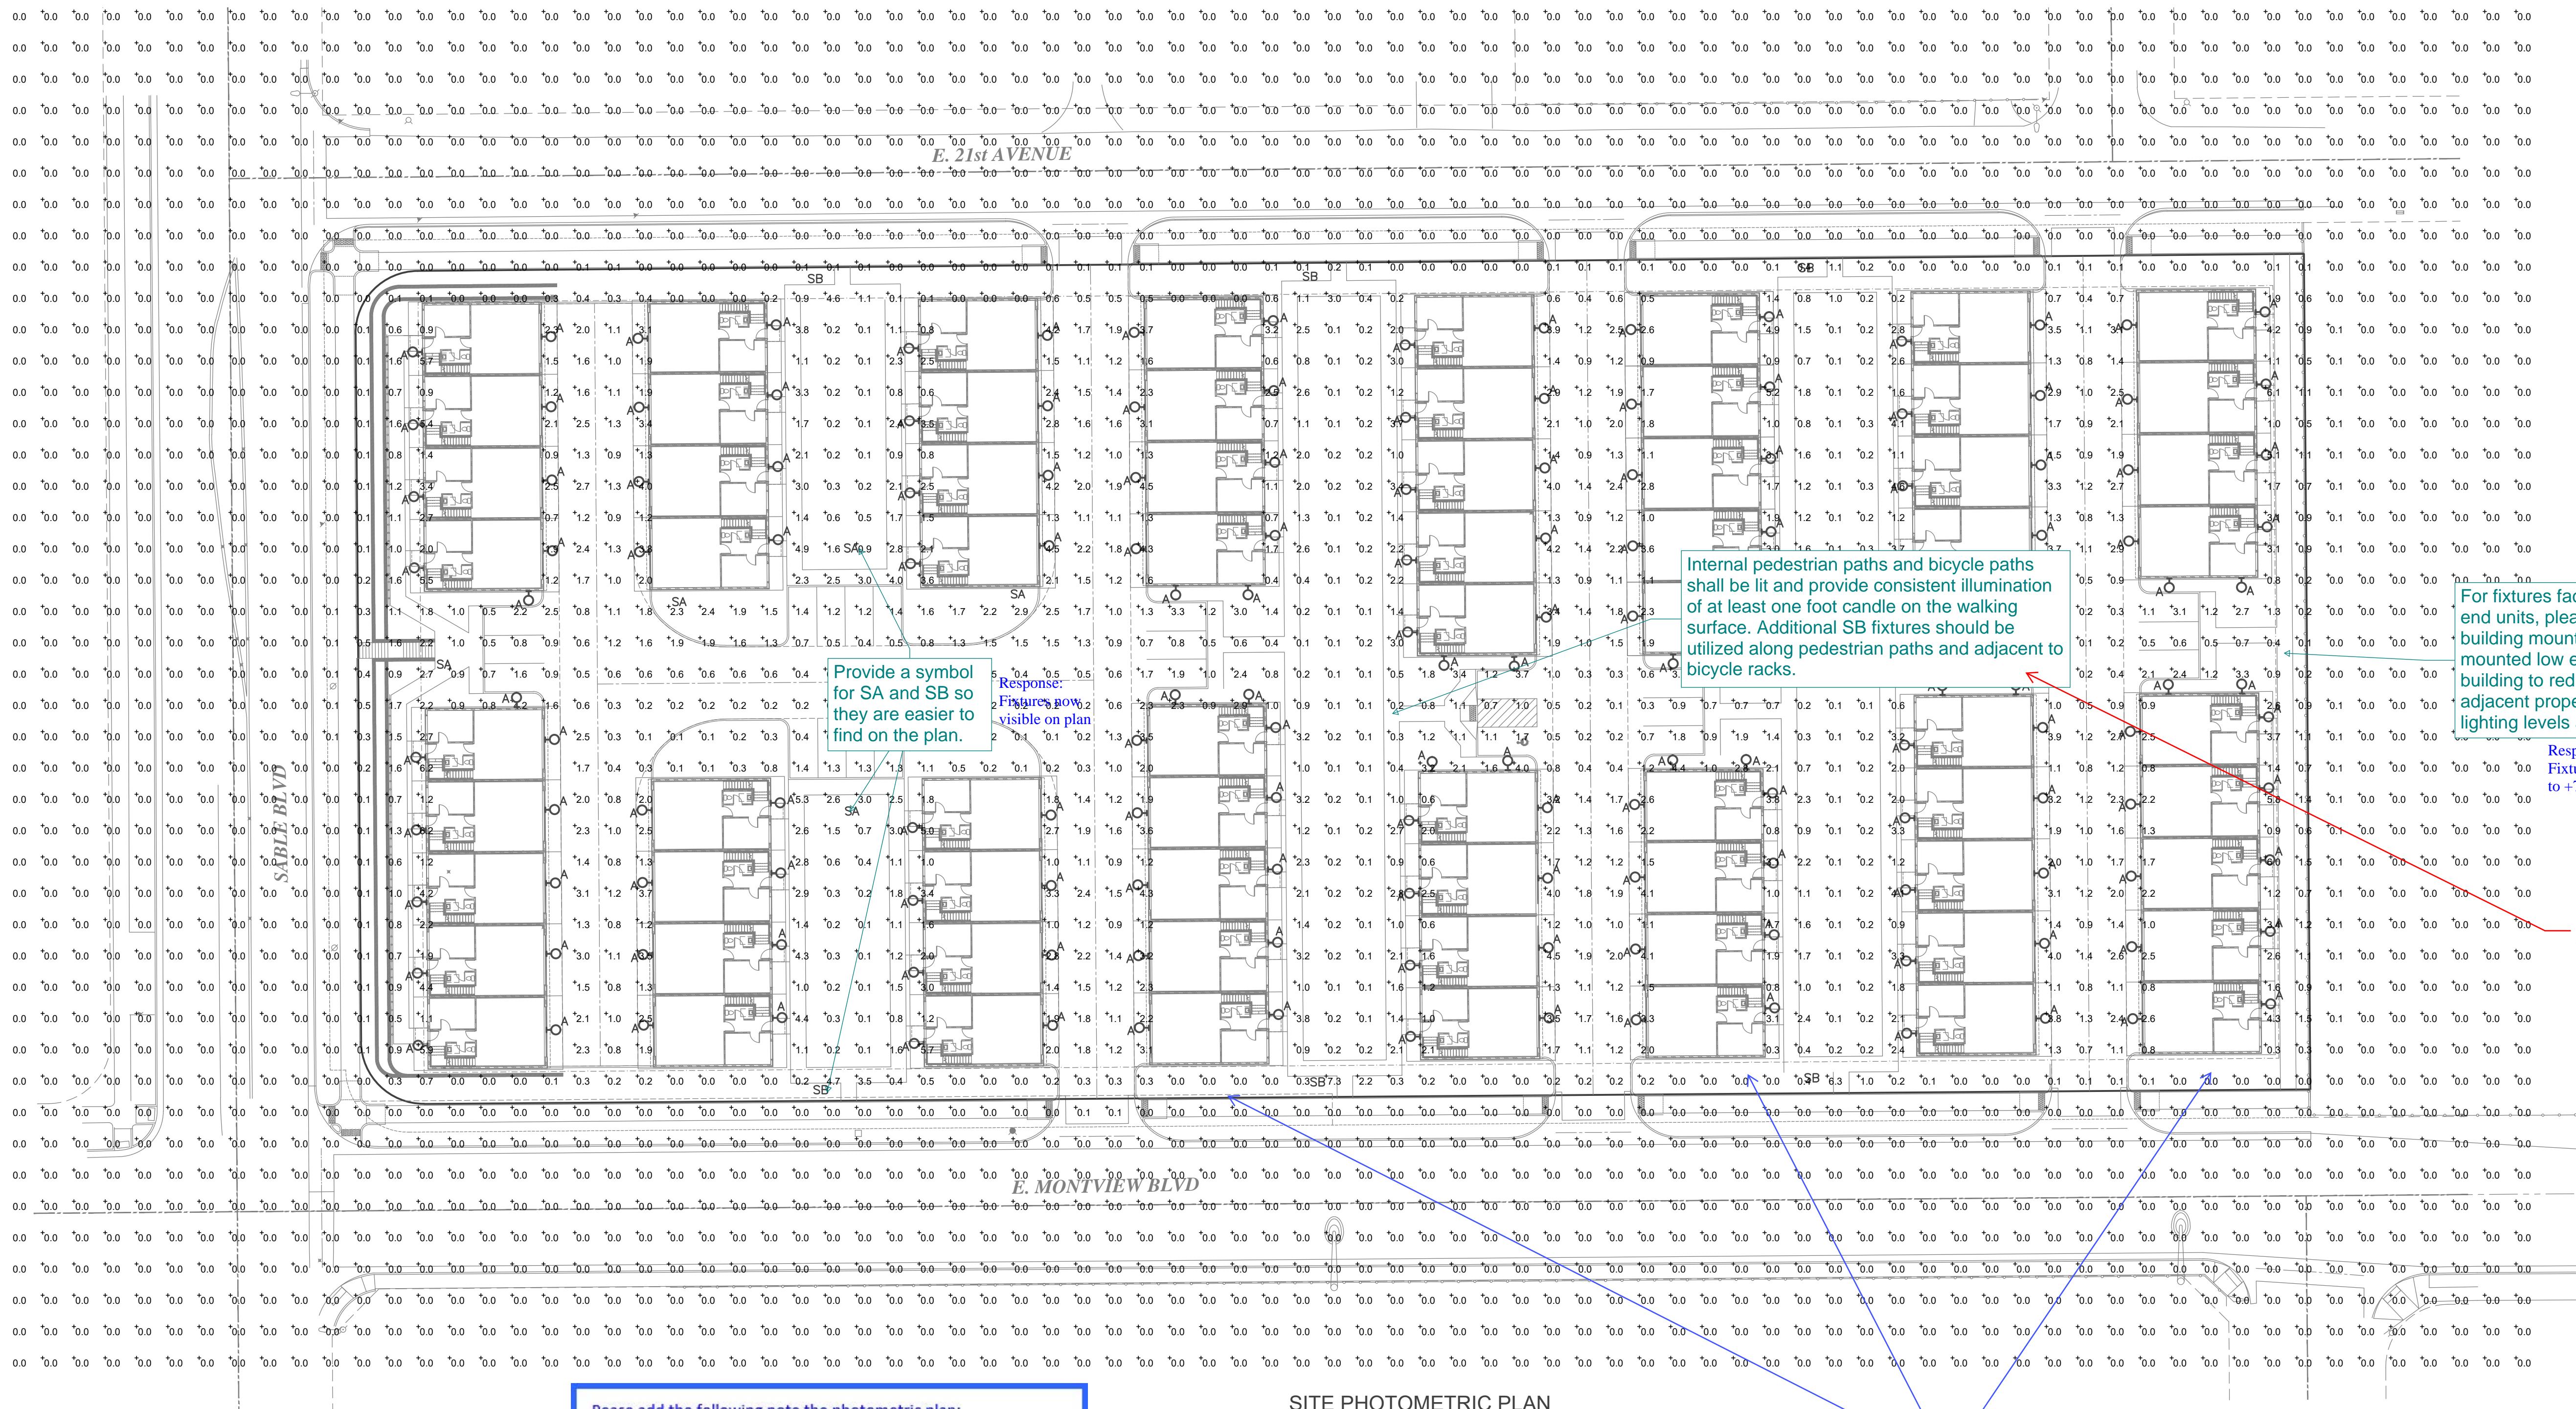

Please add the following note to the photometric plan:

ILLUMINATION WITHIN THE SITE MUST COMPLY WITH THE 2015 INTERNATIONAL BUILDING CODE REQUIREMENT FROM SECTION 1006 - MEANS OF EGRESS ILLUMINATION. SECTION 1006. ILLUMINATION REQUIRED: THE MEANS OF EGRESS, INCLUDING THE EXIT DISCHARGE, SHALL BE ILLUMINATED AT ALL TIMES THE BUILDING IS OCCUPIED. SECTION 1006.2 ILLUMINATION LEVEL. THE MEANS OF EGRESS ILLUMINATION LEVEL SHALL NOT BE LESS THAN 1 FOOT-CANDLE (11 LUX) AT THE FLOOR LEVEL AND CONTINUING TO THE "PUBLIC WAY".

Response: Note added

SITE PHOTOMETRIC PLAN

SCALE: 1" = 30'-0"

*Show a complete map of the egress route to the public way, not just to the parking area. Also show the illumination levels along the entire length of the accessible route throughout the property.

The photometric plan must show the accessible route throughout the site. Please ensure that a minimum of 1 foot candle of lighting is provided within the accessible route.

Response: accessible route now shown and light levels along the accessible path are at a minimum 1 fc

| SITE PHOTOMETRIC SUMMARY | | |
|--------------------------|------------------|--|
| AVERAGE | = 0.4 FT. CANDLE | |
| MAXIMUM | = 7.3 FT. CANDLE | |
| MINIMUM | = 0.0 FT. CANDLE | |

Client: UTAH DEVELOPMENT GROUP
324 S. 400 W. SUITE 175
SALT LAKE CITY, UTAH 84101
PHONE: (801) 641-8956
ATTN: MARCO DIAZ

Engineering Consultants
INCORPORATED
ELECTRICAL ENGINEERS
881 E Hampden Ave, Ste 208, Denver, CO 80231
(303) 355-5534 (tel) walter@ejhc.com

Title: SITE PHOTOMETRIC PLAN
SABLE BLVD. TOWNHOMES SITE PLAN
NEC E. MONTVIEW BLVD. & S. SABLE BLVD.
SABLE BLVD. TOWNHOMES SUBDIVISION FILING NO. 1
CITY OF AURORA, COUNTY OF ADAMS, STATE OF COLORADO


Drawn by: SG
Project No.: 03/06/2023
Sheet No.: AS SHOWN
Scale: 1" = 30'-0"

SABLE BLVD. TOWNHOMES SITE PLAN

SABLE BLVD. TOWNHOMES SUBDIVISION FILING NO. 1
SITUATED IN THE NE 1/4 OF SECTION 31, T.3S., R.66W. OF THE 6TH P.M.
CITY OF AURORA, COUNTY OF ADAMS, STATE OF COLORADO



STREET LIGHTING PHOTOMETRIC PLAN

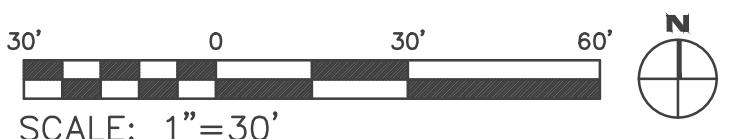

| PHOTOMETRIC SUMMARY | | | |
|------------------------|------------|---------------|------------|
| ROADWAY | | | |
| REQUIRED | PROVIDED | REQUIRED | PROVIDED |
| Avg Luminance | Uniformity | Avg Luminance | Uniformity |
| 0.3 cd/sq m MINIMUM | 6.0 MAX | 3.2 cd/sq m | 2.7 |

| PUBLIC STREET LIGHT COUNT | |
|---------------------------|---|
| PEDESTRIAN LIGHT POLES | 0 |
| NEW STREET LIGHT POLES | 5 |

Please review section 2.12.0.1 of the 2023 Roadway Manual and identify the required information regarding public streetlights on the photometric plan.

Response:
Information added on plan per Manual

UTAH DEVELOPMENT GROUP
324 S. 400 W. SUITE 175
SALT LAKE CITY, UTAH 84101
PHONE: (801) 641-8956
ATTN: MARCO DIAZ

Client: _____ Date: _____

No.: Description: _____
1. INITIAL SITE PLAN SUBMITTAL
- - - - -
- - - - -
Engineering Consultants Inc. Professional Electrical Engineers
8811 E Hampden Ave. Ste 208 Denver, CO 80231
(303) 355-5534 (tel) walter@gecinc.com

STREET LIGHTING PHOTOMETRICS
SABLE BLVD. TOWNHOMES SITE PLAN
NEC E. MONTVIEW BLVD. & S. SABLE BLVD.
SABLE BLVD. TOWNHOMES SUBDIVISION FILING NO. 1
CITY OF AURORA, COUNTY OF ADAMS, STATE OF COLORADO

Drawn by: SG Date: 03/06/2023
Project No.: Scale: AS SHOWN
Sheet No.: 14 OF 18

SABLE BLVD. TOWNHOMES SITE PLAN

SABLE BLVD. TOWNHOMES SUBDIVISION FILING NO. 1
SITUATED IN THE NE 1/4 OF SECTION 31, T.3S., R.66W. OF THE 6TH P.M.
CITY OF AURORA, COUNTY OF ADAMS, STATE OF COLORADO

STREET LIGHT "SL-2"

| LIGHTING FIXTURE SCHEDULE – STREET LIGHTS | | | | | | | | |
|---|-----|---|--|--------------------------------------|------|-------|---------|--|
| ITEM | NO. | MANUFACTURER | CAT. NO. | LAMPS | WATT | COLOR | POLE HT | DESCRIPTION |
| SL-2 | 2 | HEAD: GENERAL ELECTRIC POLE: MILLERBEND VALMONT | EVOLVE SERIES ERL1-0-06-B3-30-A-GRAY-R SJ1-041-A-070-A- 250-R-GV-NC2 DS210-700A250-D1- PC-GV-NC | 3000K LED 5,820 INITIAL LUMENS | 53 | GRAY | 25 FT | CITY STANDARD COBRA HEAD STYLE LUMINAIRE ON 4 FT TAPERED UPSWEPT ARM WITH 2 INCH PIPE SIZE TENON MOUNTED ON 25 FT. ROUND TAPERED GALVANIZED STEELE POLE |


NOTES:
ALL LUMINAIRES MUST BE EQUIPPED WITH A SURGE SUPPRESSION DEVICE WITH A MINIMUM IMMUNITY LEVEL OF 10 KV.
ALL LUMINAIRES SHALL BE EQUIPPED WITH A 0-10V DIMMING DRIVER.
ALL LUMINAIRES SHALL BE EQUIPPED WITH A CONTROL NODE.

Response:
Fixture schedule revised per
pre-approved standards

The public streetlights shall use fixtures and poles from the pre-approved fixture list: https://cdnms5-hosted.civiclive.com/UserFiles/Servers/Server_1881137/File/Business%20Services/Development%20Center/Code%208%20Rules/Design%20Standard/Engineering%20Design%20Standard/LightingEquipment.pdf. Poles for SL-1 shall be 20' height and poles for SL-3 shall be 30' height.



STREET LIGHT "SL-2" POLE

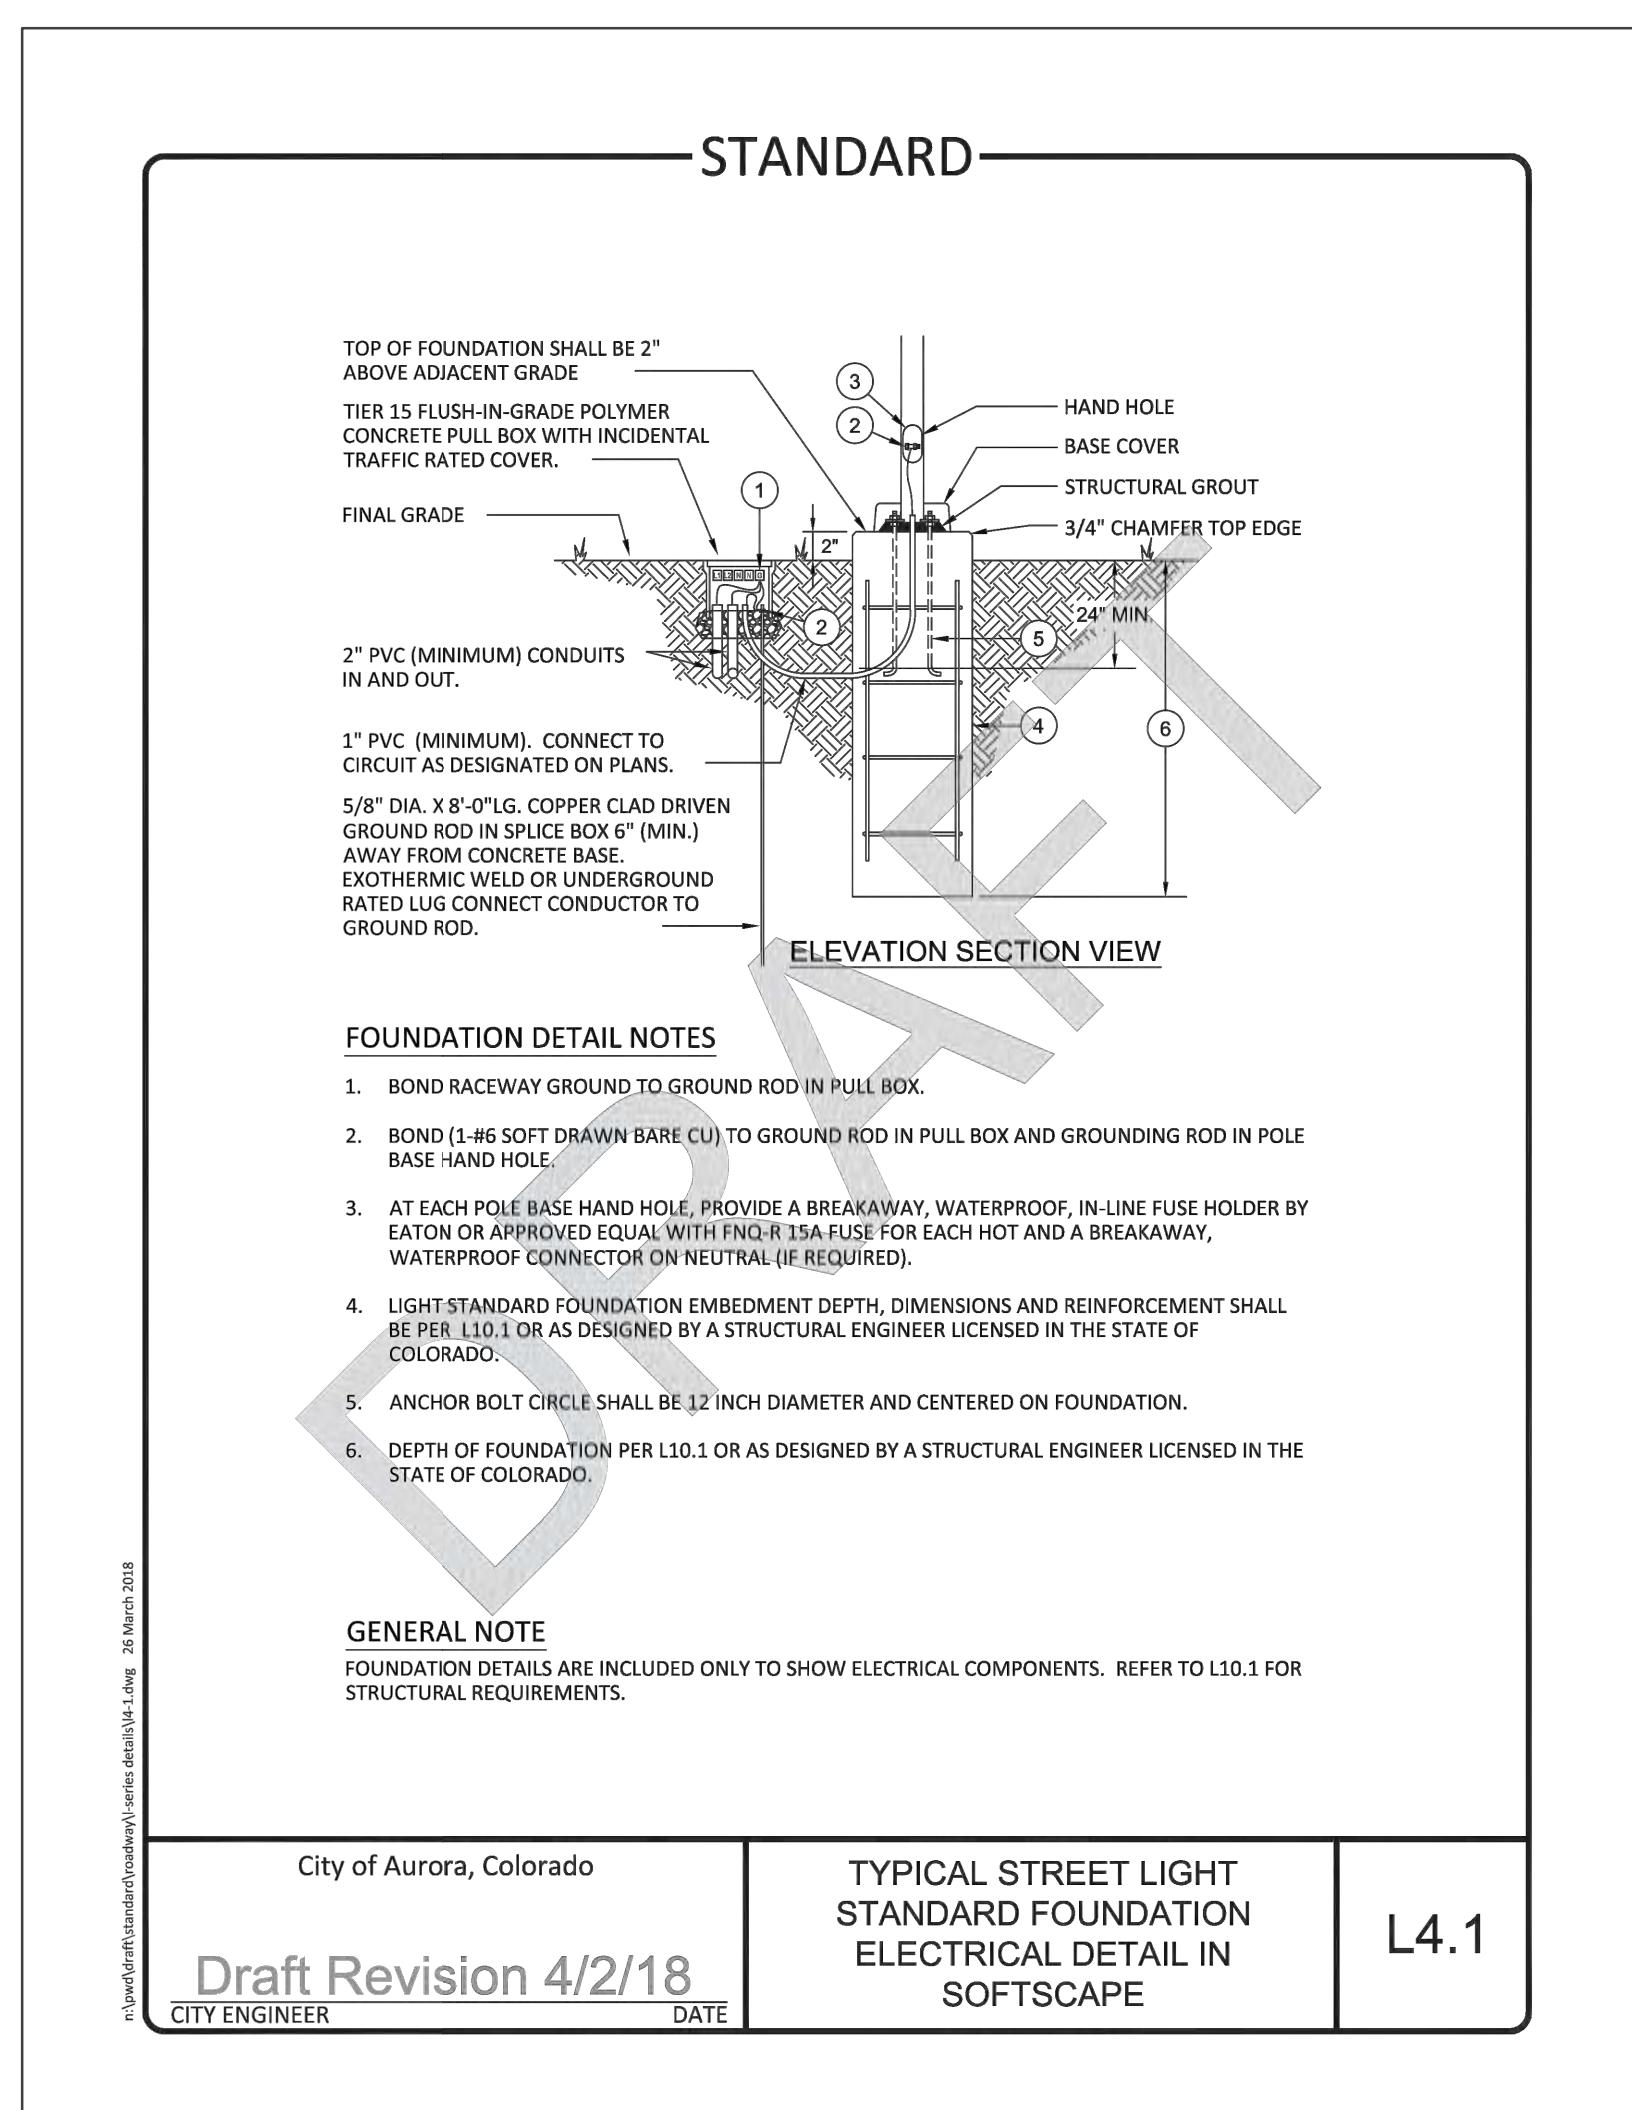

Ordering Number Logic Evolve™ LED Streetlight (ERL1)

| ERL1 | PROD. ID | VOLTAGE | LUMEN OUTPUT | DISTRIBUTION | CCT | CONTROLS | COLOR | OPTIONS |
|-------------|--------------|---------|-------------------|----------------------------|-------------------------|----------------------|---------------------------------------|------------|
| E = Evolve | 0 = 120-277V | 22* | A1 = Extra narrow | 3 = 3000K | 40 = 4000K | G = Gray | A = 4-Bolt Studfitter† | F = Fusing |
| R = Roadway | 2 = 120 | 23 | B1 = Narrow | D = ANSI C136.4-7-pin | 45 = IP66 Optic | B = Block | G = Internal Bubble Level | |
| L = Local | 2 = 208 | 24 | C1 = Standard | 48 = C136.4-7-pin | DKW = Dark | C = Cap | I = IP66 Optic | |
| | 4 = 277 | 25 | D1 = Asymmetric | receptacle with Shorting | brane | E = C136.4-7-pin | J = Internal Entry | |
| | 6 = 307 | 26 | E1 = Asymetric | Receptacle with non- | ote | F = PE Control | K = Optional Secondary Enhanced Surge | |
| | 8 = 347 | 27 | F1 = Asymetric | Dimming PC Control | Protection (IDPAKA) | G = 120-277V or 480V | L = Internal Entry | |
| | H = 347-480V | 28 | G1 = Asymmetric | *PE Control required for | M = Protection (IDPAKA) | I = 120-277V or 480V | U = Internal Entry | |
| | | | | 120-277V or 480V Decree. | N = Protection (IDPAKA) | V = Internal Entry | X = Single Package # | |
| | | | | Not available for 347-480V | O = Dimming | Y = Coastal Finish | | |
| | | | | & 120V only, not | Z = DALI | ZOO = Programmable | | |
| | | | | compatible with | | ^ = DALI | | |
| | | | | 347-480V dimming | | | | |

*Note: Dimming controls wired for 0-10V standard unless DALI option "U" requested.
See Data Table for more information

| PRODUCT ID | LUMEN OUTPUT | DISTRIBUTION | TYPICAL INITIAL LUMENS | TYPICAL SYSTEM LUMENS | WATTAGE | BUG RATING | IES FILE NUMBER 4000K | IES FILE NUMBER 3000K |
|------------|--------------|--------------|------------------------|-----------------------|----------|------------|-----------------------|-----------------------|
| 01 | 4000K | 15 | N/A | 120-277V | 347-480V | | | |
| 02 | 4000K | 28 | N/A | 120-277V | 347-480V | | | |
| 03 | 4000K | 35 | N/A | 120-277V | 347-480V | | | |
| 04 | 4000K | 38 | N/A | 120-277V | 347-480V | | | |
| 05 | 4000K | 41 | N/A | 120-277V | 347-480V | | | |
| 06 | 4000K | 58 | N/A | 120-277V | 347-480V | | | |
| 07 | 65 | 67 | N/A | 120-277V | 347-480V | | | |
| 08 | 65 | 88 | N/A | 120-277V | 347-480V | | | |
| 09 | 65 | 90 | N/A | 120-277V | 347-480V | | | |

| No.: | Description: |
|------|-----------------------------|
| 1 | W/PLATE SITE PLAN SUBMITTAL |