

Advisory note: Please provide existing civil plans if no existing civil plans are available then a new civil plan set will be required

Please proceed with civil plan submission. The civil plan submission needs to be in process prior to approval of the site plan

Response: Civil plans have been approved (EDN 1983-6105-04)

PROPOSED LANDSCAPING TO BE REVISED PER SHEETS L1.1 - L1.3

ANDERSON'S CAJUN'S WHARF  
(Official Project Name)

Planned Building Group

Legal Description: WATERPARK SUBDIVISION FILING NO. 1  
LOT 4 BLOCK 1

All Special Plans registered and recorded hereunder shall be binding upon the applicants therefor, their successors and assigns, shall limit and control the issuance and validity of all building permits and shall restrict and limit the construction, location, use and operation of all land and structures included within such Plans to all conditions and limitations set forth in such Plans.

In witness thereof ANDERSON TURNMAR JOINT VENTURE has caused these presents to be executed this 21st day of FEBRUARY AD 1984

By: [Signature] (Principal or Owners)

Corporate Seal

NOTARIAL:  
State of Colorado ) ss  
County of )

The foregoing instrument was acknowledged before me this 22nd day of February AD 1984 by [Signature] (Principals or Owners)

Witness my hand and official seal [Signature]  
NOTARY PUBLIC [Signature]  
My commission expires 1-1-87

CITY OF AURORA APPROVALS:

City Attorney: [Signature] Date: [Signature]  
Planning Director: [Signature] Date: 4-11-84  
Planning Commission: [Signature] Date: [Signature]  
City Council: [Signature] Date: [Signature]  
Attest: [Signature] City Clerk Date: [Signature]

RECORDER'S CERTIFICATE:

Accepted for filing in the office of the Clerk and Recorder of [Signature] County, Colorado at [Signature] o'clock [Signature] M. This [Signature] Day of [Signature] AD 19 [Signature]

Clerk and Recorder: [Signature] Deputy: [Signature]

\*To be placed at the top of the document in large letters.

DATA:

Land area within property lines 2.33 Acres

Gross floor area (41-16 City Code) 20,115 Sq. Ft.

Total Building Coverage 20,115 19% % and Sq. Ft.

Hard-surface area (exclusive of buildings) 67,132 SF 68% % and Sq. Ft.

Area devoted to landscaping within site 12,093 SF 13% % and Sq. Ft.

Present zoning classification B-4

Proposed uses Restaurant

Sign Area 40 sq. ft. (free standing) 10 sq. ft. (wall) Sq. Ft.

Type of Sign (Free standing, Wall, etc.) Free Standing (2 Sides)

Number of stories 2

Maximum height of buildings 34

Loading spaces provided 3

Total parking spaces provided 97 (Balance of 821 parking spaces by other provisions)

Parking spaces required 916 (Balance of 821 parking spaces by other provisions)

(List information for parking calculations based on 41-668 of the City Code.)

NOTES:

All signs must conform to the City of Aurora sign code but in no case shall any free-standing sign exceed the specifications described herein.

Right of way for ingress and egress for service and emergency vehicles is granted over, across, on and through any and all private roads and ways now or hereafter established on the described property, and the same are hereby designated as fire lanes and emergency and service vehicle roads, and shall be posted "No Parking - Fire Lane."

The Developer, his successors and assigns, shall be responsible for installation, maintenance, and replacement of all landscaping materials shown or indicated on the approved Site Plan or Landscape Plan on file in the Planning Department.

(Applicant must indicate by note the method and material to be utilized in screening of roof-top mechanical units from view.)

Trash containers shall be constructed from the same materials as the building which they serve.

Parking lot lighting will be designed by a licensed electrical engineer using "cut-off" type luminaires on 25' poles. Fixtures will be placed so light will not extend onto residential or public row property.

The approval of this document does not constitute the final approval of grading, drainage, utilities and public improvements. Construction plans must be approved by the Director of Public Works prior to the issuance of building permits.

1. A crop parking agreement between Cajun's Wharf owners & Anderson, Turnmar Joint Venture provides balance of 821 required parking spaces
2. Open hours for Cajun's Wharf will be as follows:  
Monday - Friday 11:00 am - 11:00 pm  
Saturday 10:00 am - 11:00 pm  
Sunday 12:00 pm - 11:00 pm
- ADMINISTRATIVE AMENDMENT 11-30-84
1. ADD OUTDOOR DECK AT SOUTH ELEVATION
2. CHANGE SEATING TO 500
3. REVISED LANDSCAPING
- RELOCATE 1/2" MAT, 4" PLANK 6-15-87
- RELOCATE DUMPSTER ENCLOSURE ADM ADMT L1101

- MA 81983-6105-04:
- EXTENDING THE ASPHALT PARKING LOT, ADDITION OF DECK THAT WILL TIE INTO EXISTING DECK, ADDITION OF STAIRWAY TO PROPOSED DECK.
  - RECONSTRUCTING THE STAIR ENTRY TO THE EXISTING DECK, RECONSTRUCTING THE STAIR ENTRY AT THE SOUTHWEST CORNER OF THE BUILDING, MODIFICATIONS TO THE FRONT ENTRY, ADDING A CONCRETE WALKWAY AND STAIRS TO THE ENTRY AND ADDING AN OVERHANG, REMOVING 4 PARKING SPOTS AND REPLACING THE SIDEWALK, CURB, & GUTTER.
  - RECONSTRUCTING THE ADA LANDING, AND ADDING A PEDESTRIAN CURB RAMP, ADDING SIGNAGE TO BUILDING.
  - ADDITION OF WALL AROUND POND TO INCREASE CAPACITY TO ACCOUNT FOR THE ADDITIONAL IMPERVIOUS AREA.
  - REVISING LANDSCAPE PLAN.

WATERPARK

HAVANA & PARKER RD. AURORA, CO

A JOINT VENTURE

ANDERSON INVESTMENTS/TURNMAR DEVELOPMENT CO.

goff associates ltd.  
architects/planners

6868 so. revere parkway  
suite 290  
englewood, co 80112  
(303) 694-3006

JOB NUMBER  
DRAWN BY  
CHECKED BY  
DATE 11-22-83  
REVISIONS:

SHEET TITLE  
PBG SITE PLAN

SHEET NUMBER  
A1.1


4pm. AMPS: 11-30-84

1-17-92, 06-11-01

WATERPARK PBG AMP: (CAJUN'S WHARF) 83-6105-1

L/S



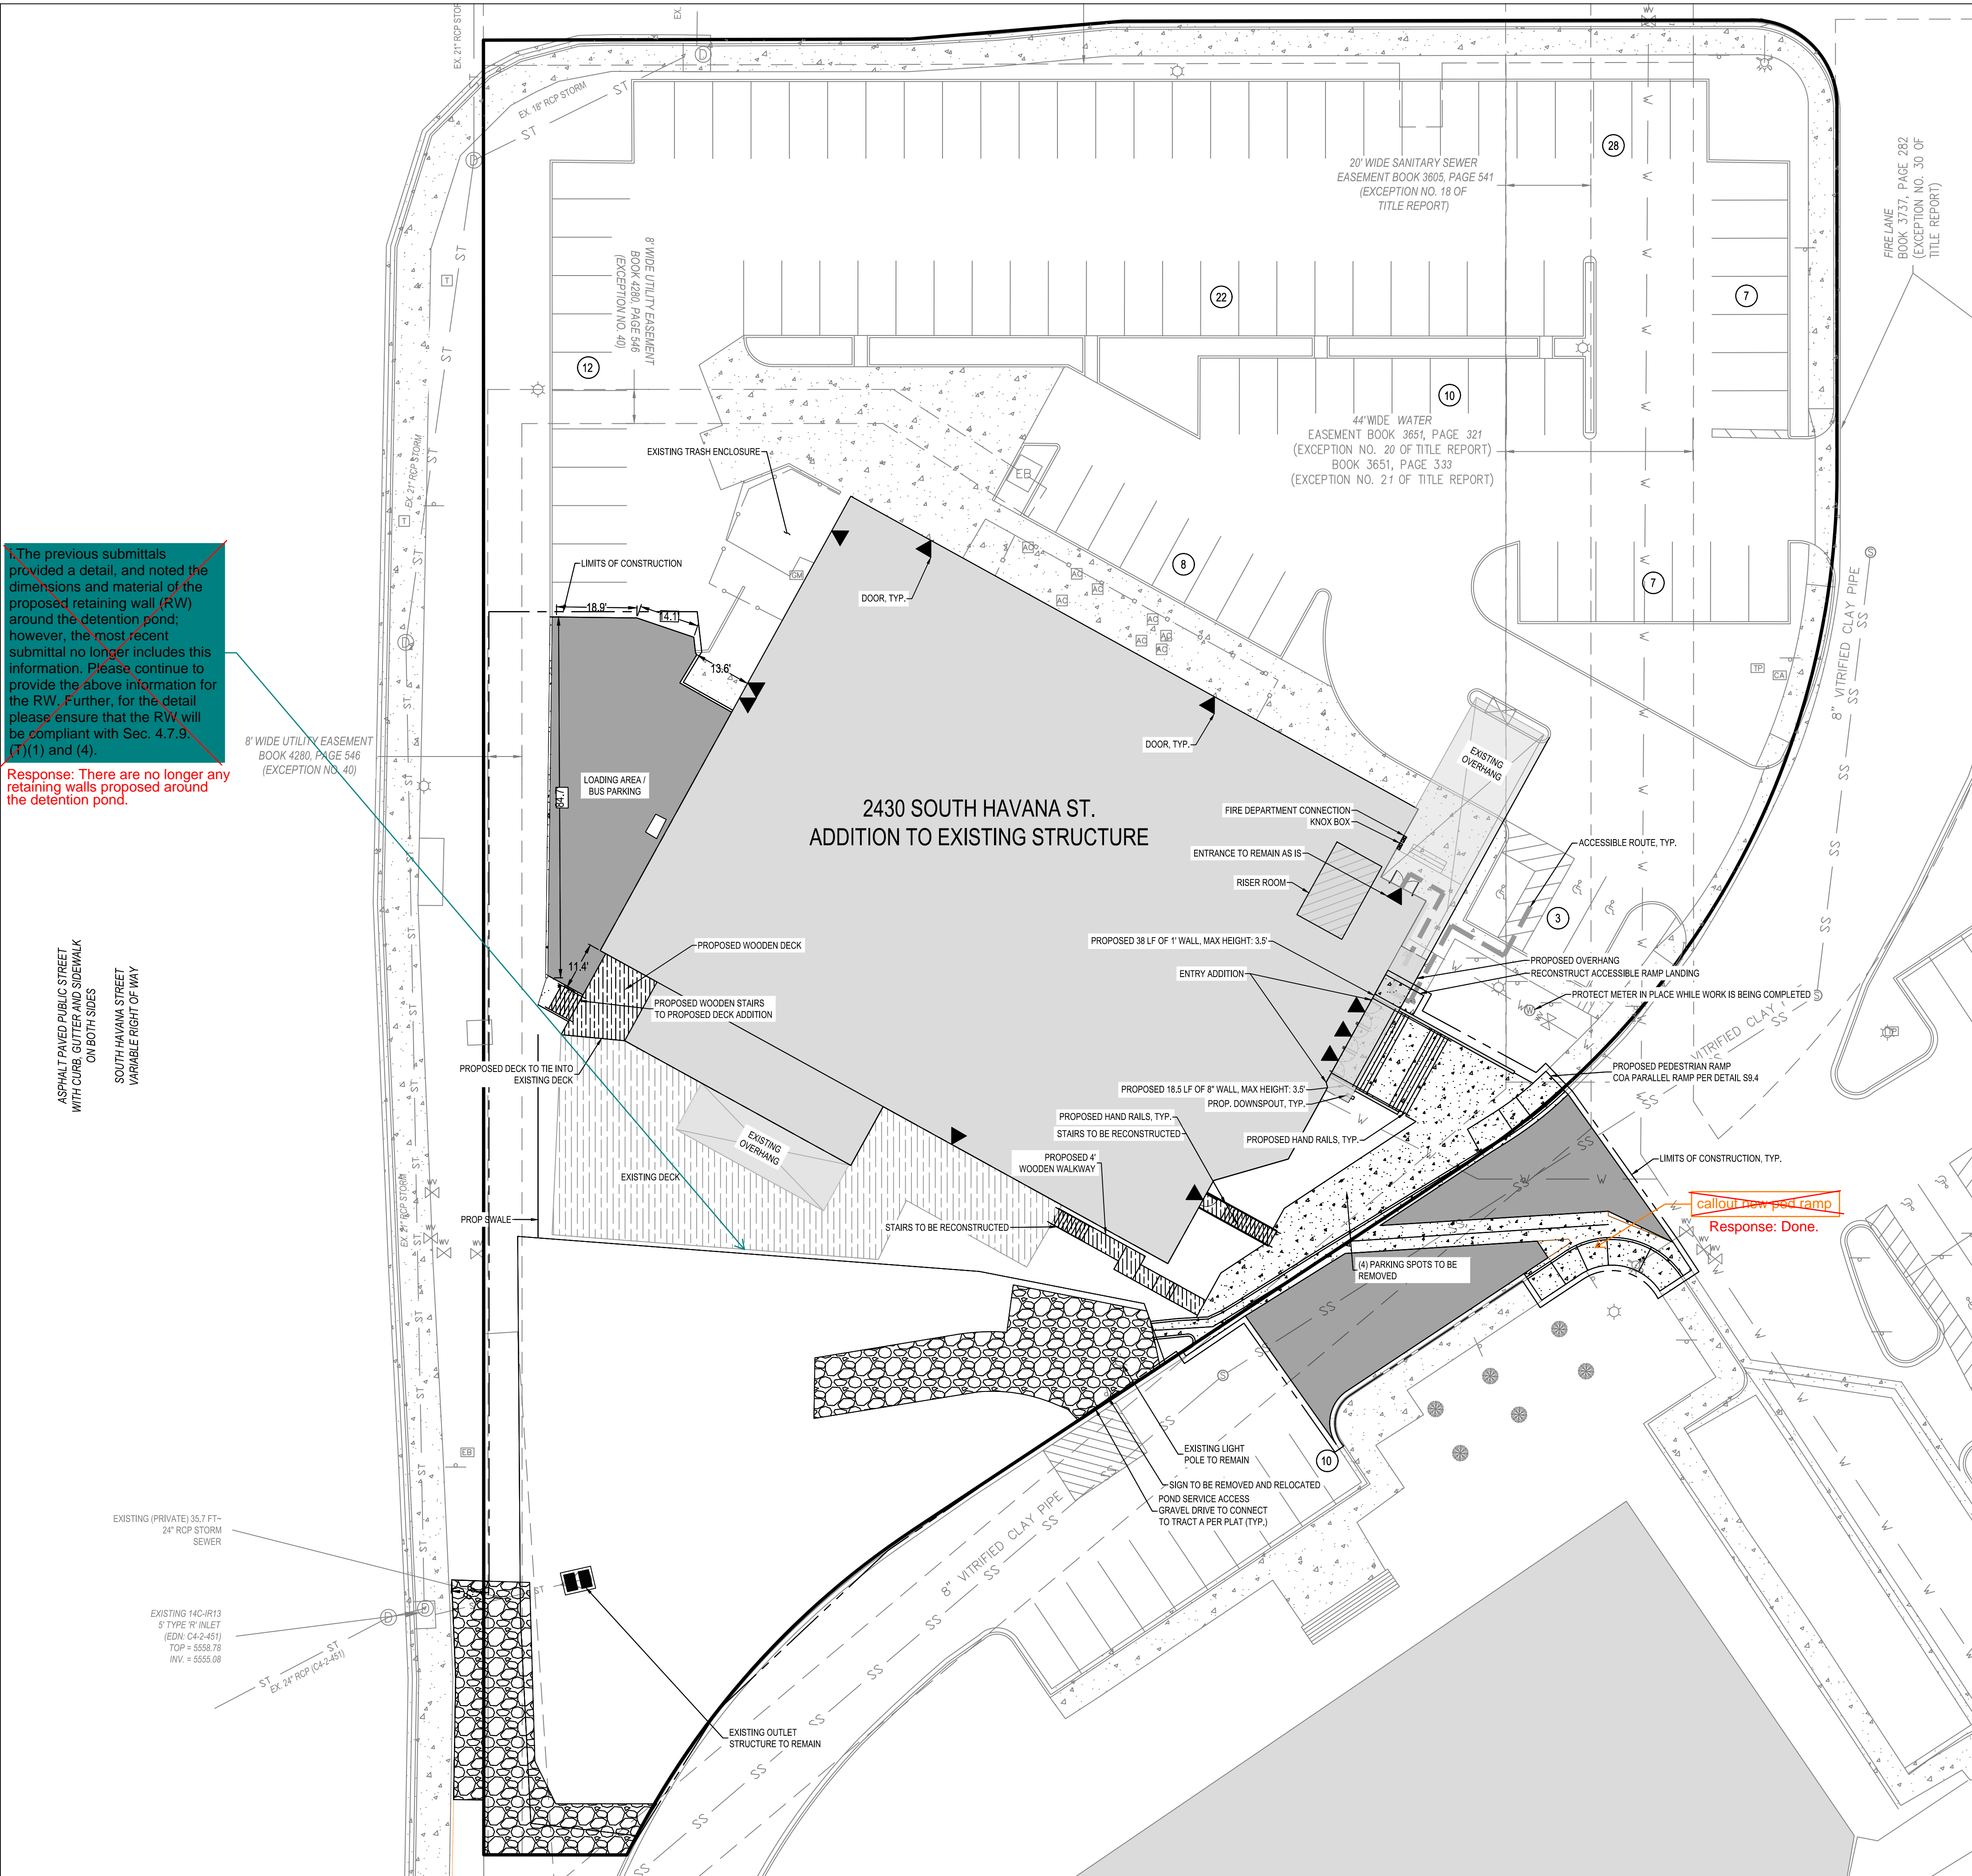

The previous submittals provided a detail, and noted the dimensions and material of the proposed retaining wall (RW) around the detention pond; however, the most recent submittal no longer includes this information. Please continue to provide the above information for the RW. Further, for the detail please ensure that the RW will be compliant with Sec. 4.7.9. (T)(1) and (4).

Response: There are no longer any retaining walls proposed around the detention pond.

- SURVEY CONTROL NOTES:**
1. FIELD WORK PERFORMED IN MAY, 2018 BY CHESSNOE AND ASSOCIATES.
  2. THIS SURVEY IS NOT A COMPLETE BOUNDARY SURVEY AND IS PREPARED AS A SURVEY CONTROL DRAWING ONLY
  3. **BASIS OF BEARINGS:** A PLAT BEARING OF N00°00'46"E BETWEEN TWO MONUMENTS 426.00 FEET APART BEING THE WEST LINE OF LOT 4, WATERPARK SUBDIVISION FILING NO. 2, ONE MONUMENT BEING A NO. 5 REBAR W/ 1.25" DIAMETER ORANGE CAP STAMPED P.E. & L.S. #9489 AT THE SOUTHWEST CORNER OF SAID LOT 4 AND THE OTHER BEING A 1.5" DIAMETER ALUMINUM CAP ILLEGIBLE AT THE NORTHWEST CORNER OF SAID LOT 4.
  4. ALL LINEAR MEASUREMENTS WERE TAKEN USING THE U.S. SURVEY FOOT.
  5. **BENCHMARK:** TOP OF A FOUND 1.5" DIAMETER ALUMINUM CAP, NO. ILLEGIBLE, AT THE NORTHWEST PROPERTY CORNER, ELEVATION = 5571.02, NAVD 88 DATUM.

**LEGAL NOTICE:**  
ACCORDING TO COLORADO LAW, YOU MUST COMMENCE ANY LEGAL ACTION BASED UPON ANY DEFECT IN THIS LAND SURVEY PLAT WITHIN THREE YEARS AFTER YOU FIRST DISCOVERED SUCH DEFECT IS DISCOVERED. IN NO EVENT MAY ANY LEGAL ACTION BASED UPON ANY DEFECT IN THIS LAND SURVEY PLAT BE COMMENCED MORE THAN TEN YEARS FROM THE DATE OF CERTIFICATION SHOWN HEREON.



ALTITUDE  
LAND CONSULTANTS  
CIVIL | SURVEY | PLANNING | LANDSCAPE  
3461 RINGSBY CT., SUITE #125  
DENVER, CO 80216  
720.594.9494  
INFO@ALTITUDELANDCO.COM  
WWW.ALTITUDELANDCO.COM

DATE: \_\_\_\_\_  
REVISIONS: \_\_\_\_\_

**WATERPARK SUBDIVISION FILING #2 MNOR  
SITE PLAN AMENDMENT**  
2430 S. HAVANA ST.  
AURORA, CO. 80014


DRAWN BY: DPT  
CHECKED BY: SCC  
DATE: 02-04-25  
ALC # 18-224  
CAD FILE: \_\_\_\_\_  
DIR: \_\_\_\_\_

MINOR SITE PLAN  
AMENDMENT

SITE PLAN  
**C1.0**  
SHEET 3 OF 14

**LEGEND:**

	PROPERTY LINE
	ADJACENT PROPERTY LINE
	LIMIT OF CONSTRUCTION
	LIMIT OF CONSTRUCTION
	PROPOSED CONCRETE
	EXISTING CONCRETE
	PROPOSED WOOD
	EXISTING WOOD
	PROPOSED ASPHALT



(IN FEET)  
1 inch = 20 ft.

For all new sheets, please continue adding delta 5 and red cloud around the sheet number to demonstrate that this sheet is being added via the current amendment.

Response: Clouds and delta 5's added to all new sheets.


callout new ped ramp  
Response: Done.





DRAWN BY: \_\_\_\_\_ DPT  
CHECKED BY: \_\_\_\_\_ SCC  
DATE: \_\_\_\_\_ 02-04-25  
ALC # \_\_\_\_\_ 18-224  
CAD FILE: \_\_\_\_\_  
DIR: \_\_\_\_\_


SHEET 4 OF 14

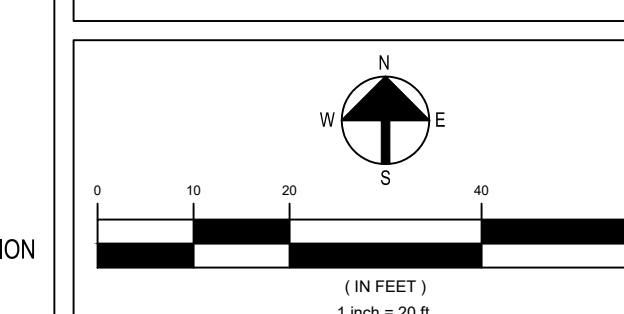




It appears that this is a duplicate page. Please only keep page 4 or 14.

Duplicate removed.

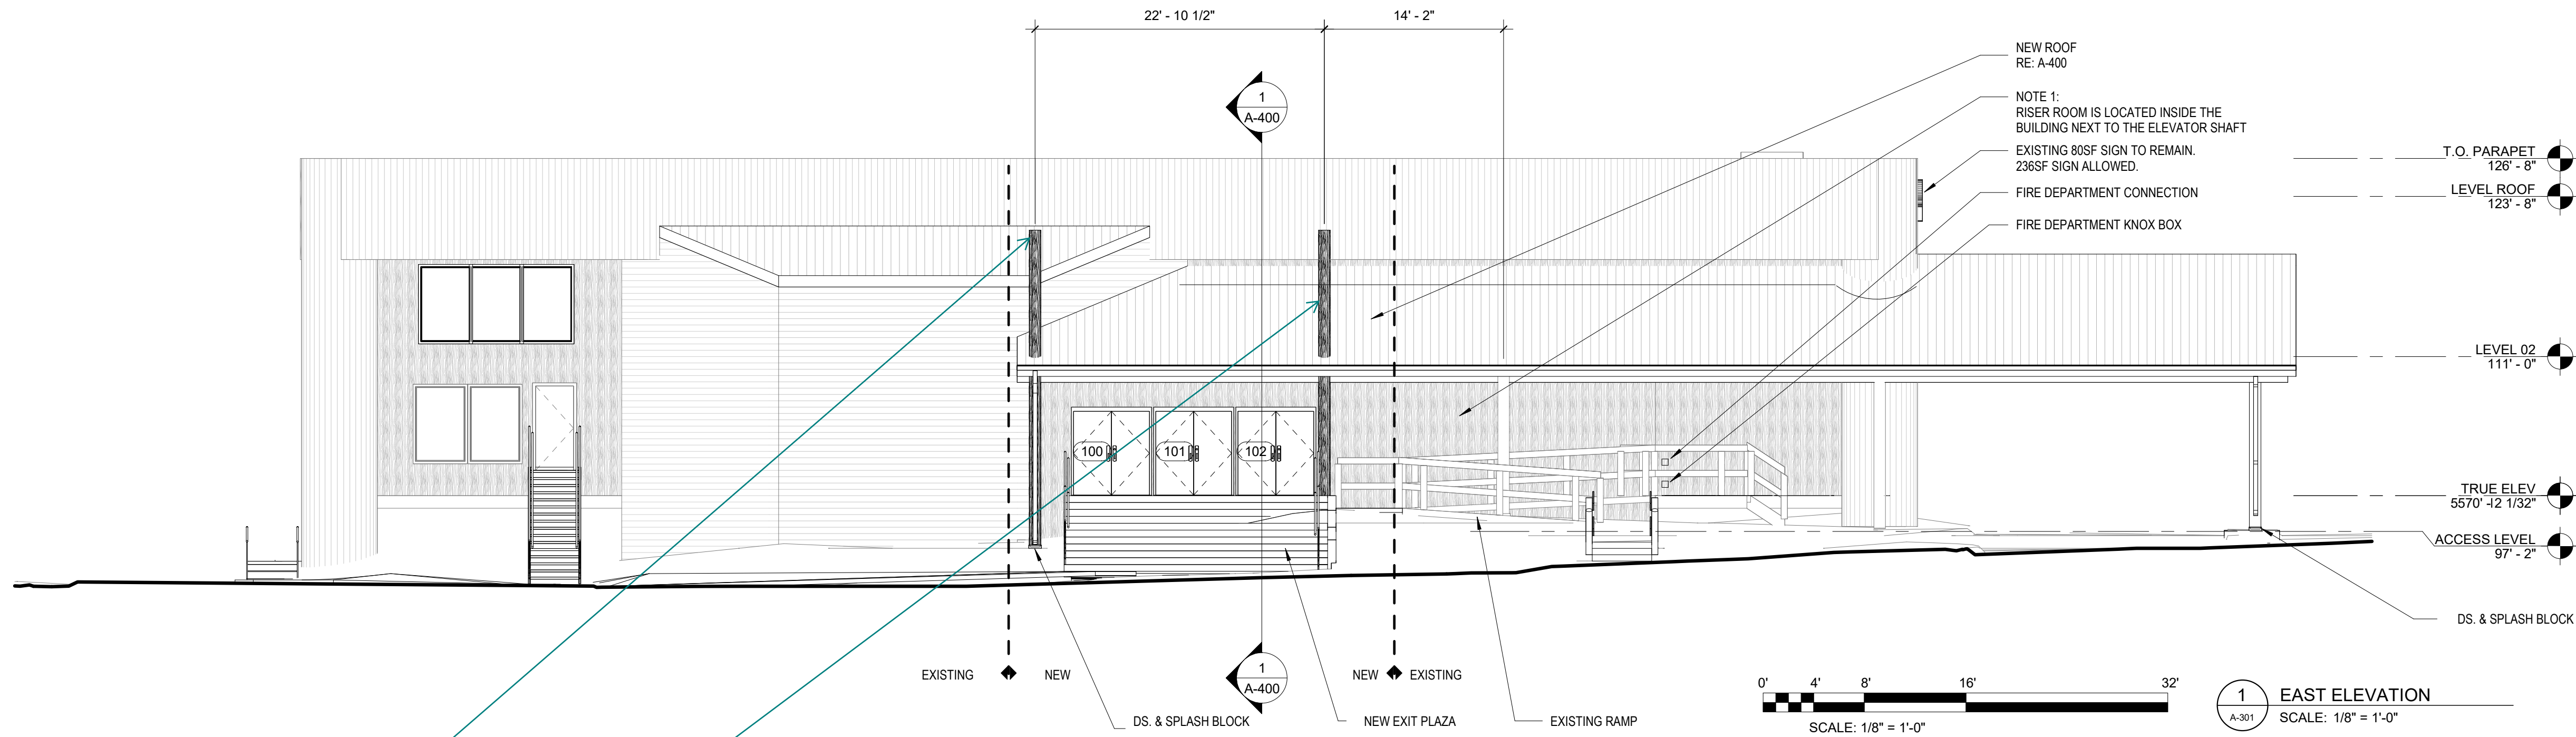

Will these posts remain or be removed as the sign is no longer being pursued?

Yes, posts will remain

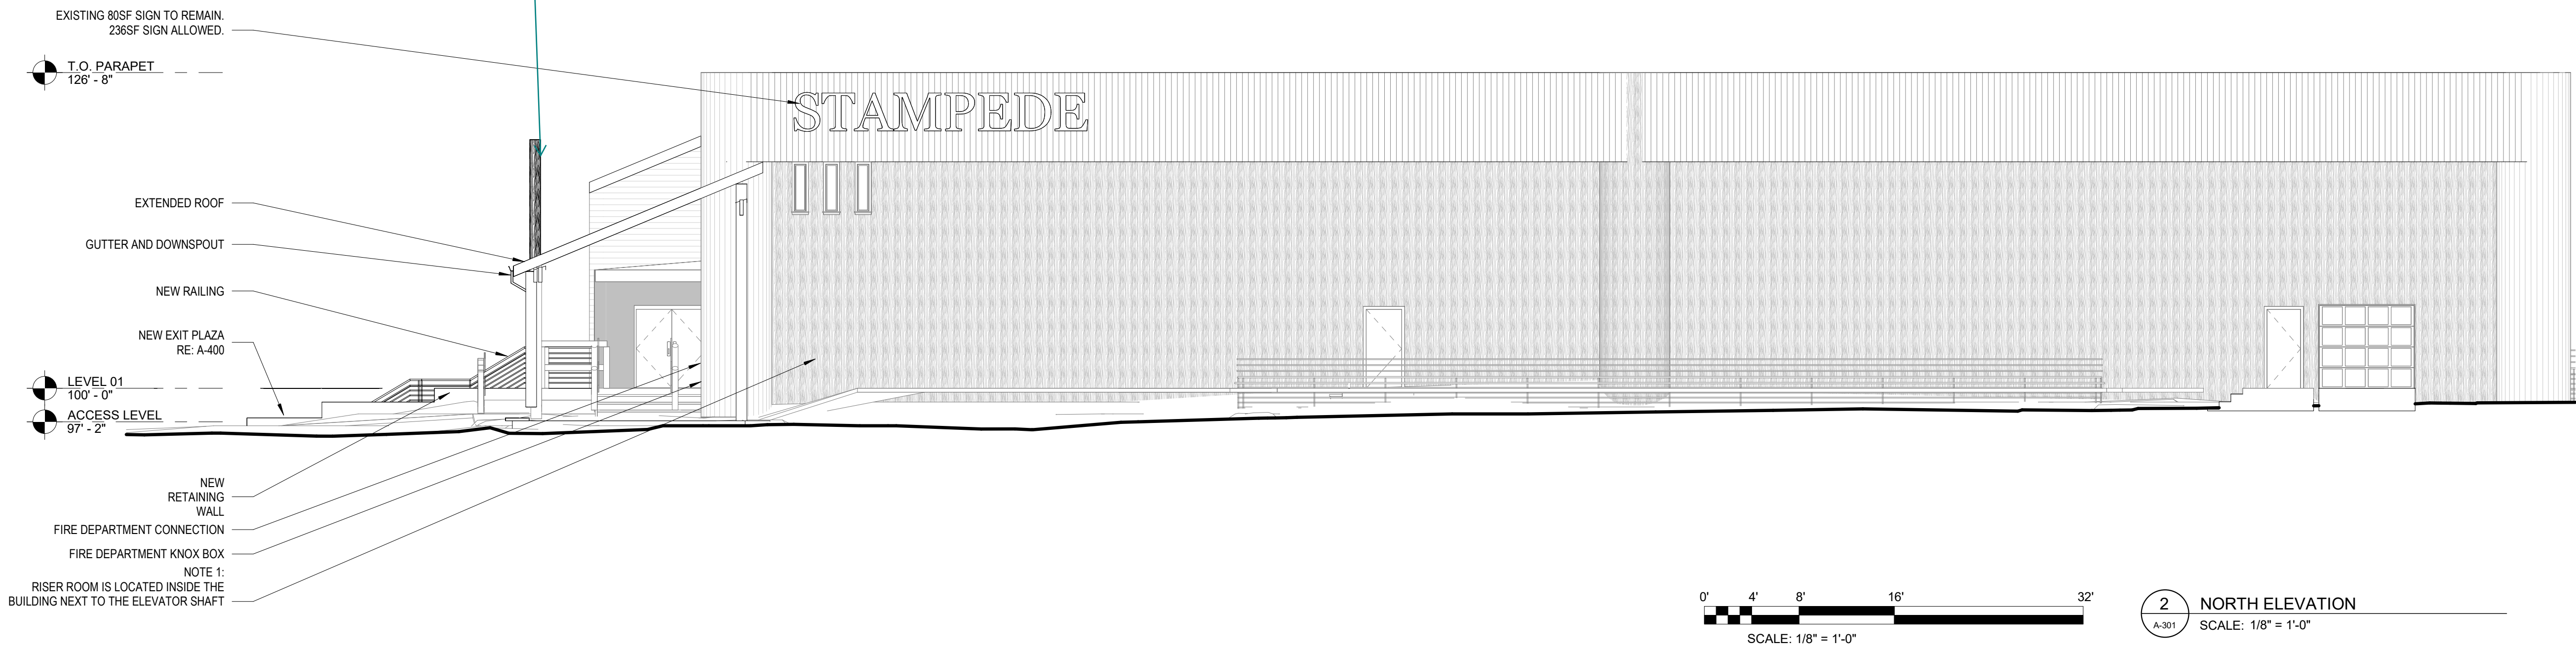

DATE:

REVISIONS:

STAMPEDE NEW EXIT DOORS, EXTERIOR PLAZA  
AMD CHANGE OF OCCUPANCY  
2430 S HAVANA ST.  
AURORA, CO. 80034


DRAWN BY: GL  
CHECKED BY: JE  
DATE: 04/04/24  
EG #  
CAD FILE:  
DIR:

PERMIT SET

EXTERIOR  
ELEVATIONS

A-301



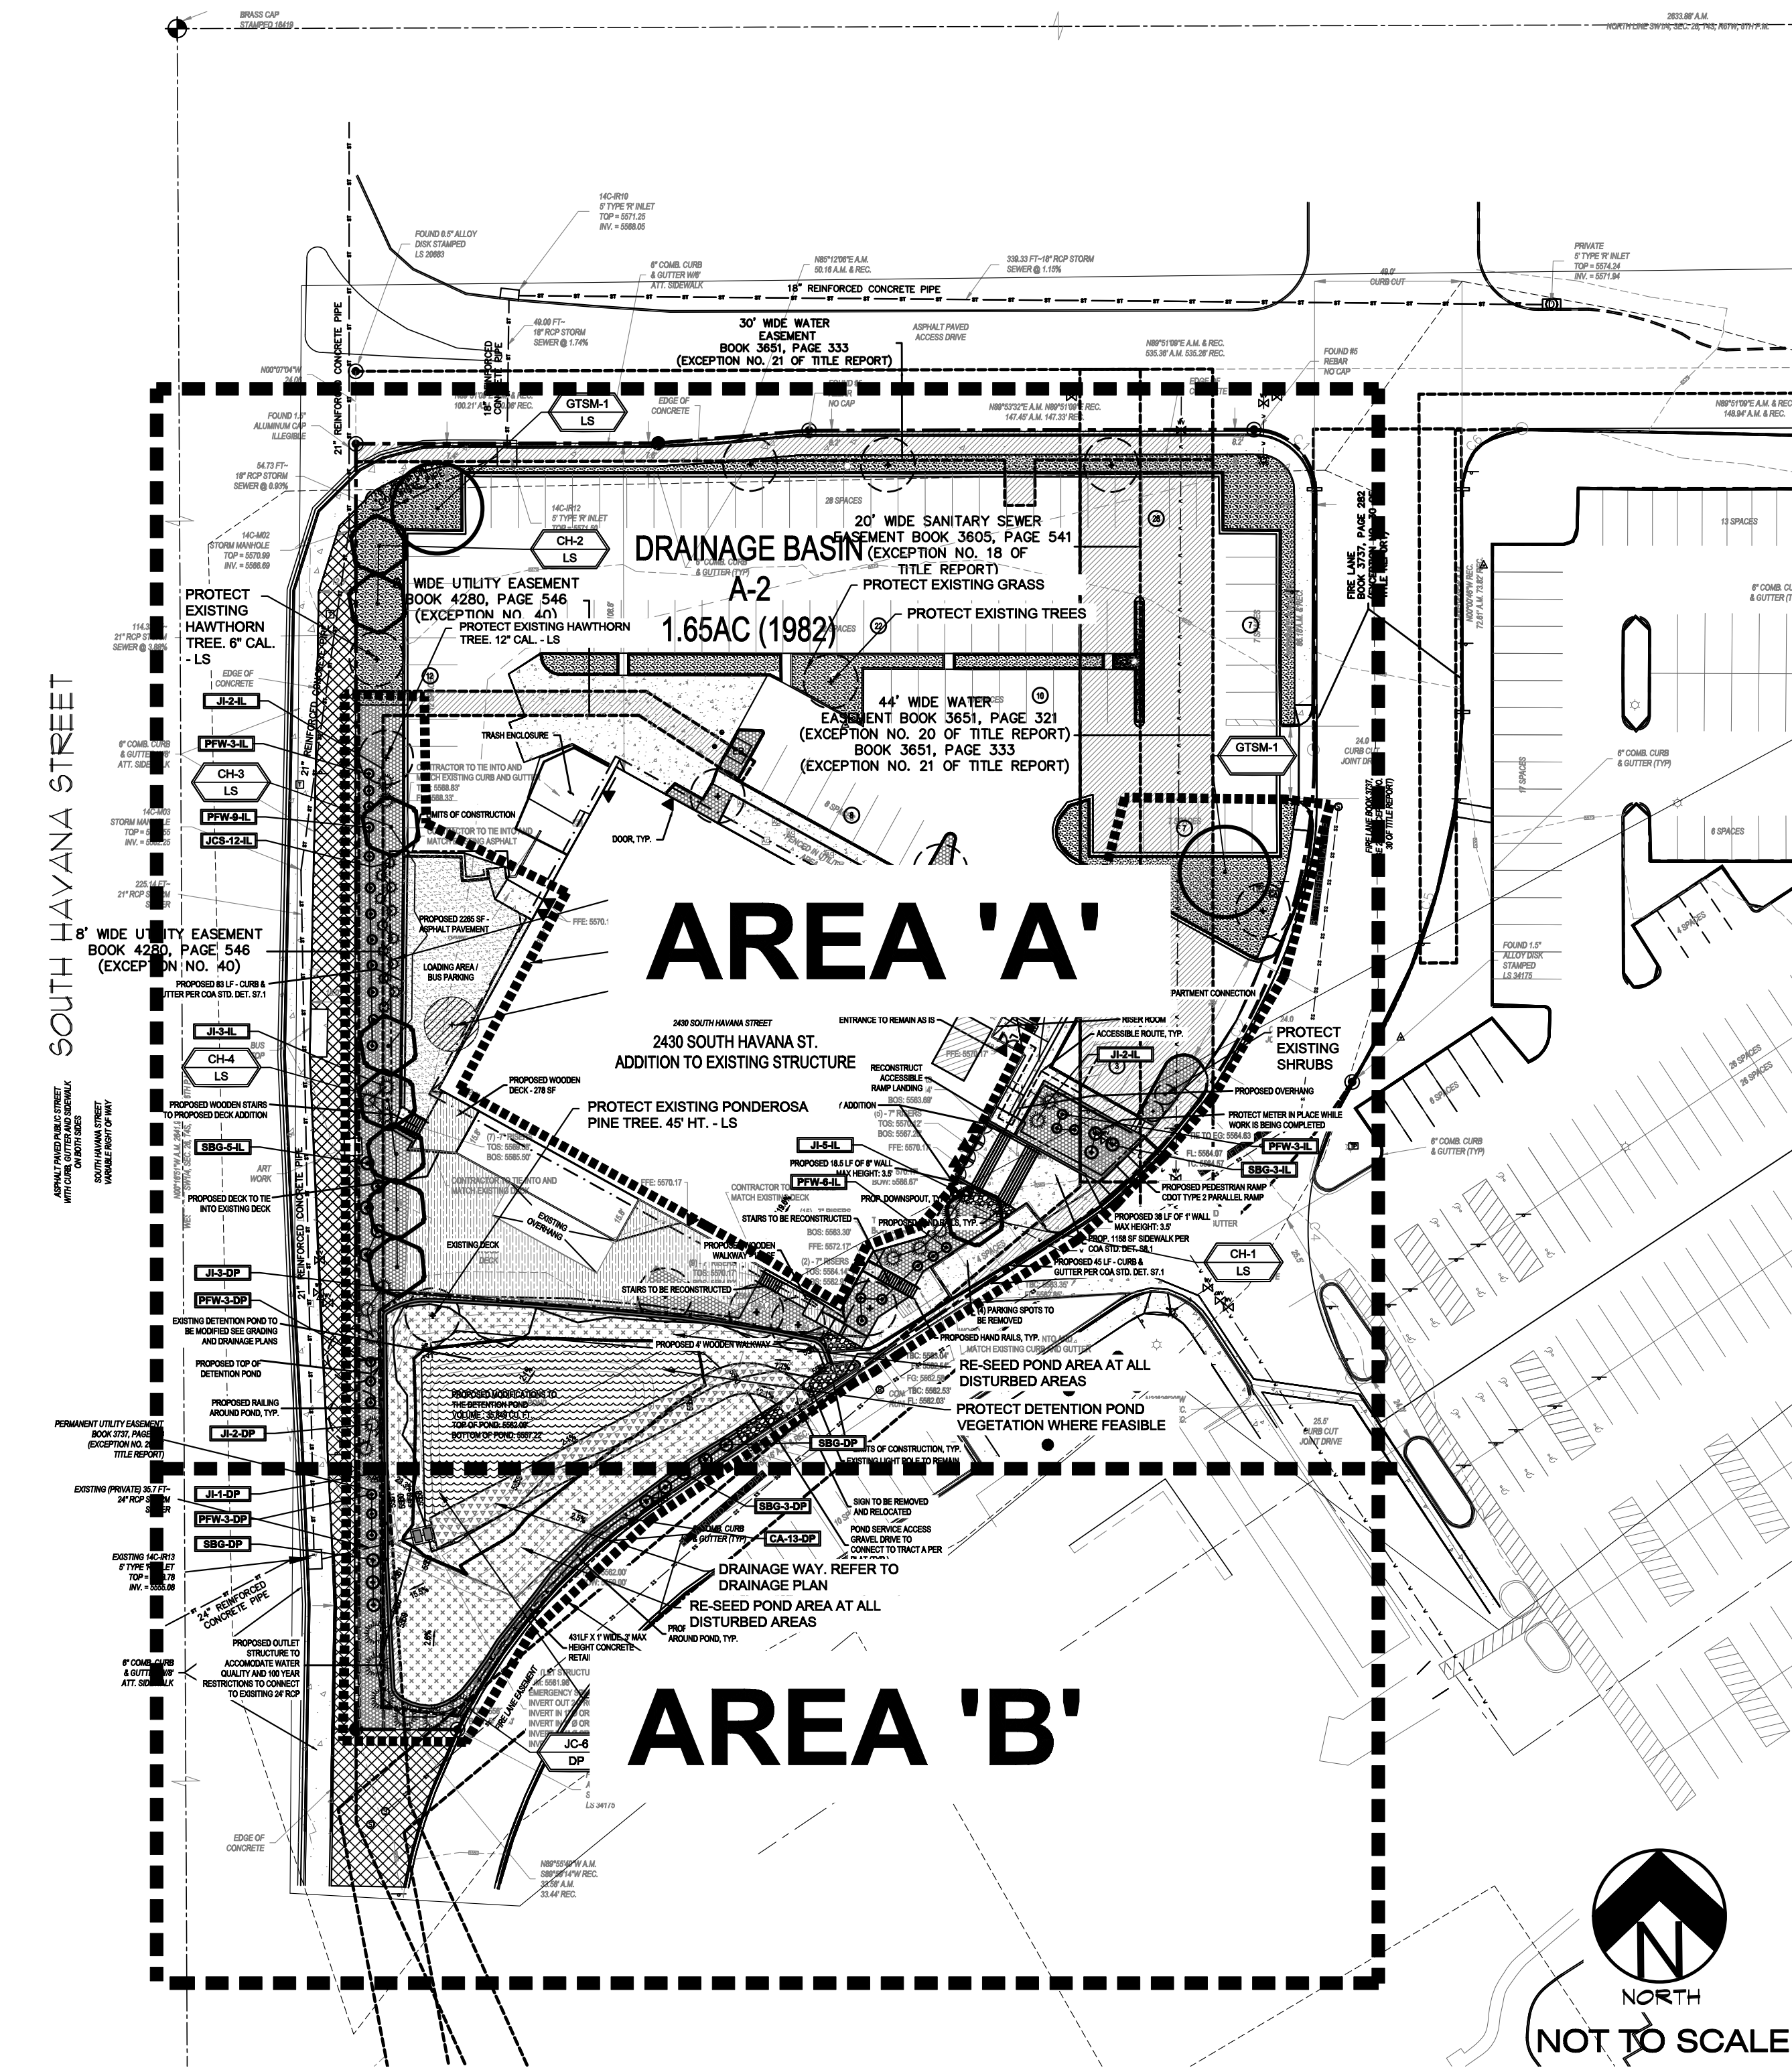

# OVERALL LANDSCAPE PLAN



Know what's below.  
Call before you dig.

## UTILITIES NOTE

VERIFY LOCATION AND DEPTH OF ALL UNDERGROUND UTILITIES PRIOR TO START OF WORK. CALL 811 FOR UTILITY LOCATES. TREE TRUNK PLACEMENT SHALL BE 6" MINIMUM DISTANCE FROM ANY GAS OR ELECTRIC AND 10' FROM GAS MAINS RATED AT 150PSI. FOR SANITARY SEWER AND WATER MAINLINES TREES SHALL NOT BE LOCATED WITHIN EASEMENTS AND WITHIN 15' OF ANY MAINLINE. ANY CONFLICT BETWEEN TREE LOCATIONS AND UTILITIES SHOWN ON PLANS SHALL BE RESOLVED WITH GENERAL CONTRACTOR PRIOR TO PLANTING. ALL ELECTRICAL VAULTS AND TRANSFORMERS SHALL BE KEPT CLEAR FROM PLANT MATERIAL PER LOCAL CODE. ALL SHRUBS TO BE LOCATED 3' CLEAR OF ALL FIRE HYDRANTS AT MATURE SIZE.

## LANDSCAPE CODE CHART

STREET TREES (LS)			
STREET NAME	LENGTH	TREE/FEET REQUIRED	NO. OF TREES REQ./PROVIDED
SOUTH HAVANA ST	421 LF	1/40 FT	11/1 (2 EXISTING)

DETENTION POND			
DETENTION POND PLANTINGS	AREA - SF	NO. OF TREES REQ./PROVIDED	NO. OF SHRUBS REQ./PROVIDED
1 TREE/10 SHRUBS PER 4,000 SQ FT ABOVE 100' FLOOD PLAIN ELEV.	5,915 SF	2/5	15/15

## GENERAL SITE NOTES

- CONTRACTOR RESPONSIBLE FOR COORDINATING AND INSTALLING ALL SLEEVING REQUIRED FOR LANDSCAPE AND IRRIGATION CONSTRUCTION. COORDINATE WITH GENERAL CONTRACTOR. ALL PLANTING AREAS SHALL RECEIVE SLEEVING. REFER TO PLANTING PLAN FOR ADDITIONAL INFORMATION.
- THE CONTRACTOR IS SPECIFICALLY CAUTIONED THAT THE LOCATION AND/OR ELEVATION OF EXISTING UTILITIES, AS SHOWN ON THESE PLANS, IS BASED ON RECORDS OF THE VARIOUS UTILITY COMPANIES AND, WHERE POSSIBLE, MEASUREMENTS TAKEN IN THE FIELD. THE INFORMATION IS NOT TO BE RELIED UPON AS BEING EXACT OR COMPLETE. THE CONTRACTOR MUST CALL THE LOCAL UTILITY LOCATION CENTER AT LEAST 48 HOURS BEFORE ANY EXCAVATION TO REQUEST EXACT FIELD LOCATIONS OF THE UTILITIES. PRIOR TO CONSTRUCTION, THE CONTRACTOR SHALL VERIFY PERTINENT LOCATIONS AND ELEVATIONS, ESPECIALLY AT CONNECTION POINTS AND AT POTENTIAL UTILITY CONFLICTS. IT SHALL BE THE RESPONSIBILITY OF THE CONTRACTOR TO RELOCATE ALL EXISTING UTILITIES THAT CONFLICT WITH THE PROPOSED IMPROVEMENTS SHOWN ON THESE PLANS.
- THE CONTRACTOR SHALL BE RESPONSIBLE FOR OBTAINING ALL NECESSARY PERMITS FOR ALL APPLICABLE AGENCIES.
- ALL MATERIALS, WORKMANSHIP, AND CONSTRUCTION OF PUBLIC IMPROVEMENTS SHALL MEET OR EXCEED THE STANDARDS AND SPECIFICATIONS SET FORTH IN LOCAL CITY STANDARDS AND SPECIFICATIONS AND APPLICABLE STATE AND FEDERAL REGULATIONS. WHERE THERE IS CONFLICT BETWEEN THESE PLANS AND THE SPECIFICATIONS, OR ANY APPLICABLE STANDARDS, THE HIGHER QUALITY STANDARD SHALL APPLY. ALL WORK SHALL BE INSPECTED AND APPROVED BY THE APPROPRIATE GOVERNING AGENCIES.
- THE CONTRACTOR SHALL HAVE ONE (1) SIGNED COPY OF THE APPROVED CONSTRUCTION DOCUMENTS, ONE (1) COPY OF THE APPROPRIATE STANDARDS AND SPECIFICATIONS, AND A COPY OF ANY PERMITS AND EXTENSION AGREEMENTS NEEDED FOR THE JOB, ON-SITE AT ALL TIMES.
- ALL REFERENCES TO ANY PUBLISHED STANDARDS SHALL REFER TO THE LATEST REVISION OF SAID STANDARD, UNLESS SPECIFICALLY STATED OTHERWISE.
- THE CONTRACTOR SHALL BE RESPONSIBLE FOR KEEPING ROADWAYS FREE AND CLEAR OF ALL CONSTRUCTION DEBRIS TRACKED FROM THE SITE.
- THE CONTRACTOR SHALL PROTECT ALL SITE ELEMENTS DURING CONSTRUCTION INCLUDING, BUT NOT LIMITED TO: CONCRETE PLATWORK, CURBS & GUTTER, PAVING, SIGNS, TREES, UTILITIES, ETC. ANY DAMAGE TO INFRASTRUCTURE SHALL BE RESPONSIBILITY OF CONTRACTOR TO REPAIR AND/OR REPLACE IN EQUAL OR BETTER CONDITION. ANY DAMAGE SHALL BE DOCUMENTED THE DAY IT OCCURS AND REPORTED TO THE CLIENT WITHIN 12 HOURS. COORDINATE WITH GENERAL CONTRACTOR.
- CONTRACTOR IS RESPONSIBLE FOR SUBMITTING LANDSCAPE AND IRRIGATION SUBMITTALS FOR APPROVAL PRIOR TO START OF ANY WORK.

## IRRIGATION SYSTEM NOTE

AN IRRIGATION SYSTEM WITH SURFACE DRIP COMPONENTS WILL BE USED TO IRRIGATE ALL PROPOSED AND EXISTING PLANT MATERIAL. INSTALL ALL IRRIGATION COMPONENTS PER MANUFACTURE RECOMMENDATIONS. CONNECT TO EXISTING SYSTEM. VERIFY CONDITION OF EXISTING IRRIGATION SYSTEM PRIOR TO ANY WORK. IRRIGATION SYSTEM SHALL BE INSTALLED PER LOCAL CODES.

## GENERAL LANDSCAPE NOTES

ALL UTILITY EASEMENTS SHALL REMAIN UNOBSTRUCTED AND FULLY ACCESSIBLE ALONG THEIR ENTIRE LENGTH FOR MAINTENANCE EQUIPMENT ENTRY.

THE DEVELOPER, HIS SUCCESSORS AND ASSIGNS, SHALL BE RESPONSIBLE FOR INSTALLATION, MAINTENANCE AND REPLACEMENT OF ALL LANDSCAPING MATERIALS SHOWN OR INDICATED ON THE APPROVED SITE PLAN OR LANDSCAPE PLAN ON FILE IN THE PLANNING DEPARTMENT. ALL LANDSCAPING WILL BE INSTALLED AS DELINEATED ON THE PLAN, UPON COMPLETION OF ALL SITE IMPROVEMENTS.

ALL LANDSCAPED AREAS AND PLANT MATERIAL EXCEPT FOR NON-IRRIGATED NATIVE, RESTORATIVE, AND DRYLAND GRASS AREAS MUST BE WATERED BY AN AUTOMATIC UNDERGROUND IRRIGATION SYSTEM. IRRIGATION SYSTEM DESIGN, INSTALLATION, OPERATION, AND MAINTENANCE SHALL CONFORM TO THE REQUIREMENTS FOUND IN THE CITY OF AURORA IRRIGATION ORDINANCE.

LANDSCAPE AREA  
TOTAL SITE: 99,340 SF  
LANDSCAPE AREA (15%) REQUIRED/PROVIDED: 14,901 SF / 25,934 SF

## FIRE LIFE SAFETY NOTE

- LANDSCAPE MATERIAL PLACEMENT SHALL NOT BE PLACED OR KEPT NEAR FIRE HYDRANTS, FIRE DEPARTMENT INLET CONNECTIONS OR FIRE PROTECTION CONTROL VALVES IN A MANNER THAT WOULD PREVENT SUCH EQUIPMENT OR FIRE HYDRANTS FROM BEING IMMEDIATELY DISCERNABLE. THE FIRE DEPT. SHALL NOT BE DETERRED OR HINDERED FROM GAINING IMMEDIATE ACCESS TO FIRE PROTECTION EQUIPMENT OR HYDRANTS.
- A 5-FOOT CLEAR SPACE SHALL BE MAINTAINED AROUND THE CIRCUMFERENCE OF FIRE HYDRANTS.
- LANDSCAPE MATERIAL SHOWN WITHIN THE SITE PLAN CANNOT ENCRATCH INTO ROADWAYS THAT ARE DEDICATED OR DESIGNATED AS FIRE LANE EASEMENTS OR CORRIDORS.

## TREE PROTECTION NOTE

ALL TREES SHOWN AS "TO BE PROTECTED" SHALL BE PRESERVED ACCORDING TO THE TREE PROTECTION STANDARDS PER THE CURRENT PARKS, RECREATION AND OPEN SPACE DEDICATION AND DEVELOPMENT CRITERIA MANUAL.

## DOCUMENT DISCLAIMER NOTE

IRRESPECTIVE OF ANY OTHER TERM IN THIS DOCUMENT, LANDSCAPE ARCHITECT SHALL NOT CONTROL OR BE RESPONSIBLE FOR CONSTRUCTION MEANS, METHODS, TECHNIQUES, SCHEDULES, SEQUENCES OR PROCEDURES, OR FOR CONSTRUCTION SAFETY OR ANY OTHER RELATED PROGRAMS, OR FOR ANY OTHER PARTIES' ERRORS OR OMISSIONS OR FOR ANY OTHER PARTIES' FAILURE TO COMPLETE THEIR WORK OR SERVICES IN ACCORDANCE WITH LANDSCAPE ARCHITECTS' DOCUMENTS.

HIGHER GROUND DESIGNS, INC.

LANDSCAPE ARCHITECTURE, PLANNING & IRRIGATION DESIGN

5350 NORTH ACADEMY BLVD. STE 207  
COLORADO SPRINGS, CO 80918  
Phone 719-477-1646  
Fax 719-506-1122



WATERPARK SUBDIVISION  
2430 SOUTH HAVANA STREET  
AURORA, CO 80011

THESE DRAWINGS ARE THE PROPERTY OF HIGHER GROUND DESIGNS, INC. AND SHALL NOT BE USED FOR ANY OTHER PURPOSE WITHOUT WRITTEN AUTHORIZATION BY HIGHER GROUND DESIGNS, INC. THESE DRAWINGS ARE NOT FOR CONSTRUCTION.

PREPARED FOR:

For City Approval Only

NOT FOR CONSTRUCTION

JOB NUMBER  
1133-23

REVISIONS	
10-16-23	PER CITY COMMENTS
4-8-24	PER CITY COMMENTS
5-22-24	PER CITY COMMENTS

ORIGINAL DATE  
5-1-23


DRAWN BY: JM

DESCRIPTION:  
OVERALL  
LANDSCAPE PLAN


SHEET NO.

L1.1



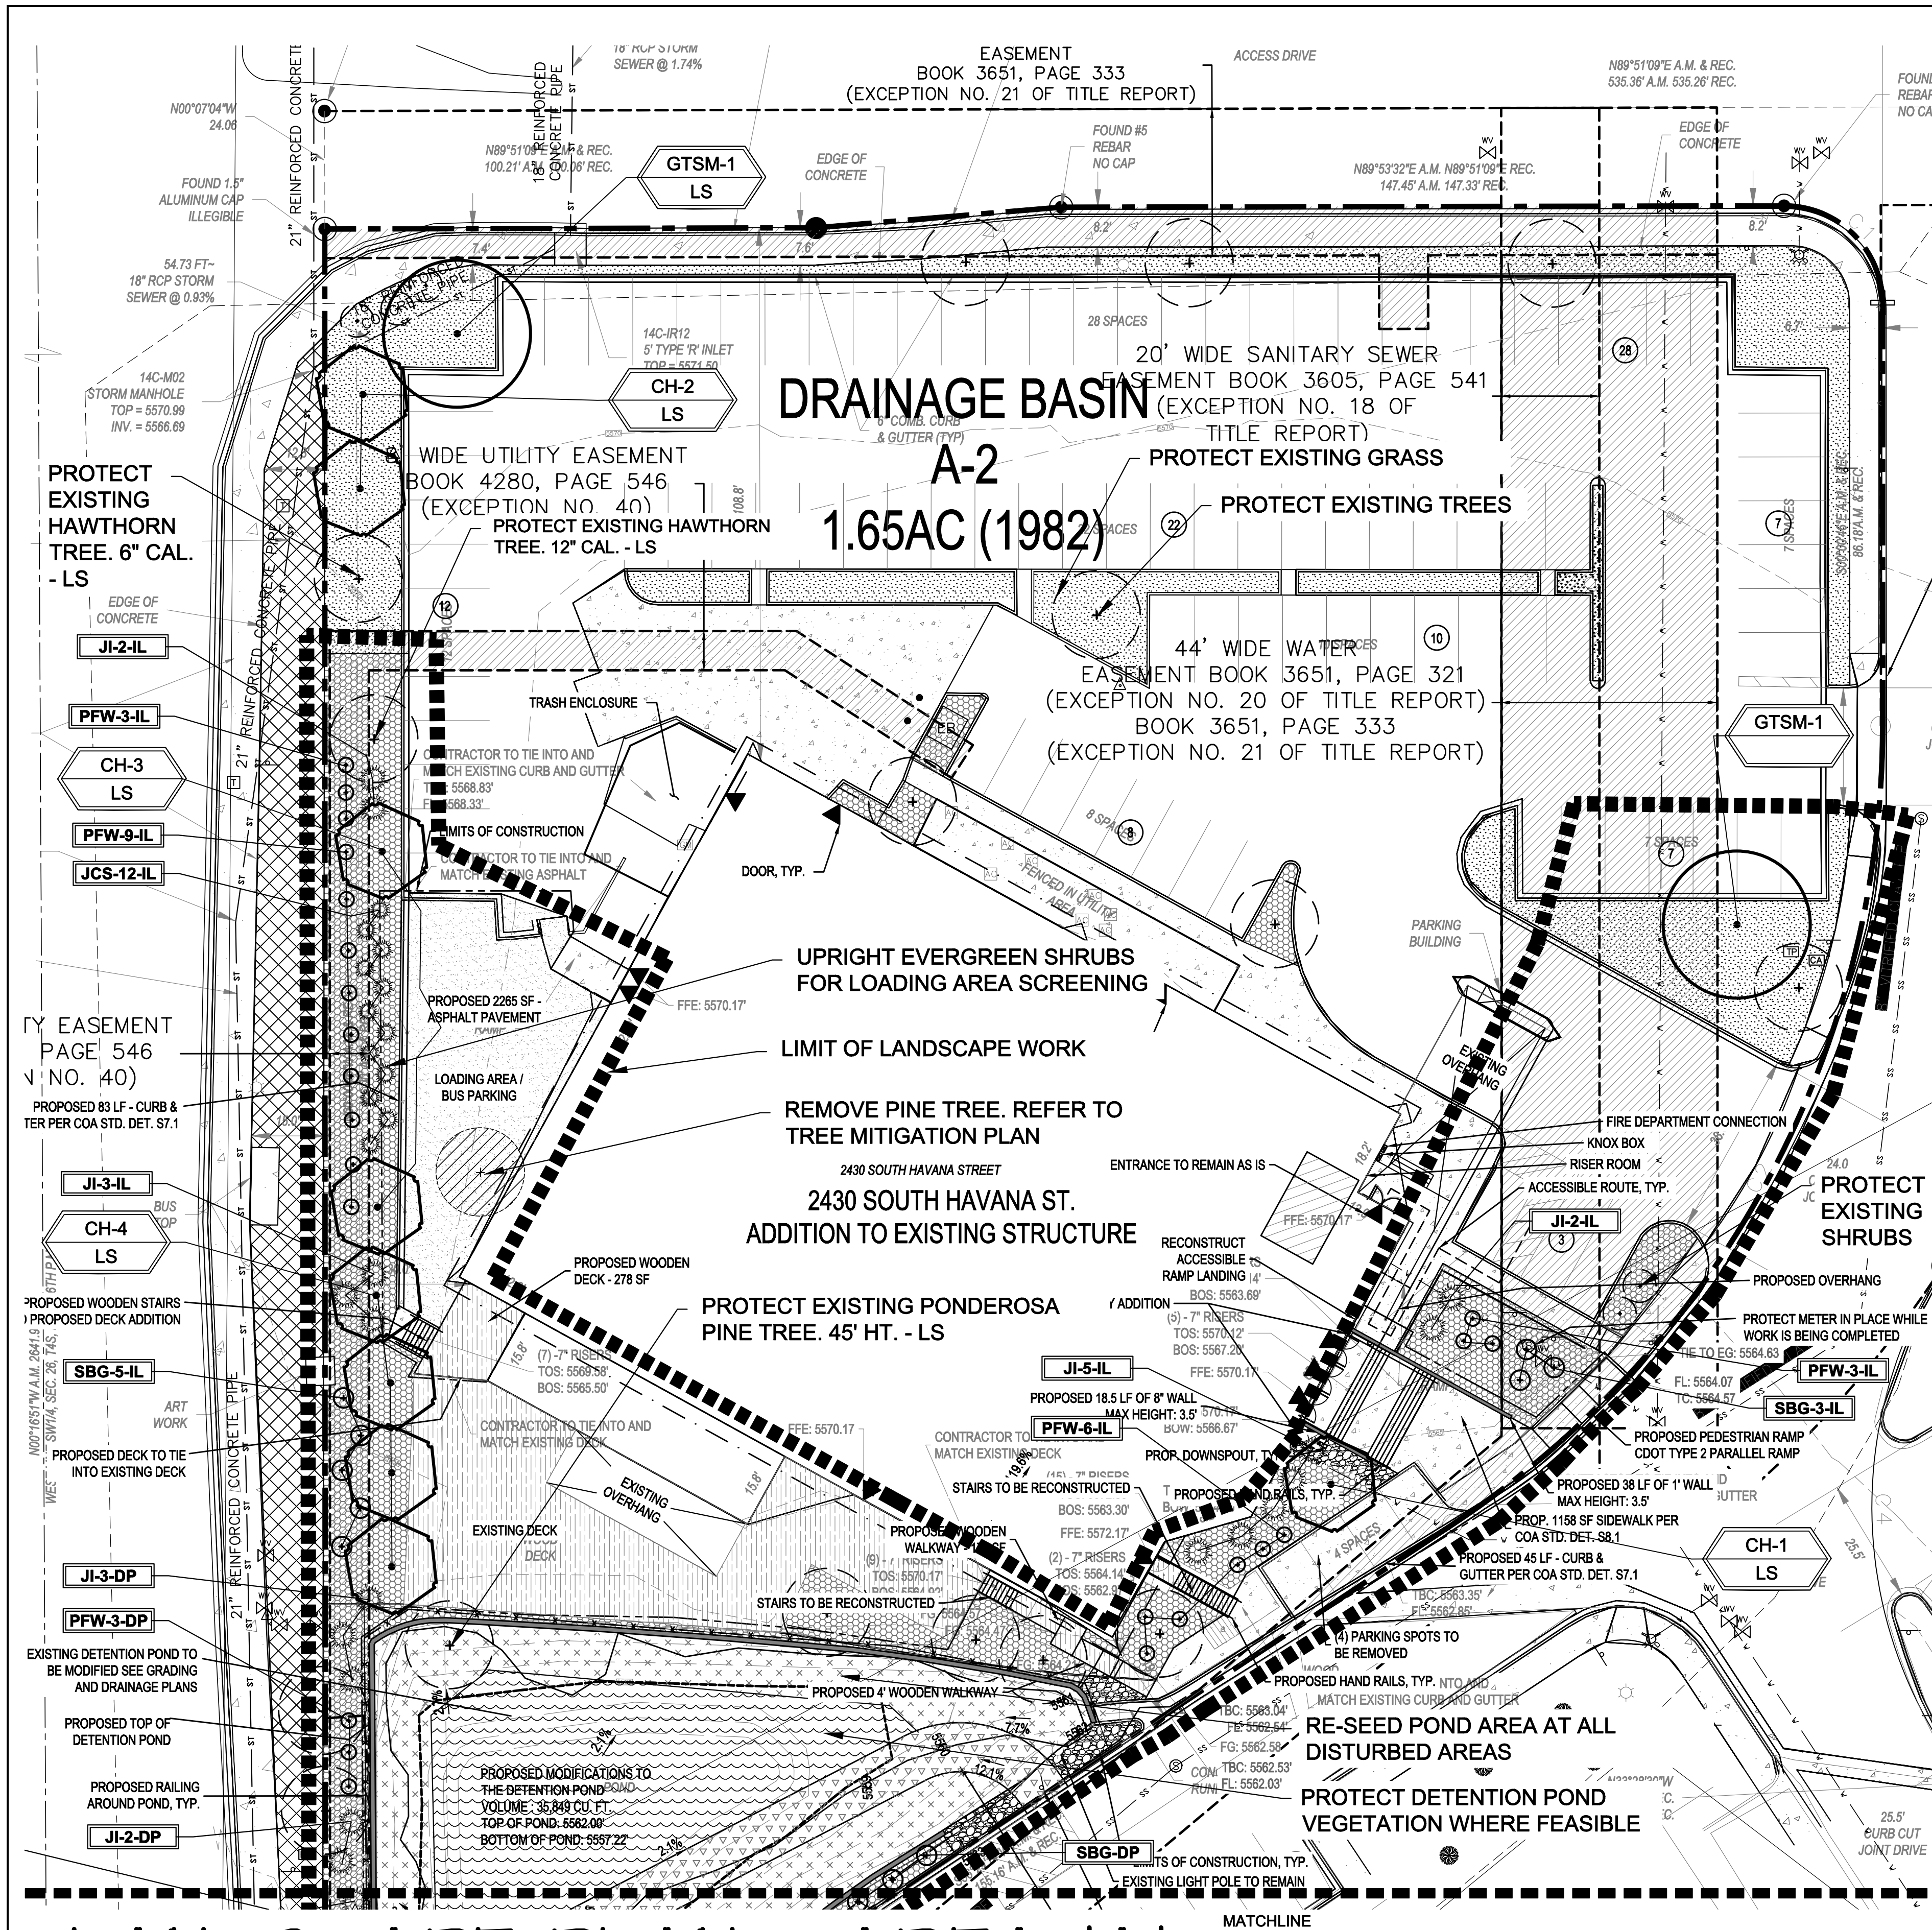

# LANDSCAPE PLAN - AREA 'A'

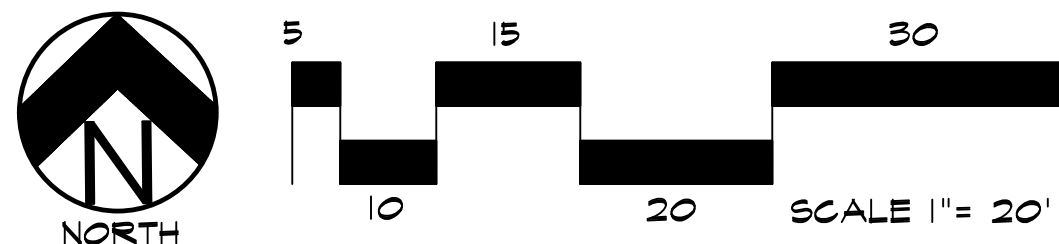

## UTILITIES NOTE

VERIFY LOCATION AND DEPTH OF ALL UNDERGROUND UTILITIES PRIOR TO START OF WORK. CALL 811 FOR UTILITY LOCATES. TREE TRUNK PLACEMENT SHALL BE 6" MINIMUM DISTANCE FROM ANY GAS OR ELECTRIC AND 10' FROM GAS MAINS RATED AT 150PSI. FOR SANITARY SEWER AND WATER MAINLINES TREES SHALL NOT BE LOCATED WITHIN EASEMENTS AND WITHIN 15' OF ANY MAINLINE. ANY CONFLICT BETWEEN TREE LOCATIONS AND UTILITIES SHOWN ON PLANS SHALL BE RESOLVED WITH GENERAL CONTRACTOR PRIOR TO PLANTING. ALL ELECTRICAL VAULTS AND TRANSFORMERS SHALL BE KEPT CLEAR FROM PLANT MATERIAL PER LOCAL CODE. ALL SHRUBS TO BE LOCATED 3' CLEAR OF ALL FIRE HYDRANTS AT MATURE SIZE.

## DOCUMENT DISCLAIMER NOTE

IRRESPECTIVE OF ANY OTHER TERM IN THIS DOCUMENT, LANDSCAPE ARCHITECT SHALL NOT CONTROL OR BE RESPONSIBLE FOR CONSTRUCTION MEANS, METHODS, TECHNIQUES, SCHEDULES, SEQUENCES OR PROCEDURES, OR FOR CONSTRUCTION SAFETY OR ANY OTHER RELATED PROGRAMS, OR FOR ANOTHER PARTIES' ERRORS OR OMISSIONS OR FOR ANOTHER PARTIES' FAILURE TO COMPLETE THEIR WORK OR SERVICES IN ACCORDANCE WITH LANDSCAPE ARCHITECTS' DOCUMENTS.

## PLANT LEGEND

Symbol	Abbr.	Quant.	Common Name	Botanical Name	Size	Descrip.
<b>DECIDUOUS TREES:</b>						
	GTSM	2	Gleditsia triacanthos 'Shademaster'	Shademaster Honeylocust	30'X30'	2"cal.
	CH	9	Cockspur Hawthorn	Crataegus crus-galli inermis	20'X 20'	2"cal.
<b>EVERGREEN SHRUBS:</b>						
	JC	6	Juniperus scopulorum 'Cologreen'	Cologreen Juniper	8' x 12-15'	5 gal.
	JCS	12	Juniperus sabiniana 'Spartan'	Buffalo Juniper	6-8' x 12-18'	5 gal.
	JCS	12	Juniperus x chinensis 'Spartan'	Spartan Juniper	3-4' x 12-15'	5 gal.
<b>DECIDUOUS SHRUBS AND ORNAMENTAL GRASSES:</b>						
	SBG	16	Spiraea x bumalda 'Goldflame'	Goldflame Spirea	3-4' x 2-3'	5 gal.
	PFW	27	Potentilla fruticosa 'McKay's White'	McKay's White	2-3' x 2-3'	5 gal.
	CA	13	Calamagrostis acutiflora 'Karl Foerster'	Feather Reed Grass	1-3' x 2-3'	1 gal.

QUANTITIES SHOWN IN LEGEND ARE FOR CONVENIENCE ONLY. CONTRACTOR IS RESPONSIBLE FOR INSTALLING ALL MATERIALS PER PLAN.

## GROUND COVER LEGEND

SYMBOL	DESCRIPTION	APPROX. SF
	Rock to Match Existing: 1.5" Diameter (with weed barrier) Submit spec to owner prior to ordering material	8,041 SF
	Rock Cobble: 2-4" Dia. Blue Gray River Submit spec to owner prior to ordering material	320 SF
	Irrigated Seed Grass. Seed Mix 'A'. Refer to notes. Submit spec to owner prior to ordering material	6,210 SF
	Drainage Way: Refer to grading plan	1,380 SF
	Protect Existing Grass and Irrigation System	6,075 SF
	Protect Existing Grass	3,334 SF
	OFF SITE: Protect Existing Grass and Irrigation System	
	Protect Existing Tree	
	Protect Existing Shrub	
	Remove Existing Tree	

QUANTITIES SHOWN IN LEGEND ARE FOR CONVENIENCE ONLY. CONTRACTOR IS RESPONSIBLE FOR INSTALLING ALL MATERIALS PER PLAN.

## GRADE NOTE

GRADE SHALL BE ESTABLISHED BASED ON GRADING PLAN BY OTHERS, AND FOR LANDSCAPE MATERIALS PER PLAN. FINAL SOIL GRADE FOR 5-12" DIAMETER ROCK AREAS SHALL BE 4" BELOW TOP OF SIDEWALK/CURB/PAVING. AT ALL OTHER ROCK AREAS GRADE SHALL BE 3" BELOW SIDEWALK/CURB. AT SOD/SEED AREAS GRADE SHALL BE 1" BELOW TOP OF SIDEWALK/CURB.

HIGHER GROUND DESIGNS, INC.  
LANDSCAPE ARCHITECTURE, PLANNING & IRRIGATION DESIGN

5350 NORTH ACADEMY BLVD. STE 207  
COLORADO SPRINGS, CO 80918  
Phone 719-477-1646  
Fax 719-526-1122



WATERPARK SUBDIVISION  
2430 SOUTH HAVANA STREET  
AURORA, CO 80011

THESE DRAWINGS ARE THE PROPERTY OF HIGHER GROUND DESIGNS, INC. AND SHALL NOT BE USED FOR ANY OTHER PURPOSE WITHOUT WRITTEN AUTHORIZATION BY HIGHER GROUND DESIGNS, INC. THESE DRAWINGS ARE NOT FOR CONSTRUCTION.

PREPARED FOR:

For City Approval Only

NOT FOR CONSTRUCTION

JOB NUMBER  
1133-23

REVISIONS	
10-16-23	PER CITY COMMENTS
4-8-24	PER CITY COMMENTS
5-22-24	PER CITY COMMENTS

ORIGINAL DATE  
5-1-23

DRAWN BY: JM


DESCRIPTION:  
AREA 'A'  
LANDSCAPE PLAN

SHEET NO.  
L1.2








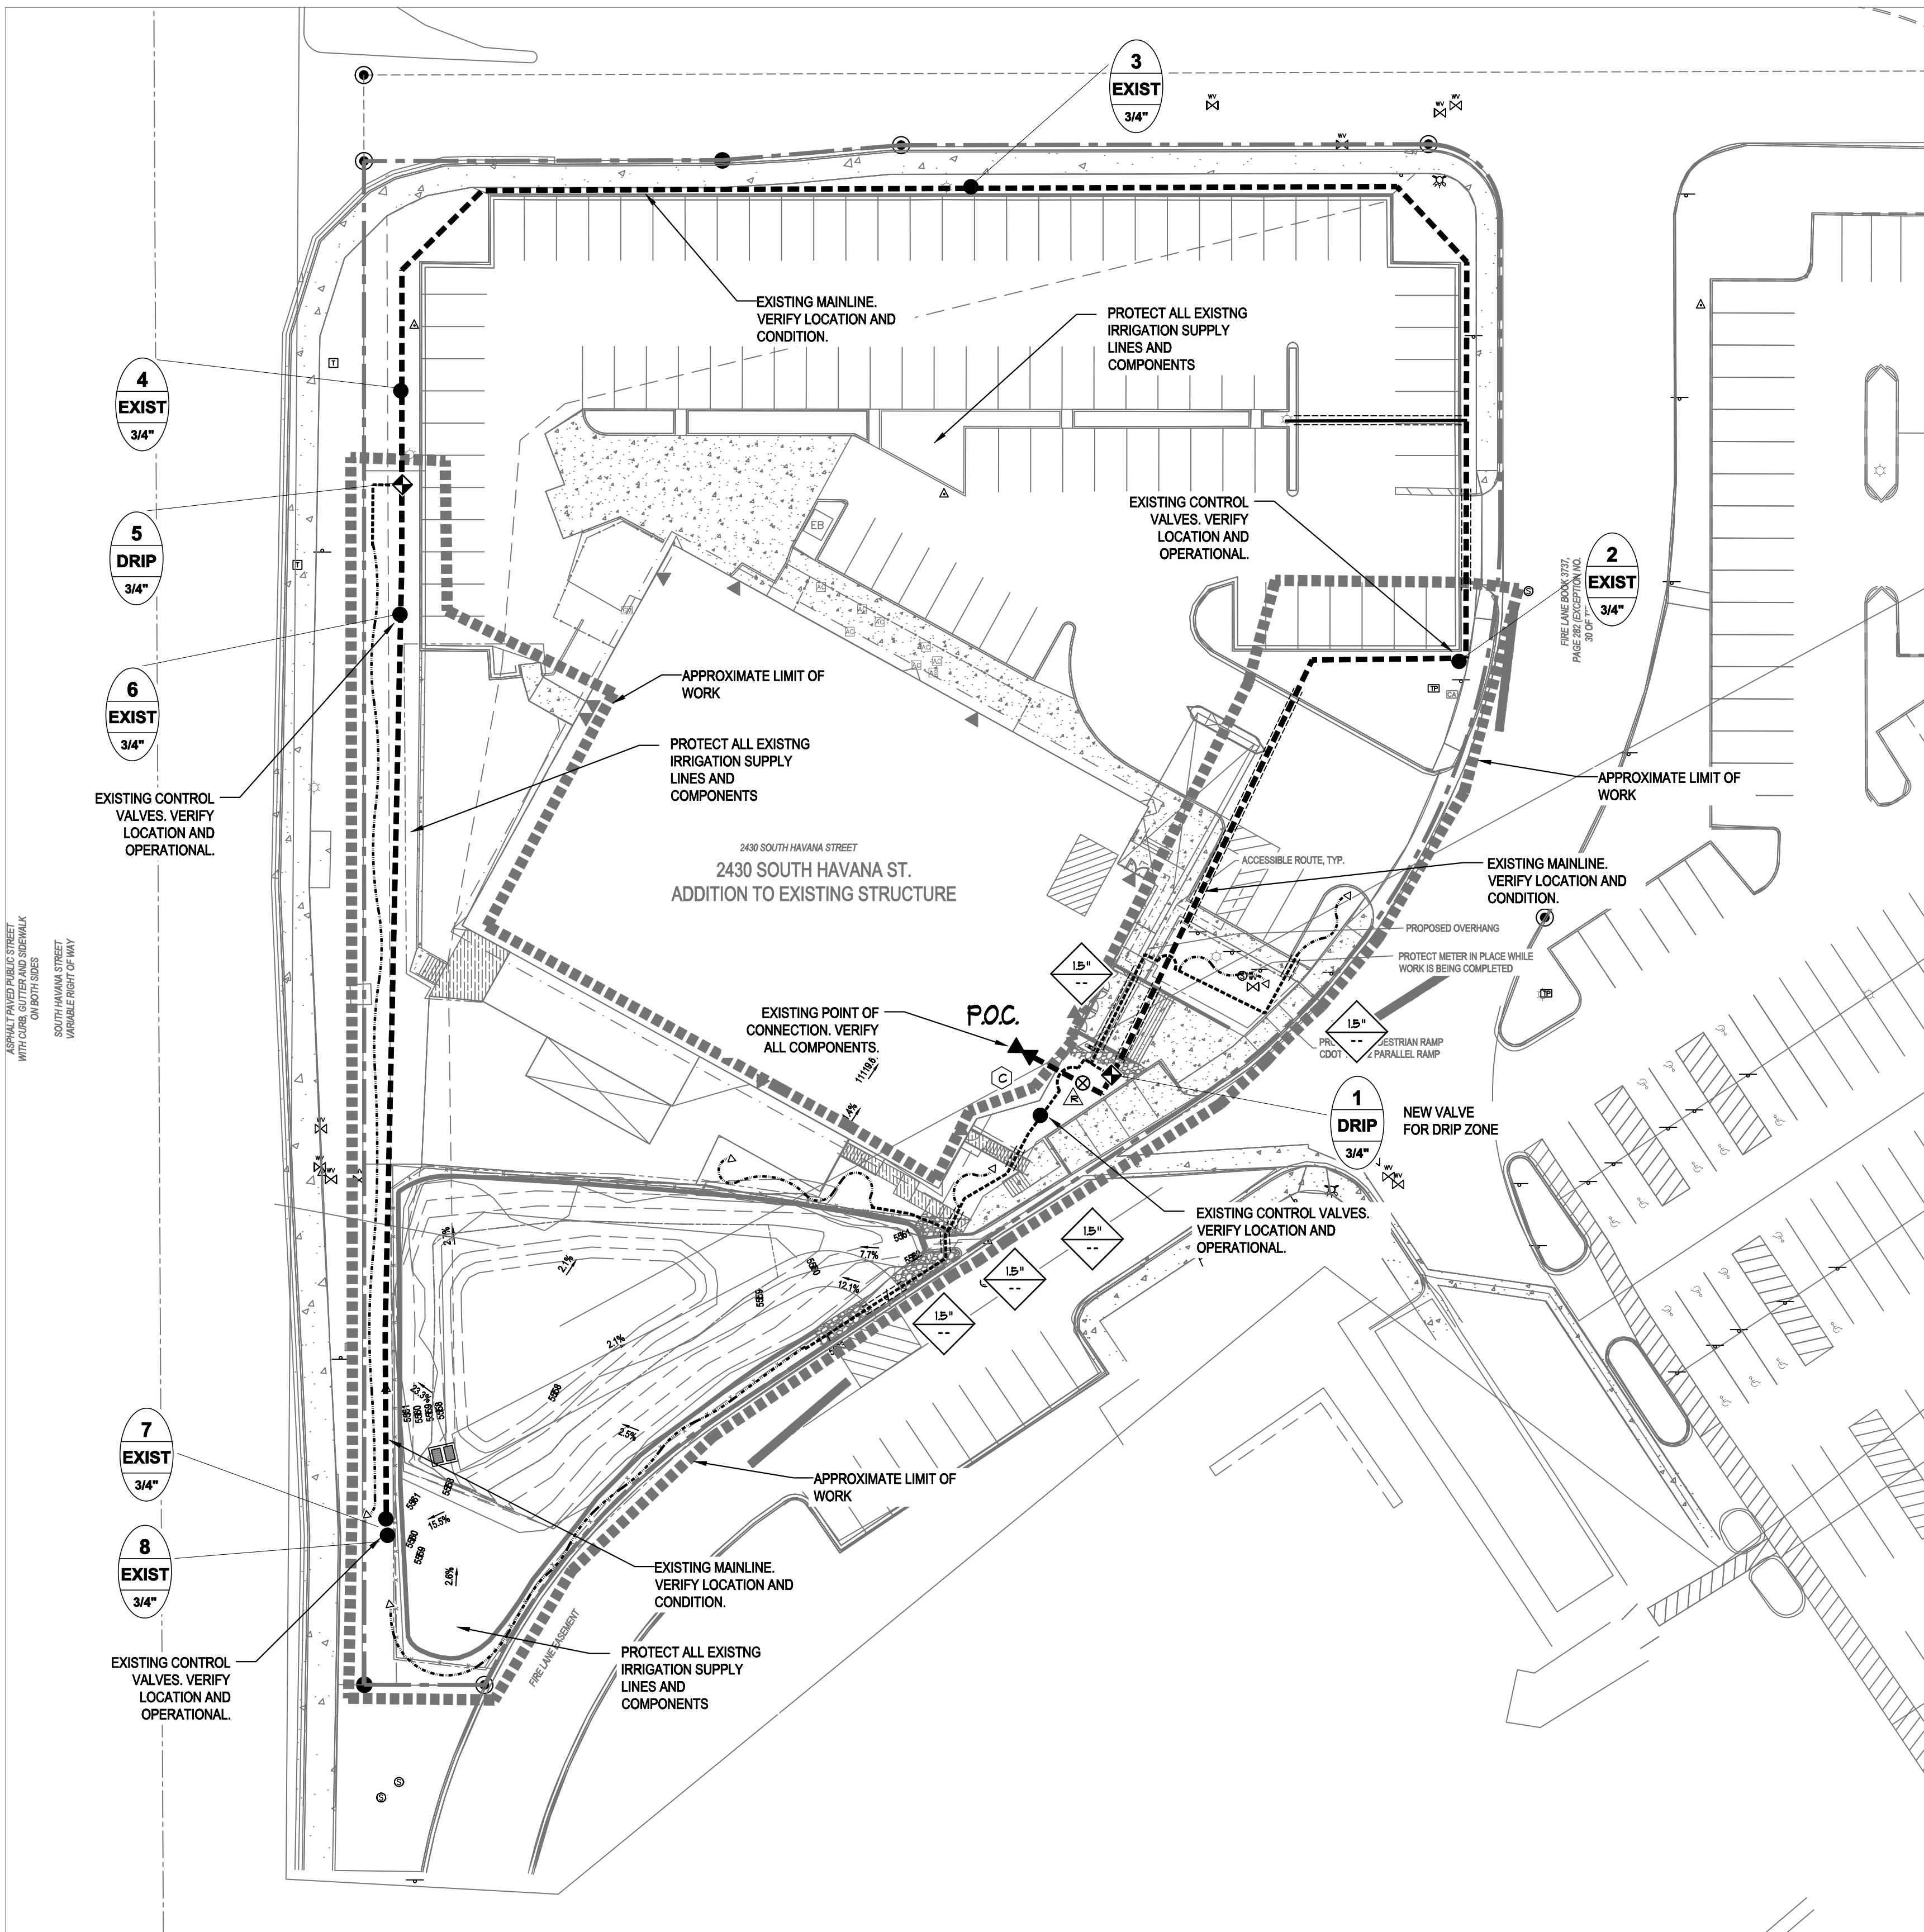

# IRRIGATION PLAN

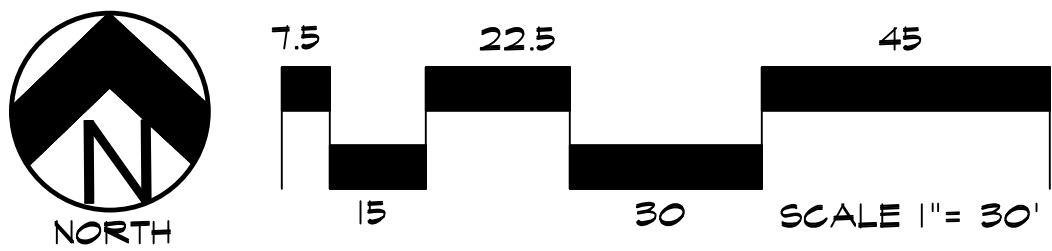

**UTILITIES NOTE**

VERIFY LOCATION AND DEPTH OF ALL UNDERGROUND UTILITIES PRIOR TO START OF WORK. CALL 811 FOR UTILITY LOCATES. TREE TRUNK PLACEMENT SHALL BE 6' MINIMUM DISTANCE FROM ANY GAS OR ELECTRIC AND 10' FROM GAS MAINS RATED AT 150PSI. FOR SANITARY SEWER AND WATER MAINS TREES SHALL NOT BE LOCATED WITHIN EASEMENTS AND WITHIN 10' OF ANY MAINLINE. ANY CONFLICT BETWEEN TREE LOCATIONS AND UTILITIES SHOWN ON PLANS SHALL BE RESOLVED WITH GENERAL CONTRACTOR PRIOR TO PLANTING. ALL ELECTRICAL VAULTS AND TRANSFORMERS SHALL BE KEPT CLEAR FROM PLANT MATERIAL PER LOCAL CODE. ALL SHRUBS TO BE LOCATED 3' CLEAR OF ALL FIRE HYDRANTS AT MATURE SIZE.

**DOCUMENT DISCLAIMER NOTE**

IRRESPECTIVE OF ANY OTHER TERM IN THIS DOCUMENT, LANDSCAPE ARCHITECT SHALL NOT CONTROL OR BE RESPONSIBLE FOR CONSTRUCTION MEANS, METHODS, TECHNIQUES, SCHEDULES, SEQUENCES OR PROCEDURES, OR FOR CONSTRUCTION SAFETY OR ANY OTHER RELATED PROGRAMS, OR FOR ANOTHER PARTIES' ERRORS OR OMISSIONS OR FOR ANOTHER PARTIES' FAILURE TO COMPLETE THEIR WORK OR SERVICES IN ACCORDANCE WITH LANDSCAPE ARCHITECT'S DOCUMENTS.

**IRRIGATION LEGEND**

**P.O.C.** EXISTING POINT OF CONNECTION: CONTRACTOR TO VERIFY IN FIELD PRIOR TO IRRIGATION COMPONENT INSTALLATION. COORDINATE WITH CITY UTILITIES AND GENERAL CONTRACTOR FOR LOCATION.

EXISTING BACKFLOW PREVENTION DEVICE

EXISTING IRRIGATION CONTROLLER

QUICK COUPLING VALVE- 1" RAINBIRD MODEL SRC WITH 55K-1 KEY

RAINBIRD REMOTE CONTROL DRIP VALVE ASSEMBLY KIT RAINBIRD XCZ-075-PRF. SEE PLAN

EXISTING MAINLINE

CLASS 200 PVC PIPE FOR SLEEVING

**\*** LAST VALVE  
ZONE #  
GPM DISCHARGE  
REMOTE CONTROL VALVE SIZE

DRIP IRRIGATION LATERAL PIPE  
80 PSI POLYETHYLENE PIPE: 3/4" DIAMETER  
BURY LATERAL 10" MINIMUM DEPTH

DRIP LINE TUBING: CENTENNIAL 3/4" or 1/2" DIAMETER (FOR REFERENCE ONLY NOT LENGTH)  
USED IN PLANTING BEDS FOR SHRUBS AND TREES - ROUTE ACCORDINGLY TO PLANT MATERIAL

AGRIFIM 3/4" CAP MODEL CETC-34 OR 1" AS REQUIRED  
(INSTALL IN 6" MIN. VALVE BOX)

4" PIPE SLEEVE SIZE (SEE PLAN)  
2" WIRE SLEEVE SIZE (SEE PLAN)

- GENERAL SITE NOTES**
- THE CONTRACTOR IS SPECIFICALLY CAUTIONED THAT THE LOCATION AND/OR ELEVATION OF EXISTING UTILITIES, AS SHOWN ON THESE PLANS, IS BASED ON RECORDS OF THE VARIOUS UTILITY COMPANIES AND, WHERE POSSIBLE, MEASUREMENTS TAKEN IN THE FIELD. THE INFORMATION IS NOT TO BE RELED UPON AS BEING EXACT OR COMPLETE. THE CONTRACTOR MUST CALL THE LOCAL UTILITY LOCATION CENTER AT LEAST 48 HOURS BEFORE ANY EXCAVATION TO REQUEST EXACT FIELD LOCATIONS OF THE UTILITIES. PRIOR TO CONSTRUCTION, THE CONTRACTOR SHALL VERIFY PERTINENT LOCATIONS AND ELEVATIONS, ESPECIALLY AT CONNECTION POINTS AND AT POTENTIAL UTILITY CONFLICTS. IT SHALL BE THE RESPONSIBILITY OF THE CONTRACTOR TO RELOCATE ALL EXISTING UTILITIES THAT CONFLICT WITH THE PROPOSED IMPROVEMENTS SHOWN ON THESE PLANS.
  - THE CONTRACTOR SHALL BE RESPONSIBLE FOR OBTAINING ALL NECESSARY PERMITS FOR ALL APPLICABLE AGENCIES.
  - ALL MATERIALS, WORKMANSHIP, AND CONSTRUCTION OF PUBLIC IMPROVEMENTS SHALL MEET OR EXCEED THE STANDARDS AND SPECIFICATIONS SET FORTH IN CITY OF COLORADO SPRINGS STANDARDS AND SPECIFICATIONS AND APPLICABLE STATE AND FEDERAL REGULATIONS. WHERE THERE IS CONFLICT BETWEEN THESE PLANS AND THE SPECIFICATIONS, OR ANY APPLICABLE STANDARDS, THE HIGHER QUALITY STANDARD SHALL APPLY. ALL WORK SHALL BE INSPECTED AND APPROVED BY THE APPROPRIATE GOVERNING AGENCIES.
  - THE CONTRACTOR SHALL HAVE ONE (1) SIGNED COPY OF THE APPROVED CONSTRUCTION DOCUMENTS, ONE (1) COPY OF THE APPROPRIATE STANDARDS AND SPECIFICATIONS, AND A COPY OF ANY PERMITS AND EXTENSION AGREEMENTS NEEDED FOR THE JOB, ON-SITE AT ALL TIMES.
  - ALL REFERENCES TO ANY PUBLISHED STANDARDS SHALL REFER TO THE LATEST REVISION OF SAID STANDARD, UNLESS SPECIFICALLY STATED OTHERWISE.
  - THE CONTRACTOR SHALL BE RESPONSIBLE FOR KEEPING ROADWAYS FREE AND CLEAR OF ALL CONSTRUCTION DEBRIS TRACKED FROM THE SITE.
  - CONTRACTOR RESPONSIBLE FOR COORDINATING AND INSTALLING ALL SLEEVING REQUIRED FOR IRRIGATION CONSTRUCTION. COORDINATE WITH GENERAL CONTRACTOR.

**IRRIGATION SYSTEM DESCRIPTION**

SITE IRRIGATION SYSTEM PROVIDED BY A FULLY AUTOMATED SPRINKLER SYSTEM CONSISTING OF DRIP IN PLANTING BEDS. ALL ZONES TO BE OPERATED FROM A SINGLE CONTROLLER LOCATED PER PLAN. COORDINATE INSTALLATION OF ALL IRRIGATION COMPONENTS WITH OWNERS REPRESENTATIVE AND OTHER TRADES. BALL VALVES SHALL BE PROVIDED BEFORE EACH ZONE VALVE FOR SYSTEM MAINTENANCE. POTABLE WATER SHALL BE USED FOR ALL SITE IRRIGATION. RAINBIRD EQUIPMENT SHALL BE INSTALLED UNLESS OTHERWISE NOTED PER PLAN. ANY DEVIATION FROM THIS PLAN SHALL BE APPROVED BY LANDSCAPE ARCHITECT OR OWNER.

CONNECT TO EXISTING SYSTEM AS REQUIRED. VERIFY ALL EXISTING SUPPLY LINES AND EQUIPMENT IS OPERATIONAL PRIOR TO START OF WORK

**DRIP SYSTEM NOTE**

ALL PLANT MATERIAL SHALL RECEIVE DRIP LINE TUBING WITH EMITTERS PER DETAILS AND NOTES. FOR SYSTEM FLUSHING INSTALL FLUSH CAP AND THE END OF EACH ZONED DRIP LINE RUN AT LOWEST POINT OF LANDSCAPE AREA. INSTALL SLEEVES UNDER ALL PAVING AS REQUIRED FOR DRIP LINE. REFER TO LEGEND.

NOT FOR CONSTRUCTION	JOB NUMBER	1133-23
	REVISIONS	
	10-16-23	PER CITY COMMENTS
	4-8-24	PER CITY COMMENTS
	5-22-24	PER CITY COMMENTS
DESCRIPTION:	ORIGINAL DATE	5-1-23
	DRAWN BY:	JM
	DESCRIPTION:	IRRIGATION PLAN
	SHEET NO.	IR1.1

WATERPARK SUBDIVISION  
2430 SOUTH HAVANA STREET  
AURORA, CO 80011

PREPARED FOR:

THESE DRAWINGS ARE THE PROPERTY OF HIGHER GROUND DESIGNS, INC. AND ARE NOT TO BE USED FOR ANY OTHER PURPOSES WITHOUT WRITTEN AUTHORIZATION BY HIGHER GROUND DESIGNS, INC. THESE DRAWINGS ARE NOT FOR CONSTRUCTION.

For City Approval Only

**HIGHER GROUND DESIGNS, INC.**  
LANDSCAPE ARCHITECTURE, PLANNING & IRRIGATION DESIGN

**HIGHER GROUND DESIGNS**

5350 NORTH ACADEMY BLVD, STE 207  
COLORADO SPRINGS, CO 80918  
Phone 719-477-1646  
Fax 719-265-1122



IRRIGATION NOTES

COORDINATE ALL UNDERGROUND UTILITY LOCATIONS PRIOR TO ANY DIGGING ON SITE. ALL MATERIALS AND INSTALLATION PRACTICES SHALL BE IN COMPLIANCE WITH LOCAL CODES. CALL 811 FOR UTILITY LOCATES.

CONTRACTOR IS RESPONSIBLE FOR INSTALLING ALL IRRIGATION COMPONENTS SHOWN ON THE PLAN. ANY DEVIATIONS FROM THIS PLAN ARE TO BE APPROVED BY OWNER'S REPRESENTATIVE AND/OR LANDSCAPE ARCHITECT. DEVIATIONS FROM THE APPROVED PLAN SHALL REQUIRE LANDSCAPE ARCHITECT APPROVAL.

THE IRRIGATION SYSTEM IS TO RUN OFF 3/4" METERED TAP AT THE LOCATION INDICATED FROM THE BUILDING DOMESTIC SUPPLY AS SHOWN. COORDINATE WITH OWNER'S REPRESENTATIVE AND OTHER TRADES TO GET WATER AT LOCATION SHOWN. COORDINATE WITH CITY WATER TO INSURE PROPER METER INSTALLATION.

THE SYSTEM CONTROLLERS SHALL BE LOCATED AS SHOWN. COORDINATE LOCATION OF CONTROLLER AND RAIN SENSOR WITH OWNER. CONNECT CONTROLLER TO POWER SUPPLY AND COORDINATED WITH OWNER. CONNECT CONTROLLER TO ZONE VALVES, RAIN SENSOR, AND GROUNDING PER MANUFACTURE'S INSTRUCTIONS.

CONTRACTOR IS RESPONSIBLE FOR ALL IRRIGATION SLEEVING. SLEEVING FOR LATERAL LINES TO BE 12" BELOW TOP OF GRADE AND/OR BELOW THE BOTTOM OF PAVING. MAINLINE SLEEVING TO BE 18" BELOW TOP OF GRADE AND/OR BELOW THE BOTTOM OF PAVING. ALL SLEEVING TO EXTEND 3" BEYOND EDGE OF CONCRETE OR ASPHALT. ENDS OF SLEEVING TO BE SECURELY COVERED AFTER INSTALLATION. SLEEVE LOCATIONS TO BE CLEARLY MARKED WITH PAINTED STAKES OR PVC. CONTRACTOR IS RESPONSIBLE FOR VERIFYING ALL SLEEVING LOCATIONS PRIOR TO CONSTRUCTION AND INSTALL ANY MISSING SLEEVE IF NECESSARY.

ALL SPRINKLER HEADS SHALL BE INSTALLED WITH TOP OF HEADS FLUSH WITH SURROUNDING FINAL GRADE. CONTRACTOR SHALL ADJUST EACH SPRINKLER HEAD TO PROVIDE OPTIMAL COVERAGE. OVERSPRAY ONTO PAVEMENT OR WALLS IS TO BE PREVENTED. CONTRACTOR TO ADJUST AND SELECT NOZZLES TO PROVIDE UNIFORM COVERAGE. PROVIDE PRESSURE COMPENSATING NOZZLES OR SCREENS IF UNIFORM PRESSURE CANNOT BE ACHIEVED BY ADJUSTING PRESSURE AT VALVES.

IRRIGATION PLAN IS DIAGRAMMATIC. ANY COMPONENTS SHOWN ON PLAN OUTSIDE OF LANDSCAPE ARE SHOWN FOR CLARITY ONLY. USE ONLY STANDARD FITTINGS. MAINLINE PIPING DEPTH TO BE 18". LATERAL LINE DEPTH TO BE 12". DRIP LINE TO BE SECURED AT FINAL SOIL GRADE.

CONTRACTOR IS TO INSTALL IRRIGATION WIRE BETWEEN CONTROLLER AND ELECTRIC VALVES. INSTALL TWO EXTRA WIRES RUNNING FROM CONTROLLER ALONG MAINLINE IN EACH DIRECTION FROM THE CONTROLLER FOR TROUBLE SHOOTING OR FUTURE ADDITIONS. WIRE SHALL BE SOLID COPPER #14 PER IRRIGATION CONTROL WIRE. CONNECTIONS SHALL BE MADE WITHIN ENCLOSURES ONLY USING 3M BRAND DBY AND DBR CONNECTORS. NO BURIED SPLICES PERMITTED.

NOTIFY OWNER'S REPRESENTATIVE OF ANY DISCREPANCIES BETWEEN PLAN DRAWINGS AND FIELD CONDITIONS PRIOR TO INSTALLATION OF ANY IRRIGATION COMPONENTS.

HIGHER GROUND DESIGNS, INC. (HGD) PREPARED THIS PLAN BASED ON EXISTING CONDITIONS AND SITE PLAN BY OTHERS. HDG DOES NOT RECOMMEND SPRAY/ROTOR OPERATION OR ROTOR/SPRAY OVER SPRAY WITHIN 5' OF ANY BUILDING. HDG ASSUMES NO LIABILITY FOR ANY WATER DAMAGE ON THIS SITE.

ALL DRIP POLYETHYLENE LATERALS AND DRIP TUBING FITTINGS SHALL BE RIBBED PLASTIC WITH OETIKER BRAND CLAMPS. THE END OF EACH DRIP LINE TO RECEIVE A DRIP FLUSH CAP PER DETAIL.

INSTALL VALVE BOXES IN PLANTER AND ROCK AREAS WHEN POSSIBLE. DO NOT SET VALVE BOXES IN TURF OR SEEDED AREAS UNLESS UNAVOIDABLE.

IRRIGATION SYSTEM MATERIALS

- PRESSURE SUPPLY LINE (FROM POINT OF CONNECTION THROUGH BACKFLOW PREVENTION UNIT) - TYPE "K" RIGID COPPER. PRESSURE SUPPLY LINES (DOWNSTREAM OF BACKFLOW PREVENTION UNITS) - CLASS 200 PVC SOLVENT WELD (1" - 2 1/2") SOLVENT WELD PIPE - MANUFACTURED FROM VIRGIN POLYVINYL CHLORIDE (PVC) COMPOUND IN ACCORDANCE WITH ASTM D2241 AND ASTM D1784; CELL CLASSIFICATION 12454-B, TYPE 1, GRADE 1. FITTINGS - STANDARD WRIGHT, SCHEDULE 40, INJECTION MOLDED PVC; COMPLYING WITH ASTM D1784 AND D2466, CELL CLASSIFICATION 12454-B
- THREADS - INJECTION MOLDED TYPE (WHERE REQUIRED).
- TEES AND ELLS - SIDE GATED, THREADED NIPPLES - ASTM D2464, SCHEDULE 80 WITH MOLDED THREADS
- ALL PVC MALE THREADED FITTINGS AND NIPPLES, EXCLUDING MATEX FITTINGS, SHALL RECEIVE WRAPPING OF TEFLON TAPE
- JOINT CEMENT AND PRIMER - TYPE AS RECOMMENDED BY MANUFACTURER OF PIPE AND FITTINGS.
- FLEXIBLE PLASTIC PIPE - MANUFACTURED FROM VIRGIN POLYETHYLENE IN ACCORDANCE WITH ASTM D2238, WITH A HYDROSTATIC DESIGN STRESS OF 630 PSI AND DESIGNATED AS PE 2306. FITTINGS - INSERT TYPE MANUFACTURED IN ACCORDANCE WITH ASTM D2608; PVC TYPE 1 CELL CLASSIFICATION 12454-B.

IRRIGATION SYSTEM INSTALLATION

- BACKFILLING - DO NOT BEGIN BACKFILLING OPERATIONS UNTIL REQUIRED SYSTEM TESTS HAVE BEEN COMPLETED. BACKFILL SHALL NOT BE DONE IN FREEZING WEATHER EXCEPT WITH REVIEW BY CONSULTANT. TRENCHES SHALL BE FINISH GRADED PRIOR TO WALK-THROUGH OF SYSTEM BY OWNER/CONSULTANT.
- EXCAVATED MATERIAL IS GENERALLY CONSIDERED SATISFACTORY FOR BACKFILL PURPOSES. BACKFILL MATERIAL SHALL BE FREE OF RUBBISH, VEGETABLE MATTER, FROZEN MATERIALS, AND STONES LARGER THAN 1 INCH IN MAXIMUM DIMENSION. DO NOT MIX SUBSOIL WITH TOPSOIL. MATERIAL NOT SUITABLE FOR BACKFILL SHALL BE HAULED AWAY. CONTRACTOR SHALL BE RESPONSIBLE FOR PROVIDING SUITABLE BACKFILL IF EXCAVATED MATERIAL IS UNACCEPTABLE OR NOT SUFFICIENT TO MEET BACKFILL, COMPACTION, AND FINAL GRADE REQUIREMENTS.
- DO NOT LEAVE TRENCHES OPEN FOR A PERIOD OF MORE THAN 48 HOURS. OPEN EXCAVATIONS SHALL BE PROTECTED IN ACCORDANCE WITH OSHA REGULATIONS. COMPACT BACKFILL TO 90% MAXIMUM DENSITY, DETERMINED IN ACCORDANCE WITH ASTM D1557. MECHANICAL TAMPING IS PROHIBITED WITHIN 20'-0" OF BUILDING OR FOUNDATION WALLS.

EXECUTION


- CONTRACTOR SHALL BE RESPONSIBLE FOR REMOVAL OF ANY SOIL RETENTION COVERING THAT WOULD INTERFERE WITH THE PROPER INSTALLATION OF THE IRRIGATION SYSTEM.
- CONTRACTOR WILL BE HELD RESPONSIBLE FOR COORDINATION BETWEEN LANDSCAPE AND IRRIGATION SYSTEM INSTALLATION. LANDSCAPE MATERIAL LOCATIONS SHOWN ON THE LANDSCAPE PLAN SHALL TAKE PRECEDENCE OVER THE IRRIGATION SYSTEM EQUIPMENT LOCATIONS. IF IRRIGATION EQUIPMENT IS INSTALLED IN CONFLICT WITH THE LANDSCAPE MATERIAL LOCATIONS SHOWN ON THE LANDSCAPE PLAN, THE CONTRACTOR WILL BE REQUIRED TO RELOCATE THE IRRIGATION EQUIPMENT, AS NECESSARY, AT CONTRACTOR'S EXPENSE.
- CONTRACTOR IS RESPONSIBLE TO NOTIFY CONSULTANT OF ANY FIELD CONDITIONS THAT VARY FROM THE CONDITIONS SHOWN ON THE IRRIGATION CONSTRUCTION DOCUMENTS. IF CONTRACTOR FAILS TO NOTIFY CONSULTANT OF THESE CONDITIONS, CONTRACTOR WILL BE HELD RESPONSIBLE FOR ALL COSTS ASSOCIATED WITH SYSTEM ADJUSTMENTS REQUIRED DUE TO THE CHANGE IN FIELD CONDITIONS.
- STATIC PRESSURE VERIFICATION - CONTRACTOR SHALL FIELD VERIFY THE STATIC PRESSURE AT THE PROJECT SITE, PRIOR TO COMMENCING WORK OR ORDERING IRRIGATION MATERIALS. IF CONTRACTOR FAILS TO VERIFY STATIC WATER PRESSURE PRIOR TO COMMENCING WORK OR ORDERING IRRIGATION MATERIALS, CONTRACTOR SHALL ASSUME RESPONSIBILITY FOR ALL COSTS REQUIRED TO MAKE SYSTEM OPERATIONAL AND THE COSTS REQUIRED TO REPLACE ANY DAMAGED LANDSCAPE MATERIAL. DAMAGE SHALL INCLUDE ALL REQUIRED MATERIAL COSTS, DESIGN COSTS AND PLANT REPLACEMENT COSTS.
- INSPECTION - EXAMINE AREAS AND CONDITIONS UNDER WHICH WORK OF THIS SECTION IS TO BE PERFORMED. DO NOT PROCEED WITH WORK UNTIL UNSATISFACTORY CONDITIONS HAVE BEEN CORRECTED.

IRRIGATION SCHEDULE NOTES


EACH VEGETATION TYPE HAS A DIFFERENT WEEKLY WATER REQUIREMENT THAT SHOULD BE FULFILLED BY A DIFFERENT NUMBER OF SCHEDULED RUN TIMES. NEW LANDSCAPE PLANTS SHALL BE IRRIGATED EVERY OTHER DAY FOR THE FIRST GROWING SEASON. DURING ALL SUBSEQUENT SEASONS LANDSCAPE PLANTS SHALL BE IRRIGATED EVERY THIRD DAY. TYPICALLY LONGER RUN TIMES HELP PROMOTE TREE, SHRUB, AND OTHER PLANT, DEEP ROOT GROWTH AND ESTABLISHMENT.

RUN TIMES SHALL BE ADJUSTED FOR SEASONAL REQUIREMENTS. SPRING RUN TIMES SHALL BE SET AT 85% OF SUMMER RUN TIMES. FALL RUN TIMES SHALL BE SET AT 80% OF SUMMER RUN TIMES.


IRRIGATION SCHEDULE						
ZONE	TYPE	FLOW GPM	PRECIP RATE INCHES/HOUR	RUN TIME MINUTES/CYCLE	TOTAL GALLONS	TREATMENT
1	DRIP	3-7	--	60	300	PLANTING
2	DRIP	3-7	--	60	300	PLANTING

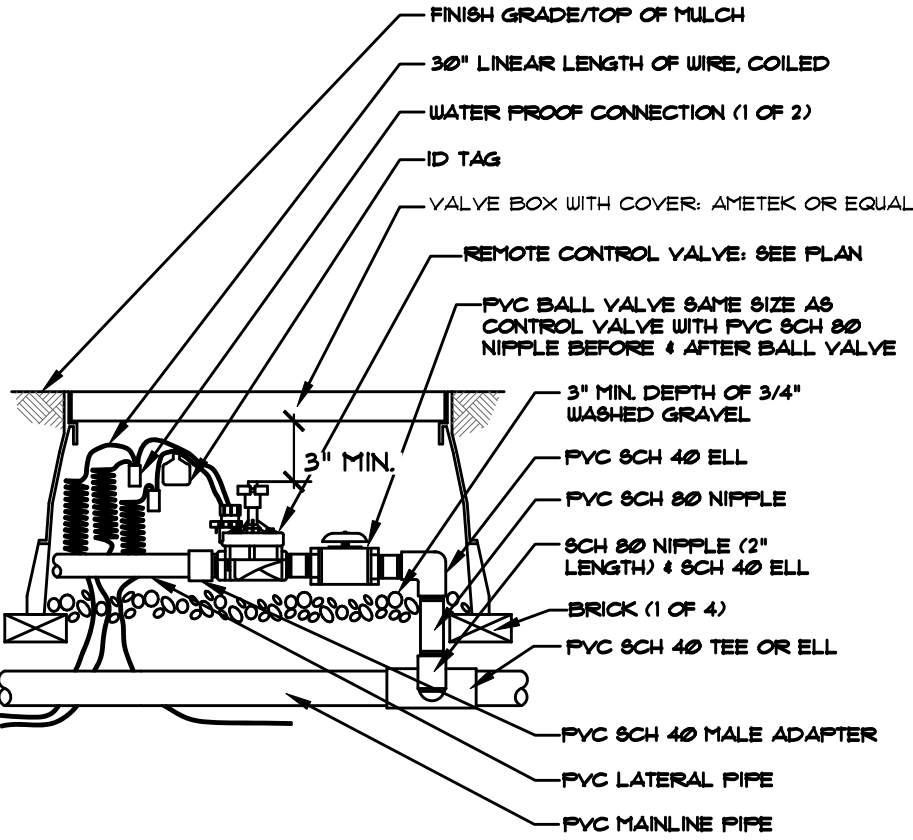

A ELECTRIC ZONE CONTROL VALVE NOT TO SCALE

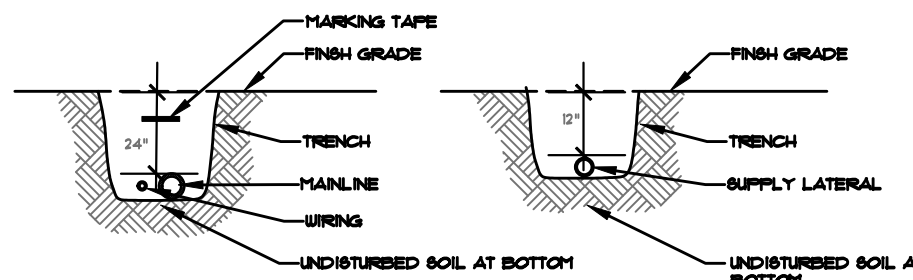

B POP-UP SPRAY SPRINKLER HEAD NOT TO SCALE

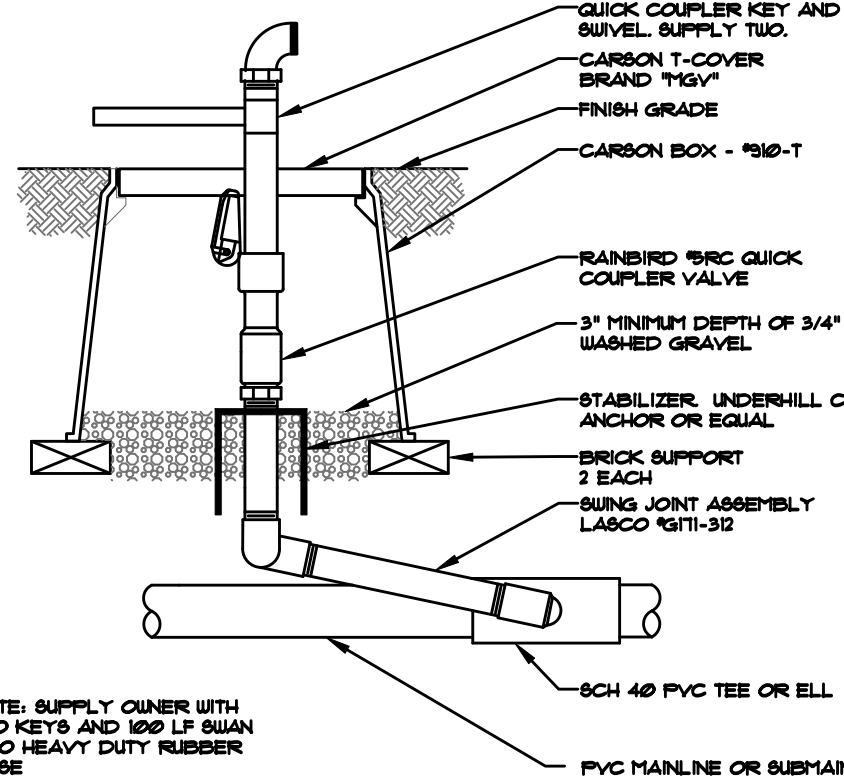


C QUICK COUPLER ASSEMBLY DETAIL NOT TO SCALE

NOTE: INSTALL PIPING NO LESS THAN 6\"/>

PIPE SIZING CHART: CLASS 200 PIPE				
Pipe Size	Short distance (50' GPM)	Medium distance (200' GPM)	Long distance (300' GPM)	
3/4"	10	8	6	
1"	17	15	12	
1-1/4"	27	27	22	
1-1/2"	36	36	30	
2"	56	56	46	
2-1/2"	83	83	69	
3"	123	123	102	


D LATERAL PIPE TRENCHING DETAIL NOT TO SCALE

NOTES: • DRIP PIPING IS TO BE STAKED TO GROUND SURFACE EVERY 4'-6'. MULCH IS TO BE INSTALLED TO COVER ALL PIPING AND TUBING. RECOMMEND PIPE INSTALLED OVER WEED BARRIER.

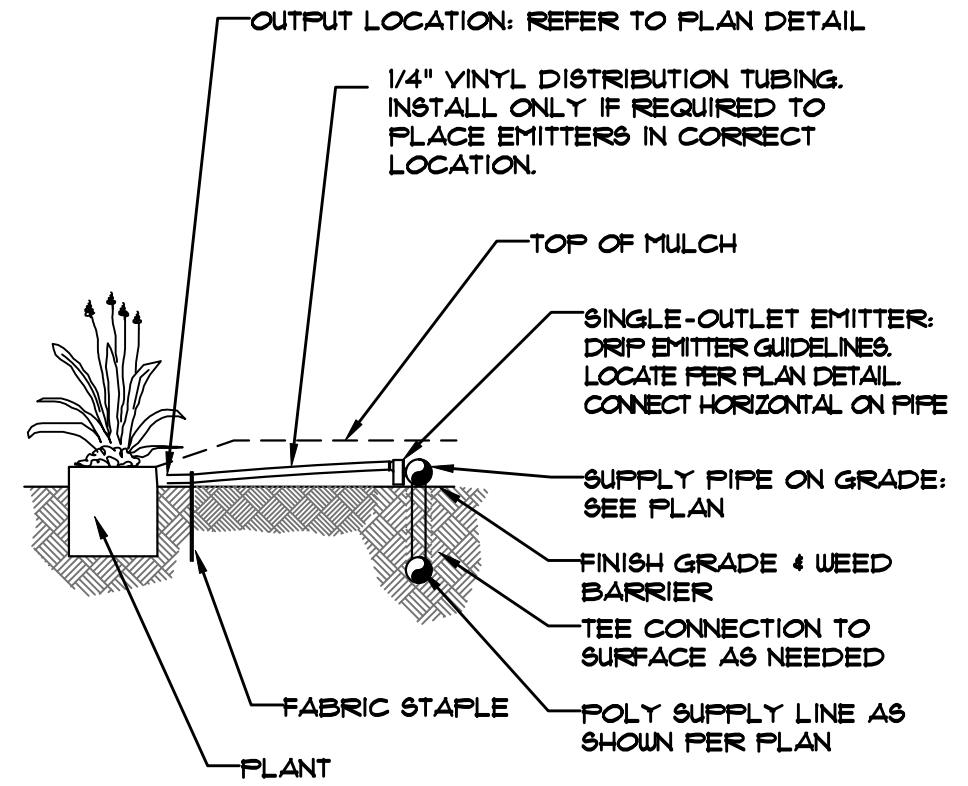


E SLEEVING DETAIL NOT TO SCALE

NOTES: DRIP EMITTERS SHALL BE PLACED APPROX. 2\"/>

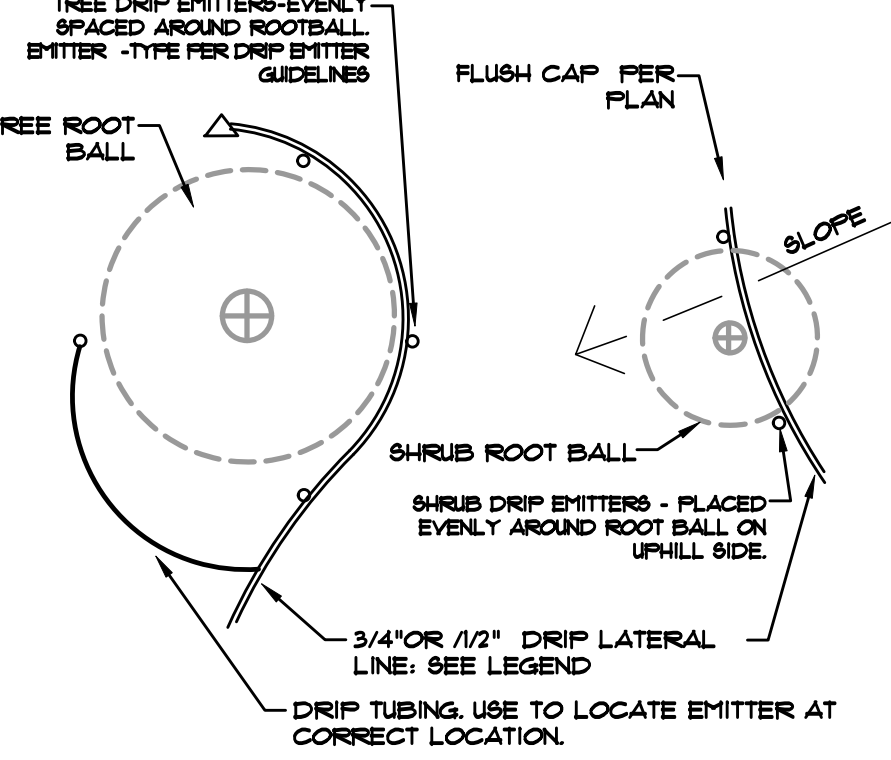

F DRIP IRRIGATION ZONE CONTROL VALVE NOT TO SCALE

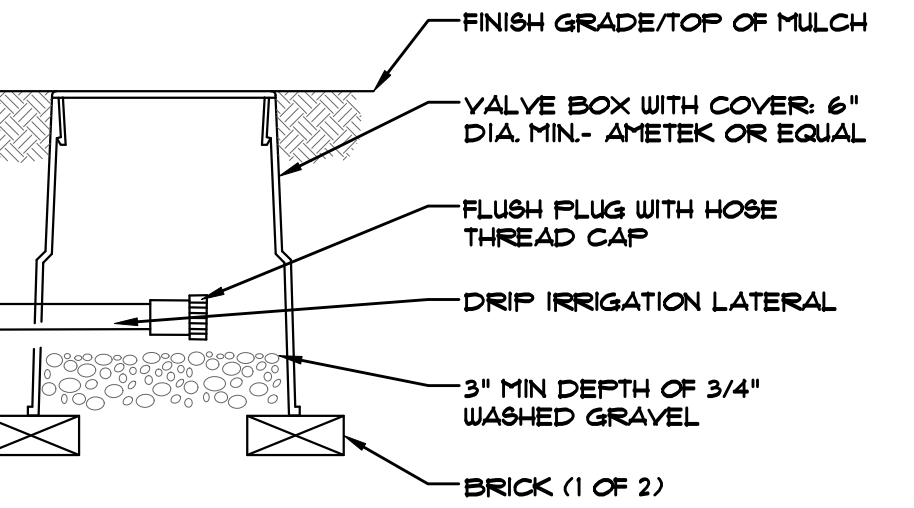

G TYPICAL EMITTER ASSEMBLY NOT TO SCALE

H DRIP EMITTER PLACEMENT NOT TO SCALE SEE GUIDELINES FOR EMITTER QUANTITY

NOTES: DRIP FLUSH CAP AND BOX SHALL BE INSTALLED AT THE END OF EACH DRIP SUPPLY LINE AT ENDS.

I DRIP FLUSH CAP NOT TO SCALE

DRIP EMITTERS

DRIP EMITTERS FOR TREES, SHRUBS, ORNAMENTAL GRASSES AND PERENNIALS SHALL BE INSTALLED PER DETAILS ON THIS SHEET. CONTRACTOR IS RESPONSIBLE FOR ADJUSTING EMITTER QUANTITY SO THAT EACH PLANT TYPE RECEIVES THE CORRECT WATER REQUIREMENT BASED ON ZONE RUN TIME AND PLANT WATER REQUIREMENTS. SEE DRIP EMITTER GUIDELINES. EXCEPT FOR PERENNIALS ALL SHRUBS SHALL RECEIVE TWO EMITTERS, AND TREES SHALL RECEIVE MINIMUM FOUR EMITTERS.

DRIP EMITTER GUIDELINES

PLANT MATERIAL	EMITTER QUANTITY	OUTPUT (GPH)
1 GAL. PERENNIAL (COLOR)	1 EACH - 5 GPH	.5
1 GAL. ORNAMENTAL GRASS	2 EACH - 5 GPH	1
5 GAL. ORNAMENTAL GRASS	2 EACH - 1 GPH	2
5 GAL. EVERGREEN SHRUB	2 EACH - 1 GPH	2
5 GAL. DECIDUOUS SHRUB	2 EACH - 1 GPH	2
HIGH WATER DECIDUOUS SHRUB	2 EACH - 2 GPH	4
6" B&B EVERGREEN TREE	4 EACH - 1 GPH	4
HIGH WATER EVERGREEN TREE	4 EACH - 2 GPH	8
1 1/2" CAL. DECIDUOUS TREE	4 EACH - 1 GPH	4
HIGH WATER DECIDUOUS TREE	4 EACH - 2 GPH	8

UTILITIES NOTE

VERIFY LOCATION AND DEPTH OF ALL UNDERGROUND UTILITIES PRIOR TO START OF WORK. CALL 811 FOR UTILITY LOCATES. TREE TRUNK PLACEMENT SHALL BE 6\"/>

DOCUMENT DISCLAIMER NOTE

IRRESPECTIVE OF ANY OTHER TERM IN THIS DOCUMENT, LANDSCAPE ARCHITECT SHALL NOT CONTROL OR BE RESPONSIBLE FOR CONSTRUCTION MEANS, METHODS, TECHNIQUES, SCHEDULES, SEQUENCES OR PROCEDURES, OR FOR CONSTRUCTION SAFETY OR ANY OTHER RELATED PROGRAMS, OR FOR ANOTHER PARTIES' ERRORS OR OMISSIONS OR FOR ANOTHER PARTIES' FAILURE TO COMPLETE THEIR WORK OR SERVICES IN ACCORDANCE WITH LANDSCAPE ARCHITECT'S DOCUMENTS.

HIGHER GROUND DESIGNS, INC.

LANDSCAPE ARCHITECTURE, PLANNING & IRRIGATION DESIGN

5350 NORTH ACADEMY BLVD, STE 207  
COLORADO SPRINGS, CO 80918  
Phone 719-477-1646  
Fax 719-265-1122



WATERPARK SUBDIVISION  
2430 SOUTH HAVANA STREET  
AURORA, CO 80011

THESE DRAWINGS ARE THE PROPERTY OF HIGHER GROUND DESIGNS, INC. AND ARE NOT TO BE USED FOR ANY OTHER PURPOSES WITHOUT WRITTEN AUTHORIZATION BY HIGHER GROUND DESIGNS, INC. THESE DRAWINGS ARE NOT FOR CONSTRUCTION.

PREPARED FOR:

For City Approval Only

NOT FOR CONSTRUCTION

JOB NUMBER 1133-23

REVISONS		
10-16-23	PER CITY COMMENTS	
4-8-24	PER CITY COMMENTS	
5-22-24	PER CITY COMMENTS	

ORIGINAL DATE 5-1-23


DRAWN BY: JM

DESCRIPTION: IRRIGATION DETAILS

SHEET NO. IR1.2



SOUTH HAVANA STREET

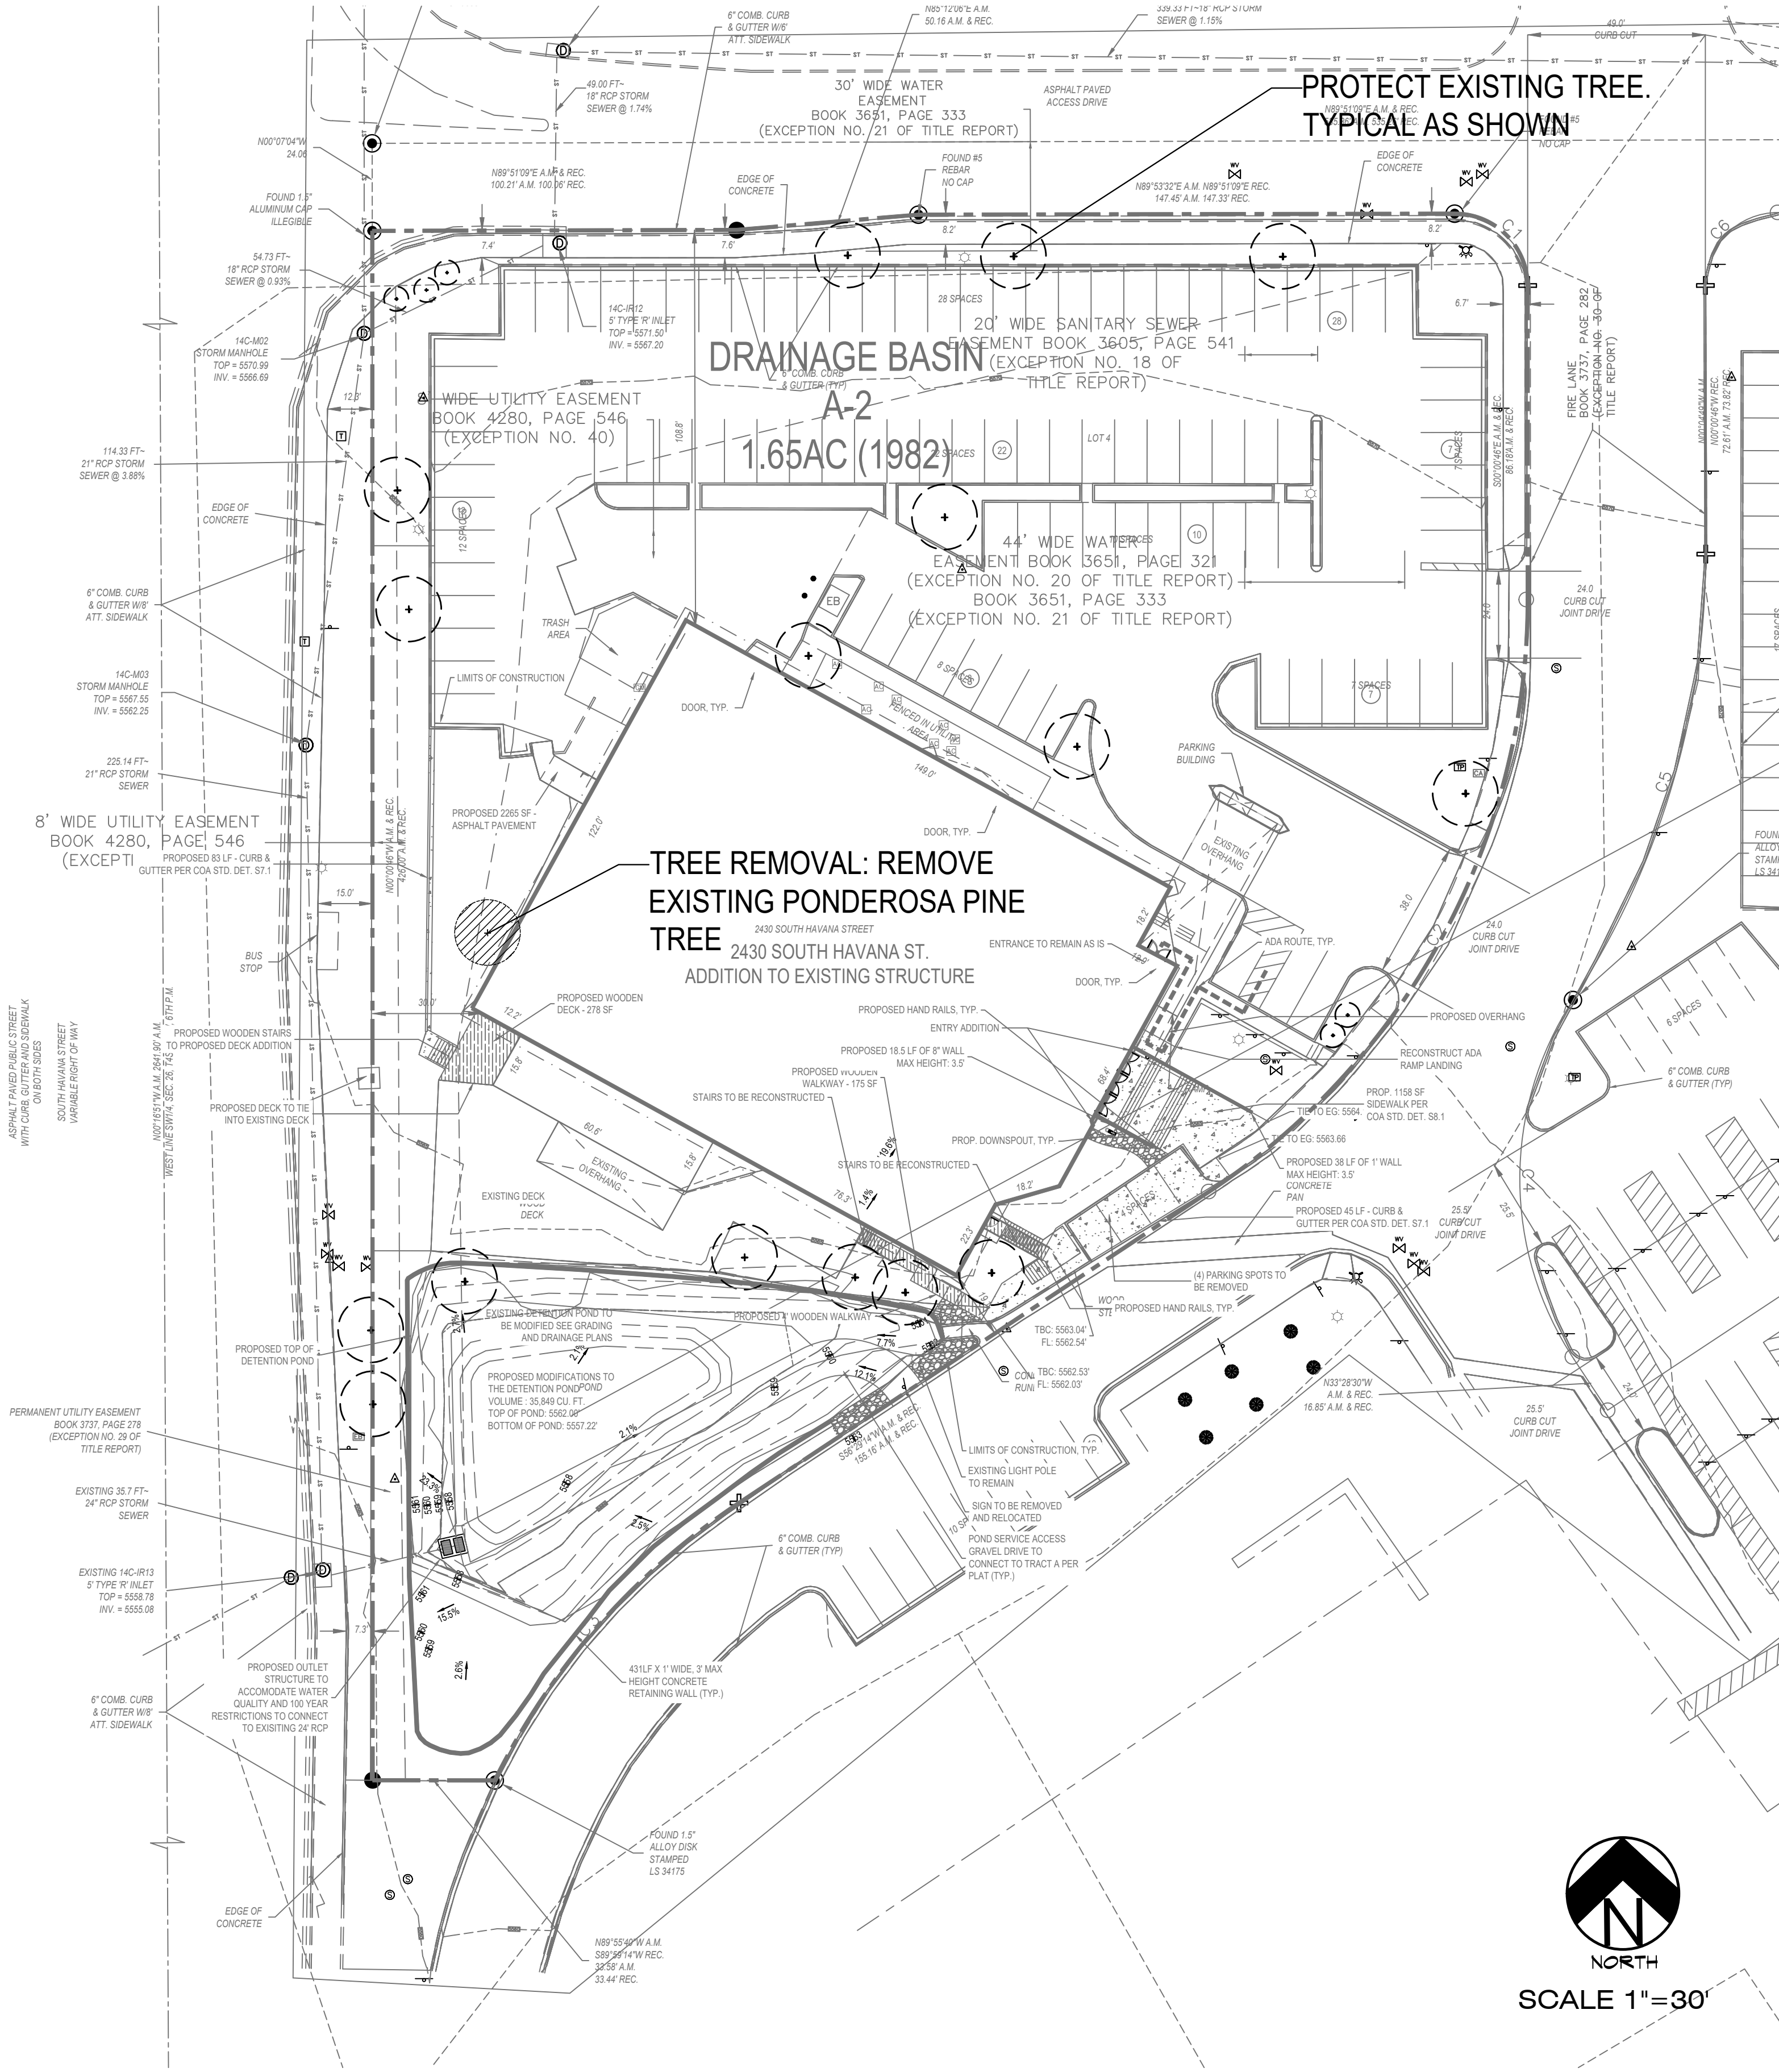

# TREE MITIGATION PLAN



**UTILITIES NOTE**  
VERIFY LOCATION AND DEPTH OF ALL UNDERGROUND UTILITIES PRIOR TO START OF WORK. CALL 811 FOR UTILITY LOCATES. TREE TRUNK PLACEMENT SHALL BE 6" MINIMUM DISTANCE FROM ANY GAS OR ELECTRIC AND 10' FROM GAS MAINS RATED AT 150PSI. FOR SANITARY SEWER AND WATER MAINLINES TREES SHALL NOT BE LOCATED WITHIN EASEMENTS AND WITHIN 15' OF ANY MAINLINE. ANY CONFLICT BETWEEN TREE LOCATIONS AND UTILITIES SHOWN ON PLANS SHALL BE RESOLVED WITH GENERAL CONTRACTOR PRIOR TO PLANTING. ALL ELECTRICAL VAULTS AND TRANSFORMERS SHALL BE KEPT CLEAR FROM PLANT MATERIAL PER LOCAL CODE. ALL SHRUBS TO BE LOCATED 3' CLEAR OF ALL FIRE HYDRANTS AT MATURE SIZE.

## GENERAL LANDSCAPE NOTES

ALL UTILITY EASEMENTS SHALL REMAIN UNOBSTRUCTED AND FULLY ACCESSIBLE ALONG THEIR ENTIRE LENGTH FOR MAINTENANCE EQUIPMENT ENTRY.

THE DEVELOPER, HIS SUCCESSORS AND ASSIGNS, SHALL BE RESPONSIBLE FOR INSTALLATION, MAINTENANCE AND REPLACEMENT OF ALL LANDSCAPING MATERIALS SHOWN OR INDICATED ON THE APPROVED SITE PLAN OR LANDSCAPE PLAN ON FILE IN THE PLANNING DEPARTMENT. ALL LANDSCAPING WILL BE INSTALLED AS DELINEATED ON THE PLAN, UPON COMPLETION OF ALL SITE IMPROVEMENTS.

ALL LANDSCAPED AREAS AND PLANT MATERIAL EXCEPT FOR NON-IRRIGATED NATIVE, RESTORATIVE, AND DRYLAND GRASS AREAS MUST BE WATERED BY AN AUTOMATIC UNDERGROUND IRRIGATION SYSTEM. IRRIGATION SYSTEM DESIGN, INSTALLATION, OPERATION, AND MAINTENANCE SHALL CONFORM TO THE REQUIREMENTS FOUND IN THE CITY OF AURORA IRRIGATION ORDINANCE.

LANDSCAPE AREA  
TOTAL SITE: 99,340 SF  
LANDSCAPE AREA (15%) REQUIRED/PROVIDED: 14,901 SF / 25,934 SF

## TREE PROTECTION NOTE

ALL TREES SHOWN AS "TO BE PROTECTED" SHALL BE PRESERVED ACCORDING TO THE TREE PROTECTION STANDARDS PER THE CURRENT PARKS, RECREATION AND OPEN SPACE DEDICATION AND DEVELOPMENT CRITERIA MANUAL.



TREE REMOVAL - ONE TREE

## TREE MITIGATION PAYMENT NOTE

Any tree that is removed from this site will either require replacement within the landscape or be mitigated through payment to the Community Tree Fund. Tree mitigation is always above and beyond the Landscape Code requirements.

The caliper inches lost with removal are 14" with 6" replacement. The mitigation value is \$947.00. This fee will be paid to the tree fund.

TREE #	SPECIES	DIAMETER	MITIGATION VALUE	MITIGATION INCHES	TREE PLANTING FUND PAYMENT
1	Ponderosa Pine	14	\$947.38	6	
Total		14	\$947.38	6	\$947.38

NOTE: Mitigation values based on International Society of Arboriculture's Guide to Plant Appraisal. Species, diameter, condition, and location factors were included in the assessment.

## EXISTING TREE LEGEND

SYMBOL	DESCRIPTION
	Protect Existing Tree
	Remove Existing Tree

## DOCUMENT DISCLAIMER NOTE

IRRESPECTIVE OF ANY OTHER TERM IN THIS DOCUMENT, LANDSCAPE ARCHITECT SHALL NOT CONTROL OR BE RESPONSIBLE FOR CONSTRUCTION MEANS, METHODS, TECHNIQUES, SCHEDULES, SEQUENCES OR PROCEDURES, OR FOR CONSTRUCTION SAFETY OR ANY OTHER RELATED PROGRAMS, OR FOR ANOTHER PARTIES' ERRORS OR OMISSIONS OR FOR ANOTHER PARTIES' FAILURE TO COMPLETE THEIR WORK OR SERVICES IN ACCORDANCE WITH LANDSCAPE ARCHITECT'S DOCUMENTS.

**HIGHER GROUND DESIGNS, INC.**  
LANDSCAPE ARCHITECTURE, PLANNING & IRRIGATION DESIGN

5350 NORTH ACADEMY BLVD. STE 207  
COLORADO SPRINGS, CO 80918  
Phone 719-477-1646  
Fax 719-266-1122



WATERPARK SUBDIVISION  
2430 SOUTH HAVANA STREET  
AURORA, CO 80011

THESE DRAWINGS ARE THE PROPERTY OF HIGHER GROUND DESIGNS, INC. AND SHALL NOT BE USED FOR ANY OTHER PURPOSE WITHOUT WRITTEN AUTHORIZATION BY HIGHER GROUND DESIGNS, INC. THESE DRAWINGS ARE NOT FOR CONSTRUCTION.

PREPARED FOR:

For City Approval Only

NOT FOR CONSTRUCTION

JOB NUMBER	1133-23
REVISIONS	
10-16-23	PER CITY COMMENTS
4-8-24	PER CITY COMMENTS
5-22-24	PER CITY COMMENTS
ORIGINAL DATE	5-1-23
DRAWN BY:	JM
DESCRIPTION:	TREE MITIGATION PLAN
SHEET NO.	TM1.1






STAMPEDE  
NEW ENTRY / WALKWAY SITE LIGHTING  
2340 S HAVANA ST  
AURORA, CO 80014

[illegible]

CLIENT:  
CHRIS SWANK

PROJECT NUMBER	24123
DATE	5/12/2024
DRAWN BY	BEK
CHECKED BY	BEK

E1

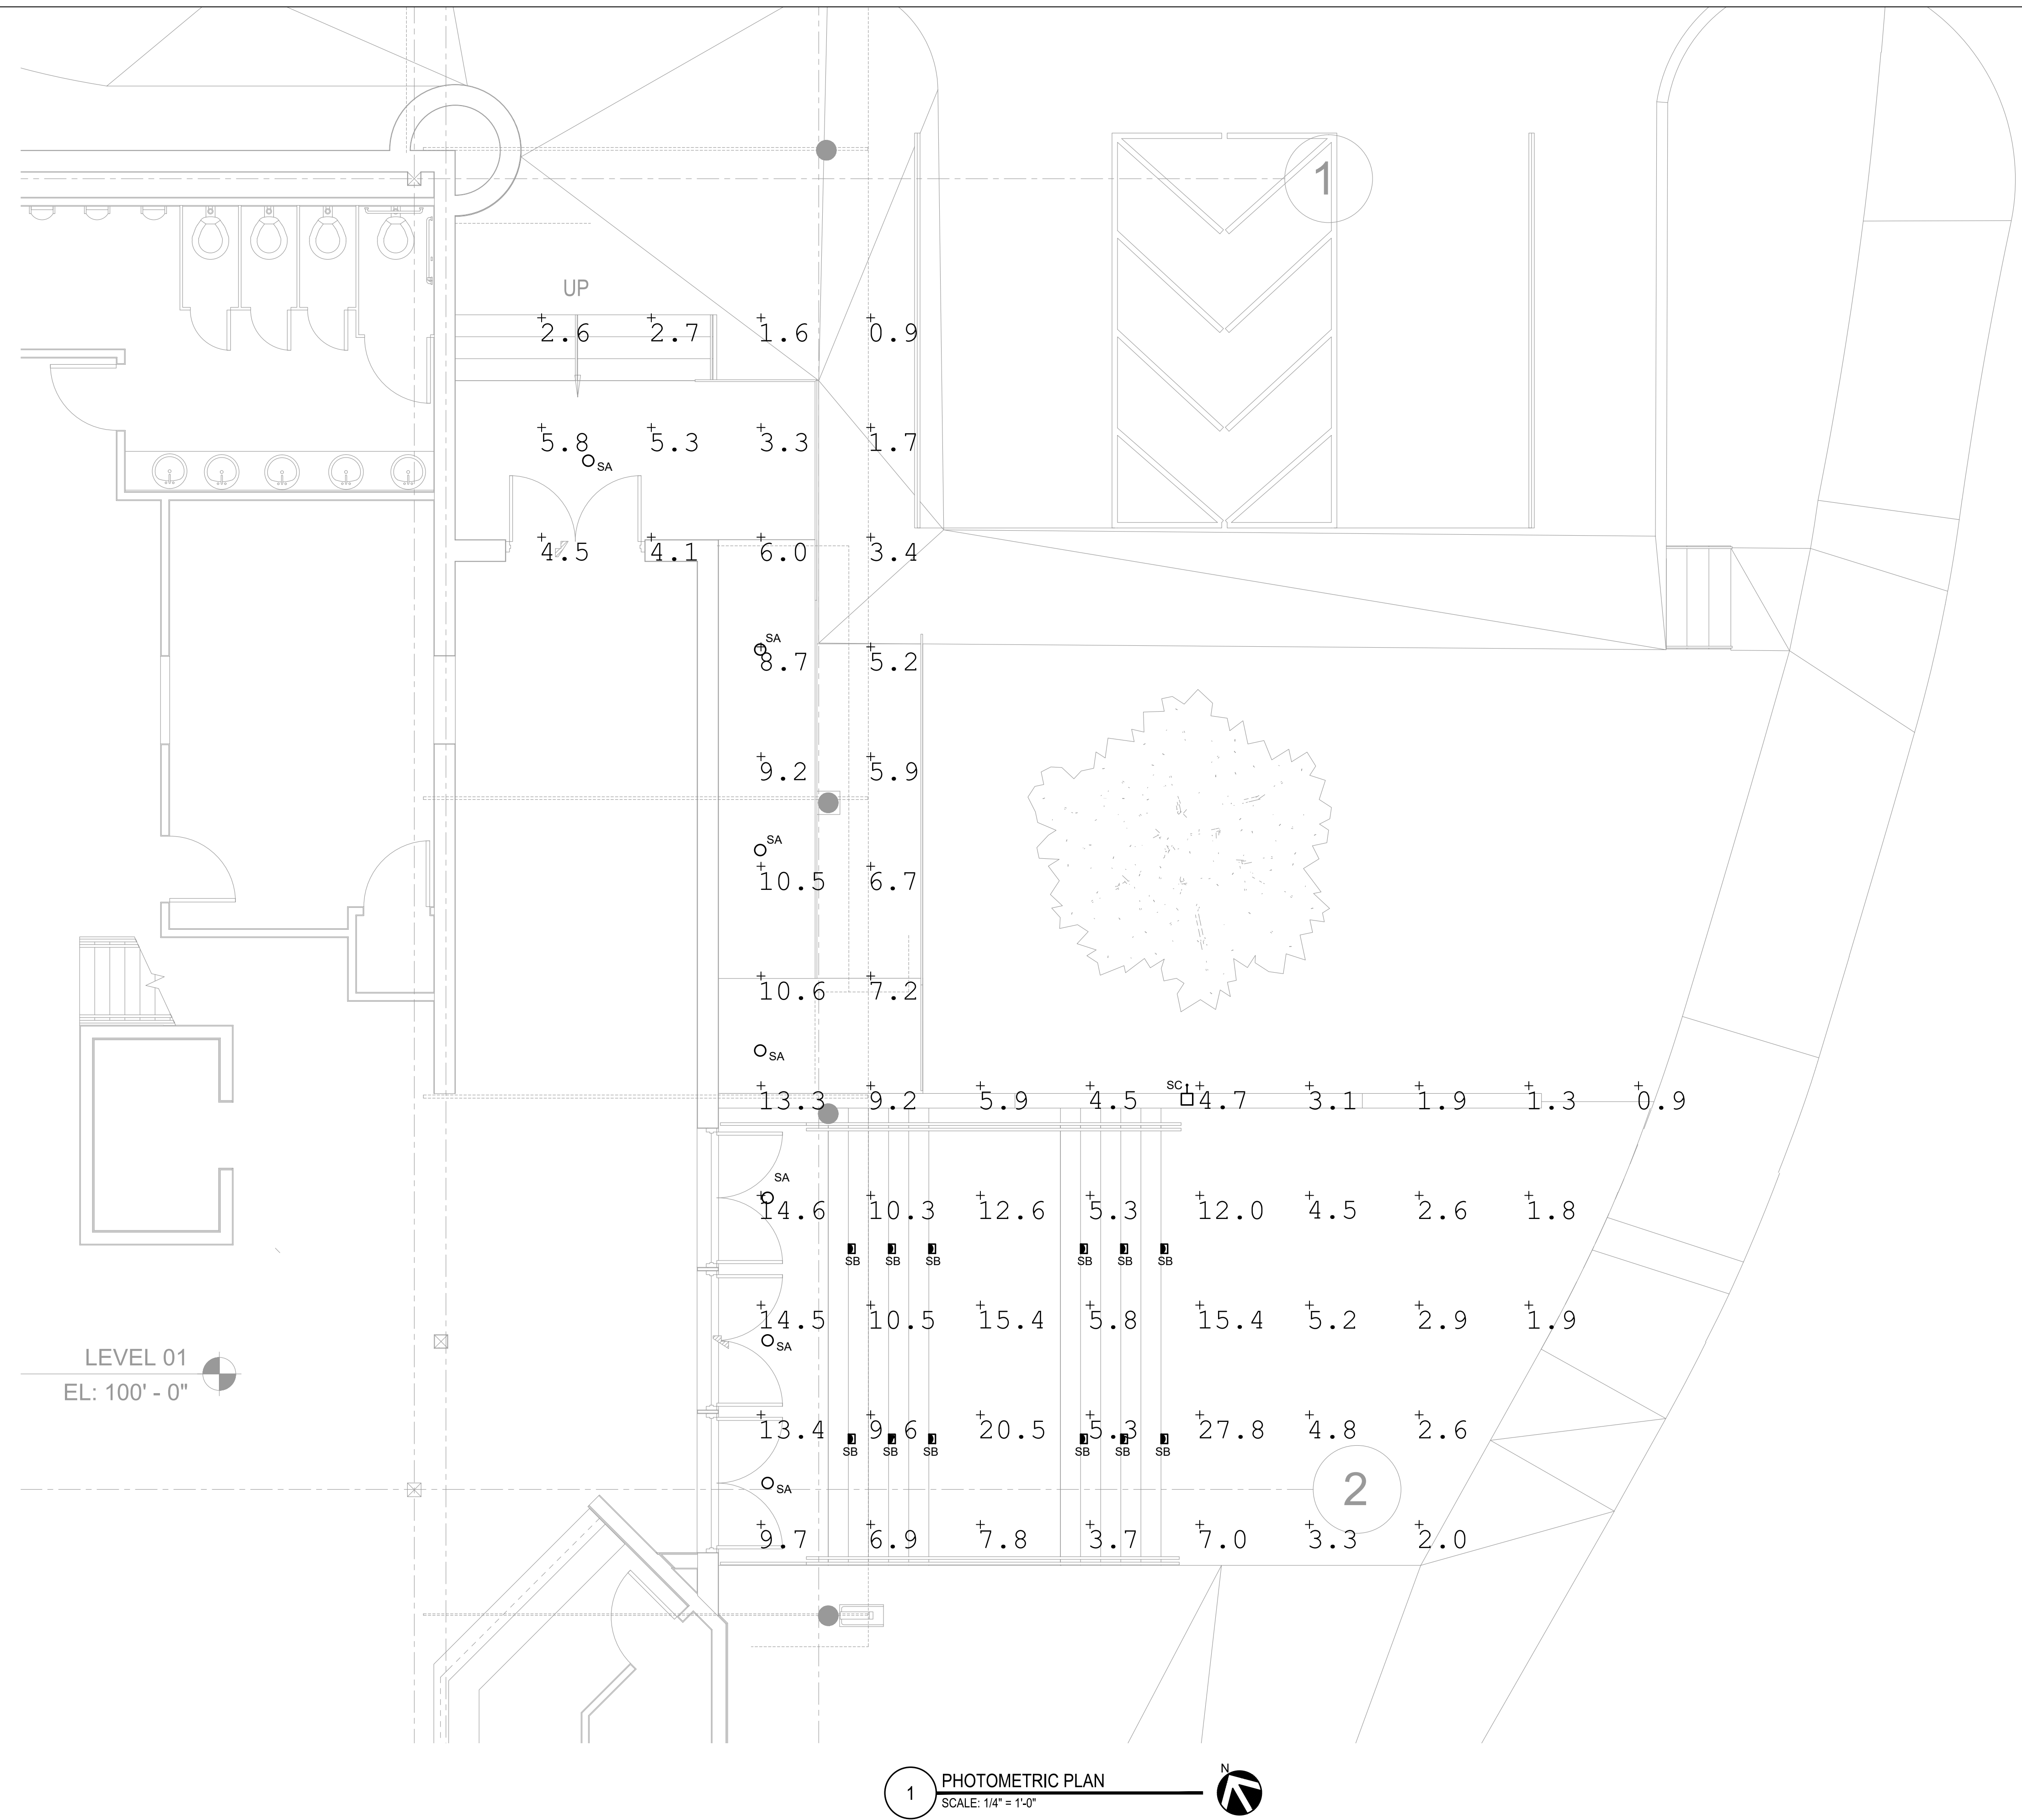








PLAN LEGEND:	PLAN NOTES:
<div><div>-----</div>ELEMENTS OVERHEAD</div> <div><div>---</div>OPEN TO ABOVE / BELOW / BEYOND</div> <div><div>█</div>EXISTING WALLS AND ELEMENTS TO REMAIN</div> <div><div>▒</div>EXISTING WALLS AND ELEMENTS TO BE DEMOLISHED</div> <div><div>▬</div>EXISTING WALL OPENING TO BE INFILLED AS NOTED</div> <div><div>—</div>NEW WALL, FULL HEIGHT</div>	<div>1. RE: STRUCTURAL FOR FOUNDATION WALL DIMENSIONS</div> <div>2. TYP INTERIOR DIMS: TAKEN FROM FACE OF FINISH (UON)</div> <div>3. TYP EXTERIOR DIMS: ALL GLASS ENTRIES - DIMS TO SYSTEM CL LEVEL 01 STOREFRONT - DIMS TO EXT FO FRAME (NOT INCLUDING EXTENDED MULLION CAP) LEVEL 02 CURTAIN WALL - DIMS TO EXT FO GLASS CLERESTORY - DIMS TO EXT FO FRAME STONE RAINSCREEN - DIMS TO EXT FO STONE</div> <div>4. CONTRACTOR SHALL PROVIDE SLIP JOINTS AT ALL PARTITIONS AND PARTITION BRACES ATTACHED TO ROOF AND/OR WALL STRUCTURAL ASSEMBLIES</div> <div>5. DOOR OPENINGS NOT LOCATED BY DIMENSION SHALL BE LOCATED 4" FROM THE FINISHED WALL OR PARTITION TO OUTSIDE FACE OF FINISHED JAMB.</div> <div>6. THE CONTRACTOR SHALL PROVIDE AND INSTALL A CONTINUOUS COMPRESSIBLE JOINT FILLER AT THE INTERIOR SLAB / GRADE PERIMETER AND AT INTERIOR COLUMN BLOCK-OUTS; 1/2" WIDTH.</div> <div>7. ALL SLAB ON GRADE JOINTS, INCLUDING SLAB PERIMETER JOINTS, SHALL BE FILLED WITH SEALANT</div> <div>8. REFER TO A-500 FOR WALL DETAILS</div> <div>9. REFER TO A-501 FOR ALL SCHEDULES</div>

DATE:	
REVISIONS:	

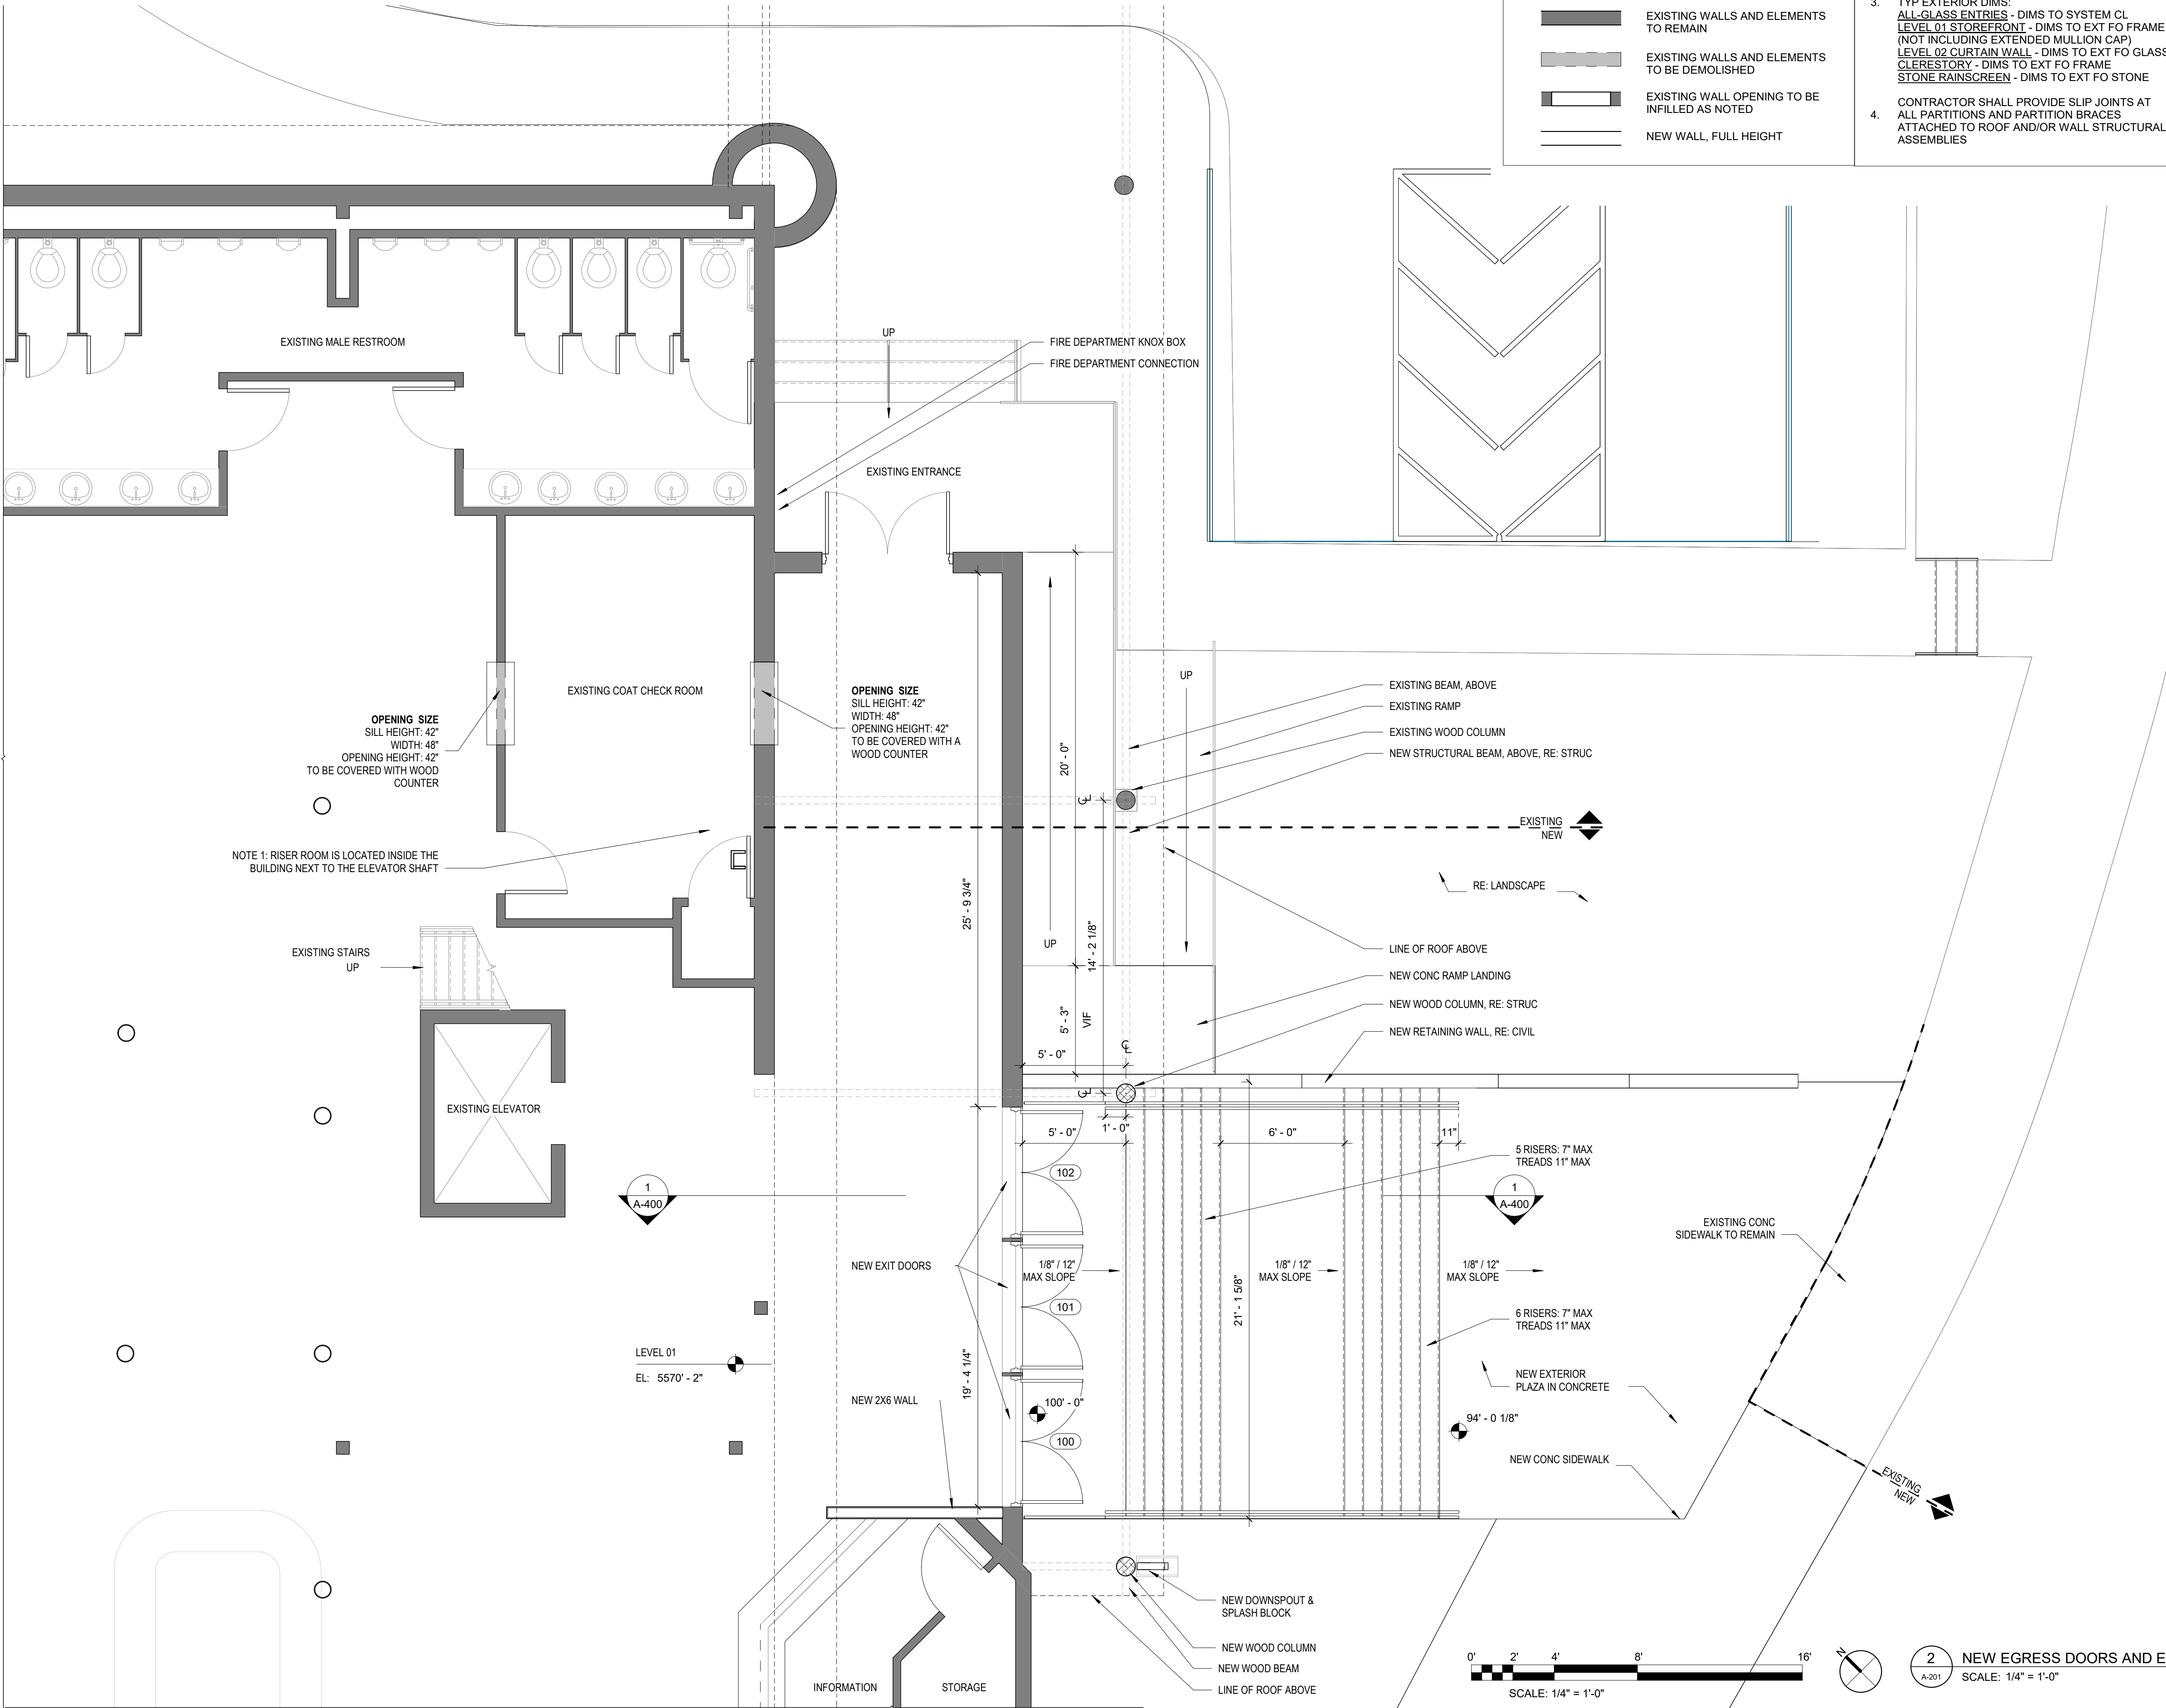

STAMPEDE NEW EXIT DOORS, EXTERIOR PLAZA  
AMD CHANGE OF OCCUPANCY  
2430 S HAVANA ST.  
AURORA, CO. 80034

DRAWN BY: GL  
CHECKED BY: JE  
DATE: 04/04/24  
EG #  
CAD FILE:  
DIR:

PERMIT SET



LEVEL 01 -  
FLOOR PLAN

A-201

2 NEW EGRESS DOORS AND EXTERIOR PLAZA FLOOR PLAN  
SCALE: 1/4" = 1'-0"



Please remove this sheet.

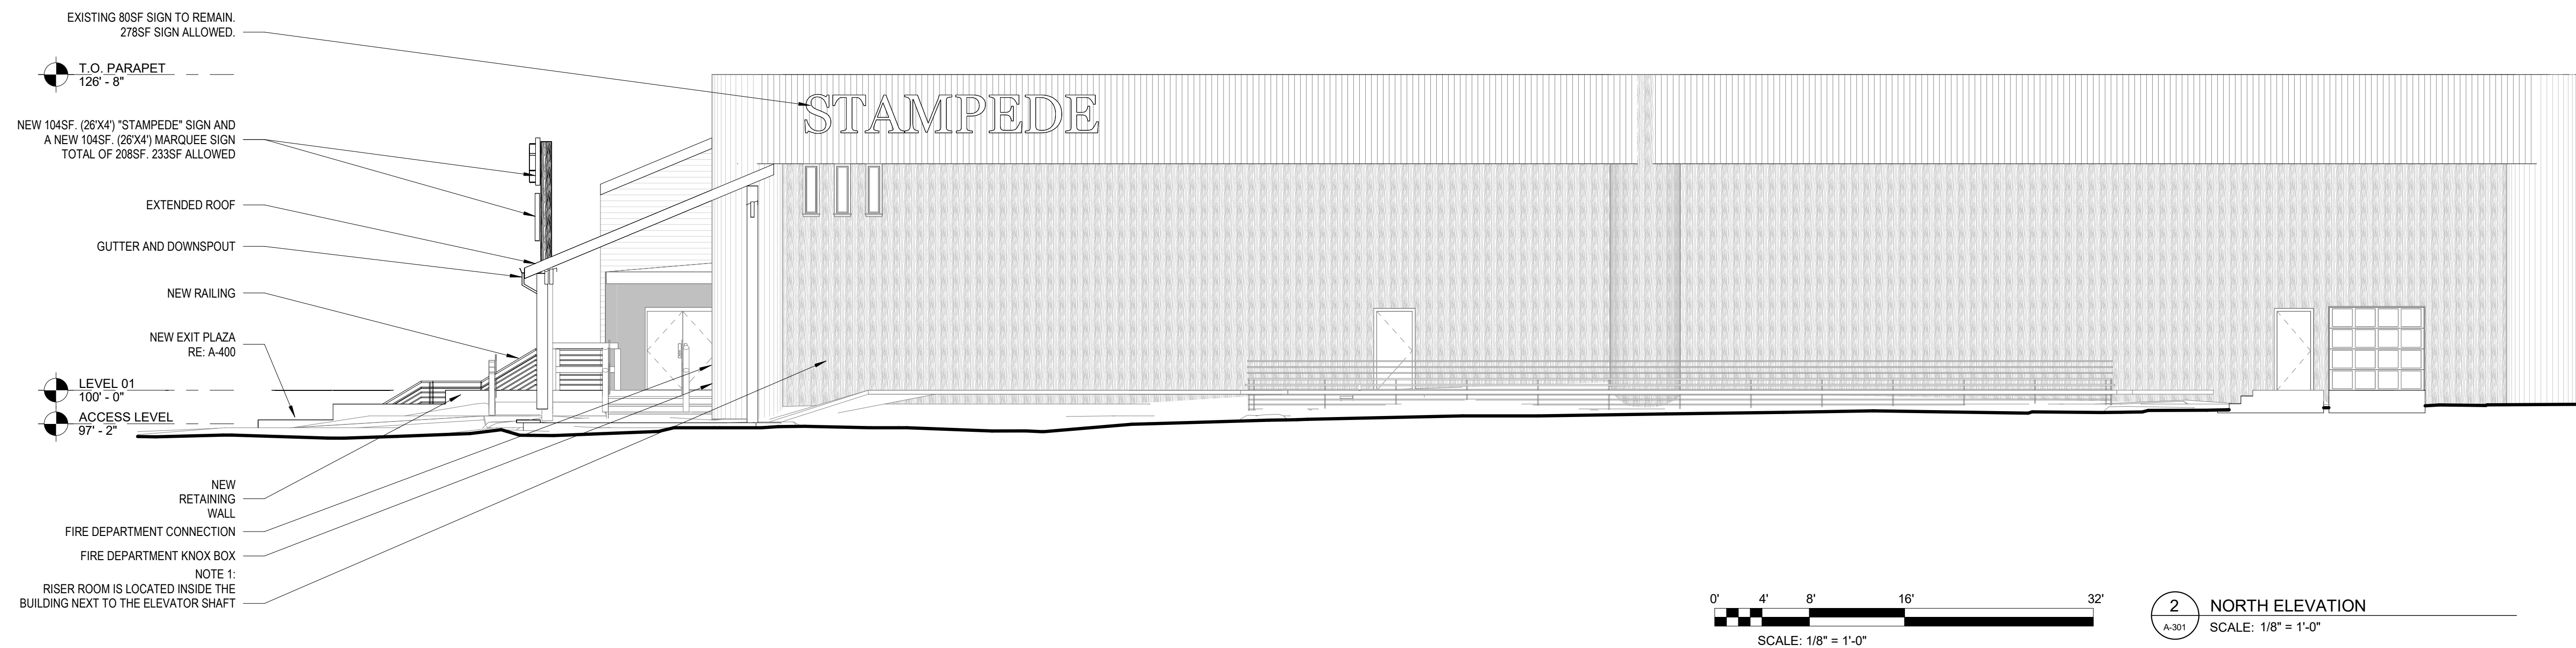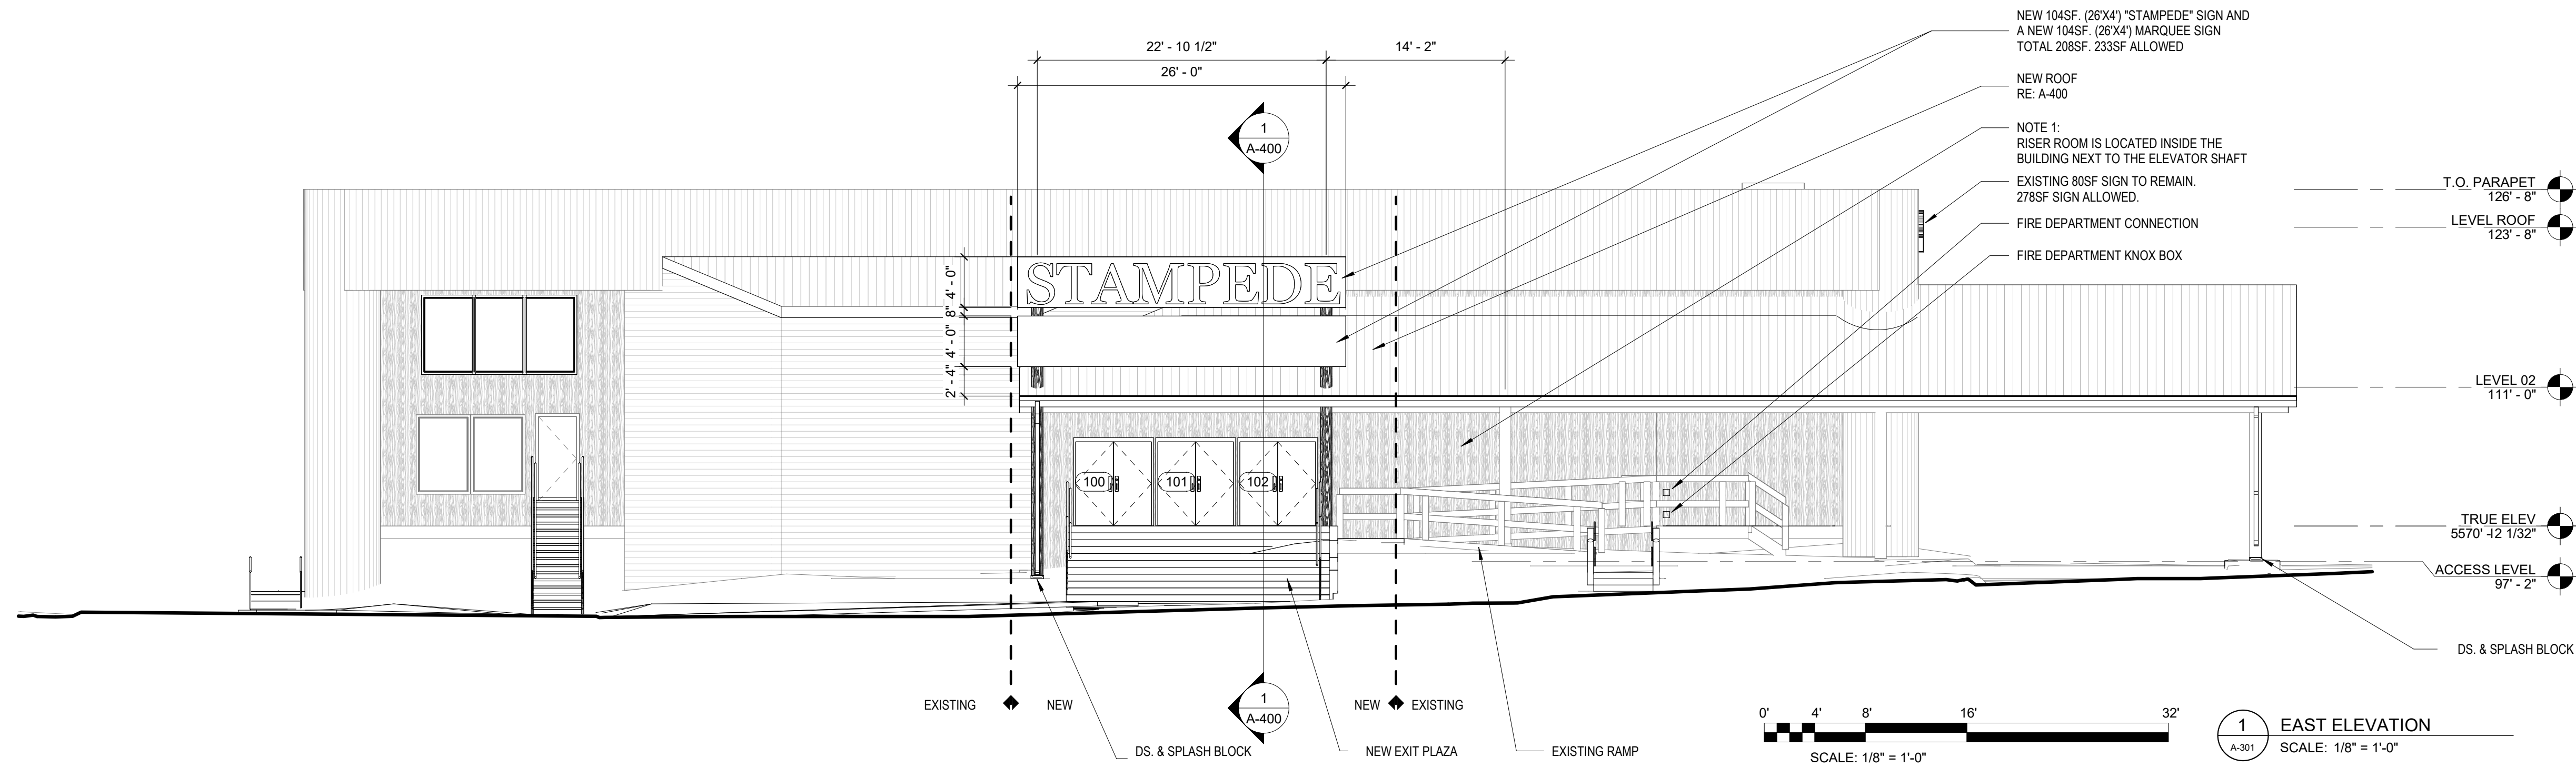

DATE:

REVISIONS:

STAMPEDE NEW EXIT DOORS, EXTERIOR PLAZA  
AMD CHANGE OF OCCUPANCY  
2430 S HAVANA ST.  
AURORA, CO. 80034

DRAWN BY: GL  
CHECKED BY: JE  
DATE: 04/04/24  
EG #  
CAD FILE:  
DIR:

PERMIT SET

EXTERIOR  
ELEVATIONS

A-301