


NATURAL GAS & CRUDE OIL PIPELINE GATHERING SYSTEM
AS-BUILT SITE PLAN



SECTIONS 19, 20, 29, 30, 32, 33, & 34, TOWNSHIP 3 SOUTH, RANGE 64 WEST, SECTIONS 13,15, 22, 23, 24, 25, 26, 27, 28, 33, & 34, TOWNSHIP 3 SOUTH, RANGE 65 WEST, OF THE SIXTH PRINCIPAL MERIDIAN, CITY OF AURORA, ADAMS COUNTY, STATE OF COLORADO
SECTIONS 3, 15, 17, 20, 21, 22, 25, 26, 27 & 28, TOWNSHIP 4 SOUTH, RANGE 65 WEST, SECTIONS 18, 19 & 30, TOWNSHIP 4 SOUTH, RANGE 64 WEST OF THE SIXTH PRINCIPAL MERIDIAN, CITY OF AURORA, ARAPAHOE COUNTY, STATE OF COLORADO

- AS-BUILT SITE PLAN NOTES:
- 1. TOTAL LENGTH OF GATHERING SYSTEM = 34 MILES.
  - 2. ALL INTERESTED PARTIES ARE HEREBY ALERTED THAT THIS SITE PLAN IS SUBJECT TO ADMINISTRATIVE CHANGES AND AS SHOWN ON THE ORIGINAL SITE PLAN ON FIELD IN THE AURORA CITY PLANNING OFFICE AT THE MUNICIPAL BUILDING. A COPY OF THE OFFICIAL CURRENT PLAN MAY BE PURCHASED THERE. LIKEWISE, SITE PLANS ARE REQUIRED TO AGREE WITH THE APPROVED SUBDIVISION PLAT OF RECORD AT THE TIME OF A BUILDING PERMIT, AND IF NOT MUST BE AMENDED TO AGREE WITH THE PLAT AS NEEDED, OR VICE VERSA.
  - 3. ERRORS IN APPROVED SITE PLANS RESULTING FROM COMPUTATIONS OF INCONSISTENCIES IN THE DRAWINGS MADE BY THE APPLICANT ARE THE RESPONSIBILITY OF THE APPLICANT OF RECORD. WHERE FOUND, THE CURRENT MINIMUM CODE REQUIREMENTS WILL APPLY AT THE TIME OF BUILDING PERMIT. PLEASE BE SURE THAT ALL PLAN COMPUTATIONS ARE CORRECT.
  - 4. ALL REPRESENTATIONS AND COMMITMENTS MADE BY APPLICANT AT PUBLIC HEARINGS, REGARDING THIS PLAN, ARE BINDING UPON THE APPLICANT, AND ITS HEIRS, SUCCESSORS, AND ASSIGNS.
  - 5. THE CITY OF AURORA REQUIRES PLAN AND PROFILES (P&P) OF THE PROPOSED PIPELINE AT CITY OF AURORA RIGHTS-OF-WAY AND EASEMENTS WITH ALL LICENSE AGREEMENTS AND CIVIL PLAN SUBMITTALS. THE P&PS SHALL SHOW ALL EXISTING AND KNOWN PROPOSED UTILITIES WITH VERIFIED ELEVATIONS BASED ON PRE-DESIGN POT-HOLING AND DEMONSTRATE THE REQUIRED MINIMUM HORIZONTAL AND VERTICAL UTILITY CLEARANCES ARE BEING MET.
  - 6. AS-BUILT DRAWINGS SHALL BE PROVIDED TO THE CITY OF AURORA WITHIN 30 DAYS OF FINAL CONSTRUCTION IN A FORMAT THAT MEETS THE LATEST CITY OF AURORA CAD DATA SUBMITTAL STANDARDS.
  - 7. PIPELINES CONSTRUCTED THROUGH COLLECTORS OR LOCALS SHALL PROVIDE 15' OF COVER MINIMUM, UNLESS OTHERWISE STATED ON PLANS. IF A CROSSING WILL NOT MEET MINIMUM COVER, A VARIANCE REQUEST WILL BE REQUIRED.
  - 8. PIPELINES CONSTRUCTED THROUGH ARTERIALS SHALL PROVIDE 20' OF COVER MINIMUM, UNLESS OTHERWISE STATED ON PLANS. IF A CROSSING WILL NOT MEET MINIMUM COVER, A VARIANCE REQUEST WILL BE REQUIRED.
  - 9. DISTURBED GROUND TO BE RETURNED TO EXISTING ELEVATIONS.
  - 10. IN THE EVENT GROUNDWATER IS ENCOUNTERED DURING PIPELINE CONSTRUCTION, CONTRACTOR SHALL NOTIFY THE CITY OF AURORA AND BE PREPARED TO REPORT THE LOCATION AND DEPTH OF THE GROUNDWATER. ADDITIONALLY, IF DEWATERING OF THE TRENCH IS NECESSARY, A DEWATERING PERMIT FROM COLORADO DEPARTMENT OF PUBLIC HEALTH AND ENVIRONMENT MAY BE REQUIRED.
  - 11. A FLOODPLAIN DEVELOPMENT PERMIT IS REQUIRED FOR ALL WORK WITHIN A FEMA DESIGNATED FLOODPLAIN.
  - 12. UPON REMOVING A GATHERING SYSTEM OR FLOWLINE FROM SERVICE, ALL SEGMENTS MUST BE REMOVED OR ABANDONED IN PLACE USING FLOWFILL OR SIMILAR.
  - 13. ALL AMENDMENTS TO THIS SITE PLAN SHALL UTILIZE EASEMENTS THAT DO NOT SIGNIFICANTLY ENCUMBER CURBSIDE LANDSCAPING OR STREET FRONTAGE LANDSCAPE BUFFERS FOR FUTURE DEVELOPMENTS. THIS CAN BE DONE BY EITHER LOCATING ALL EASEMENTS OUTSIDE OF THESE IDENTIFIED AREAS OR INCLUDING EASEMENT LANGUAGE THAT ALLOWS SUFFICIENT PLANTINGS (AS DETERMINED BY THE CITY LANDSCAPE ARCHITECT) TO BE INSTALLED WITHIN EASEMENTS.
  - 14. THE GATHERING SYSTEM AND FLOWLINE WILL NOT HAVE ANY UNDUE ADVERSE EFFECTS ON EXISTING AND FUTURE DEVELOPMENT OF THE SURROUNDING AREA AS SET FORTH IN APPLICABLE CITY MASTER PLANS. THE DESIGN OF THE PROPOSED GATHERING SYSTEM AND FLOWLINE MITIGATES NEGATIVE IMPACTS ON THE SURROUNDING AREA TO THE GREATEST EXTENT FEASIBLE. THE DISTURBED AREA SHALL BE MAINTAINED DURING CONSTRUCTION BY THE APPLICANT OR PROPERTY OWNER IN SUCH A MANNER TO CONTROL SOIL EROSION, DUST AND THE GROWTH OF NOXIOUS WEEDS.

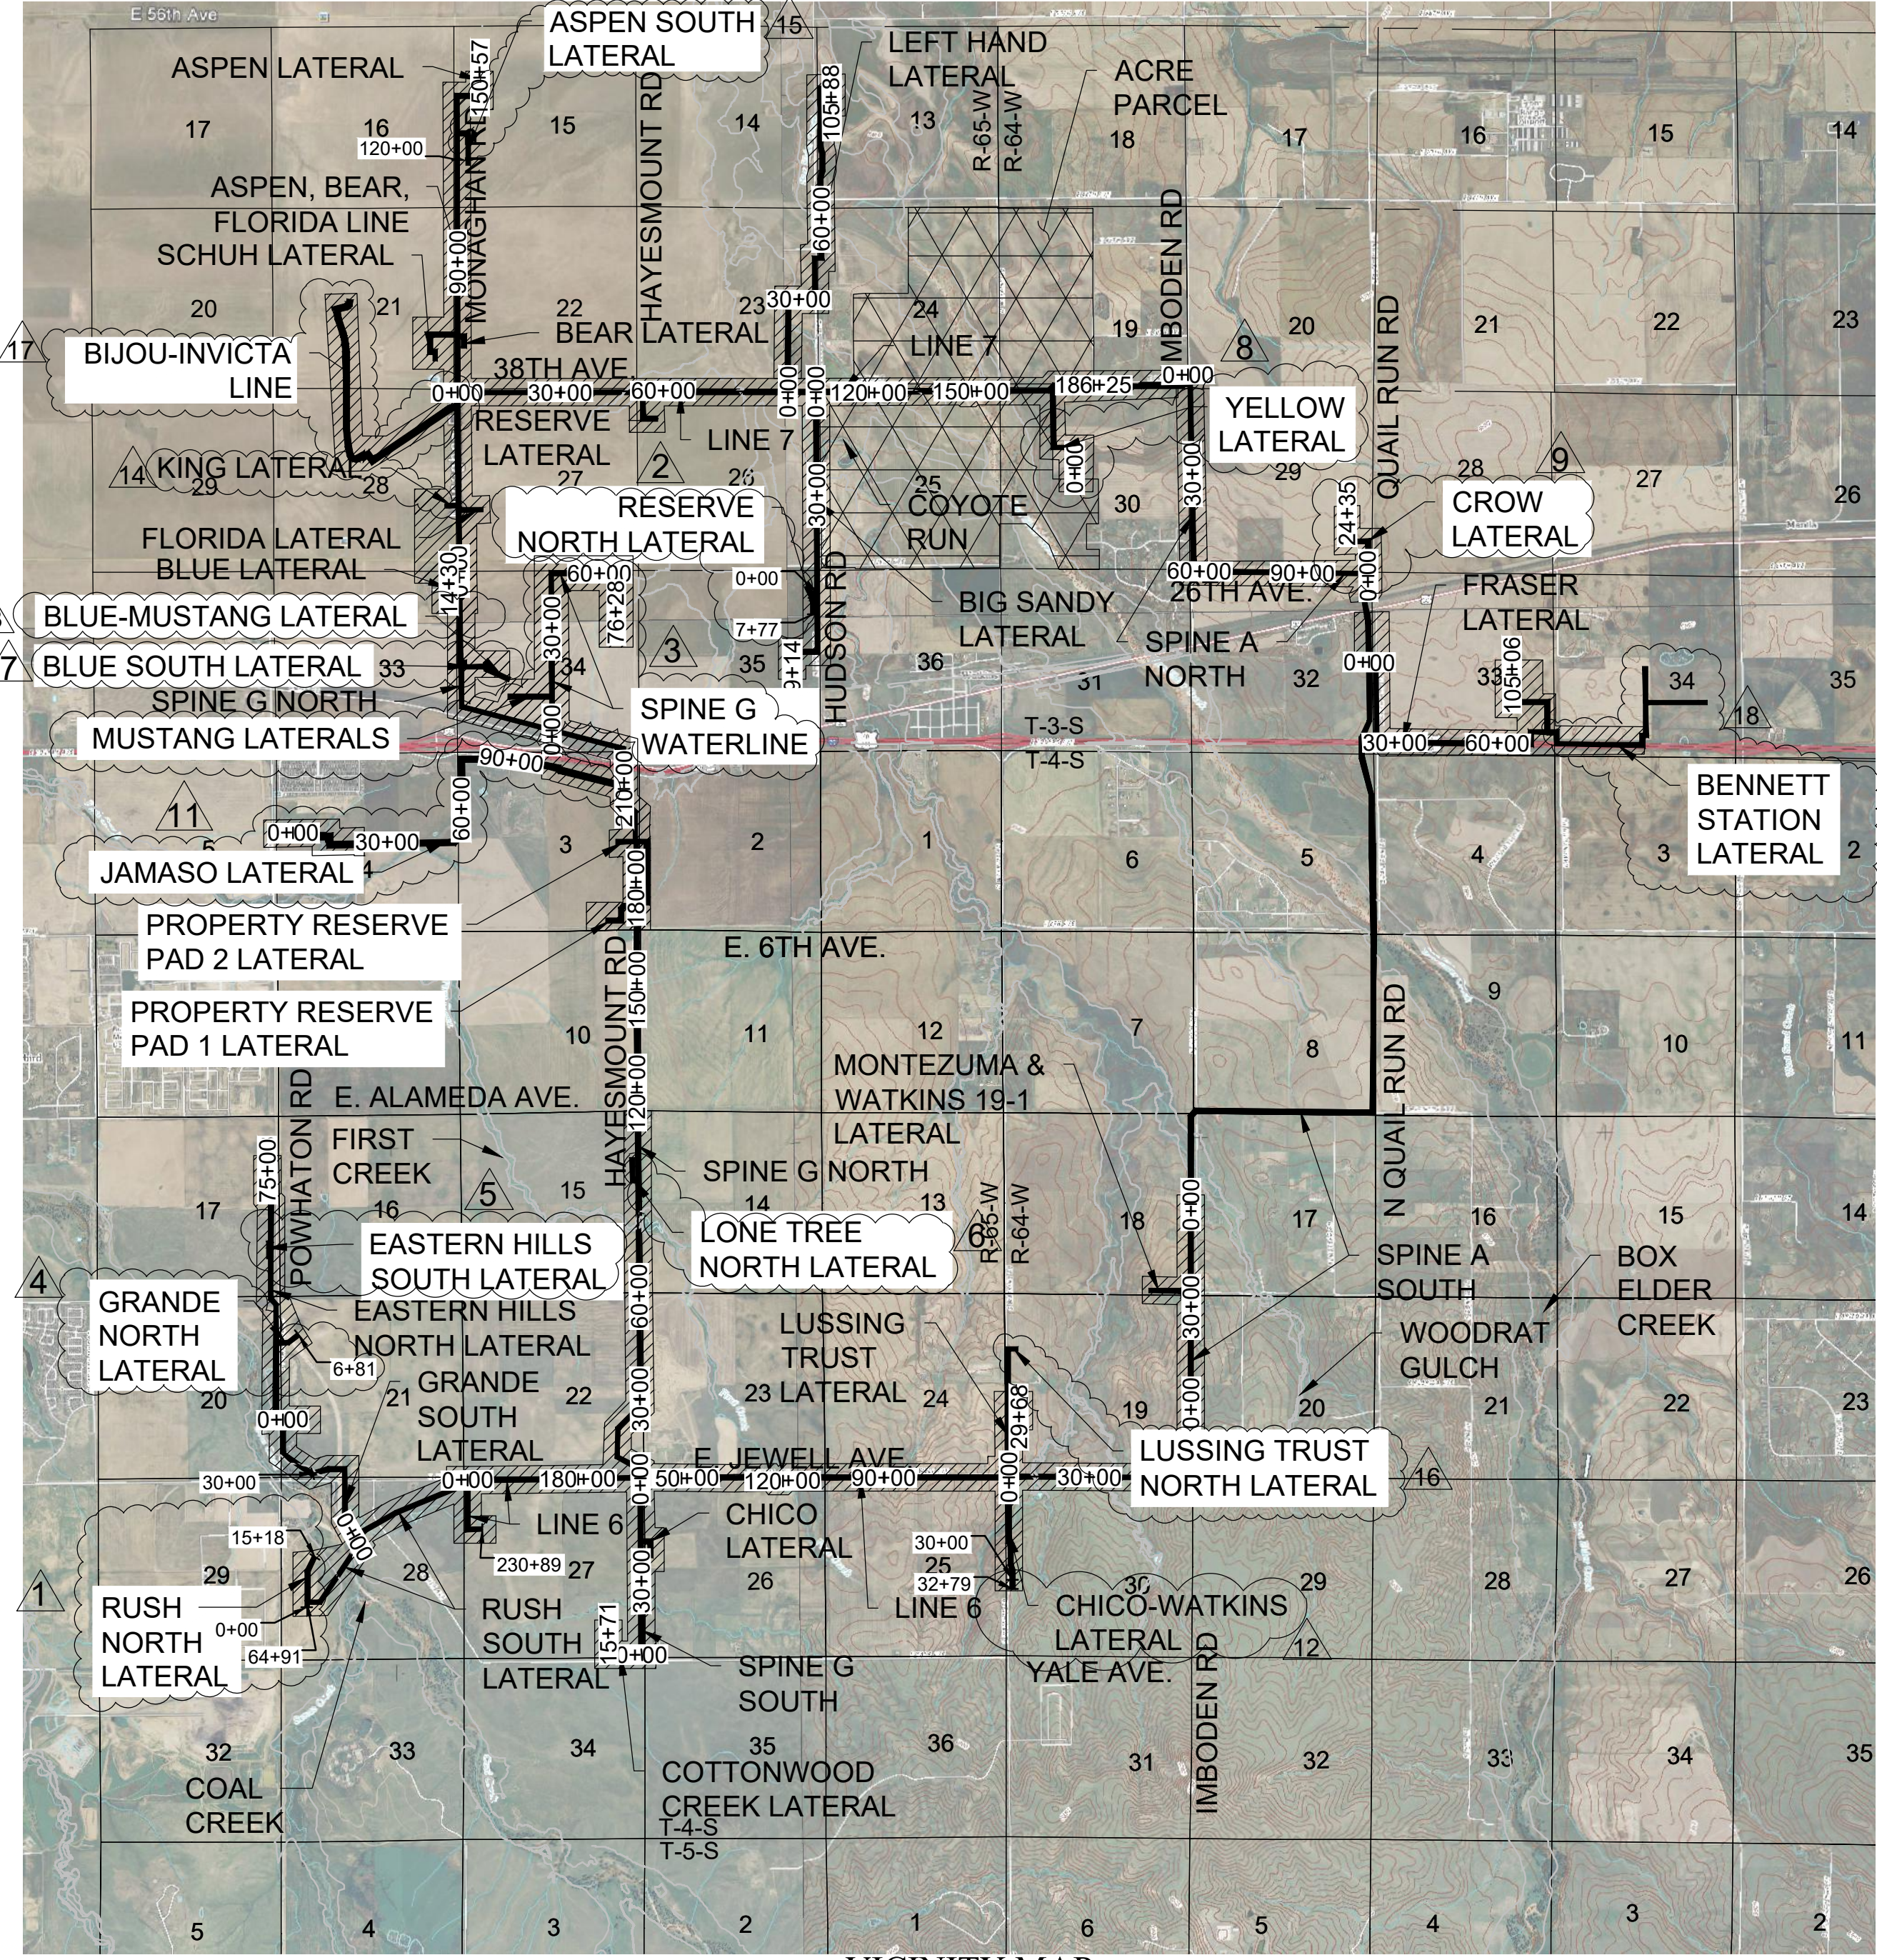

VICINITY MAP
SCALE: 1" = 4,000 FT.

- 1 - COVER SHEET
2 - CITY OF AURORA LIMITS & ZONING
3 - CITY OF AURORA NEIGHBORHOOD MAP
4 - APPURTENANCE SITE & FEMA FLOODPLAIN MAP
5 - SPINE A SOUTH 0+00 TO 80+61, LINE 6 0+00 TO 2+50, WATKINS 19-1 LATERAL & MONTEZUMA LATERAL
6 - LINE 6 2+50 TO 137+50, LUSSING TRUST LATERAL 0+00 TO 2+50, & WATKINS 30-5 LATERAL 0+00 TO 2+50
7 - LUSSING TRUST LATERAL 5+00 TO 29+68 & CHICO-WATKINS LATERAL 2+50 TO 32+79
8 - LINE 6 137+50 TO 230+89 & RUSH SOUTH LATERAL 0+00 TO 4+50
9 - RUSH SOUTH LATERAL 4+50 TO 52+50 & GRANDE SOUTH LATERAL 0+00 TO 5+00 & RUSH NORTH LATERAL 0+00 TO 4+50
10 - GRANDE SOUTH LATERAL 5+00 TO 50+42 & EASTERN HILLS NORTH LATERAL 5+50 TO 27+50
11 - EASTERN HILLS NORTH LATERAL 27+50 TO 75+58 & EASTERN HILLS SOUTH LATERAL
12 - SPINE G SOUTH 2+00 TO 51+35, CHICO LATERAL, & COTTONWOOD CREEK LATERAL 0+00 TO 15+71
13 - SPINE G NORTH 2+00 TO 101+50, SUNSET GRIMM MOTOCROSS LATERAL, & LONE TREE NORTH LATERAL
14 - SPINE G NORTH 101+50 TO 222+50, PROPERTY RESERVE PAD 1 LATERAL, & PROPERTY RESERVE PAD 2 LATERAL
15 - SPINE G NORTH 222+50 TO 303+05 BLUE LATERAL 0+00 TO 14+30, ASPEN, BEAR, FLORIDA LINE 0+00 TO 1+50, & SPINE G WATERLINE/MUSTANG STATION LATERALS
16 - ASPEN, BEAR, FLORIDA LINE 1+50 TO 56+50, KING LATERAL, FLORIDA LATERAL, & LINE 7 0+00 TO 2+00 & BIJOU LATERAL 0+00 TO 3+00
17 - ASPEN, BEAR, FLORIDA LINE 56+50 TO 127+50, SCHUH LATERAL, & BEAR LATERAL
18 - ASPEN, BEAR, FLORIDA LINE 127+50 TO 150+57 & LINE 7 2+00 TO 50+50
19 - LINE 7 50+50 TO 118+50, RESERVE LATERAL, LEFT HAND LATERAL 0+00 TO 3+50, & BIG SANDY LATERAL 0+00 TO 4+50
20 - LINE 7 118+50 TO 186+25 & LEFT HAND LATERAL 3+50 TO 31+50
21 - LEFT HAND LATERAL 31+50 TO 105+88
22 - BIG SANDY LATERAL 4+50 TO 89+14 & RESERVE NORTH LATERAL 0+00 TO 7+77
23 - SPINE A NORTH 0+00 TO 111+50 & CROW LATERAL 0+00 TO 2+50
24 - SPINE A NORTH 111+50 TO 135+81 & FRASER LATERAL 0+00 TO 72+50
25 - FRASER LATERAL 72+50 TO 105+06
26 - CITY OF AURORA FUTURE ROW CROSS SECTIONS
27 - RUSH NORTH LATERAL 4+50 TO 15+18
28 - SPINE G WATERLINE & MUSTANG STATION LATERALS
29 - GRANDE NORTH LATERAL 1+50 TO 6+81
30 - BLUE SOUTH LATERAL 0+00 TO 8+89
31 - YELLOW LATERAL 0+00 TO 19+50
32 - CROW LATERAL 2+50 TO 24+35
33 - JAMASO LATERAL 0+00 TO 26+00 & 100+00 TO 124+90
34 - ASPEN SOUTH LATERAL
35 - LUSSING TRUST NORTH LATERAL
36 - BIJOU-INVICTA LINE STA 3+00 TO 38+00
37 - BIJOU-INVICTA LINE STA 38+00 TO 86+60
38 - BENNETT STATION LATERAL STA 3+50 TO 34+40

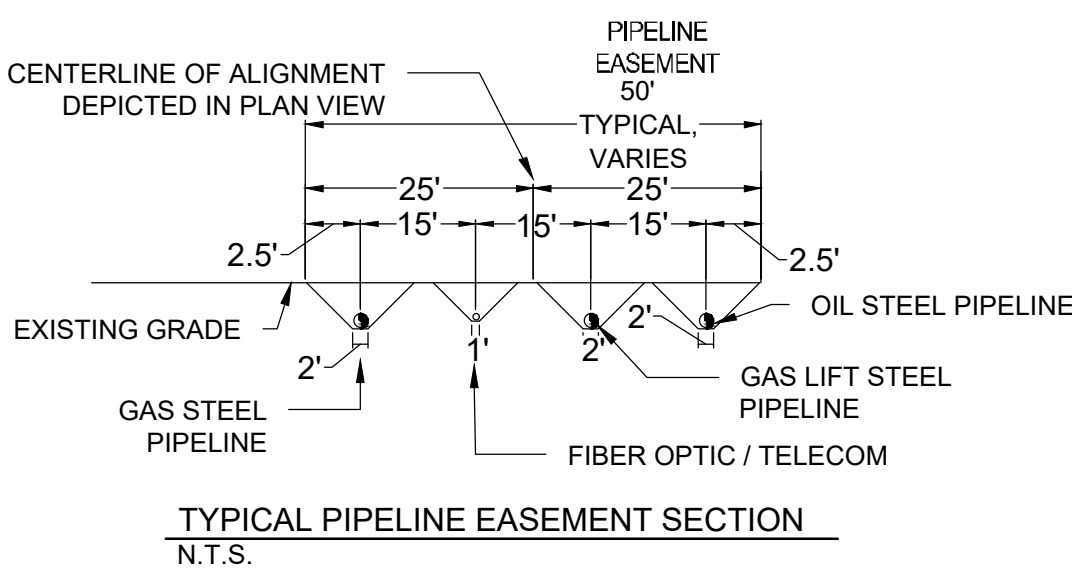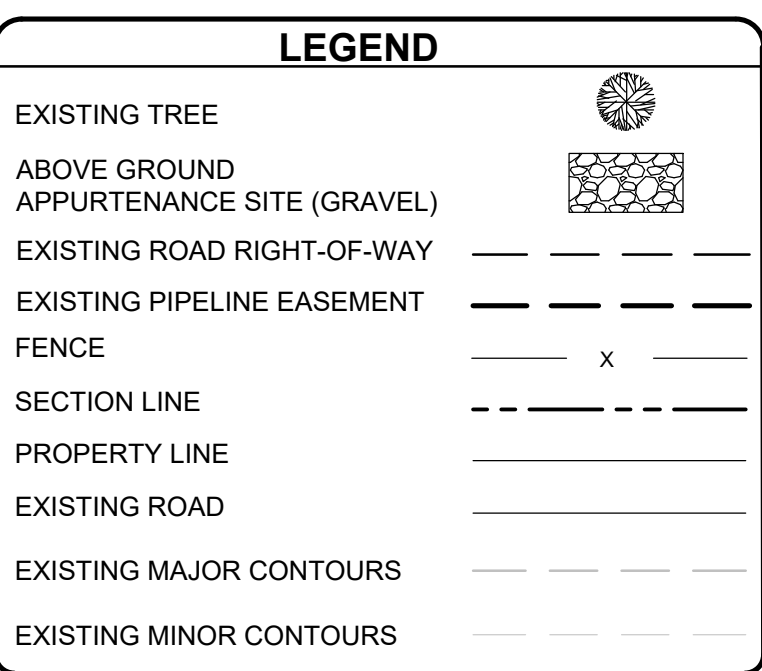

- AMENDMENTS:
- 1: 02/08/2021 - RUSH NORTH LATERAL (1,500 FEET)
  - 2: 02/09/2021 - RESERVE NORTH LATERAL (800 FEET)
  - 3: 05/04/2021 - SPINE G WATERLINE (6,930 FEET) & MUSTANG STATION LATERALS (2,250 FEET)
  - 4: 08/10/2021 - GRANDE NORTH LATERAL (685 FEET)
  - 5: 10/25/2021 - EASTERN HILLS SOUTH LATERAL (550 FEET)
  - 6: 10/26/2021 - LONE TREE NORTH LATERAL (130 FEET)
  - 7: 11/12/2021 - BLUE SOUTH LATERAL (900 FEET)
  - 8: 11/13/2021 - YELLOW LATERAL (1,850 FEET)
  - 9: 02/04/2022 - CROW LATERAL (2,500 FEET)
  - 10: 03/23/2022 - ADDITION OF CRUDE OIL ON THE TITLE/BORDER
  - 11: 10/13/2022 - JAMASO LATERAL (12,440 FEET)
  - 12: 03/29/2024 - CHICO-WATKINS LATERAL (710 FEET)
  - 13: 04/05/2024 - BLUE-MUSTANG LATERAL (740 FEET)
  - 14: 07/10/2024 - KING LATERAL MODIFICATION
  - 15: 09/09/2024 - ASPEN SOUTH LATERAL (930 FEET)
  - 16: 09/09/2024 - LUSSING TRUST NORTH LATERAL (1,976 FEET)
  - 17: 09/09/2024 - BIJOU-INVICTA LINE (8,660 FEET)
  - 18: 01/03/2025 - BENNETT STATION LATERAL (3,265 FEET)

NATURAL GAS & CRUDE OIL PIPELINE GATHERING SYSTEM
AS-BUILT SITE PLAN
CRESTONE PEAK RESOURCES MIDSTREAM LLC

THIS SITE PLAN AND ANY AMENDMENTS HERETO, UPON APPROVAL BY THE CITY OF AURORA AND RECORDING, SHALL BE BINDING UPON THE APPLICANTS THEREFORE, THEIR SUCCESSORS AND ASSIGNS. THIS PLAN SHALL LIMIT AND CONTROL THE ISSUANCE AND VALIDITY OF ALL BUILDING PERMITS, AND SHALL RESTRICT AND LIMIT THE CONSTRUCTION, LOCATION, USE, OCCUPANCY AND OPERATION OF ALL LAND AND STRUCTURES WITHIN THIS PLAN TO ALL CONDITIONS, REQUIREMENTS, LOCATIONS AND LIMITATIONS SET FORTH HEREIN. ABANDONMENT, WITHDRAWAL OR AMENDMENT OF THIS PLAN MAY BE PERMITTED ONLY UPON APPROVAL OF THE CITY OF AURORA.

IN WITNESS WHEREOF, \_\_\_\_\_ HAS CAUSED THESE
(CORPORATION, COMPANY, OR INDIVIDUAL)

PRESENTS TO BE EXECUTED THIS \_\_\_\_\_ DAY OF \_\_\_\_\_ AD. 20\_\_\_\_.

BY: \_\_\_\_\_
(PRINCIPALS OR OWNERS)

STATE OF \_\_\_\_\_, JSS

COUNTY OF \_\_\_\_\_

THE FOREGOING INSTRUMENT WAS ACKNOWLEDGED BEFORE ME THIS \_\_\_\_\_ DAY OF \_\_\_\_\_ AD, 20\_\_\_\_ BY

(PRINCIPALS OR OWNERS)

WITNESS MY HAND AND SEAL

(NOTARY PUBLIC)

MY COMMISSION EXPIRES: \_\_\_\_\_

NOTARY BUSINESS ADDRESS: \_\_\_\_\_

CITY OF AURORA APPROVALS

CITY ATTORNEY: \_\_\_\_\_ DATE: \_\_\_\_\_
PLANNING DIRECTOR: \_\_\_\_\_ DATE: \_\_\_\_\_
PLANNING COMMISSIONER: \_\_\_\_\_ DATE: \_\_\_\_\_
CITY COUNCIL: \_\_\_\_\_ DATE: \_\_\_\_\_
ATTEST: \_\_\_\_\_ DATE: \_\_\_\_\_
(CITY CLERK)
DATABASE APPROVAL DATE: \_\_\_\_\_

COUNTY RECORDATION

RECORDER'S CERTIFICATE:
ACCEPTED FOR FILING IN THE OFFICE OF THE CLERK AND RECORDER OF COLORADO AT \_\_\_\_\_ O'CLOCK \_\_\_\_\_ M, THIS \_\_\_\_\_ DAY OF \_\_\_\_\_ AD, \_\_\_\_\_.
CLERK AND RECORDER \_\_\_\_\_ DEPUTY: \_\_\_\_\_

NO.	DATE	BY	REVISIONS
1	02/08/2021	_____	COVER SHEET
2	02/09/2021	_____	RESERVE NORTH LATERAL (800 FEET)
3	05/04/2021	_____	SPINE G WATERLINE (6,930 FEET) & MUSTANG STATION LATERALS (2,250 FEET)
4	08/10/2021	_____	GRANDE NORTH LATERAL (685 FEET)
5	10/25/2021	_____	EASTERN HILLS SOUTH LATERAL (550 FEET)
6	10/26/2021	_____	LONE TREE NORTH LATERAL (130 FEET)
7	11/12/2021	_____	BLUE SOUTH LATERAL (900 FEET)
8	11/13/2021	_____	YELLOW LATERAL (1,850 FEET)
9	02/04/2022	_____	CROW LATERAL (2,500 FEET)
10	03/23/2022	_____	ADDITION OF CRUDE OIL ON THE TITLE/BORDER
11	10/13/2022	_____	JAMASO LATERAL (12,440 FEET)
12	03/29/2024	_____	CHICO-WATKINS LATERAL (710 FEET)
13	04/05/2024	_____	BLUE-MUSTANG LATERAL (740 FEET)
14	07/10/2024	_____	KING LATERAL MODIFICATION
15	09/09/2024	_____	ASPEN SOUTH LATERAL (930 FEET)
16	09/09/2024	_____	LUSSING TRUST NORTH LATERAL (1,976 FEET)
17	09/09/2024	_____	BIJOU-INVICTA LINE (8,660 FEET)
18	01/03/2025	_____	BENNETT STATION LATERAL (3,265 FEET)


Westwood
10333 E DRY CREEK RD.
ENGLEWOOD, CO 80150
TEL: 720.482.9526

CRESTONE PEAK RESOURCES MIDSTREAM LLC
ATTN: NATHAN BENNETT
5551 W. ST. STE 3700
PHOENIX, AZ 85043
PHONE: (303) 312-8166

NATURAL GAS & CRUDE OIL PIPELINE
GATHERING SYSTEM
AS-BUILT SITE PLAN
CRESTONE PEAK RESOURCES MIDSTREAM LLC
COVER SHEET


SCALE:
AS SHOWN
FILE NO:
DRAWN BY:
CHECKED BY:
DATE:
SHEET NUMBER
1



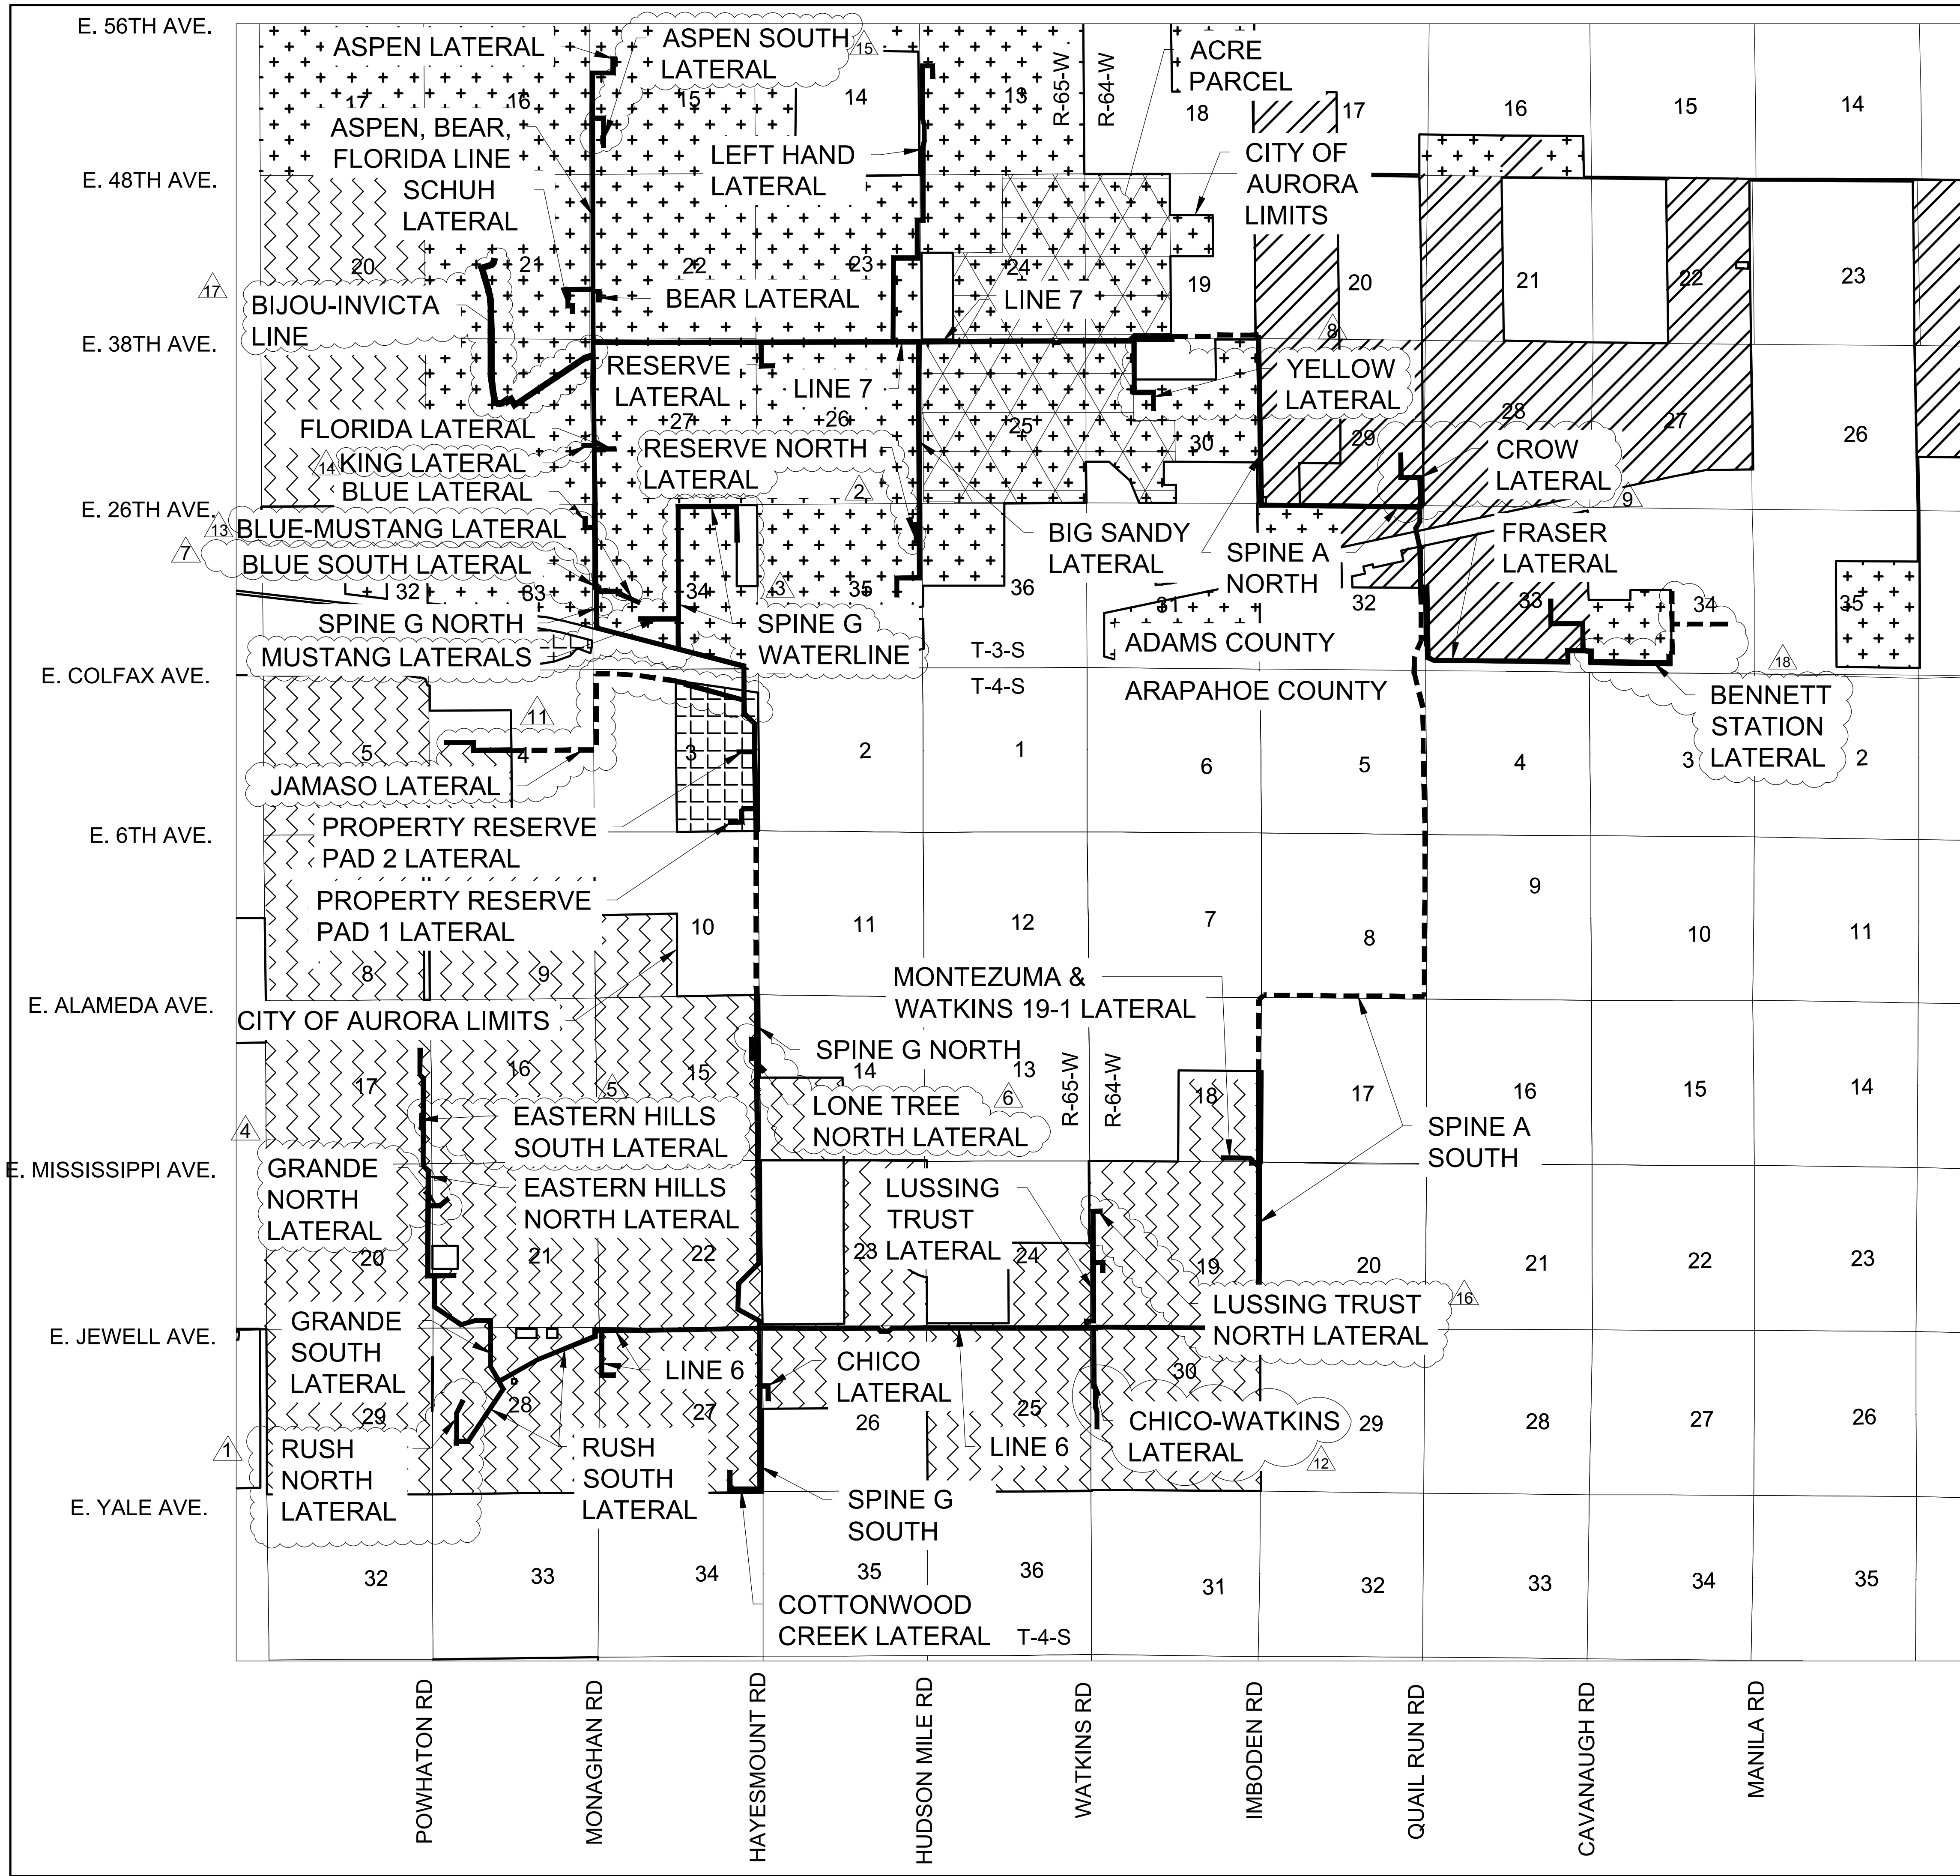

- LEGEND**
- PIPELINE WITHIN CITY OF AURORA LIMITS
  - PIPELINE OUTSIDE CITY OF AURORA LIMITS
  - MU-A - MIXED USE AIRPORT
  - AD - AIRPORT DISTRICT
  - I-2 - INDUSTRIAL DISTRICT
  - R-2 - MEDIUM-DENSITY RESIDENTIAL DISTRICT

- NOTES**
- ALL AMENDMENTS TO THIS SITE PLAN SHALL UTILIZE EASEMENTS THAT DO NOT SIGNIFICANTLY ENCUMBER CURBSIDE LANDSCAPING OR STREET FRONTAGE LANDSCAPE BUFFERS FOR FUTURE DEVELOPMENTS. THIS CAN BE DONE BY EITHER LOCATING ALL EASEMENTS OUTSIDE OF THESE IDENTIFIED AREAS OR INCLUDING EASEMENT LANGUAGE THAT ALLOWS SUFFICIENT PLANTINGS (AS DETERMINED BY THE CITY LANDSCAPE ARCHITECT) TO BE INSTALLED WITHIN EASEMENTS.
  - THE GATHERING SYSTEM AND FLOWLINE WILL NOT HAVE ANY UNDUE ADVERSE EFFECTS ON EXISTING AND FUTURE DEVELOPMENT OF THE SURROUNDING AREA AS SET FORTH IN APPLICABLE CITY MASTER PLANS. THE DESIGN OF THE PROPOSED GATHERING SYSTEM AND FLOWLINE MITIGATES NEGATIVE IMPACTS ON THE SURROUNDING AREA TO THE GREATEST EXTENT FEASIBLE. THE DISTURBED AREA SHALL BE MAINTAINED DURING CONSTRUCTION BY THE APPLICANT OR PROPERTY OWNER IN SUCH A MANNER TO CONTROL SOIL EROSION, DUST AND THE GROWTH OF NOXIOUS WEEDS.

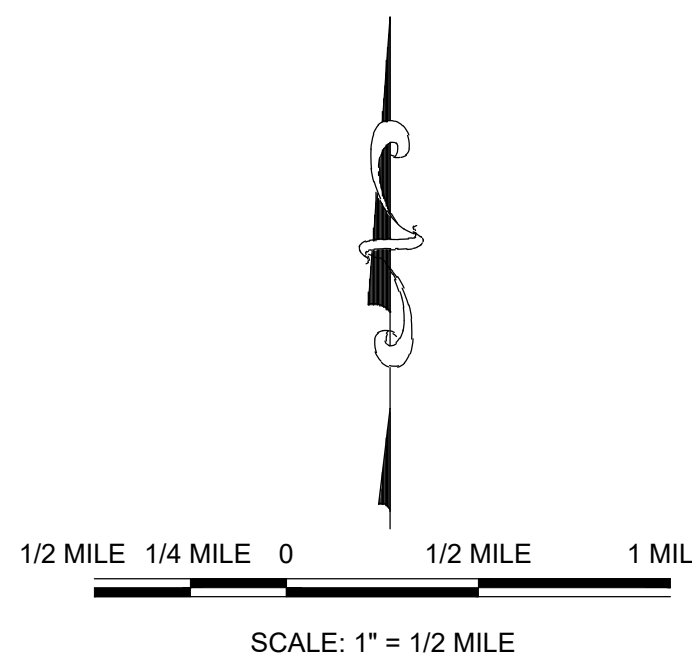

NO.	REVISIONS	DATE	BY	DATE
1	AS-BUILT SITE PLAN	08/19/2020	KRW	
2	AS-BUILT SITE PLAN	08/19/2020	KRW	
**Westwood**  
10333 E DRY CREEK RD  
SUITE 400  
ENGLEWOOD, CO 80112  
TEL: 720.482.9526  
Westwoodps.com  
Westwood Professional Services, Inc.


CRESTONE PEAK RESOURCES MIDSTREAM LLC  
ATTN: NATHAN BENNETT  
555 17TH ST. STE 3700  
DENVER, CO 80202  
PHONE: (303) 312-8166

NATURAL GAS & CRUDE OIL PIPELINE  
GATHERING SYSTEM  
AS-BUILT SITE PLAN  
CRESTONE PEAK RESOURCES MIDSTREAM LLC  
CITY OF AURORA LIMITS & ZONING

SCALE:  
AS SHOWN  
FILE NO:  
8.13.0330001  
DATE:  
08/19/2020

SHEET NUMBER  
**2**  
City Limits - Amendment #18.dwg



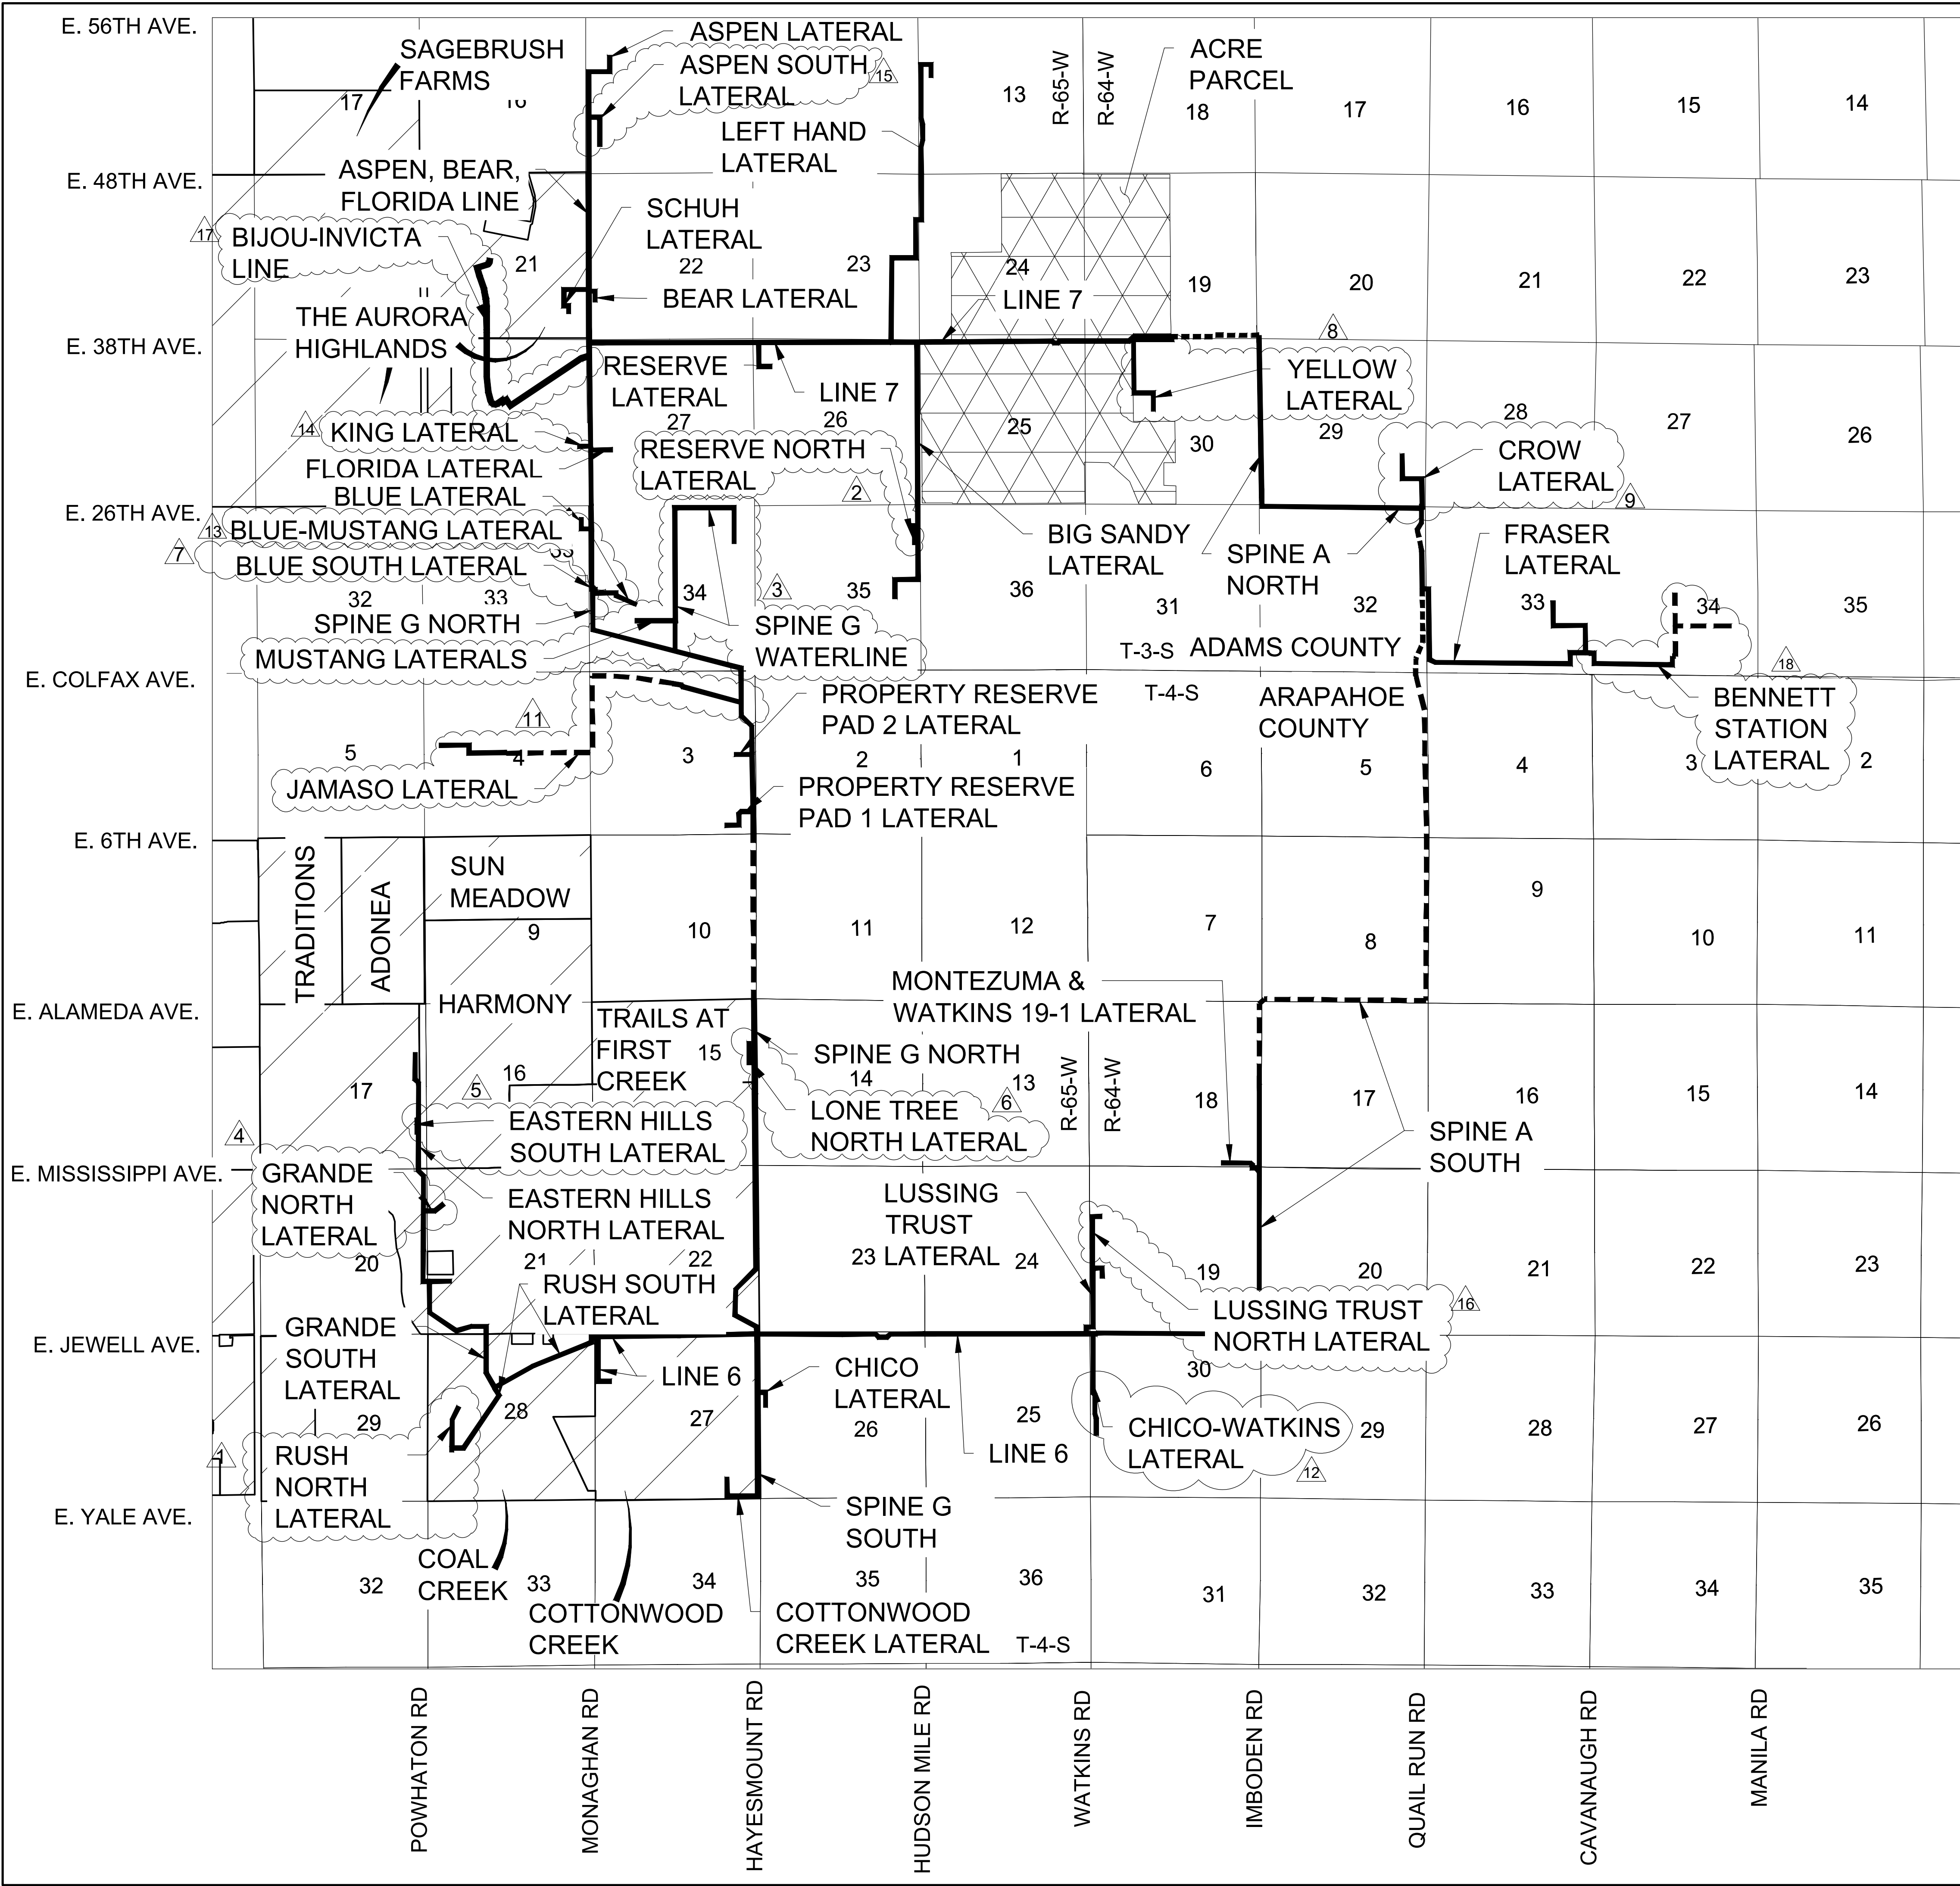

LEGEND

—

PIPELINE WITHIN CITY OF AURORA LIMITS

- - - - -


PIPELINE OUTSIDE CITY OF AURORA LIMITS

///

EXISTING NEIGHBORHOOD

- NOTES
- 1

ALL AMENDMENTS TO THIS SITE PLAN SHALL UTILIZE EASEMENTS THAT DO NOT SIGNIFICANTLY ENCUMBER CURBSIDE LANDSCAPING OR STREET FRONTAGE LANDSCAPE BUFFERS FOR FUTURE DEVELOPMENTS. THIS CAN BE DONE BY EITHER LOCATING ALL EASEMENTS OUTSIDE OF THESE IDENTIFIED AREAS OR INCLUDING EASEMENT LANGUAGE THAT ALLOWS SUFFICIENT PLANTINGS (AS DETERMINED BY THE CITY LANDSCAPE ARCHITECT) TO BE INSTALLED WITHIN EASEMENTS.
- THE GATHERING SYSTEM AND FLOWLINE WILL NOT HAVE ANY UNDUE ADVERSE EFFECTS ON EXISTING AND FUTURE DEVELOPMENT OF THE SURROUNDING AREA AS SET FORTH IN APPLICABLE CITY MASTER PLANS. THE DESIGN OF THE PROPOSED GATHERING SYSTEM AND FLOWLINE MITIGATES NEGATIVE IMPACTS ON THE SURROUNDING AREA TO THE GREATEST EXTENT FEASIBLE. THE DISTURBED AREA SHALL BE MAINTAINED DURING CONSTRUCTION BY THE APPLICANT OR PROPERTY OWNER IN SUCH A MANNER TO CONTROL SOIL EROSION, DUST AND THE GROWTH OF NOXIOUS WEEDS.

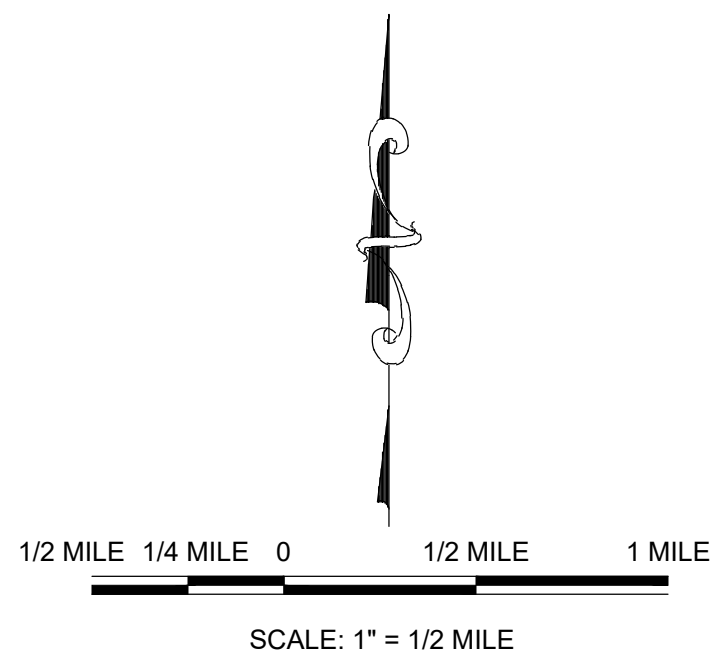

Revisions

No.	Date	Init.
1	08/19/2020	NSW
2	08/19/2020	NSW
3	08/19/2020	NSW
Westwood

10333 E DRY CREEK RD.  
DENVER, CO 80103  
ENGLWOOD, CO 80103  
TEL: 720.482.9536

CRESTONE PEAK RESOURCES MIDSTREAM LLC  
ATTN: NATHAN BENNETT  
550 W. 17TH ST., STE 3700  
DENVER, CO 80202  
PHONE: (303) 312-8166

NATURAL GAS & CRUDE OIL PIPELINE  
GATHERING SYSTEM  
AS-BUILT SITE PLAN  
CRESTONE PEAK RESOURCES MIDSTREAM LLC  
CITY OF AURORA NEIGHBORHOOD MAP

SCALE:  
NOW  
AS SHOWN

FILE NO:  
8.13.0330001

DRAWN BY:  
NSW


CHECKED BY:  
KSW

DATE:  
09/19/2020





3

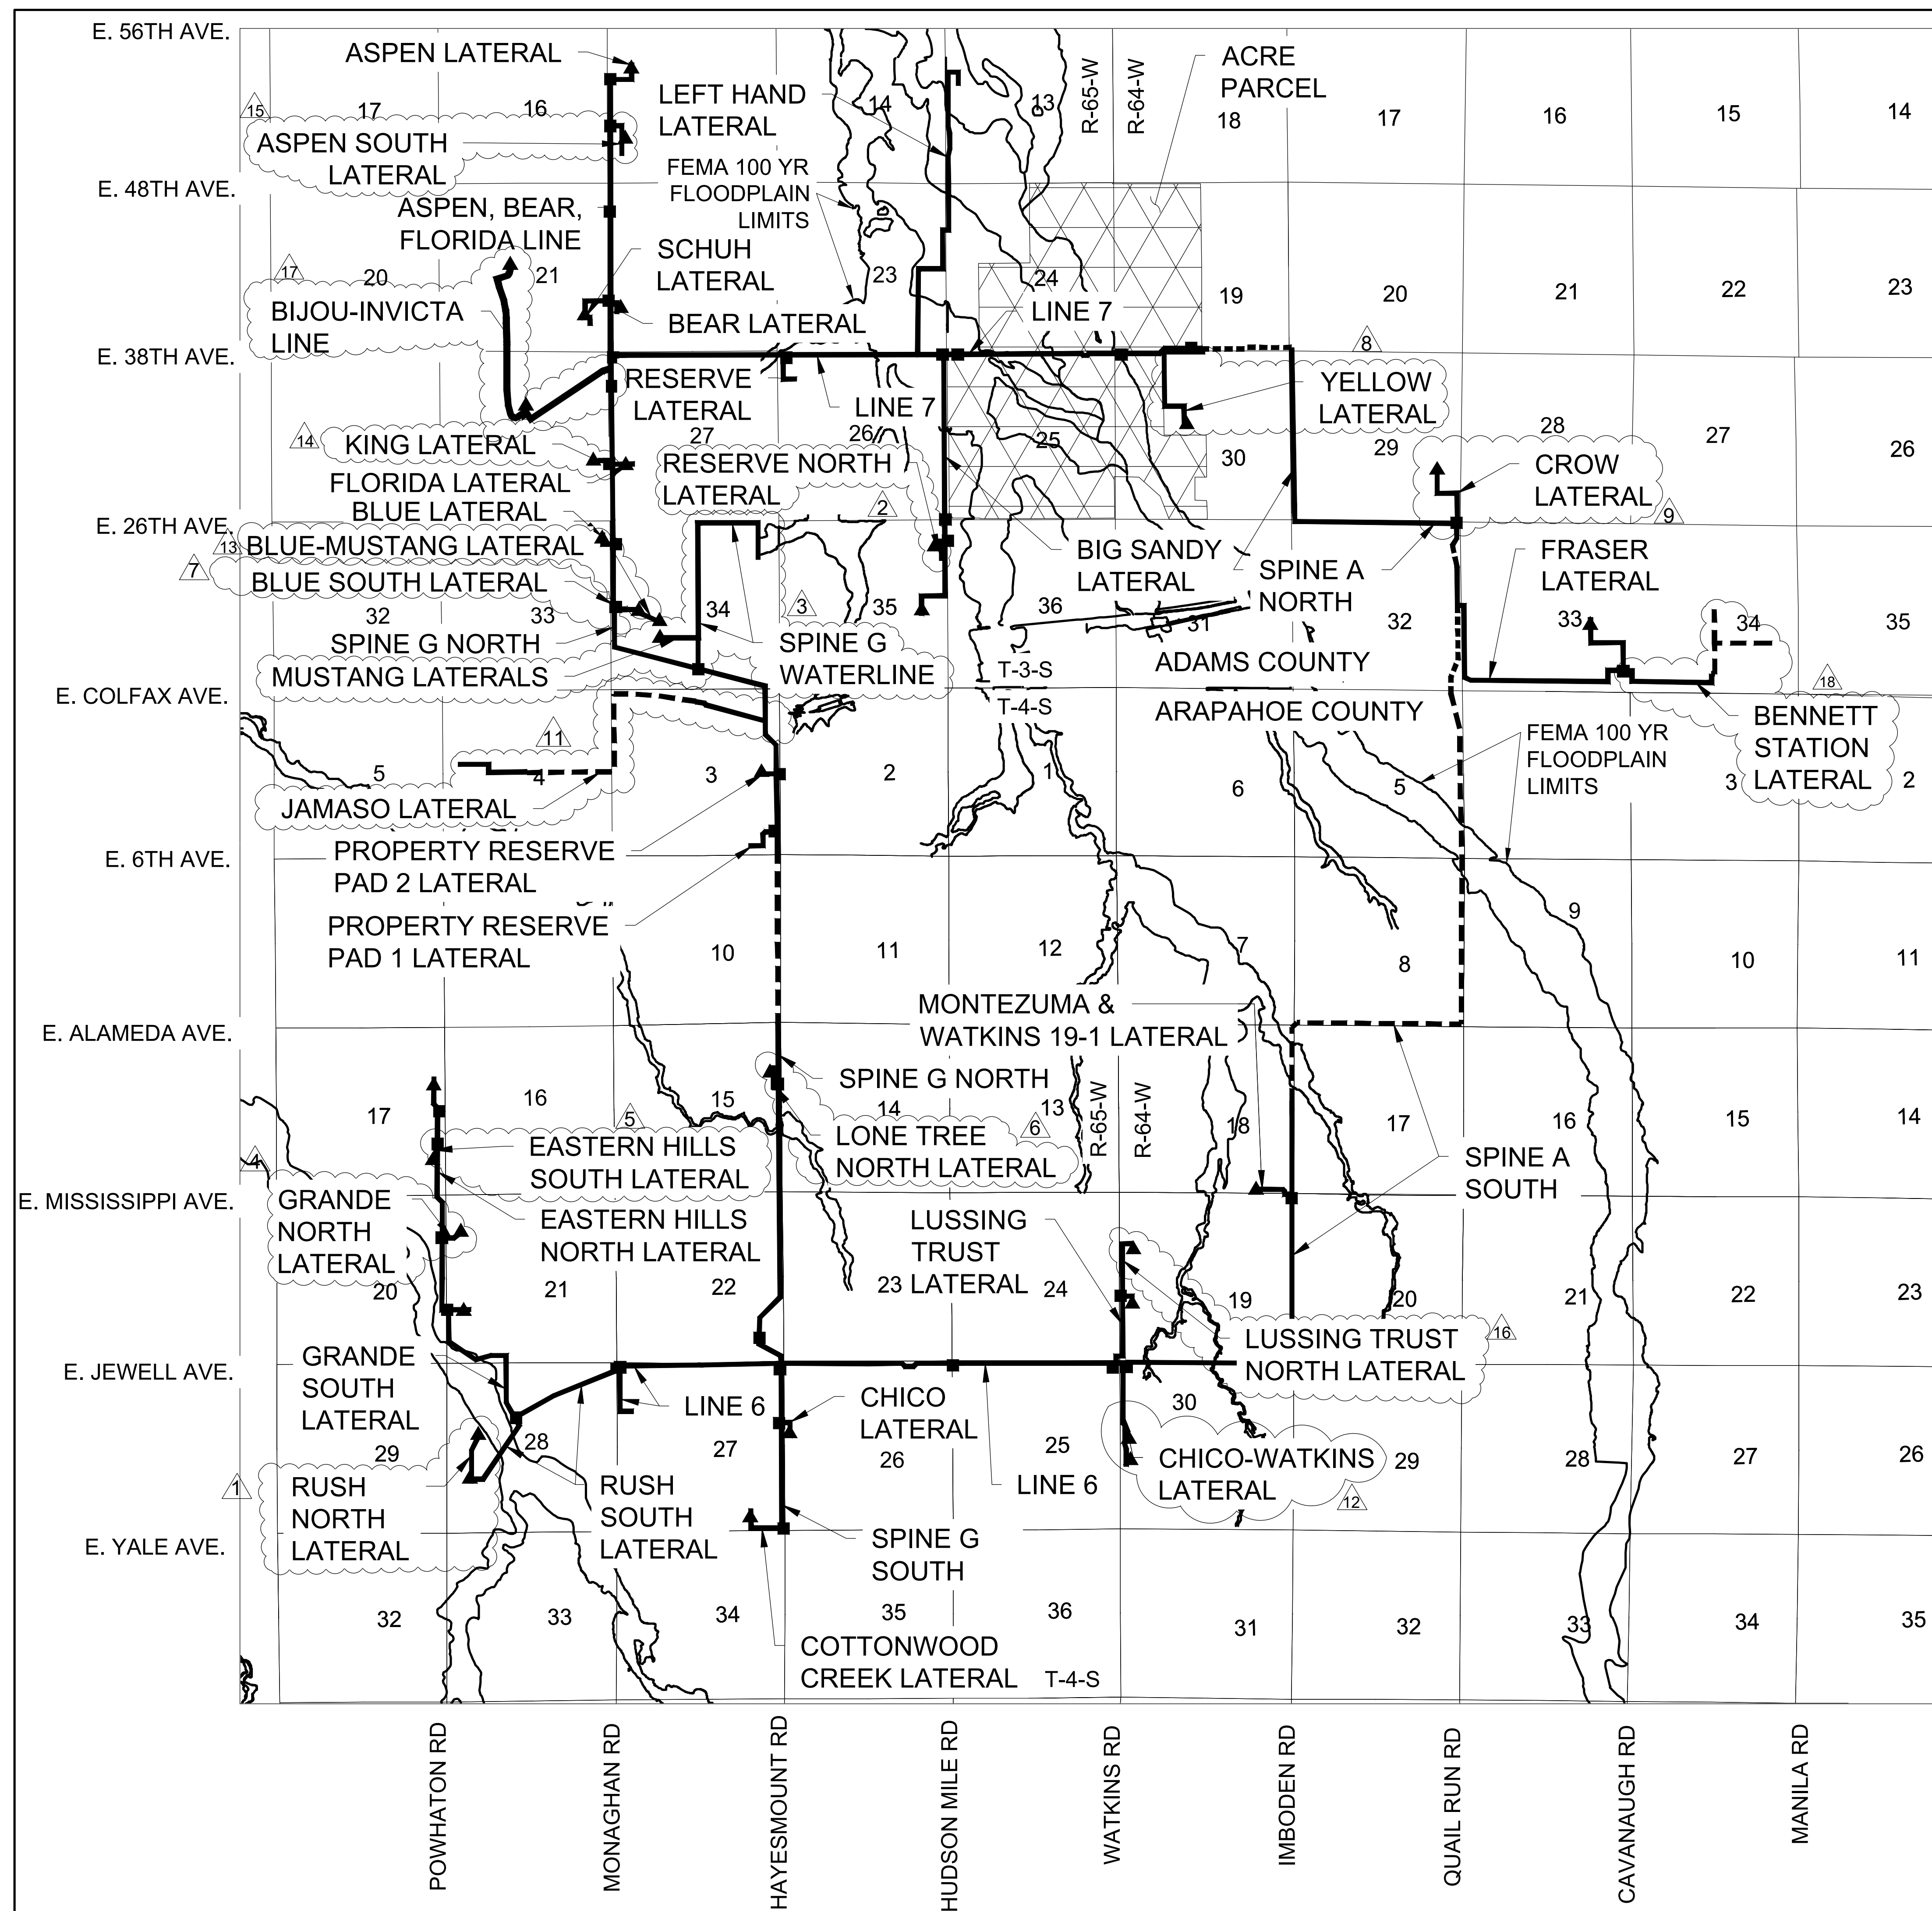
Neighborhoods - Amendment #18.dwg





**LEGEND**

	PIPELINE WITHIN CITY OF AURORA LIMITS
	PIPELINE OUTSIDE CITY OF AURORA LIMITS
	ABOVE GROUND APPURTENANCE SITE LOCATIONS WITHIN CITY OF AURORA
	WELL PAD APPURTENANCE SITE LOCATIONS WITHIN CITY OF AURORA



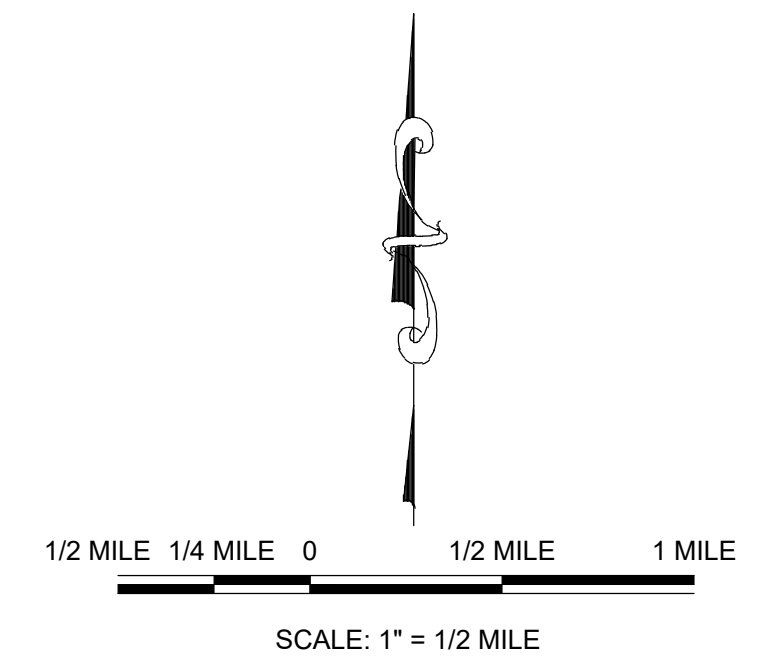


## ABOVE GROUND APPURTENANCE EQUIPMENT EXAMPLE

- NOTES
- ALL AMENDMENTS TO THIS SITE PLAN SHALL UTILIZE EASEMENTS THAT DO NOT SIGNIFICANTLY ENCUMBER CURBSIDE LANDSCAPING OR STREET FRONTAGE LANDSCAPE BUFFERS FOR FUTURE DEVELOPMENTS. THIS CAN BE DONE BY EITHER LOCATING ALL EASEMENTS OUTSIDE OF THESE IDENTIFIED AREAS OR INCLUDING EASEMENT LANGUAGE THAT ALLOWS SUFFICIENT PLANTINGS (AS DETERMINED BY THE CITY LANDSCAPE ARCHITECT) TO BE INSTALLED WITHIN EASEMENTS.
  - THE GATHERING SYSTEM AND FLOWLINE WILL NOT HAVE ANY UNDUE ADVERSE EFFECTS ON EXISTING AND FUTURE DEVELOPMENT OF THE SURROUNDING AREA AS SET FORTH IN APPLICABLE CITY MASTER PLANS. THE DESIGN OF THE PROPOSED GATHERING SYSTEM AND FLOWLINE MITIGATES NEGATIVE IMPACTS ON THE SURROUNDING AREA TO THE GREATEST EXTENT FEASIBLE. THE DISTURBED AREA SHALL BE MAINTAINED DURING CONSTRUCTION BY THE APPLICANT OR PROPERTY OWNER IN SUCH A MANNER TO CONTROL SOIL EROSION, DUST AND THE GROWTH OF NOXIOUS WEEDS.

[illegible]



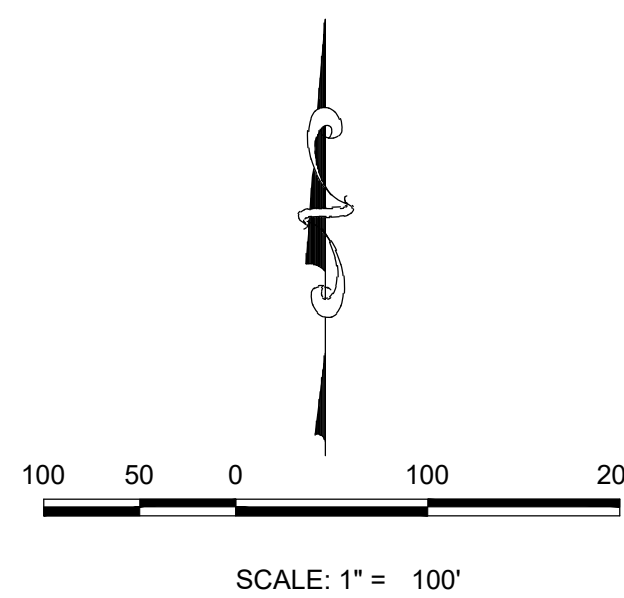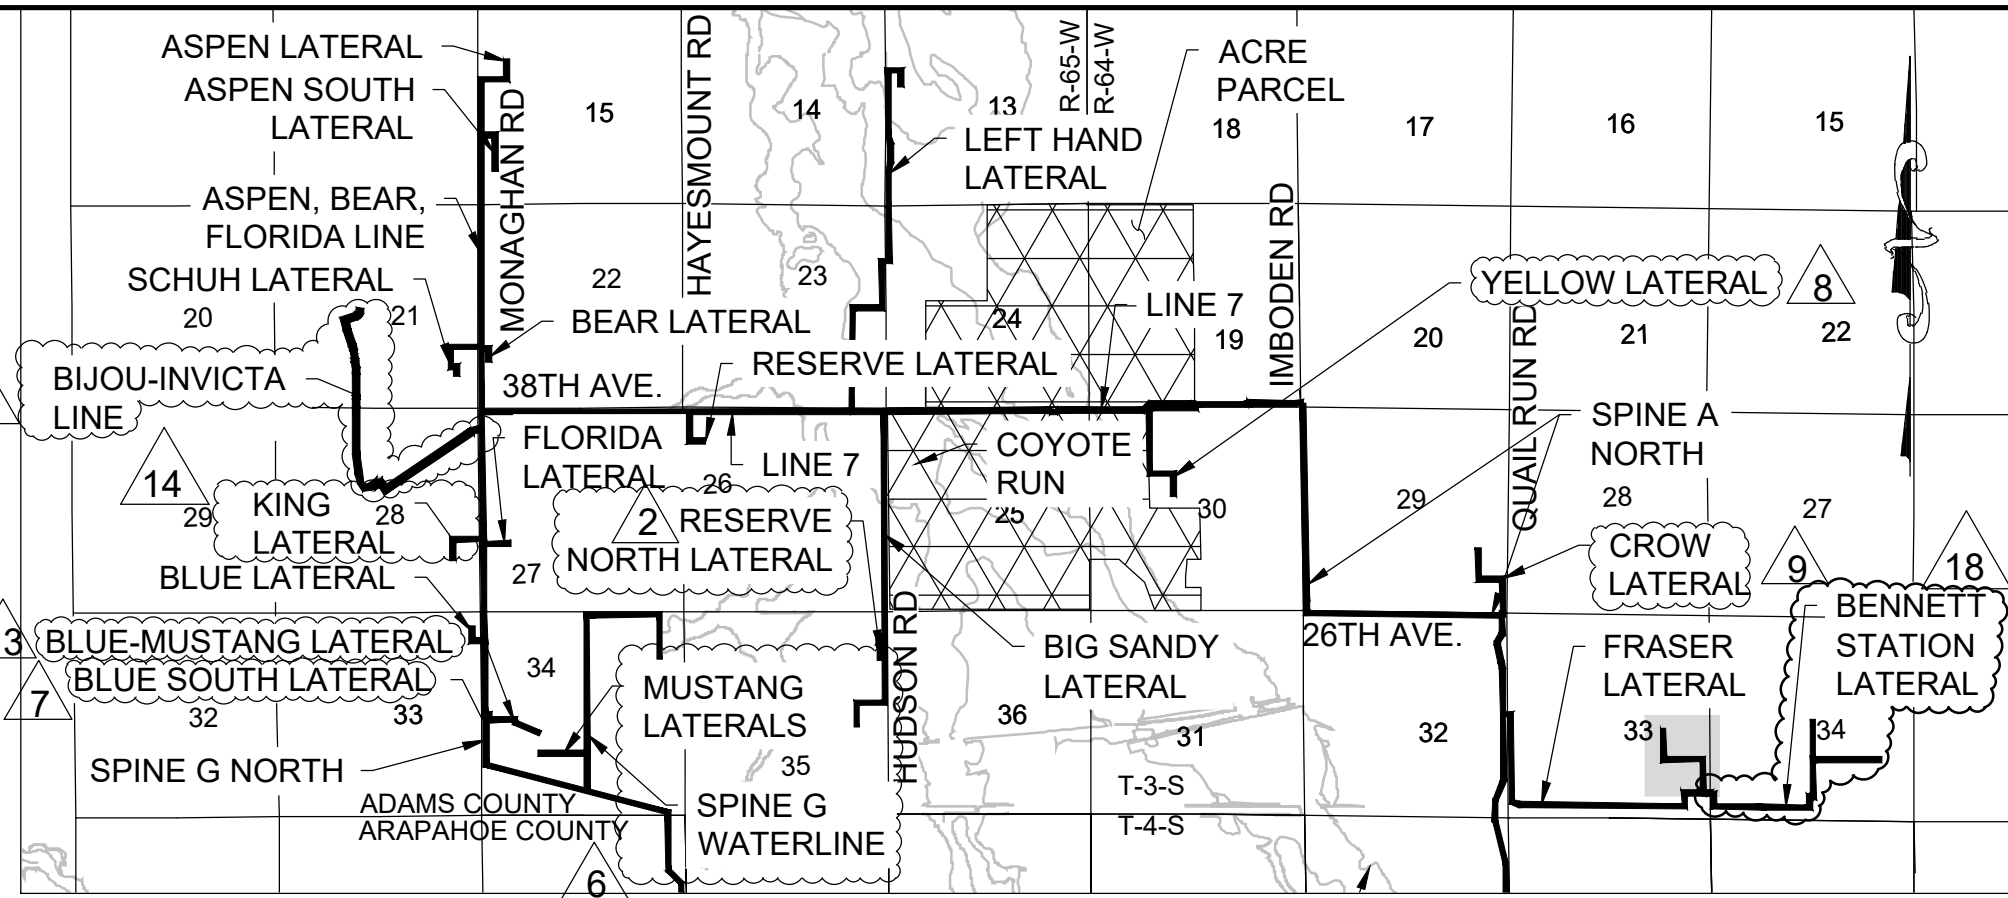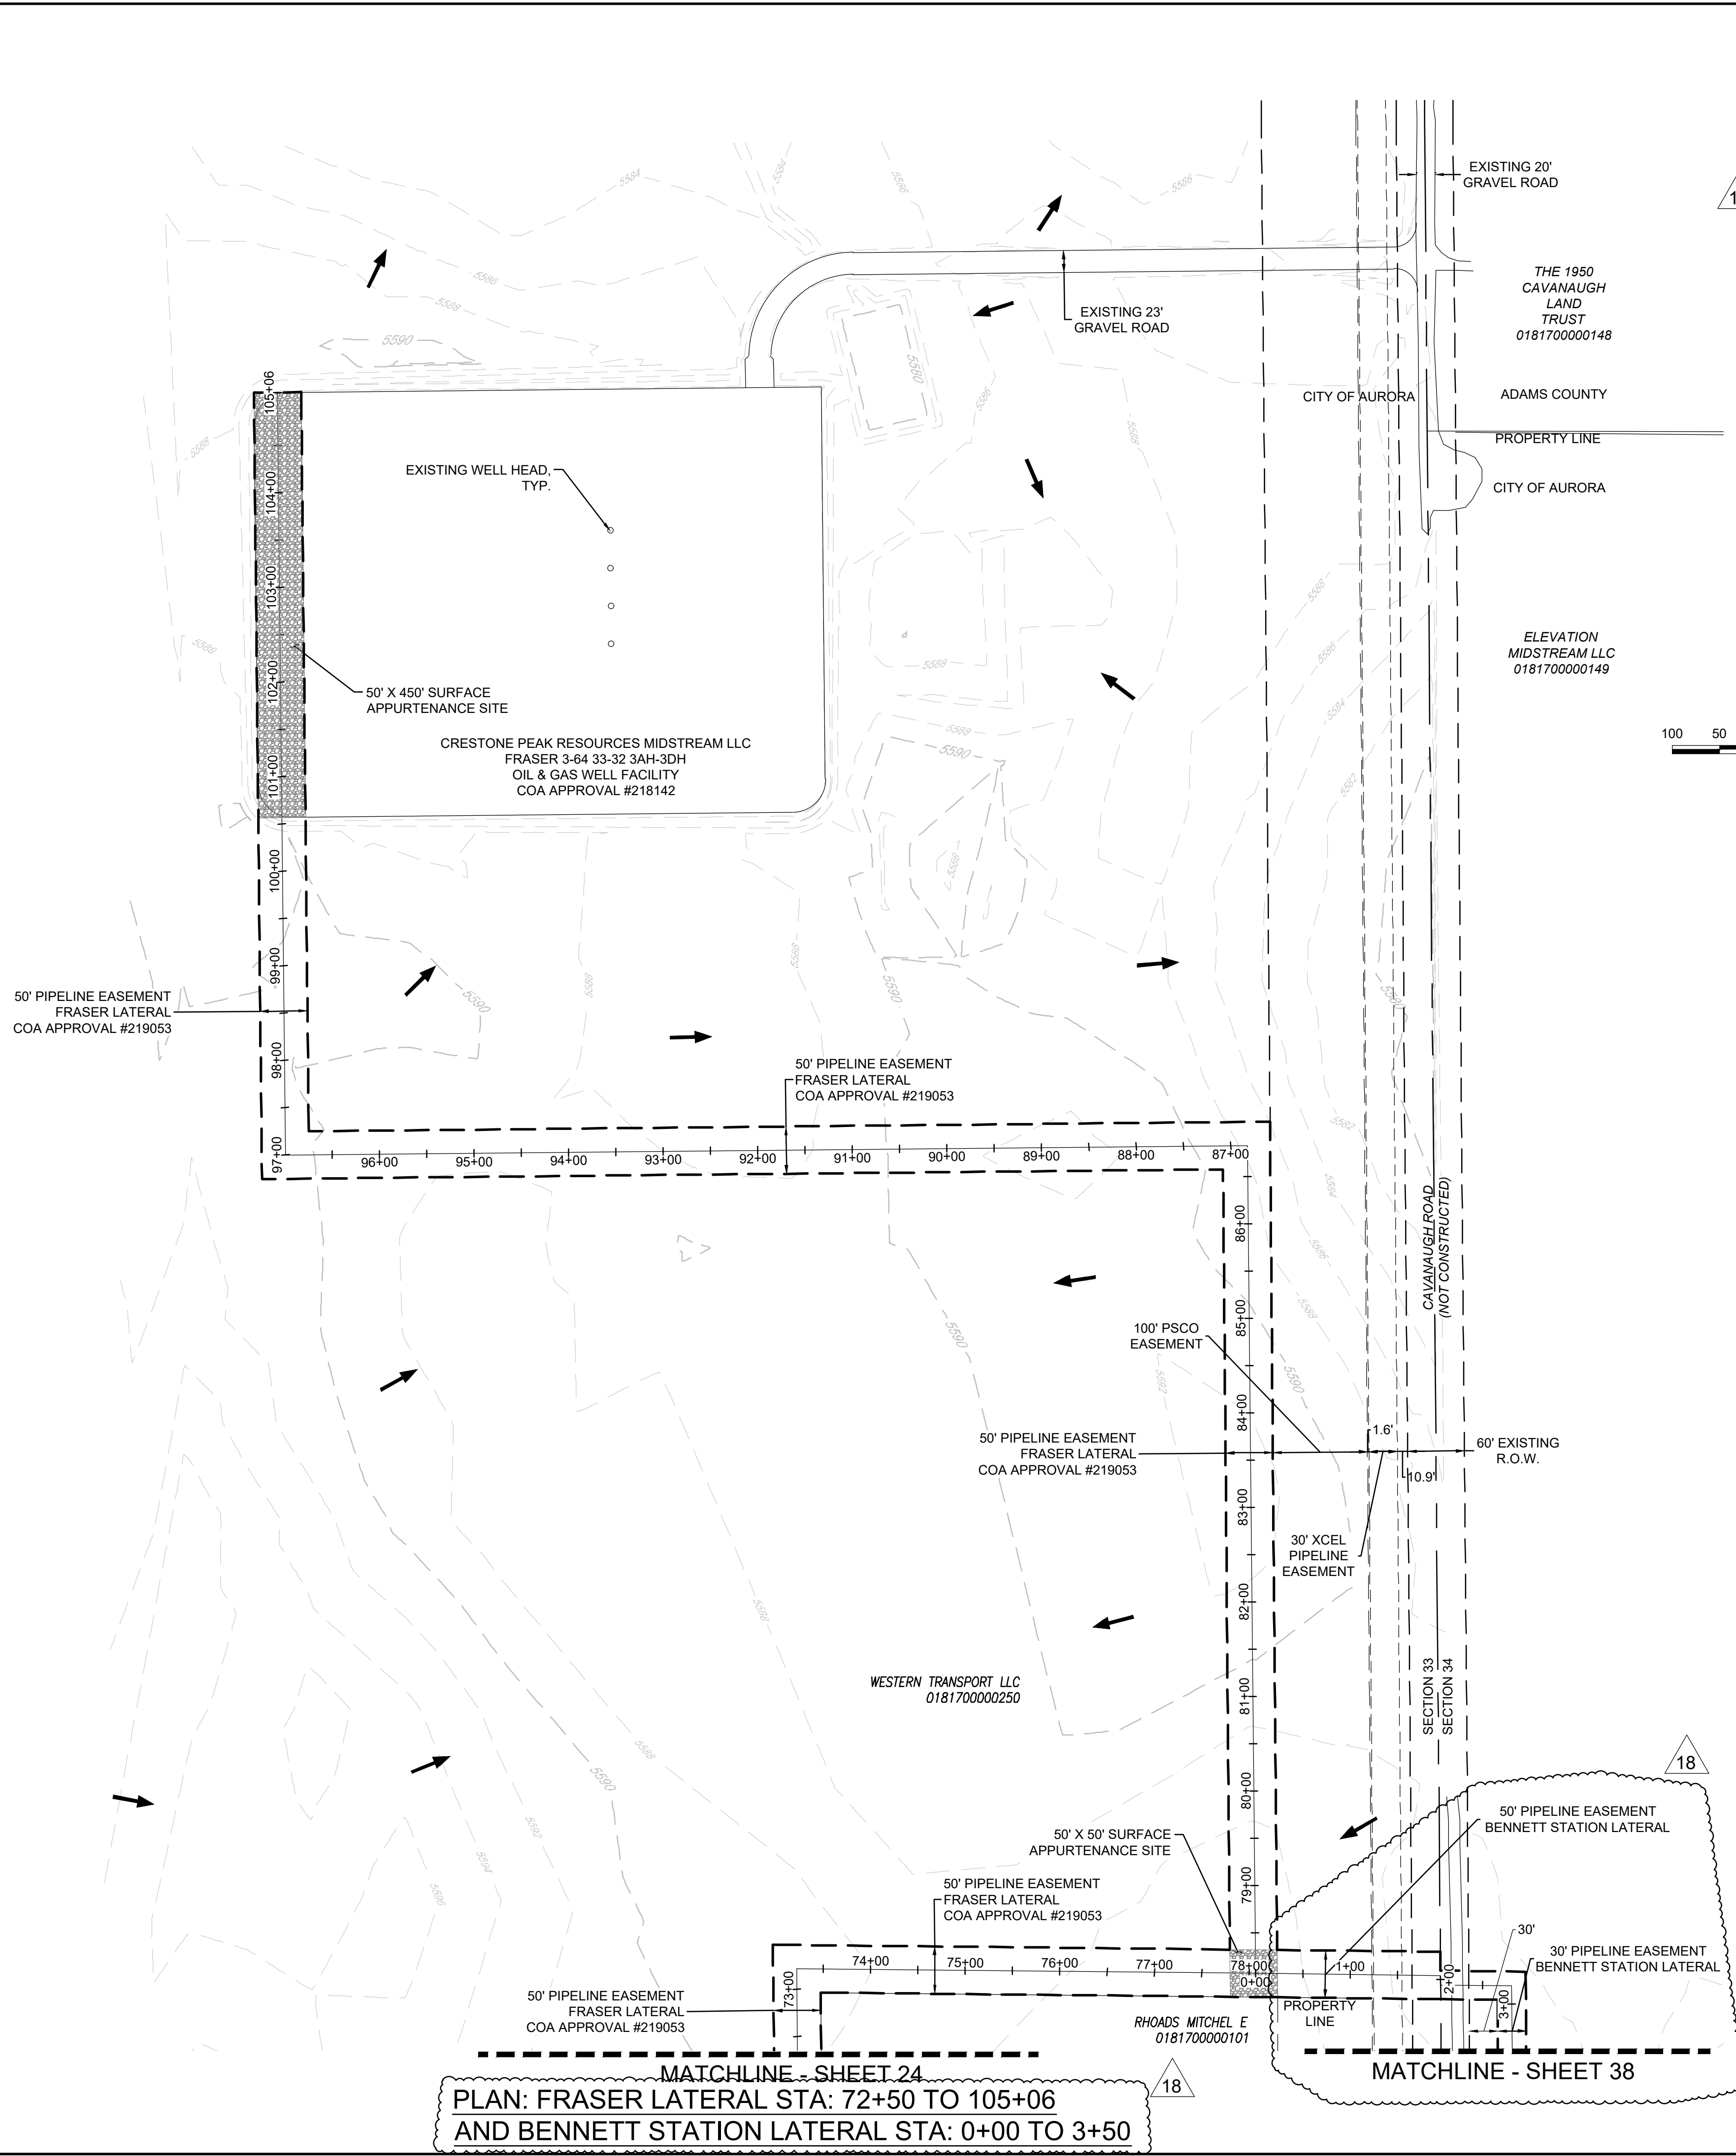

MATCHLINE - SHEET 24  
PLAN: FRASER LATERAL STA: 72+50 TO 105+06  
AND BENNETT STATION LATERAL STA: 0+00 TO 3+50

<b>SHEET NUMBER</b>  <b>25</b>	<b>DRAWN BY:</b> NCW	<b>SCALE:</b> AS SHOWN	<b>NATURAL GAS &amp; CRUDE OIL PIPELINE</b>	<b>CRESTONE PEAK RESOURCES MIDSTREAM LLC</b> ATTN: NATHAN BENNETT 555 17TH ST. STE 3700 DENVER, CO 80202 PHONE: (303) 312-8166 FRASER LATERAL 72+50 TO 105+06
	<b>CHECKED BY:</b> KRW	<b>FILE NO:</b>	<b>GATHERING SYSTEM</b>	
	<b>DATE:</b> 08/19/2020	<b>8.13.0330001</b>	<b>AS-BUILT SITE PLAN</b>	
	<b>CRESTONE PEAK RESOURCES MIDSTREAM LLC</b>			
<b>Revisions</b>		<b>Westwood</b> 10333 E DRY CREEK RD. SUITE 400 ENGLEWOOD, CO 80112 TEL: 720.482.9526 Westwoodps.com Westwood Professional Services, Inc.		
No.	Date	Init.	Appr.	Date
18	01/03/25	NCW		
17	07/10/24	NCW		
16	04/05/24	NCW		
15	03/22/22	KRW		
14	03/22/22	KRW		
13	11/13/21	KRW		
12	11/13/21	KRW		
11	03/05/21	KRW		
10	03/05/21	KRW		
9	03/05/21	KRW		
8	03/05/21	KRW		
7	03/05/21	KRW		
6	03/05/21	KRW		
5	03/05/21	KRW		
4	03/05/21	KRW		
3	03/05/21	KRW		
2	03/05/21	KRW		
1	03/05/21	KRW		



