

AMENDMENT BLOCK

DATE	SUMMARY OF AMENDMENT
7.9.2024	MINOR AMENDMENT TO REFLECT AS-BUILT CONDITIONS AND RELOCATE 1 CONIFEROUS TREE GREATER THAN 4" CALIPER, TO ACCOMMODATE NEW COVERED PATIO AT 800 S HAVANA STREET AND ADDING A TEMPORARY FENCE TO BE LATER REPLACED BY A 6'-0" H. FENCE.

**HAVANA SHOPS SITE
MINOR AMENDMENT APPLICATION**

LOTS 2 & 3, BLOCK 1, COLONY SUBDIVISION FILING NO. 1, AND A PART OF TRACT 9 IN HAVANA GARDENS IN THE SW 1/4, SECTION 14, T.4S., R.67W., OF THE 6TH P.M., CITY OF AURORA, COUNTY OF ARAPAHOE, STATE OF COLORADO



VICINITY MAP

SHEET INDEX	
SHEET NUMBER	SHEET NAME
S-001	COVER
S-002	SITE PLAN
S-003	810 S HAVANA STREET SOUTH ELEVATION
S-004	850 S HAVANA STREET WEST ELEVATION
S-005	850 S HAVANA STREET NORTH ELEVATION
S-006	800 S HAVANA STREET WEST ELEVATION

SITE DATA

LAND AREA WITHIN PROPERTY LINES: 189,829 SF (4.35 Acres)

EXISTING ON SITE		WITH PROPOSED PATIO
GROSS FLOOR AREA	29,384 SF	30,134 SF
NUMBER OF BUILDINGS	4	4 (1 COVERED PATIO)
NUMBER OF STORIES	1	1
TOTAL ROOF COVERAGE	32,769 SF	33,758 SF
HARD SURFACE AREA	84,528 SF	85,517 SF
LANDSCAPE AREA	25,069 SF	24,085 SF

MAXIMUM HEIGHT OF EXISTING BUILDING:

810 S HAVANA STREET: 18' - 0"
850 S HAVANA STREET: 18' - 0"
800 S HAVANA STREET: 16' - 3"

MAXIMUM HEIGHT OF PROPOSED PARAPET:

810 S HAVANA STREET: 25' - 0"
850 S HAVANA STREET: 28' - 6"
800 S HAVANA STREET: 18' - 0"

PRESENT ZONING CLASSIFICATION: (MU-C)

CHARACTER AREA: SUBAREA A

PROPOSED USE: MULTI-TENANT RETAIL AND COMMERCIAL

PERMITTED USE: TABLE 3.2-1 OF AURORA UNIFIED DEVELOPMENT ORDINECE

DESCRIPTION OF WORK:

REMODEL OF EXTERIOR FACADES AT THE FOLLOWING ADDRESSES:
810 S HAVANA STREET
850 S HAVANA STREET
800 S HAVANA STREET

PROPOSED EXTERIOR COVERED PATIO AT:
800 S HAVANA STREET

EXISTING TO REMAIN:
840 S HAVANA STREET

PARKING:

PROVIDED: 161 STANDARD
4 ADA COMPIANT
165 TOTAL PARKING

PROJECT DIRECTORY

ARCHITECT	CLIENT
d4 Architecture, LLC DEREK PRICE 3550 W 38 th Ave, Suite 12 Denver, CO 80211 303-946-5389	Donavan Welsh Title: Owner Email: charlenewelsh@havanaautoparts.com Phone: (303) 261-8263 Address: 810 S Havana Street Denver, Aurora CO 80012

LEGAL DESCRIPTION

HAVANA AUTO-PLEX CENTER SUBDIVISION FILING NO. 1

LOTS 2 & 3, BLOCK 1, COLONY SUBDIVISION FILING NO. 1, AND A PART OF TRACT 9 IN HAVANA GARDENS IN THE SW 1/4, SECTION 14, T.4S., R.67W., OF THE 6TH P.M., CITY OF AURORA, COUNTY OF ARAPAHOE, STATE OF COLORADO

SITE ADDRESS:
810 S HAVANA STREET
AURORA, CO 80012

OWNER'S CERTIFICATE:

THIS SITE PLAN AND ANY AMENDMENTS HERETO, UPON APPROVAL BY THE CITY OF AURORA AND RECORDING SHALL BE BINDING UPON THE APPLICANTS THEREFORE, THEIR SUCCESSORS AND ASSIGNS. THIS PLAN SHALL LIMIT AND CONTROL THE ISSUANCE AND VALIDITY OF ALL BUILDING PERMITS, AND SHALL RESTRICT AND LIMIT THE CONSTRUCTION, LOCATION, USE, OCCUPANCY, AND OPERATION OF ALL LAND AND STRUCTURES WITHIN THIS PLAN TO ALL CONDITIONS, REQUIREMENTS, LOCATIONS AND LIMITATIONS SET FORTH HEREIN ABANDONMENT, WITHDRAWAL, OR AMENDMENT OF THIS PLAN MAY BE PERMITTED ONLY UPON APPROVAL OF THE CITY OF AURORA.

IN WITNESS THEREOF _____ HAS CAUSED THESE PRESENTS TO BE EXECUTED

THIS _____ DAY OF _____ 20____ AD

BY: _____

PRINT NAME: _____

PRINT TITLE: _____

NOTARIAL:

STATE OF COLORADO _____)
COUNTY OF _____)

THE FOREGOING INSTRUMENT WAS ACKNOWLEDGED BEFORE ME

THIS _____ DAY OF _____ AD 20____

BY: _____

WITNESS MY HAND AND OFFICIAL SEAL

NOTARY PUBLIC

MY COMMISSION EXPIRES: _____ ADRESS: _____

RECORDERS CERTIFICATE:

ACCEPTED FOR FILING IN THE OFFICE OF THE CLERK AND RECORDER

OF _____ COUNTY, COLORADO AT _____ O'CLOCK.

THIS _____ DAY OF _____ AD20____

CLERK AND RECORDER: _____

DEPUTY: _____

CITY OF AURORA APPROVALS:

CITY ATTORNEY: _____ DATE: _____

PLANNING DIRECTOR: _____ DATE: _____

PLANNING COMMISSION: _____ DATE: _____

CHAIRMAN

CITY COUNCIL: _____ DATE: _____

MAYOR

ATTEST: _____ DATE: _____

CITY CLERK

SITE BENCHMARK:

NW COR. OF THE SW 1/4, SEC. 14, T. 4 S. R. 67 W. OF THE 6TH P.M.

(FOUND 3" BRASS CAP L.S. NO. 11342IN C.O.A. RANGE BOX) AS PER MONUMENT RECORD BY L.S. #16419 ACCEPTED FOR FILING 11-13-89

ELEVATION = 5469.06 (USGS 2024)



1825 LAWRENCE ST. #111
Denver, CO 80202
PH: 303-946-5389

COPYRIGHT 2024 BY d4 ARCHITECTURE, L.L.C. ALL RIGHTS RESERVED. THIS DOCUMENT CONTAINS DRAWINGS, IDEAS AND DESIGN CONCEPTS WHICH ARE THE SOLE PROPERTY OF d4 ARCHITECTURE, L.L.C. THE ARCHITECT RESERVES ALL RIGHTS AND ALL OTHER PROPERTY RIGHTS IN THESE DRAWINGS, IDEAS, AND DESIGN CONCEPTS. THESE DRAWINGS, IDEAS, AND DESIGN SHALL NOT BE REPRODUCED, COPIED, OR USED IN ANY MANNER WITHOUT THE WRITTEN CONSENT OF THE ARCHITECT. THESE DRAWINGS, IDEAS AND DESIGN SHALL NOT BE USED BY THE CLIENT OR ANY OTHER PARTY IN ANY PROJECT FOR WHICH THE ARCHITECT PREPARED THESE DRAWINGS, IDEAS AND DESIGN CONCEPTS OR FOR ANY OTHER PROJECT WITHOUT THE WRITTEN CONSENT OF THE ARCHITECT. YOUR RECEIPT OF THESE DRAWINGS, IDEAS AND DESIGN CONCEPTS CONSTITUTES CONCLUSIVE EVIDENCE OF YOUR ACCEPTANCE OF THESE RESTRICTIONS. VIOLATIONS SHALL BE PROSECUTED.

I CERTIFY THAT THESE DOCUMENTS WERE PREPARED OR APPROVED BY ME AND THAT THEY ARE FULLY LICENSED ARCHITECTURE FROM UNDER THE LAWS OF THE STATE OF COLORADO.

COVER

SHEET NAME :

PROJECT :
HAVANA SHOPS SITE MINOR AMENDMENT APPLICATION
800 S HAVANA STREET, 810 S HAVANA STREET,
850 S HAVANA STREET AURORA, CO 80012

Drawn by: BLO
Checked by: DSP
Project Date: 7.9.24
Project #: 2024.32


S-001
1" = 10'-0"

HAVANA SHOPS SITE MINOR AMENDMENT APPLICATION

LOTS 2 & 3, BLOCK 1, COLONY SUBDIVISION FILING NO. 1, AND
 A PART OF TRACT 9 IN HAVANA GARDENS IN THE SW 1/4,
 SECTION 14, T.4S., R.67W., OF THE 6TH P.M., CITY OF AURORA,
 COUNTY OF ARAPAHOE, STATE OF COLORADO

SITE PLAN NOTES:

- 1 EXISTING FIRE HYDRANT TO REMAIN
- 2 EXISTING LIGHT POLE TO REMAIN
- 3 EXISTING ELECTRICAL POLE TO REMAIN
- 4 NOT USED
- 5 EXISTING MONUMENT SIGN TO REMAIN
- 6 EXISTING BUILDING TO REMAIN
- 7 EXISTING CONCRETE SIDEWALK TO REMAIN
- 8 EXISTING PARKING STALLS TO REMAIN
- 9 EXISTING CONCRETE SWALE TO REMAIN
- 10 EXISTING STORM INLET TO REMAIN
- 11 EXISTING TELEPHONE PEDESTAL
- 12 EXISTING WATER TAP TO REMAIN
- 13 EXISTING IRRIGATION BOX TO REMAIN
- 14 EXISTING CITY MANHOLE
- 15 EXISTING PRIVATE MANHOLE TO REMAIN
- 16 EXISTING DECIDUOUS TREE TO REMAIN
- 17 EXISTING CONIFEROUS TREE TO REMAIN
- 18 EXISTING PANEL BOX ON CONCRETE PAD
- 19 EXISTING TEMPORARY FENCE AS AGREED TO BY PROPERTY OWNERS - TO BE REMOVED
- 20 EXISTING GAS MAIN TO REMAIN
- 21 CONIFEROUS TREE REPLACEMENT/RELOCATION
- 22 EXISTING ADA PARKING
- 23 COVERED SIDEWALK
- 24 ADA SIGNS
- 25 EXISTING SOD TO REMAIN
- 26 EXISTING ROCK TO REMAIN
- 27 STORAGE LOT
- 28 EXISTING FENCE TO REMAIN
- 29 RAMP
- 30 CAR RAMP
- 31 DELIVERIES
- 32 STOP SIGNS
- 33 SITE SCULPTURE (VINTAGE AIRPLANE)
- 34 FUTURE 6'-0" H. WOOD FENCE (TEMPORARY CHAINLINK CONSTRUCTION FENCE)
- 35 FUTURE 6'-0" H. WOOD GATE (TEMPORARY CHAINLINK GATE) WITH KNOX BOX

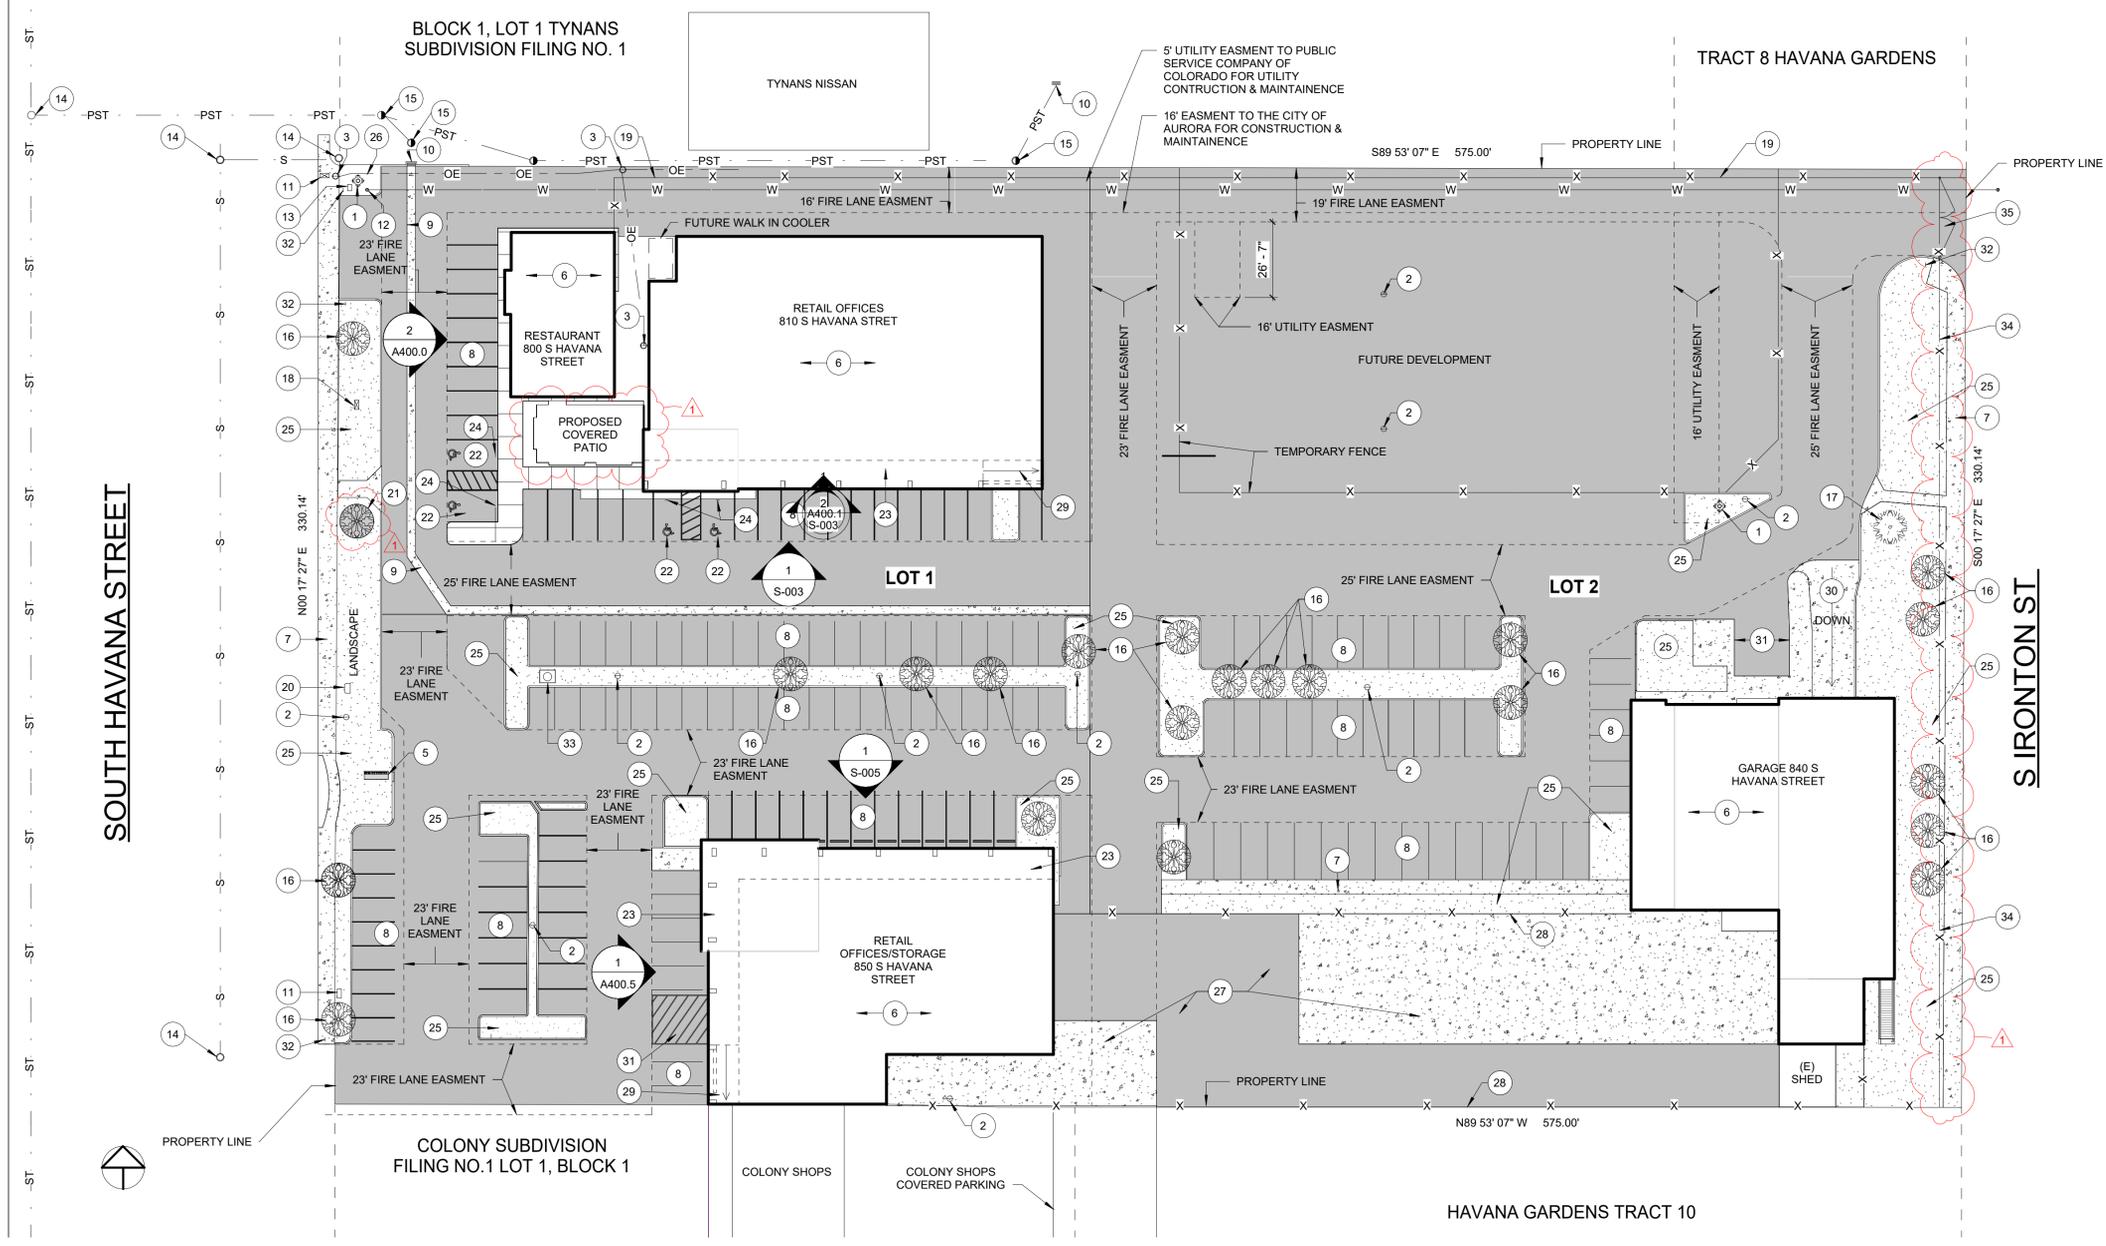

COPYRIGHT 2024 BY ARCHITECTURE, L.L.C. ALL RIGHTS RESERVED. THIS DOCUMENT CONTAINS DRAWINGS, IDEAS AND DESIGNS AND IS AN INSTRUMENT OF SERVICE, AND AS SUCH, REMAINS THE SOLE PROPERTY OF ARCHITECTURE, L.L.C. THE USER AND ALL OTHER PROPERTY RIGHTS IN THESE DRAWINGS, IDEAS, AND DESIGNS SHALL BE ASSIGNED TO ARCHITECTURE, L.L.C. NO PART OF THESE DRAWINGS, IDEAS, AND DESIGNS SHALL BE REPRODUCED, CHANGED, OR COPIED IN ANY FORM, AND SHALL NOT BE ASSIGNED TO ANY THIRD PARTY. ARCHITECTURE, L.L.C. AND THE ARCHITECT SHALL NOT BE HELD RESPONSIBLE FOR ANY CONSTRUCTION DEFECTS OR CONNECTION WITH ANY PROJECT OTHER THAN THE SPECIFIC PROJECT FOR WHICH THE ARCHITECT PREPARED THEIR PROFESSIONAL SERVICES. THE ARCHITECT'S OBLIGATION SHALL BE LIMITED TO THE DESIGN AND CONSTRUCTION OF THE PROJECT. YOUR ACCEPTANCE OF THESE DRAWINGS, IDEAS AND DESIGNS CONSTITUTES CONCLUSIVE EVIDENCE OF YOUR ACCEPTANCE OF THESE RESTRICTIONS. VIOLATION SHALL BE PROSECUTED.

I CERTIFY THAT THESE DOCUMENTS WERE PREPARED OR APPROVED BY ME AND THAT I AM A DULY LICENSED ARCHITECTURE FIRM UNDER THE LAWS OF THE STATE OF COLORADO.

SITE PLAN

SHEET NAME :

HAVANA SHOPS SITE MINOR AMENDMENT APPLICATION

PROJECT:
 800 S HAVANA STREET, 810 S HAVANA STREET,
 850 S HAVANA STREET AURORA, CO 80012

Drawn by: BLO
 Checked by: DSP
 Project Date: 7.9.24
 Project #: 2024.32

S-002
 As indicated

SITE LEGEND

SITE SYMBOL	DESCRIPTION
	EXISTING FIRE HYDRANT
	EXISTING LIGHT POLE
	EXISTING ELECTRICAL POST
	EXISTING TELEPHONE PEDESTAL
	EXISTING MONUMENT SIGN
	EXISTING STORM INLET
	EXISTING WATER TAP
	EXISTING IRRIGATION BOX
	EXISTING CITY MANHOLE
	EXISTING PRIVATE MANHOLE
	EXISTING GAS MAIN

1 SITE PLAN
 SCALE: 1" = 50'-0"

SITE LEGEND

LINE TYPE	DESCRIPTION
	SEWER MAIN
	STORM MAIN
	PRIVATE STORM MAIN
	WATER LINE
	OVERHEAD ELECTRICAL
	FENCE
	EASMENT LINE
	PROPERTY LINE

SITE LEGEND

GROUND COVER	DESCRIPTION
	LANDSCAPED
	CONCRETE
	ASPHALT

ADDITIONAL SITE FEATURES

	SITE SCULPTURE WITH CONCRETE BASE
--	-----------------------------------

SITE LEGEND

TREES	DESCRIPTION
	EXISTING CONIFEROUS TREE
	CONIFEROUS TREE REPLACEMENT/RELOCATION
	EXISTING DECIDUOUS TREE

PARKING


	ADA PARKING SYMBOL
--	--------------------

1 7.9.2024 MINOR AMENDMENT TO REFLECT AS-BUILT CONDITIONS AND RELOCATE 1 CONIFEROUS TREE GREATER THAN 4" CALIPER, TO ACCOMMODATE NEW COVERED PATIO AT 800 S HAVANA STREET AND ADDING A TEMPORARY FENCE TO BE LATER REPLACED BY A 6'-0" H. FENCE.

HAVANA SHOPS SITE MINOR AMENDMENT APPLICATION


LOTS 2 & 3, BLOCK 1, COLONY SUBDIVISION FILING NO. 1, AND
A PART OF TRACT 9 IN HAVANA GARDENS IN THE SW 1/4,
SECTION 14, T.4S., R.67W., OF THE 6TH P.M., CITY OF AURORA,
COUNTY OF ARAPAHOE, STATE OF COLORADO

EQUIPMENT DATA ARCHITECTURE, L.L.C.
ALL RIGHTS RESERVED.
THIS DOCUMENT CONTAINS DRAWINGS, IDEAS AND DESIGNS
AND IS AN INSTRUMENT OF SERVICE, AND AS SUCH, REMAINS
THE SOLE PROPERTY OF EQUIPMENT DATA ARCHITECTURE, L.L.C. AND
ALL OTHER PROPERTY RIGHTS IN THESE DRAWINGS, IDEAS,
AND DESIGNS, THESE DRAWINGS, IDEAS, AND DESIGNS SHALL
NOT BE REPRODUCED, CHANGED, OR COPIED IN ANY FORM,
WHETHER OR NOT BE ASSIGNED TO ANY THIRD PARTY.
BY RECEIVING THESE DRAWINGS, IDEAS, AND DESIGNS FROM THE
ARCHITECT, THESE DRAWINGS, IDEAS AND DESIGNS SHALL
NOT BE USED BY THE CLIENT OR ANY OTHER PARTY IN
CONNECTION WITH ANY PROJECT OTHER THAN THE SPECIFIC
PROJECT FOR WHICH THE ARCHITECT PREPARED THEM.
WITHOUT THE WRITTEN CONSENT OF THE ARCHITECT, THE
CLIENT'S RECEIPT OF THESE DRAWINGS, IDEAS AND
DESIGNS CONSTITUTES CONCLUSIVE EVIDENCE OF YOUR
ACCEPTANCE OF THESE RESTRICTIONS. VIOLATIONS SHALL
BE PROSECUTED.
I CERTIFY THAT THESE DOCUMENTS WERE PREPARED OR
APPROVED BY ME AND THAT I AM A DULY LICENSED
ARCHITECTURE FIRM UNDER THE LAWS OF THE STATE OF
COLORADO.

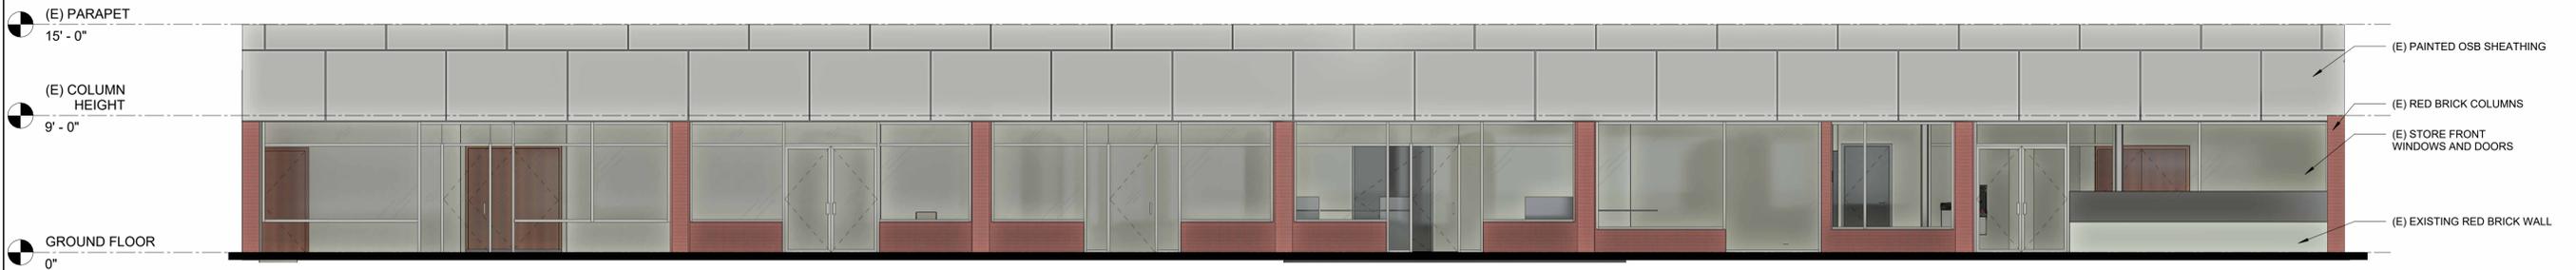

1 810 S HAVANA - EXISTING SOUTH ELEVATION
SCALE: 3/16" = 1'-0"

SHEET NAME :
**810 S HAVANA STREET
SOUTH ELEVATION**

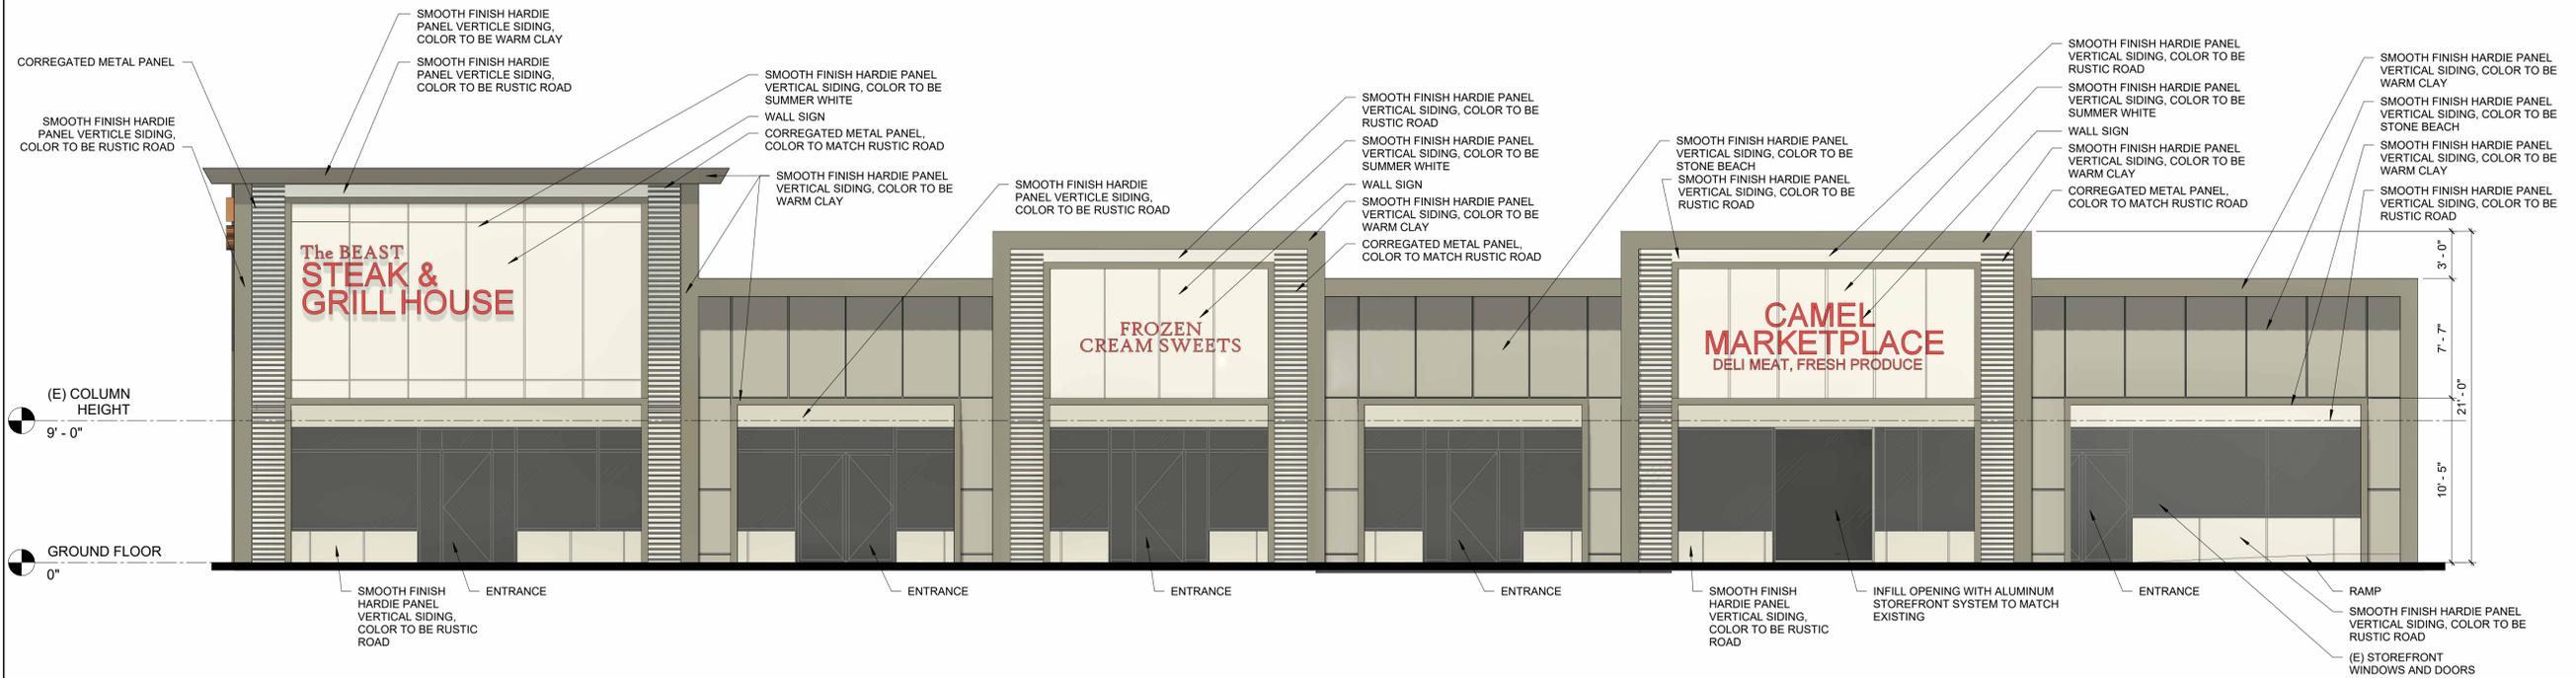

2 810 S HAVANA - PROPOSED SOUTH ELEVATION
SCALE: 3/16" = 1'-0"


PROJECT :
**HAVANA SHOPS SITE MINOR AMENDMENT
APPLICATION**
800 S HAVANA STREET, 810 S HAVANA STREET,
850 S HAVANA STREET AURORA, CO 80012

Drawn by: BLO, MAF
Checked by: DSP
Project Date: 7.9.24
Project #: 2024.32


S-003
As indicated

HAVANA SHOPS SITE MINOR AMENDMENT APPLICATION

LOTS 2 & 3, BLOCK 1, COLONY SUBDIVISION FILING NO. 1, AND
A PART OF TRACT 9 IN HAVANA GARDENS IN THE SW 1/4,
SECTION 14, T.4S., R.67W., OF THE 6TH P.M., CITY OF AURORA,
COUNTY OF ARAPAHOE, STATE OF COLORADO

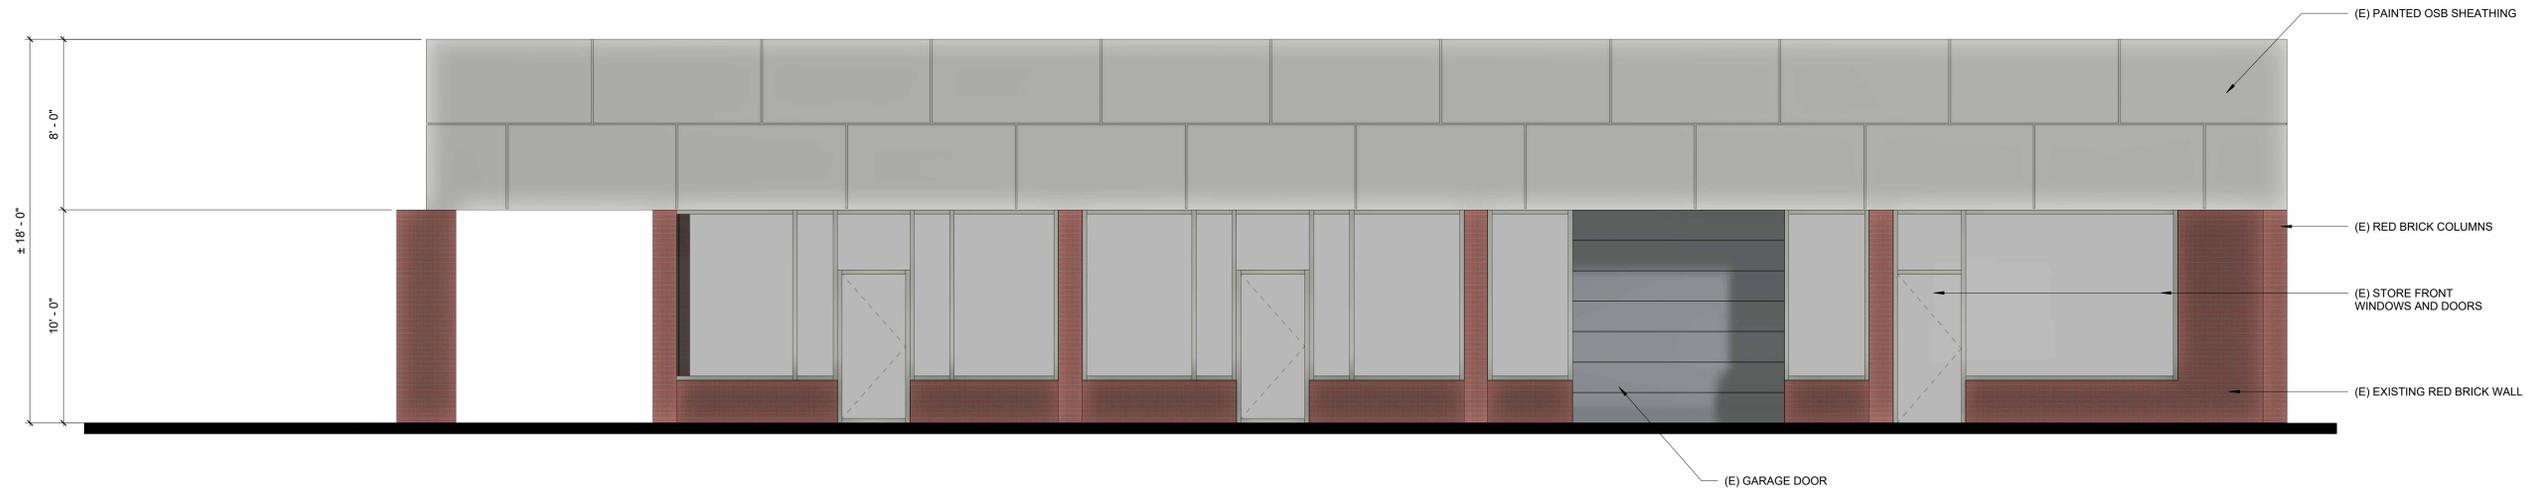

1 850 S HAVANA - EXISTING WEST ELEVATION
SCALE: 1/4" = 1'-0"

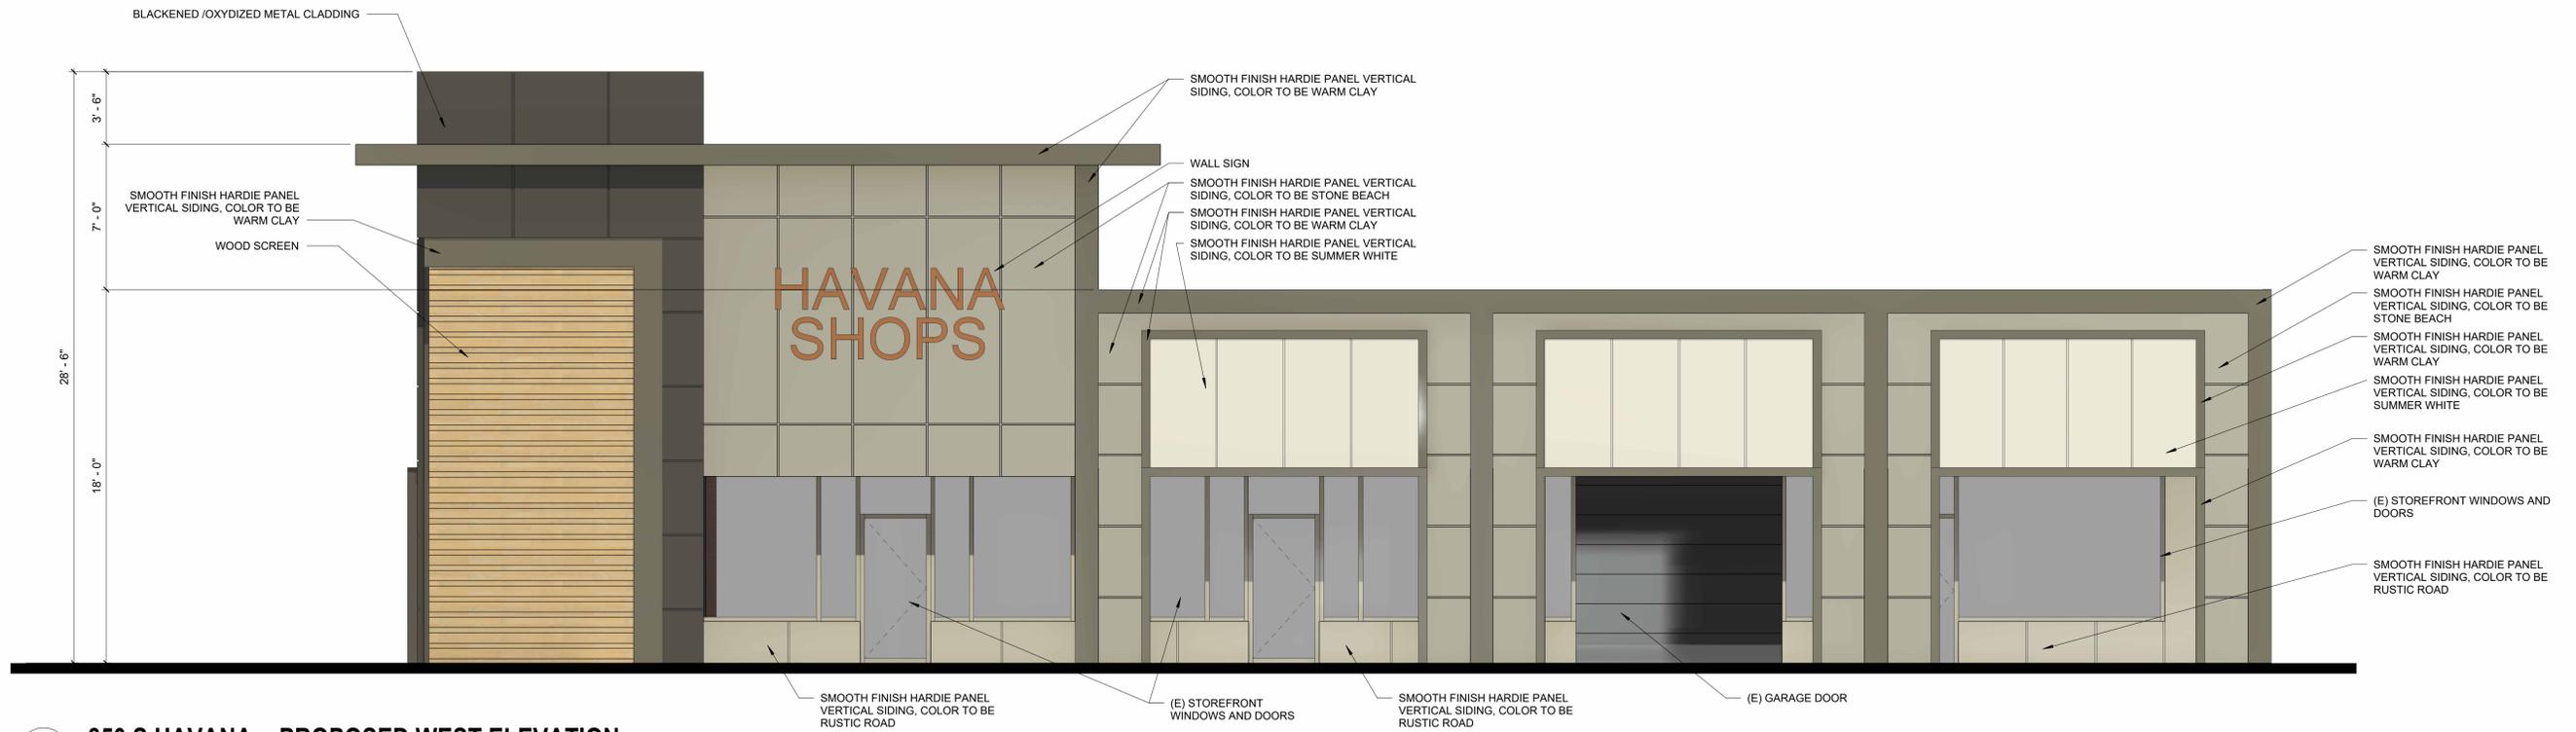

2 850 S HAVANA - PROPOSED WEST ELEVATION
SCALE: 1/4" = 1'-0"

EQUIPMENT DATA ARCHITECTURE, L.L.C.
ALL RIGHTS RESERVED.
THIS DOCUMENT CONTAINS DRAWINGS, IDEAS AND DESIGNS
AND IS AN INSTRUMENT OF SERVICE, AND AS SUCH, REMAINS
THE SOLE PROPERTY OF EQUIPMENT DATA ARCHITECTURE, L.L.C. AND
ALL OTHER PROPERTY RIGHTS IN THESE DRAWINGS, IDEAS,
AND DESIGNS, THESE DRAWINGS, IDEAS AND DESIGNS SHALL
NOT BE REPRODUCED, CHANGED, OR COPIED IN ANY FORM,
WHETHER OR NOT ATTRIBUTED TO ANY THIRD PARTY.
NO PART OF THIS DOCUMENT SHALL BE REPRODUCED OR
TRANSMITTED IN ANY FORM OR BY ANY MEANS, ELECTRONIC OR
MECHANICAL, INCLUDING PHOTOCOPYING, RECORDING, OR BY
ANY INFORMATION STORAGE AND RETRIEVAL SYSTEM, WITHOUT
THE WRITTEN CONSENT OF EQUIPMENT DATA ARCHITECTURE,
L.L.C. THESE DRAWINGS, IDEAS AND DESIGNS SHALL
NOT BE USED FOR ANY OTHER PROJECT WITHOUT THE
CONSENT OF EQUIPMENT DATA ARCHITECTURE, L.L.C. AND THE
PAYMENT OF ADDITIONAL COMPENSATION TO THE
ARCHITECT. YOUR RECEIPT OF THESE DRAWINGS, IDEAS AND
DESIGNS CONSTITUTES CONCLUSIVE EVIDENCE OF YOUR
AGREEMENT TO THESE RESTRICTIONS. VIOLATIONS SHALL
BE PROSECUTED.

SHEET NAME :
**850 S HAVANA STREET
WEST ELEVATION**

PROJECT :
**HAVANA SHOPS SITE MINOR AMENDMENT
APPLICATION**
800 S HAVANA STREET, 810 S HAVANA STREET,
850 S HAVANA STREET AURORA, CO 80012


Drawn by: BLO, MAF
Checked by: DSP
Project Date: 7.9.24
Project #: 2024.32

S-004
As indicated


HAVANA SHOPS SITE MINOR AMENDMENT APPLICATION

LOTS 2 & 3, BLOCK 1, COLONY SUBDIVISION FILING NO. 1, AND
A PART OF TRACT 9 IN HAVANA GARDENS IN THE SW 1/4,
SECTION 14, T.4S., R.67W., OF THE 6TH P.M., CITY OF AURORA,
COUNTY OF ARAPAHOE, STATE OF COLORADO

EQUIPMENT DATA ARCHITECTURE, L.L.C.
ALL RIGHTS RESERVED.
THIS DOCUMENT CONTAINS DRAWINGS, IDEAS AND DESIGNS
AND IS AN INSTRUMENT OF SERVICE, AND AS SUCH, REMAINS
THE SOLE PROPERTY OF EQUIPMENT DATA ARCHITECTURE, L.L.C. THE
ARCHITECT, THE ARCHITECT'S LICENSEE(S), CONTRACTOR(S) AND
ALL OTHER PROPERTY RIGHTS IN THESE DRAWINGS, IDEAS,
AND DESIGNS, THESE DRAWINGS, IDEAS, AND DESIGNS SHALL
NOT BE REPRODUCED, CHANGED, OR COPIED IN ANY FORM,
WHICH SHALL BE ASSIGNED TO ANY THIRD PARTY.
WITHOUT THE WRITTEN CONSENT OF THE ARCHITECT, THESE
DRAWINGS, IDEAS AND DESIGNS SHALL NOT BE USED BY THE
CLIENT OR ANY OTHER PARTY IN CONNECTION WITH ANY
PROJECT OTHER THAN THE SPECIFIC PROJECT FOR WHICH
THE ARCHITECT PREPARED THEM. WITHOUT THE WRITTEN
CONSENT OF THE ARCHITECT, THESE DRAWINGS, IDEAS AND
DESIGNS SHALL NOT BE USED AS EVIDENCE OF YOUR
AGREEMENT TO THESE RESTRICTIONS. VIOLATION SHALL
BE PROSECUTED.
I CERTIFY THAT THESE DOCUMENTS WERE PREPARED OR
APPROVED BY ME AND THAT I AM A DULY LICENSED
ARCHITECTURE FIRM UNDER THE LAWS OF THE STATE OF
COLORADO.

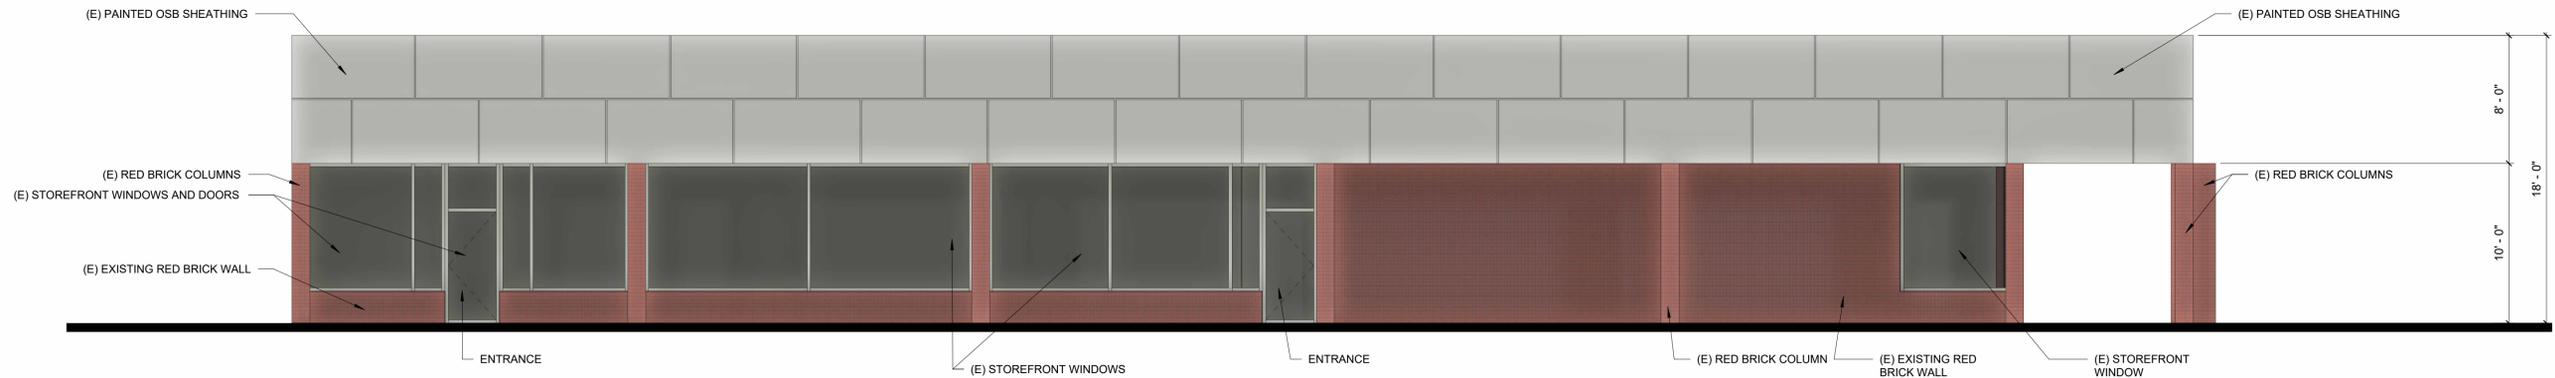

1 850 S HAVANA - EXISTING NORTH ELEVATION
SCALE: 3/16" = 1'-0"

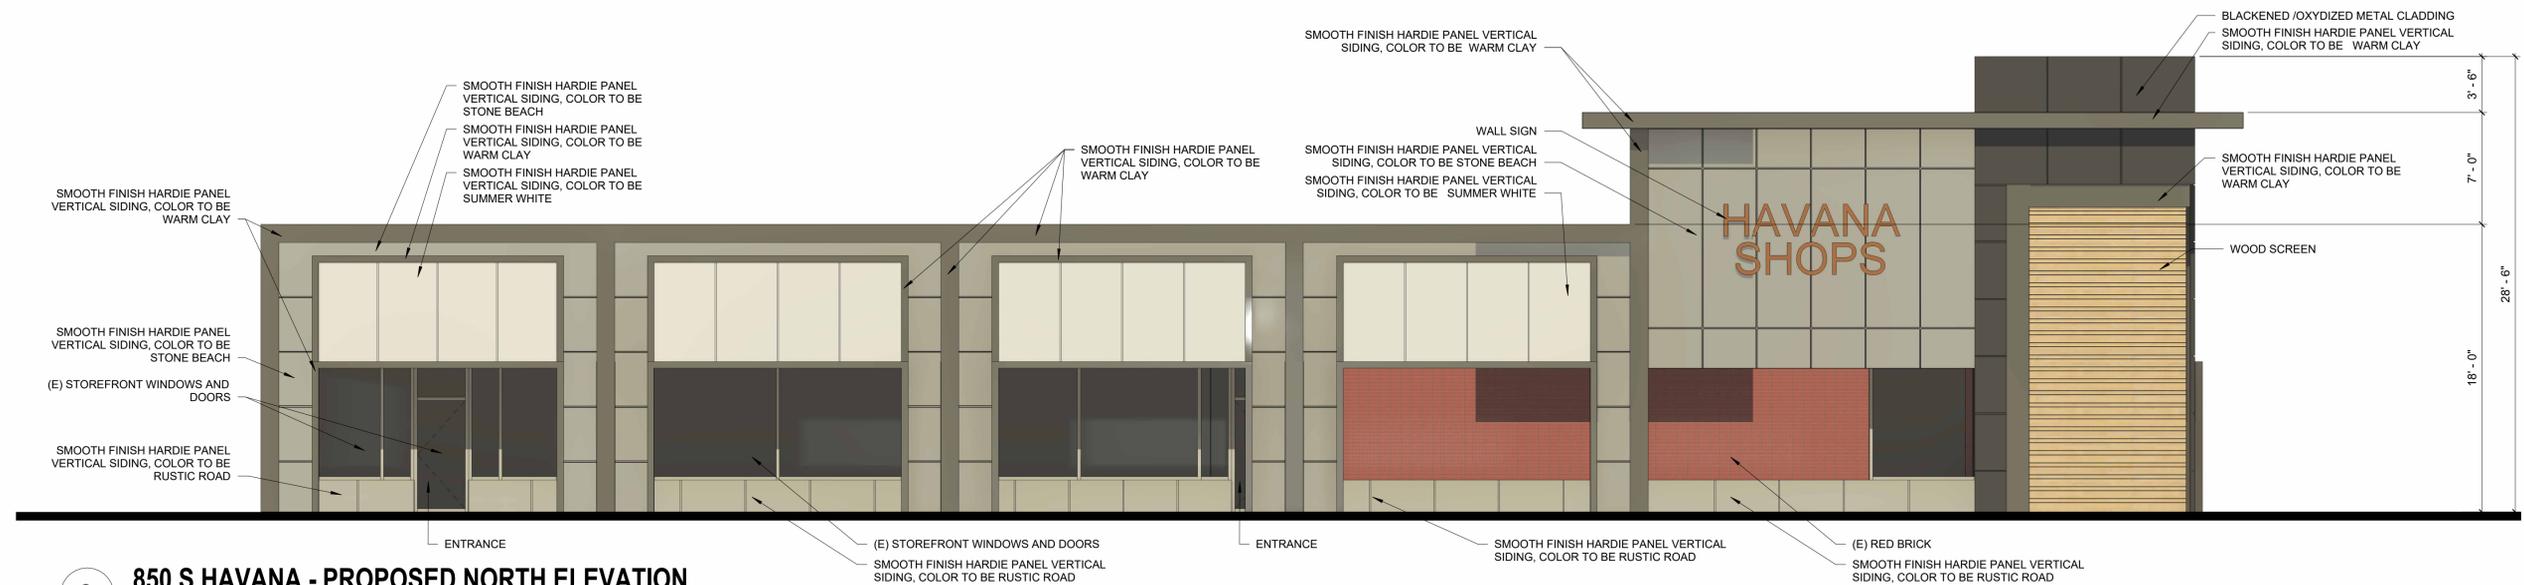

2 850 S HAVANA - PROPOSED NORTH ELEVATION
SCALE: 3/16" = 1'-0"

SHEET NAME :
**850 S HAVANA STREET
NORTH ELEVATION**

PROJECT :
**HAVANA SHOPS SITE MINOR AMENDMENT
APPLICATION**
800 S HAVANA STREET, 810 S HAVANA STREET,
850 S HAVANA STREET AURORA, CO 80012

Drawn by: Author
Checked by: Checker
Project Date: 7.9.24
Project #: 2024.32


S-005
As indicated

HAVANA SHOPS SITE MINOR AMENDMENT APPLICATION

LOTS 2 & 3, BLOCK 1, COLONY SUBDIVISION FILING NO. 1, AND
A PART OF TRACT 9 IN HAVANA GARDENS IN THE SW 1/4,
SECTION 14, T.4S., R.67W., OF THE 6TH P.M., CITY OF AURORA,
COUNTY OF ARAPAHOE, STATE OF COLORADO




COPYRIGHT 2024 BY ARCHITECTURE 4, L.L.C. ALL RIGHTS RESERVED. THIS DOCUMENT CONTAINS DRAWINGS, IDEAS AND DESIGNS AND IS AN INSTRUMENT OF SERVICE, AND AS SUCH, REMAINS THE SOLE PROPERTY OF ARCHITECTURE 4, L.L.C. THE ARCHITECT. THE ARCHITECT'S LIABILITY TO CONTRACTORS AND ALL OTHER PROPERTY RIGHTS IN THESE DRAWINGS, IDEAS AND DESIGNS, THESE DRAWINGS, IDEAS AND DESIGNS SHALL NOT BE REPRODUCED, CHANGED, OR COPIED IN ANY FORM, WITHOUT THE WRITTEN CONSENT OF ARCHITECTURE 4, L.L.C. ARCHITECT. THESE DRAWINGS, IDEAS AND DESIGNS SHALL NOT BE USED BY THE CLIENT OR ANY OTHER PARTY IN CONNECTION WITH ANY PROJECT OTHER THAN THE SPECIFIC PROJECT FOR WHICH THE ARCHITECT PREPARED THEM WITHOUT THE WRITTEN CONSENT OF ARCHITECTURE 4, L.L.C. ARCHITECT. YOUR RECEIPT OF THESE DRAWINGS, IDEAS AND DESIGNS CONSTITUTES CONCLUSIVE EVIDENCE OF YOUR ACCEPTANCE OF THESE RESTRICTIONS. VIOLATION SHALL BE PROSECUTED. I CERTIFY THAT THESE DOCUMENTS WERE PREPARED OR APPROVED BY ME AND THAT I AM A DULY LICENSED ARCHITECTURE FIRM UNDER THE LAWS OF THE STATE OF COLORADO.

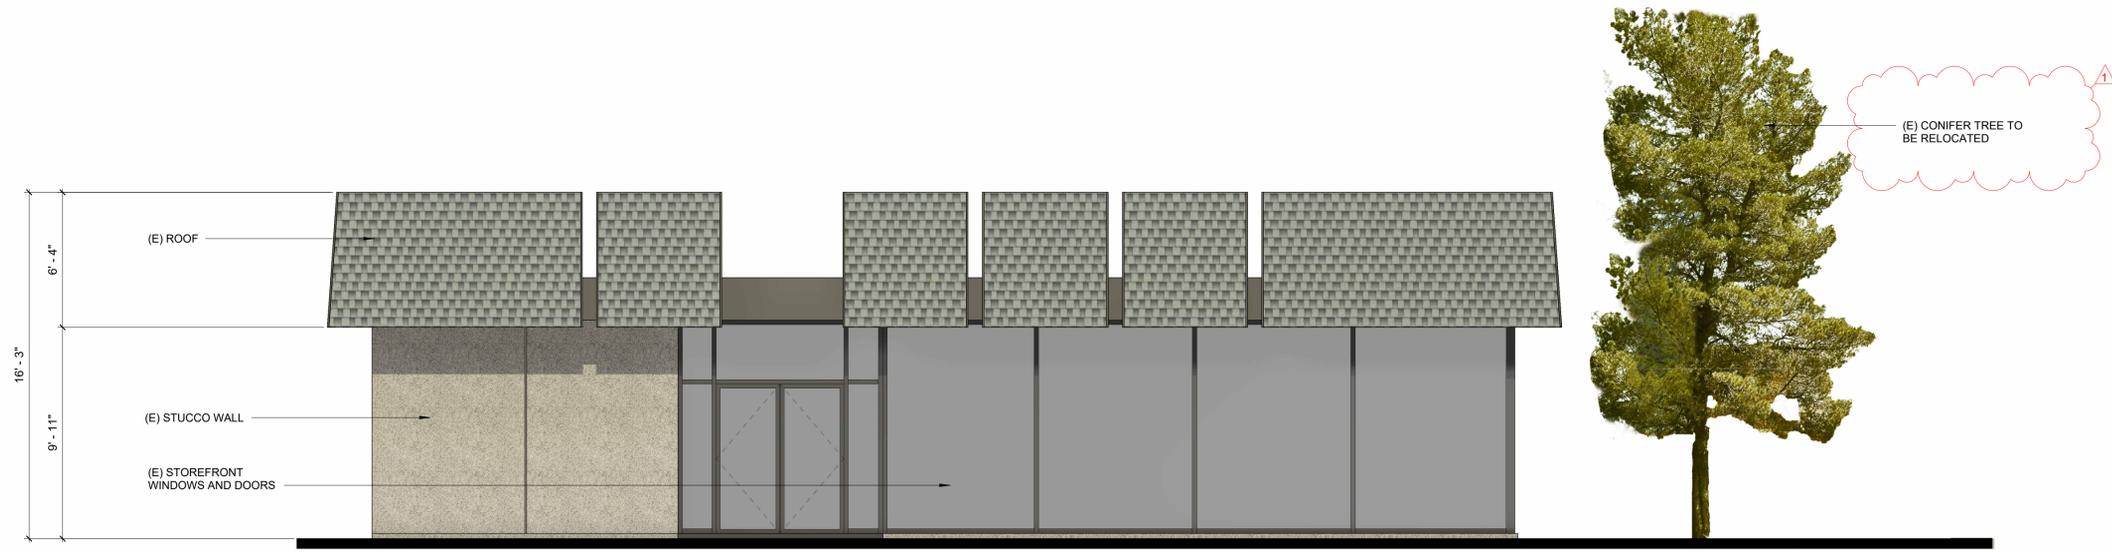

4.24.2024 MINOR AMENDMENT TO REFLECT AS-BUILT CONDITIONS AND RELOCATE 1 CONIFEROUS TREE GREATER THAN 4" CALIPER, TO ACCOMMODATE NEW COVERED PATIO AT 800 S HAVANA STREET

1 800 S HAVANA - EXISTING WEST ELEVATION
SCALE: 1/4" = 1'-0"

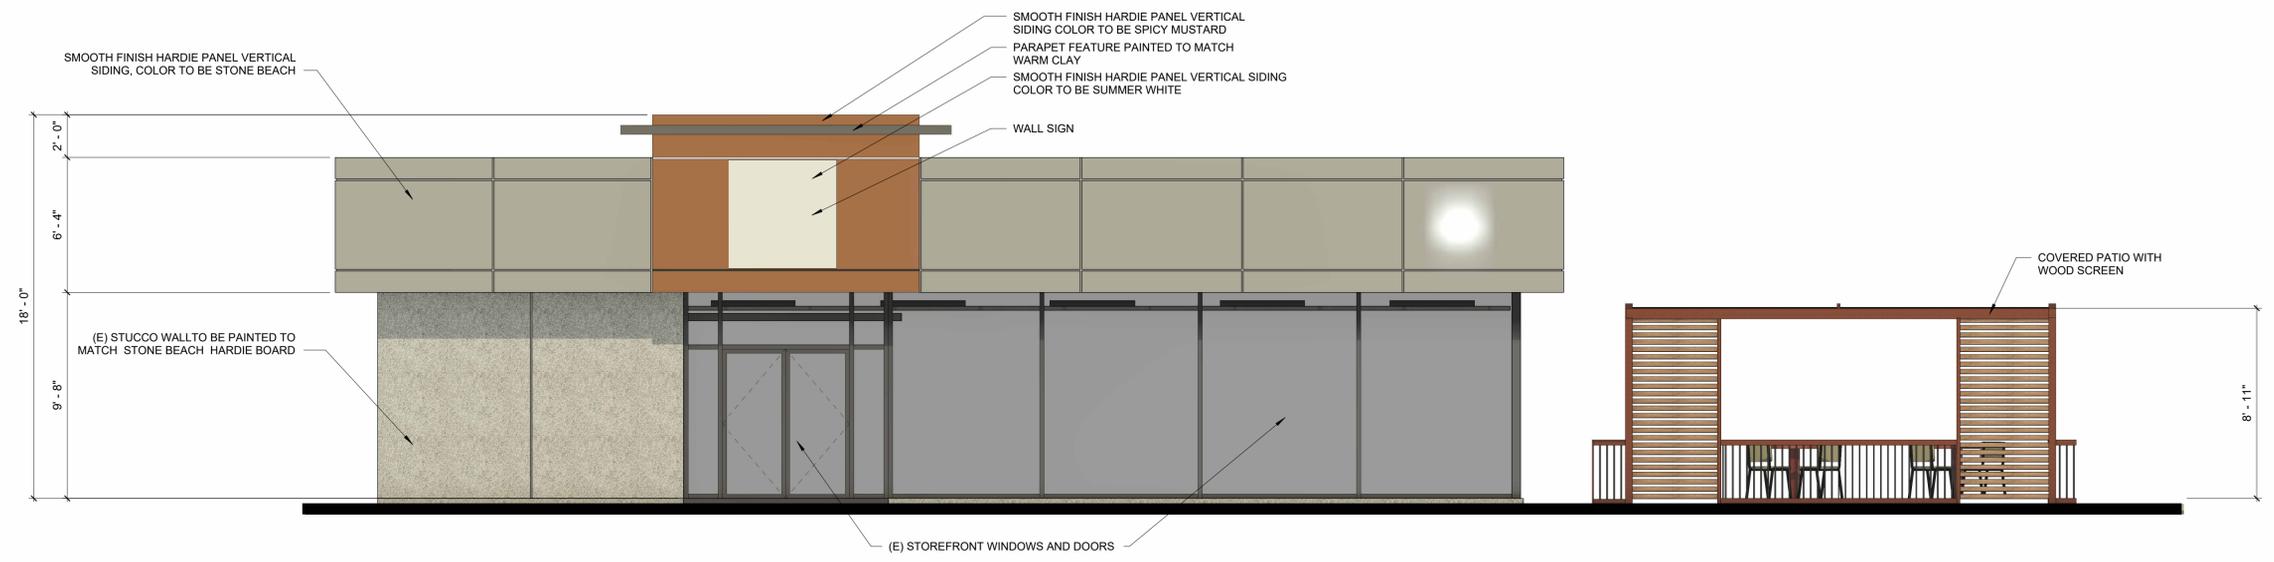

2 800 S HAVANA - PROPOSED WEST ELEVATION
SCALE: 1/4" = 1'-0"

SHEET NAME :
**800 S HAVANA STREET
WEST ELEVATION**

PROJECT :
**HAVANA SHOPS SITE MINOR AMENDMENT
APPLICATION**
800 S HAVANA STREET, 810 S HAVANA STREET,
850 S HAVANA STREET AURORA, CO 80012

Drawn by: BLO
Checked by: DSP
Project Date: 7.9.24
Project #: 2024.32

S-006
As indicated