

Ready for Technical Referral, Minor comments,
Sidewalk at the North, Sidewalk Easement

Advisory Comment:
The Preliminary Drainage Study must be approved before the site plan can be approved.


 מרכז מדיניות וסדרה

1900 S CHAMBERS COMMUNITY
SITE PLAN AMENDMENT WITH ADJUSTMENT
AURORA, COLORADO
COVER SHEET

[illegible]

PA / PM:	JN / AH
DRAWN BY:	TB
JOB NO.:	23010

SHEET

01

GENERAL NOTES

1. THE DEVELOPER, SUCCESSORS OR ASSIGNS, INCLUDING THE HOMEOWNERS OR MERCHANTS ASSOCIATION, SHALL BE RESPONSIBLE FOR INSTALLATION, MAINTENANCE AND REPLACEMENT OF ALL FIRE LANE SIGNS AS REQUIRED BY THE CITY OF AURORA.
2. RIGHT-OF-WAY FOR INGRESS AND EGRESS FOR EMERGENCY VEHICLES IS GRANTED OVER, ACROSS, ON, AND THROUGH ANY AND ALL PRIVATE ROADS, WAYS, FIRE LANES EASEMENTS OR FIRE LANE CORRIDORS NOW OR HEREAFTER ESTABLISHED ON THE DESCRIBED PROPERTY. WHERE DEDICATED AS A FIRE LANE EASEMENT OR DESIGNATED AS A FIRE LANE CORRIDOR, THE ROADWAY SHALL BE POSTED "NO PARKING - FIRE LANE".
3. "ACCESSIBLE EXTERIOR ROUTES" SHALL BE PROVIDED FROM PUBLIC TRANSPORTATION STOPS, ACCESSIBLE PARKING, ACCESSIBLE PASSENGER LOADING ZONES AND PUBLIC SIDEWALKS TO THE ACCESSIBLE BUILDING ENTRANCE THEY SERVE. AT LEAST 50% OF ALL BUILDING ENTRANCES SHALL BE THE MOST PRACTICAL DIRECT ROUTE. NO SLOPE ALONG THIS ROUTE MAY EXCEED 1:20 WITHOUT PROVIDING A RAMP WITH A MAXIMUM SLOPE OF 1:12 AND HANDRAILS. CROSSWALKS ALONG THIS ROUTE SHALL BE WIDE ENOUGH TO WHOLLY CONTAIN THE CURB RAMP WITH A MINIMUM WIDTH OF 36" AND SHALL BE PAINTED WITH WHITE STRIPES. REQUIRED ACCESSIBLE MEANS OF EGRESS SHALL BE CONTINUOUS FROM EACH REQUIRED ACCESSIBLE OCCUPIED AREA TO THE PUBLIC WAY. THE "ACCESSIBLE EXTERIOR ROUTES" SHALL COMPLY WITH IBC CHAPTER 11, AND ICC A117.1.
4. THE APPLICANT HAS THE OBLIGATION TO COMPLY WITH ALL APPLICABLE REQUIREMENTS OF THE AMERICAN WITH DISABILITIES ACT.
5. THE DEVELOPER, SUCCESSORS OR ASSIGNS, SHALL BE RESPONSIBLE FOR INSTALLATION, MAINTENANCE AND REPLACEMENT OF ALL LANDSCAPING MATERIALS SHOWN OR INDICATED ON THE APPROVED SITE PLAN OR LANDSCAPE PLAN ON FILE IN THE PLANNING AND DEVELOPMENT SERVICES DEPARTMENT. ALL LANDSCAPING WILL BE INSTALLED PRIOR TO ISSUANCE OF CERTIFICATE OF OCCUPANCY.
6. ALL CROSSINGS OR ENCROACHMENTS INTO EASEMENTS AND RIGHTS-OF-WAY OWNED BY THE CITY OF AURORA ("CITY") IDENTIFIED AS BEING PRIVATELY-OWNED AND MAINTAINED HEREIN ARE ACKNOWLEDGED BY THE UNDERSIGNED AS BEING SUBJECT TO THE CITY'S USE AND OCCUPANCY OF SAID EASEMENTS OR RIGHTS-OF-WAY. THE UNDERSIGNED, ITS SUCCESSORS AND ASSIGNS, FURTHER AGREES TO REMOVE, REPAIR, REPLACE, RELOCATE, MODIFY, OR OTHERWISE ADJUST SAID CROSSINGS UPON REQUEST FROM THE CITY AT NO EXPENSE TO THE CITY. THE CITY RESERVES THE RIGHT TO MAKE FULL USE OF THE EASEMENTS AND RIGHTS-OF-WAY AS MAY BE NECESSARY OR CONVENIENT AND THE CITY RETAINS ALL RIGHTS TO OPERATE, MAINTAIN, INSTALL, REPAIR, REMOVE OR RELOCATE ANY CITY FACILITIES LOCATED WITHIN SAID EASEMENTS AND RIGHTS-OF-WAY AT ANY TIME IN SUCH A MANNER AS IT DEEMS NECESSARY OR CONVENIENT.
7. THE STREETLIGHT INSTALLATION WITHIN THE PUBLIC RIGHT-OF-WAY SHALL BE DESIGNED, FUNDED, AND CONSTRUCTED BY THE DEVELOPER/OWNER. OWNERSHIP AND MAINTENANCE OF THE STREET/PEDESTRIAN LIGHTS SHALL BE THE RESPONSIBILITY OF THE CITY OF AURORA ONCE THEY HAVE BEEN ACCEPTED. STREET LIGHT AND/OR PEDESTRIAN PHOTOMETRICS PLANS SHALL BE PREPARED AND SUBMITTED TO THE CITY FOR REVIEW AND APPROVAL AND SHALL BECOME A PART OF THE APPROVED CIVIL CONSTRUCTION PLANS FOR THE PROJECT. SEPARATE PERMITS FOR STREET LIGHTS WILL BE REQUIRED: ONE FOR PUBLIC IMPROVEMENTS AND ONE FOR A BUILDING PERMIT FOR ELECTRICAL. THE BUILDING PERMIT SUBMITTAL WILL NEED TO INCLUDE AN ELECTRICAL PLAN SHOWING SITE LOCATION OF LIGHTS, ELECTRIC METER LOCATION, ELECTRICAL ONE LINE AND GROUNDING DETAILS AND ANY ADDITIONAL ELECTRICAL INFORMATION FOR APPROVAL. THE OWNER IS RESPONSIBLE FOR OBTAINING AN ADDRESS FOR THE METER(S) FROM THE PLANNING DEPARTMENT. CERTIFICATE OF OCCUPANCIES WILL NOT BE ISSUED UNTIL THE STREET AND/OR PEDESTRIAN LIGHTING PLANS ARE APPROVED, CONSTRUCTED, AND INITIALLY ACCEPTED.
8. PRIOR TO FINAL ACCEPTANCE OF PUBLIC IMPROVEMENTS, IF THE ADJACENT SITE IS NOT UNDER CONSTRUCTION, THE CURB CUT/CURB RETURNS AND CROSS PAN MUST BE REMOVED AND REPLACED WITH SIDEWALK, LANDSCAPING AND CURB AND GUTTER AT THE DEVELOPER'S EXPENSE. THE DEVELOPER ACKNOWLEDGES THE RISK OF CONSTRUCTING THE CURB CUT WITHOUT APPROVED CIVIL PLANS FOR THE ADJACENT SITE SHOWING THE CURB CUT.
9. THE APPROVAL OF THIS DOCUMENT DOES NOT CONSTITUTE FINAL APPROVAL OF GRADING, DRAINAGE, UTILITY, PUBLIC IMPROVEMENTS AND BUILDING PLANS. CONSTRUCTION PLANS MUST BE REVIEWED AND APPROVED BY THE APPROPRIATE AGENCY PRIOR TO THE ISSUANCE OF BUILDING PERMITS.
10. ALL BUILDING ADDRESS NUMBERS SHALL COMPLY WITH SECTIONS 126-271 AND 126-278 OF THE AURORA CITY CODE.
11. ALL ROOFTOP MECHANICAL EQUIPMENT AND VENTS GREATER THAN EIGHT (8) INCHES IN DIAMETER MUST BE SCREENED. SCREENING MAY BE DONE EITHER WITH AN EXTENDED PARAPET WALL OR A FREESTANDING SCREEN WALL. SCREENS SHALL BE AT LEAST AS HIGH AS THE EQUIPMENT THEY HIDE. IF EQUIPMENT IS VISIBLE BECAUSE SCREENS DON'T MEET THIS MINIMUM HEIGHT REQUIREMENT, THE DIRECTOR OF PLANNING AND DEVELOPMENT SERVICES MAY REQUIRE CONSTRUCTION MODIFICATIONS PRIOR TO THE ISSUANCE OF A PERMANENT CERTIFICATE OF OCCUPANCY.
12. NOTWITHSTANDING ANY SURFACE IMPROVEMENTS, LANDSCAPING, PLANTING OR CHANGES SHOWN IN THESE SITE OR CONSTRUCTION PLANS, OR ACTUALLY CONSTRUCTED OR PUT IN PLACE, ALL UTILITY EASEMENTS MUST REMAIN UNOBSTRUCTED AND FULLY ACCESSIBLE ALONG THEIR ENTIRE LENGTH TO ALLOW FOR ADEQUATE MAINTENANCE EQUIPMENT. ADDITIONALLY, NO INSTALLATION, PLANTING, CHANGE IN THE SURFACE, ETC., SHALL INTERFERE WITH THE OPERATION OF THE UTILITY LINES PLACED WITHIN THE EASEMENT. BY SUBMITTING THESE SITE OR CONSTRUCTION PLANS FOR APPROVAL, THE LANDOWNER RECOGNIZES AND ACCEPTS THE TERMS, CONDITIONS AND REQUIREMENTS OF THIS NOTE.
13. FINAL GRADE SHALL BE AT LEAST SIX (6) INCHES BELOW ANY EXTERIOR WOOD SIDING ON THE PREMISES.
14. ALL INTERESTED PARTIES ARE HEREBY ALERTED THAT THIS SITE PLAN IS SUBJECT TO ADMINISTRATIVE CHANGES AND AS SHOWN ON THE ORIGINAL SITE PLAN ON FILE IN THE AURORA CITY PLANNING AND DEVELOPMENT SERVICES DEPARTMENT. A COPY OF THE OFFICIAL CURRENT PLAN MAY BE OBTAINED THERE. LIKEWISE, SITE PLANS ARE REQUIRED TO AGREE WITH THE APPROVED SUBDIVISION PLAT OF RECORD AT THE TIME OF A BUILDING PERMIT, AND IF NOT, MUST BE AMENDED TO AGREE WITH THE PLAT AS NEEDED, OR VICE VERSA.
15. ERRORS IN APPROVED SITE PLANS RESULTING FROM COMPUTATIONS OR INCONSISTENCIES IN THE DRAWINGS MADE BY THE APPLICANT ARE THE RESPONSIBILITY OF THE PROPERTY OWNER OF RECORD. WHERE FOUND, THE CURRENT MINIMUM CODE REQUIREMENTS WILL APPLY AT THE TIME OF BUILDING PERMIT. PLEASE BE SURE THAT ALL PLAN COMPUTATIONS ARE CORRECT.
16. ALL REPRESENTATIONS AND COMMITMENTS MADE BY APPLICANTS AND PROPERTY OWNERS AT PUBLIC HEARINGS REGARDING THIS PLAN ARE BINDING UPON THE APPLICANT, PROPERTY OWNER, AND ITS HEIRS, SUCCESSORS, AND ASSIGNS.
17. ARCHITECTURAL FEATURES, SUCH AS BAY WINDOWS, FIREPLACES, ROOF OVERHANGS, GUTTERS, EAVES, FOUNDATIONS, FOOTINGS, CANTILEVERED WALLS, ETC., ARE NOT ALLOWED TO ENCROACH INTO ANY EASEMENT OR FIRE LANE.
18. (THIS NOTE IS REQUIRED ONLY WHEN APPLICABLE) ATTENTION BUILDING DEPARTMENT: AN ACOUSTIC ANALYSIS, PREPARED BY AN ACOUSTIC EXPERT, AND WILL IDENTIFY BUILDING DESIGN FEATURES NECESSARY TO ACCOMPLISH EXTERIOR NOISE REDUCTION TO ACHIEVE INTERIOR NOISE LEVELS NOT EXCEEDING ____ (25/30 – REFER TO SECTION 146-2.6.2.C.) DECIBELS AS CALCULATED IN CHAPTER 22 OF THE AURORA MUNICIPAL CODE UNDER WORSE-CASE NOISE CONDITIONS.
19. (THIS NOTE IS REQUIRED ONLY WHEN APPLICABLE) THE VENDOR OF ANY FUTURE SALE OF THE REAL PROPERTY SHALL PROVIDE THE REQUIRED NOTICE PER CITY CODE SECTION 146-1587(C) TO BE RECORDED WITH THE COUNTY CLERK AND RECORDER AND SHALL PROVIDE SUCH NOTICE TO EACH PROSPECTIVE PURCHASER OF ANY AND ALL SAID PROPERTY. SEE EXHIBIT C4 UNDER THE AIRPORT RELATED LAND USE RESTRICTIONS SECTION OF THIS GUIDEBOOK.
20. THE DEVELOPER IS RESPONSIBLE FOR SIGNING AND STRIPING ALL PUBLIC STREETS. THE DEVELOPER IS REQUIRED TO PLACE TRAFFIC CONTROL, STREET NAME, AND GUIDE SIGNS ON ALL PUBLIC STREETS AND PRIVATE STREETS APPROACHING AN INTERSECTION WITH A PUBLIC STREET. SIGNS SHALL BE FURNISHED AND INSTALLED PER THE MOST CURRENT EDITIONS OF THE MANUAL ON UNIFORM TRAFFIC CONTROL DEVICES (MUTCD) AND CITY STANDARDS, SHOWN ON THE SIGNING AND STRIPING PLAN FOR DEVELOPMENT.
21. FIRE LANE AND HANDICAPPED PARKING SIGNS, SIGN DETAILS, HANDICAPPED PARKING STALL DETAILS, AND LOCATIONS SHALL BE APPROVED WITH THE CIVIL PLANS, "SIGNAGE AND STRIPING" PACKAGE.
22. THIS SITE HAS THE FOLLOWING CONDITIONAL USE APPROVAL(S): (LIST ANY/ALL APPLICABLE USES AND THE DATE OF PLANNING COMMISSION APPROVAL – MULTITENANT BUILDINGS SHOULD LEAVE ROOM FOR MODIFICATIONS OR FUTURE ADDITIONS)
23. IN LOCATIONS WHERE UTILITY EASEMENTS OVERLAP DRAINAGE EASEMENTS, ONLY SUBSURFACE UTILITIES SHALL BE PERMITTED WITHIN THE PORTION OF THE UTILITY EASEMENT THAT OVERLAPS THE DRAINAGE EASEMENT. INSTALLATION OF ABOVE GROUND UTILITIES WITHIN A DRAINAGE EASEMENT REQUIRES PRIOR WRITTEN APPROVAL BY THE CITY ENGINEER



1900 S CHAMBERS COMMUNITY
SITE PLAN AMENDMENT WITH ADJUSTMENT
AURORA, COLORADO
GENERAL NOTES

NO.	DATE	REMARKS
1	05/15/2024	SITE PLAN

PA / PM:	JN / AH
DRAWN BY:	TB
JOB NO.:	23010


SHEET

02

SITE LOCATION DETAILS	
ADDRESS	1900 S. CHAMBERS ROAD
CITY/STATE/ZIP CODE	AURORA, COLORADO 80014
PARCEL ID	1975-20-3-29-001
COUNTY	ARAPAHOE COUNTY
ZONING MUNICIPALITY	AURORA ZONNING
ZONING	R-3

1900 S CHAMBERS COMMUNITY
LOT, 1 BLOCK 1, 1900 SOUTH CHAMBERS SUBDIVISION FILING NO. 1 / C2-2976
CITY OF AURORA, COUNTY OF ARAPAHOE, STATE OF COLORADO

LOT1, BLOCK 1
CHAMBERS U-STOR
SUB. FILING NO.1
REC. NO. A8106254

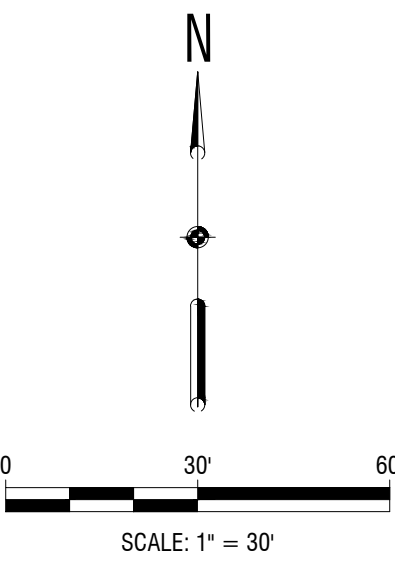


REPEATED COMMENT

Per Pre-App notes, please provide sidewalks at the north side past the property line connecting to existing sidewalk.

City is still requesting extension of sidewalk. Please continue to coordinate.

Please label the sidewalk easement. Sidewalk easement shall extend 0.5' from edge of the sidewalk.

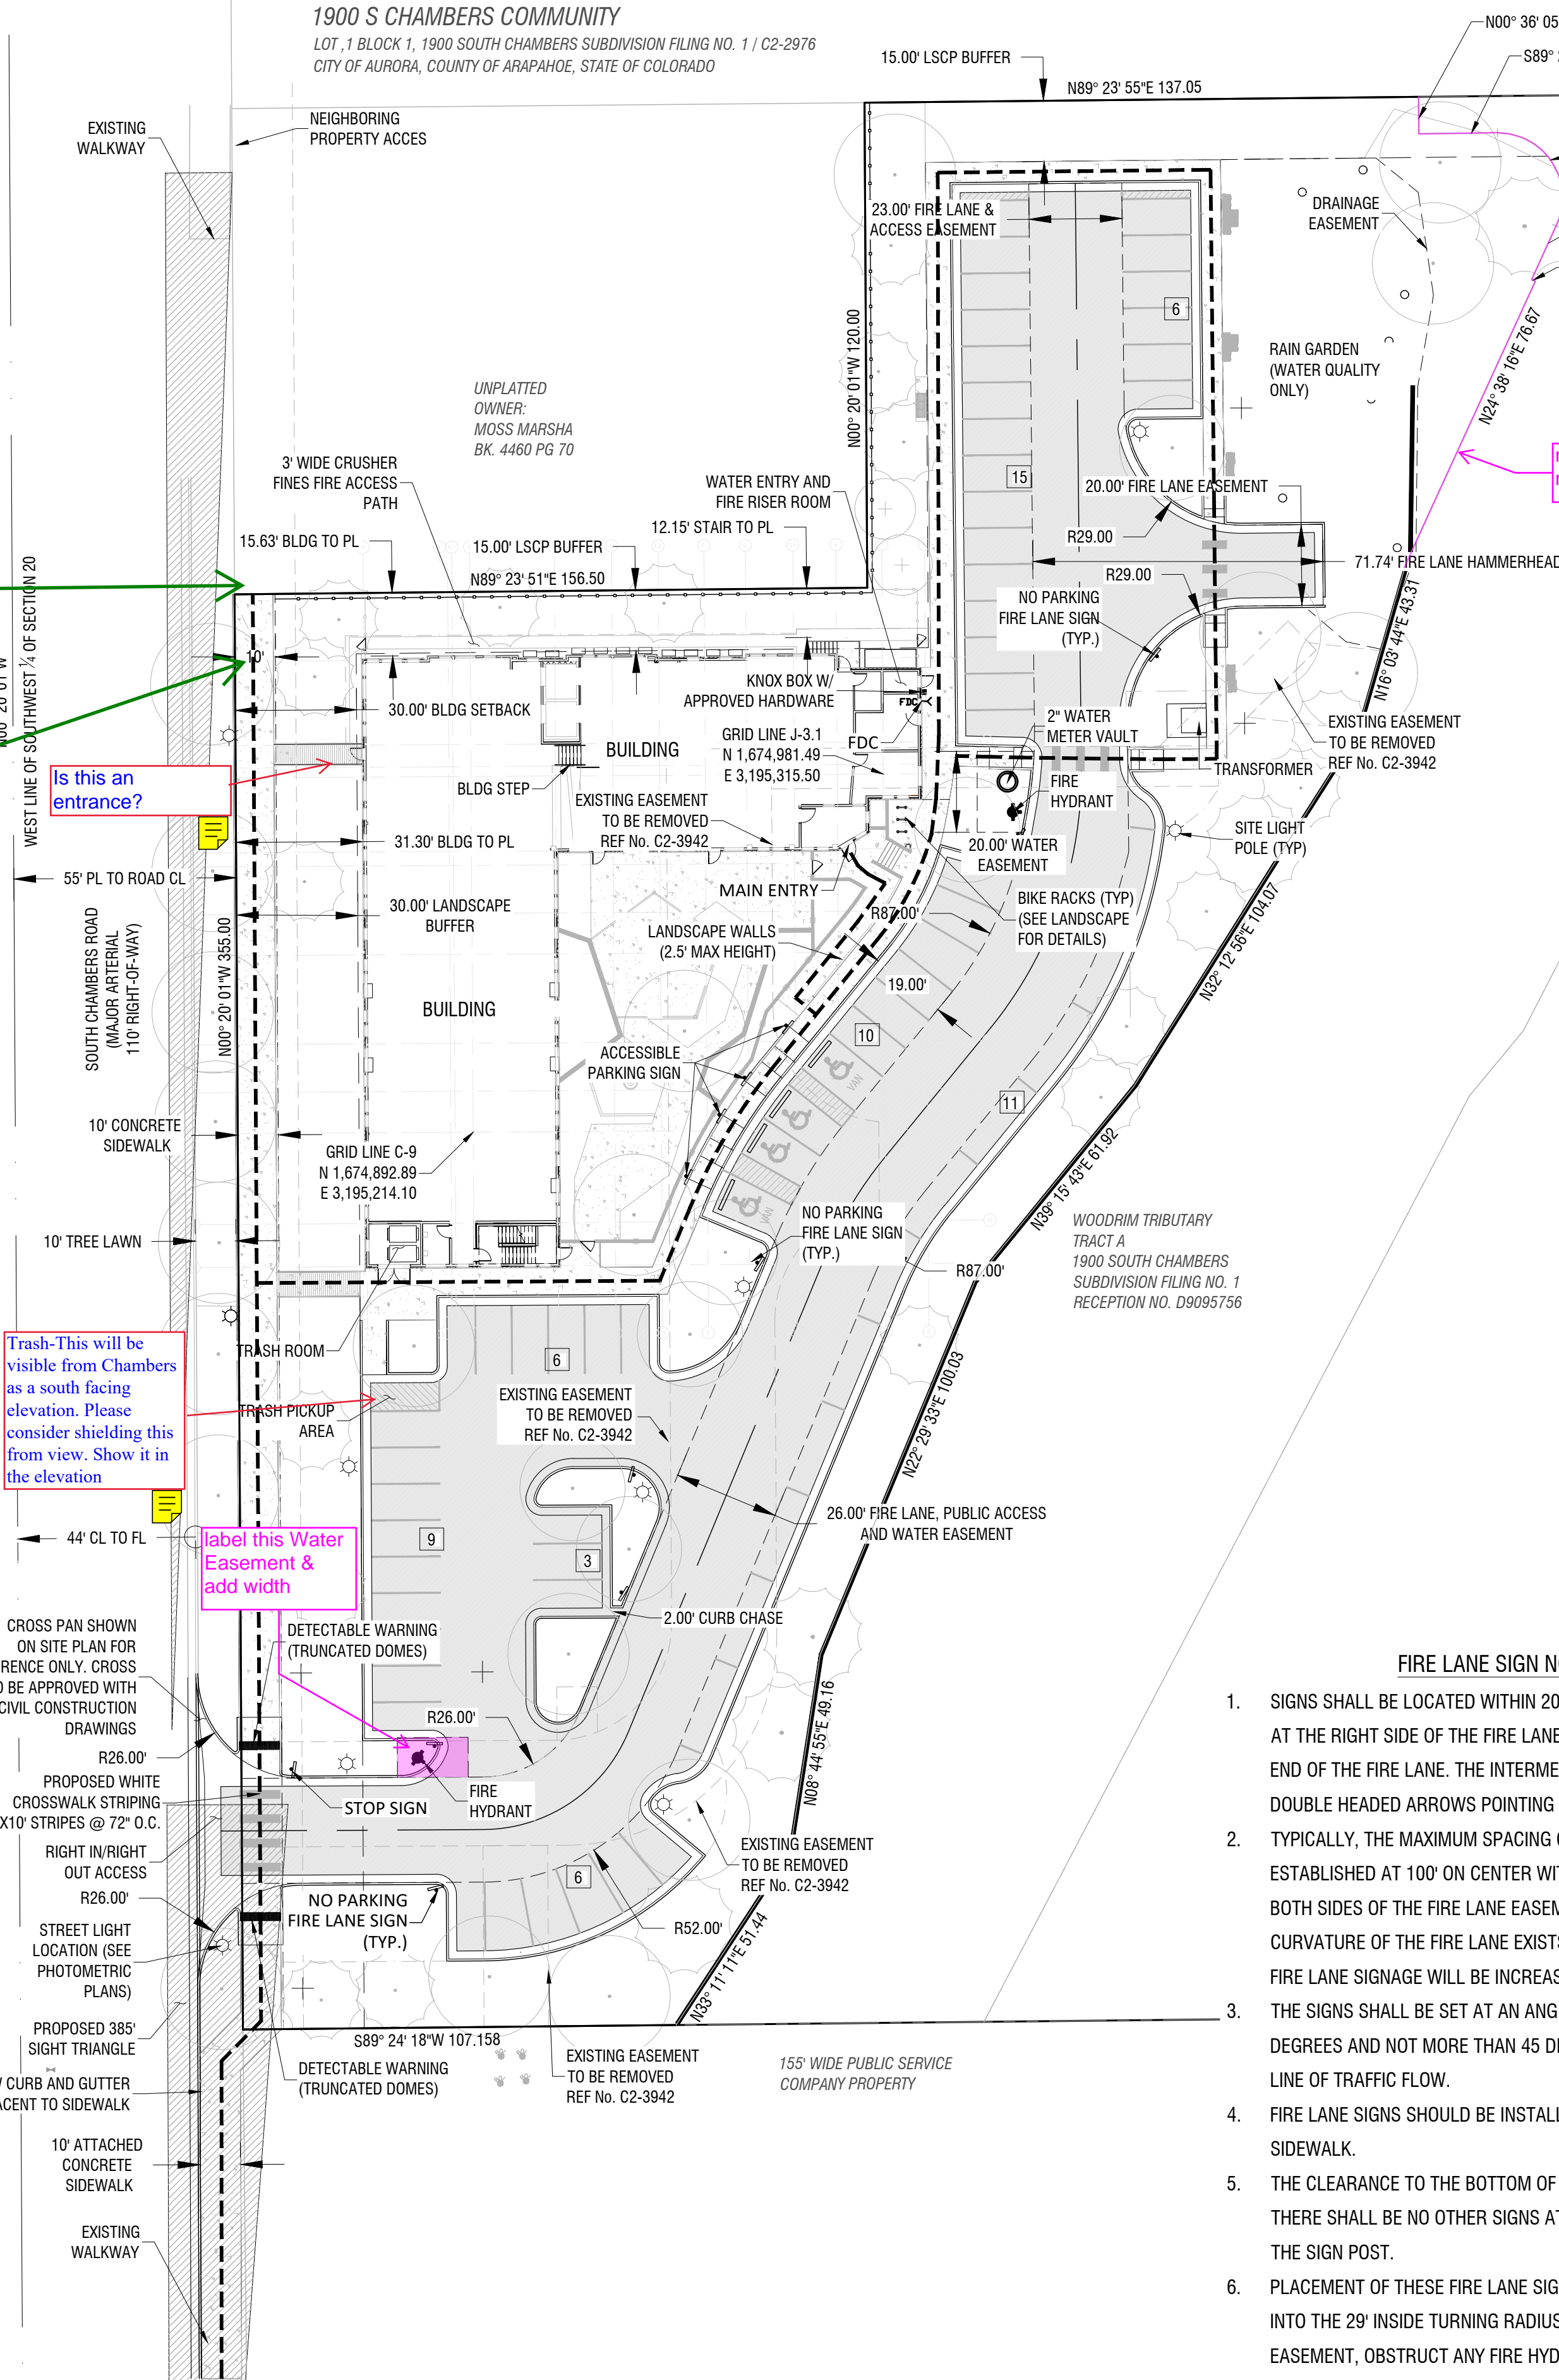

SITE PLAN NOTES

1. CONTRACTOR TO VERIFY EXISTING CONDITIONS AND NOTIFY THE ENGINEER OF ANY DISCREPANCIES PRIOR TO CONSTRUCTION.
2. ALL DIMENSIONS FROM FLOWLINE AND OUTSIDE BUILDING FACE UNLESS OTHERWISE NOTED
3. ALL ADA ACCESSIBLE RAMPS TO INCLUDE DETECTABLE WARNING PADS.
4. CONTRACTOR SHALL REMOVE AND REPLACE DAMAGED CURB, GUTTER, PAVING, AND LANDSCAPED AREAS OUTSIDE THE LIMITS OF SITE AND RESTORE BACK TO ITS ORIGINAL CONDITION.
5. PAVEMENT THICKNESS PER GEOTECH REPORT.
6. ALL ENTRANCES ARE PRIVATE UNLESS OTHERWISE NOTED.
7. ADDITIONAL ROADWAY IMPROVEMENTS MAY BE REQUIRED PENDING TIS UPDATES.
8. BENCHMARK: AURORA BENCHMARK POINT NO. 09-0708, 3" DIAMETER BRASS CAP ATOP THE NORTH EDGE OF A CURB OPENING INLET & CENTERED THEREON BEING ON THE WEST SIDE OF S. CHAMBERS ROAD & 40' MORE/LESS NORTH OF THE JEWELL LANDLINE AS EVIDENCED BY THE RANGE BOX IN S. CHAMBERS ROAD. PUBLISHED ELEVATION = 5535.38

SITE PLAN LEGEND

PROPERTY LINE	
EXISTING CURB AND GUTTER	
EXISTING FIRE HYDRANT	
PROPOSED FENCE	
PROPOSED CURB AND GUTTER	
PROPOSED SPILL GUTTER	
PROPOSED SIDEWALK	
PROPOSED ASPHALT & SAWCUT	
PROPOSED FIRE HYDRANT	
PROPOSED TRANSFORMER	
PROPOSED SITE LIGHTING	
PROPOSED SIGNAGE	
PROPOSED ADA ACCESSIBLE ROUTE	
PROPOSED TREE LOCATION	
NUMBER OF PARKING STALLS	




SIGHT TRIANGLE NOTES

1 - AASHTO SIGHT TRIANGLE - NO OBSTRUCTIONS OVER 24" PERMITTED WITHIN THE SIGHT TRIANGLE. BASED ON 4.04.2.10.1.01

PROPOSED STREET LIGHT LOCATIONS ARE CONCEPTUAL. FINAL LOCATIONS WILL BE DETERMINED WITH PHOTOMETRIC ANALYSIS SUBMITTED WITH THE STREET LIGHTING PLANS IN THE CIVIL PLAN SUBMITTAL.

FIRE LANE SIGN NOTES

1. SIGNS SHALL BE LOCATED WITHIN 20' FROM ANY INTERSECTION, AT THE RIGHT SIDE OF THE FIRE LANE ENTRANCE AND AT THE END OF THE FIRE LANE. THE INTERMEDIATE SIGNS SHALL HAVE DOUBLE HEADED ARROWS POINTING IN BOTH DIRECTIONS.
2. TYPICALLY, THE MAXIMUM SPACING OF THE FIRE LANE SIGNS IS ESTABLISHED AT 100' ON CENTER WITH SIGNS BEING PLACED ON BOTH SIDES OF THE FIRE LANE EASEMENT. WHERE EXCESSIVE CURVATURE OF THE FIRE LANE EXISTS, THE SPACING OF THE FIRE LANE SIGNAGE WILL BE INCREASED AS NEEDED.
3. THE SIGNS SHALL BE SET AT AN ANGLE OF NOT LESS THAN 30 DEGREES AND NOT MORE THAN 45 DEGREES WITH THE CURB OR LINE OF TRAFFIC FLOW.
4. FIRE LANE SIGNS SHOULD BE INSTALLED 2' BEHIND CURB OR SIDEWALK.
5. THE CLEARANCE TO THE BOTTOM OF THE SIGN SHALL BE 7 FEET. THERE SHALL BE NO OTHER SIGNS ATTACHED TO THE SIGN OR THE SIGN POST.
6. PLACEMENT OF THESE FIRE LANE SIGNS CANNOT ENCROACH INTO THE 29' INSIDE TURNING RADIUS OF THE FIRE LANE EASEMENT, OBSTRUCT ANY FIRE HYDRANT OR FIRE DEPARTMENT CONNECTION OR ENCROACH INTO THE ACCESSIBLE ROUTE OF THE SIDEWALK AREA. FIRE HYDRANT SPACING IS BASED ON THE TRAVEL PATH OF A FIRE APPARATUS.

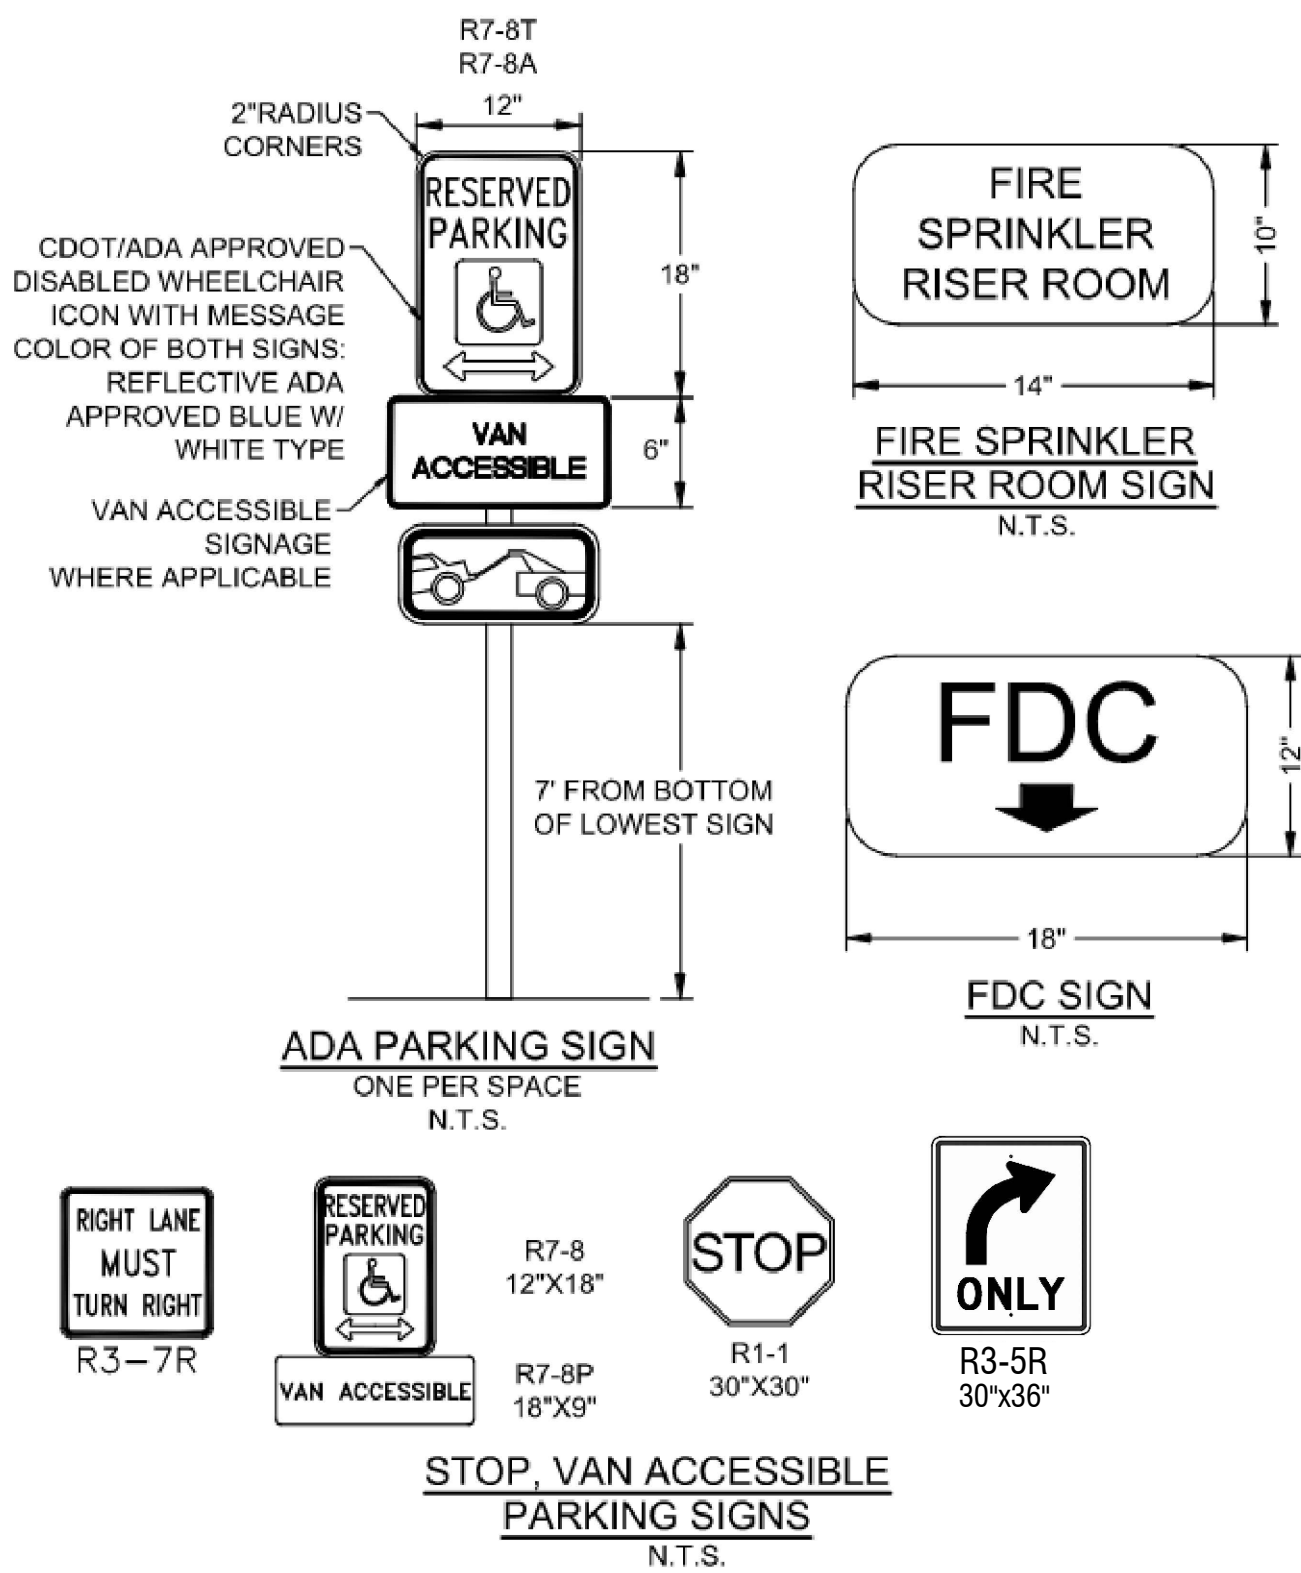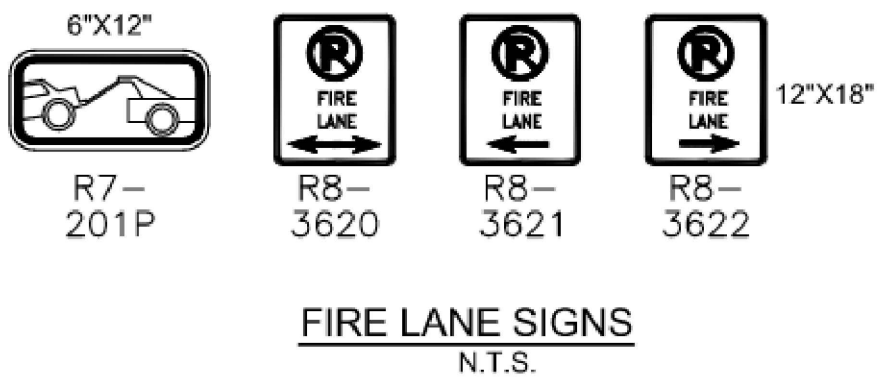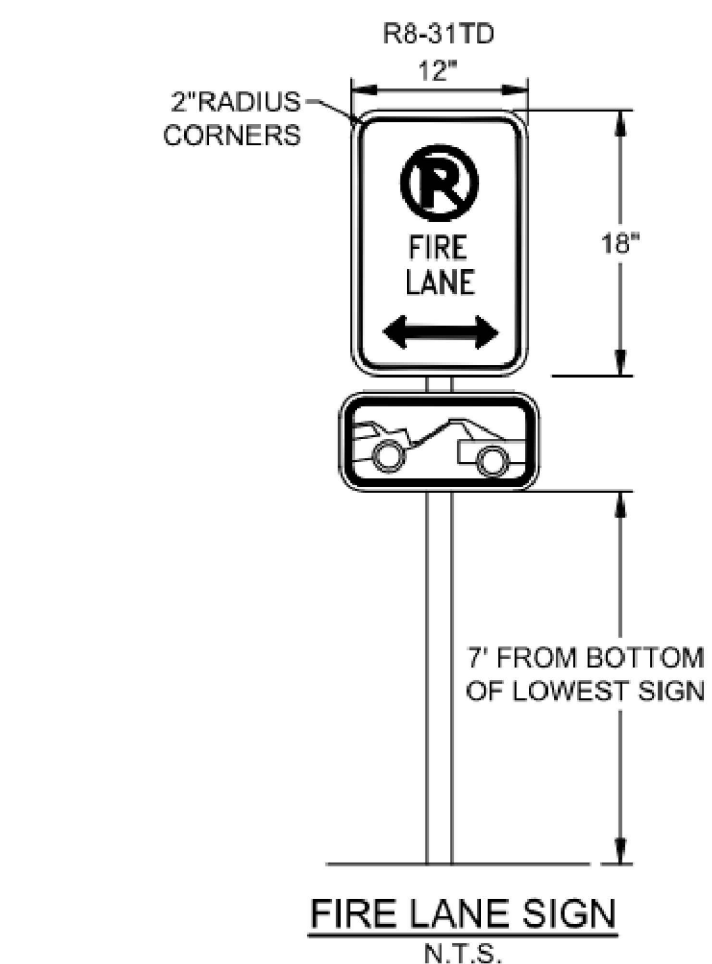


1900 S CHAMBERS COMMUNITY SITE PLAN AMENDMENT WITH ADJUSTMENT AURORA, COLORADO SITE PLAN

REMARKS	
DATE	05/15/2024
NO.	1
DATE	05/11/2024
NO.	2

PA / PM:	TS
DRAWN BY:	CS
JOB NO.:	23010

file path: C:\Users\cris\hian\Shopworks Architecture\Server - Projects\23010 BRL 1900 S Chambers PSH\04. Design\Civil\CAD\Sheets\Planning\23010_Grading Plan.dwg

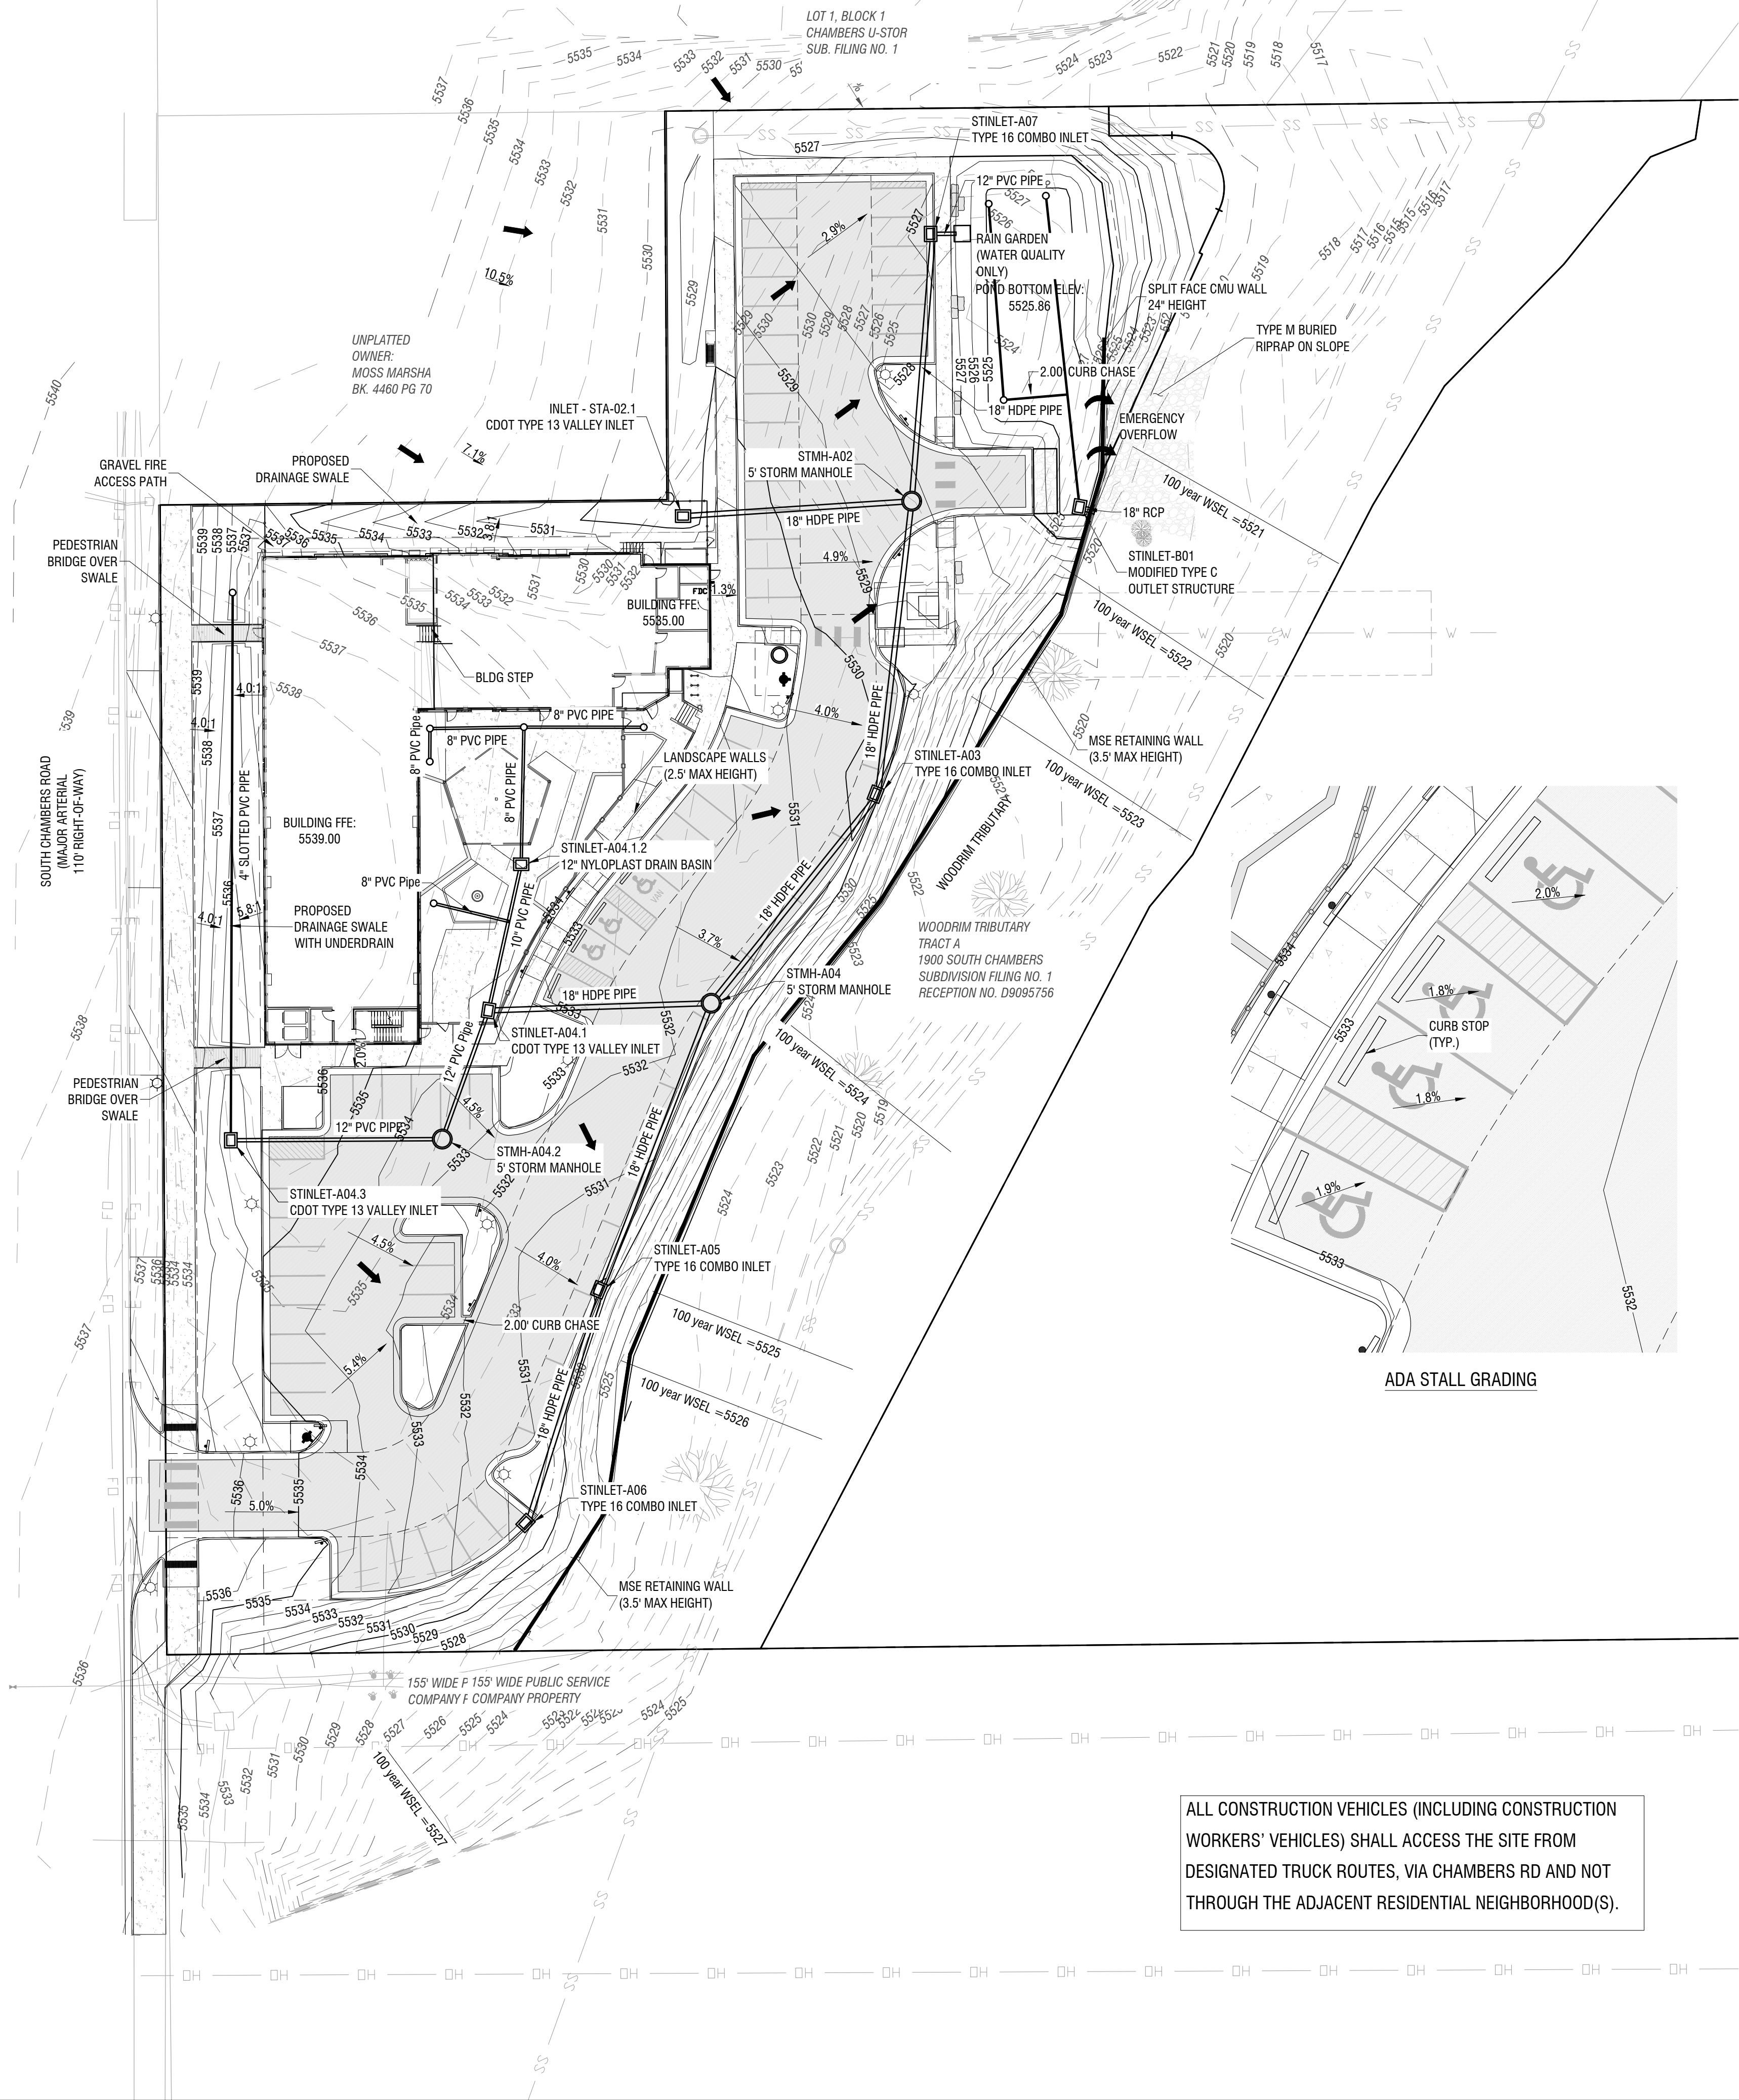


ALL CONSTRUCTION VEHICLES (INCLUDING CONSTRUCTION WORKERS' VEHICLES) SHALL ACCESS THE SITE FROM DESIGNATED TRUCK ROUTES, VIA CHAMBERS RD AND NOT THROUGH THE ADJACENT RESIDENTIAL NEIGHBORHOOD(S).

PROPOSED STREET LIGHT LOCATIONS ARE CONCEPTUAL. FINAL LOCATIONS WILL BE DETERMINED WITH PHOTOMETRIC ANALYSIS SUBMITTED WITH THE STREET LIGHTING PLANS IN THE CIVIL PLAN SUBMITTAL.

- NOTES
1. ALL ENTRANCES ARE PRIVATE UNLESS OTHERWISE NOTED.
 2. SIDEWALKS AND LANDINGS SHALL SLOPE 1.5% TOWARDS ROADS, DRIVE LANES UNLESS NOTED OTHERWISE.
 3. THE CONTRACTOR SHALL NOTIFY THE ENGINEER OF ANY DISCREPANCIES WITH THE PROPOSED ELEVATIONS SHOWN ON THE GRADING PLAN. THE ENGINEER WILL NOT BE LIABLE FOR ANY COSTS ASSOCIATED WITH CHANGES TO THE DESIGN WITHOUT PROPER NOTIFICATION.
 4. MINIMUM SLOPE ON UNPAVED AREAS IS 2%, MINIMUM SLOPE ON ASPHALT IS 1%, AND MINIMUM SLOPE ON CONCRETE IS 0.5%.
 5. THE MAXIMUM SLOPE WITHIN ROW IS 4:1, THE MAXIMUM SLOPE FOR PROPERTY OUTSIDE OF THE ROW IS 3:1.
 6. THE SLOPE AWAY FROM THE BUILDING SHALL HAVE A MINIMUM GRADE OF FIVE PERCENT FOR THE FIRST TEN FEET OR TO THE PROPERTY LINE, WHICHEVER OCCURS FIRST, THEN A MINIMUM OF TWO (2) PERCENT UNTIL THE SLOPE REACHES THE SWALE AROUND THE BUILDING. IF PHYSICAL OBSTRUCTIONS OR LOT LINES PROHIBIT THE TEN FEET OF HORIZONTAL DISTANCE, A FIVE (5) PERCENT SLOPE SHALL BE PROVIDED TO AN APPROVED ALTERNATIVE METHOD OF DIVERTING STORM RUNOFF AWAY FROM THE FOUNDATION. IMPERVIOUS SURFACES WITHIN TEN FEET OF THE BUILDING FOUNDATION SHALL BE SLOPED A MINIMUM OF TWO (2) PERCENT AWAY FROM THE BUILDING.
 7. THE MAXIMUM PERMISSIBLE LONGITUDINAL GRADE FOR FIRE LANES IS 10%. THE MAXIMUM TRANSVERSE GRADE FOR A FIRE LANE IS FOUR PERCENT WITH A RESULTANT MAXIMUM SLOPE OF TEN PERCENT.
 8. THE RESULTANT GRADE IN ANY DIRECTION WITHIN ACCESSIBLE PARKING AREAS SHALL NOT EXCEED TWO PERCENT.
 9. THE MAXIMUM CROSS SLOPE IN AN ACCESSIBLE PATH SHALL NOT EXCEED TWO PERCENT. THE MAXIMUM LONGITUDINAL SLOPE IN AN ACCESSIBLE PATH SHALL NOT EXCEED FIVE PERCENT.
 10. EXISTING UTILITIES STRUCTURES TO BE ADJUSTED AS NECESSARY TO MEET PROPOSED GRADE.
 11. ALL STORM SEWER IS PRIVATE AND WILL BE MAINTAINED BY OWNER UNLESS OTHERWISE NOTED.
 12. BENCHMARK: AURORA BENCHMARK POINT NO. 09-0708, 3" DIAMETER BRASS CAP ATOP THE NORTH EDGE OF A CURB OPENING INLET & CENTERED THEREON BEING ON THE WEST SIDE OF S. CHAMBERS ROAD & 40' MORE/LESS NORTH OF THE JEWELL LANDLINE AS EVIDENCED BY THE RANGE BOX IN S. CHAMBERS ROAD. PUBLISHED ELEVATION = 5535.38

GRADING PLAN LEGEND

PROPERTY BOUNDARY	---
EXISTING WATER LINE	W
EXISTING FIRE HYDRANT	●
EXISTING SEWER LINE	SS
EXISTING SEWER MANHOLE	⊙
EXISTING STORM LINE	---
EXISTING STORM MANHOLE	⊙
EXISTING STORM INLET	⊙
EXISTING FIBER LINE	FO
EXISTING GAS LINE	G
EXISTING ELECTRIC LINE	E
EXISTING MINOR CONTOUR	5281
EXISTING MAJOR CONTOUR	5280
PROPOSED FIRE HYDRANT	◆
PROPOSED STORM LINE	---
PROPOSED STORM MANHOLE	⊙
PROPOSED STORM INLET	⊙
PROPOSED MINOR CONTOUR	5281
PROPOSED MAJOR CONTOUR	5280
PROPOSED SPOT ELEVATION	5887.19
PROPOSED SLOPE	0.5%
PROPOSED CONCRETE SIDEWALK	▨
PROPOSED ASPHALT ROAD	▨

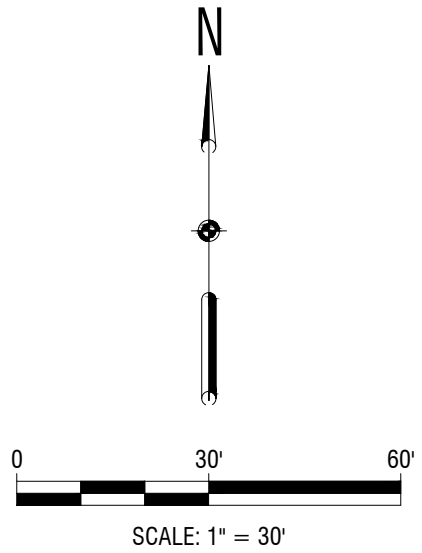


1900 S CHAMBERS COMMUNITY
SITE PLAN AMENDMENT WITH ADJUSTMENT
AURORA, COLORADO
GRADING PLAN

NO.	DATE	REMARKS
1	05/15/24	GRADING PLAN
2	05/11/24	GRADING PLAN

PA / PM:	TS
DRAWN BY:	TS
JOB NO.:	23010

1900 S CHAMBERS COMMUNITY
LOT 1 BLOCK 1, 1900 SOUTH CHAMBERS SUBDIVISION FILING NO. 1 / C2-2976
CITY OF AURORA, COUNTY OF ARAPAHOE, STATE OF COLORADO

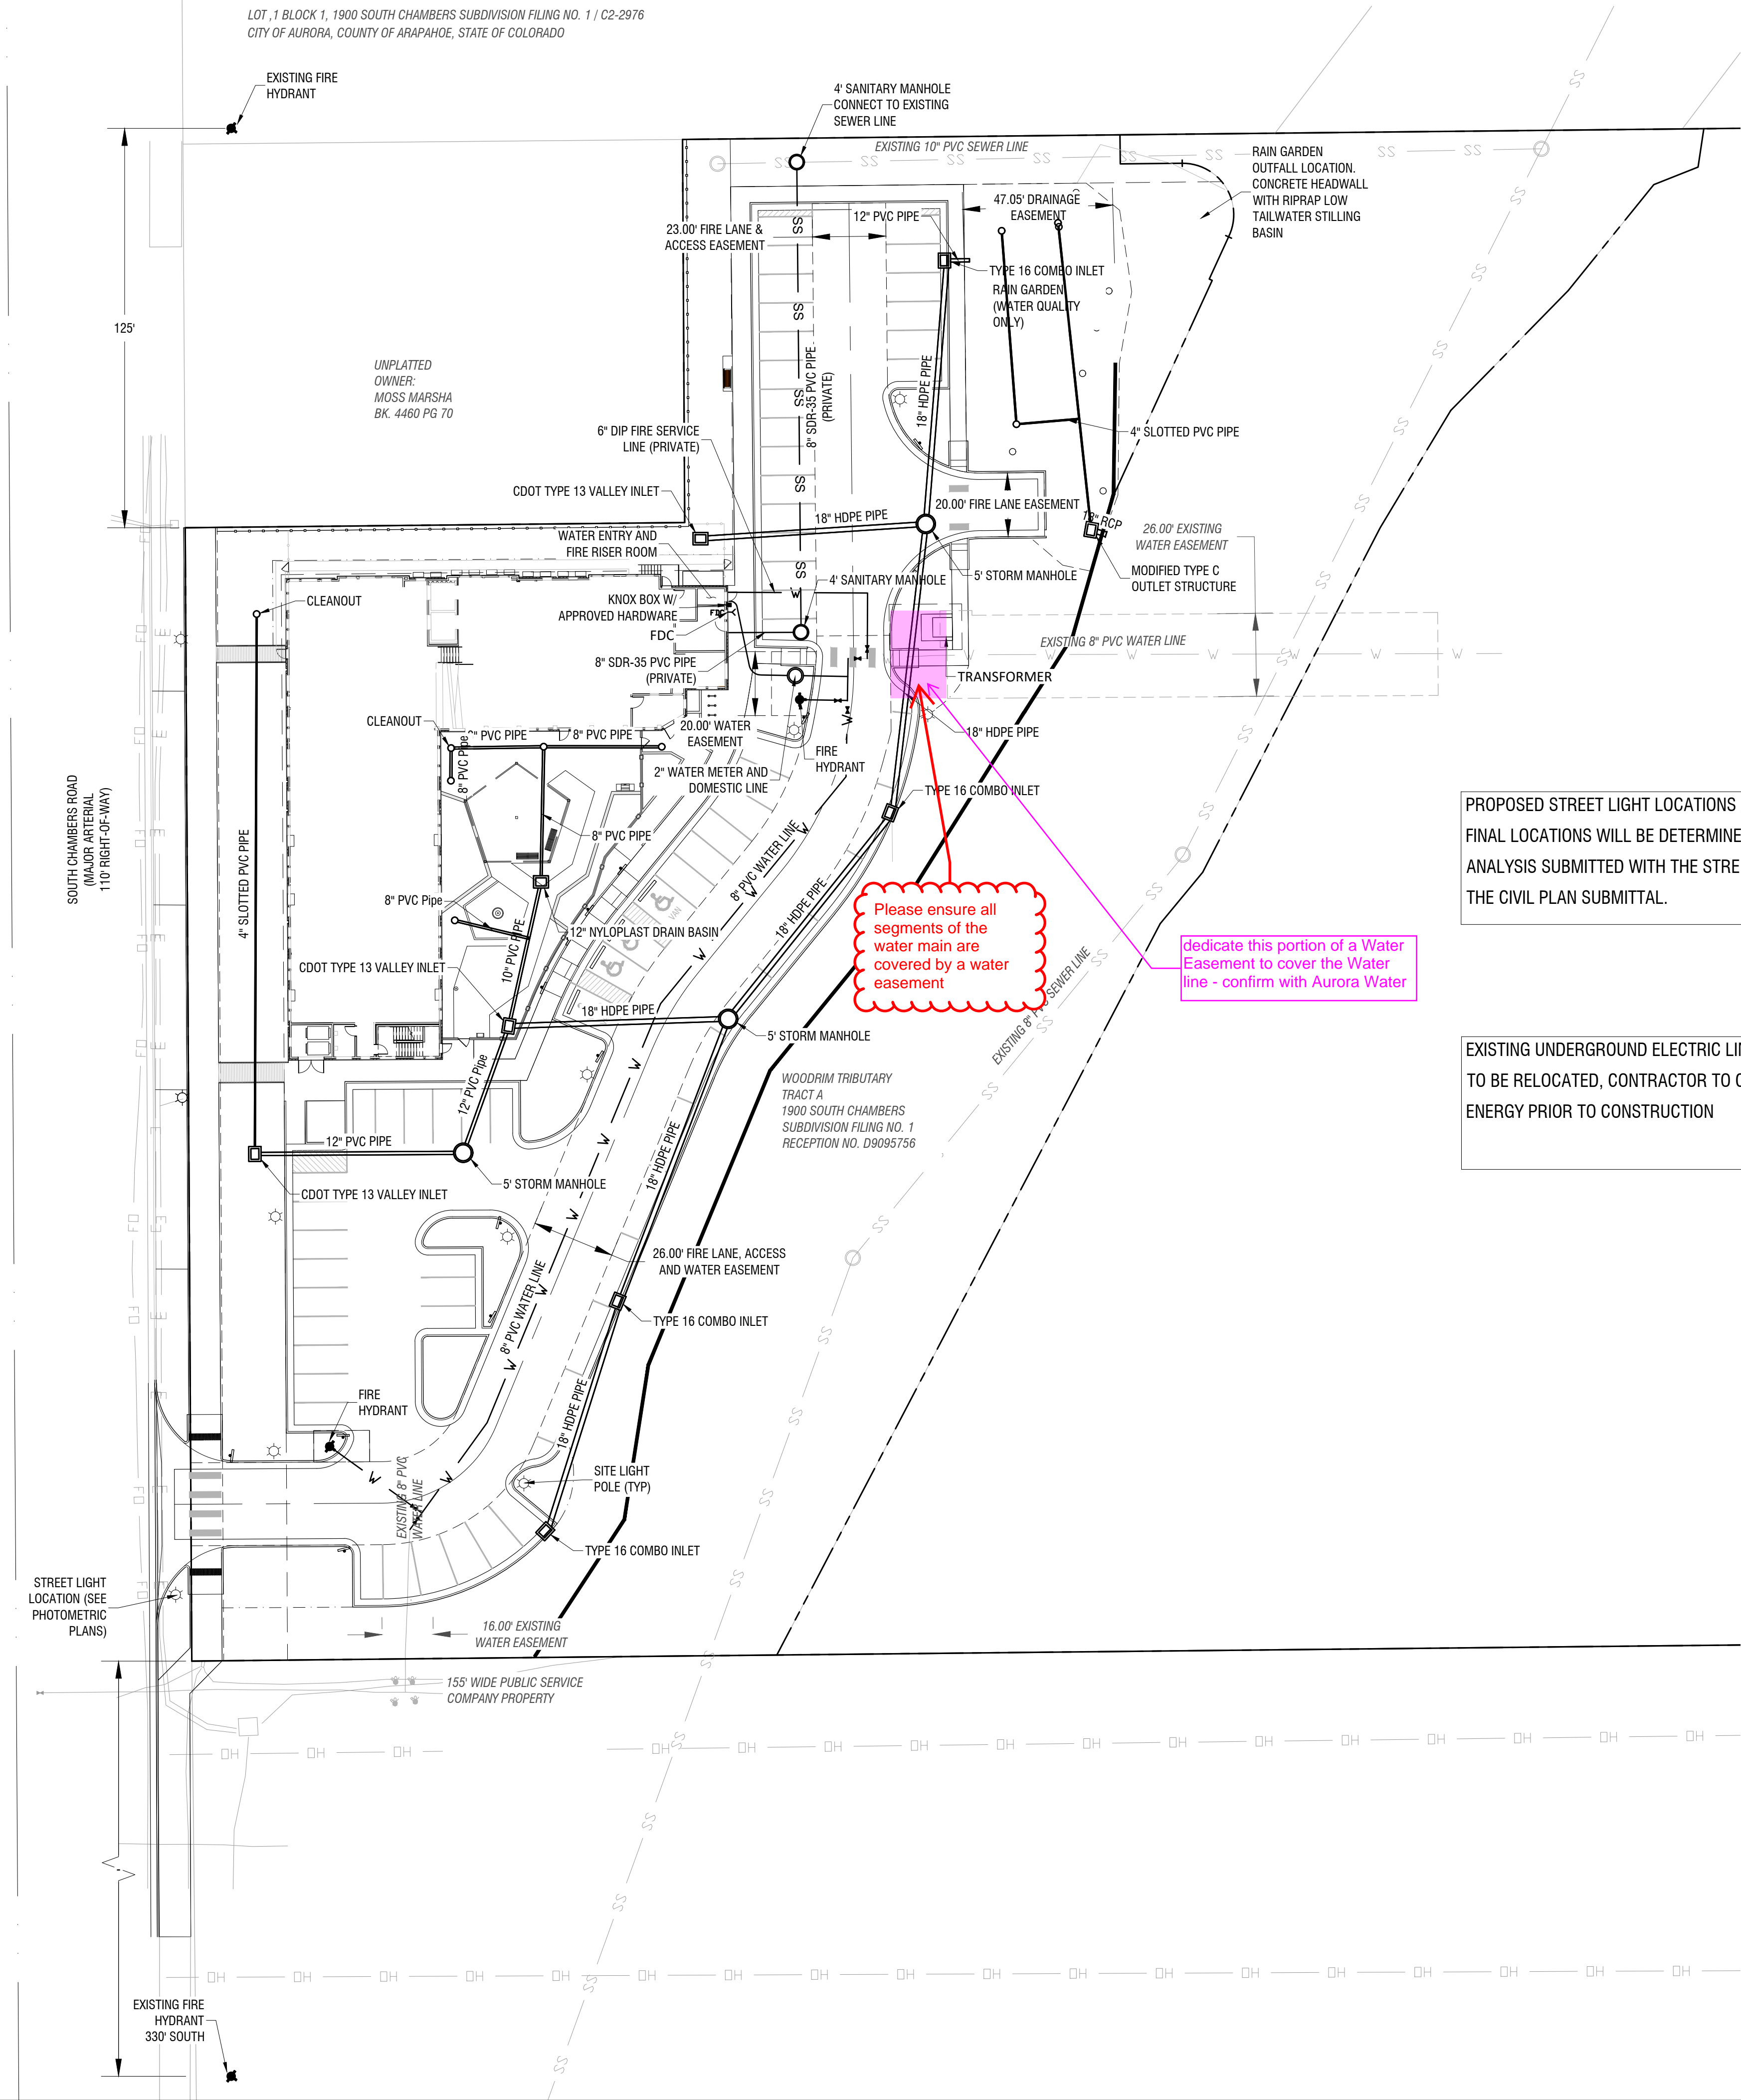

NOTES

1. THE CONTRACTOR IS TO VERIFY THE ELEVATION OF ALL EXISTING UTILITIES WHERE NEW WORK WILL CONNECT AND NOTIFY THE ENGINEER IF THERE ARE ANY DISCREPANCIES.
2. MANHOLES ARE CONTROLLED AT CENTER OF MANHOLE.
3. ALL WATER SERVICES DOWNSTREAM OF THE METER SHALL BE PRIVATE.
4. ALL SANITARY SERVICES SHALL BE PRIVATE.
5. BENCHMARK: AURORA BENCHMARK POINT NO. 09-0708, 3" DIAMETER BRASS CAP ATOP THE NORTH EDGE OF A CURB OPENING INLET & CENTERED THEREON BEING ON THE WEST SIDE OF S. CHAMBERS ROAD & 40' MORE/LESS NORTH OF THE JEWELL LANDLINE AS EVIDENCED BY THE RANGE BOX IN S. CHAMBERS ROAD. PUBLISHED ELEVATION = 5535.38

FIRE FLOW DATA BLOCK


TOTAL FIRE FLOW REQS ARE 1500 GPM MIN @ 20 PSI RESIDUAL PRESSURE (75% REDUCTION FOR FULLY SPRINKLED BUILDING)
THIS FLOW MUST BE PROVIDED FROM A MINIMUM OF 1 FIRE HYDRANT
EACH FIRE HYDRANT MUST SUPPLY 1500 GPM MIN @ 20 PSI
RESIDUAL PRESSURE AT THE HYDRANT OUTLET TO BE ACCEPTABLE
CODE USED FOR ANALYSIS: 2021 IFC
OCCUPANCY GROUP: R-2
CONSTRUCTION TYPE: V-A (RESIDENTIAL)
FIRE AREA: 44,664 SF

PROPOSED STREET LIGHT LOCATIONS ARE CONCEPTUAL.
FINAL LOCATIONS WILL BE DETERMINED WITH PHOTOMETRIC ANALYSIS SUBMITTED WITH THE STREET LIGHTING PLANS IN THE CIVIL PLAN SUBMITTAL.

EXISTING UNDERGROUND ELECTRIC LINES AND STRUCTURES TO BE RELOCATED. CONTRACTOR TO COORDINATE WITH XCEL ENERGY PRIOR TO CONSTRUCTION

UTILITY PLAN LEGEND

EXISTING WATER LINE	W
EXISTING FIRE HYDRANT	◆
EXISTING SEWER LINE	SS
EXISTING SEWER MANHOLE	⊙
EXISTING STORM LINE	SS
EXISTING STORM MANHOLE	⊙
EXISTING STORM INLET	⊙
EXISTING FIBER LINE	FO
EXISTING GAS LINE	G
EXISTING ELECTRIC LINE	E
PROPOSED WATER LINE	W
PROPOSED FIRE HYDRANT	◆
PROPOSED SEWER LINE	SS
PROPOSED SEWER MANHOLE	⊙
PROPOSED STORM LINE	SS
PROPOSED STORM MANHOLE	⊙
PROPOSED STORM INLET	⊙
PROPOSED FIBER LINE	FO
PROPOSED GAS LINE	G
PROPOSED ELECTRIC LINE	E
PROPOSED LIGHT POLE	☆
PROPOSED FENCE	—○—○—○—○—

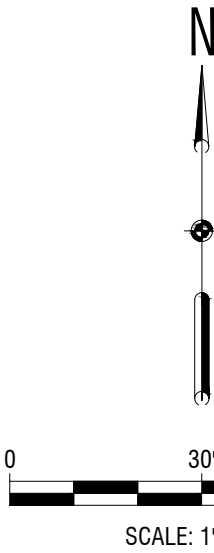

1900 S CHAMBERS COMMUNITY
SITE PLAN AMENDMENT WITH ADJUSTMENT
AURORA, COLORADO
UTILITY PLAN

NO.	DATE	REMARKS	
		SITE PLAN	SITE PLAN
1	05/15/2024		
2	05/11/2024		

PA / PM:	TS
DRAWN BY:	CS
JOB NO.:	23010

APPROX	APPROXIMATE	FL	FLOW LINE	REINF	REINFORCING
ARCH	ARCHITECTURE	FS	FINISH SURFACE	REQ	REQUIRED
ARCH'L	ARCHITECTURAL	FT	FOOT/FEET	RIM	RIM ELEVATION
ASPH	ASPHALT	FTG	FOOTING	ROW	RIGHT OF WAY
AD	AREA DRAIN	FV	FIELD VERIFY	SAN	SANITARY SEWER
BB	BOTTOM OF BASIN	GA	GAUGE	SCHD	SCHEDULE
BITUM	BITUMINOUS	GALV	GALVANIZED	SP	STARTING POINT
BLDG	BUILDING	HB	HOSE BIB	SPEC	SPECIFICATIONS
BP	BOTTOM OF PIPE	HP	HIGH POINT	STD	STANDARD
BS	BOTTOM OF STEP	HT	HEIGHT	STL	STEEL
BW	BOTTOM OF WALL	INV	INVERT	ST	STORM SEWER
CB	CATCH BASIN	JT	JOINT	STR	STRUCTURAL
CIP	CAST IN PLACE	L	LENGTH	T	TREAD
CJ	CONTROL JOINT	LP	LOW POINT	T+B	TOP AND BOTTOM
CL	CENTER LINE	LT	LIGHT	TC	TOP OF CONCRETE
COL	COLUMN	MAT	MATERIAL	TOC	TOP OF CURB
CONC	CONCRETE	MAX	MAXIMUM	TPZ	TREE PROTECTION ZONE
CONT	CONTINUOUS	MECH	MECHANICAL	TS	TOP OF STEP
CP	CENTER POINT	MFR	MANUFACTURER	TW	TOP OF WALL
CRZ	CRITICAL ROOT ZONE	MH	MANHOLE	TYP	TYPICAL
DF	DRINKING FOUNTAIN	MIN	MINIMUM	W	WIDTH
DIA	DIAMETER	MISC	MISCELLANEOUS	W/	WITH
DIM	DIMENSION	MP	MID POINT	WP	WATER METER PIT
DN	DOWN	NIC	NOT IN CONTRACT	WSE	WATER SURFACE ELEVATION
DTL	DETAIL	NO	NUMBER	WT	WEIGHT
DWG	DRAWING	NTS	NOT TO SCALE	WWF	WELDED WIRE FABRIC
EA	EACH	OC	ON CENTER		
EL	ELEVATION	OD	OUTSIDE DIAMETER		
EQ	EQUAL/EQUIVALENT	PT	POINT		
EX	EXISTING	REC	RECEPTACLE		
EXP	EXPANSION	REF	REFERENCE		
EJ	EXPANSION JOINT				
FG	FINISH GRADE				

The diagram illustrates a typical section line and a table for site detail keynotes. The section line is a horizontal line with a break in the middle, indicated by two parallel diagonal lines. A hexagon containing the number '1.0' is attached to the left end of the line, and the text 'TYP.' is placed to the right of the break. Below the section line is a table with two columns: 'DETAIL' and 'SHEETSPEC SECTION'. The table contains three rows of data. To the left of the table, a series of arrows point from the 'DETAIL' column to the 'SHEETSPEC SECTION' column, indicating the relationship between the two columns. The arrows are labeled with the following text: 'KEYNOTE (SYSTEM) ITEM & BRIEF DESCRIPTION', 'KEYNOTE CALL-OUT', 'KEYNOTE HEADING (PROPOSED IMPROVEMENT SYSTEM)', 'PRIMARY KEYNOTE DETAIL REFERENCE', and 'SPECIFICATION REFERENCE'. A note at the bottom states: 'NOTE: MULTIPLE SECTIONS MAY BE REFERENCED'.

DETAIL	SHEETSPEC SECTION
1.0 PAVING & SURFACING	X1X-01
1.1 ENHANCED CONCRETE - BROOM FINISH	321400

NOTE: MULTIPLE SECTIONS MAY BE REFERENCED

0.0	EXISTING CONDITIONS
1.0	PAVING & SURFACING
2.0	STEPS & RAMPS
3.0	WALL, CURBS & EDGERS
4.0	RAILINGS, BARRIERS & FENCING
5.0	SITE FURNISHINGS & SIGNS
6.0	PLANTING & LANDSCAPE
7.0	DRAINAGE
8.0	SITE LIGHTING & ELECTRICAL
9.0	MISCELLANEOUS

"X" REFERENCE NOTES

1 TYP.

1

FINAL LOCATION OF PATH TO BE DETERMINED IN FILED UNDER DIRECTION OF LANDSCAPE ARCHITECT

SERIES SPECIFIC REFERENCE NOTE
(SUPPLEMENTAL TO KEYNOTES. TYPICALLY
DESCRIBES ITEMS TO BE CONSIDERED DURING
CONSTRUCTION. MAY REFERENCE A DETAIL OR
SPECIFICATION OR BOTH.)

REFERENCE NOTE CALL-OUT




flow
design collaborative
301 W. 45th Ave. Denver, CO 80216

1900 S CHAMBERS COMMUNITY
SITE PLAN AMENDMENT WITH ADJUSTMENT
AURORA, COLORADO
LANDSCAPE GENERAL NOTES

[illegible]

PA / PM:	CH
DRAWN BY:	CH
JOB NO.:	Author

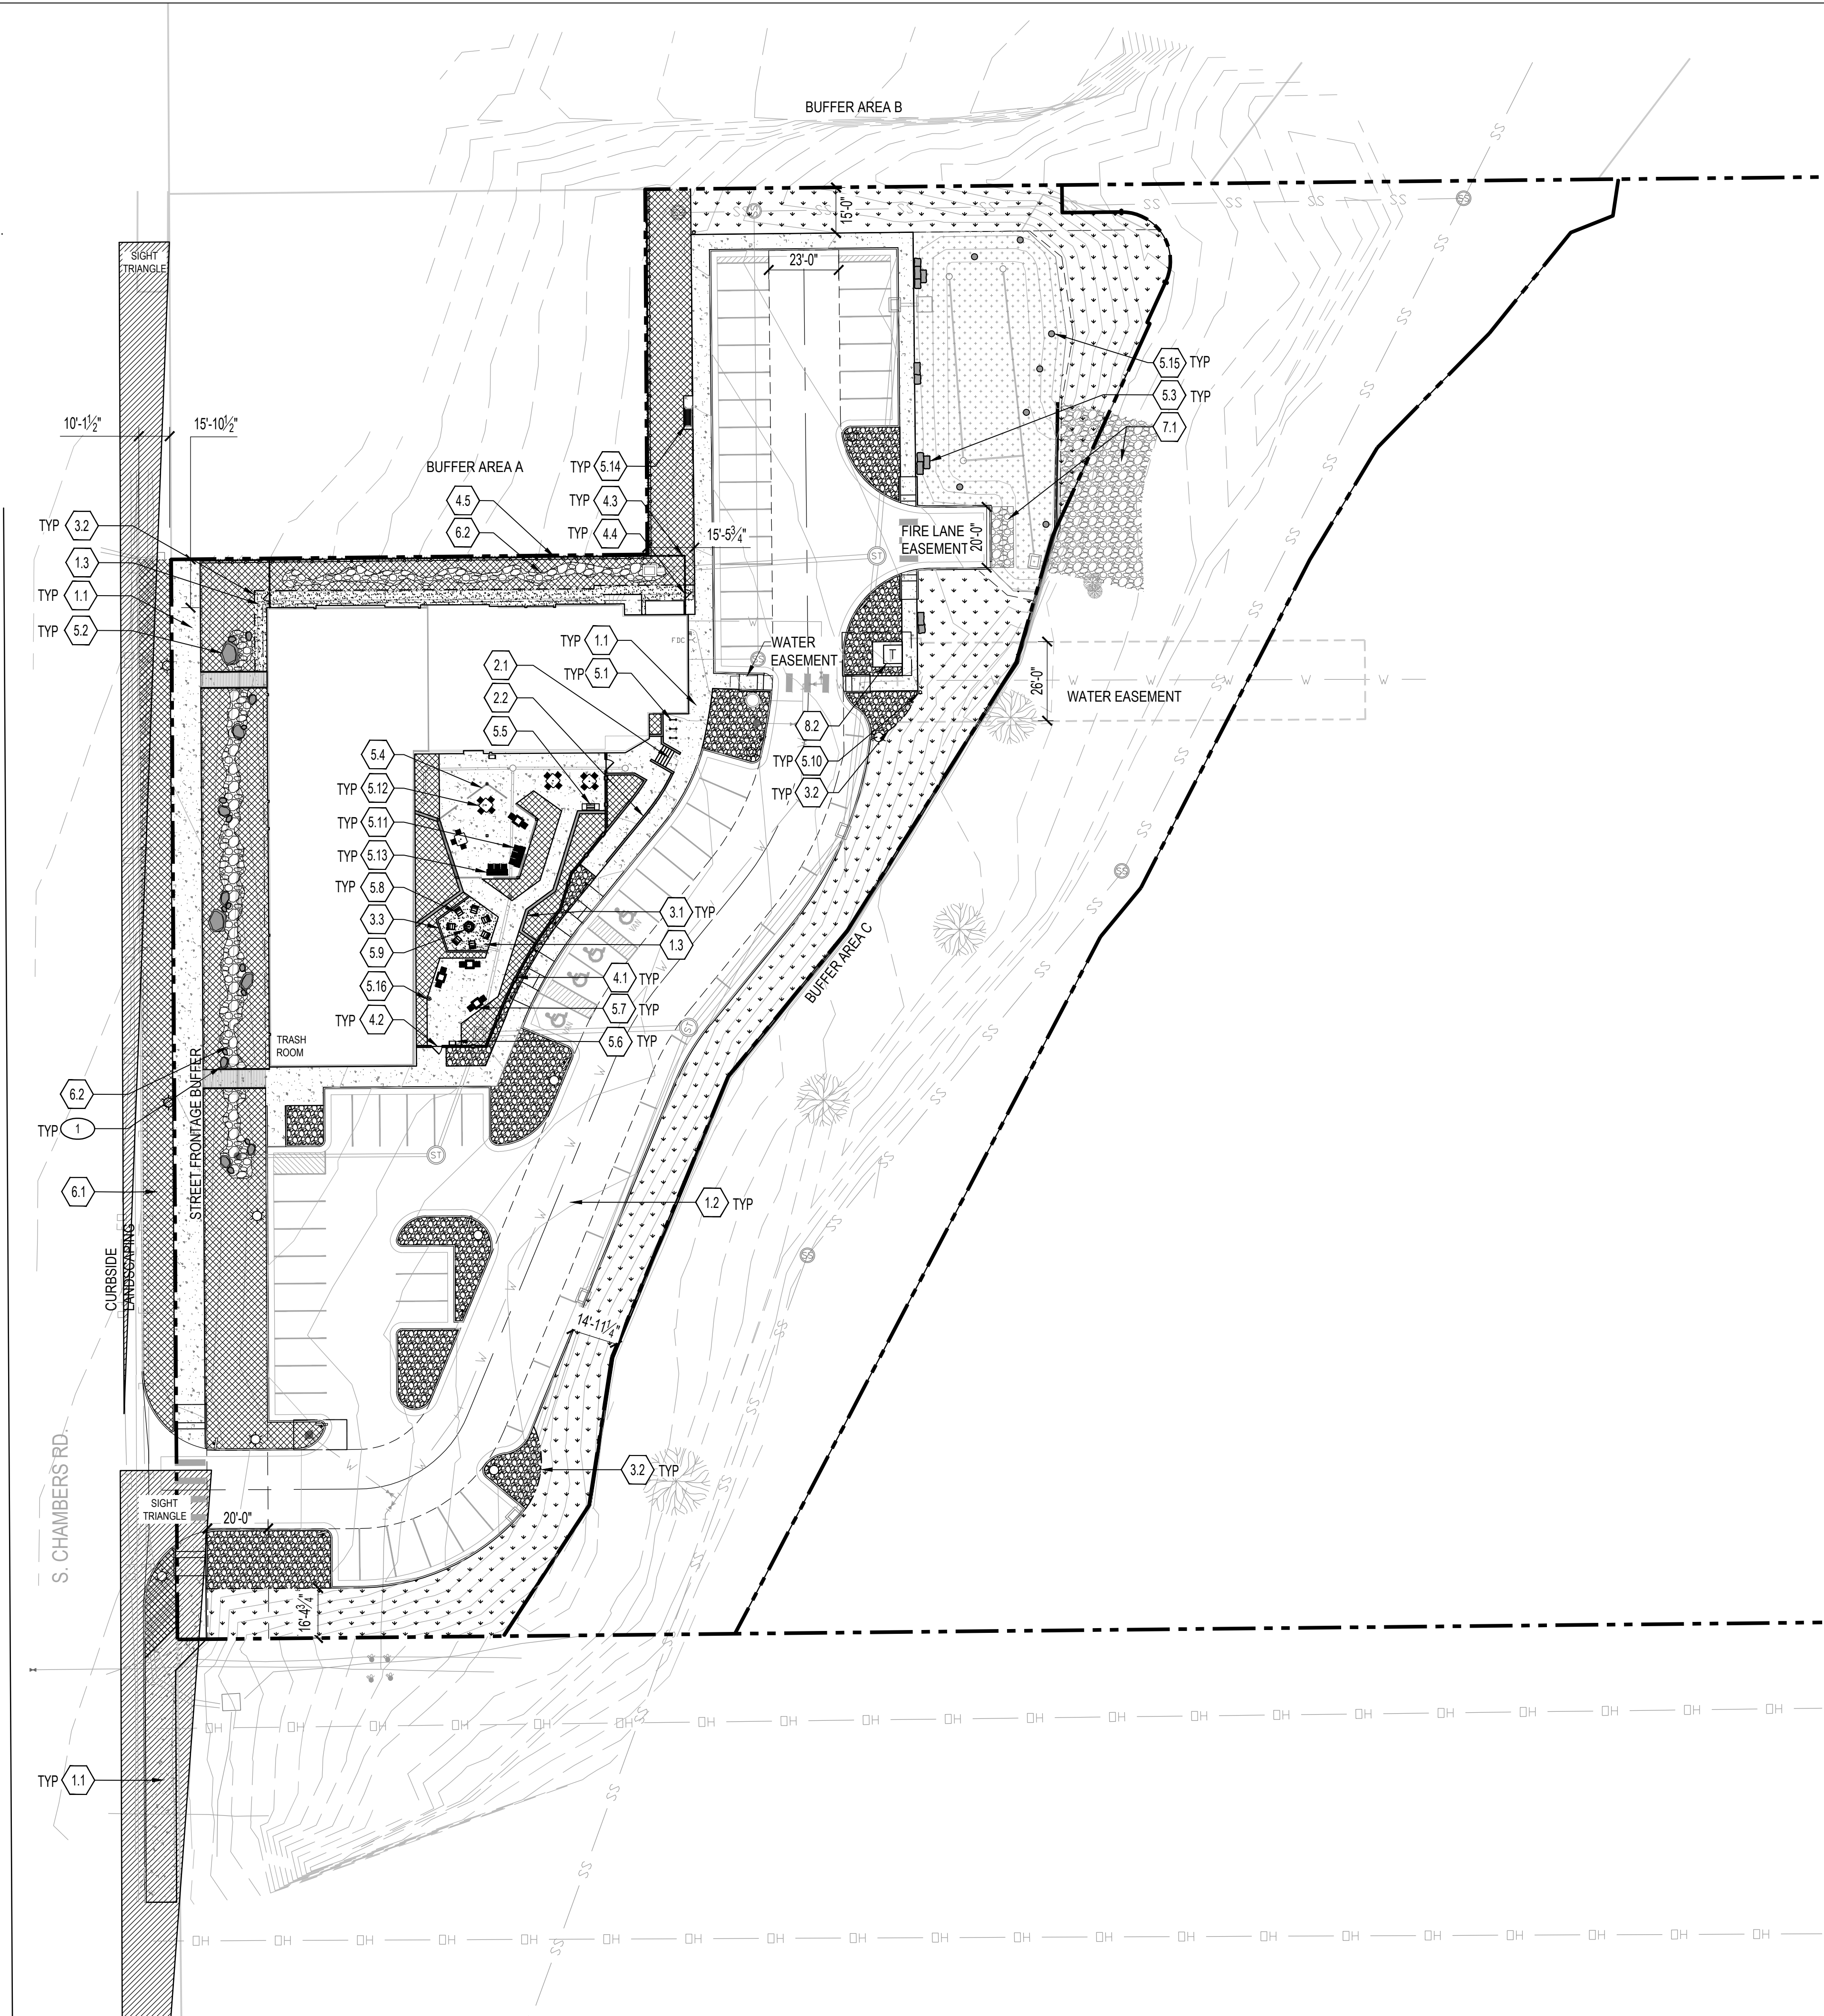

LANDSCAPE LEGEND

LARGE DECIDUOUS SHADE TREE

SMALL ORNAMENTAL/ MULTI-STEM TREE

EVERGREEN TREE

FENCING

PROPERTY LINE

CONCRETE EDGER

STEEL EDGER

SCORING JOINTS

BOULDER SEATING CLUSTER

LANDSCAPE BOULDERS

BIKE RACKS

SITE WALL

PET WASTE STATION

TRASH & RECYCLING

ASH RECEPTACLE

ADIRONDACK CHAIR

BAR HEIGHT STOOLS

STANDARD GRAY CONCRETE

COBBLE SWALE

PEBBLE MULCH

DETENTION SEED MIX

CRUSHER FINES

CEDAR MULCH

NATIVE SEED

BAR HEIGHT TABLES

BENCH

GAME TABLE

SQUARE GAME TABLE

BIRDHOUSES

SITE DETAIL KEYNOTES:

	PAVING & SURFACING	DETAIL/SHEETS
1.0	1.1 STANDARD GRAY CONCRETE	RE: CIVIL
	1.2 ASPHALT PAVING	RE: CIVIL
	1.3 CRUSHER FINES	A/11
	STEPS & RAMPS	DETAIL
2.0	2.1 CONCRETE STAIRS W/ RAILINGS	RE: CIVIL
	2.2 HAND RAIL	RE: CIVIL
	WALLS, CURBS & EDGERS	DETAIL
3.0	3.1 CMU SEAT WALL W/ PRECAST CONCRETE CAP	B/11
	3.2 STEEL EDGER	C/11
	3.3 CONCRETE EDGER	D/11
	BARRIERS & FENCING	DETAIL
4.0	4.1 ORNAMENTAL FENCE ON WALL	E/11
	4.2 ORNAMENTAL METAL GATE	F/11
	4.3 PICKET FENCING	-/-
	4.4 PICKET GATE	-/-
	4.5 PRIVACY FENCE	G/11
	SITE FURNISHINGS & SIGNS	DETAIL
5.0	5.1 BIKE RACK	E/12
	5.2 LANDSCAPE BOULDERS	A/12
	5.3 BOULDER SEATING CLUSTERS	B/12
	5.4 SOLID SHADE PERGOLA	A/13
	5.5 BBQ GRILL	C/13
	5.6 TRASH & RECYCLING RECEPTACLE	A/14
	5.7 GAME TABLE	F/12
	5.8 ADIRONDACK CHAIR	C/14
	5.9 WATER FEATURE	D/13
	5.10 PET WASTE STATION	E/13
	5.11 BAR HEIGHT STOOL	B/14
	5.12 SQUARE GAME TABLE	A/15
	5.13 BAR HEIGHT TABLE	B/13
	5.14 BENCH	D/14
	5.15 BIRDHOUSE	C/12
	5.16 ASH RECEPTACLE	F/13
	PLANTING & LANDSCAPE	DETAIL
6.0	6.1 CEDAR MULCH	-
	6.2 COBBLE SWALE	D/12
	DRAINAGE	DETAIL
7.0	7.1 RE: CIVIL	-/-
	SITE LIGHTING & ELECTRICAL	DETAIL
8.0	8.1 LIGHTING	RE: ELECTRICAL
	8.2 TRANSFORMER	RE: CIVIL

SITE REFERENCE KEYNOTES:

- 1 ALL LANDSCAPE BOULDERS TO BE LOCATED OUT OF CLEAR ZONE (MIN. 25' FROM ROADWAY).

NO.	DATE	REMARKS
1	05/15/2024	SITE PLAN
2	05/11/2024	SITE PLAN

PA / PM:	CH
DRAWN BY:	CH
JOB NO.:	Author

CURBSIDE LANDSCAPE BUFFER TABLE

1 TREE / 40 LF + 1 SHRUB / 40 SF 3x1 GAL PERENNIALS = 1x5 GAL SHRUB							
Curbside Landscape Description	Width	Length	Trees Required	Trees Provided	Shrubs Required	Shrubs Provided	Ornamental Grasses Provided
S. CHAMBERS RD.	10'	329'	8	8	82	82	0

STREET FRONTAGE LANDSCAPE BUFFER TABLE

1 TREE + 10 SHRUBS / 40 LF (4.7.5.D.7)								
Street Frontage Buffer Description	Length	Trees Required	Trees Provided	Shrubs Required	Shrubs Provided	Grasses Provided	Width Required	Width Provided
S. CHAMBERS RD.	329'	8	25	82	166	130	20'	21'

NON-STREET FRONTAGE BUFFER TABLE

1 TREE + 5 SHRUBS / 25 LF (4.7.5.E.2.b)										
Area	Buffer Description	Length	Width Required	Width Provided	Trees Required	Deciduous Trees Provided	Evergreen Trees Provided	Shrubs Required	Shrubs Provided	
A	NORTHWEST PROPERTY LINE (RESIDENTIAL) (1 Tree & 5 Shrubs per 40 LF)	267'	*10'	15'	7	11	6	33	61	
B	NORTH PROPERTY LINE (COMMERCIAL) (1 Tree & 5 Shrubs per 25 LF)	122'	*25'	15'	5	0*	0*	24	48	
C	EAST PROPERTY LINE (DRAINAGE AREA) (1 Tree & 5 Shrubs per 25 LF)	640'	*12'	14'-11" - 16'-4"	26	13	13	128	128	

**BUFFER WIDTH REDUCTIONS FROM TABLE 4.7-2)

1.
- AREA A BUFFER REQUIREMENT OF 15' REDUCED TO 10' DUE TO INCENTIVE ADDITION OF A PRIVACY FENCE WITH LANDSCAPING ON EXTERIOR SIDE.
2.
- AREA B BUFFER REQUIREMENT OF 25' REDUCED TO 15'. SANITARY SEWER ENCUMBRANCE PREVENTS TREES, UTILIZING (2) SHRUB-TREE EQUIVALENTS.
3.
- AREA C BUFFER REQUIREMENT OF 25' REDUCED TO 12' IN PRE-APPLICATION.

BUILDING PERIMETER LANDSCAPING TABLE

1.25 Plants / 5 LF of total building perimeter = Total Plants Required										
Building Description	Building Perimeter	Trees Required 5%	Trees Provided	Tall Shrubs Required 15%	Tall Shrubs Provided	Regular Shrubs Up to 80%	Regular Shrubs Provided	Grasses/Peren. Provided	Total Plants Required	Total Plants Provided
A	579'	7	36	22	22	116	116	247	145	421

PARKING LOT LANDSCAPING TABLE

1 TREE + 6 SHRUBS PER ONE 9'X19' ISLAND, 1 ISLAND PER 15 SPACES					
Parking Lot Description	Number of Islands	Trees Required	Trees Provided	Shrubs Required	Shrubs Provided
PARKING LOT	12	12	13	72	95

WATER USE TABLE

Area	Non Water (Z)	Water Conserving Irrigation (Non-Sod)	Non-Water Conserving Irrigation (Sod)	Total Area (sf)
SITE	0 (0%)	32,895 SF (91.5%)	0 (0%)	32,895
ROW	0 (0%)	3,057 SF (8.5%)	0 (0%)	3,057
TOTAL	0 (0%)	35,952 SF (100%)	0 (0%)	35,952


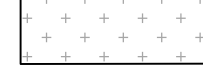
CITY OF AURORA STANDARD LANDSCAPE NOTES


1.
- ALL LANDSCAPED AREAS ARE TO RECEIVE ORGANIC SOIL PREPARATION AT 4 CU. YARDS/1,000 SF.
2.
- STREET LIGHTS ARE LOCATED AT THE BACK OF PROPOSED DETACHED SIDEWALK ALONG 6TH AVE. REMAINING FREESTANDING LIGHTS HAVE BEEN PLACED BY ELECTRICAL ENGINEER ACCORDING TO AURORA UDO.
3.
- SURFACE MATERIAL OF WALKS AND PLAZAS ON SITE ARE TO BE LIGHT BROOM FINISHED STANDARD GRAY CONCRETE. WHERE AREAS ARE CALLED OUT AS ENHANCED CONCRETE, AREAS TO HAVE SAND FINISH. THE COLOR OF THE ENHANCED CONCRETE IS TO BE DETERMINED. SPECIALTY PAVERS TO BE USED AS PAVING ACCENTS AT SELECT SITE LOCATIONS. ALL CRUSHER FINES PATHWAYS ARE TO BE GRAY IN COLOR. PARKING LOTS AND VEHICULAR DRIVES ARE TO BE ASPHALT. A RAISED CONCRETE PAD IS PROVIDED AS A PEDESTRIAN CONNECTION BETWEEN THE DEVELOPMENT AND RESTORATION CHRISTIAN FELLOWSHIP.
4.
- ALL UTILITY EASEMENT SHALL REMAIN UNOBSTRUCTED AND FULLY ACCESSIBLE ALONG THEIR ENTIRE LENGTH FOR MAINTENANCE EQUIPMENT ENTRY.
5.
- THE DEVELOPER, HIS SUCCESSORS AND ASSIGNS, SHALL BE RESPONSIBLE FOR INSTALLATION, MAINTENANCE AND REPLACEMENT OF ALL LANDSCAPING MATERIALS SHOWN OR INDICATED ON THE APPROVED SITE PLAN OR LANDSCAPE PLAN ON FILE IN THE PLANNING DEPARTMENT. ALL LANDSCAPING WILL BE INSTALLED AS DELINEATED ON THE PLAN, PRIOR TO ISSUANCE OF CERTIFICATES OF OCCUPANCY.
6.
- ALL LANDSCAPED AREAS AND PLANT MATERIAL, EXCEPT FOR NON-IRRIGATED NATIVE, RESTORATIVE, AND DRYLAND GRASS AREAS THAT COMPLY WITH REQUIREMENTS, MUST BE WATERED BY AN AUTOMATIC UNDERGROUND IRRIGATION SYSTEM. IRRIGATION SYSTEM DESIGN, INSTALLATION, OPERATION, AND MAINTENANCE SHALL CONFORM TO REQUIREMENTS FOUND IN THE CITY OF AURORA IRRIGATION ORDINANCE.
7.
- LANDSCAPE MATERIAL SHALL NOT BE PLACED OR KEPT NEAR FIRE HYDRANTS IN A MANNER THAT WOULD PREVENT SUCH EQUIPMENT FROM BEING IMMEDIATELY DISCERNIBLE. A 5-FOOT CLEAR SPACE SHALL BE MAINTAINED AROUND THE CIRCUMFERENCE OF FIRE HYDRANTS. LANDSCAPING MATERIAL SHOWN WITHIN THE SITE PLAN CANNOT ENCROACH INTO ROADWAYS THAT ARE DEDICATED (OR DESIGNATED) AS FIRE LANE EASEMENTS (OR CORRIDORS).
8.
- ALL PROPOSED LANDSCAPING WITHIN THE SIGHT TRIANGLE SHALL BE IN COMPLIANCE WITH COA ROADWAY SPECIFICATIONS, SECTION 4.04.2.10.
9.
- ENSURE ALL HYDRANTS ARE WITHIN LANDSCAPED AREAS AND 5 FT. CLEAR ON ALL SIDES FROM ANY OBSTRUCTIONS. WITH THE RELOCATION OF FIRE HYDRANTS ENSURE THE FIRE HYDRANT IS WITHIN THE 3'-6" TO 8' DISTANCE FROM BACK OF CURB AND FACING ADJACENT ROADWAY.

PLANTING PLAN NOTES


1.
- ALL PLANT MATERIAL SHALL MEET OR EXCEED CURRENT AMERICAN STANDARD FOR NURSERY STOCK ANSI Z60.1
2.
- STAKE ALL TREES BASED ON THESE DRAWINGS. LOCATIONS OF PLANT MATERIALS TO BE APPROVED BY THE OWNER'S REPRESENTATIVE IN THE FIELD PRIOR TO INSTALLATION. THE CONTRACTOR SHALL FOLLOW THE LANDSCAPE PLAN. ANY DISCREPANCIES BETWEEN THE PLAN AND FIELD CONDITIONS SHALL BE REPORTED TO THE OWNER'S REPRESENTATIVE AND LANDSCAPE ARCHITECT BEFORE PROCEEDING WITH WORK.
3.
- NOTIFY OWNER'S REPRESENTATIVE OF ANY CONFLICTS BETWEEN UTILITIES AND PLANTINGS TO COORDINATE FIELD ADJUSTMENTS.
4.
- TREES SHALL BE A MINIMUM OF 10' FROM ALL UTILITIES, UNLESS NOTED OTHERWISE.
5.
- IF THERE IS A DISCREPANCY BETWEEN THE PLANT COUNTS ON THE CALLOUTS AND/OR SCHEDULES ON THE PLANS AND THE ACTUAL NUMBER OF PLANTS DEPICTED ON THE PLANS, THE CONTRACTOR IS RESPONSIBLE FOR INSTALLING THE ACTUAL NUMBER OF PLANTS DEPICTED ON THE DRAWINGS.
6.
- THE CONTRACTOR IS RESPONSIBLE FOR WEED CONTROL FOR ALL LANDSCAPE AREAS UNTIL FINAL PROJECT ACCEPTANCE.
7.
- FINE GRADING MUST BE APPROVED BY OWNER'S REPRESENTATIVE PRIOR TO SEEDING, SODDING, AND PLANTING.

SEED SCHEDULE


SANDHILL PRAIRIE MIX (WITH FORBS)					WATER QUALITY FACILITY MIX (WITH FORBS)				
Scientific Name	Common Name	PLS lbs/ac	PLS/sq ft	% of PLS/sf	Scientific Name	Common Name	PLS lbs/ac	PLS/sq ft	% of PLS/sf
GRAMINOIDS					GRAMINOIDS				
Achnatherum hymenoides	Indian ricegrass	5.0	12	8	Elymus canadensis	Canada wildrye	4.5	10	6
Andropogon gerardii	Big bluestem	3.8	11	7	Elymus trachycaulis	Slender wheatgrass	5.0	17	11
Andropogon hallii	Sand bluestem	4.0	10	7	Panicum virgatum	Switchgrass	2.0	18	11
Calamovilla longifolia	Prairie Sandreed	2.0	13	8	Pascopyrum smithii	Western wheatgrass	6.0	18	11
Panicum virgatum	Switchgrass	1.0	9	6	Schizachyrium scoparium	Little bluestem	2.5	11	7
Pascopyrum smithii	Western wheatgrass	4.5	14	9	Sorghastrum nutans	Yellow Indiangrass	7.0	27	17
Schizachyrium scoparium	Little bluestem	3.0	13	8	Spartina pectinata	Prairie cordgrass	2.0	8	5
Sorghastrum nutans	Indiangrass	4.0	16	10	Graminoid Totals		29.0	110	69
Sporobolus cryptandrus	Sand dropseed	0.1	13	8					
Graminoid Totals		27.4	110	70					
FORBS					FORBS				
Eriogonum umbellatum	Sulphur-flower buckwheat	2.0	10	6	Coreopsis tinctorial	Plains coreopsis	0.2	11	7
Gaillardia aristata	Blanket flower	2.5	8	5	Dalea candida	White prairie clover	1.0	8	5
Heterotheca villosa	Hairy false goldenaster	0.8	12	7	Dalea purpurea	Purple prairie clover	1.5	10	6
Penstemon angustifolius	Broadbeard beardtongue	1.5	9	6	Gaillardia aristata	Blanket flower	3.0	9	6
Ratibida columifera	Upright prairie coneflower	0.6	10	6	Ratibida columifera	Upright prairie coneflower	0.7	12	7
Forb Totals		7.4	48	30	Forbs Totals		6.4	50	31
					Total		35.4	160	100
TOTAL		34.7	159	100					
Drill Seeded Rate: 34.7 PLS#/Acre Mechanical Broadcast Rate: 34.7 PLS#/Acre Hand Broadcast Areas Rate: 69.4 PLS#/Acre					Drill Seeded Rate: 35.4 PLS#/Acre Mechanical Broadcast Rate: 35.4 PLS#/Acre Hand Broadcast Areas Rate: 70.8 PLS#/Acre				
									
HYDROZONE WATER USE: VERY LOW					HYDROZONE WATER USE: VERY LOW				

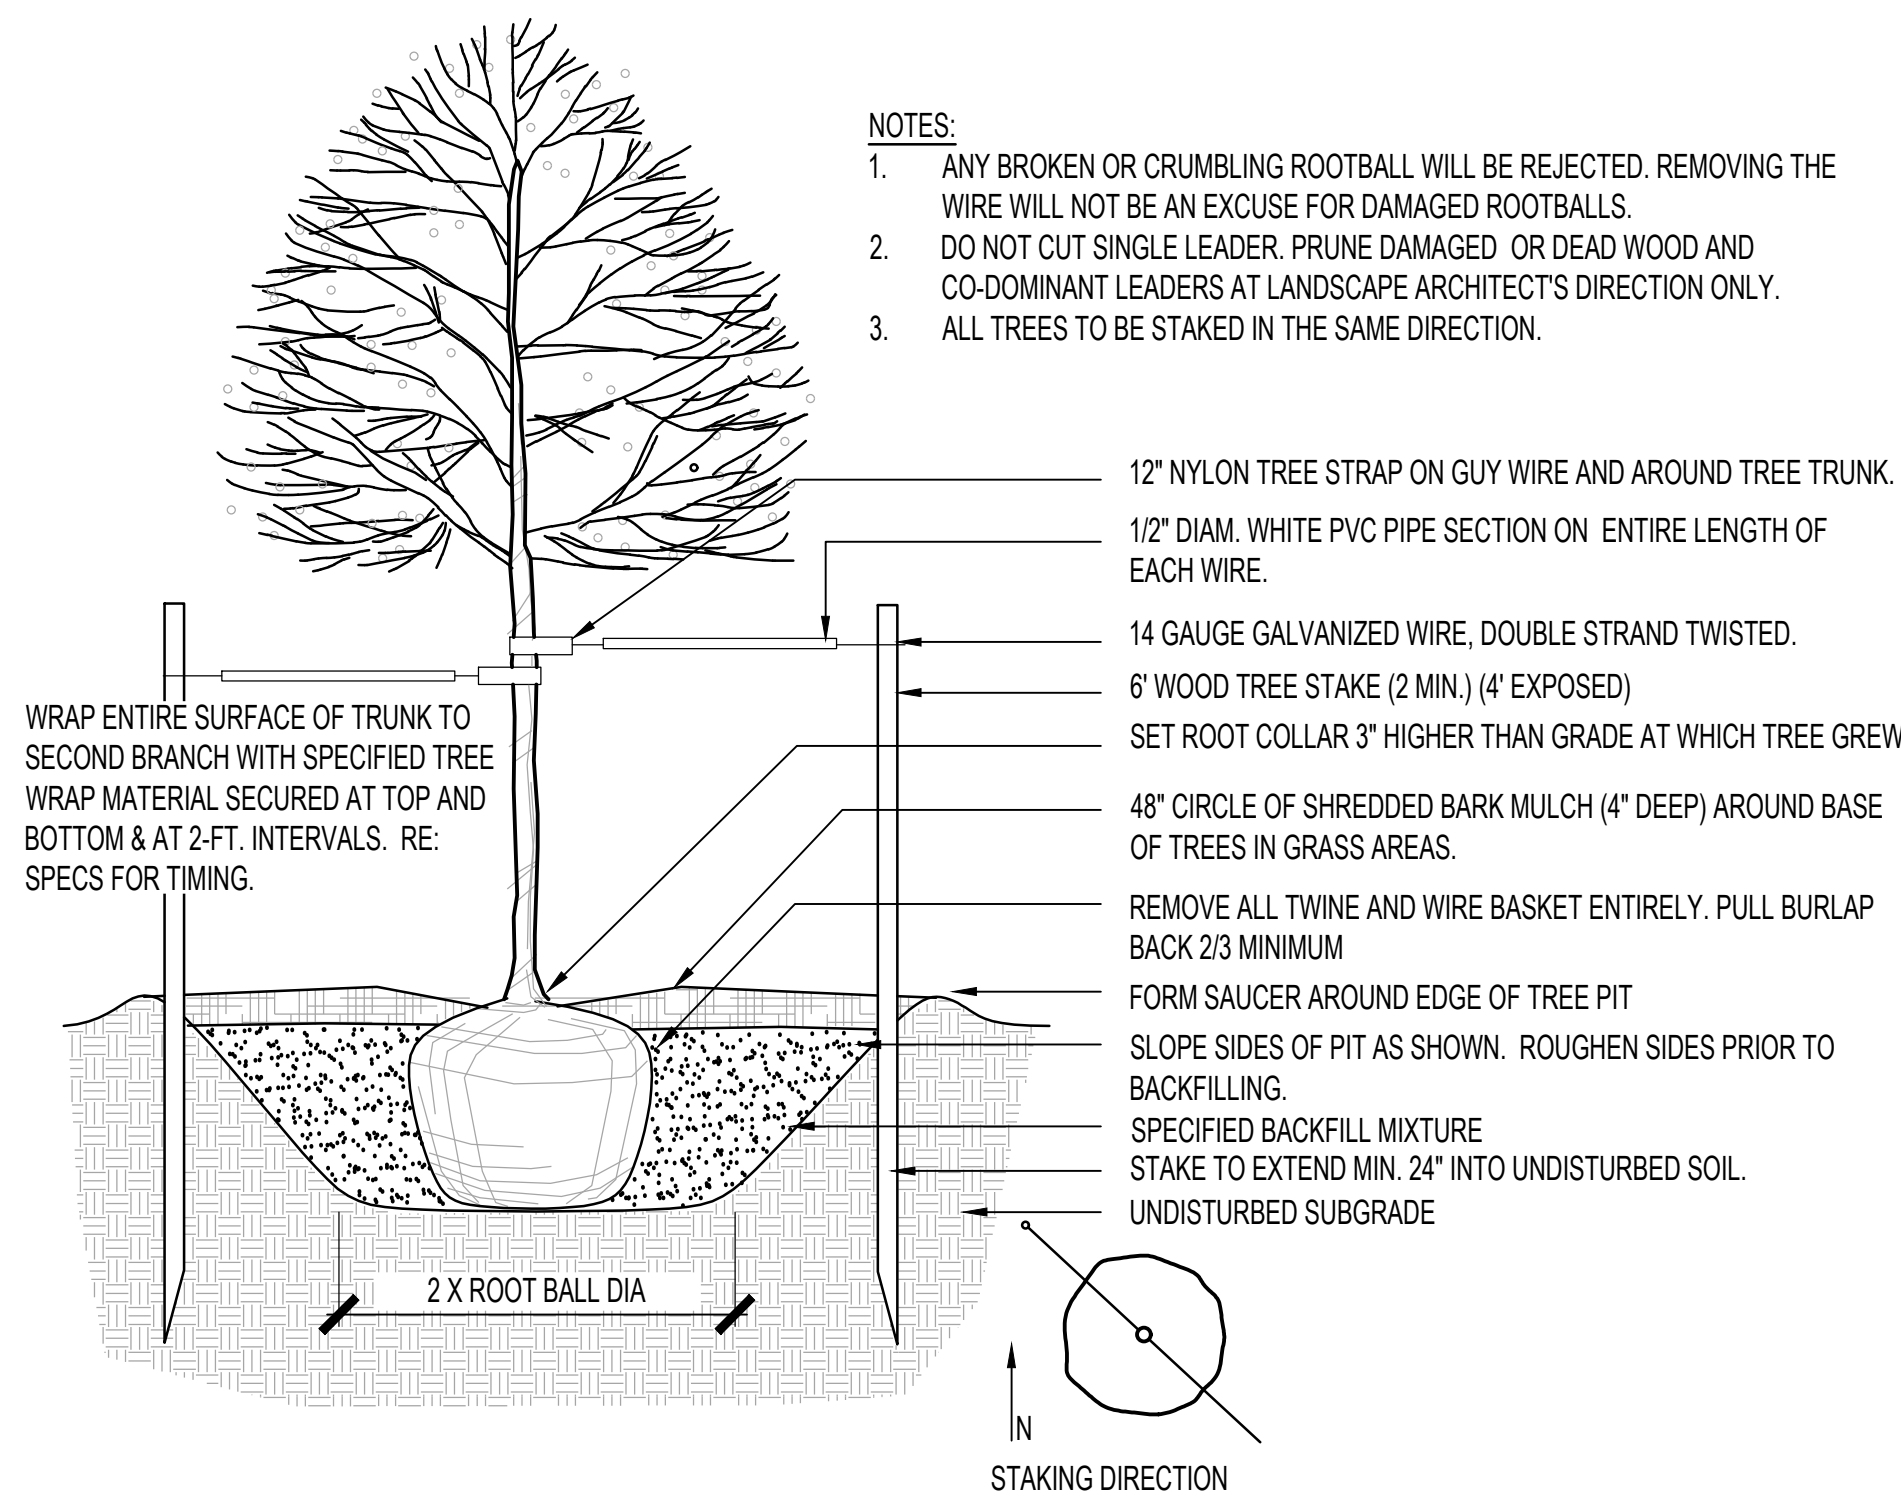


A DECIDUOUS TREE PLANTING
SCALE: NTS

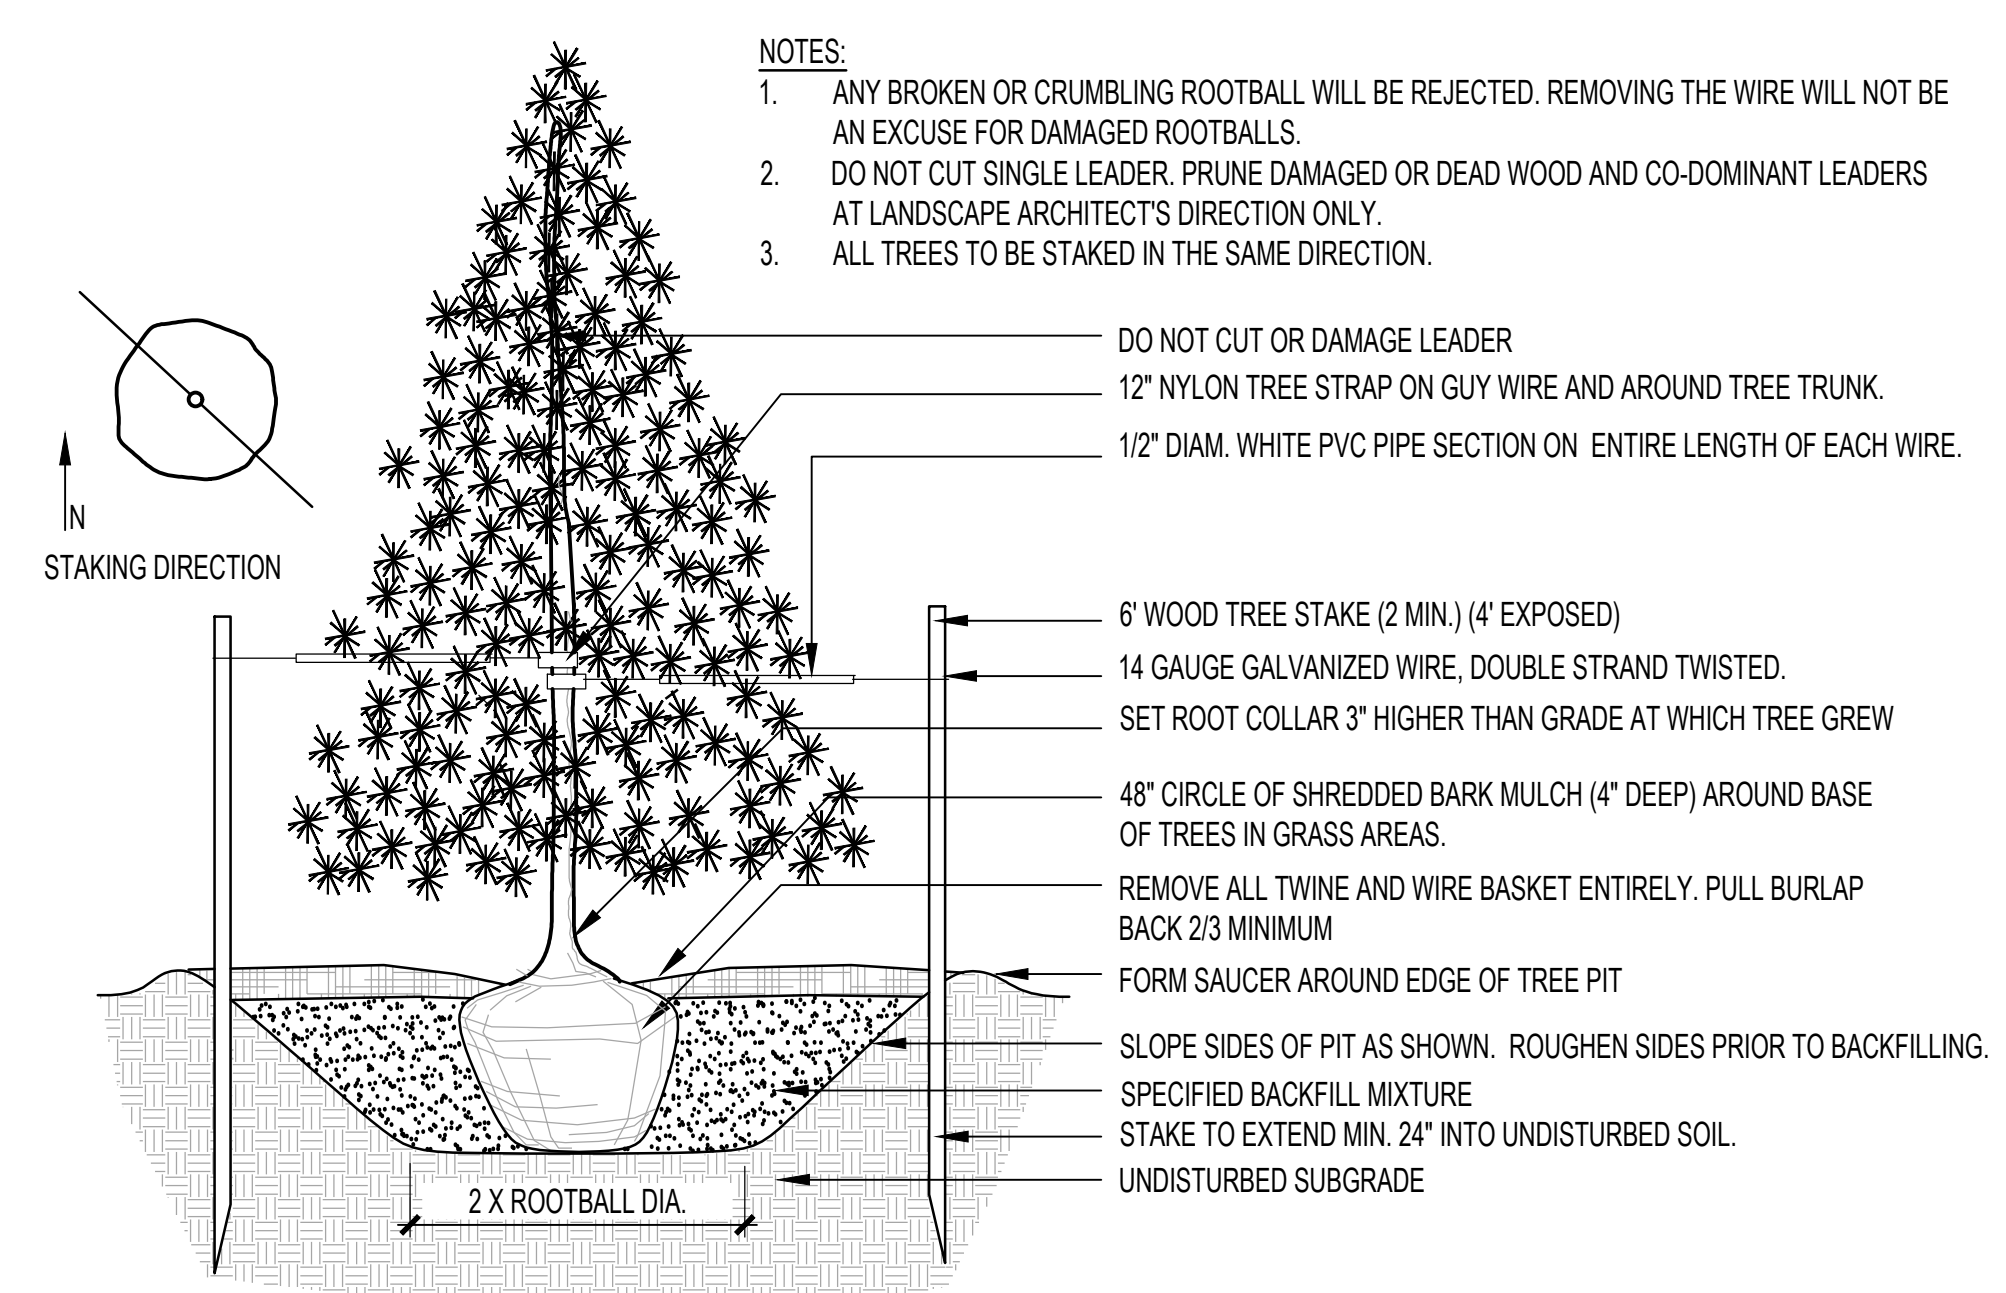


B EVERGREEN TREE PLANTING
SCALE: NTS

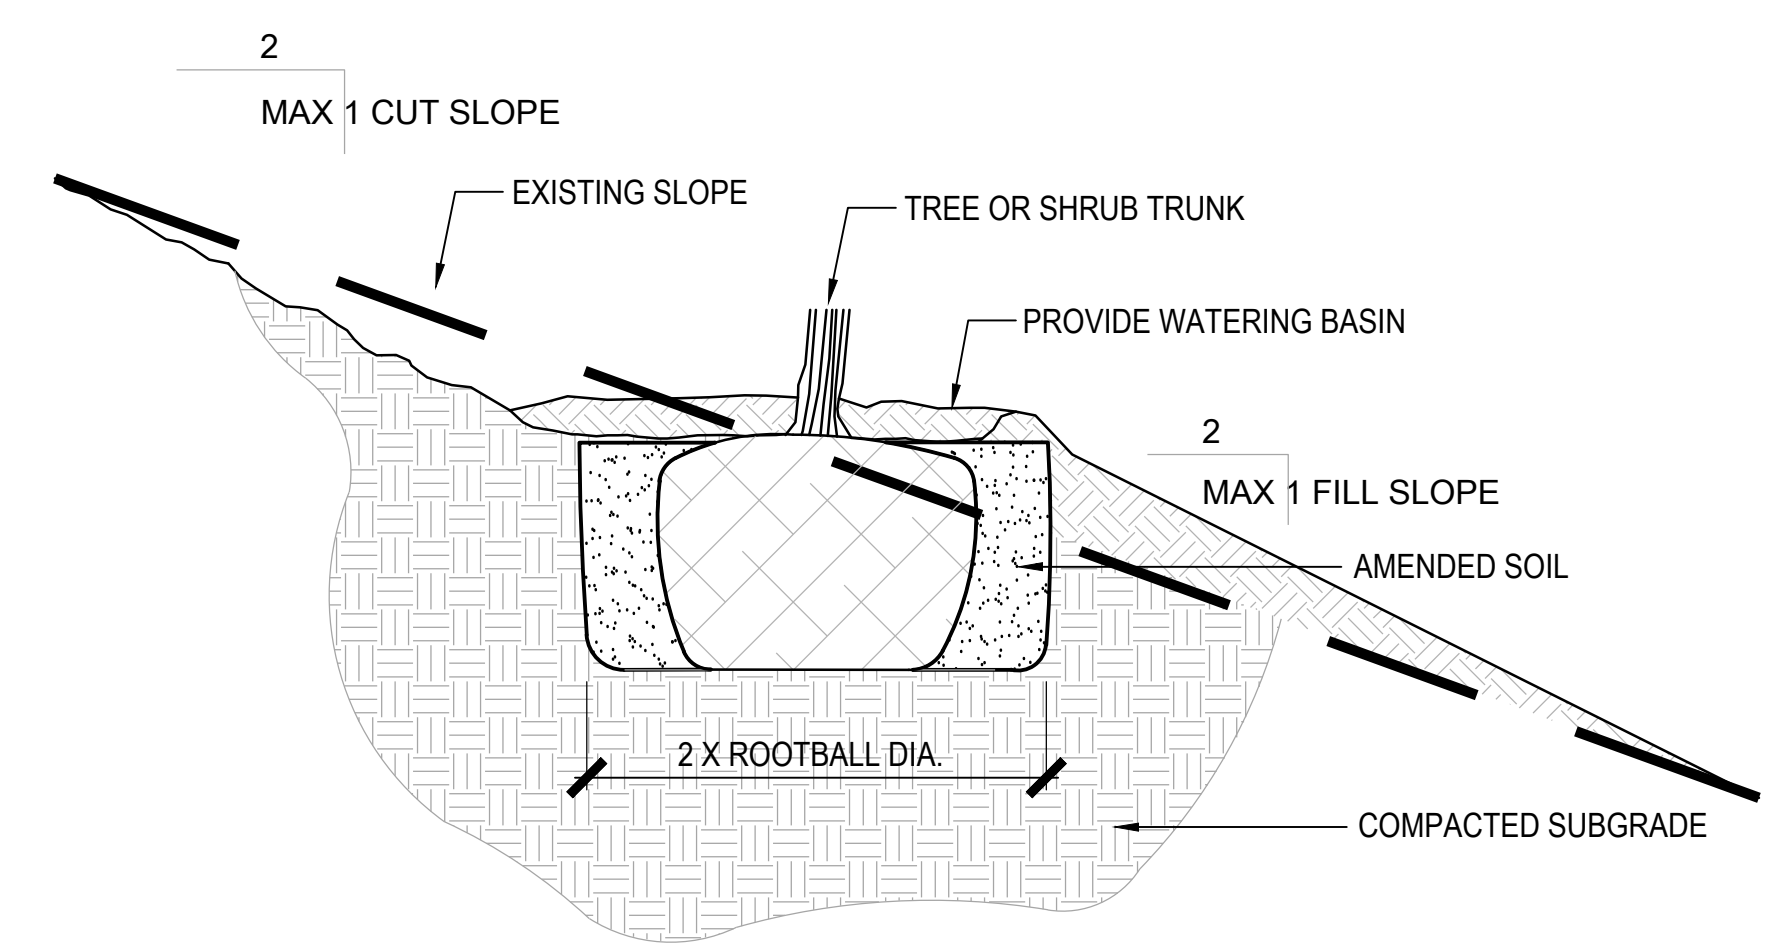


C TREE & SHRUB PLANTING ON SLOPES
SCALE: NTS

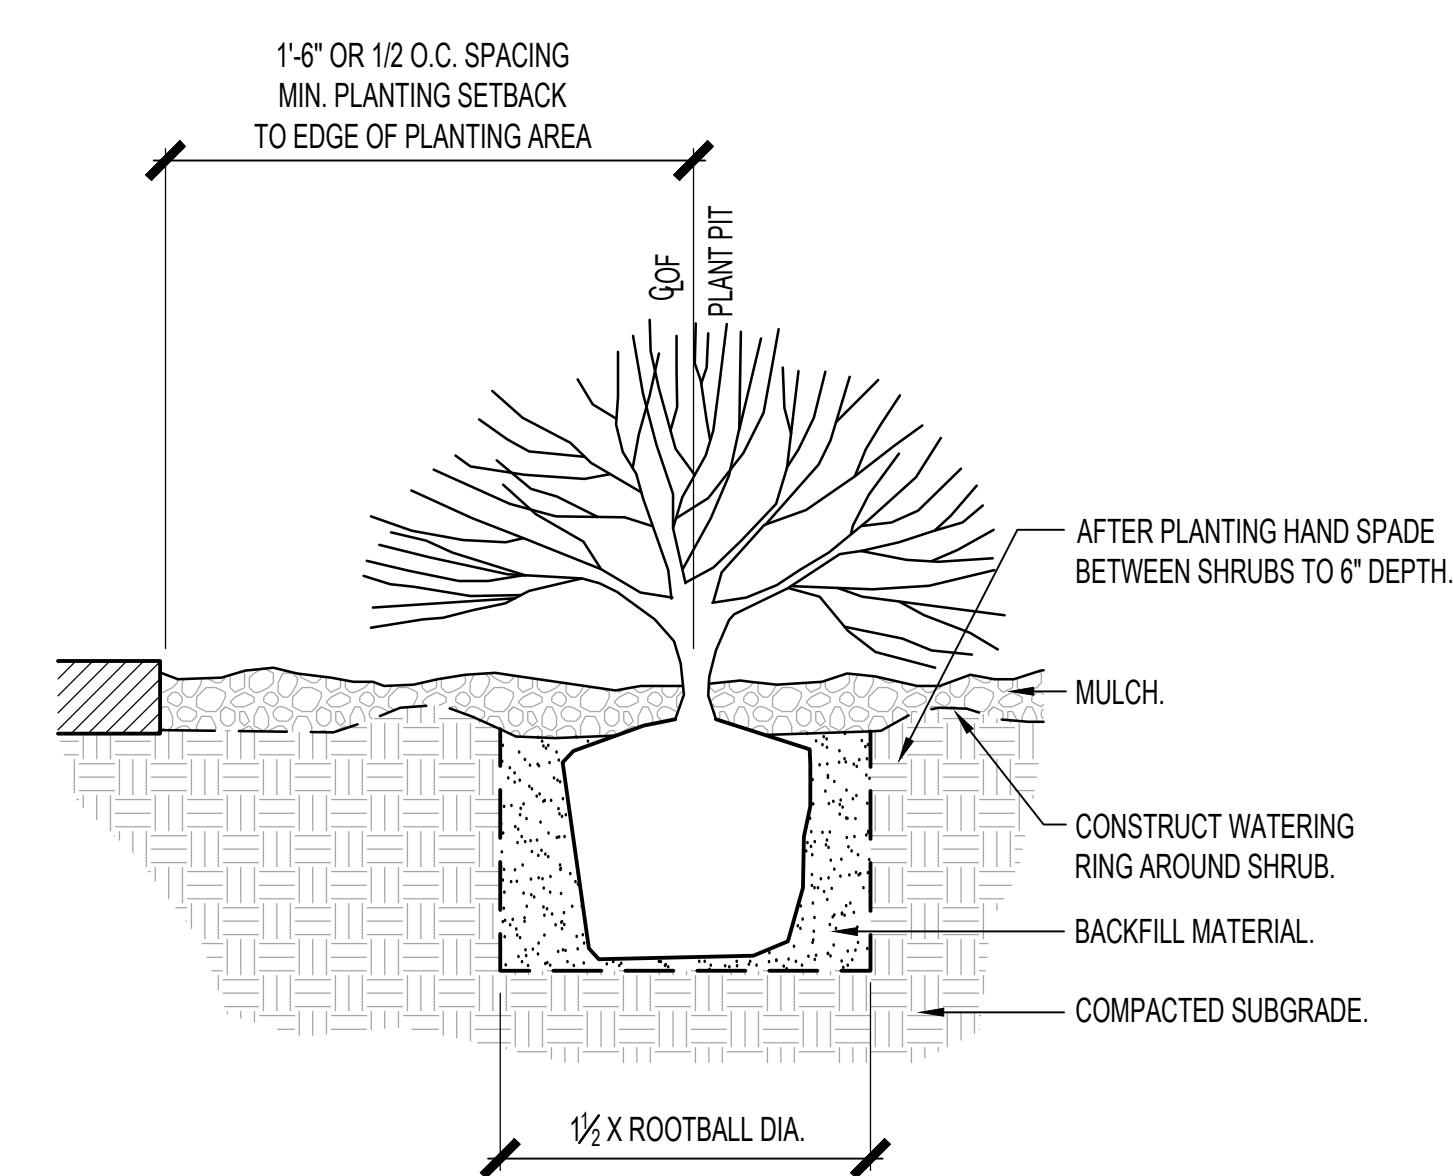

D SHRUB PLANTING
SCALE: NTS

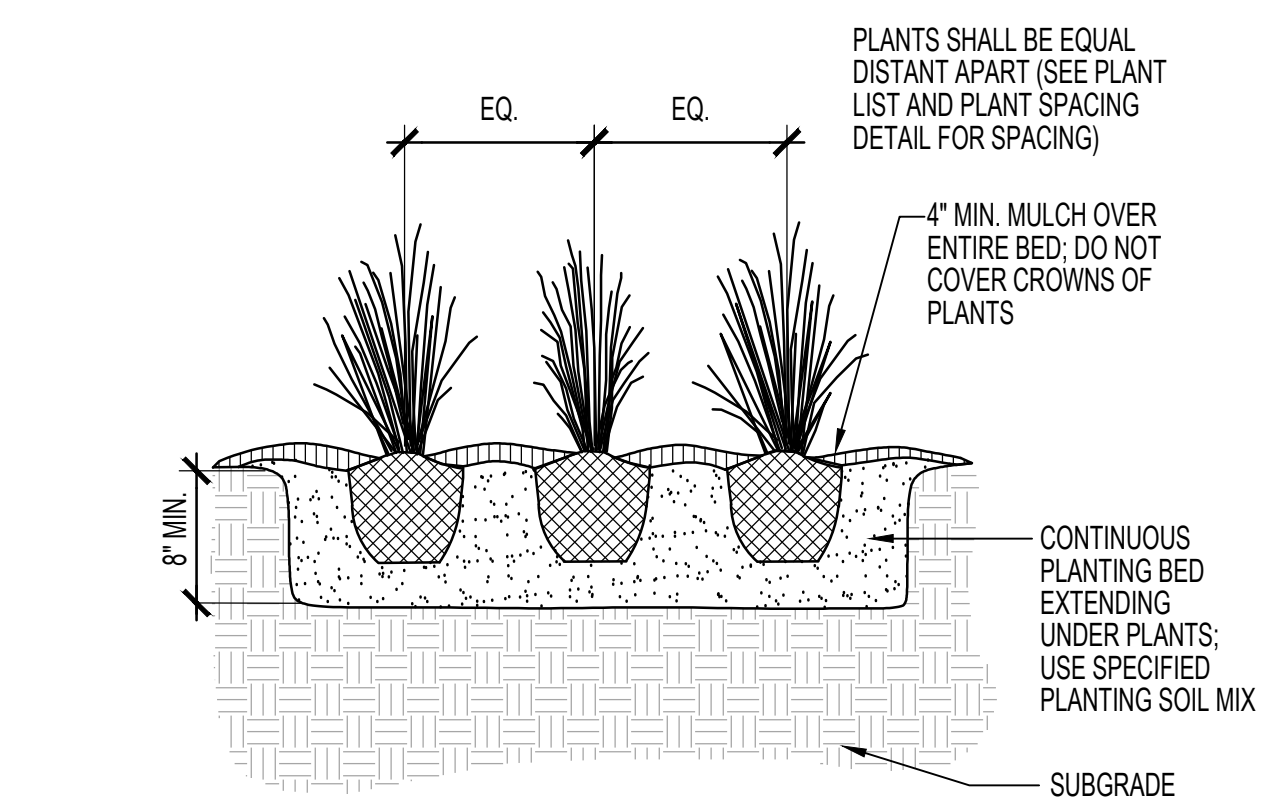


E ORNAMENTAL GRASS/PERENNIAL PLANTING
SCALE: NTS

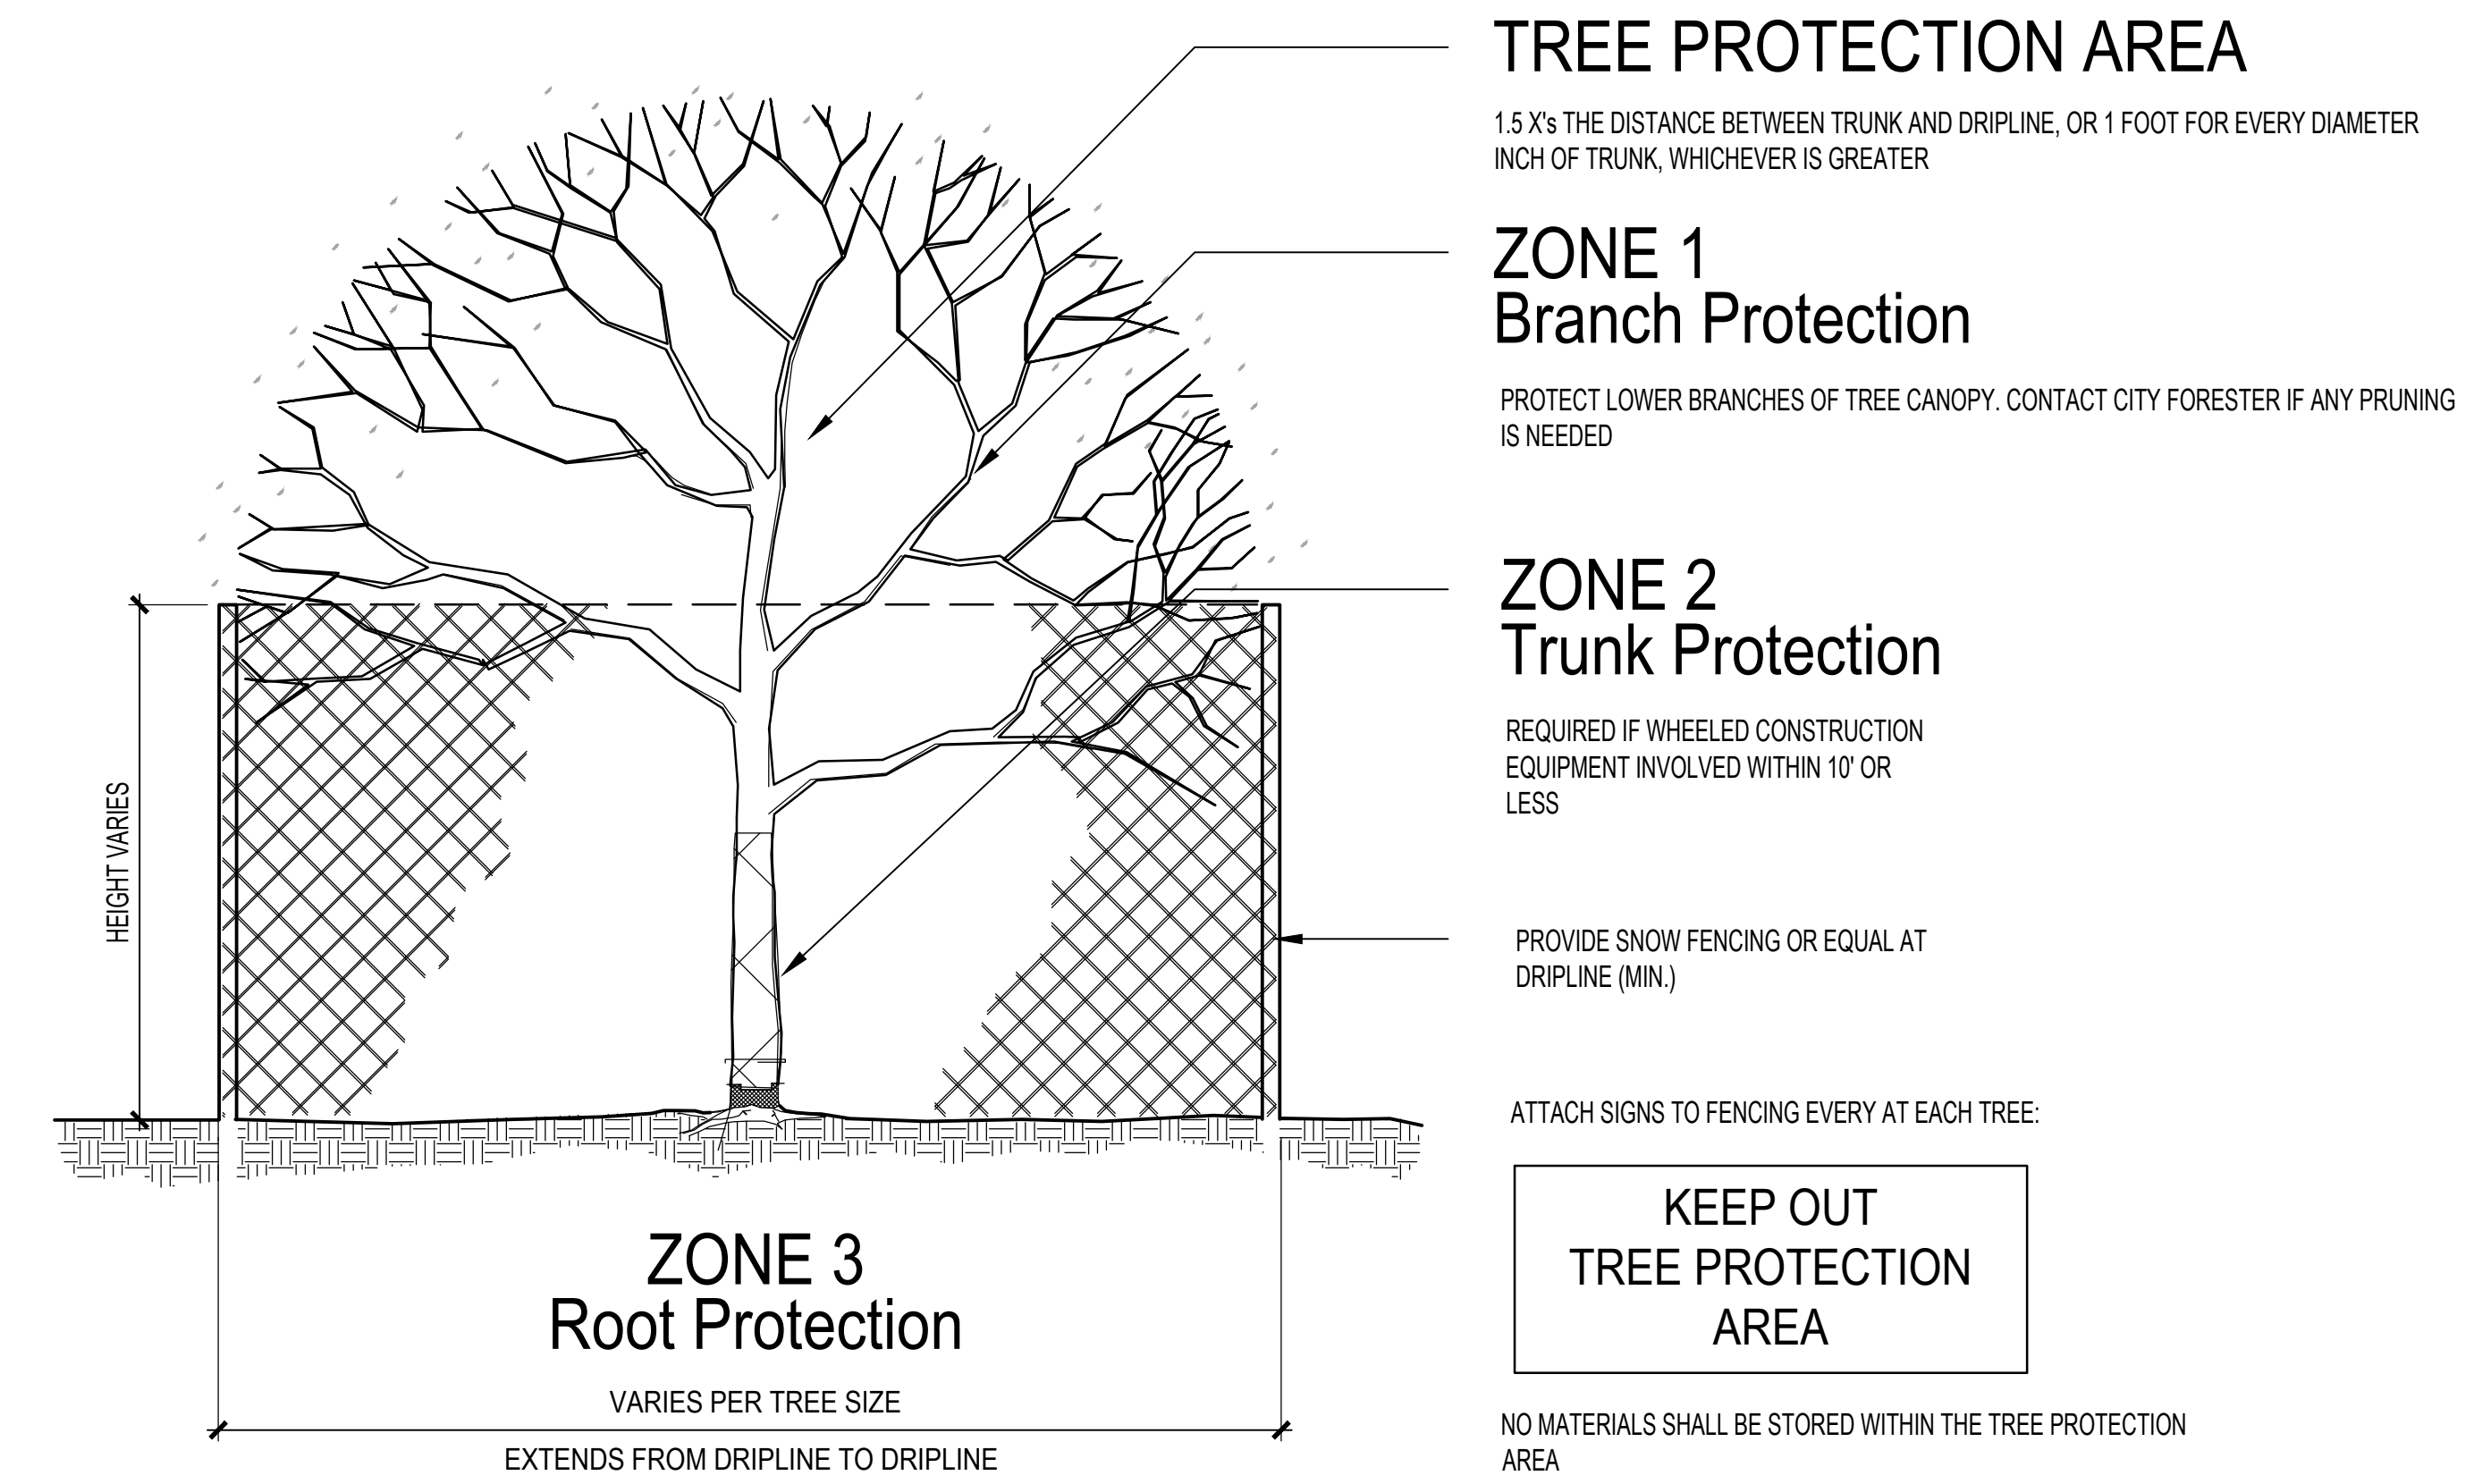

F TREE PROTECTION (AS REQUIRED)
SCALE: NTS


NO.	DATE	REMARKS
1	05/15/2024	SITE PLAN
2	05/11/2024	SITE PLAN

PA / PM:	CH
DRAWN BY:	CH
JOB NO.:	Author

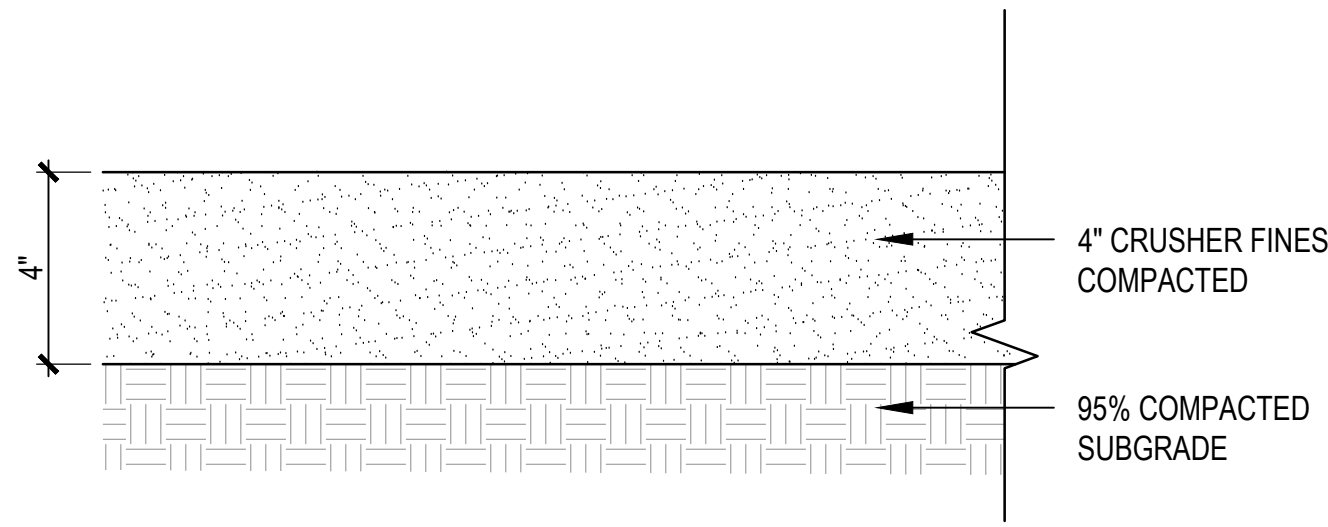


- NOTES:
1. 3/4" MINUS AGGREGATE GRAY GRANITE CRUSHER FINES.
 2. INSTALL IN (2) 2" LIFTS.

A CRUSHER FINES
SCALE: 3/4"=1'-0"

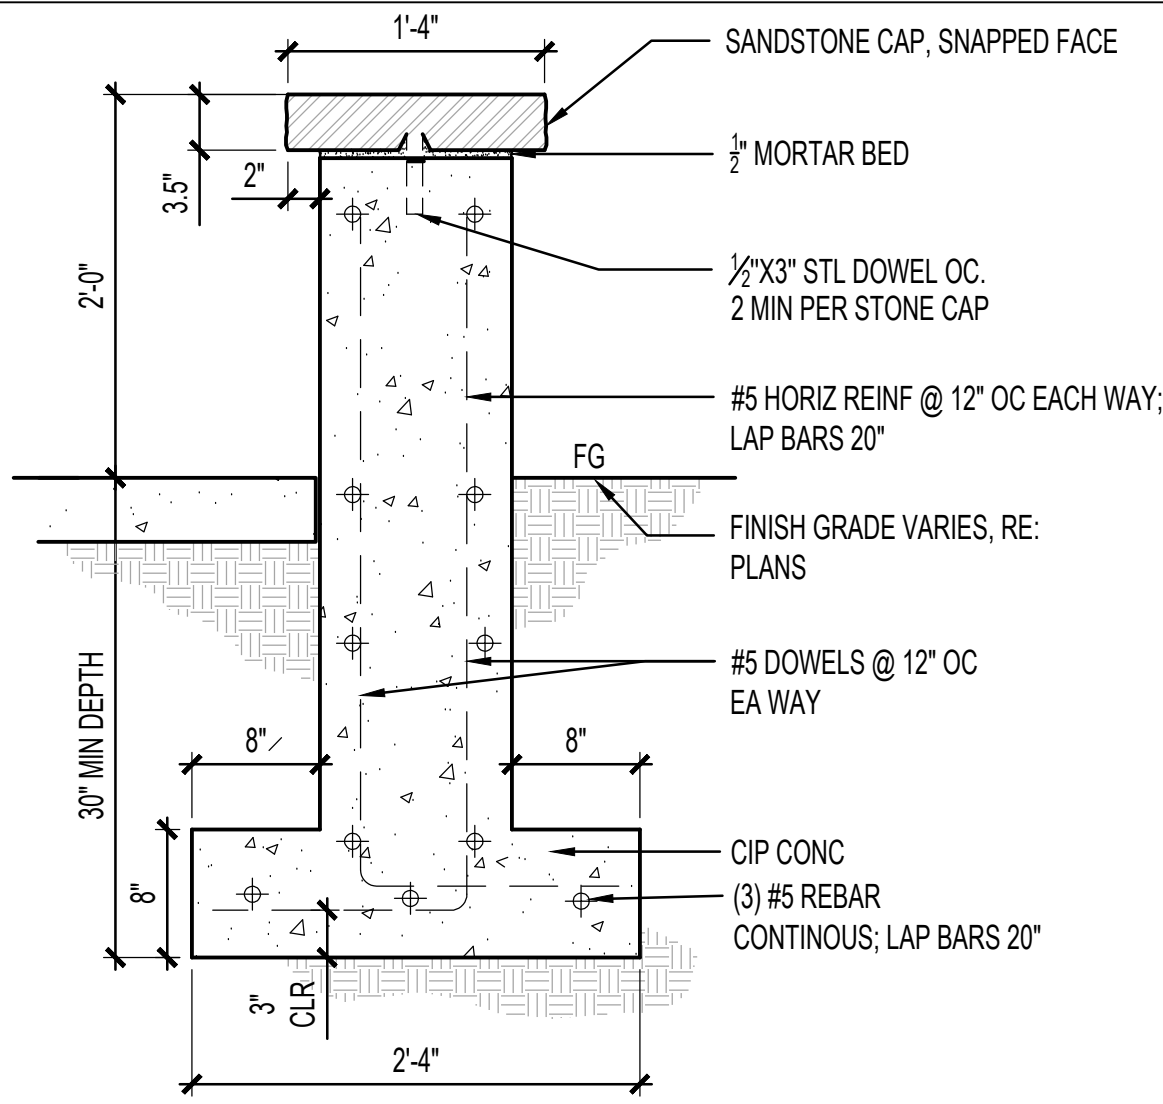


- NOTES:
1. ALL STONE TO BE PINK SANDSTONE.
 2. STONE TO BE SET IN MORTAR. JOINTS TO BE 1/2" TYP.
 3. CONCRETE TO BE INTEGRAL COLOR, DAVIS COLOR, TBD. SACK FINISH


B CIP CONCRETE SEAT WALL W/ STONE CAP
SCALE: 1'-1'-0"

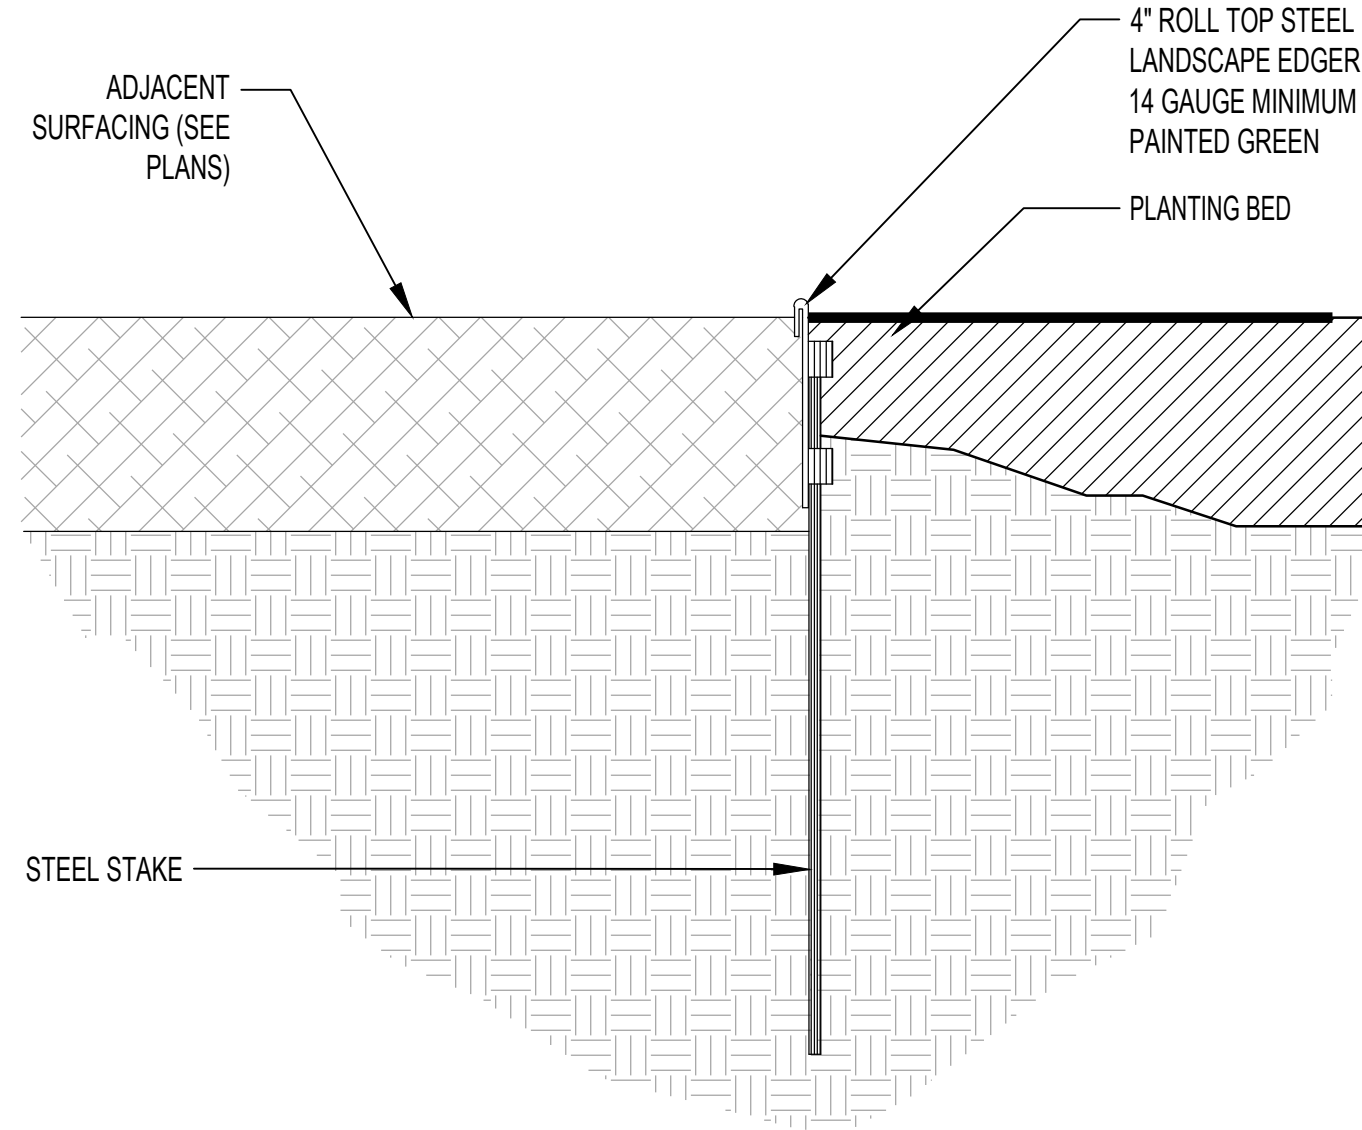

C STEEL EDGER
SCALE: 3/4"=1'-0"
FILENAME

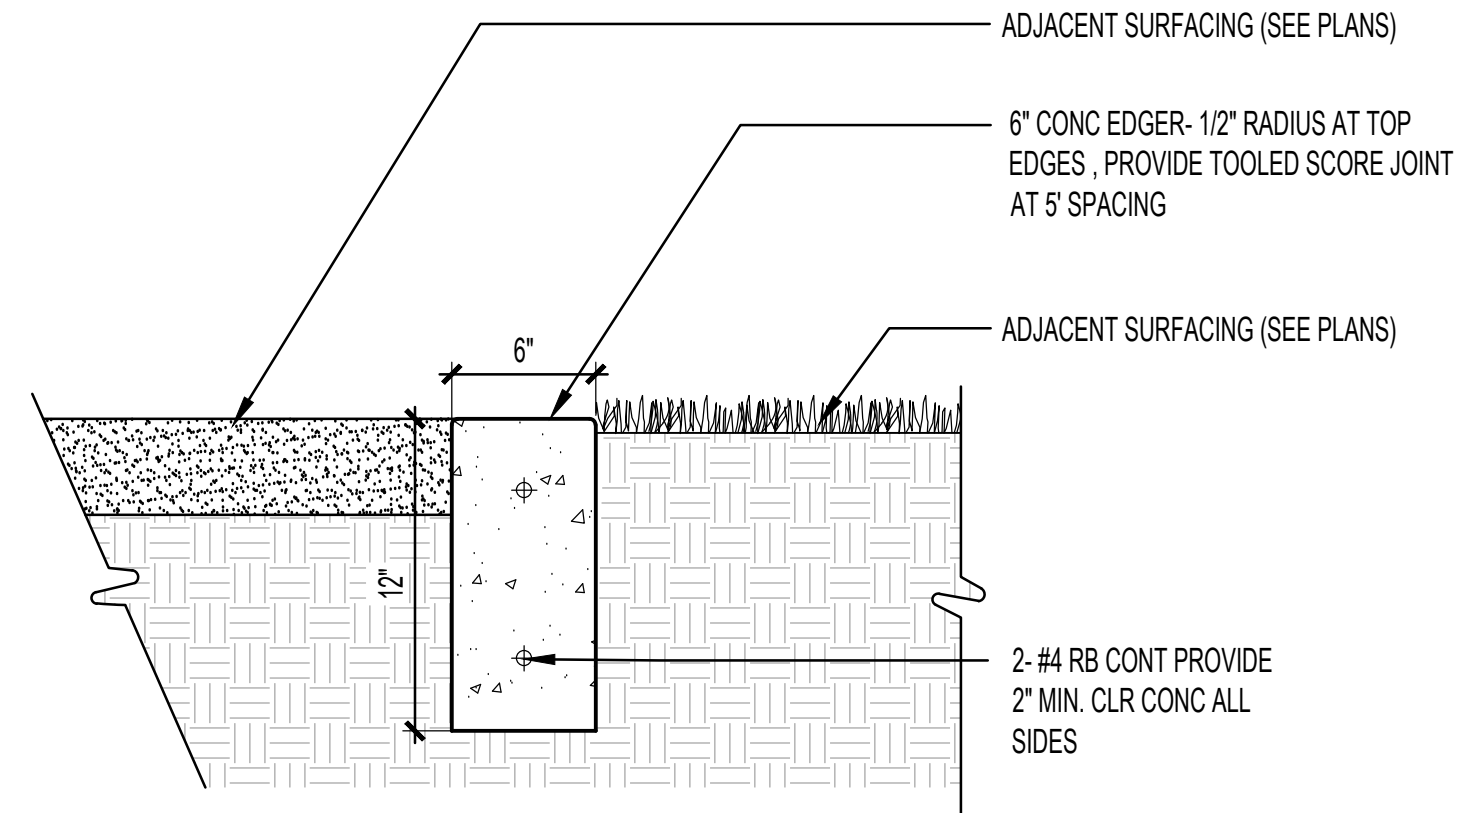


D FLUSH CONCRETE EDGER
SCALE: 1 1/2"=1'-0"

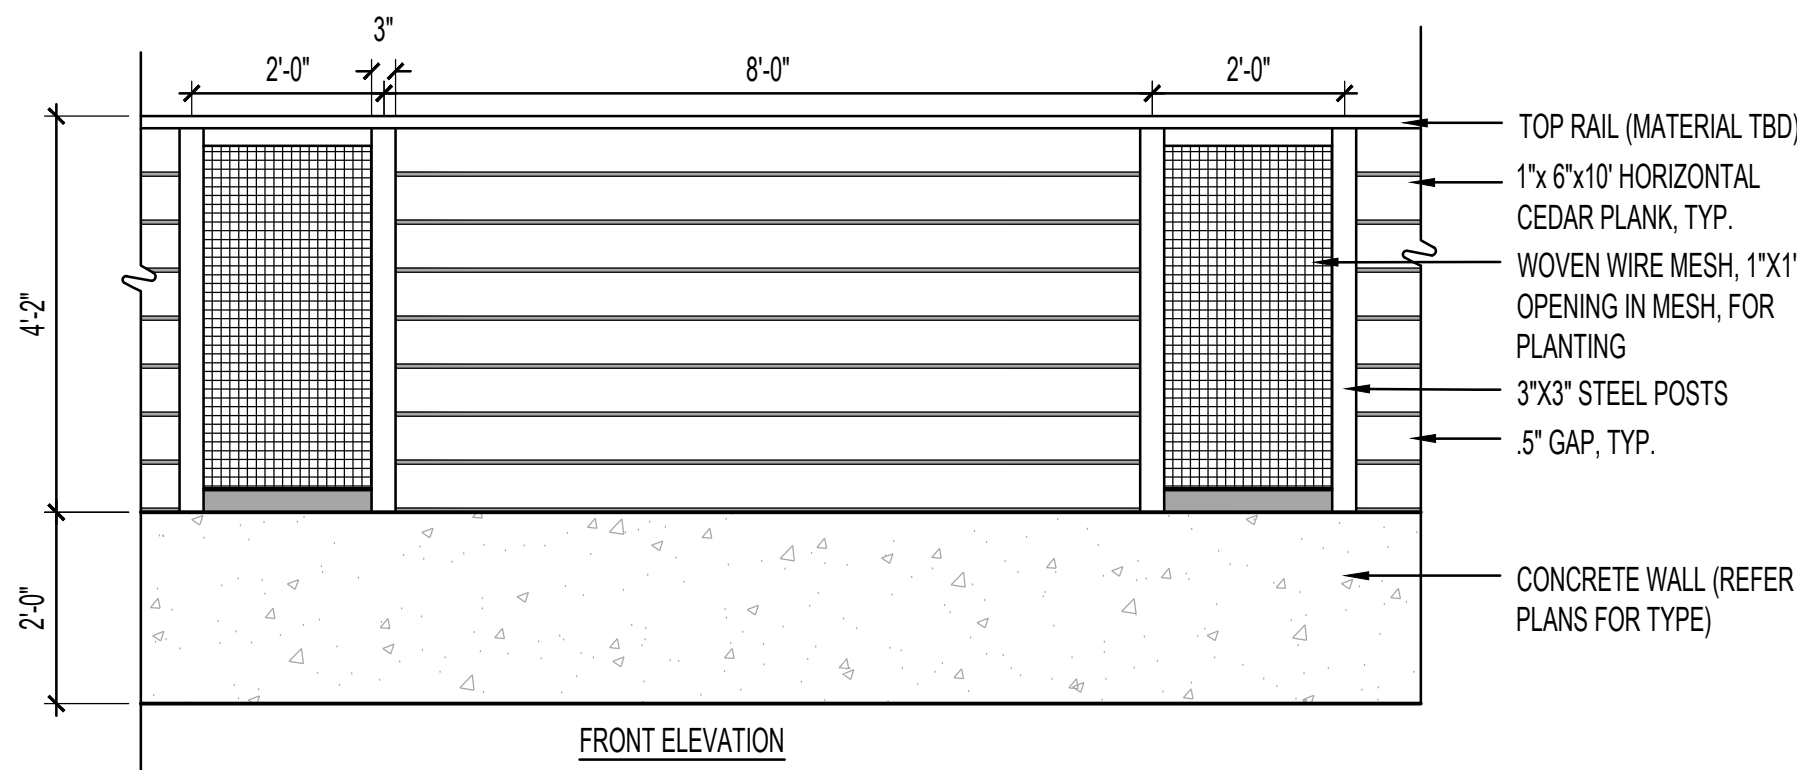


NOTE:
1. SUBMIT SHOP DRAWINGS

E ORNAMENTAL FENCE ON WALL
SCALE: 1/2"=1'-0"

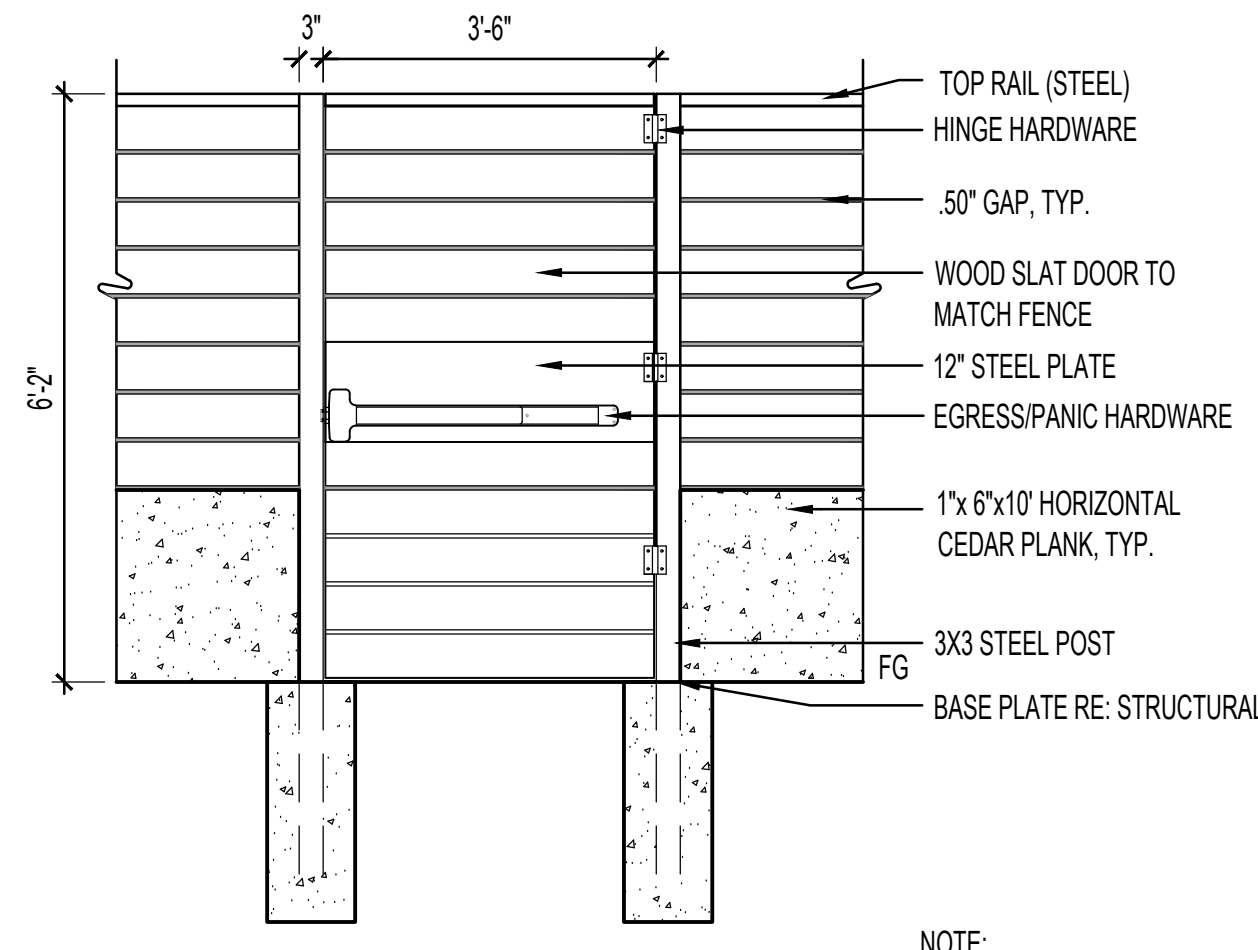

NOTE:
1. SUBMIT SHOP DRAWINGS

F ORNAMENTAL FENCE GATE (6')
SCALE: 1/2"=1'-0"

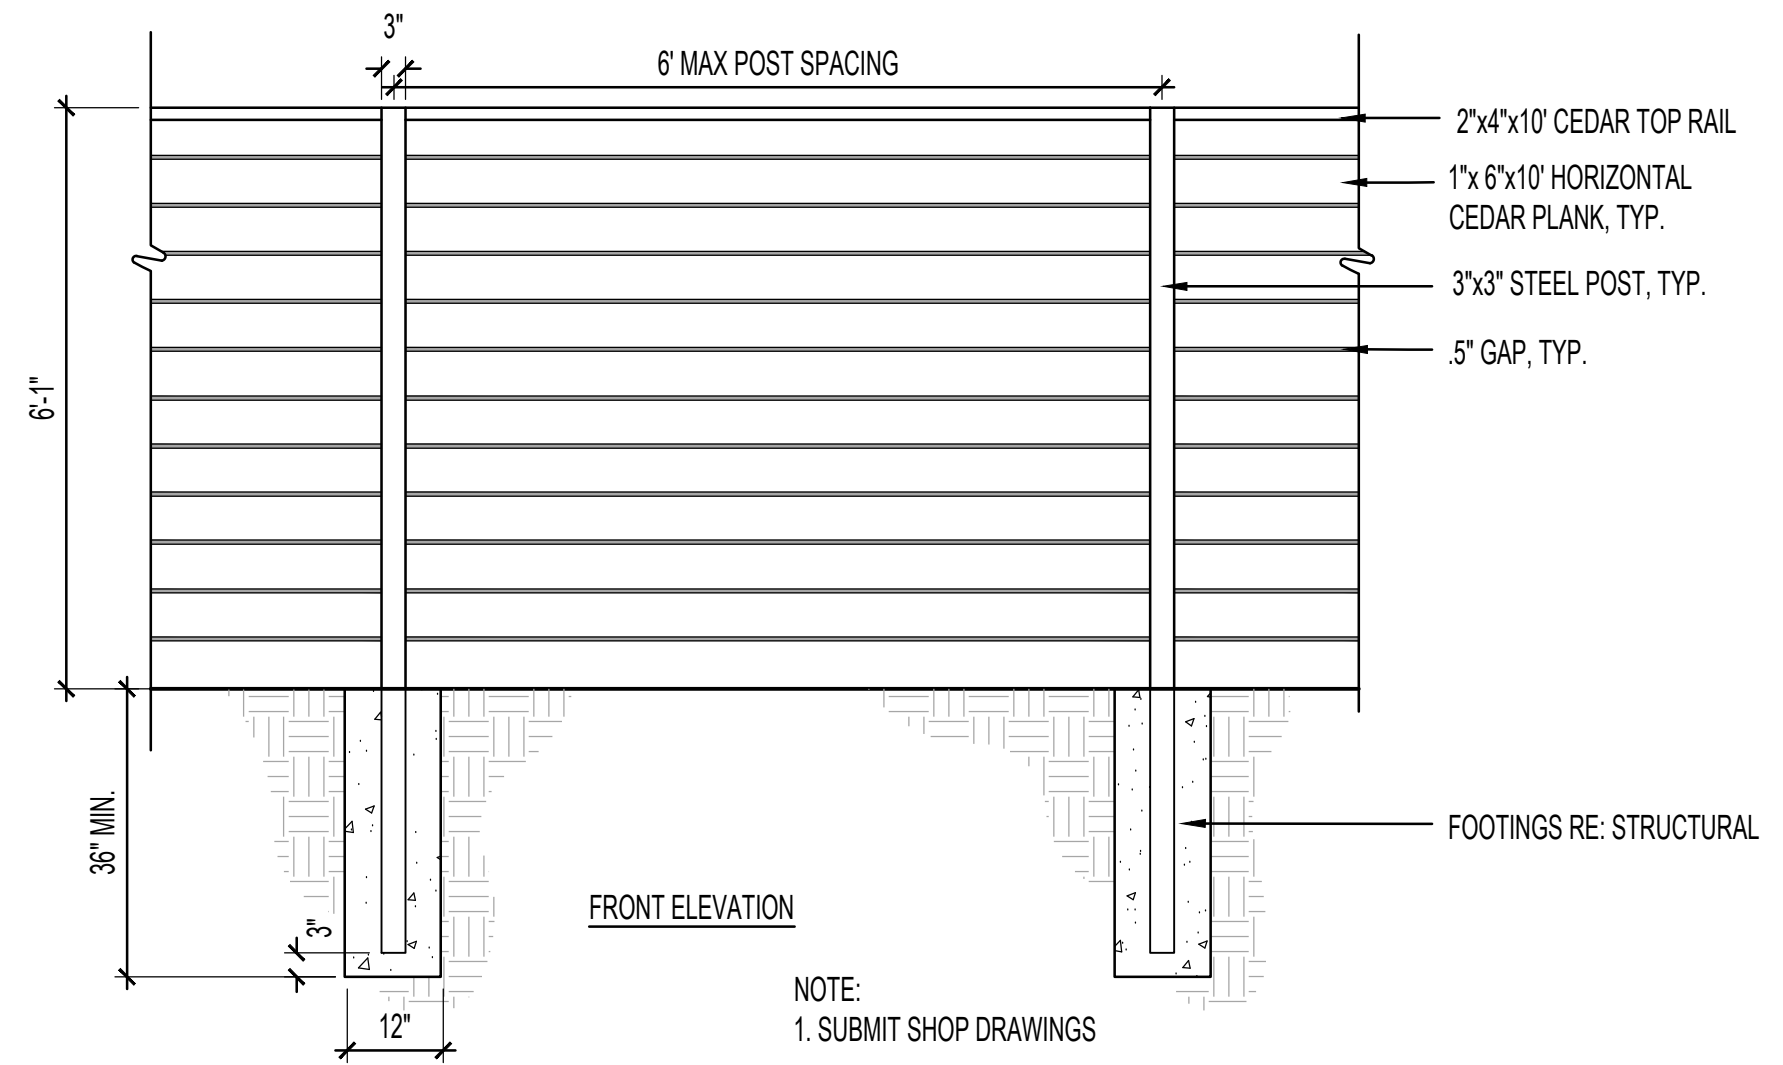


NOTE:
1. SUBMIT SHOP DRAWINGS


G PRIVACY FENCE
SCALE: 1/2"=1'-0"

NO.	DATE	REMARKS
1	05/15/2024	SITE PLAN
2	05/11/2024	SITE PLAN

PA / PM:	CH
DRAWN BY:	CH
JOB NO.:	Author

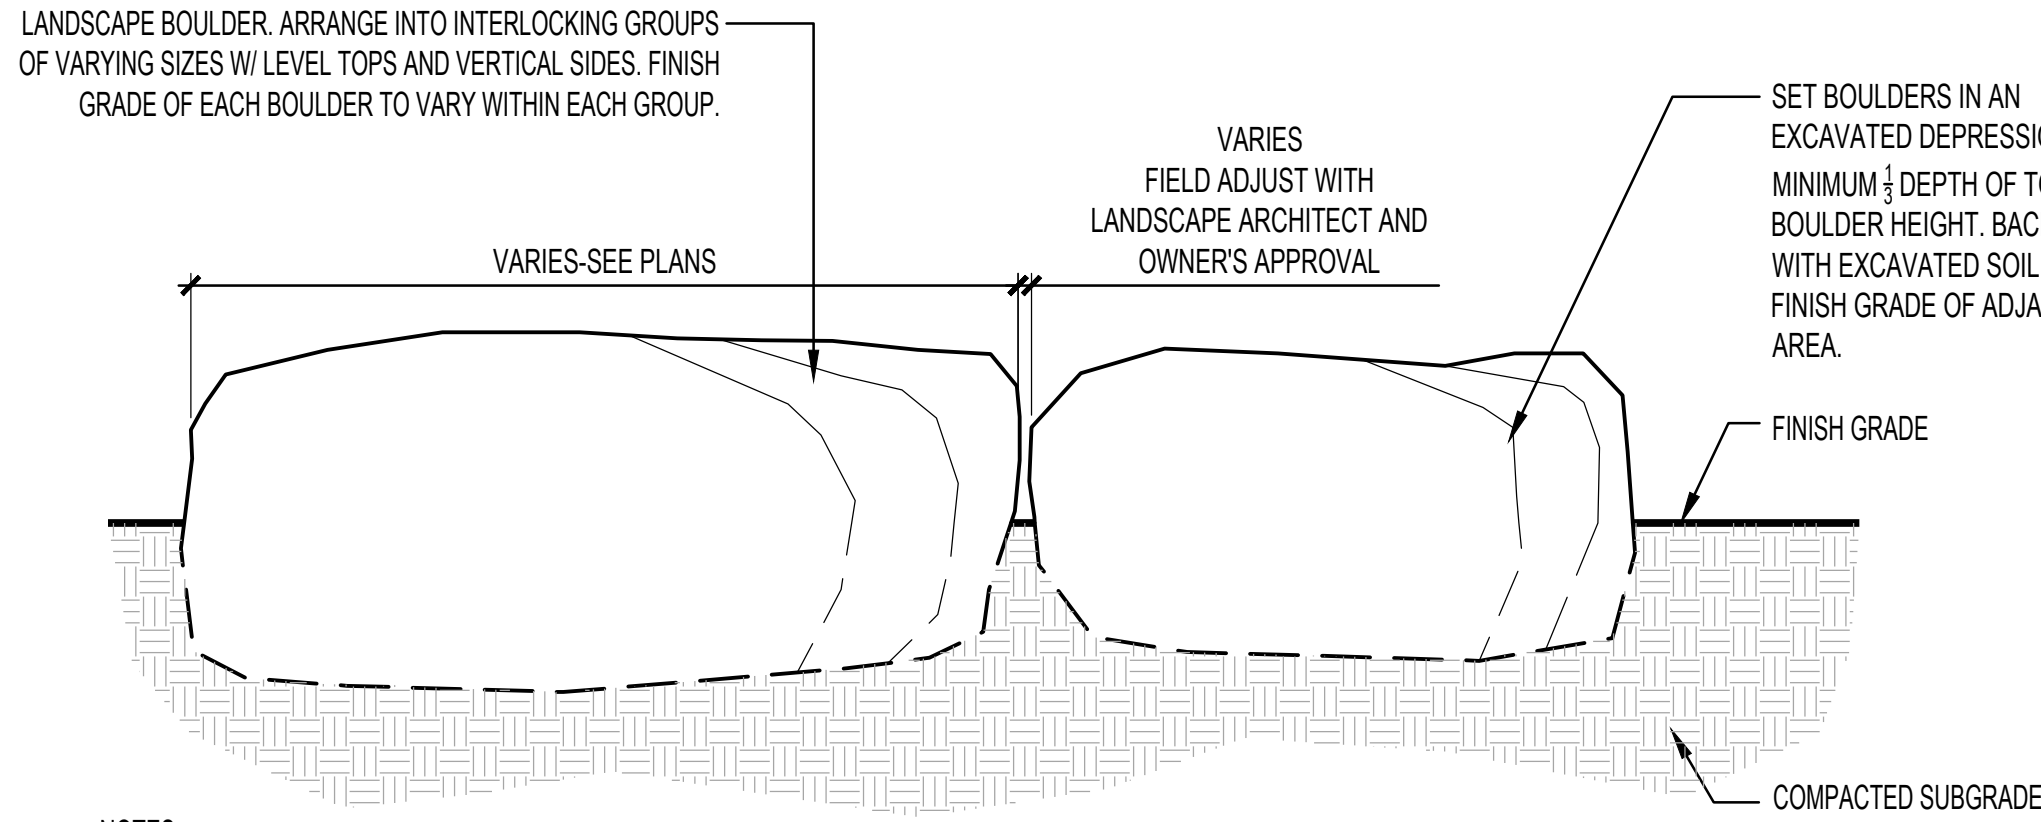

- NOTES:
1. CONTRACTOR TO STAKE LOCATIONS W/ WOODEN STAKE (W/ SIZE NOTED). STAKED LOCATIONS SHALL BE APPROVED PRIOR TO INSTALLATION BY LANDSCAPE ARCHITECT OR OWNER.
 2. BOULDERS SHALL NOT BE PLACED ALONG ARTERIAL STREETS.
 3. BOULDER LOCATIONS SHALL BE OUTSIDE OF CLEAR-ZONES OF ALL PUBLIC ROW. 50% BURIED IN PUBLIC ROW. NO MORE THAN 14" HEIGHT IN PUBLIC ROW.

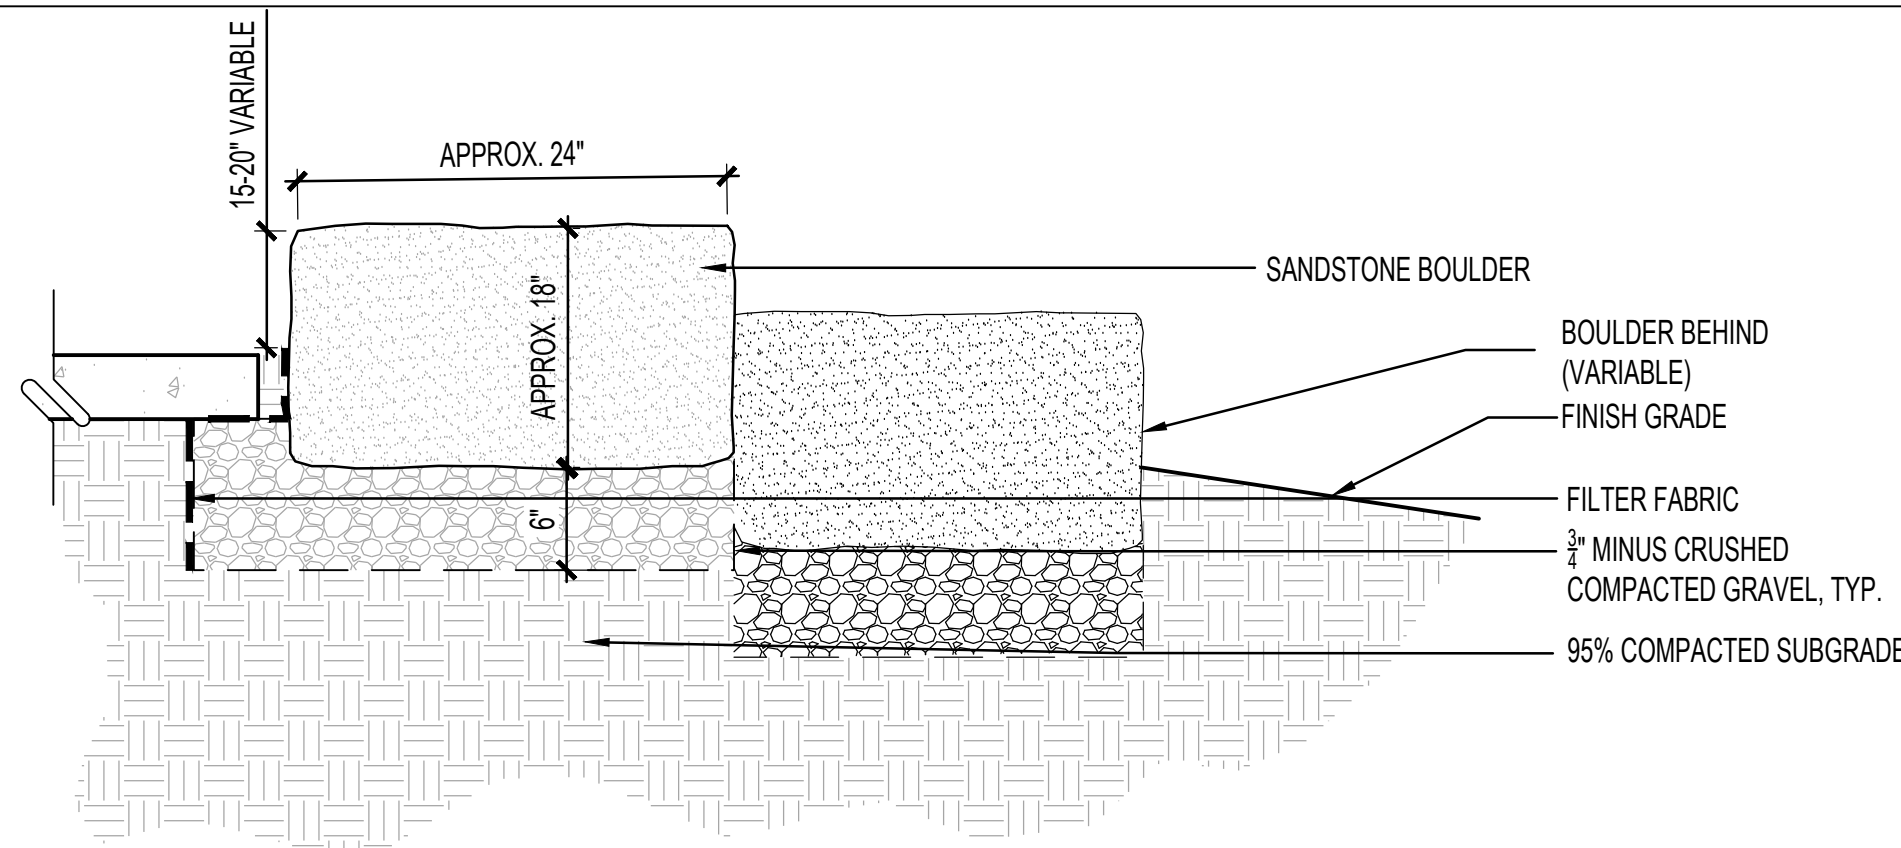

NOTE: ALL BOULDER PLACEMENT SHALL BE DONE UNDER SUPERVISION OF THE LANDSCAPE ARCHITECT. THERE SHALL BE NO MORE THAN A 1" MAX GAP BETWEEN BOULDERS AT THE FRONT (ALONG FACE) AND A 3" MAX GAP TOWARD THE BACK OF THE BOULDERS. ALL GAPS ARE TO FILLED WITH STABILIZED CRUSHED GRANITE AND COMPACTED.



PRECEDENT IMAGE SHOWN FOR CHARACTER AND DESIGN INTENT ONLY.

1. LOCATE BIRDHOUSES WITHIN AND ADJACENT TO WATER QUALITY POND
2. MOUNT TO STEEL POSTS
3. FINAL DESIGN TO BE DETERMINED
4. SEE PLAN FOR GENERAL LOCATIONS

A LANDSCAPE BOULDER


SCALE: 3/4"=1'-0"

B BOULDER SEATING CLUSTER

SCALE: 1"=1'-0"

C BIRDHOUSES

SCALE: NTS

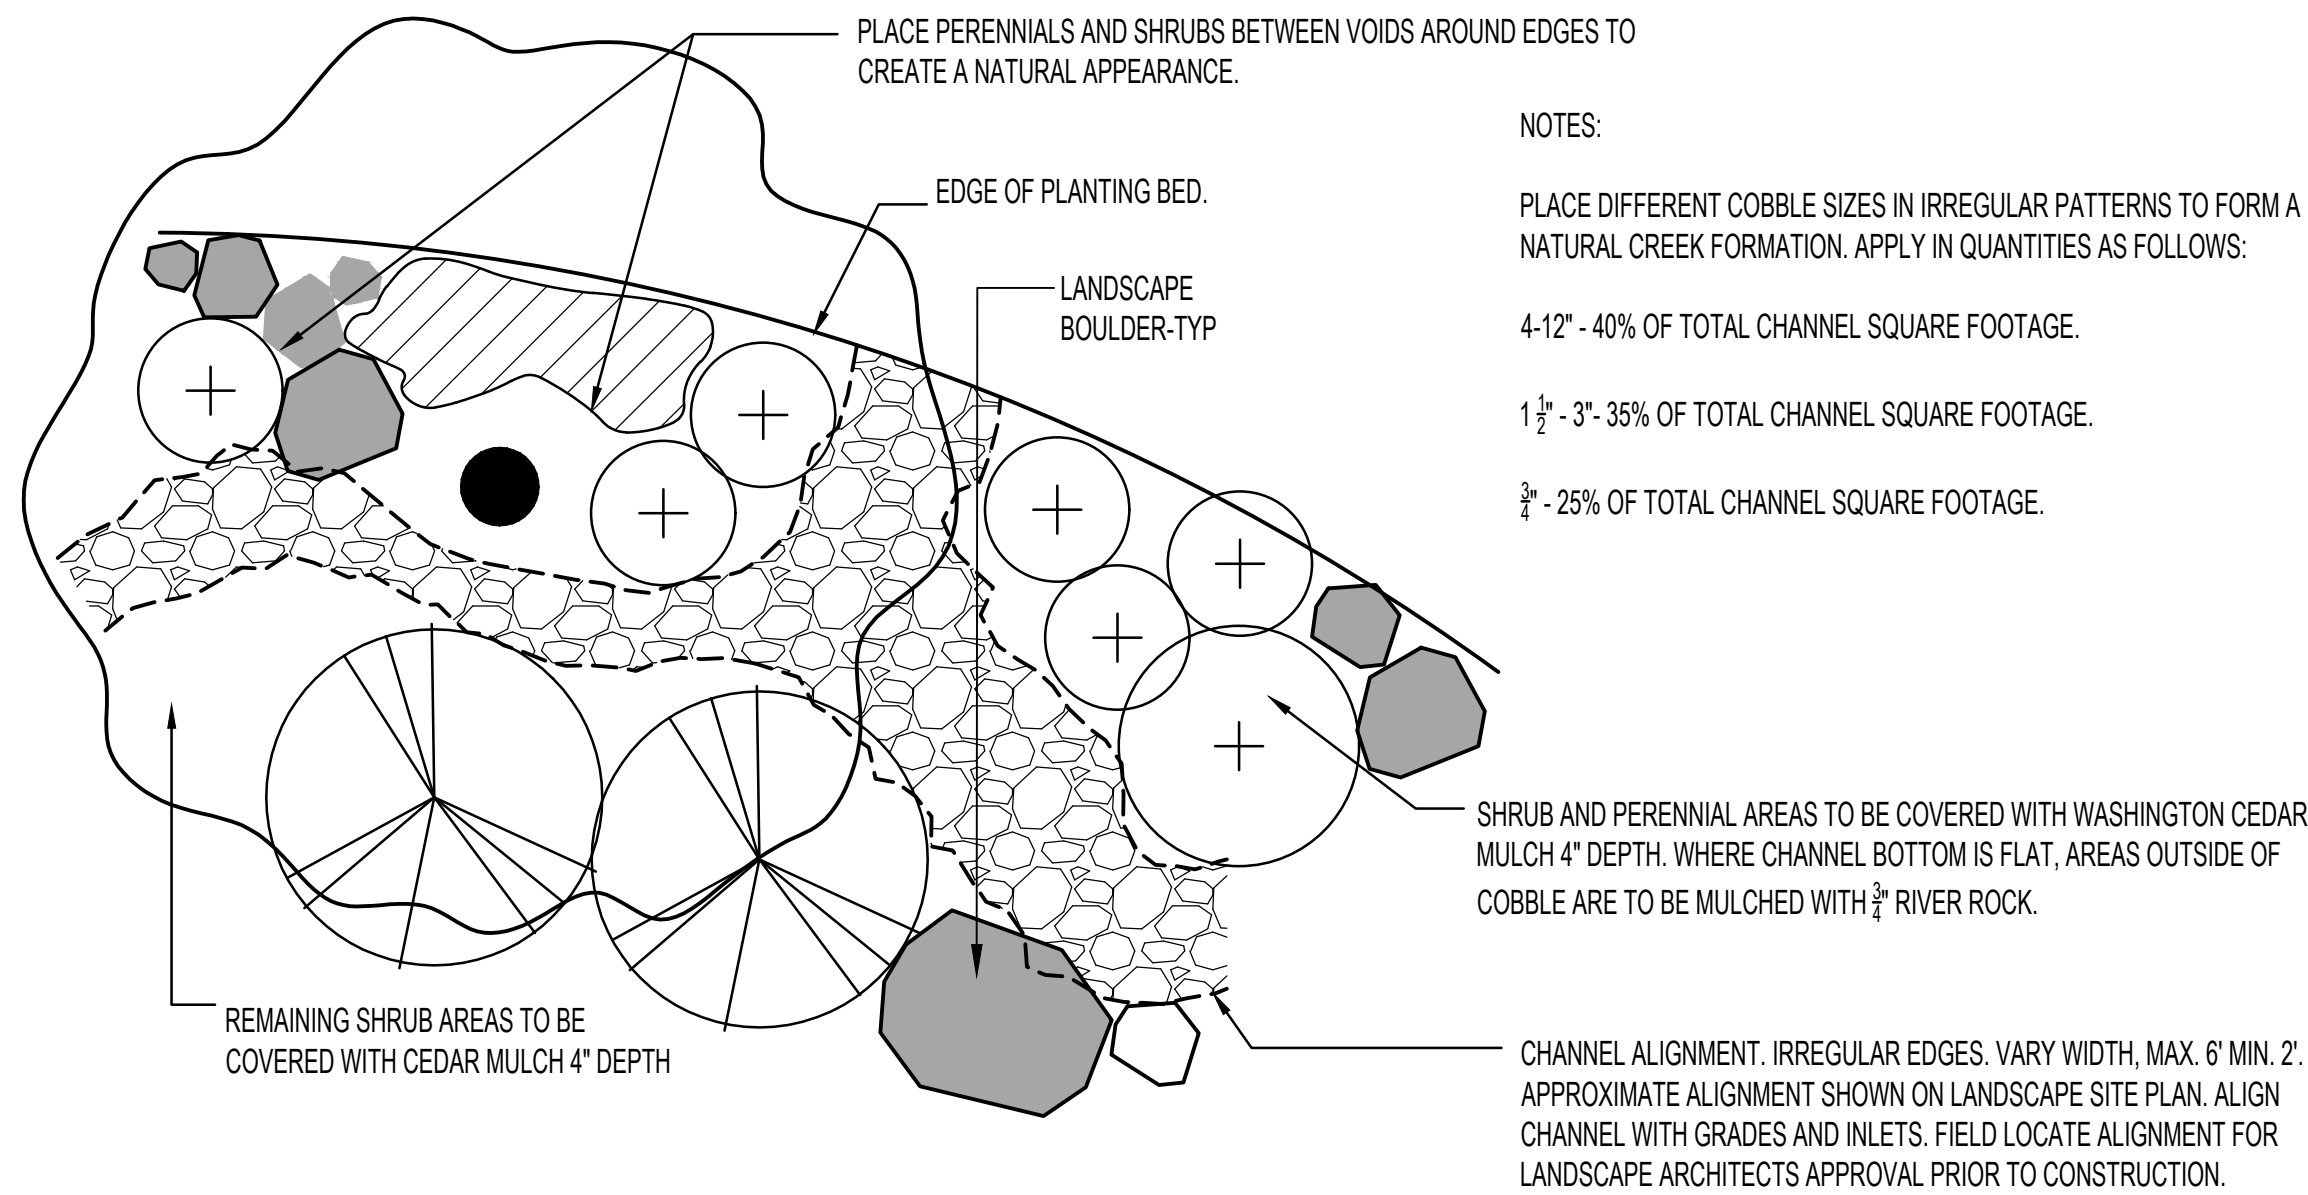


- NOTES:
- PLACE DIFFERENT COBBLE SIZES IN IRREGULAR PATTERNS TO FORM A NATURAL CREEK FORMATION. APPLY IN QUANTITIES AS FOLLOWS:
- 4-12" - 40% OF TOTAL CHANNEL SQUARE FOOTAGE.
 - 1 1/2" - 3" - 35% OF TOTAL CHANNEL SQUARE FOOTAGE.
 - 3/4" - 25% OF TOTAL CHANNEL SQUARE FOOTAGE.

- NOTE:
1. PLACE DIFFERENT COBBLE SIZES IN IRREGULAR PATTERN TO FORM NATURAL CREEK FORMATION. MEANDER EDGES OF SWALE THAT DEFINES THE EDGES BETWEEN THE MULCH AND THE COBBLE WITH LARGER VARIETIES OF COBBLE.
 2. REFER TO CIVIL DRAWINGS FOR SWALE GRADING.
 3. LARGER STONE SHALL BE PLACED FIRST, TO BE EMBEDDED, MINGLED AND SETTLED WITH SMALLER COBBLE.
 4. IMAGE SHOWN TO THE THE RIGHT FOR REFERENCE AND DESIGN INTENT.
 5. CONTRACTOR TO MOCK UP A 100 SF SECTION OF COBBLE SWALE FOR APPROVAL BY LANDSCAPE ARCHITECT PRIOR TO COMPLETING WORK.



D COBBLE SWALE


SCALE: 1/4"=1'-0"

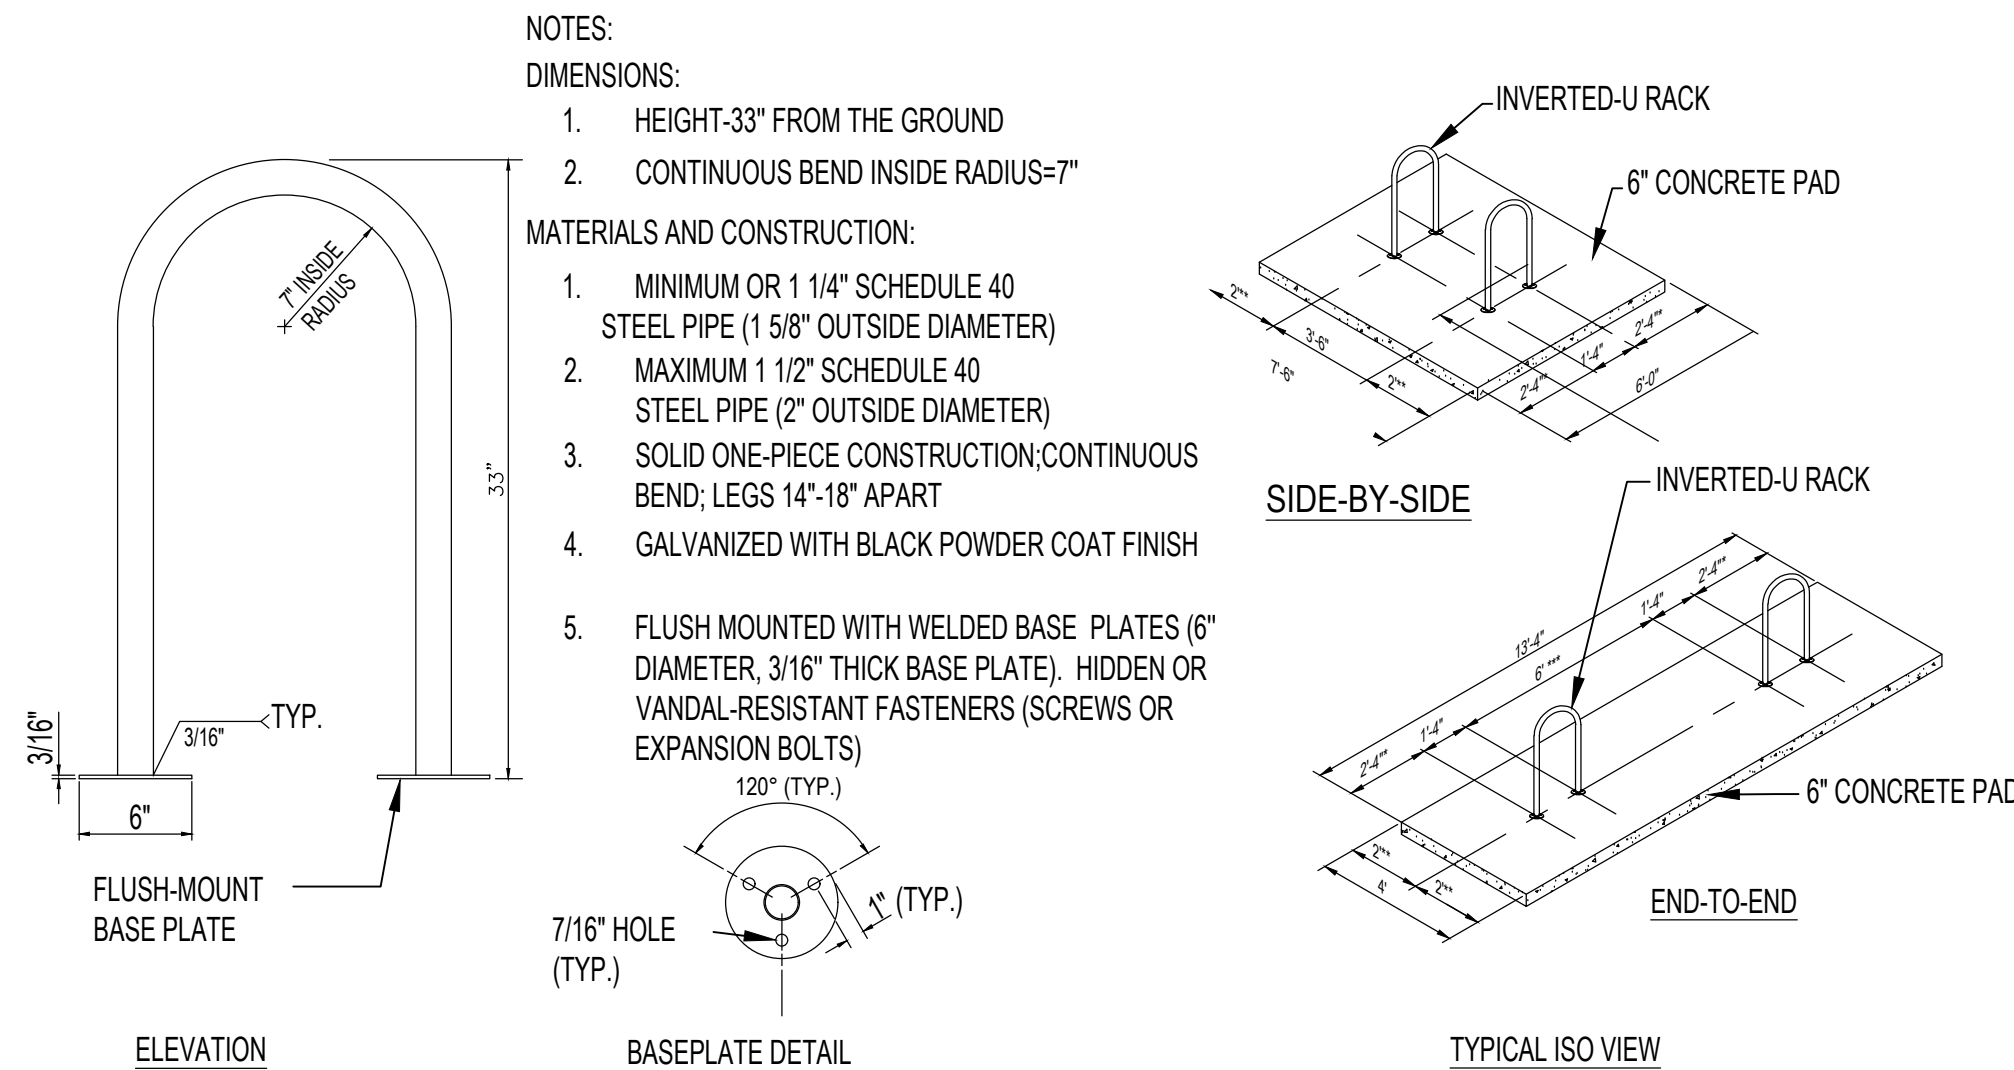

- NOTES:
- DIMENSIONS:
1. HEIGHT-33" FROM THE GROUND
 2. CONTINUOUS BEND INSIDE RADIUS=7"
- MATERIALS AND CONSTRUCTION:
1. MINIMUM OR 1 1/4" SCHEDULE 40 STEEL PIPE (1 5/8" OUTSIDE DIAMETER)
 2. MAXIMUM 1 1/2" SCHEDULE 40 STEEL PIPE (2" OUTSIDE DIAMETER)
 3. SOLID ONE-PIECE CONSTRUCTION;CONTINUOUS BEND, LEGS 14"-18" APART
 4. GALVANIZED WITH BLACK POWDER COAT FINISH
 5. FLUSH MOUNTED WITH WELDED BASE PLATES (6" DIAMETER, 3/16" THICK BASE PLATE). HIDDEN OR VANDAL-RESISTANT FASTENERS (SCREWS OR EXPANSION BOLTS)


- 3'-4" MINIMUM WHEN INSTALLED PERPENDICULAR TO A WALL OR CURB.
- 3' MINIMUM WHEN INSTALLED PARALLEL TO A WALL OR CURB. 5' MINIMUM SEPARATION FROM CURB FACE WHEN INSTALLED ADJACENT TO A CURB WITH "HEAD-IN" AUTOMOBILE PARKING.
- 10' MINIMUM IF MORE THAN TWO "U" RACKS IN A SERIES.

- NOTES:
1. EXPOSED CONCRETE SURFACE TO BE BROOM FINISHED. PAD SIZE MAY VARY AS DIRECTED BY THE ENGINEER.
 2. PAD IS TO BE CONSTRUCTED WITH CLASS B CONCRETE.
 3. EXCAVATION AND/OR EMBANKMENT REQUIRED FOR PAD CONSTRUCTION WILL NOT BE PAID FOR SEPERATELY, BUT SHALL BE INCLUDED IN THE COST OF THE PAD. CONCRETE SHALL BE SLOPED AT 2% TO DRAIN.

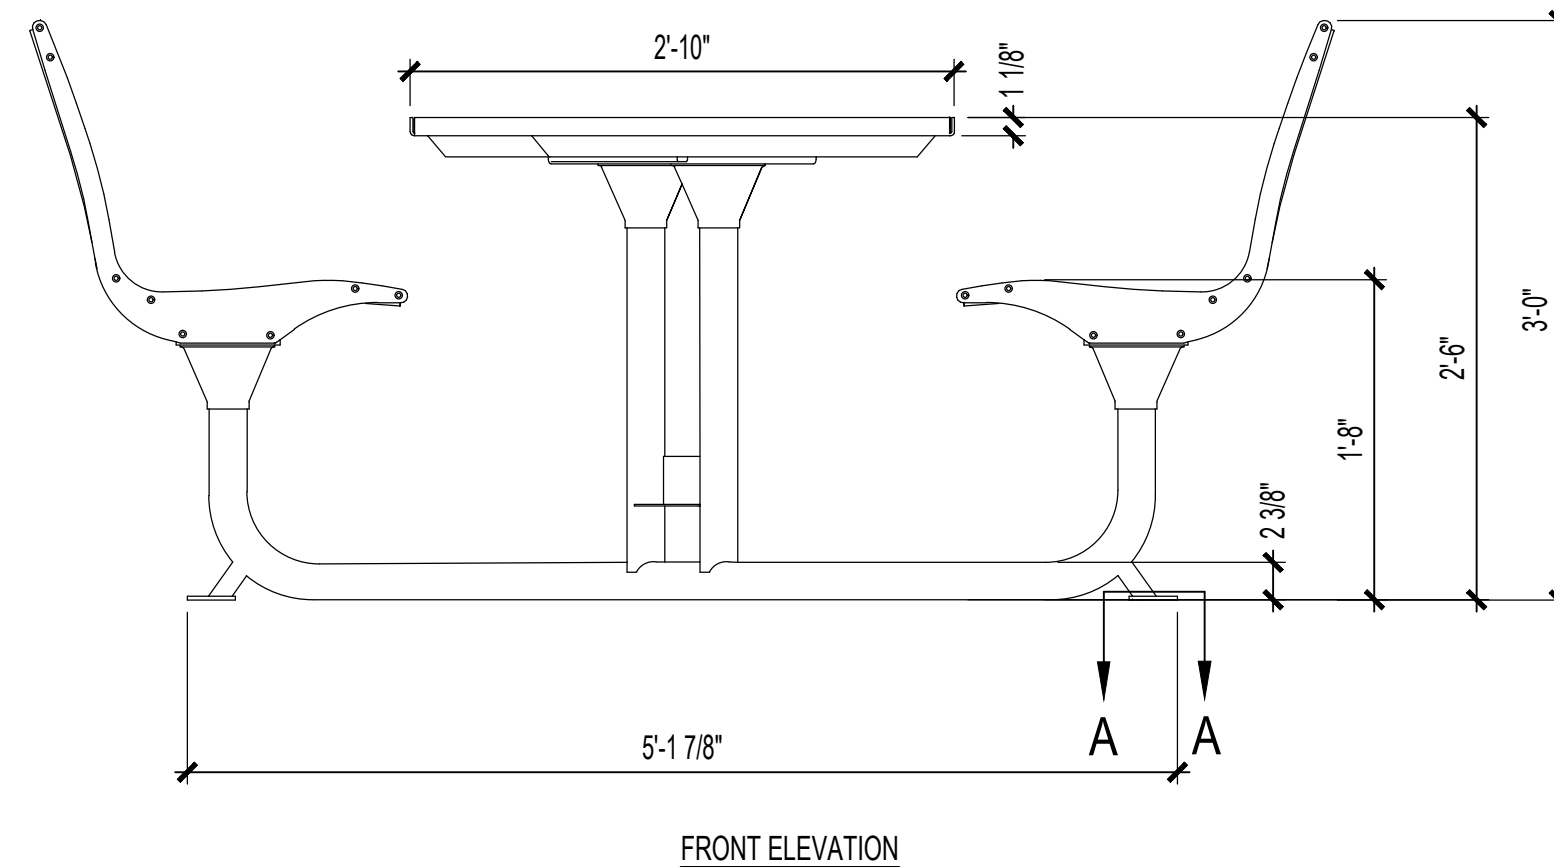

SEE SPECIFICATIONS SECTION 323300 FOR MORE INFORMATION

CONTACT:
ANOVA
support@anovafurnishings.com
800-325-3047

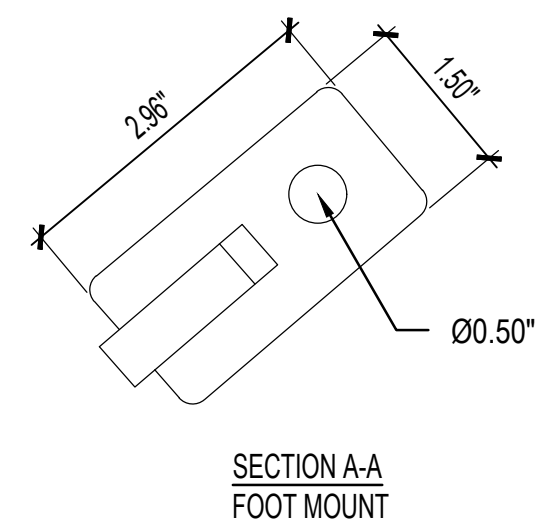

- NOTES:
1. INSTALLATION TO BE COMPLETED IN ACCORDANCE WITH MANUFACTURER'S SPECIFICATIONS.

E BIKE RACK

SCALE: NTS

F GAME TABLE

SCALE: NTS



NO.	DATE	REMARKS
1	05/15/2024	SITE PLAN
2	05/11/2024	SITE PLAN

PA / PM:	CH
DRAWN BY:	CH
JOB NO.:	Author

SHEET

12

NOT FOR CONSTRUCTION

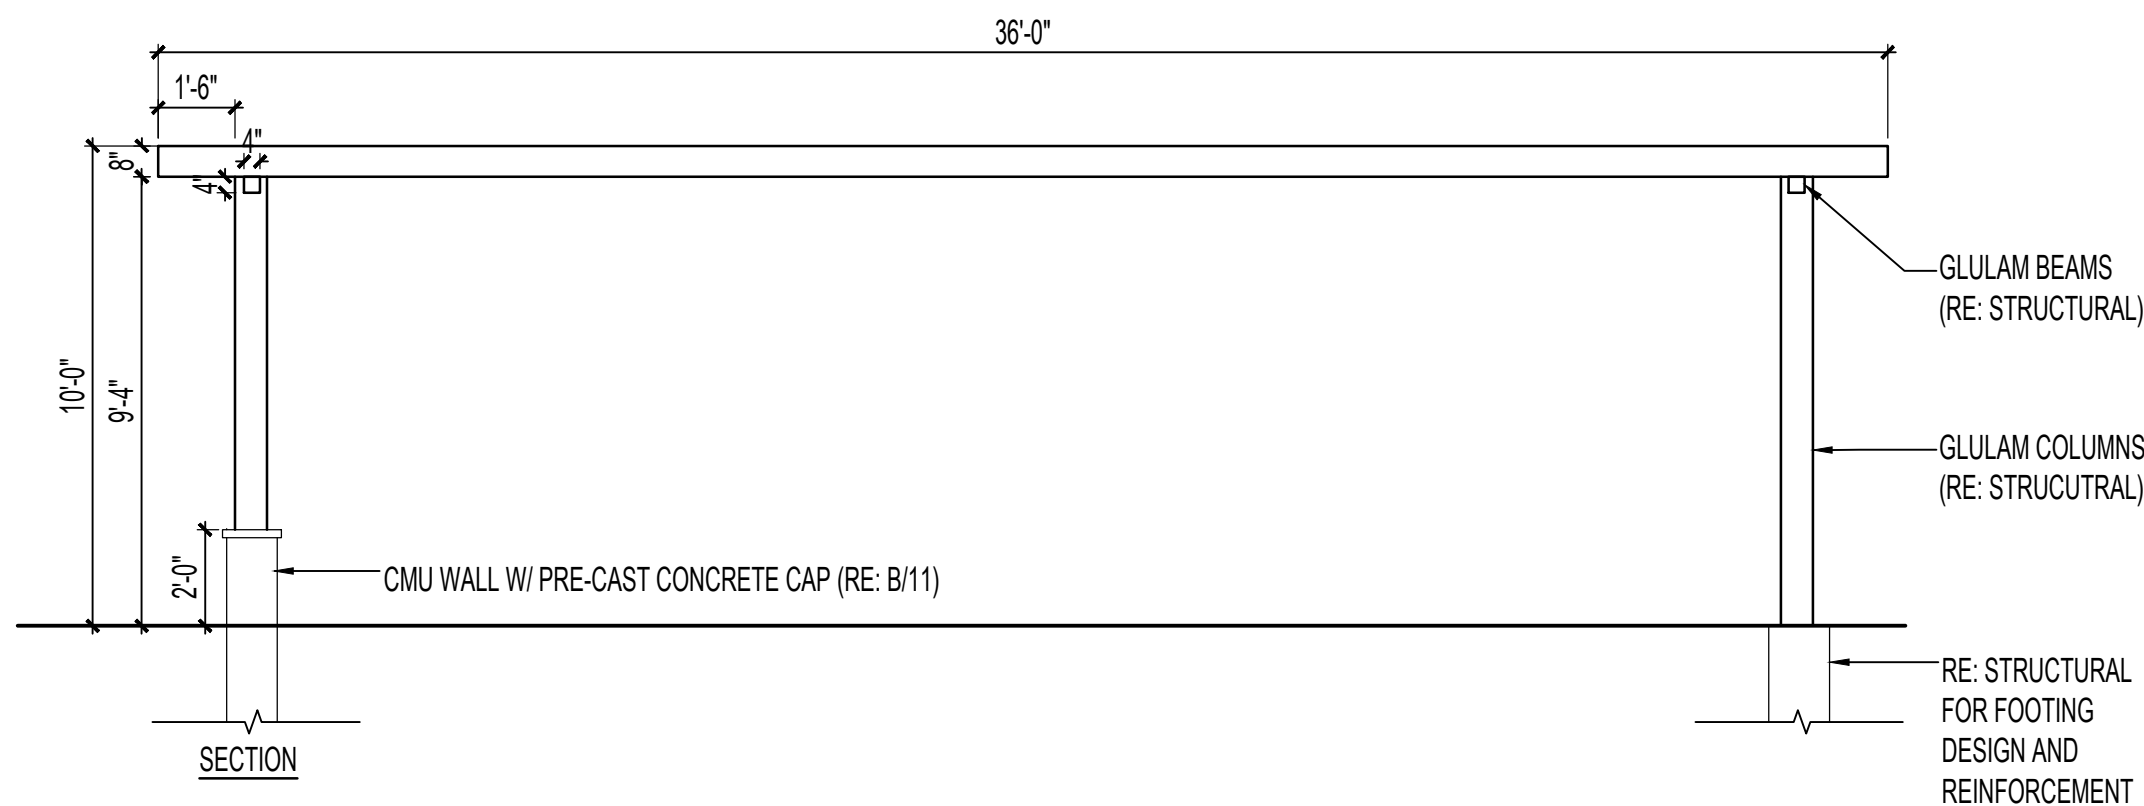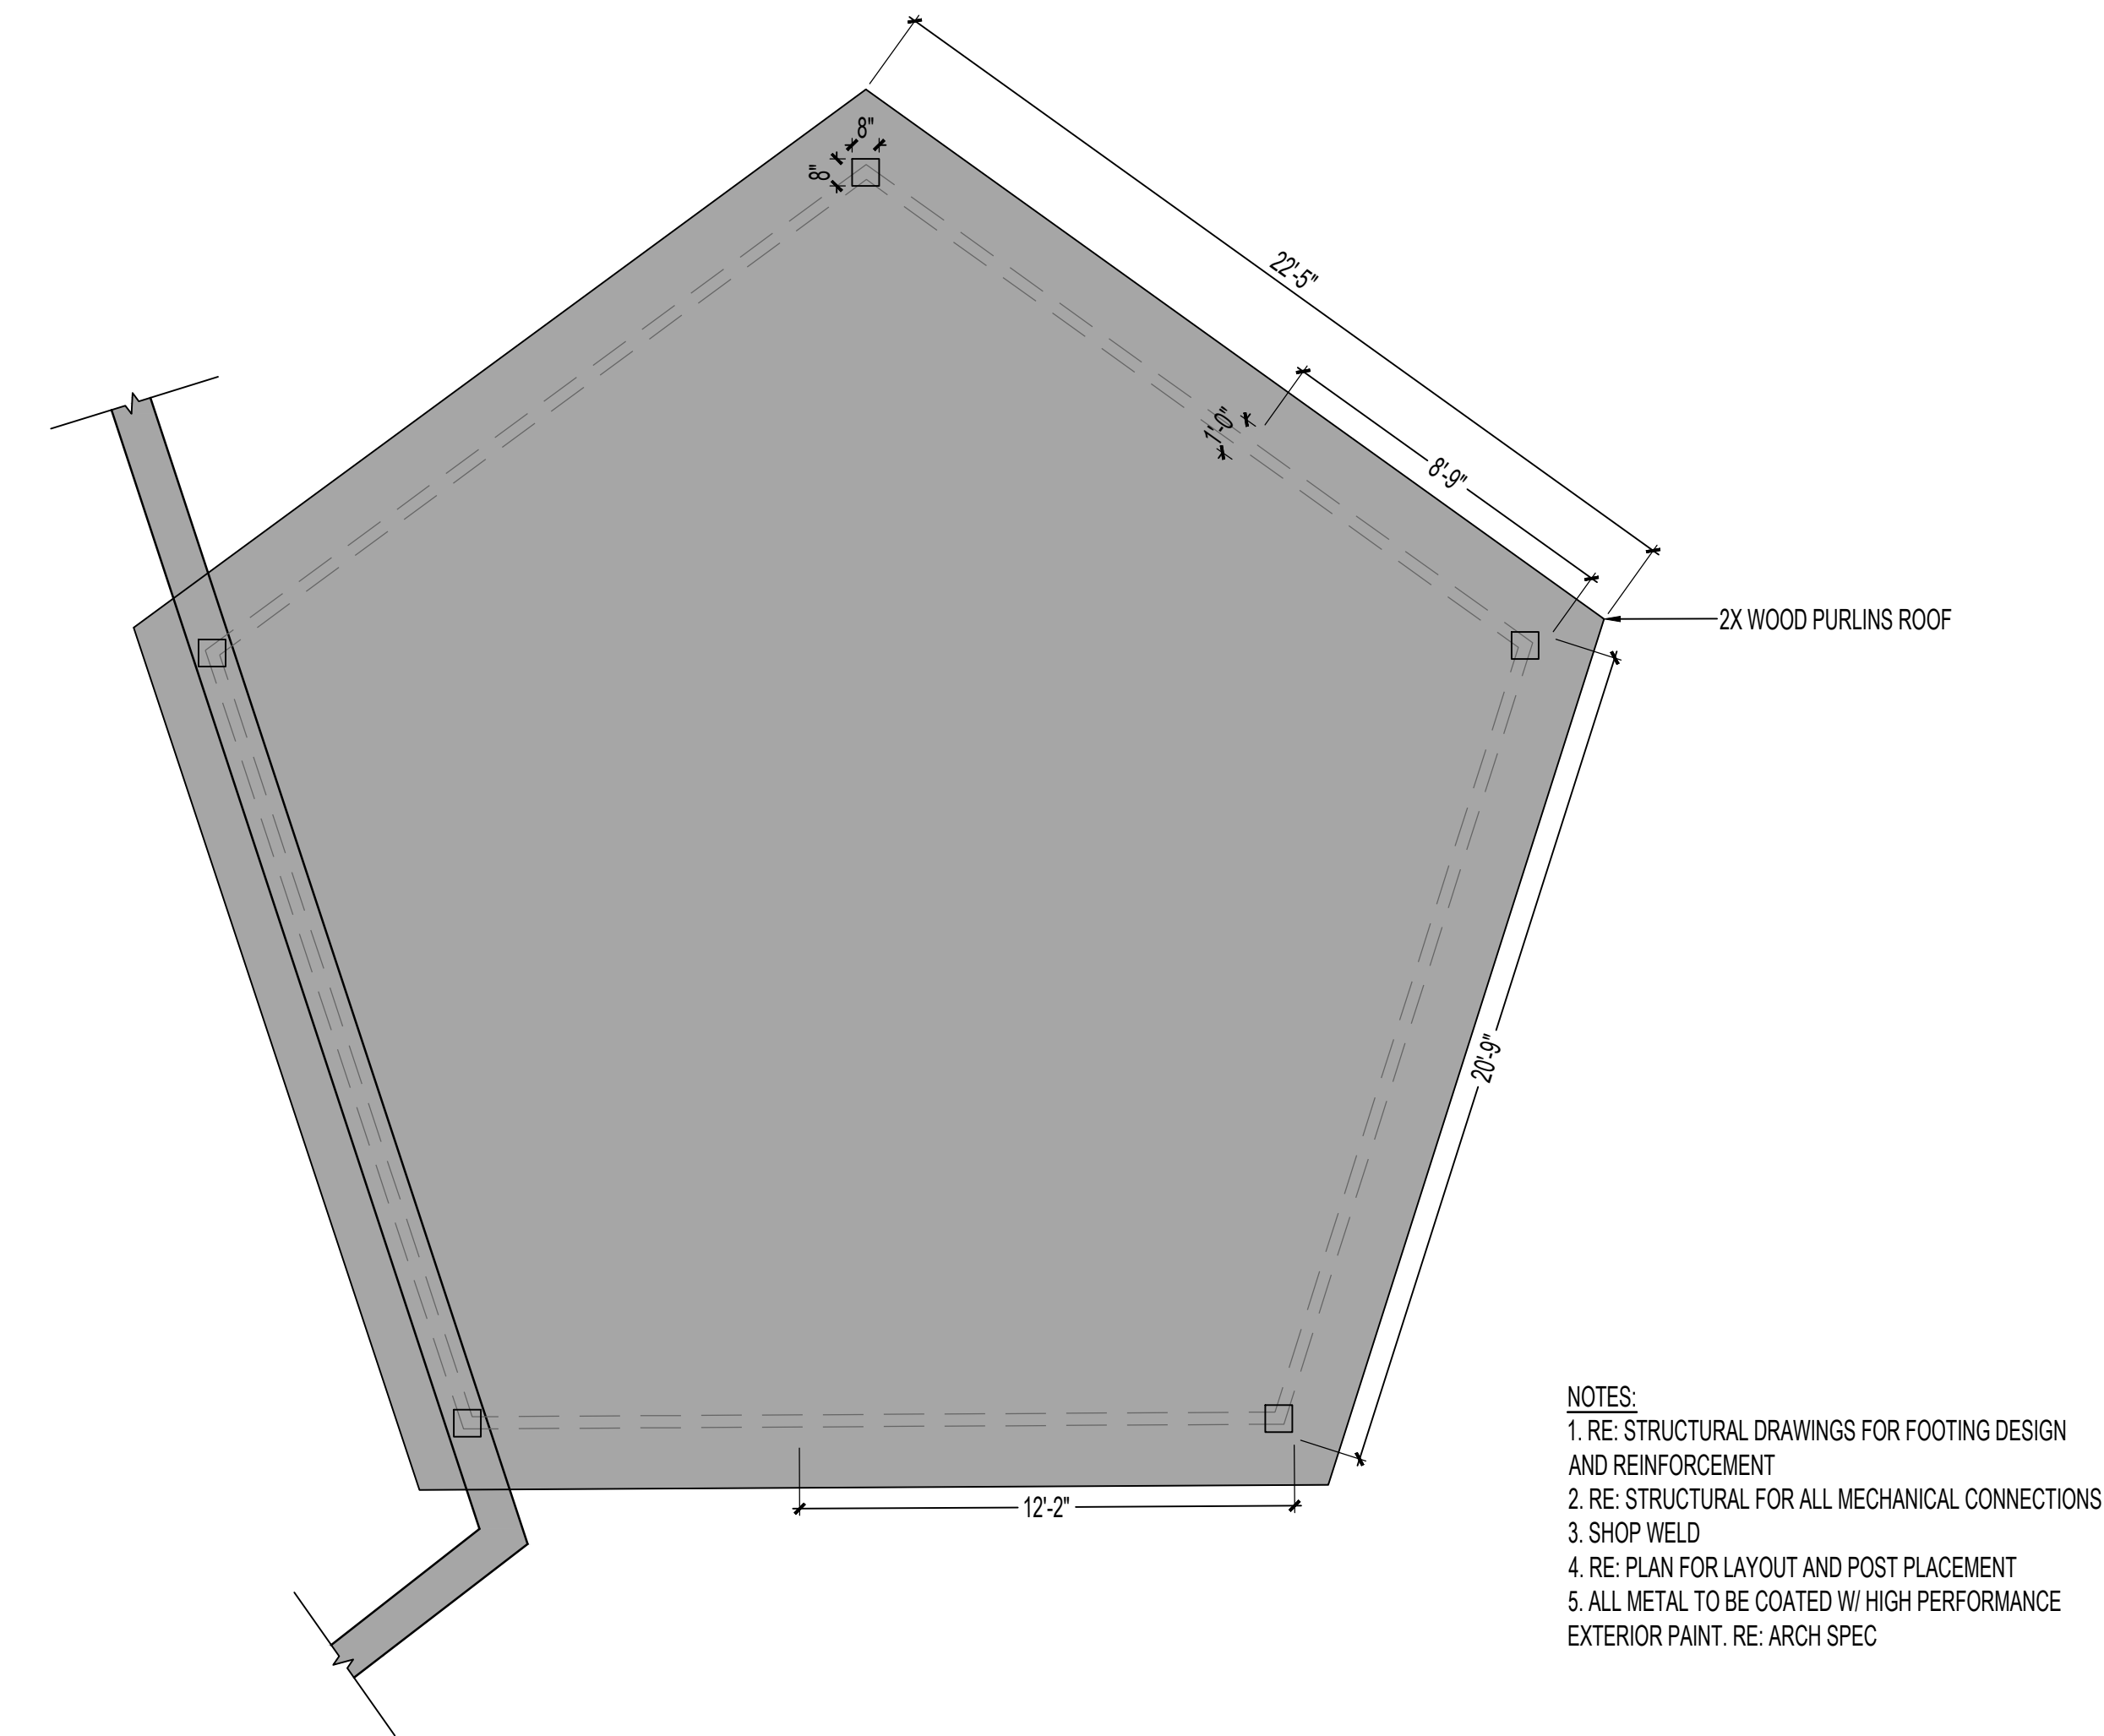

A SOLID SHADE PERGOLA
SCALE: 1/4"=1'-0"




AMERICAN OUTDOOR GRILL T-SERIES (24NGT-00SP)
BBQ GUYS - 877-286-7249
customerservice@bbguys.com
8151 Airline Hwy
Baton Rouge, LA 70815

C BBQ
SCALE: NTS



NATURAL MILLSTONE FOUNTAIN #GF19-36
CONTACT:
STONE FOREST
info@stoneforest.com
(505) 986-8883

D WATER FEATURE
SCALE: NTS

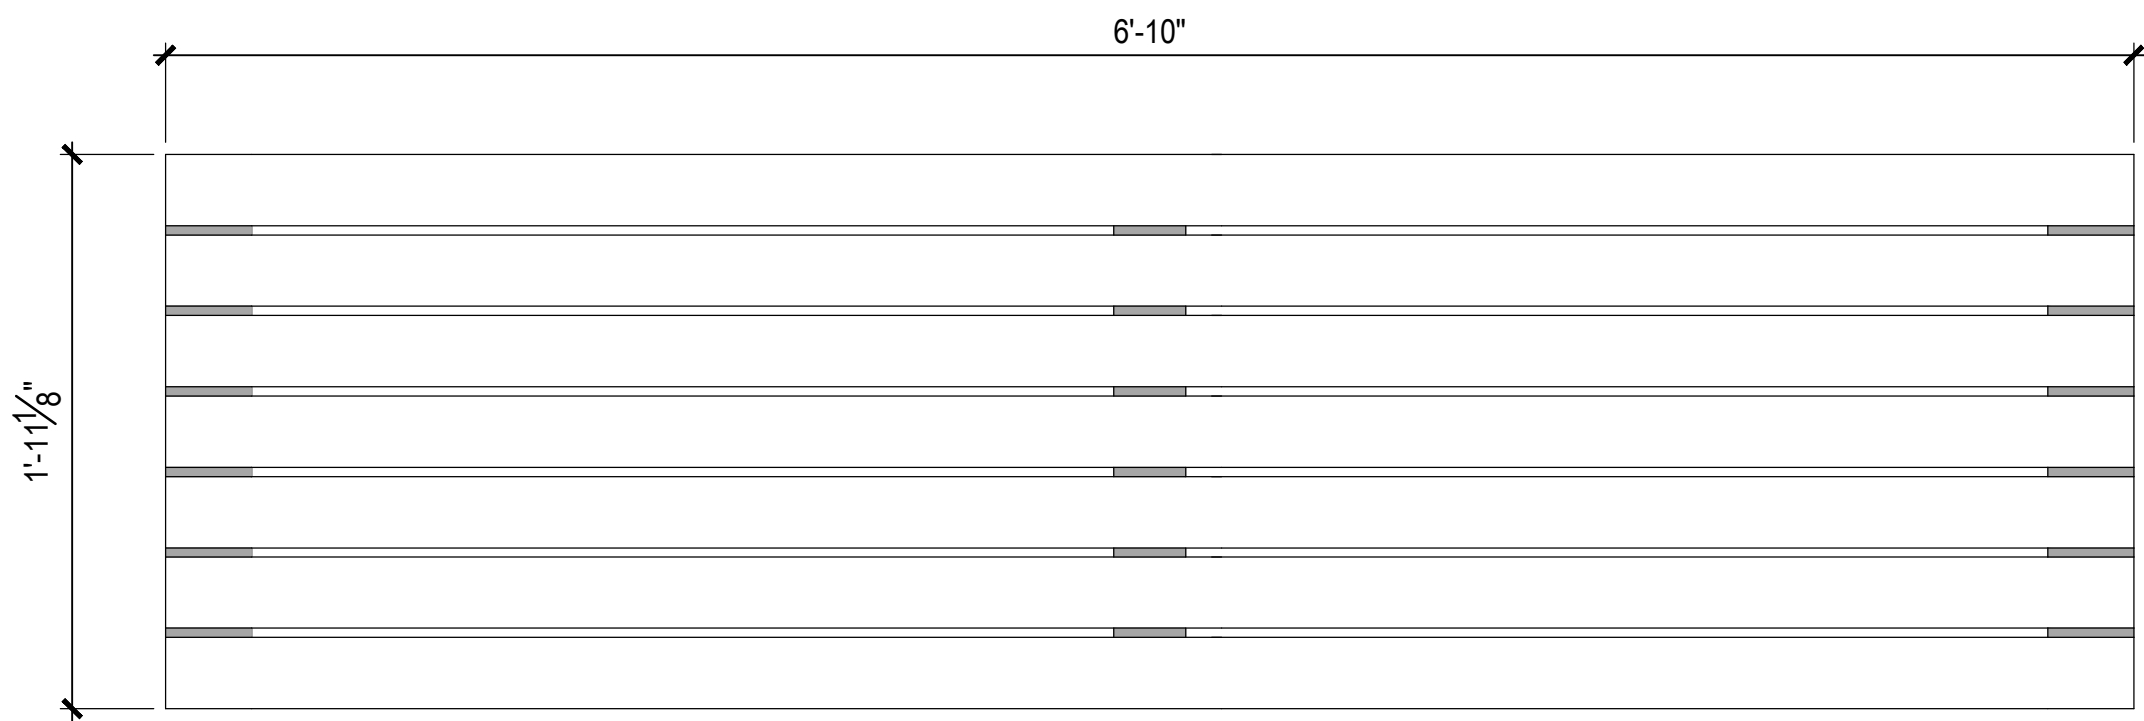


CONTACT:
SITE PIECES
MIKE HONERLAW
SITEPIECES.COM
720.665.5251

- NOTES:
- FRAME: ALL ALUMINUM CONSTRUCTION
 - 3/8" ALUMINUM GLIDES W/ 1/2" PRE-DRILLED COUNTERSUNK HOLE FOR SURFACE MOUNTING
 - THERMORY (N. WHITE ASH) OR ALUMINUM SLATS
 - SITE PIECES RECOMMENDS STAINLESS STEEL DROP-IN ANCHORS W/ FLAT HEAD
 - SHIPS FULLY ASSEMBLED



BENCH DETAIL FOR DESIGN INTENT ONLY. MANUFACTURER TO BE FINALIZED AT TIME OF CONSTRUCTION DOCUMENTS

B BAR HEIGHT TABLES
SCALE: 1 1/2"=1'-0"

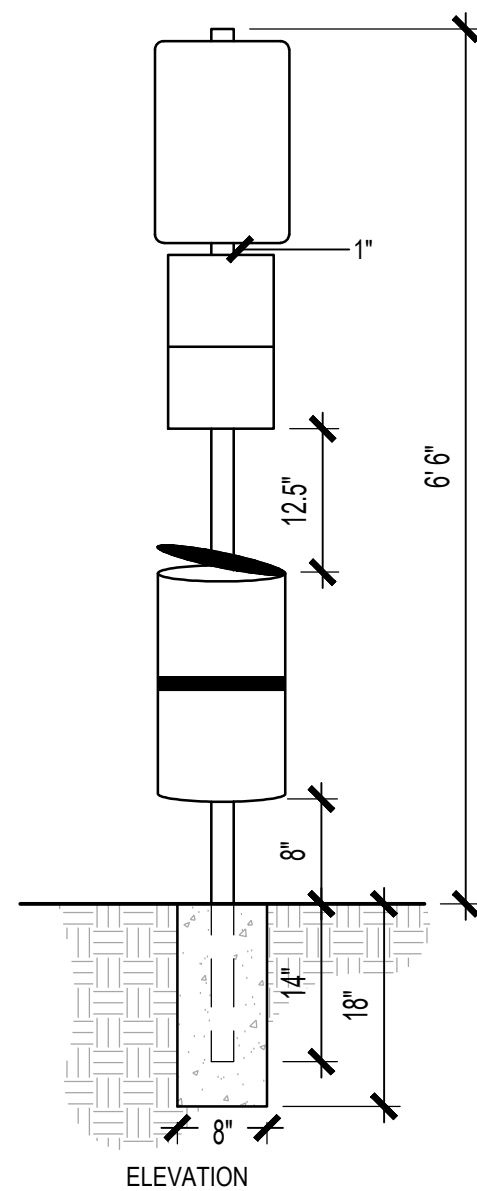

NOTE: OWNER TO PROVIDE FF&E
MANUFACTURER: CARROT-TOP INDUSTRIES OR APPROVED EQUAL
MODEL: DOGIPOT OR APPROVED EQUAL
COLOR/FINISH: GREEN/STEEL
INSTALL PER MANUFACTURERS RECOMMENDATIONS

- NOTES:
1. LOWER WASTE BIN SHALL PROJECT 10" MAX FROM THE POST.
 2. SECURE OPERABLE PARTS NO HIGHER THAN 46" ABOVE FINISH GRADE.

E PET WASTE STATION
SCALE: NTS



CONTACT:
ANOVA
support@anovafurnishings.com
800-325-3047

- NOTES:
1. INSTALLATION TO BE COMPLETED IN ACCORDANCE WITH MANUFACTURER'S SPECIFICATIONS.

F ASH RECEPTACLE
SCALE: NTS



NO.	DATE	REMARKS	
		SITE PLAN	SITE PLAN
1	05.15.2024		
2	05.11.2024		

PA / PM:	CH
DRAWN BY:	CH
JOB NO.:	Author

SHEET


13

NOT FOR CONSTRUCTION

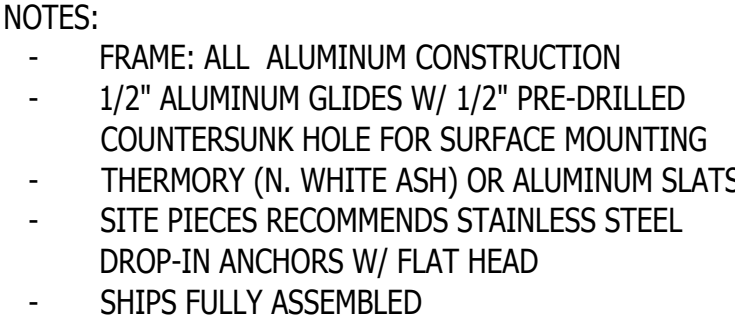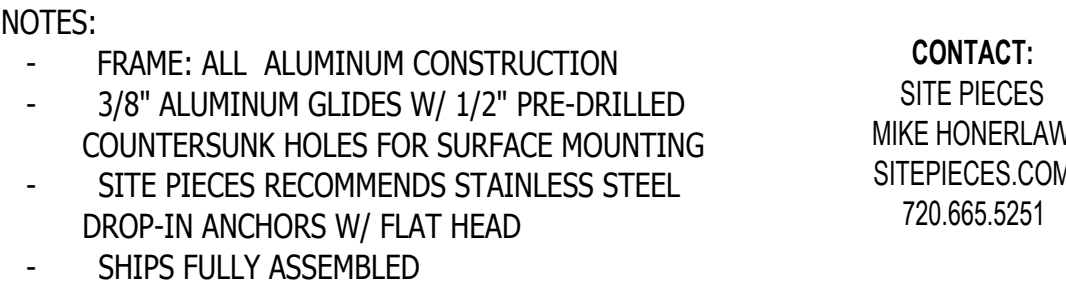


SEE SPECIFICATIONS SECTION 323300
FOR MORE INFORMATION

SCALE: 1 1/2" = 1'-0"

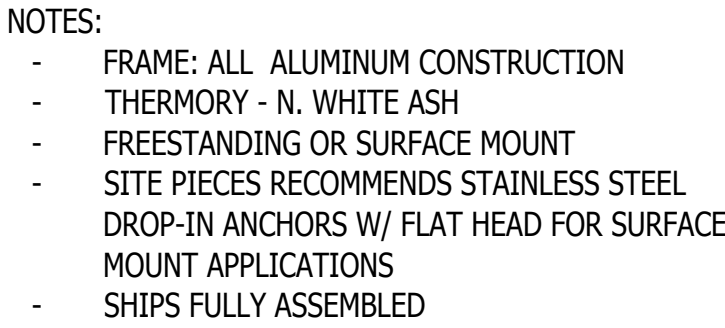


SITE PIECES ALPINE 46er CHAIR (AC-46ER-CHR)
Color: To be Determined
800.484.0797
hello@sitepieces.com
3000 Lawrence Street #57
Denver, CO 80205

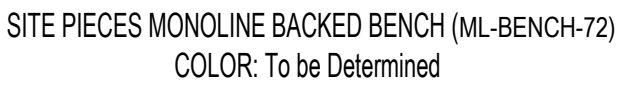

CONTACT:
SITE PIECES
KE HONERLAW
TEPIECES.COM
720.665.5251

NOTES:

- FRAME: ALL ALUMINUM CONSTRUCTION
- 3/8" ALUMINUM GLIDES W/ 1/2" PRE-DRILLED COUNTERSUNK HOLE FOR SURFACE MOUNTING
- THERMORY (N. WHITE ASH) OR ALUMINUM SLATS
- SITE PIECES RECOMMENDS STAINLESS STEEL DROP-IN ANCHORS W/ FLAT HEAD
- SHIPS FULLY ASSEMBLED

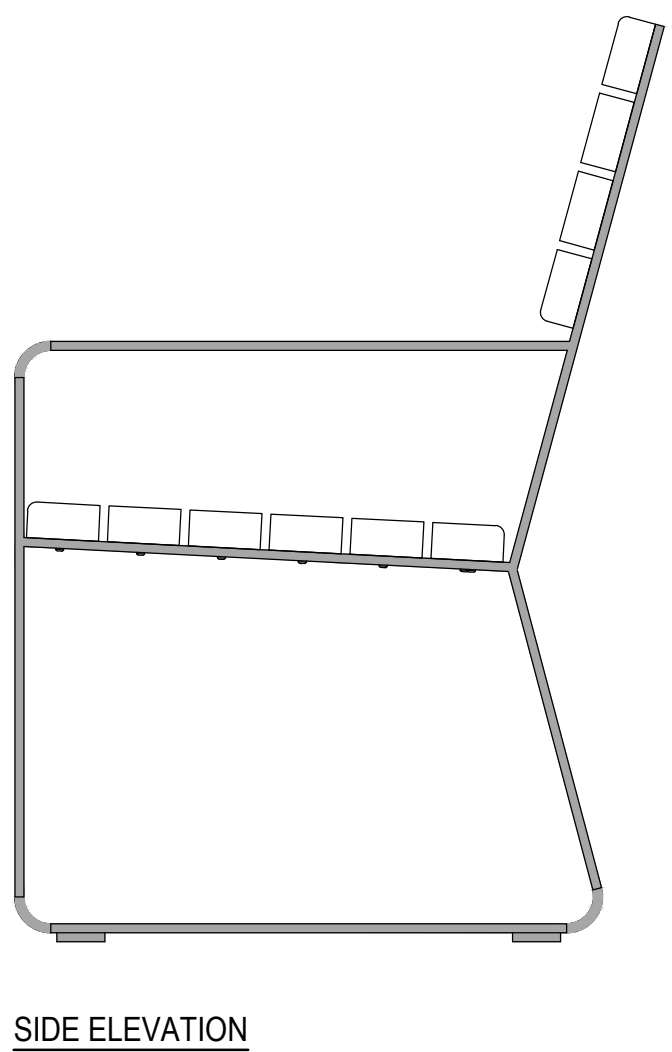

SCALE: 1 1/2" = 1'-0"


SCALE: 1 1/2" = 1'-0"

BENCH DETAIL FOR DESIGN INTENT ONLY. MANUFACTURER
TO BE FINALIZED AT TIME OF CONSTRUCTION DOCUMENTS

1900 S CHAMBERS COMMUNITY
SITE PLAN AMENDMENT WITH ADJUSTMENT
AURORA, COLORADO
LANDSCAPE SITE DETAILS

NO.	DATE	REMARKS
1	05-15-2024	SITE PLAN
2	09-11-2024	SITE PLAN


A / PM:	CH
DRAWN BY:	CH
DOB NO.:	Author

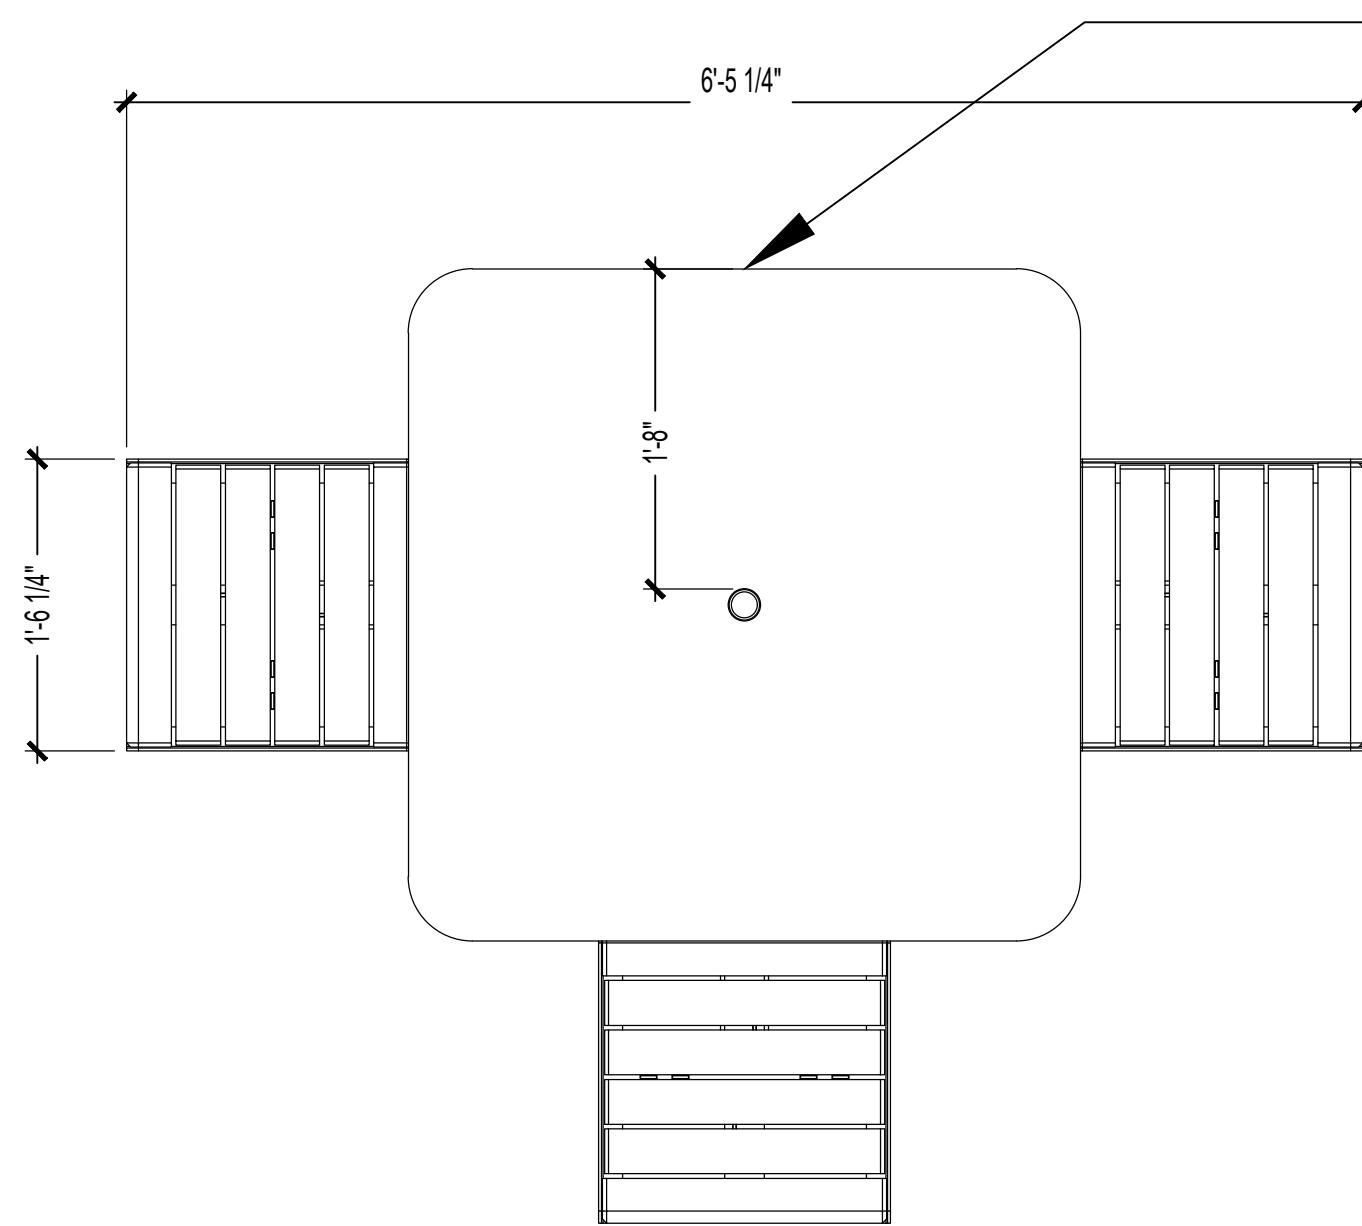

PLAN

CONTACT:
SITE PIECES
MIKE HONERLAW
SITEPIECES.COM
720.666.5251

- NOTES:
- FRAME: ALL ALUMINUM CONSTRUCTION
 - 1/2" PRE-DRILLED COUNTERSUNK HOLES PROVIDED FOR SURFACE MOUNTING
 - THERMORY (N. WHITE ASH) OR ALUMINUM SLATS
 - SITE PIECES RECOMMENDS STAINLESS STEEL DROP-IN ANCHORS W/ FLAT HEAD
 - SHIPS FULLY ASSEMBLED

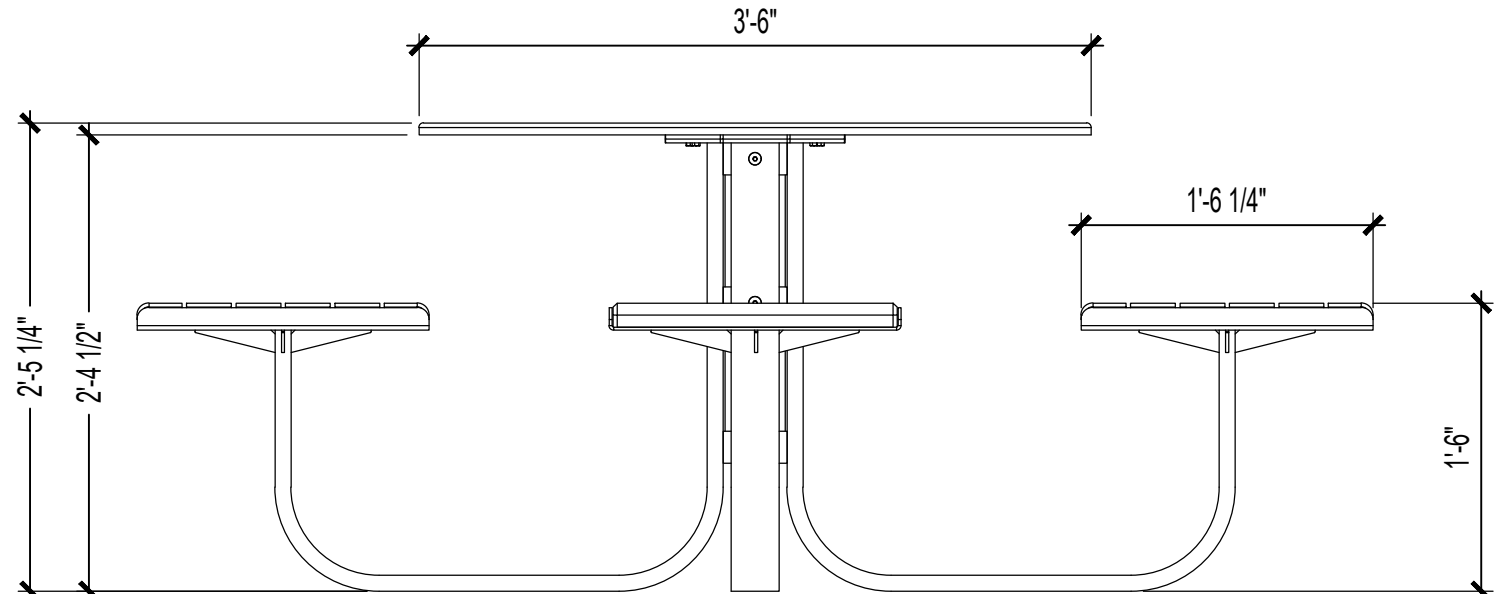

SIDE ELEVATION

SEE SPECIFICATIONS SECTION 323300 FOR MORE INFORMATION

B SQUARE GAME TABLE

SCALE: NTS



1900 S CHAMBERS COMMUNITY
SITE PLAN AMENDMENT WITH ADJUSTMENT
AURORA, COLORADO
LANDSCAPE SITE DETAILS

NO.	DATE	REMARKS
1	05.15.2024	SITE PLAN
2	05.11.2024	SITE PLAN

PA / PM:	CH
DRAWN BY:	CH
JOB NO.:	Author


A

TREE MITIGATION PLAN

SCALE: 1" = 30'



NOT FOR CONSTRUCTION

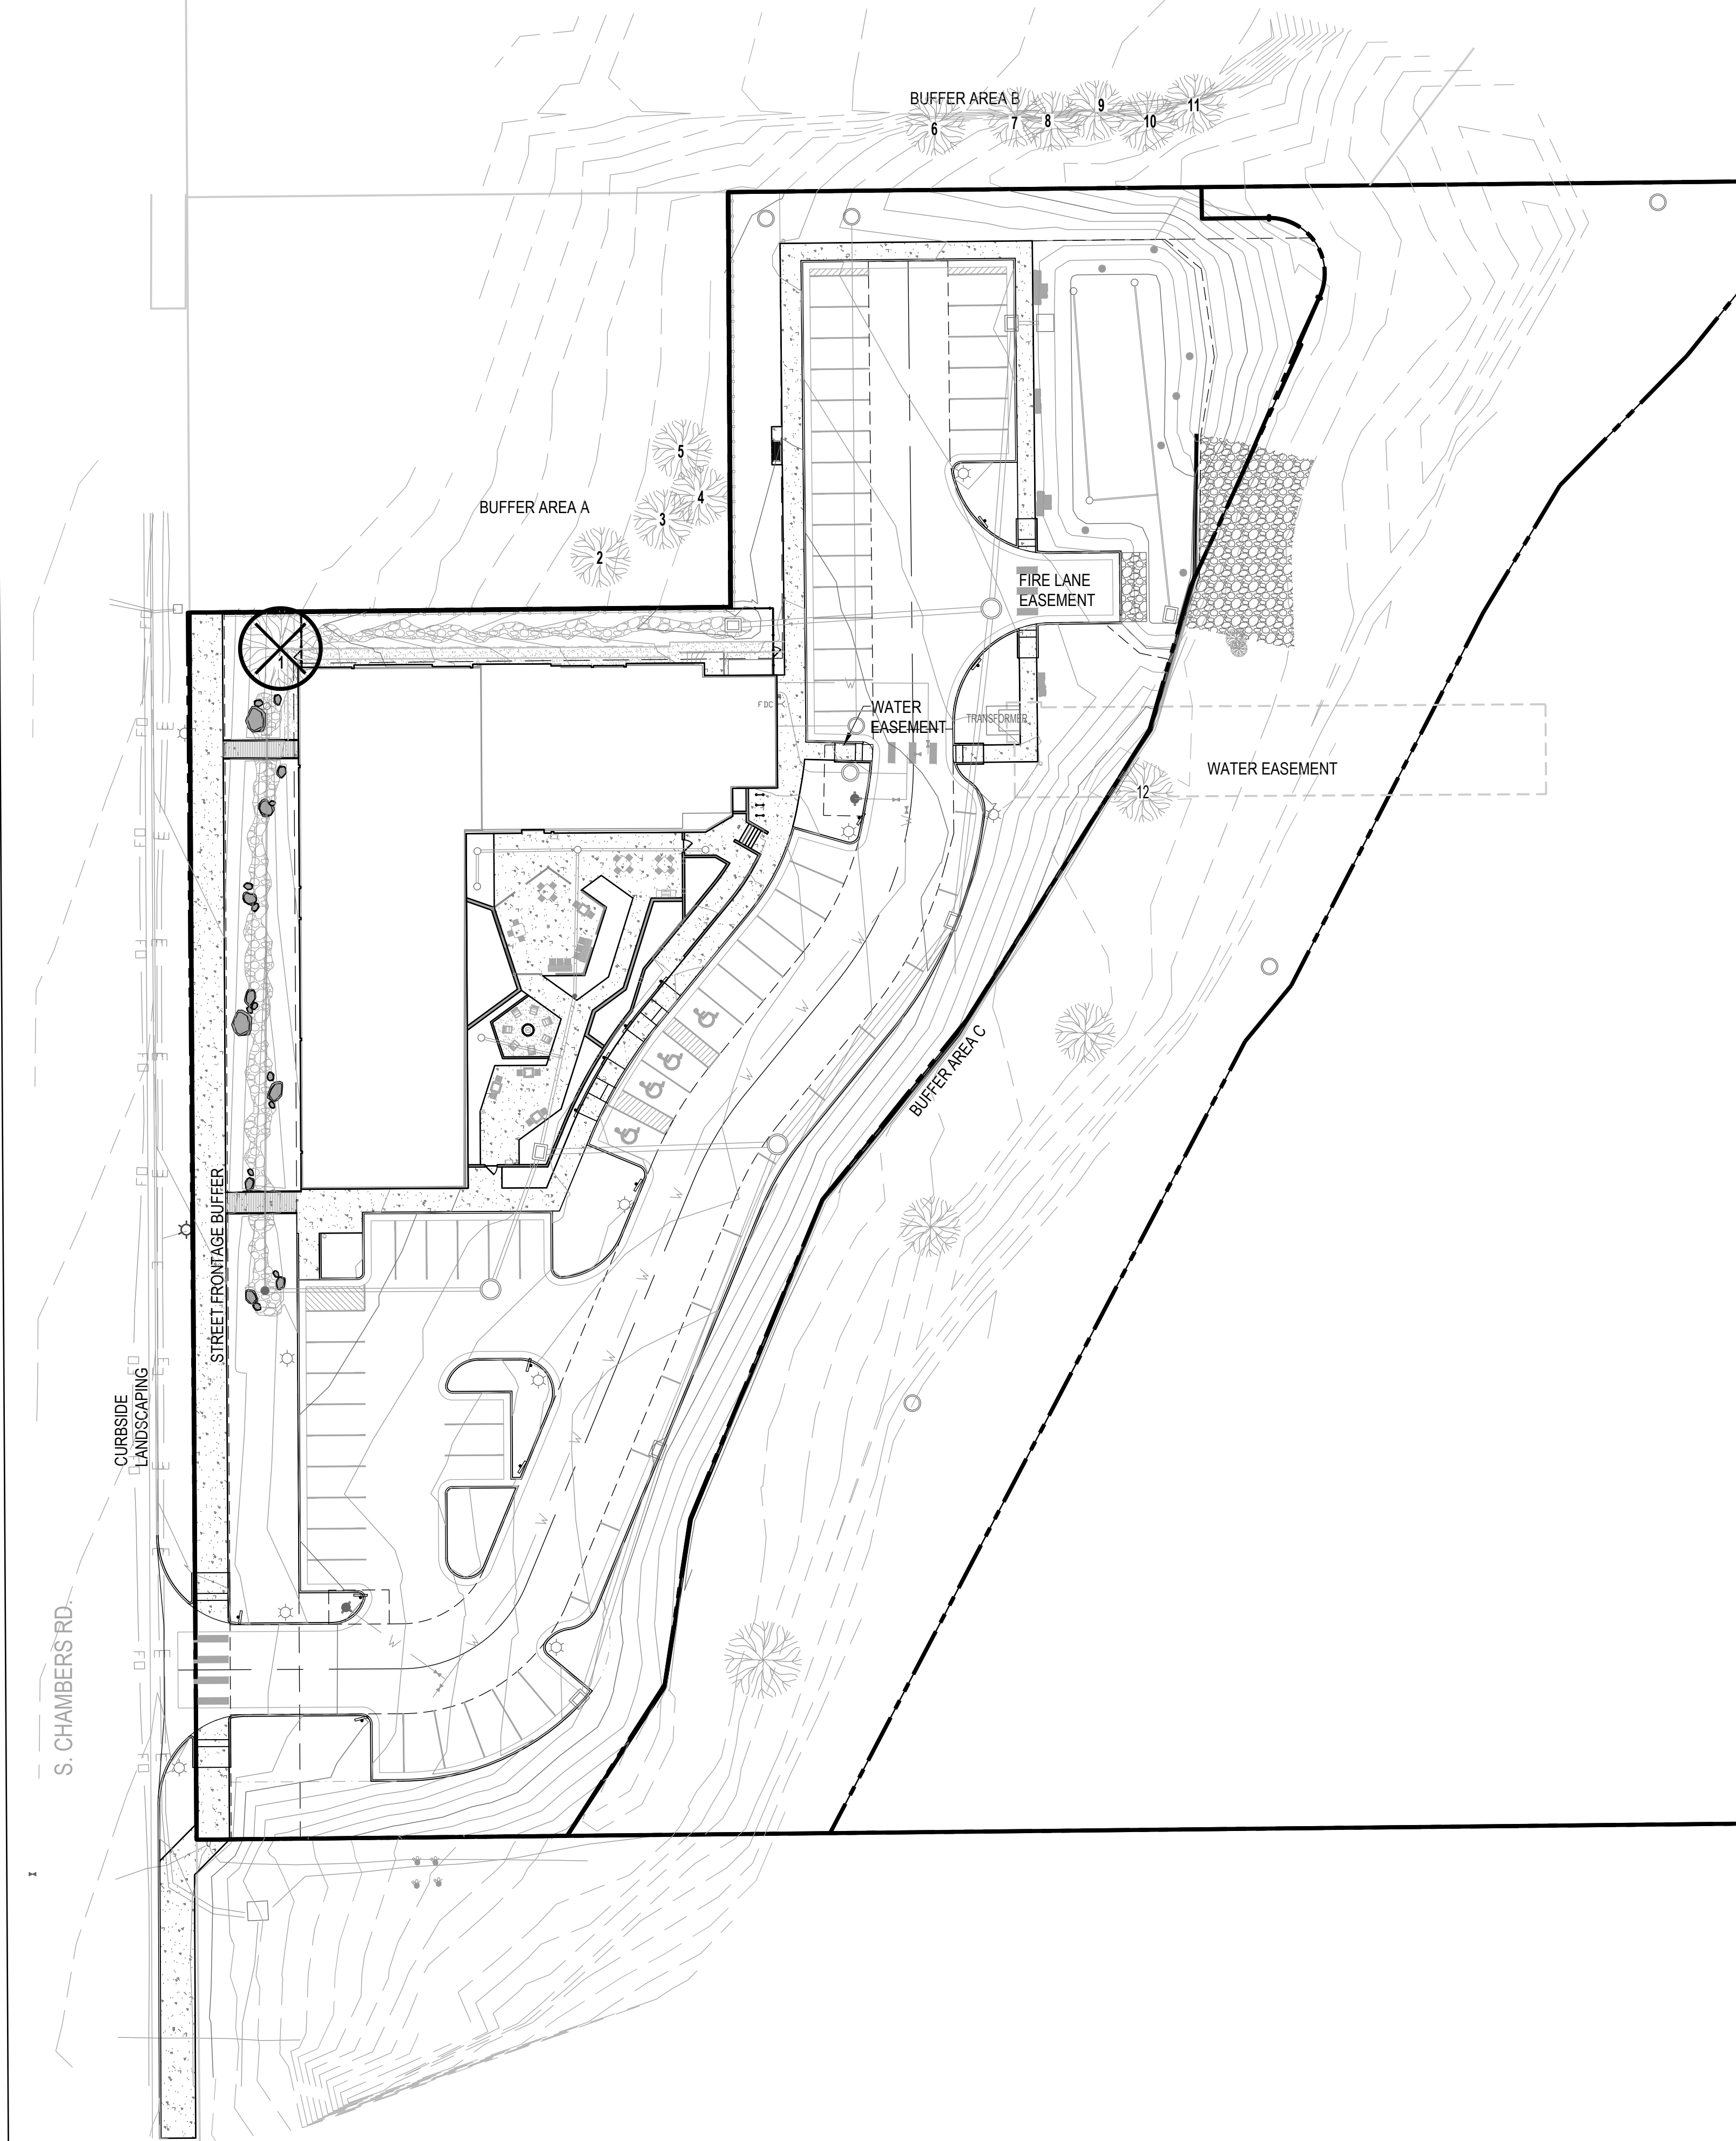


TREE MITIGATION TABLE

Caliper Inches Removed Requiring Mitigation	Caliper Inches To Remain	Caliper Inches Replaced for Mitigation	Total Cost Required in Lieu of Caliper Replacement for Mitigation	Total Mitigation Cost Required (Total Inches Mitigated x \$525)
12"	0"	0"	\$6,300	\$6,300

NOTE: TREE #1 IS THE ONLY TREE REMOVED WITHIN THE PROPERTY BOUNDARY.

LEGEND

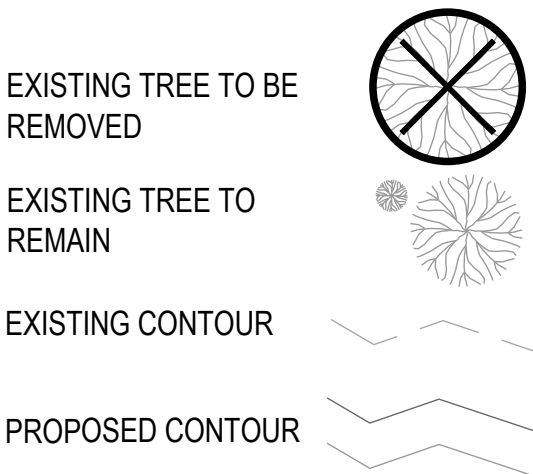

8585 E Warren Avenue, Denver, CO 80231
Phone: (720) 641-0506 – fax: (303) 337-0157
Email: sgelst@savatree.com

savatree.com/consulting

APPENDIX C APPRAISAL SUMMARY FOR ALL TREES

Table 1

Tree #	Common name	Location	Trunk Diameter inches	Condition Percent	Functional Limitation Percent	External Limitation Percent	Appraisal \$100	Mitigation Inches
1	Siberian elm	On property line	21.1	56	40	100	\$ 6,300	11.8
2	Siberian elm	1812 S Chambers	33.0	58	50	100	\$ 18,900	0.0
3	Siberian elm	1812 S Chambers	12.0	56	50	100	\$ 2,900	0.0
4	Siberian elm	1812 S Chambers	24.0	40	50	100	\$ 7,200	0.0
5	Siberian elm	1812 S Chambers	16.0	40	50	100	\$ 3,500	0.0
6	Austrian pine	1800 S Chambers	12.0	78	70	100	\$ 4,100	0.0
7	Pinyon pine	1800 S Chambers	6.0	68	70	100	\$ 1,400	0.0
8	Siberian elm	1800 S Chambers	4.5	56	10	100	\$ -	0.0
9	Siberian elm	1800 S Chambers	6.4	48	10	100	\$ -	0.0
10	Siberian elm	1800 S Chambers	7.0	60	10	100	\$ -	0.0
11	Bur oak	1800 S Chambers	12.0	84	70	100	\$ 7,100	0.0
12	Siberian elm	Aurora, Woodrim	19.0	60	40	100	\$ 5,600	0.0
Total							\$57,000	11.8




1900 S CHAMBERS COMMUNITY
SITE PLAN AMENDMENT WITH ADJUSTMENT
AURORA, COLORADO
TREE MITIGATION

NO.	DATE	REMARKS
1	05/15/2024	SITE PLAN
2	05/11/2024	SITE PLAN


PA / PM:	CH
DRAWN BY:	CH
JOB NO.:	Author

SHEET

16

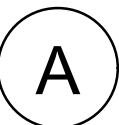
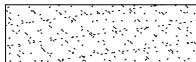



SCALE: 1" = 30'

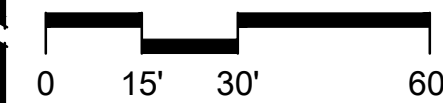

7

NOT FOR CONSTRUCTION

ELEVATIONS MATERIAL LEGEND			
		TOTAL SQUARE FOOTAGE	% OF TOTAL
	BRICK MASONRY	3,852 SF	17%
	STUCCO	17,144 SF	76%
	PAINTED CEMENT BOARD FASCIA/TRIM	1,491 SF	7%
		22,487 SF	100%

MATERIALS BY ELEVATION:
STUCCO: 4,187 SF [78%]
BRICK: 881 SF [16%]
FASCIA/TRIM: 298 SF [6%]



3 NORTH ELEVATION

1/8" = 1'-0"

MATERIALS BY ELEVATION:
STUCCO: 4,187 SF [78%]
BRICK: 881 SF [16%]
FASCIA/TRIM: 298 SF [6%]






1 WEST ELEVATION

1/8" = 1'-0"

NO.	DATE	REMARKS	
		DATE	DESCRIPTION
1	05.15.2024		SITE PLAN

PA / PM:	JN / AH
DRAWN BY:	TB
JOB NO.:	23010

ELEVATIONS MATERIAL LEGEND			
		TOTAL SQUARE FOOTAGE	% OF TOTAL
	BRICK MASONRY	3,852 SF	17%
	STUCCO	17,144 SF	76%
	PAINTED CEMENT BOARD FASCIA/TRIM	1,491 SF	7%
		22,487 SF	100%



2 SOUTH ELEVATION
1/8" = 1'-0"




1 EAST ELEVATION
1/8" = 1'-0"

NO.	DATE	REMARKS	
		SITE PLAN	
1	05.15.2024		

PA / PM:	JN / AH
DRAWN BY:	TB
JOB NO.:	23010

C:\Users\RobertC\AppData\Local\Temp\AcPublish_24212\PH1 - PHOTOMETRIC.dwg RobertC 09.09.24 4:13 pm

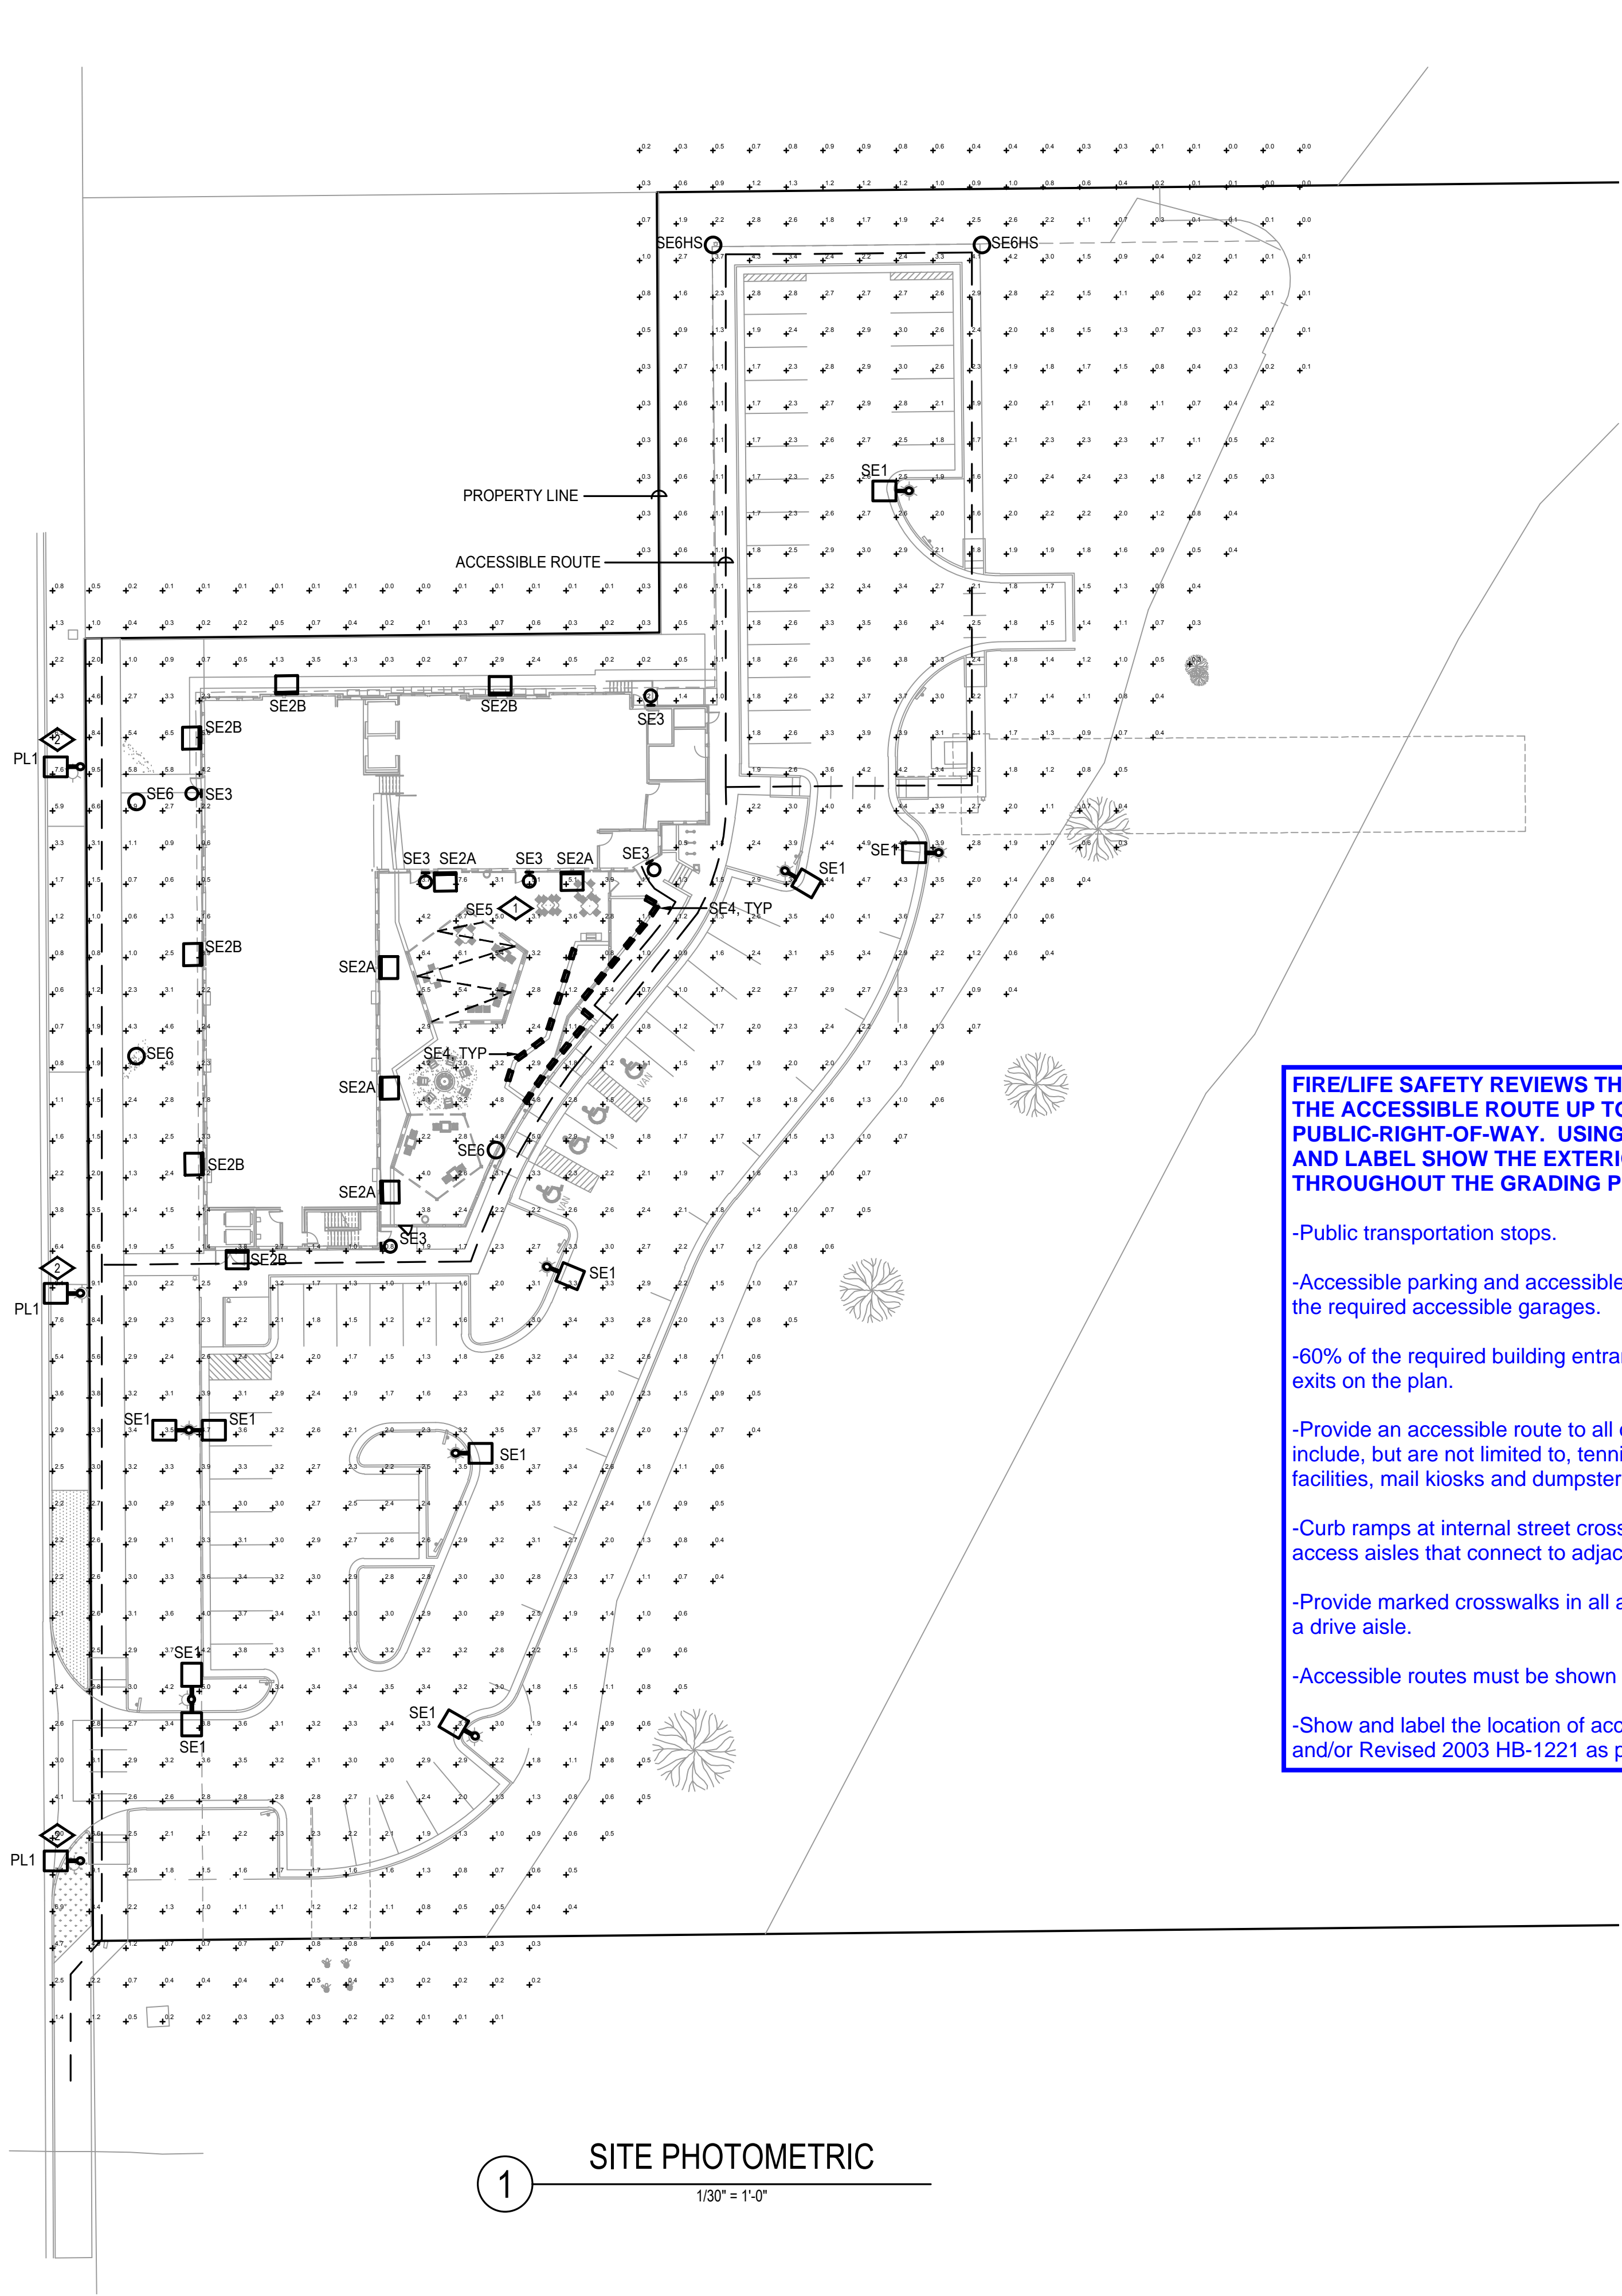

Statistics						
Description	Symbol	Avg	Max	Min	Max/Min	Avg/Min
SITE	+	2.1	9.0 fc	0.0 fc	N/A	N/A

- GENERAL NOTES
1.

ANY PROPOSED LIGHT FIXTURES INSTALLED ON PRIVATE PROPERTY, ADJACENT TO THE PUBLIC ROW, SHALL BE ORIENTED IN SUCH A MANNER OR LIMITED IN LUMEN OUTPUT TO PREVENT GLARE PROBLEMS AND SHALL NOT EXCEED NATIONAL I.E.S. LIGHTING STANDARDS FOR DISABILITY GLARE.
2.

ALL PROVIDED EXTERIOR FIXTURES SHALL BE FULL CUT-OFF TYPE FIXTURES TO COMPLY WITH SEC. 10.7.4.2.A.1.
3.

EXTERIOR LIGHT FIXTURES SHALL BE DIMMED AS REQUIRED TO COMPLY WITH BUILDING DEPARTMENT 8 FOOT CANDLE MAX AND 2 FOOT CANDLE AT THE ZONE LOT LINE REQUIREMENTS.
4.

PROPOSED STREET LIGHT LOCATIONS ARE CONCEPTUAL. FINAL LOCATIONS WILL BE DETERMINED WITH PHOTOMETRIC ANALYSIS SUBMITTED WITH THE STREET LIGHTING PLANS IN THE CIVIL PLAN SUBMITTAL.


- ◇ DETAIL NOTES
- 1

FIXTURES MOUNTED TO UNDERSIDE OF TRELLIS. COORDINATE WITH ARCHITECT.
- 2

CITY OF AURORA POLE MOUNTED STREET LIGHT. REFER TO CITY OF AURORA 2023 ROADWAY DESIGN AND CONSTRUCTION SPECIFICATIONS FOR ADDITIONAL FIXTURE INFORMATION.

FIRE/LIFE SAFETY REVIEWS THE INTERIOR SITE GRADES WITHIN THE ACCESSIBLE ROUTE UP TO THE ADJACENT PUBLIC-RIGHT-OF-WAY. USING A HEAVY DASHED DELINEATION AND LABEL SHOW THE EXTERIOR ACCESSIBLE ROUTE OF TRAVEL THROUGHOUT THE GRADING PLAN TO:

- Public transportation stops.
- Accessible parking and accessible passenger loading zones. This includes the required accessible garages.
- 60% of the required building entrances. Indicate all entrances and required exits on the plan.
- Provide an accessible route to all on-site amenities. These elements can include, but are not limited to, tennis courts, club houses, pools, laundry facilities, mail kiosks and dumpsters.
- Curb ramps at internal street crossings and accessible parking space access aisles that connect to adjacent sidewalks.
- Provide marked crosswalks in all areas where the accessible route crosses a drive aisle.
- Accessible routes must be shown passing through gated entry(s) served.
- Show and label the location of accessible units required by IBC Chapter 11 and/or Revised 2003 HB-1221 as part of the exterior accessible route.

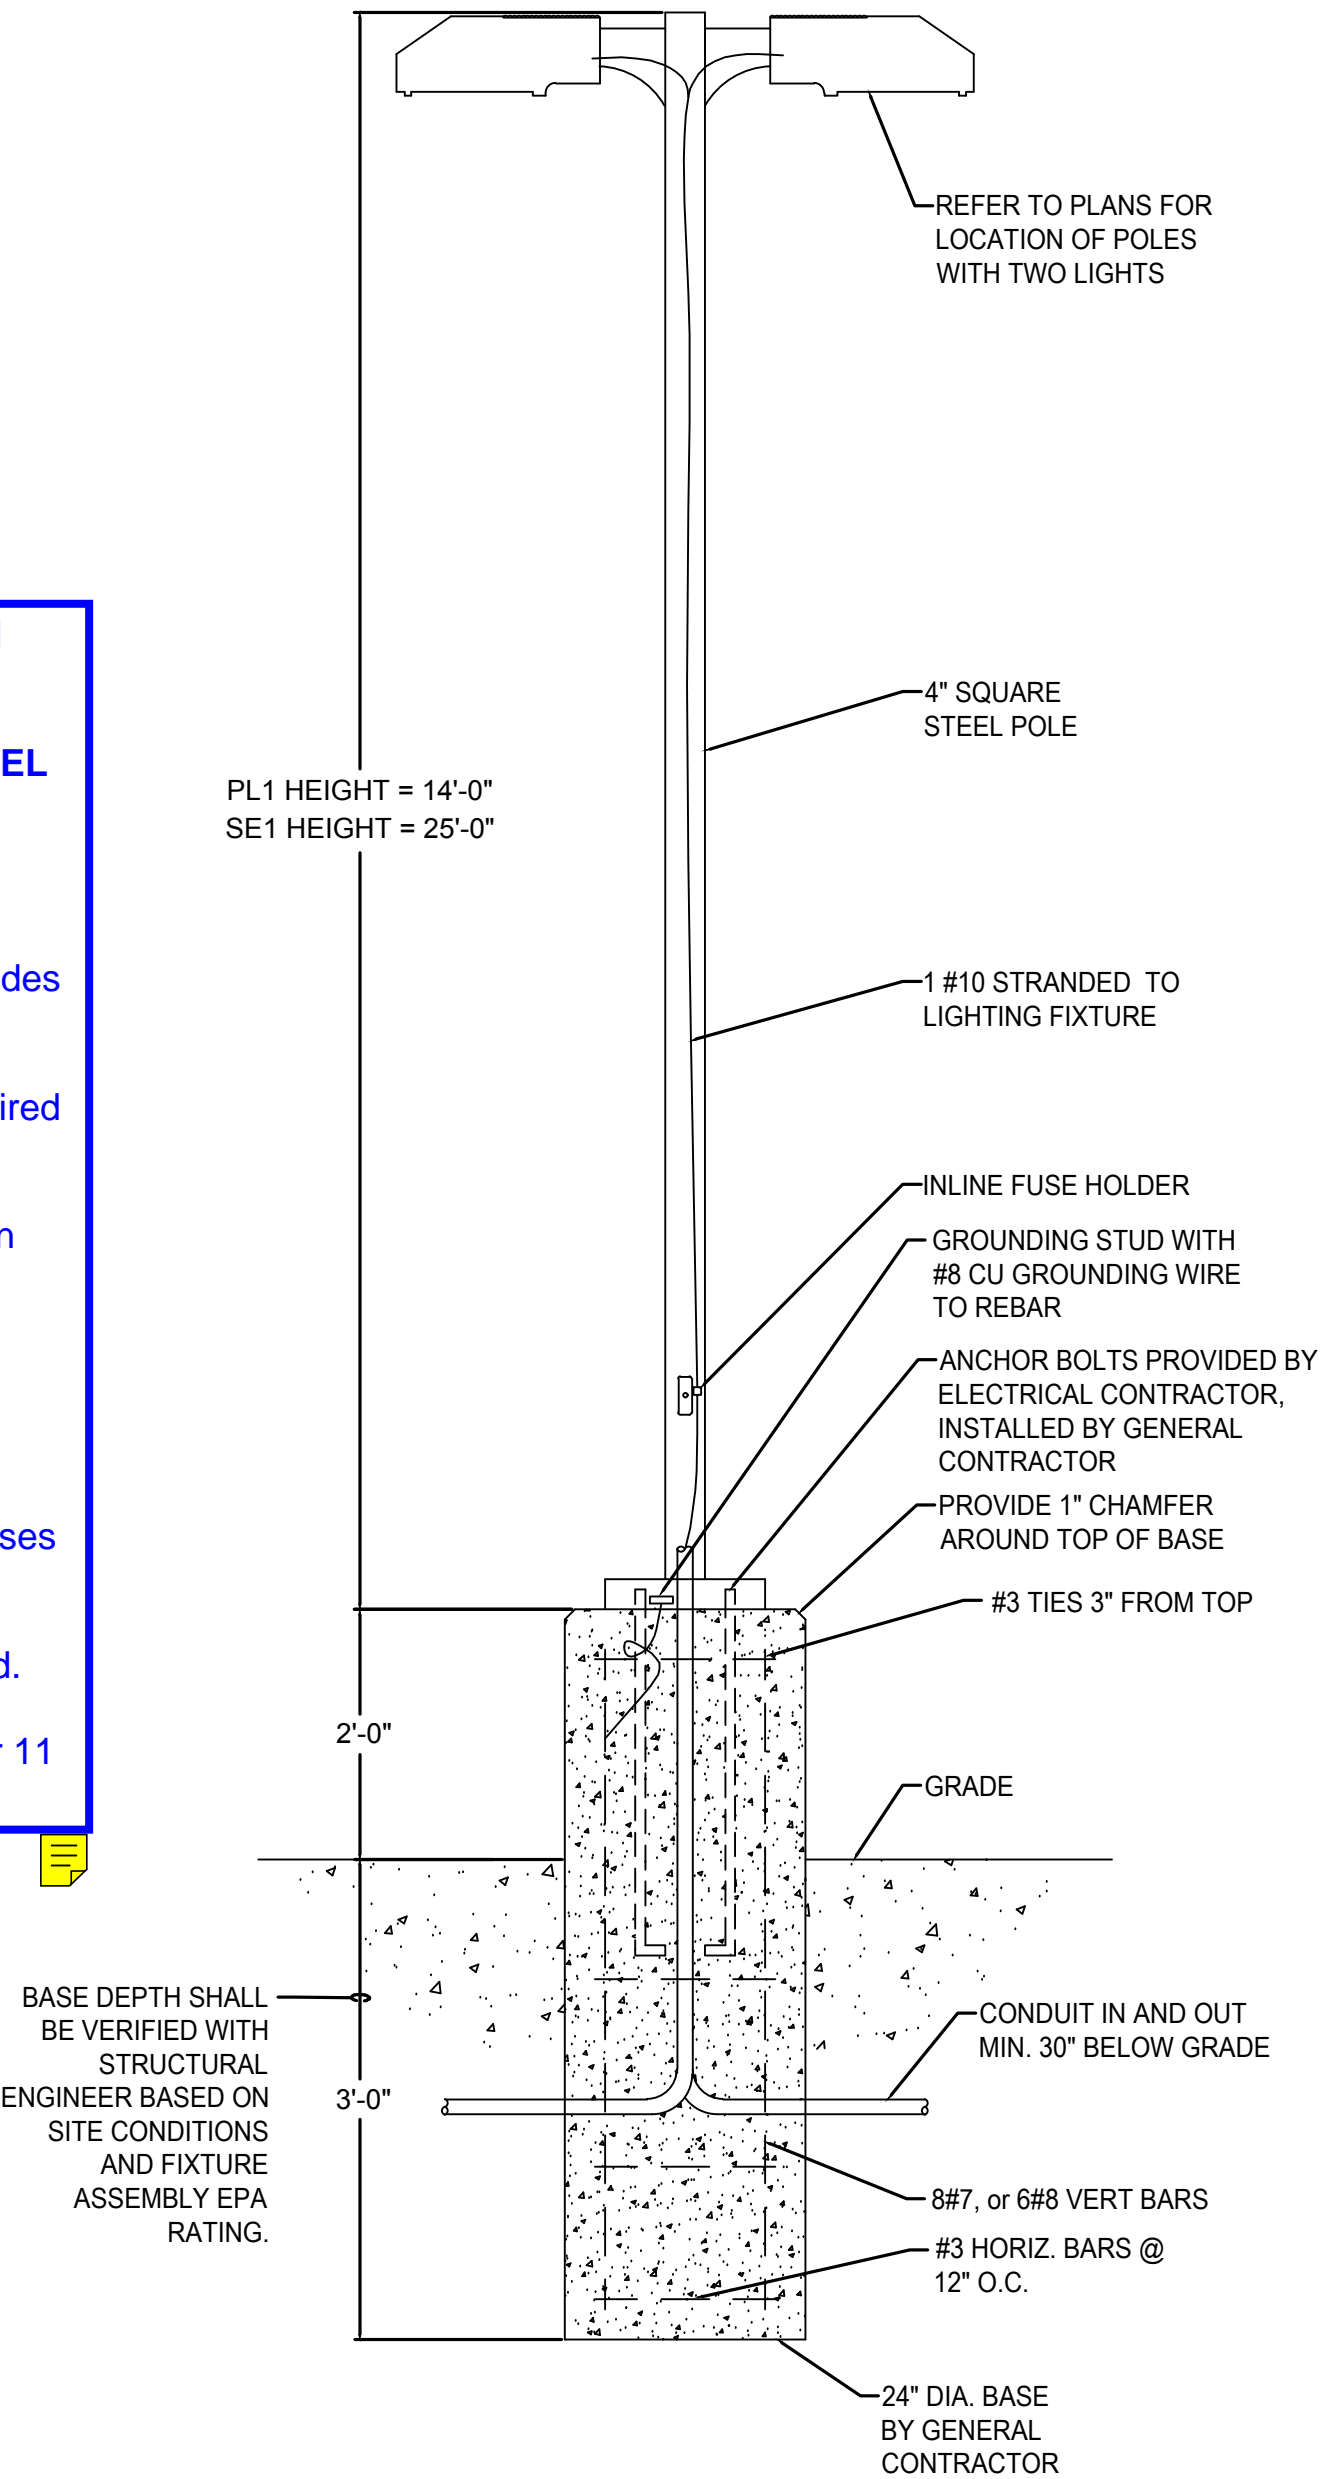

POLE BASE DETAIL
NO SCALE

NOTE:
1. FIXTURE BASE DETAIL PROVIDED FOR INFORMATIONAL PURPOSES ONLY. ELECTRICAL CONTRACTOR TO COORDINATE REQUIREMENTS OF POLE BASE WITH STRUCTURAL ENGINEER AND/OR POLE MANUFACTURER PRIOR TO ROUGH-IN.

NO.	DATE	REMARKS	
		SITE PLAN	SITE PLAN
1	05.15.2024		
2	09.11.2024		

PA / PM:	MTV
DRAWN BY:	NMG
JOB NO.:	2023-054-00

J:\2023\2023-054-00\Cad\Elec\PH2 - SITE LIGHTING DETAILS.dwg RobertC 09/09/24 4:13 pm



1 FIXTURE TYPE SE1




2 FIXTURE TYPE SE2A/SE2B



3 FIXTURE TYPE SE3





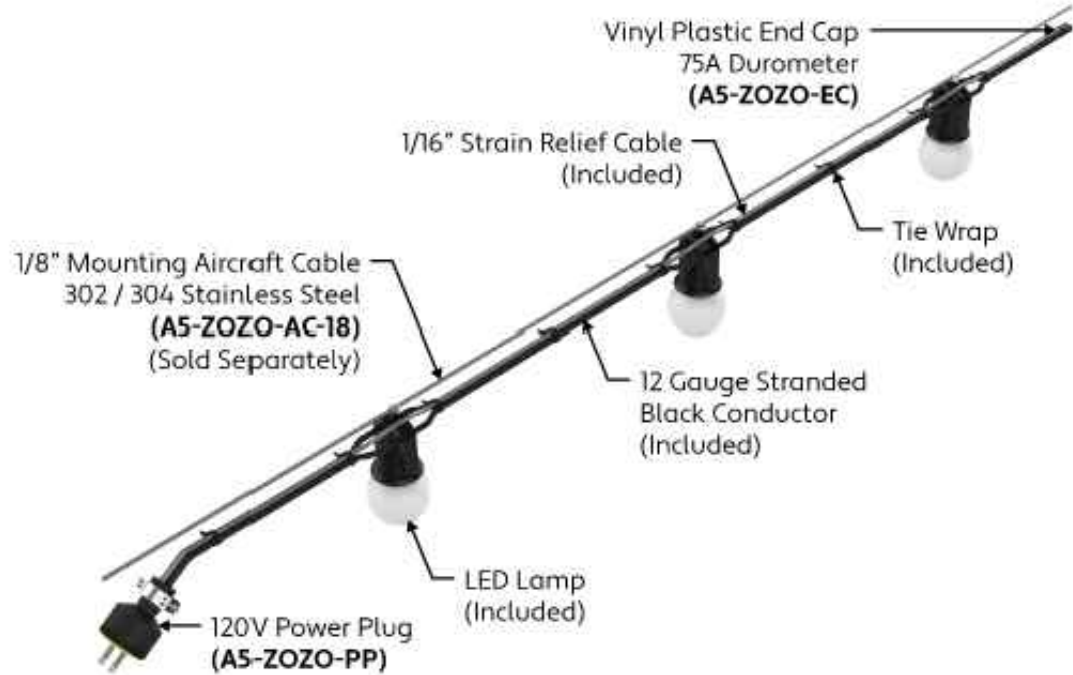




4 FIXTURE TYPE SE4



5 FIXTURE TYPE SE5



5 FIXTURE TYPE SE6

Schedule										
Symbol	Label	Quantity	Manufacturer	Catalog Number	Description	Lamp	Number Lamps	Lumens Per Lamp	Light Loss Factor	Wattage
	SE1	11	LITHONIA LIGHTING	DSX1-LED-P4-30K-80CRI-T3M	POLE MOUNTED D SERIES AREA LED W/ TYPE 3M DIST. MOUNTED AT 25'-0" AFG	LED 3000K	1	13965	1	123.94
	SE2A	5	LITHONIA LIGHTING	WDGE1-LED-P2-30K-80CRI-VF	WDGE1 LED WALL PACK WITH P2 PERFORMANCE PACKAGE, 3000K, VF DIST. MOUNTED AT 12'-0" AFG	LED 3000K	1	1872	1	15.02
	SE2B	6	LITHONIA LIGHTING	WDGE1-LED-P1-30K-80CRI-VW	WDGE1 LED WALL PACK WITH P1 PERFORMANCE PACKAGE, 3000K, VW DIST. MOUNTED AT 12'-0" AFG	LED 3000K	1	1163	1	10
	SE3	6	GOTHAM	EVO2WC-30/05-AR-LD-MWD-MVOLT-UGZ-WL-DBL	2" DIAMETER WALL MOUNTED DOWN LIGHT, BLACK FINISH MOUNTED AT 7'-0" AFG	LED 3000K	1	499	0.5	6.3347
	SE4	20	BEGA	B33018-K3-BLK	10" LONG RECESSED LED STEP LIGHT, BLACK FINISH MOUNTED AT 1'-6" AFG	LED 3000K	1	44	1	5
	SE5	111 FT	ALUZ	A5-ZOZO-BLL-27K-GSFL-3W	LED FESTOON LIGHTING W/ LAMP SHADE MOUNTED AT 10'-0" AFG	LED 2700K	1	106	1	3W/LF
	SE6	5	LITHONIA LIGHTING	RADPT PATH HS LED P2 30K SYM MVOLT PT4 PE DBLXD	LED POST TOP PEDESTRIAN LIGHTING MOUNTED AT 10'-0" AFG	LED 3000K	1	4931	1	38

NO.	DATE	REMARKS
1	05/15/2024	SITE PLAN
2	05/11/2024	SITE PLAN

PA / PM:	MTV
DRAWN BY:	NMG
JOB NO.:	2023-054-00