


TRAILS AT OVERLAND RANCH FILING NO. 1


A PARCEL OF LAND LOCATED IN SECTION 34, TOWNSHIP 5 SOUTH, RANGE 65 WEST OF THE 6TH PRINCIPAL MERIDIAN CITY OF AURORA, COUNTY OF ARAPAHOE, STATE OF COLORADO

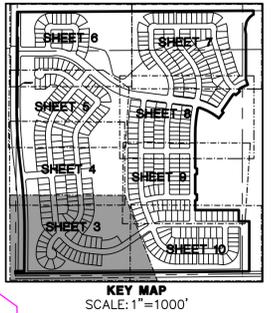

LEGEND

- SET 30" #6 REBAR W/ 2" ALUMINUM CAP STAMPED "COA RP LS38252"
- SET 18" #5 REBAR W/ 1-1/4" PINK PLASTIC CAP STAMPED "JR ENG 38252"
- (R) RECORD
- (M) MEASURED
- (R) RADIAL BEARING
- U.E. UTILITY EASEMENT
- G.E. GAS EASEMENT
- PROPOSED PROPERTY LINE
- - - PROPOSED RIGHT-OF-WAY
- - - PROPOSED CENTERLINE
- EXISTING PROPERTY LINE
- - - EXISTING RIGHT-OF-WAY

NOTE: SEE SHEET 11 FOR LINE AND CURVE TABLES.
NOTE: ALL LINES ARE RADIAL TO THE CORRESPONDING CURVES UNLESS OTHERWISE NOTED

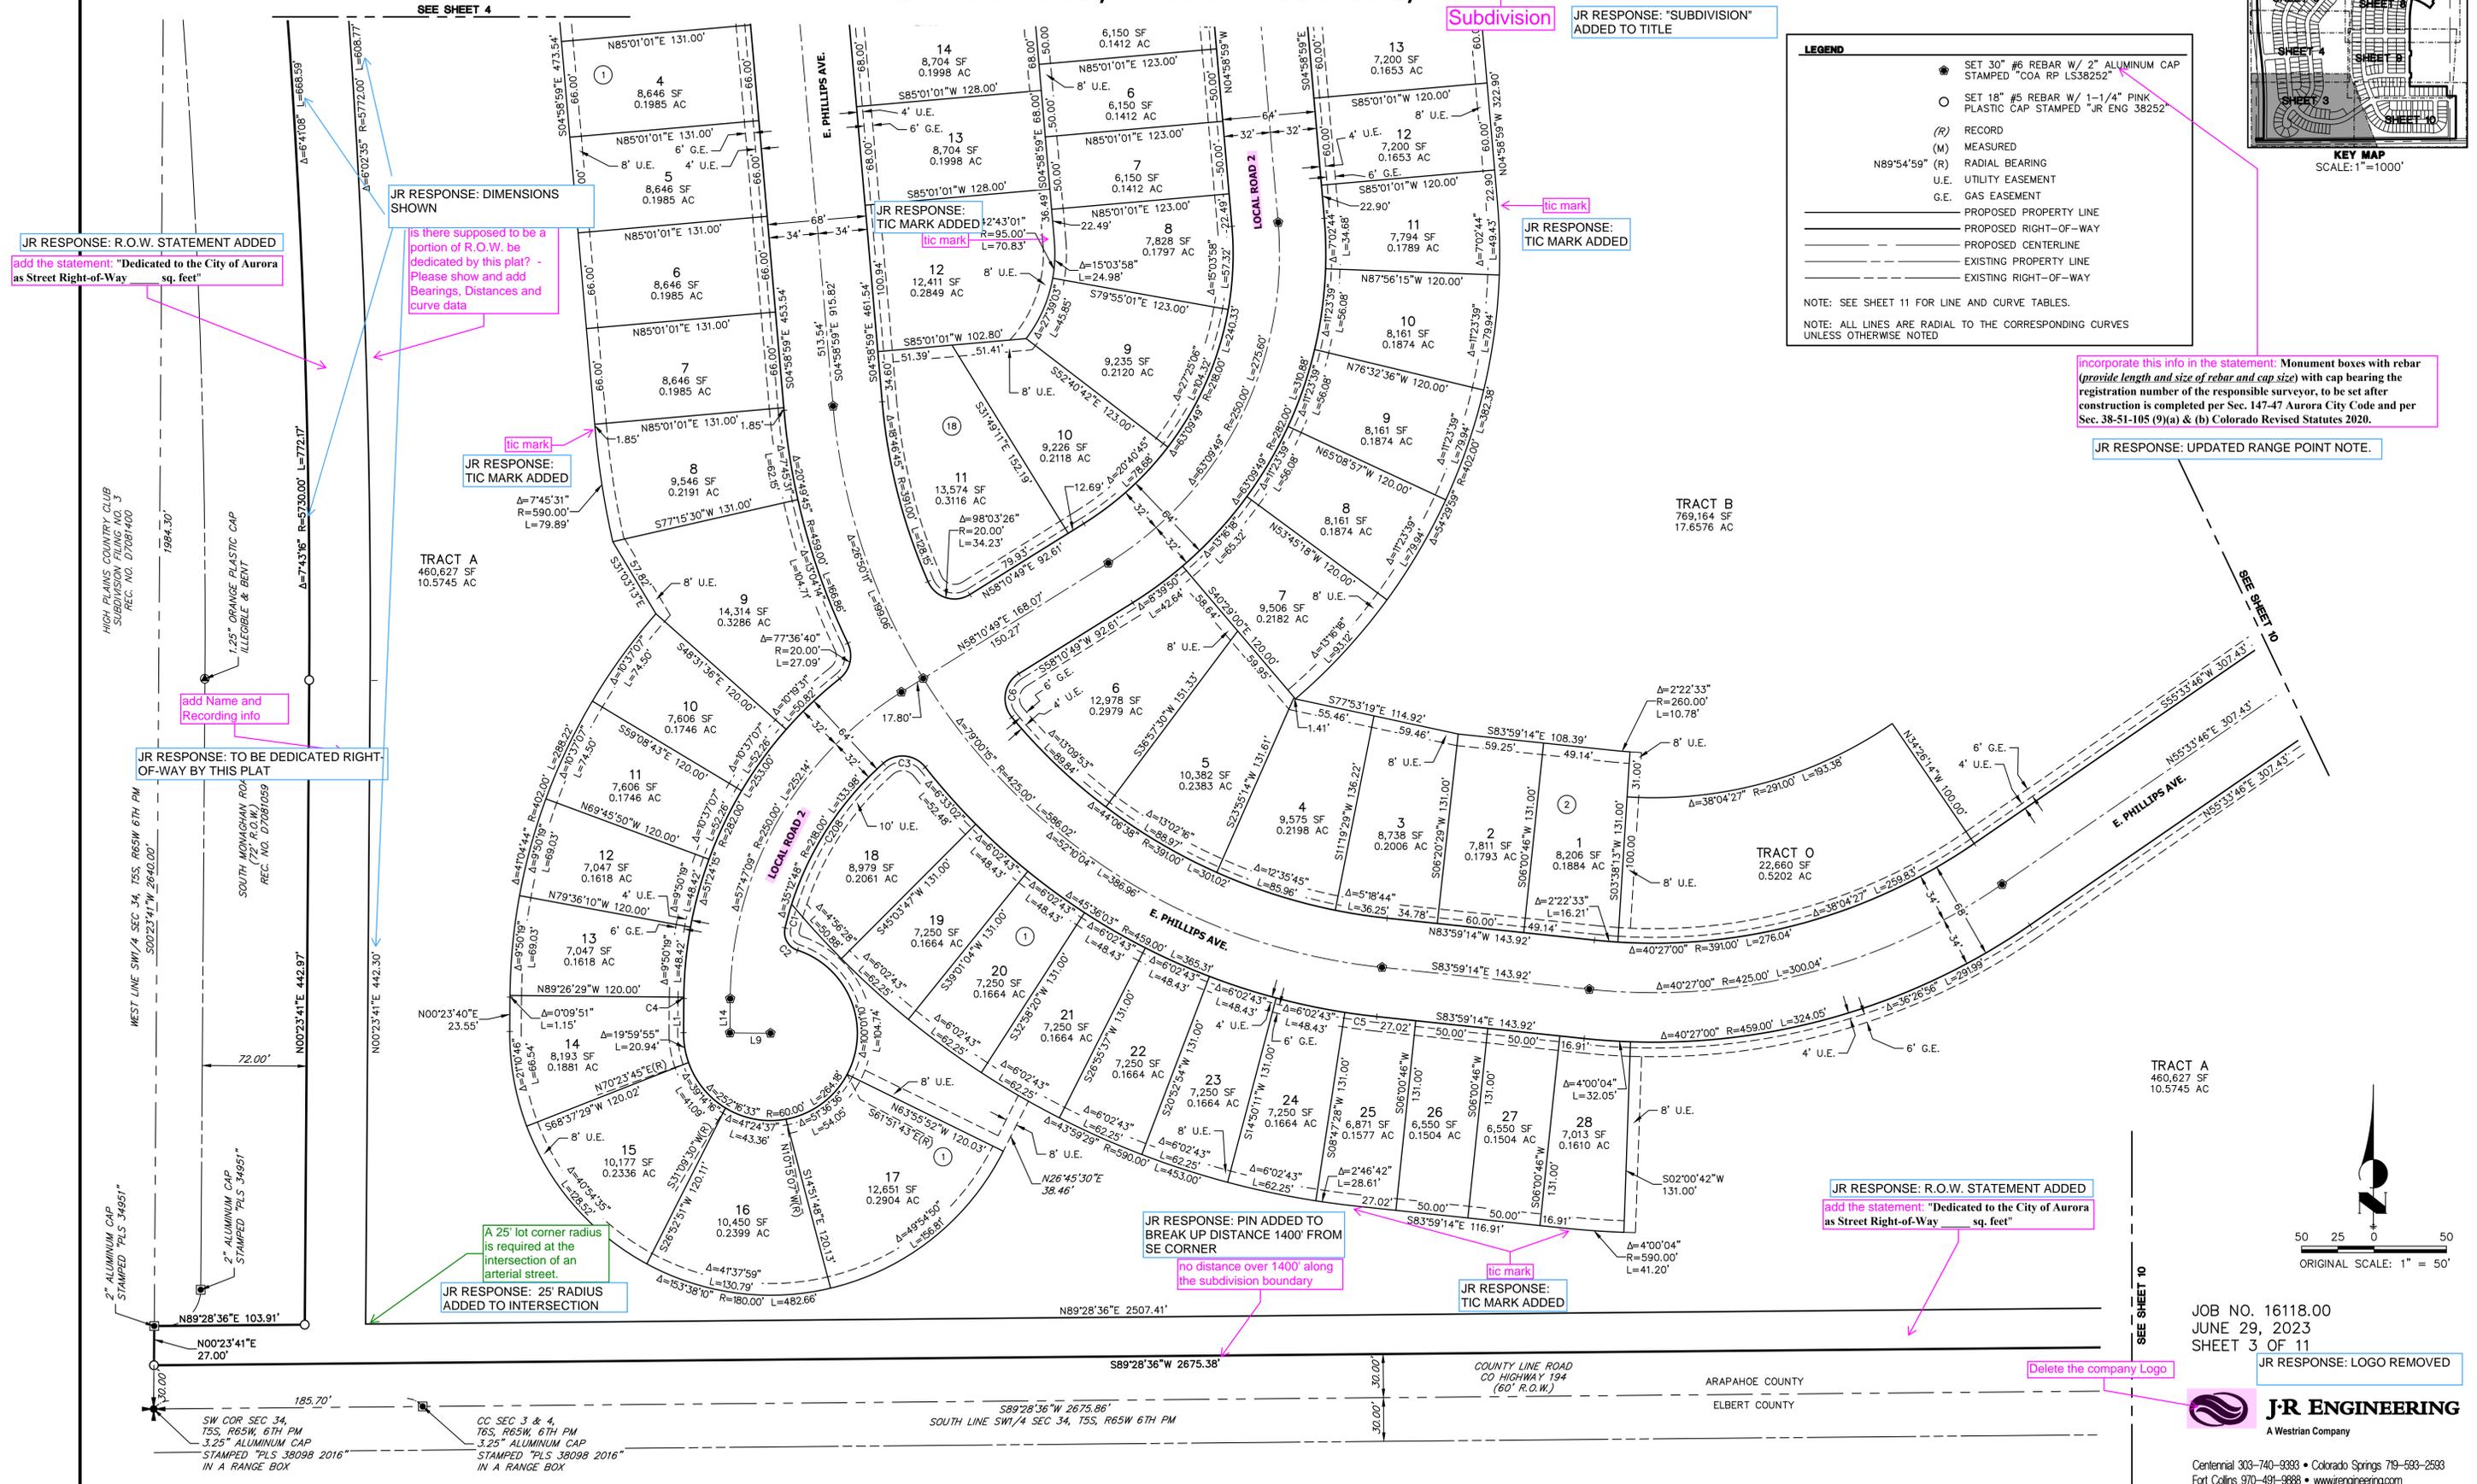

JR RESPONSE: R.O.W. STATEMENT ADDED
add the statement: "Dedicated to the City of Aurora as Street Right-of-Way sq. feet"

JR RESPONSE: DIMENSIONS SHOWN
Is there supposed to be a portion of R.O.W. be dedicated by this plat? - Please show and add Bearings, Distances and curve data

JR RESPONSE: TIC MARK ADDED

JR RESPONSE: TIC MARK ADDED

JR RESPONSE: TIC MARK ADDED

incorporate this info in the statement: Monument boxes with rebar (provide length and size of rebar and cap size) with cap bearing the registration number of the responsible surveyor, to be set after construction is completed per Sec. 147-47 Aurora City Code and per Sec. 38-51-105 (9)(a) & (b) Colorado Revised Statutes 2020.

JR RESPONSE: UPDATED RANGE POINT NOTE.

JR RESPONSE: TO BE DEDICATED RIGHT-OF-WAY BY THIS PLAT

add Name and Recording info

JR RESPONSE: 25' RADIUS ADDED TO INTERSECTION

JR RESPONSE: PIN ADDED TO BREAK UP DISTANCE 1400' FROM SE CORNER
no distance over 1400' along the subdivision boundary

JR RESPONSE: TIC MARK ADDED

JR RESPONSE: R.O.W. STATEMENT ADDED
add the statement: "Dedicated to the City of Aurora as Street Right-of-Way sq. feet"

Delete the company Logo

JR RESPONSE: LOGO REMOVED


JOB NO. 16118.00
JUNE 29, 2023
SHEET 3 OF 11



Centennial 303-740-9393 • Colorado Springs 719-593-2593
Fort Collins 970-491-9888 • www.jrengineering.com

TRAILS AT OVERLAND RANCH FILING NO. 1

A PARCEL OF LAND LOCATED IN SECTION 34, TOWNSHIP 5 SOUTH, RANGE 65 WEST OF THE 6TH PRINCIPAL MERIDIAN
CITY OF AURORA, COUNTY OF ARAPAHOE, STATE OF COLORADO

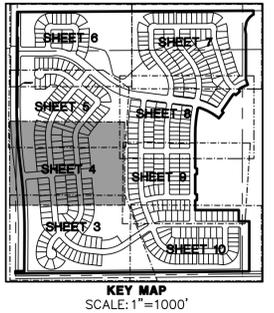


JR RESPONSE: R.O.W. STATEMENT ADDED
add the statement: "Dedicated to the City of Aurora as Street Right-of-Way _____ sq. feet"



LEGEND

- SET 30" #6 REBAR W/ 2" ALUMINUM CAP STAMPED "COA RP LS38252"
- SET 18" #5 REBAR W/ 1-1/4" PINK PLASTIC CAP STAMPED "JR ENG 38252"
- (R) RECORD
- (M) MEASURED
- N89°54'59" (R) RADIAL BEARING
- U.E. UTILITY EASEMENT
- G.E. GAS EASEMENT
- PROPOSED PROPERTY LINE
- PROPOSED RIGHT-OF-WAY
- PROPOSED CENTERLINE
- EXISTING PROPERTY LINE
- EXISTING RIGHT-OF-WAY

NOTE: SEE SHEET 11 FOR LINE AND CURVE TABLES.
NOTE: ALL LINES ARE RADIAL TO THE CORRESPONDING CURVES UNLESS OTHERWISE NOTED

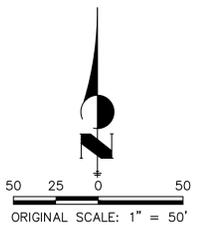

JOB NO. 16118.00
JUNE 29, 2023
SHEET 4 OF 11


Delete the company Logo



Centennial 303-740-9393 • Colorado Springs 719-593-2593
Fort Collins 970-491-9888 • www.jrengineering.com

TRAILS AT OVERLAND RANCH FILING NO. 1

A PARCEL OF LAND LOCATED IN SECTION 34, TOWNSHIP 5 SOUTH, RANGE 65 WEST OF THE 6TH PRINCIPAL MERIDIAN
CITY OF AURORA, COUNTY OF ARAPAHOE, STATE OF COLORADO

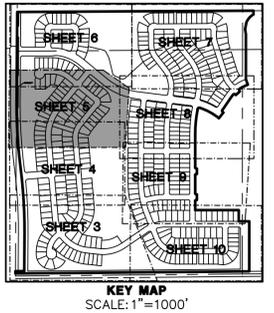

Subdivision JR RESPONSE: "SUBDIVISION" ADDED TO TITLE

SEE SHEET 6

INGRESS/EGRESS EASEMENT BOOK 1586 PAGE 534


JR RESPONSE: R.O.W. STATEMENT ADDED
add the statement: "Dedicated to the City of Aurora as Street Right-of-Way sq. feet"

JR RESPONSE: TIC MARK ADDED

JR RESPONSE: UPDATED RANGE POINT NOTE.

incorporate this info in the statement: Monument boxes with rebar (provide length and size of rebar and cap size) with cap bearing the registration number of the responsible surveyor, to be set after construction is completed per Sec. 147-47 Aurora City Code and per Sec. 38-51-105 (9)(a) & (b) Colorado Revised Statutes 2020.


Delete the company Logo JR RESPONSE: LOGO REMOVED

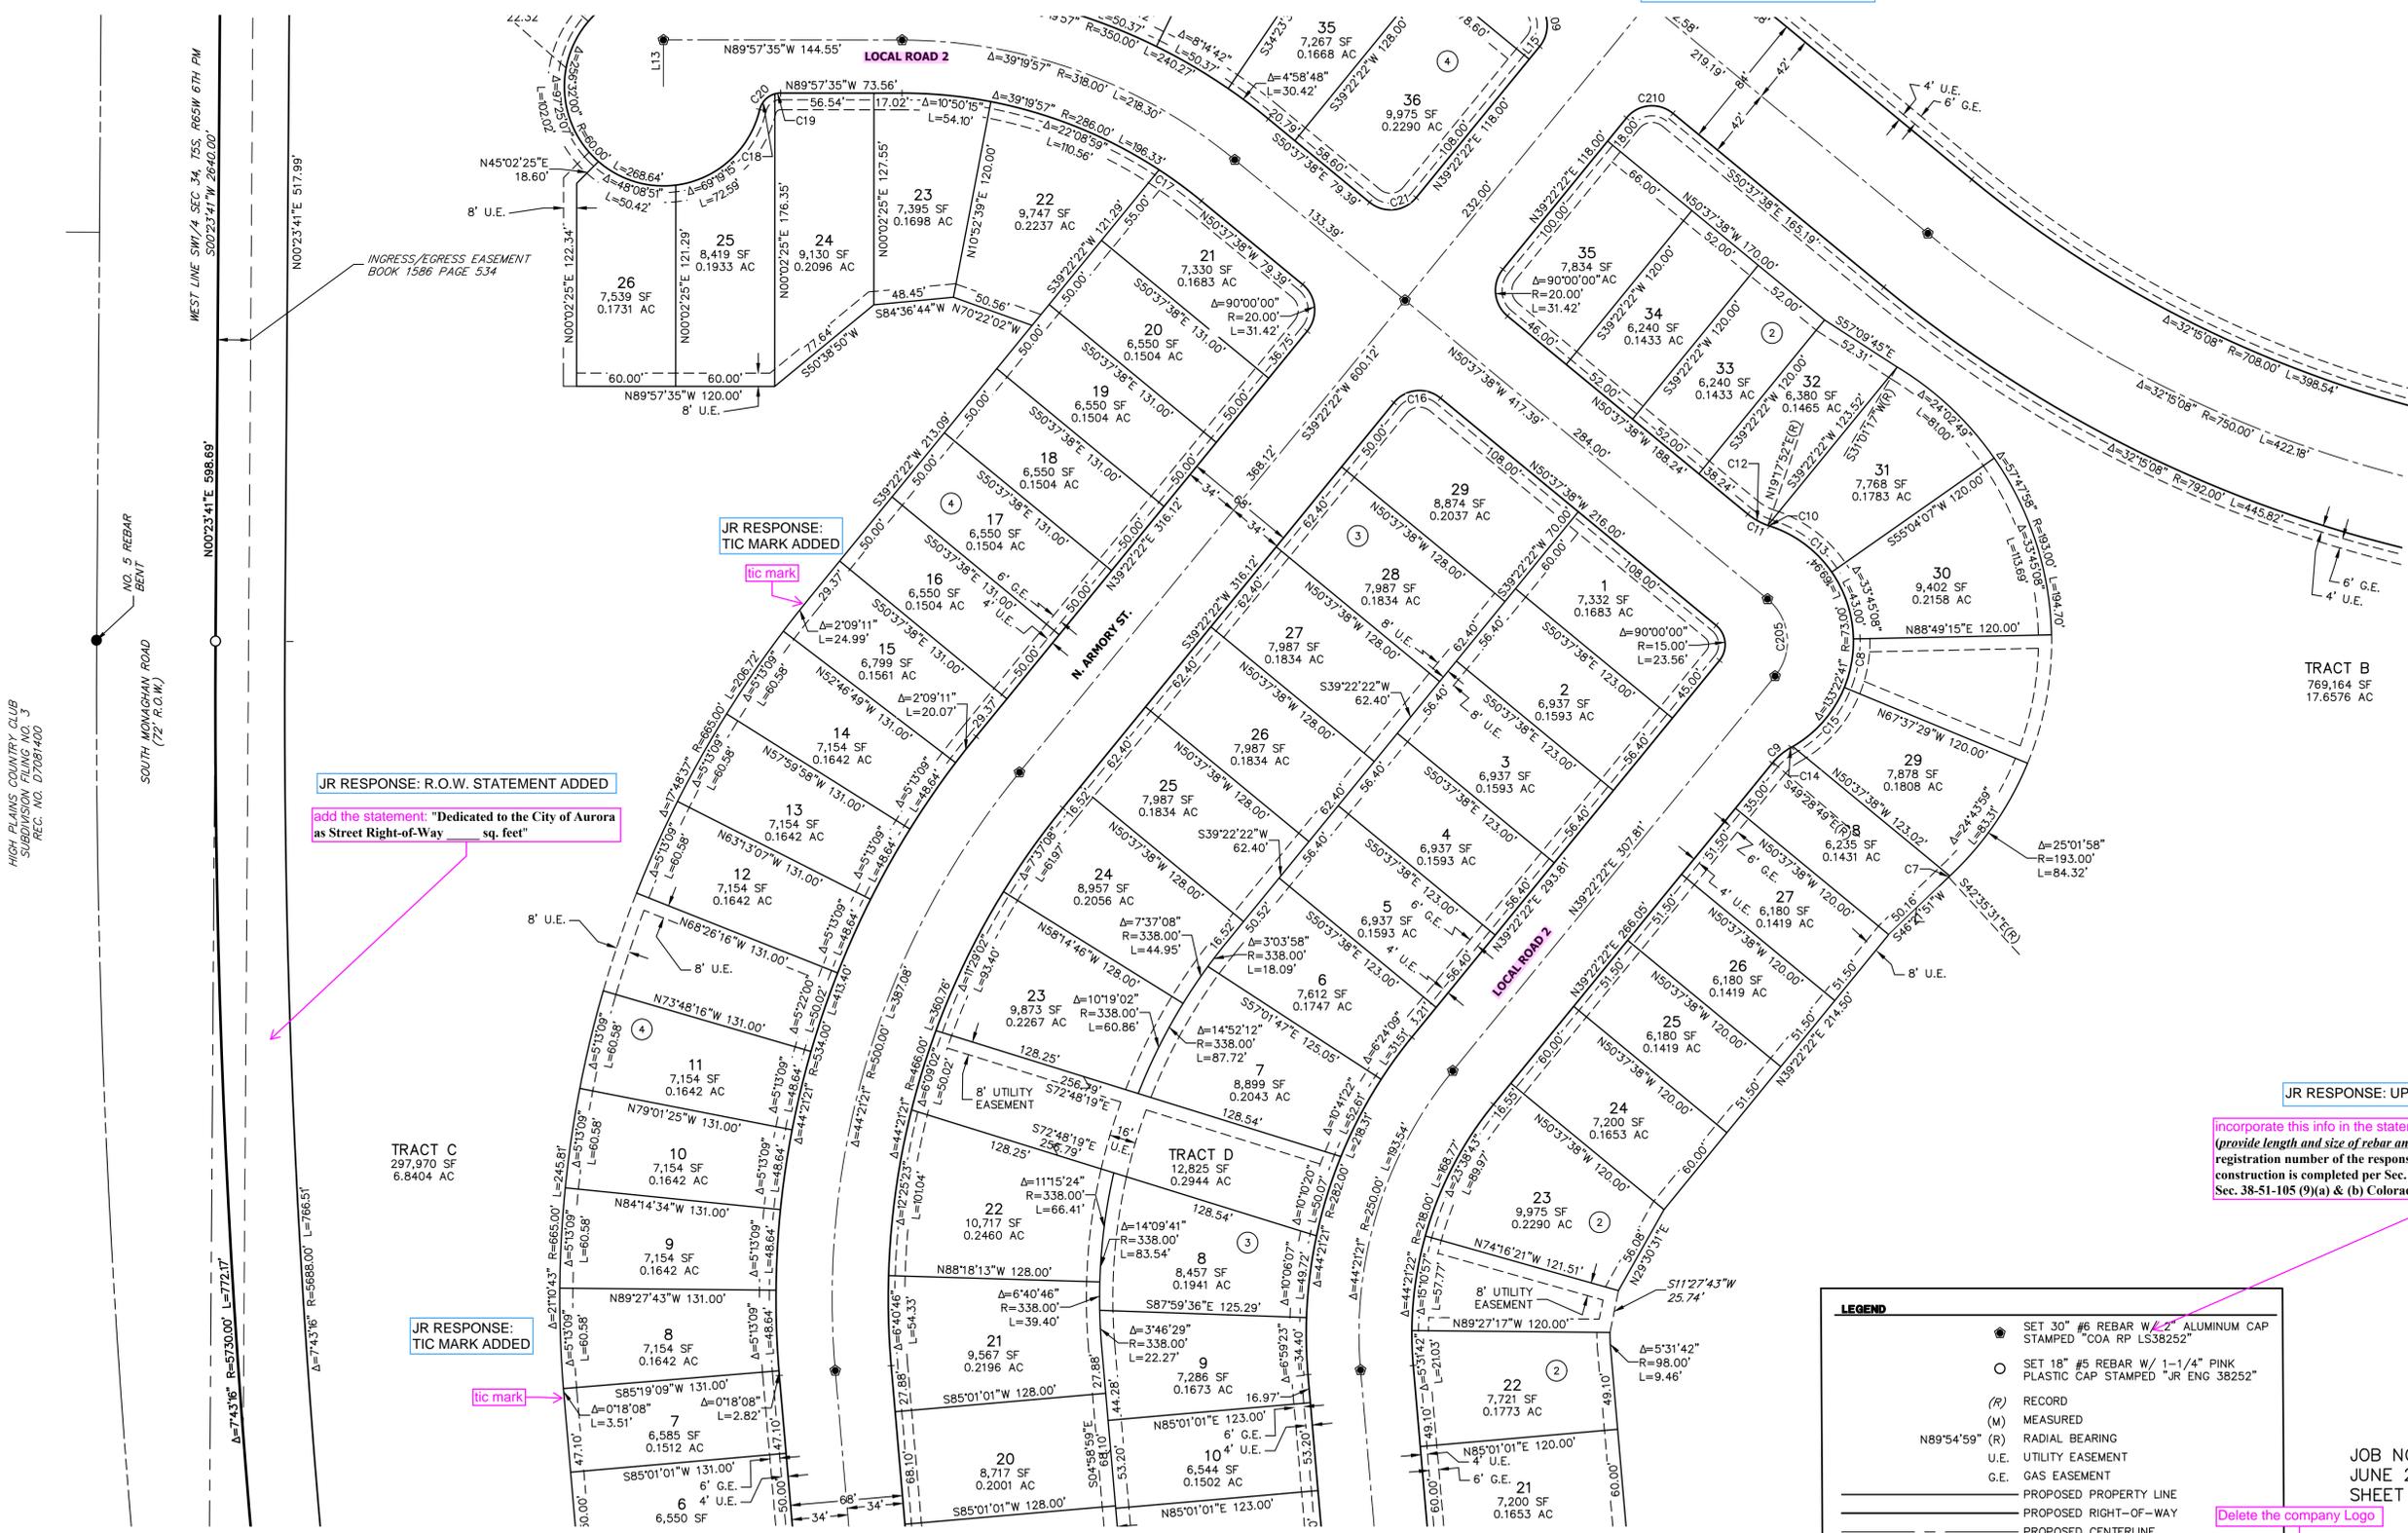

LEGEND

- SET 30" #6 REBAR W/ 2" ALUMINUM CAP STAMPED "COA RP LS38252"
- SET 18" #5 REBAR W/ 1-1/4" PINK PLASTIC CAP STAMPED "JR ENG 38252"
- (R) RECORD
- (M) MEASURED
- N89°54'59" (R) RADIAL BEARING
- U.E. UTILITY EASEMENT
- G.E. GAS EASEMENT
- PROPOSED PROPERTY LINE
- PROPOSED RIGHT-OF-WAY
- PROPOSED CENTERLINE
- EXISTING PROPERTY LINE
- EXISTING RIGHT-OF-WAY

NOTE: SEE SHEET 11 FOR LINE AND CURVE TABLES.
NOTE: ALL LINES ARE RADIAL TO THE CORRESPONDING CURVES UNLESS OTHERWISE NOTED

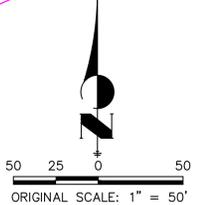

JOB NO. 16118.00
JUNE 29, 2023
SHEET 5 OF 11



Centennial 303-740-9393 • Colorado Springs 719-593-2593
Fort Collins 970-491-9888 • www.jrengineering.com

HIGH PLAINS COUNTRY CLUB
SUBDIVISION FILING NO. 3
REC. NO. D7081400

SOUTH MOWAGHAN ROAD
(72' R.O.W.)

WEST LINE SW 1/4 SEC. 34, T5S, R65W 6TH PM
S002341°W 2640.00'

N002341°E 598.69'

N74°43'16" R=5730.00' L=772.17'

SEE SHEET 4


TRACT B
769,164 SF
17.6576 AC

TRACT C
297,970 SF
6.8404 AC

TRACT D
12,825 SF
0.2944 AC

TRAILS AT OVERLAND RANCH FILING NO. 1

A PARCEL OF LAND LOCATED IN SECTION 34, TOWNSHIP 5 SOUTH, RANGE 65 WEST OF THE 6TH PRINCIPAL MERIDIAN
CITY OF AURORA, COUNTY OF ARAPAHOE, STATE OF COLORADO

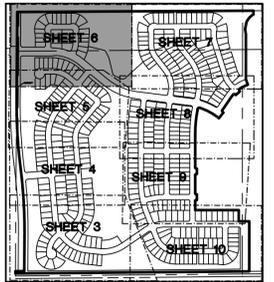

KEY MAP
SCALE: 1"=1000'

Subdivision
JR RESPONSE: "SUBDIVISION" ADDED TO TITLE

JR RESPONSE: TIC MARK ADDED

JR RESPONSE: R.O.W. STATEMENT ADDED
add the statement: "Dedicated to the City of Aurora as Street Right-of-Way sq. feet"

LEGEND

- SET 30" #6 REBAR W/ 2" ALUMINUM CAP STAMPED "COA RP LS38252"
- SET 18" #5 REBAR W/ 1-1/4" PINK PLASTIC CAP STAMPED "JR ENG 38252"
- (R) RECORD
- (M) MEASURED
- (R) RADIAL BEARING
- U.E. UTILITY EASEMENT
- G.E. GAS EASEMENT
- PROPOSED PROPERTY LINE
- - - PROPOSED RIGHT-OF-WAY
- - - PROPOSED CENTERLINE
- EXISTING PROPERTY LINE
- - - EXISTING RIGHT-OF-WAY

NOTE: SEE SHEET 11 FOR LINE AND CURVE TABLES.
NOTE: ALL LINES ARE RADIAL TO THE CORRESPONDING CURVES UNLESS OTHERWISE NOTED.

incorporate this info in the statement: Monument boxes with rebar (provide length and size of rebar and cap size) with cap bearing the registration number of the responsible surveyor, to be set after construction is completed per Sec. 147-47 Aurora City Code and per Sec. 38-51-105 (9)(a) & (b) Colorado Revised Statutes 2020.

JR RESPONSE: UPDATED RANGE POINT NOTE.

JR RESPONSE: TIC MARK ADDED


JR RESPONSE: UPDATED DIMENSIONS
Please correct this dimension.

JR RESPONSE: R.O.W. STATEMENT ADDED
add the statement: "Dedicated to the City of Aurora as Street Right-of-Way sq. feet"

JR RESPONSE: MONUMENT ADDED
add Monument here

JR RESPONSE: TIC MARK ADDED

Delete the company Logo

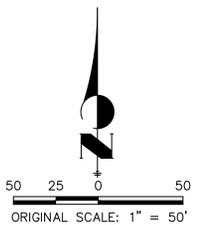


JOB NO. 16118.00
JUNE 29, 2023
SHEET 6 OF 11

JR RESPONSE: LOGO REMOVED



Centennial 303-740-9393 • Colorado Springs 719-593-2593
Fort Collins 970-491-9888 • www.jrengineering.com

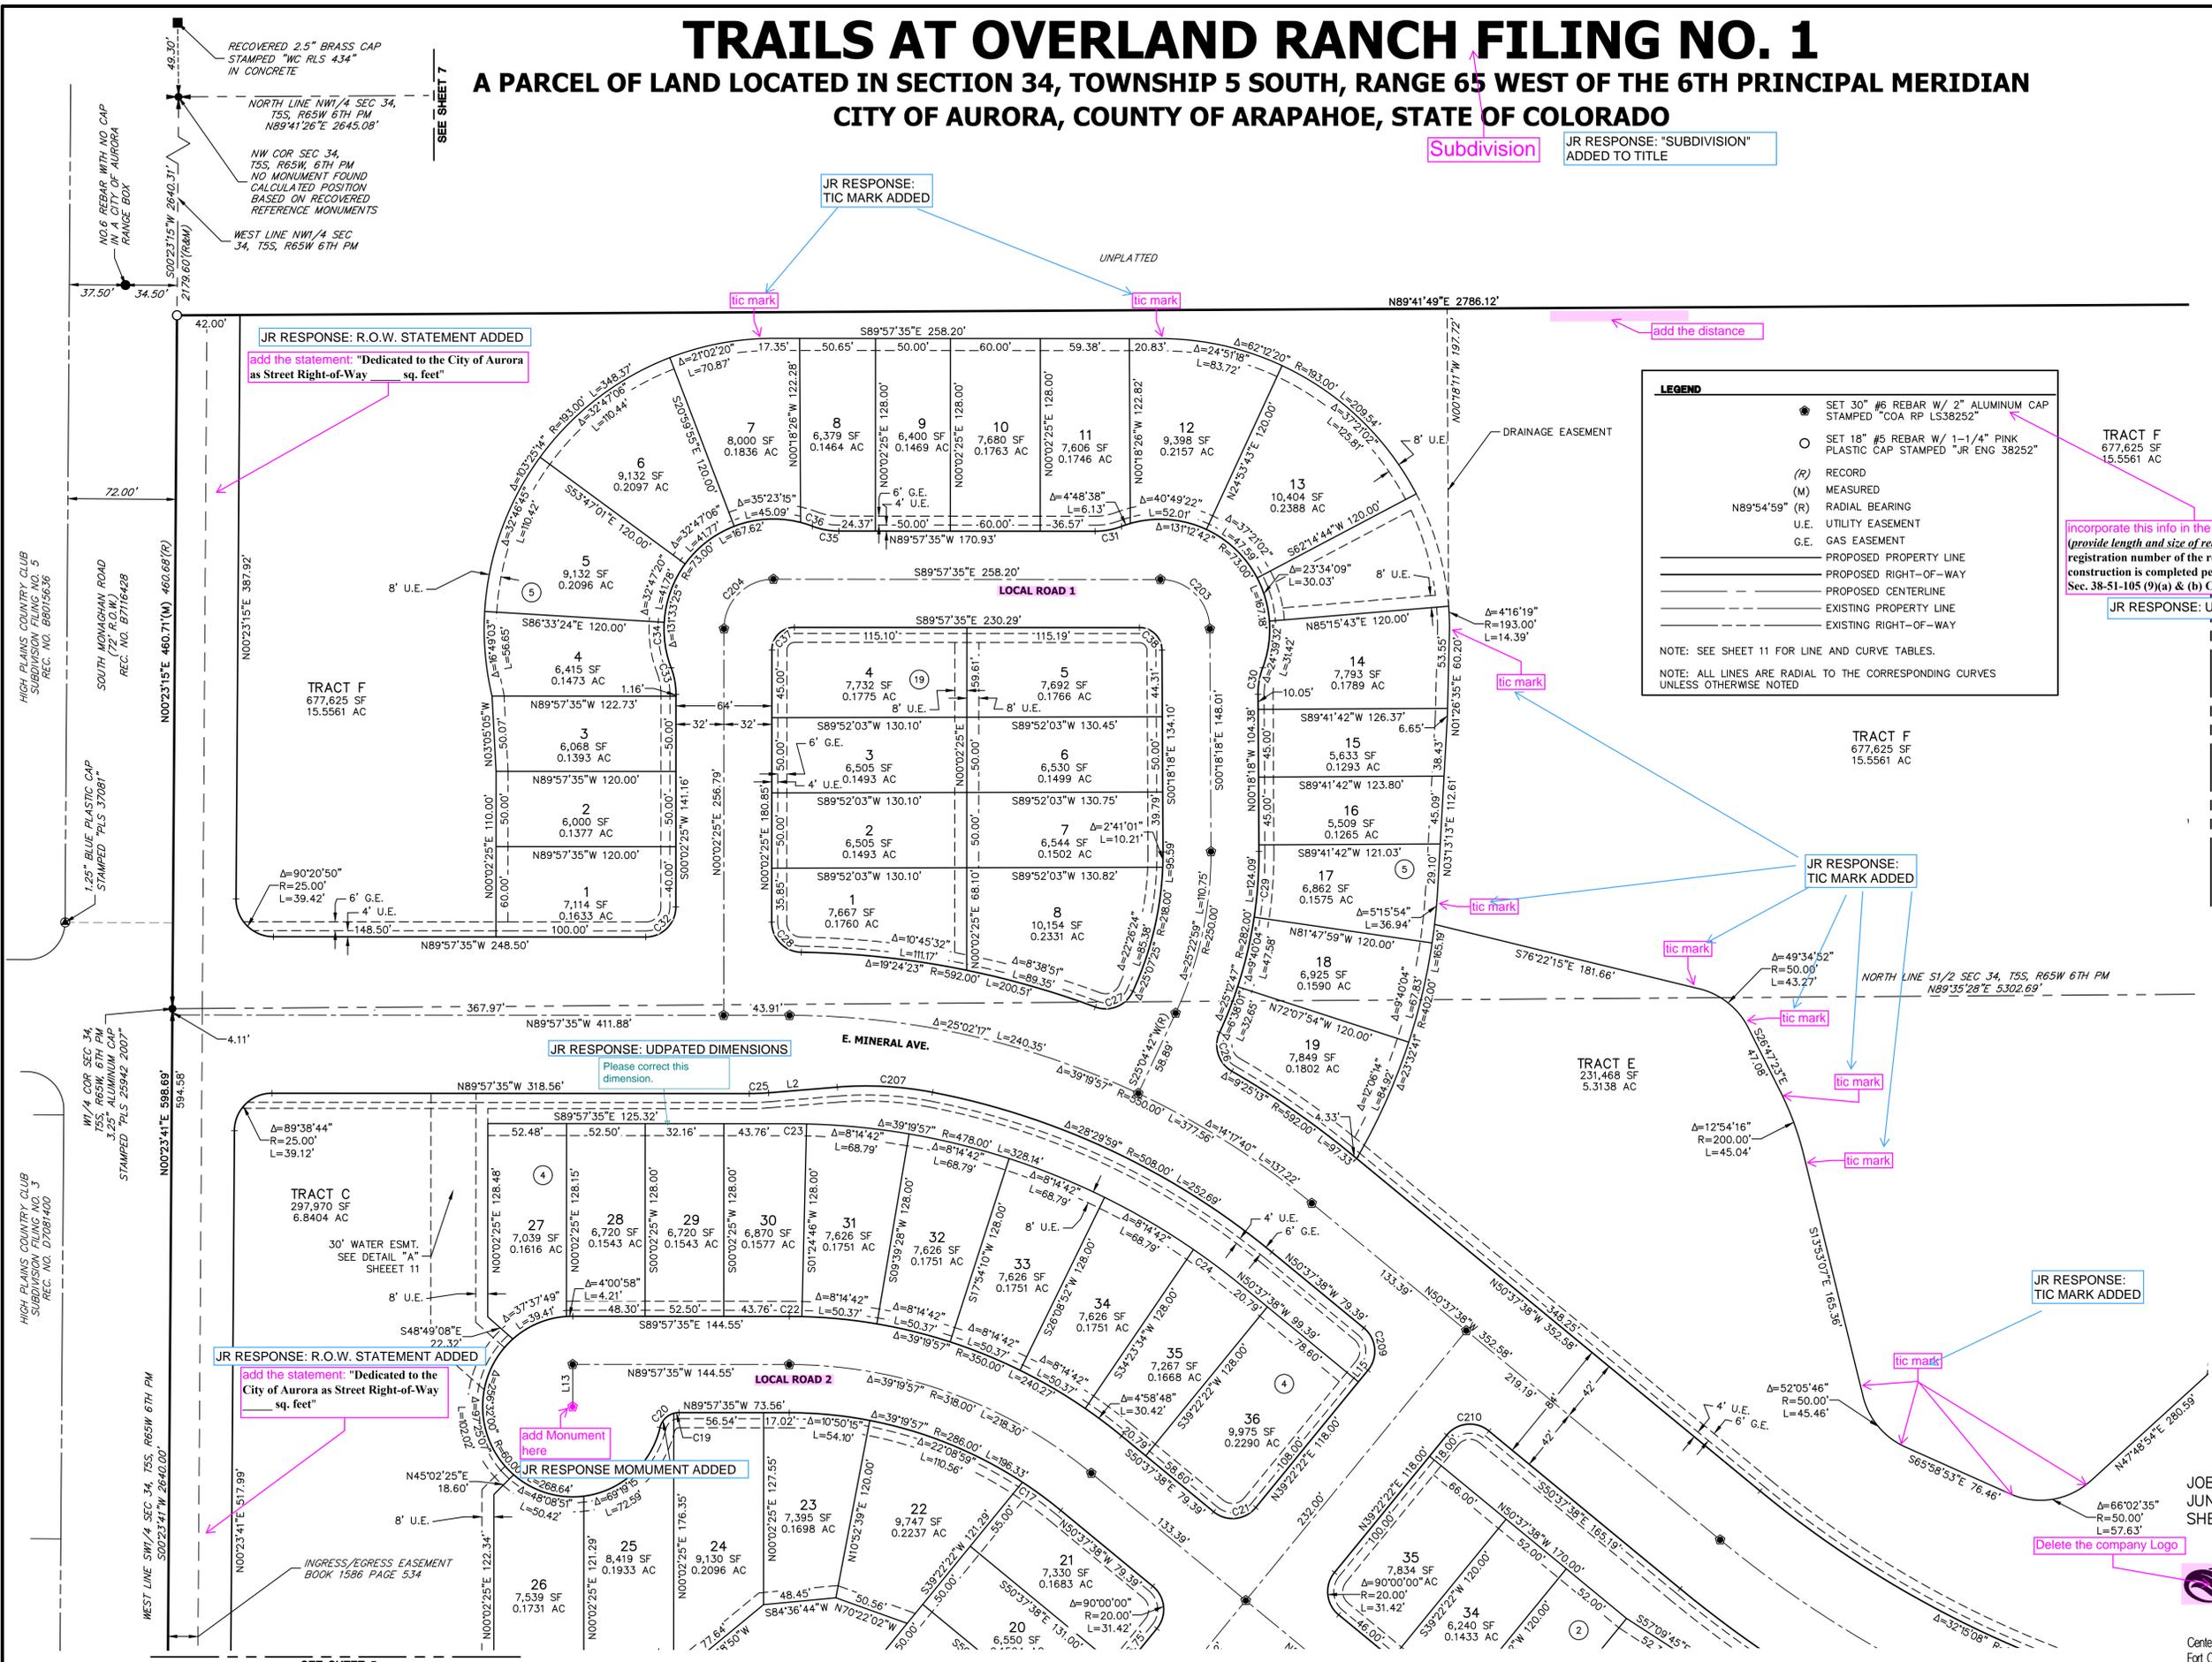

SEE SHEET 5

SEE SHEET 7

HIGH PLAINS COUNTRY CLUB
SUBDIVISION FILING NO. 5
REC. NO. B8015636

HIGH PLAINS COUNTRY CLUB
SUBDIVISION FILING NO. 3
REC. NO. D7081400

WEST LINE SW 1/4 SEC. 34, T5S, R65W 6TH PM
500'23'41\" W 2640.00'

W 1/4 COR SEC. 34, T5S, R65W 6TH PM
3.25\" ALUMINUM CAP
STAMPED \"PLS 37081\"

SOUTH MONAGHAN ROAD
REC. NO. B7116428

1.25\" BLUE PLASTIC CAP
STAMPED \"PLS 37081\"

NO. 6 REBAR WITH NO CAP
IN A CITY OF AURORA
RANGE BOX

RECOVERED 2.5\" BRASS CAP
STAMPED \"WC RLS 434\"
IN CONCRETE

NORTH LINE NW 1/4 SEC. 34,
T5S, R65W 6TH PM
N89°41'26\" E 2645.08'

NW COR SEC. 34,
T5S, R65W 6TH PM
NO MONUMENT FOUND
CALCULATED POSITION
BASED ON RECOVERED
REFERENCE MONUMENTS

WEST LINE NW 1/4 SEC.
34, T5S, R65W 6TH PM

W 1/4 COR SEC. 34,
T5S, R65W 6TH PM
3.25\" ALUMINUM CAP
STAMPED \"PLS 29942 2007\"

W 1/4 COR SEC. 34,
T5S, R65W 6TH PM
3.25\" ALUMINUM CAP
STAMPED \"PLS 37081\"

WEST LINE SW 1/4 SEC. 34, T5S, R65W 6TH PM
500'23'41\" W 2640.00'

INGRESS/EGRESS EASEMENT
BOOK 1586 PAGE 534

TRAILS AT OVERLAND RANCH FILING NO. 1

A PARCEL OF LAND LOCATED IN SECTION 34, TOWNSHIP 5 SOUTH, RANGE 65 WEST OF THE 6TH PRINCIPAL MERIDIAN
CITY OF AURORA, COUNTY OF ARAPAHOE, STATE OF COLORADO

(Subdivision)
JR RESPONSE: "SUBDIVISION"
ADDED TO TITLE



KEY MAP
SCALE: 1" = 1000'
JR RESPONSE: TRACT AND AREA ADDED

add Tract and area

JR RESPONSE: TIC MARK ADDED

tic mark

tic mark

JR RESPONSE: TIC MARK ADDED



TRACT F
677,625 SF
15.5561 AC
JR RESPONSE: UPDATED RANGE POINT NOTE.

Incorporate this info in the statement: Monument boxes with rebar (provide length and size of rebar and cap size) with cap bearing the registration number of the responsible surveyor, to be set after construction is completed per Sec. 147-47 Aurora City Code and per Sec. 38-51-105 (9)(a) & (b) Colorado Revised Statutes 2020.

LEGEND

- SET 30" #6 REBAR W/ 2" ALUMINUM CAP STAMPED "COA RP LS38252"
- SET 18" #5 REBAR W/ 1-1/4" PINK PLASTIC CAP STAMPED "JR ENG 38252"
- (R) RECORD
- (M) MEASURED
- N89°54'59" (R) RADIAL BEARING
- (U.E.) UTILITY EASEMENT
- (G.E.) GAS EASEMENT
- PROPOSED PROPERTY LINE
- PROPOSED RIGHT-OF-WAY
- - - PROPOSED CENTERLINE
- EXISTING PROPERTY LINE
- EXISTING RIGHT-OF-WAY

NOTE: SEE SHEET 11 FOR LINE AND CURVE TABLES.
NOTE: ALL LINES ARE RADIAL TO THE CORRESPONDING CURVES UNLESS OTHERWISE NOTED.


JOB NO. 16118.00
JUNE 29, 2023
SHEET 7 OF 11
JR RESPONSE: LOGO REMOVED



Centennial 303-740-9393 • Colorado Springs 719-593-2593
Fort Collins 970-491-9888 • www.jrengineering.com

TRAILS AT OVERLAND RANCH FILING NO. 1

A PARCEL OF LAND LOCATED IN SECTION 34, TOWNSHIP 5 SOUTH, RANGE 65 WEST OF THE 6TH PRINCIPAL MERIDIAN
CITY OF AURORA, COUNTY OF ARAPAHOE, STATE OF COLORADO

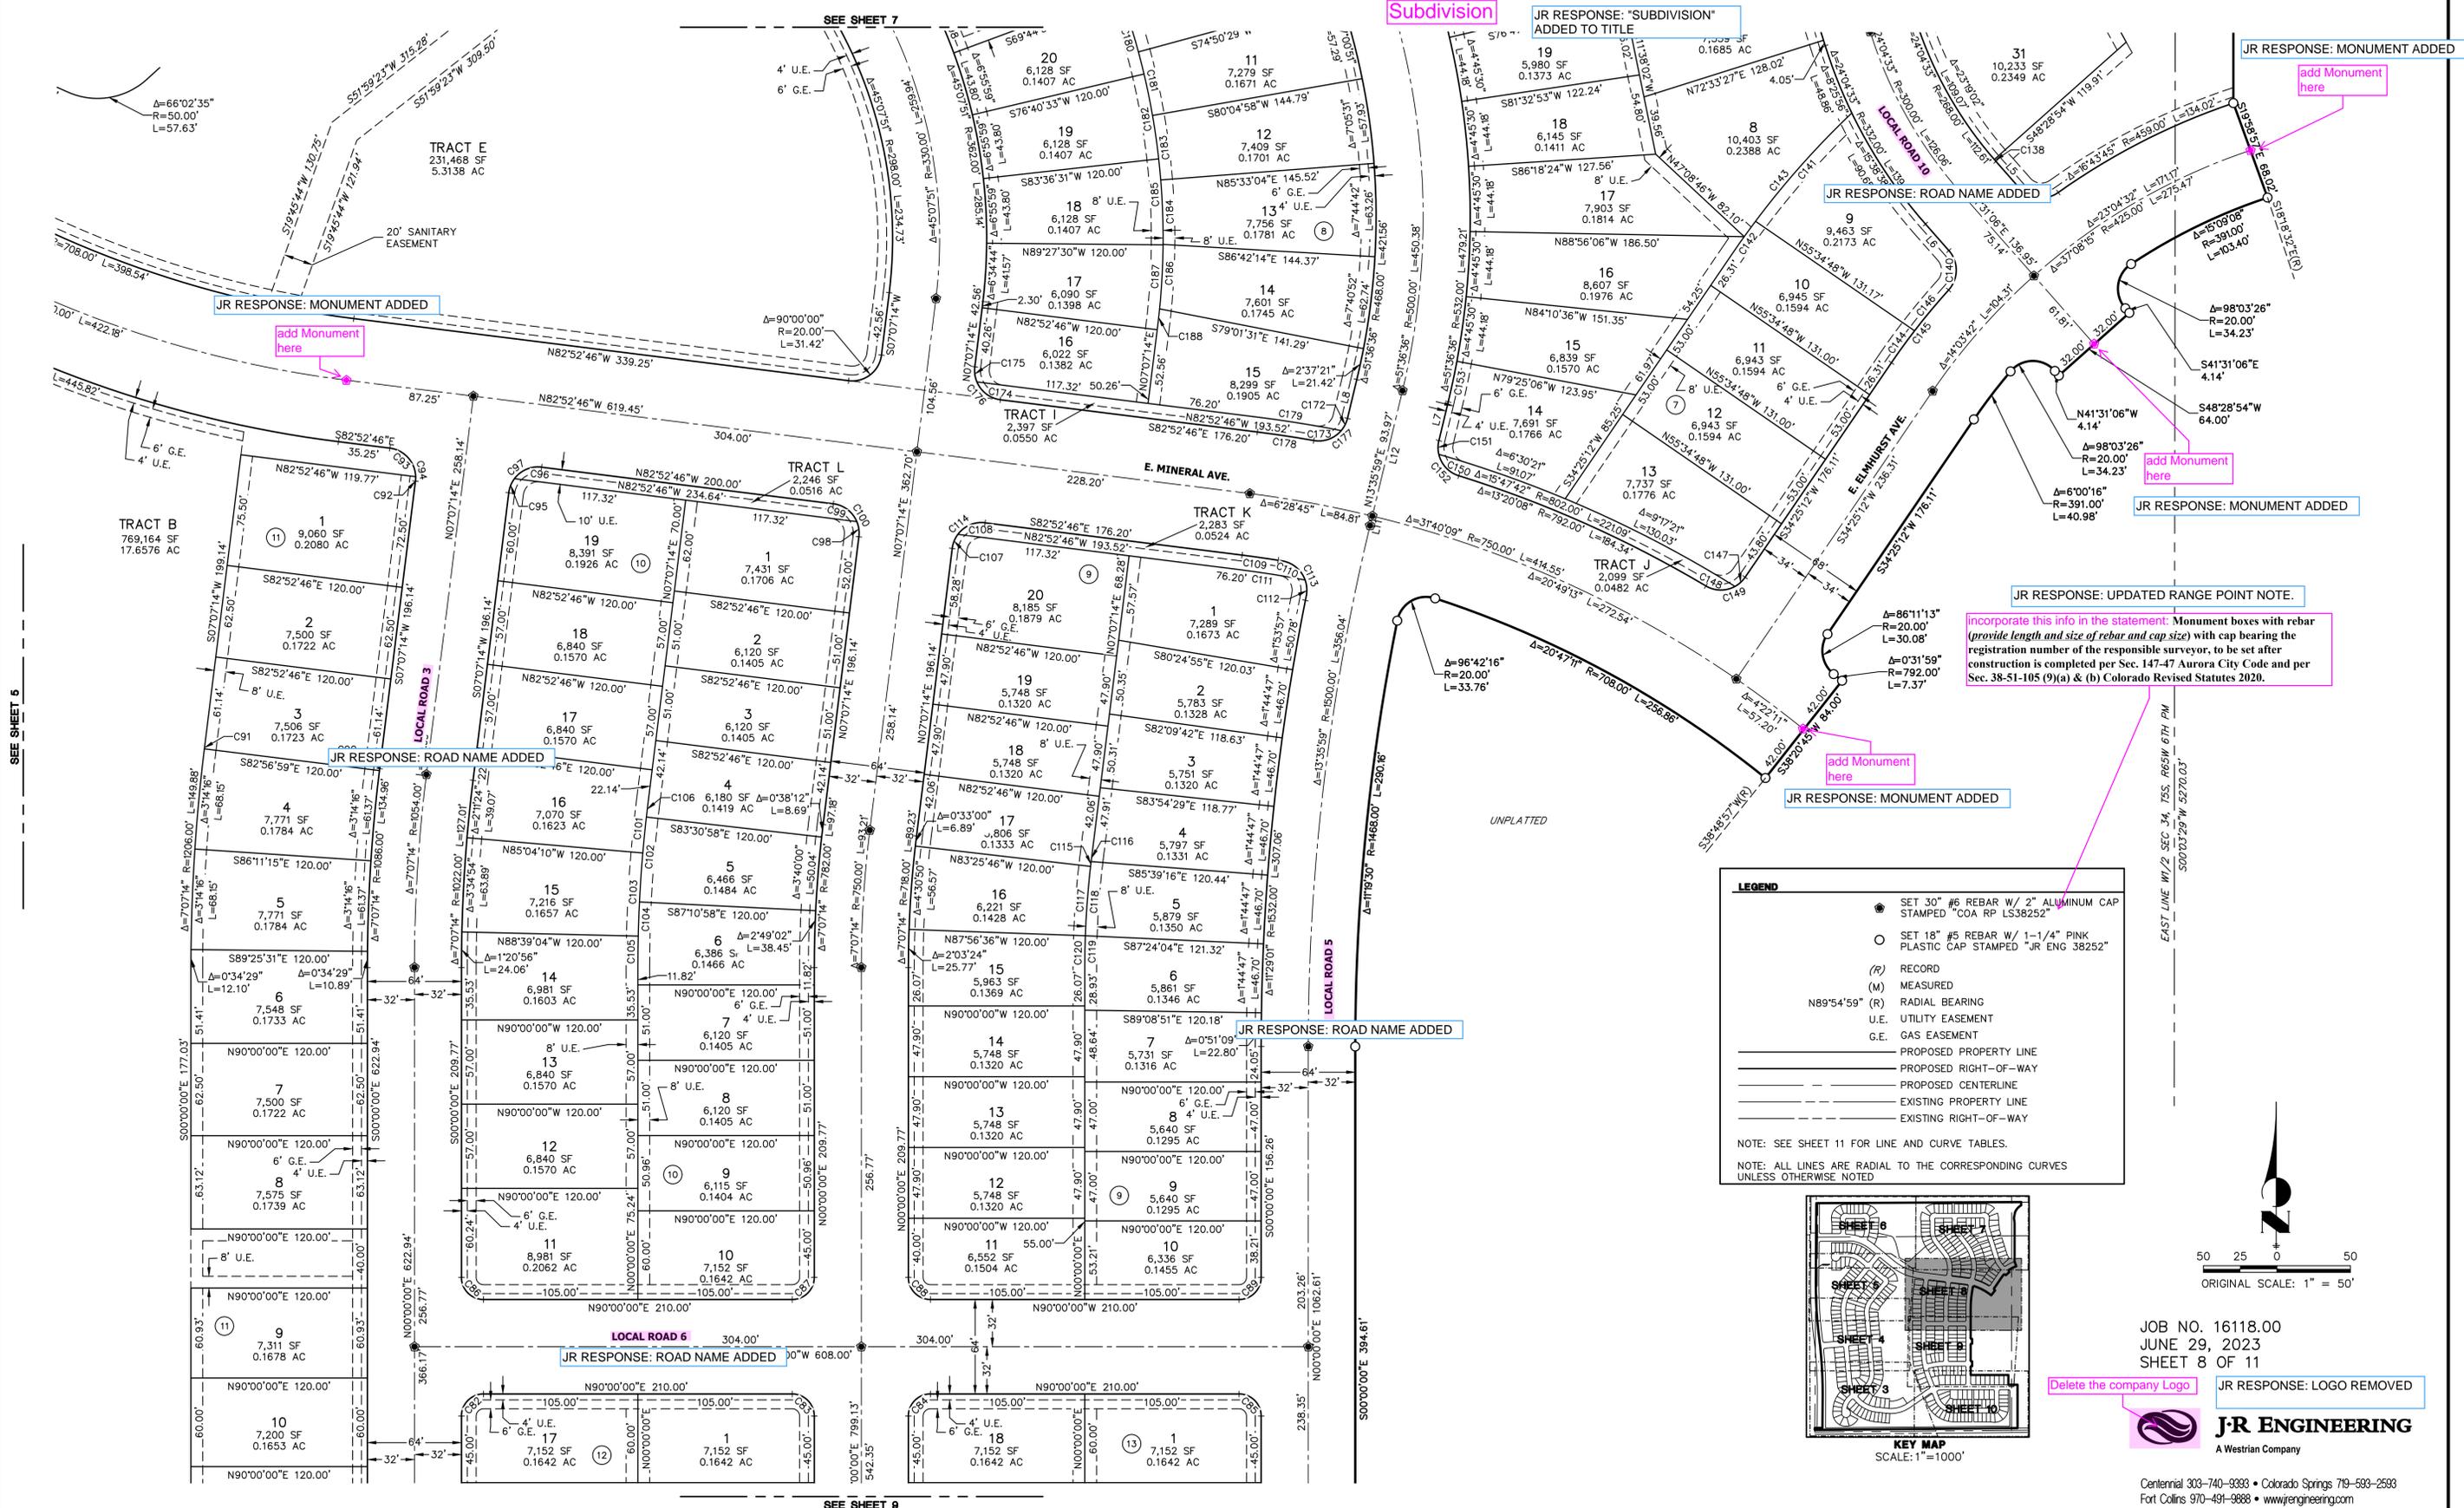

Subdivision

JR RESPONSE: "SUBDIVISION" ADDED TO TITLE

JR RESPONSE: MONUMENT ADDED

JR RESPONSE: MONUMENT ADDED

add Monument here

JR RESPONSE: ROAD NAME ADDED

add Monument here

JR RESPONSE: MONUMENT ADDED

JR RESPONSE: UPDATED RANGE POINT NOTE.

Incorporate this info in the statement: Monument boxes with rebar (provide length and size of rebar and cap size) with cap bearing the registration number of the responsible surveyor, to be set after construction is completed per Sec. 147-47 Aurora City Code and per Sec. 38-51-105 (9)(a) & (b) Colorado Revised Statutes 2020.

add Monument here

JR RESPONSE: MONUMENT ADDED

LEGEND

- SET 30" #6 REBAR W/ 2" ALUMINUM CAP STAMPED "COA RP LS38252"
- SET 18" #5 REBAR W/ 1-1/4" PINK PLASTIC CAP STAMPED "JR ENG 38252"
- (R) RECORD
- (M) MEASURED
- (R) RADIAL BEARING
- U.E. UTILITY EASEMENT
- G.E. GAS EASEMENT
- PROPOSED PROPERTY LINE
- - - PROPOSED RIGHT-OF-WAY
- - - PROPOSED CENTERLINE
- EXISTING PROPERTY LINE
- - - EXISTING RIGHT-OF-WAY

NOTE: SEE SHEET 11 FOR LINE AND CURVE TABLES.
NOTE: ALL LINES ARE RADIAL TO THE CORRESPONDING CURVES UNLESS OTHERWISE NOTED



50 25 0 50
ORIGINAL SCALE: 1" = 50'

JOB NO. 16118.00
JUNE 29, 2023
SHEET 8 OF 11

Delete the company Logo


JR RESPONSE: LOGO REMOVED



Centennial 303-740-9393 • Colorado Springs 719-593-2593
Fort Collins 970-491-9888 • www.jrengineering.com

TRAILS AT OVERLAND RANCH FILING NO. 1

A PARCEL OF LAND LOCATED IN SECTION 34, TOWNSHIP 5 SOUTH, RANGE 65 WEST OF THE 6TH PRINCIPAL MERIDIAN
CITY OF AURORA, COUNTY OF ARAPAHOE, STATE OF COLORADO

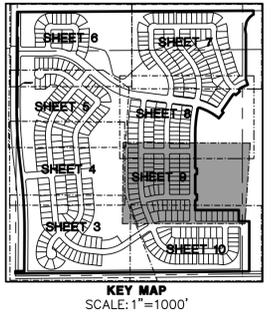


LEGEND	
●	SET 30" #6 REBAR W/ 2" ALUMINUM CAP STAMPED "COA RP LS38252"
○	SET 18" #5 REBAR W/ 1-1/4" PINK PLASTIC CAP STAMPED "JR ENG 38252"
(R)	RECORD
(M)	MEASURED
N89°54'59" (R)	RADIAL BEARING
U.E.	UTILITY EASEMENT
G.E.	GAS EASEMENT
---	PROPOSED PROPERTY LINE
---	PROPOSED RIGHT-OF-WAY
---	PROPOSED CENTERLINE
---	EXISTING PROPERTY LINE
---	EXISTING RIGHT-OF-WAY

NOTE: SEE SHEET 11 FOR LINE AND CURVE TABLES.
NOTE: ALL LINES ARE RADIAL TO THE CORRESPONDING CURVES UNLESS OTHERWISE NOTED.

incorporate this info in the statement: Monument boxes with rebar (provide length and size of rebar and cap size) with cap bearing the registration number of the responsible surveyor, to be set after construction is completed per Sec. 147-47 Aurora City Code and per Sec. 38-51-105 (9)(a) & (b) Colorado Revised Statutes 2020.

JR RESPONSE: UPDATED RANGE POINT NOTE.

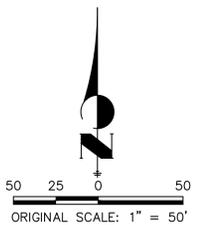

JOB NO. 16118.00
JUNE 29, 2023
SHEET 9 OF 11



Centennial 303-740-9393 • Colorado Springs 719-593-2593
Fort Collins 970-491-9888 • www.jrengineering.com

Delete the company Logo
JR RESPONSE: LOGO REMOVED


SEE SHEET 4

SEE SHEET 8


SEE SHEET 10

TRAILS AT OVERLAND RANCH FILING NO. 1

A PARCEL OF LAND LOCATED IN SECTION 34, TOWNSHIP 5 SOUTH, RANGE 65 WEST OF THE 6TH PRINCIPAL MERIDIAN
CITY OF AURORA, COUNTY OF ARAPAHOE, STATE OF COLORADO

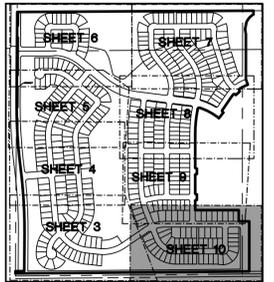

KEY MAP
SCALE: 1"=1000'

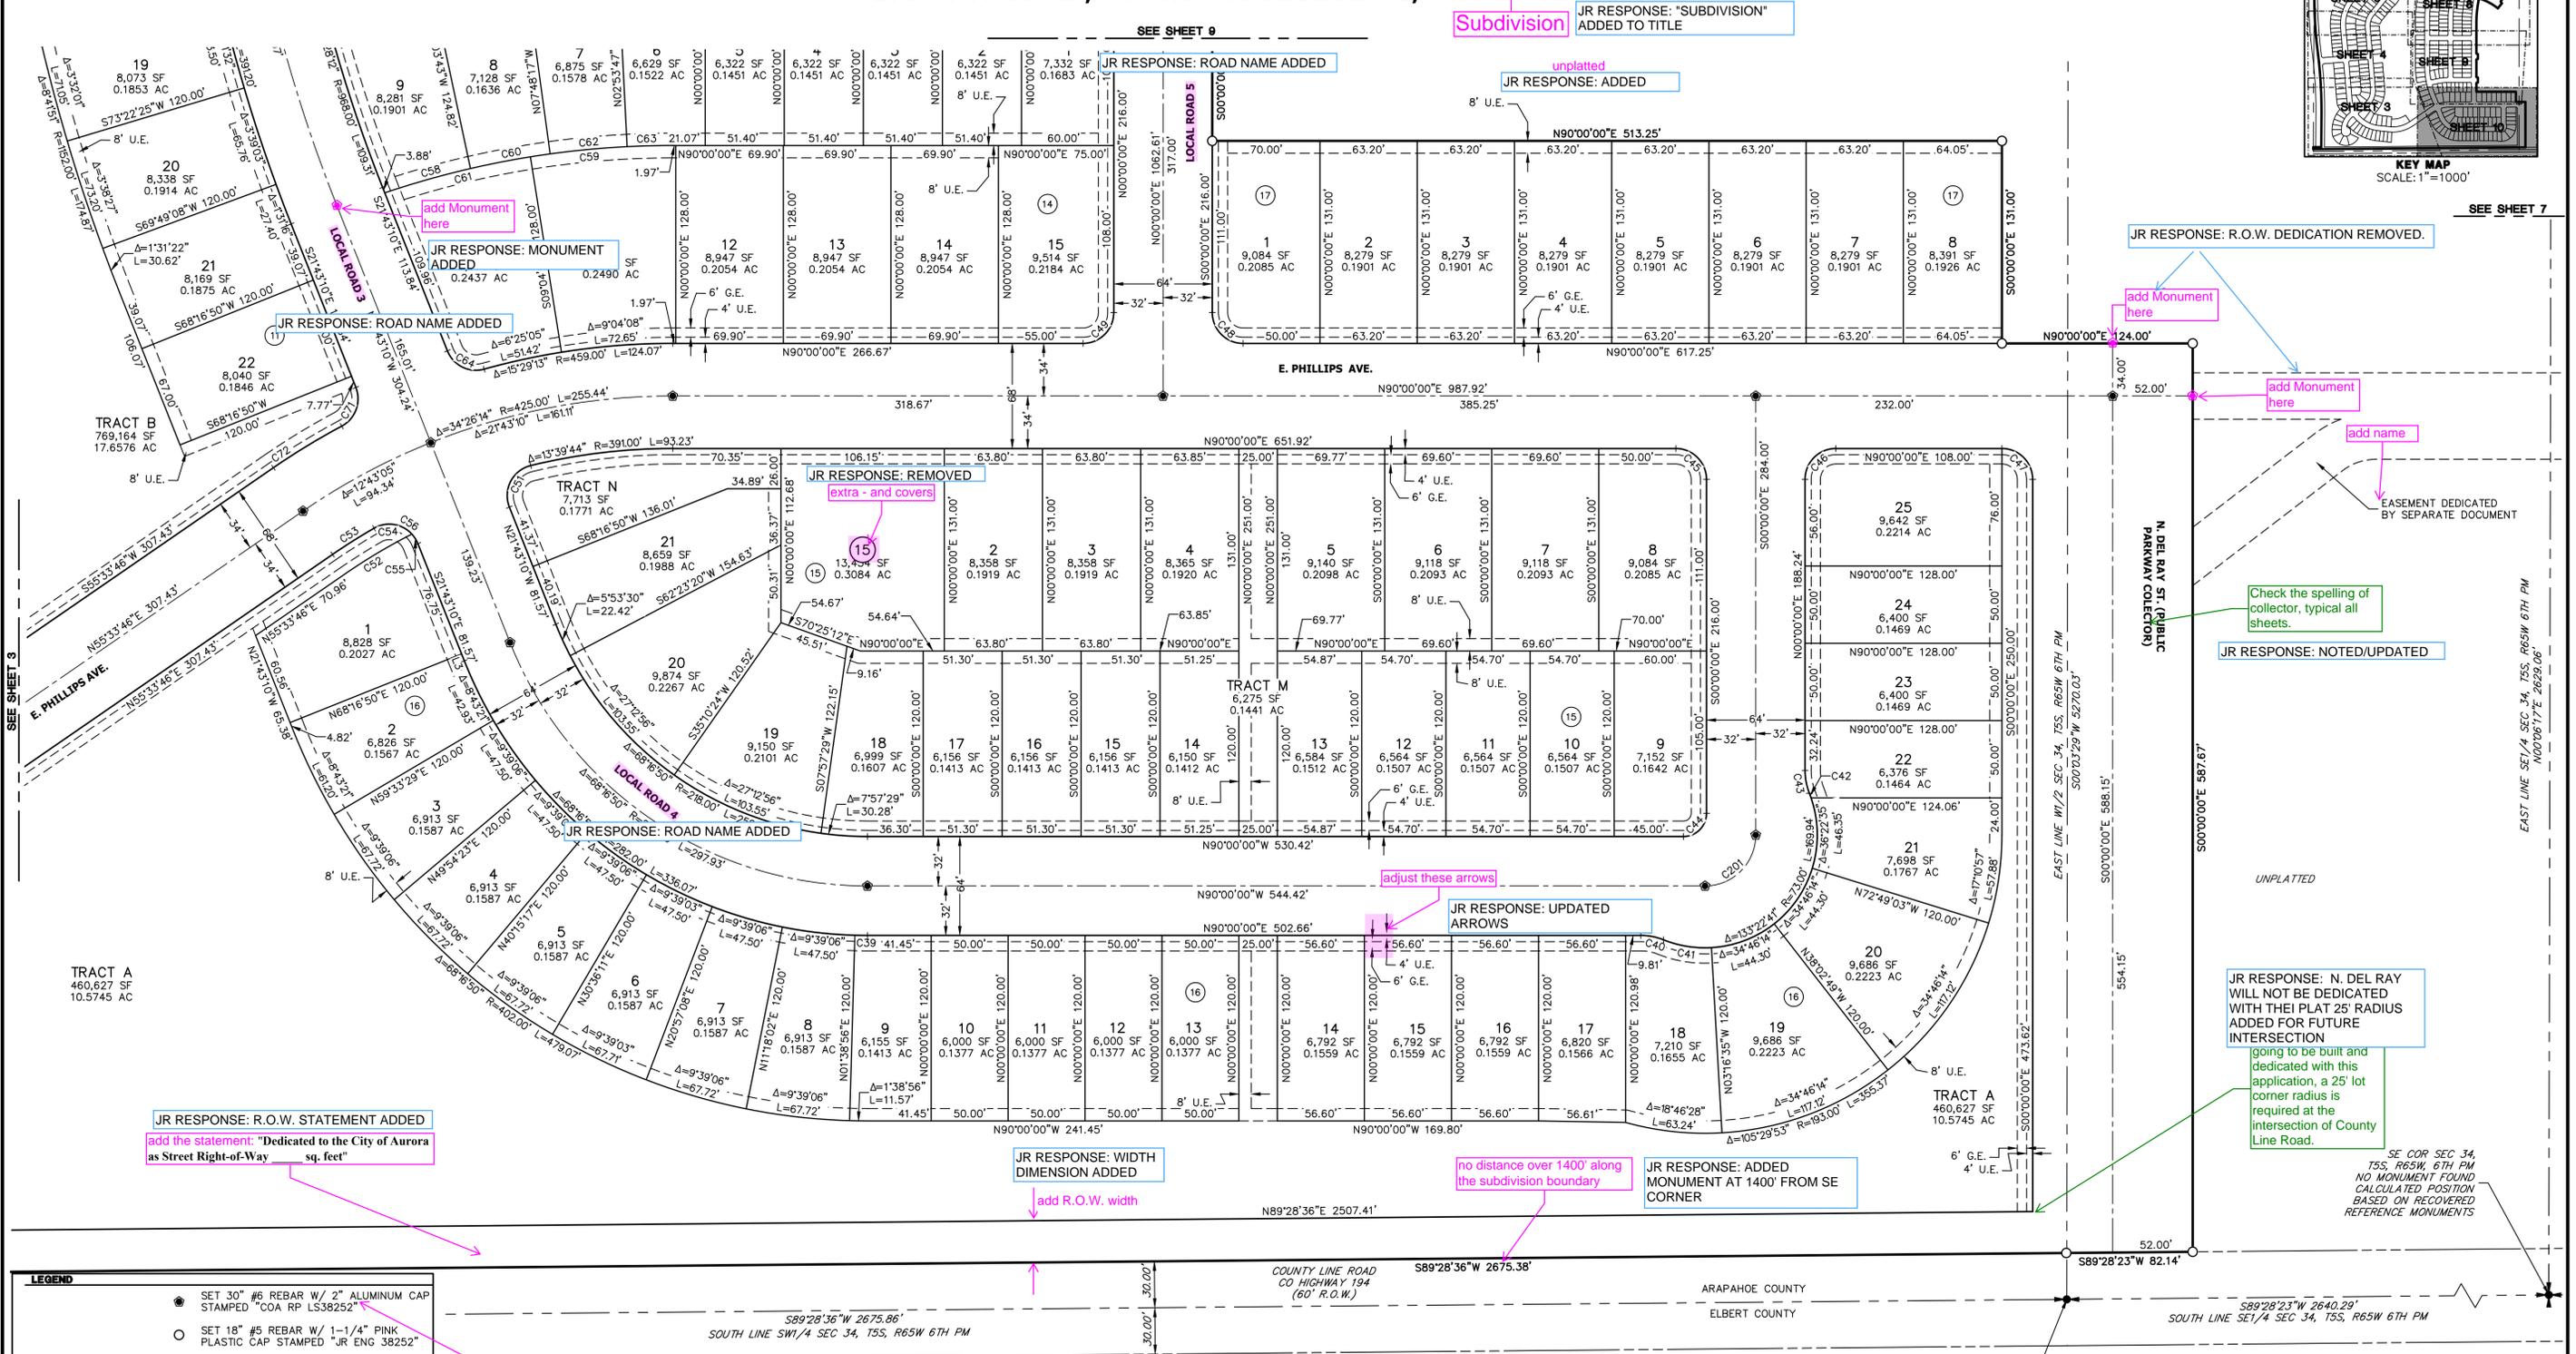


LEGEND

- SET 30" #6 REBAR W/ 2" ALUMINUM CAP STAMPED "COA RP LS38252"
- SET 18" #5 REBAR W/ 1-1/4" PINK PLASTIC CAP STAMPED "JR ENG 38252"
- (R) RECORD
- (M) MEASURED
- (R) RADIAL BEARING
- U.E. UTILITY EASEMENT
- G.E. GAS EASEMENT
- PROPOSED PROPERTY LINE
- - - PROPOSED RIGHT-OF-WAY
- - - PROPOSED CENTERLINE
- EXISTING PROPERTY LINE
- - - EXISTING RIGHT-OF-WAY

NOTE: SEE SHEET 11 FOR LINE AND CURVE TABLES.
NOTE: ALL LINES ARE RADIAL TO THE CORRESPONDING CURVES UNLESS OTHERWISE NOTED.

incorporate this info in the statement: Monument boxes with rebar (provide length and size of rebar and cap size) with cap bearing the registration number of the responsible surveyor, to be set after construction is completed per Sec. 147-47 Aurora City Code and per Sec. 38-51-105 (9)(a) & (b) Colorado Revised Statutes 2020.

JR RESPONSE: UPDATED RANGE POINT NOTE.

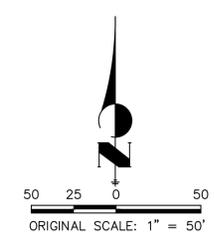

JOB NO. 16118.00
JUNE 29, 2023
SHEET 10 OF 11

Delete the company Logo JR RESPONSE: LOGO REMOVED



Centennial 303-740-9393 • Colorado Springs 719-593-2593
Fort Collins 970-491-9888 • www.jrengineering.com

TRAILS AT OVERLAND RANCH FILING NO. 1

A PARCEL OF LAND LOCATED IN SECTION 34, TOWNSHIP 5 SOUTH, RANGE 65 WEST OF THE 6TH PRINCIPAL MERIDIAN
CITY OF AURORA, COUNTY OF ARAPAHOE, STATE OF COLORADO

CURVE TABLE					
CURVE	DELTA	RADIUS	LENGTH	CHORD	
C1	4°27'16"	218.00'	16.95'	S15°35'02"W	16.94'
C2	85°14'17"	13.00'	19.34'	S29°15'45"E	17.61'
C3	93°02'38"	20.00'	32.48'	N84°54'30"W	29.03'
C4	0°09'51"	282.00'	0.81'	S00°28'36"W	0.81'
C5	2°46'42"	459.00'	22.26'	S82°35'53"E	22.26'
C6	98°03'26"	20.00'	34.23'	S09°09'06"W	30.20'
C7	0°17'59"	193.00'	1.01'	N47°15'30"E	1.01'
C8	23°33'16"	73.00'	30.01'	N10°35'53"E	29.80'
C9	21°41'20"	40.00'	15.14'	S50°13'02"W	15.05'
C10	1°36'51"	40.00'	1.13'	S71°30'33"E	1.13'
C11	21°41'20"	40.00'	15.14'	S61°28'19"E	15.05'
C12	20°04'29"	40.00'	14.01'	S60°39'53"E	13.94'
C13	37°23'05"	73.00'	47.63'	N53°37'26"W	46.79'
C14	21°41'20"	40.00'	15.14'	S50°13'02"W	15.05'
C15	37°50'39"	73.00'	48.22'	N41°17'51"E	47.35'
C16	90°00'00"	20.00'	31.42'	S84°22'22"W	28.28'
C17	6°20'43"	286.00'	31.67'	N53°48'00"W	31.66'
C18	61°05'54"	13.00'	13.86'	S44°03'21"W	13.22'
C19	15°26'06"	13.00'	3.50'	S82°19'22"W	3.49'
C20	76°32'01"	13.00'	17.36'	S51°46'24"W	16.10'
C21	90°00'00"	20.00'	31.42'	N84°22'22"E	28.28'
C22	1°22'22"	350.00'	8.39'	N89°16'24"W	8.39'
C23	1°22'22"	478.00'	11.45'	N89°16'24"W	11.45'
C24	4°58'48"	478.00'	41.55'	N53°07'02"W	41.53'
C25	4°45'49"	156.00'	12.97'	N87°39'30"E	12.97'
C26	84°57'21"	20.00'	29.66'	S17°34'11"E	27.01'
C27	85°23'06"	20.00'	29.81'	N67°30'41"E	27.12'
C28	89°14'34"	20.00'	31.15'	S44°34'52"E	28.10'
C29	8°54'42"	282.00'	43.86'	N04°09'03"E	43.82'
C30	20°46'42"	50.00'	18.13'	S10°05'04"W	18.03'
C31	20°46'42"	50.00'	18.13'	N79°39'04"E	18.03'
C32	90°00'00"	20.00'	31.42'	N45°02'25"E	28.28'
C33	20°46'42"	50.00'	18.13'	N10°20'56"W	18.03'
C34	24°09'57"	73.00'	30.79'	S08°39'20"E	30.56'
C35	20°46'42"	50.00'	18.13'	S79°34'14"E	18.03'

CURVE TABLE					
CURVE	DELTA	RADIUS	LENGTH	CHORD	
C36	6°25'47"	73.00'	8.19'	N72°23'46"W	8.19'
C37	90°00'00"	15.00'	23.56'	S45°02'25"W	21.21'
C38	89°39'18"	15.00'	23.47'	N45°07'56"W	21.15'
C39	1°38'56"	282.00'	8.12'	S89°10'32"E	8.12'
C40	21°41'20"	40.00'	15.14'	N79°09'20"W	15.05'
C41	24°57'55"	73.00'	31.81'	S80°47'37"E	31.56'
C42	2°29'42"	73.00'	3.18'	N20°26'29"W	3.18'
C43	21°41'20"	40.00'	15.14'	S10°50'40"E	15.05'
C44	90°00'00"	15.00'	23.56'	N45°00'00"E	21.21'
C45	90°00'00"	20.00'	31.42'	N45°00'00"W	28.28'
C46	90°00'00"	20.00'	31.42'	S45°00'00"W	28.28'
C47	90°00'00"	20.00'	31.42'	N45°00'00"W	28.28'
C48	90°00'00"	20.00'	31.42'	S45°00'00"E	28.28'
C49	90°00'00"	20.00'	31.42'	N45°00'00"E	28.28'
C50	90°00'00"	33.00'	51.84'	N44°41'42"E	46.67'
C51	98°03'26"	20.00'	34.23'	S27°18'33"W	30.20'
C52	7°37'54"	376.00'	50.08'	S59°22'43"W	50.05'
C53	4°39'39"	391.00'	31.81'	S57°53'35"W	31.80'
C54	77°00'47"	20.00'	26.88'	N81°16'12"W	24.90'
C55	21°02'39"	20.00'	7.35'	N32°14'29"W	7.30'
C56	77°00'47"	20.00'	26.88'	N81°16'12"W	24.90'
C57	90°00'00"	15.00'	23.56'	N45°00'00"W	21.21'
C58	5°38'57"	587.00'	57.88'	S74°13'49"W	57.85'
C59	4°54'30"	587.00'	50.29'	S84°38'58"W	50.27'
C60	3°52'35"	587.00'	39.71'	S78°59'35"W	39.71'
C61	5°38'57"	587.00'	57.88'	S74°13'49"W	57.85'
C62	4°54'30"	587.00'	50.29'	S84°38'58"W	50.27'
C63	2°53'47"	587.00'	29.67'	S88°33'06"W	29.67'
C64	83°46'04"	20.00'	29.24'	S63°36'12"E	26.70'
C65	92°49'37"	15.00'	24.30'	S31°09'51"W	21.73'
C66	0°21'37"	718.00'	4.52'	S77°45'28"W	4.52'
C67	92°49'37"	15.00'	24.30'	S56°00'32"E	21.73'
C68	88°13'03"	15.00'	23.10'	N44°06'32"E	20.88'
C69	90°00'00"	15.00'	23.56'	S45°00'00"E	21.21'
C70	90°00'00"	15.00'	23.56'	N45°00'00"E	21.21'

CURVE TABLE					
CURVE	DELTA	RADIUS	LENGTH	CHORD	
C71	83°46'04"	20.00'	29.24'	N20°09'52"E	26.70'
C72	6°29'08"	459.00'	51.96'	S58°48'20"W	51.93'
C73	0°49'03"	1032.00'	14.72'	S00°24'31"E	14.72'
C74	0°49'03"	1152.00'	16.44'	S00°24'31"E	16.44'
C75	0°11'58"	782.00'	2.72'	S77°40'38"W	2.72'
C76	3°35'42"	902.00'	56.60'	S79°34'29"W	56.59'
C77	3°35'42"	902.00'	56.60'	S79°34'29"W	56.59'
C78	3°12'45"	902.00'	50.57'	S83°22'32"W	50.57'
C79	4°23'47"	902.00'	69.21'	S87°10'48"W	69.19'
C80	4°23'47"	902.00'	69.21'	S87°10'48"W	69.19'
C81	0°11'58"	902.00'	3.14'	S77°40'38"W	3.14'
C82	90°00'00"	15.00'	23.56'	S45°00'00"W	21.21'
C83	90°00'00"	15.00'	23.56'	N45°00'00"E	21.21'
C84	90°00'00"	15.00'	23.56'	S45°00'00"W	21.21'
C85	90°00'00"	15.00'	23.56'	N45°00'00"E	21.21'
C86	90°00'00"	15.00'	23.56'	S45°00'00"E	21.21'
C87	90°00'00"	15.00'	23.56'	N45°00'00"E	21.21'
C88	90°00'00"	15.00'	23.56'	S45°00'00"E	21.21'
C89	90°00'00"	15.00'	23.56'	N45°00'00"E	21.21'
C90	0°04'13"	1086.00'	1.33'	S07°05'08"W	1.33'
C91	0°04'13"	1206.00'	1.48'	S07°05'08"W	1.48'
C92	8°37'37"	20.00'	3.01'	N02°48'26"E	3.01'
C93	81°22'23"	20.00'	28.40'	N42°11'34"W	26.08'
C94	81°22'23"	20.00'	28.40'	N42°11'34"W	26.08'
C95	30°00'00"	20.00'	10.47'	S22°07'14"W	10.35'
C96	60°00'00"	20.00'	20.94'	S67°07'14"W	20.00'
C97	60°00'00"	20.00'	20.94'	S67°07'14"W	20.00'
C98	30°00'00"	20.00'	10.47'	N07°52'46"W	10.35'
C99	60°00'00"	20.00'	20.94'	N52°52'46"W	20.00'
C100	60°00'00"	20.00'	20.94'	N52°52'46"W	20.00'
C101	1°33'12"	902.00'	24.46'	S05°42'26"W	24.45'
C102	2°06'48"	902.00'	33.27'	S03°52'26"W	33.27'
C103	2°06'48"	902.00'	33.27'	S03°52'26"W	33.27'
C104	1°28'06"	902.00'	23.12'	S02°04'59"W	23.12'
C105	1°20'56"	902.00'	21.24'	S00°40'28"W	21.23'

CURVE TABLE					
CURVE	DELTA	RADIUS	LENGTH	CHORD	
C106	0°38'12"	902.00'	10.02'	S06°48'08"W	10.02'
C107	30°00'00"	20.00'	10.47'	S22°07'14"W	10.35'
C108	60°00'00"	20.00'	20.94'	S67°07'14"W	20.00'
C109	21°3'58"	708.00'	27.59'	N81°45'47"W	27.59'
C110	60°43'07"	20.00'	21.19'	N50°17'14"W	20.22'
C111	3°39'54"	698.00'	44.65'	N81°02'49"W	44.64'
C112	31°24'42"	20.00'	10.96'	N04°13'20"W	10.83'
C113	60°43'07"	20.00'	21.19'	N50°17'14"W	20.22'
C114	60°00'00"	20.00'	20.94'	S67°07'14"W	20.00'
C115	0°18'52"	598.00'	3.28'	S06°43'41"W	3.28'
C116	0°14'07"	598.00'	2.46'	S07°00'10"W	2.46'
C117	4°30'50"	598.00'	47.11'	S04°18'49"W	47.10'
C118	4°30'50"	598.00'	47.11'	S04°18'49"W	47.10'
C119	2°03'22"	598.00'	21.46'	S01°01'41"W	21.46'
C120	2°03'22"	598.00'	21.46'	S01°01'41"W	21.46'
C121	1°40'54"	402.00'	11.80'	S01°08'45"E	11.80'
C122	1°40'54"	282.00'	8.28'	S01°08'45"E	8.28'
C123	7°04'08"	282.00'	34.79'	S34°28'33"E	34.77'
C124	10°26'02"	50.00'	9.11'	N05°31'18"W	9.09'
C125	10°20'41"	50.00'	9.03'	N15°54'39"W	9.02'
C126	10°20'41"	50.00'	9.03'	N15°54'39"W	9.02'
C127	23°23'27"	73.00'	29.80'	S37°52'39"W	29.60'
C128	20°46'42"	50.00'	18.13'	S79°54'56"E	18.03'
C129	20°46'42"	50.00'	18.13'	N79°18'21"E	18.03'
C130	23°42'54"	73.00'	30.22'	N31°33'48"W	30.00'
C131	3°53'04"	50.00'	3.39'	S18°31'53"W	3.39'
C132	16°53'39"	50.00'	14.74'	S08°08'32"W	14.69'
C133	20°46'42"	50.00'	18.13'	S10°05'04"W	18.03'
C134	8°42'01"	218.00'	33.10'	S04°39'18"E	33.07'
C135	17°08'15"	218.00'	65.21'	S08°52'25"E	64.96'
C136	8°26'14"	218.00'	32.10'	S13°13'26"E	32.07'
C137	0°23'39"	268.00'	1.84'	S17°38'22"E	1.84'
C138	0°21'53"	268.00'	1.71'	S41°20'10"E	1.71'
C139	83°46'04"	20.00'	29.24'	S83°24'08"E	26.70'
C140	83°46'04"	20.00'	29.24'	N00°21'56"E	26.70'

CURVE TABLE					
CURVE	DELTA	RADIUS	LENGTH	CHORD	
C141	9°33'20"	590.00'	98.40'	S41°47'25"W	98.28'
C142	2°35'33"	590.00'	26.70'	S35°42'58"W	26.70'
C143	10°48'57"	590.00'	111.37'	N41°09'37"E	111.21'
C144	3°20'00"	459.00'	26.70'	S36°05'12"W	26.70'
C145	7°49'46"	459.00'	62.72'	S38°20'05"W	62.67'
C146	4°29'46"	459.00'	36.02'	S40°00'05"W	36.01'
C147	26°47'59"	20.00'	9.35'	N47°49'11"E	9.27'
C148	59°23'13"	20.00'	20.73'	S89°05'12"E	19.81'
C149	86°11'13"	20.00'	30.08'	N77°30'48"E	27.33'
C150	59°23'13"	20.00'	20.73'	S43°02'07"E	19.81'
C151	26°56'29"	20.00'	9.40'	S00°07'44"W	9.32'
C152	86°19'42"	20.00'	30.13'	S29°33'52"E	27.36'
C153	3°01'04"	532.00'	28.02'	N12°05'26"E	28.02'
C154	5°24'04"	600.00'	56.56'	N14°20'04"W	56.54'
C155	5°11'05"	600.00'	54.29'	N15°00'59"W	54.28'
C156	5°36'45"	600.00'	58.77'	N19°50'29"W	58.75'
C157	5°11'14"	600.00'	54.32'	N20°12'08"W	54.30'
C158	5°31'05"	600.00'	57.78'	N25°33'17"W	57.76'
C159	5°39'58"	600.00'	59.34'	N25°28'51"W	59.31'
C160	0°47'24"	600.00'	8.27'	N12°01'44"W	8.27'
C161	4°40'27"	652.00'	53.19'	N32°49'03"W	53.18'
C162	2°51'21"	652.00'	32.50'	N36°34'57"W	32.49'
C163	2°01'03"	652.00'	22.96'	N37°00'06"W	22.96'
C164	5°30'45"	652.00'	62.73'	N33°14'12"W	62.71'
C165	2°41'34"	532.00'	25.00'	N29°02'26"W	25.00'
C166	2°51'21"	532.00'	26.52'	N36°34'57"W	26.51'
C167	90°00'00"	15.00'	23.56'	S44°41'42"W	21.21'
C168	90°00'00"	15.00'	23.56'	N45°18'18"W	21.21'
C169	7°47'55"	282.00'	3		